




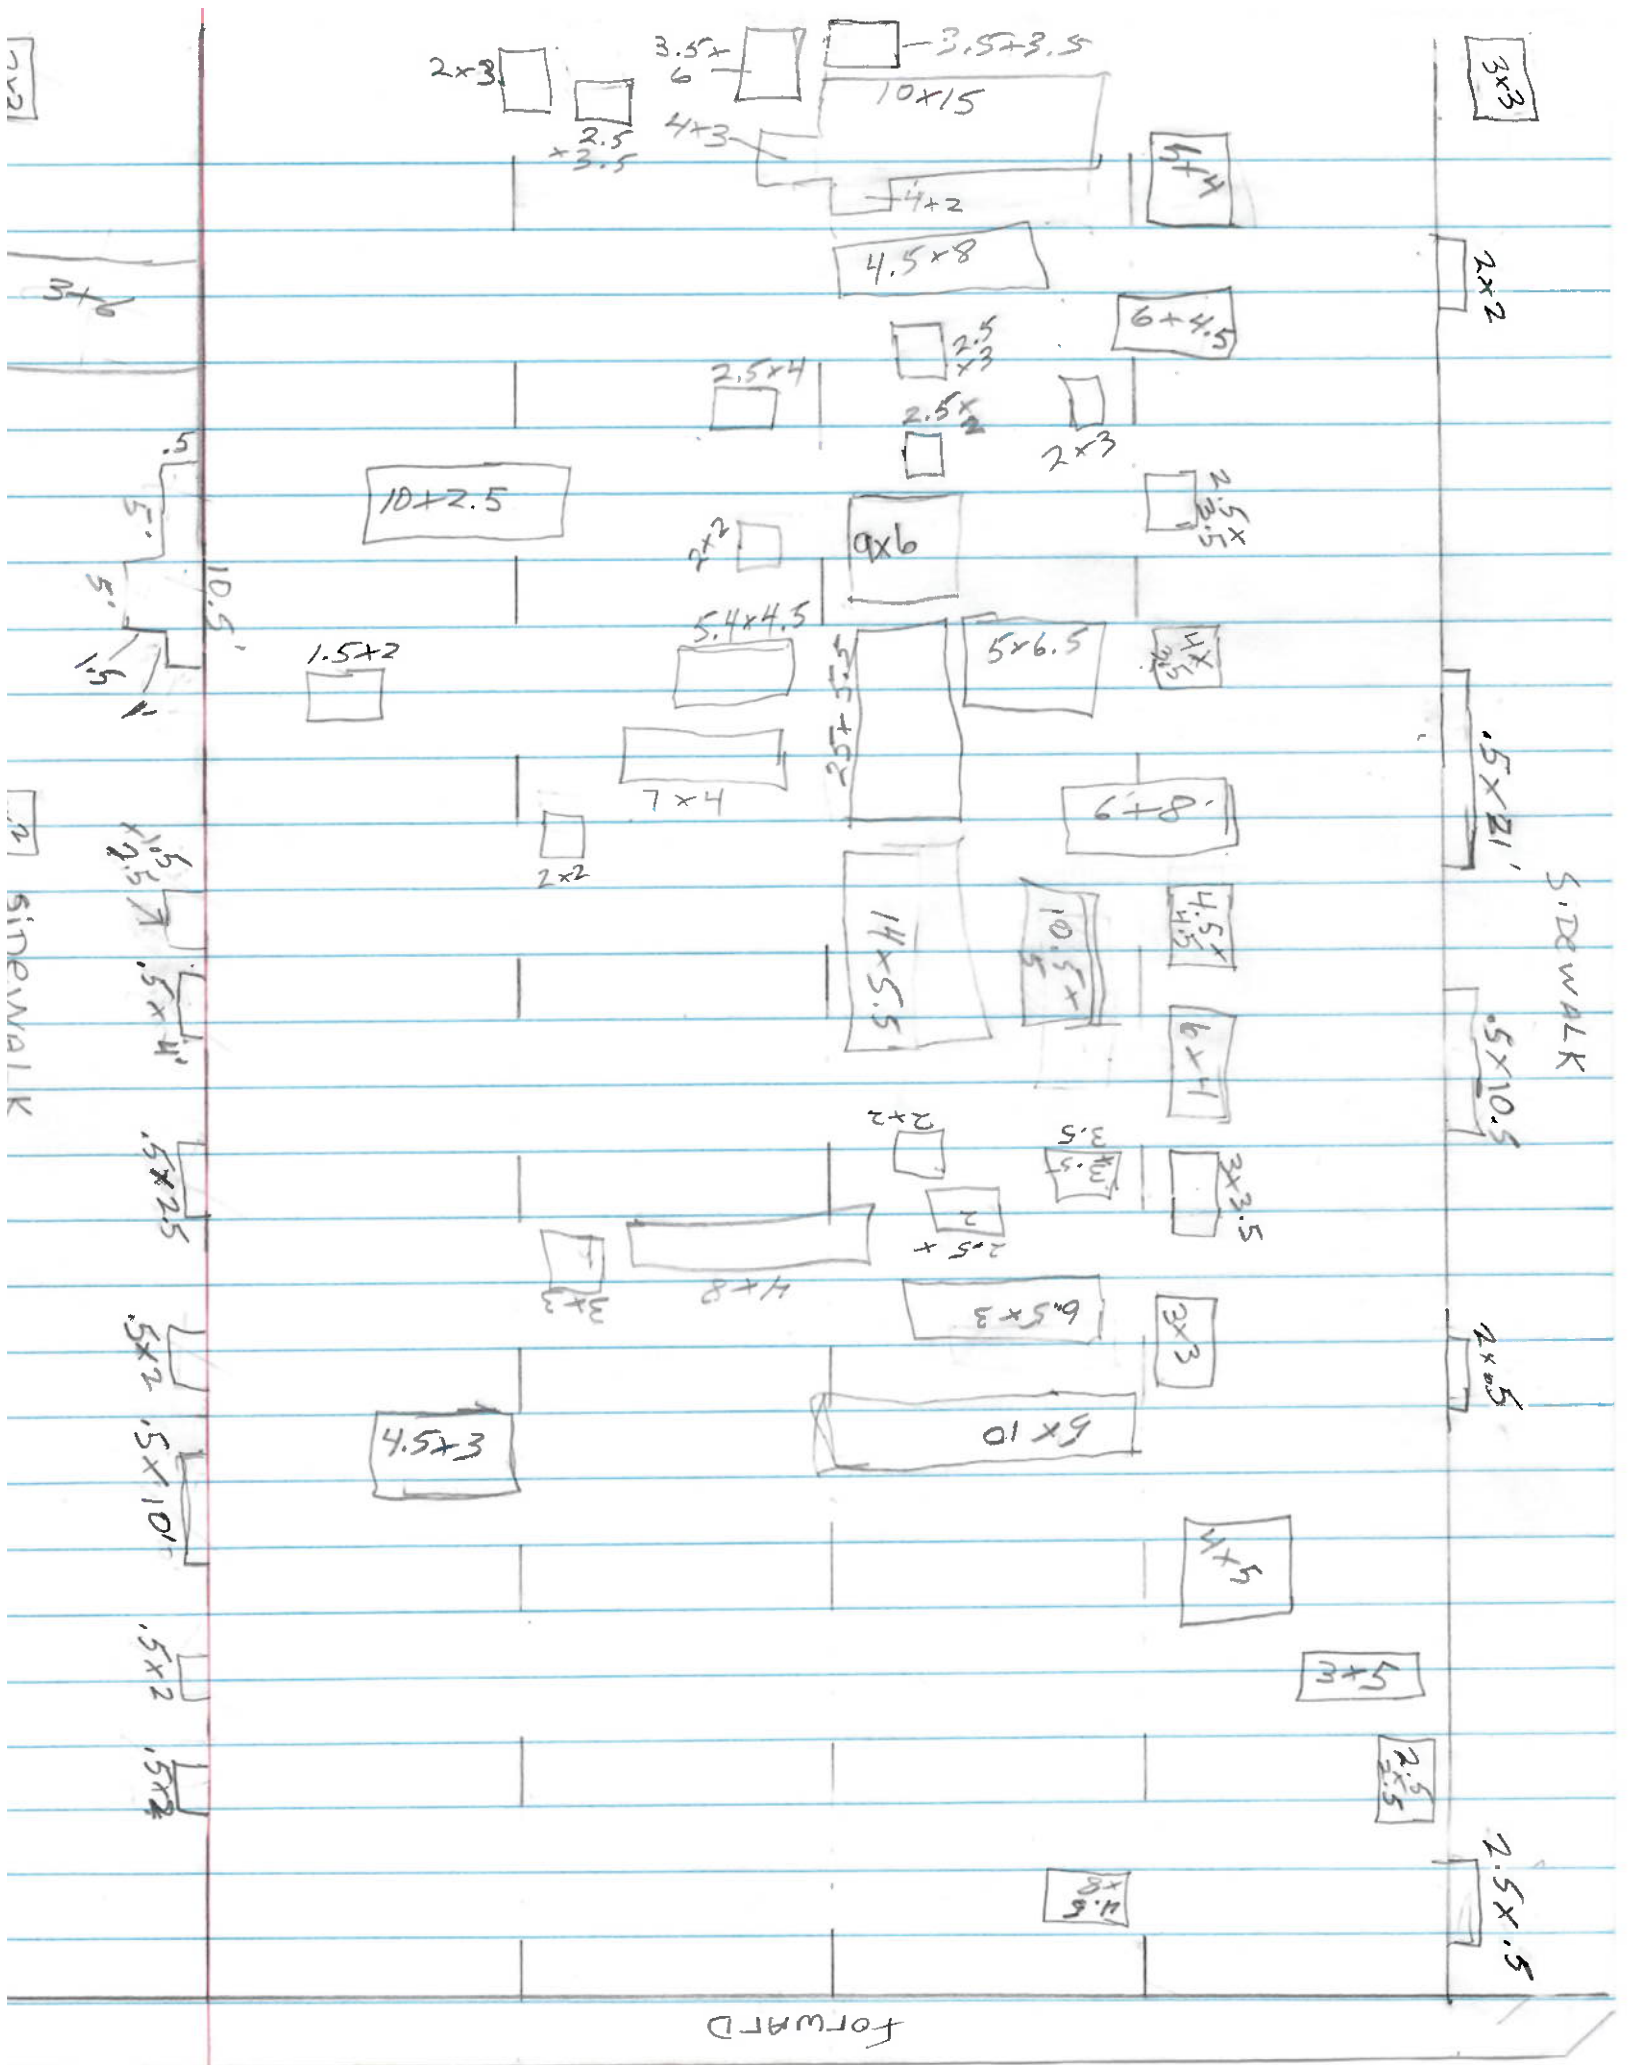

Rear

13.50  
6.25  
55.00  
16.00  
8.00  
7.50  
95.00  
24.00  
7.50  
33.25  
25.00  
16.50  
14.00  
8.00  
42.00  
13.75  
9.00  
87.50  
6.25  
72.25  
56.25  
10.00  
22.50  
13.75  
80.00  
4.00  
5.00  
4.00  
60.00  
3 19.00  
72.00  
2.00  
6.00  
11.25  
28.00  
22.50  
16.00  
10.00  
27.00  
13.50  
18.00  
6.00

90.25

12.00

33.25

56.00

35.75

12.00

35.00

24.00

5.00

1670.25

Rear Sidewalk

8.00

4.00

6.00

1.00

1.50

3.50

19.25

11.50

1.75

2.75

3.50

.50

1.00

64.25

# Forward

# Sidewalk

36.00

6.25

15.00

20.00

50.00

6.00

19.50

13.50

32.00

9.00

5.00

4.00

12.25

10.50

24.00

77.00

52.50

20.25

48.00

4.00

28.00

137.50

24.75

4.00

54.00

32.50

14.00

8.75

6.00

27.00

7.50

5.00

10.00

25.00

3.00

36.00

20.00

8.00

12.00

150.00

12.25

21.00

6.00

8.75

1125.75

Deck  
Total

2796 SF.

Sidewalk  
Total

151 SF.

1.25

1.00

5.25

10.50

4.00

9.00

6.00

18.00

5.25

7.50

3.75

4.00

2.00

1.25

1.00

5.00

1.00

1.00

86.75