


HAM-75-8.28

NORTH

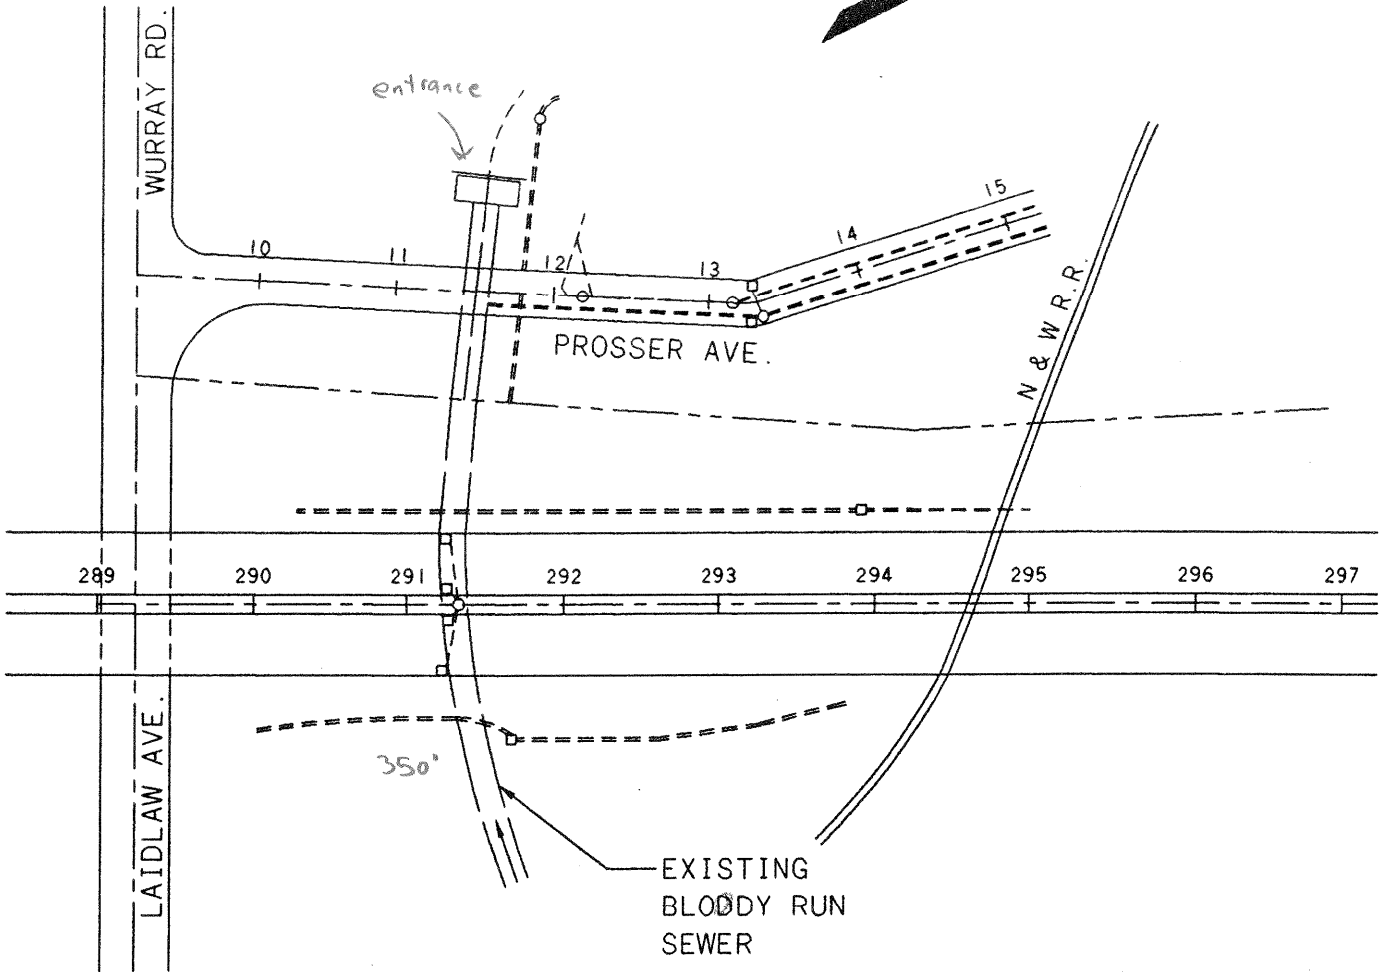

BLOODY RUN SEWER
HAMILTON COUNTY
HAM-75-0828

RUBENSON
ENGINEERS
ARCHITECTS