




NOTES:

(Depth of Hole 377.3', Elev. 607.0')

1. Upon attempting to install well, encountered obstruction at 40.0', then installed observation well to that depth.
2. The Observation Well was installed on 3-15-04.

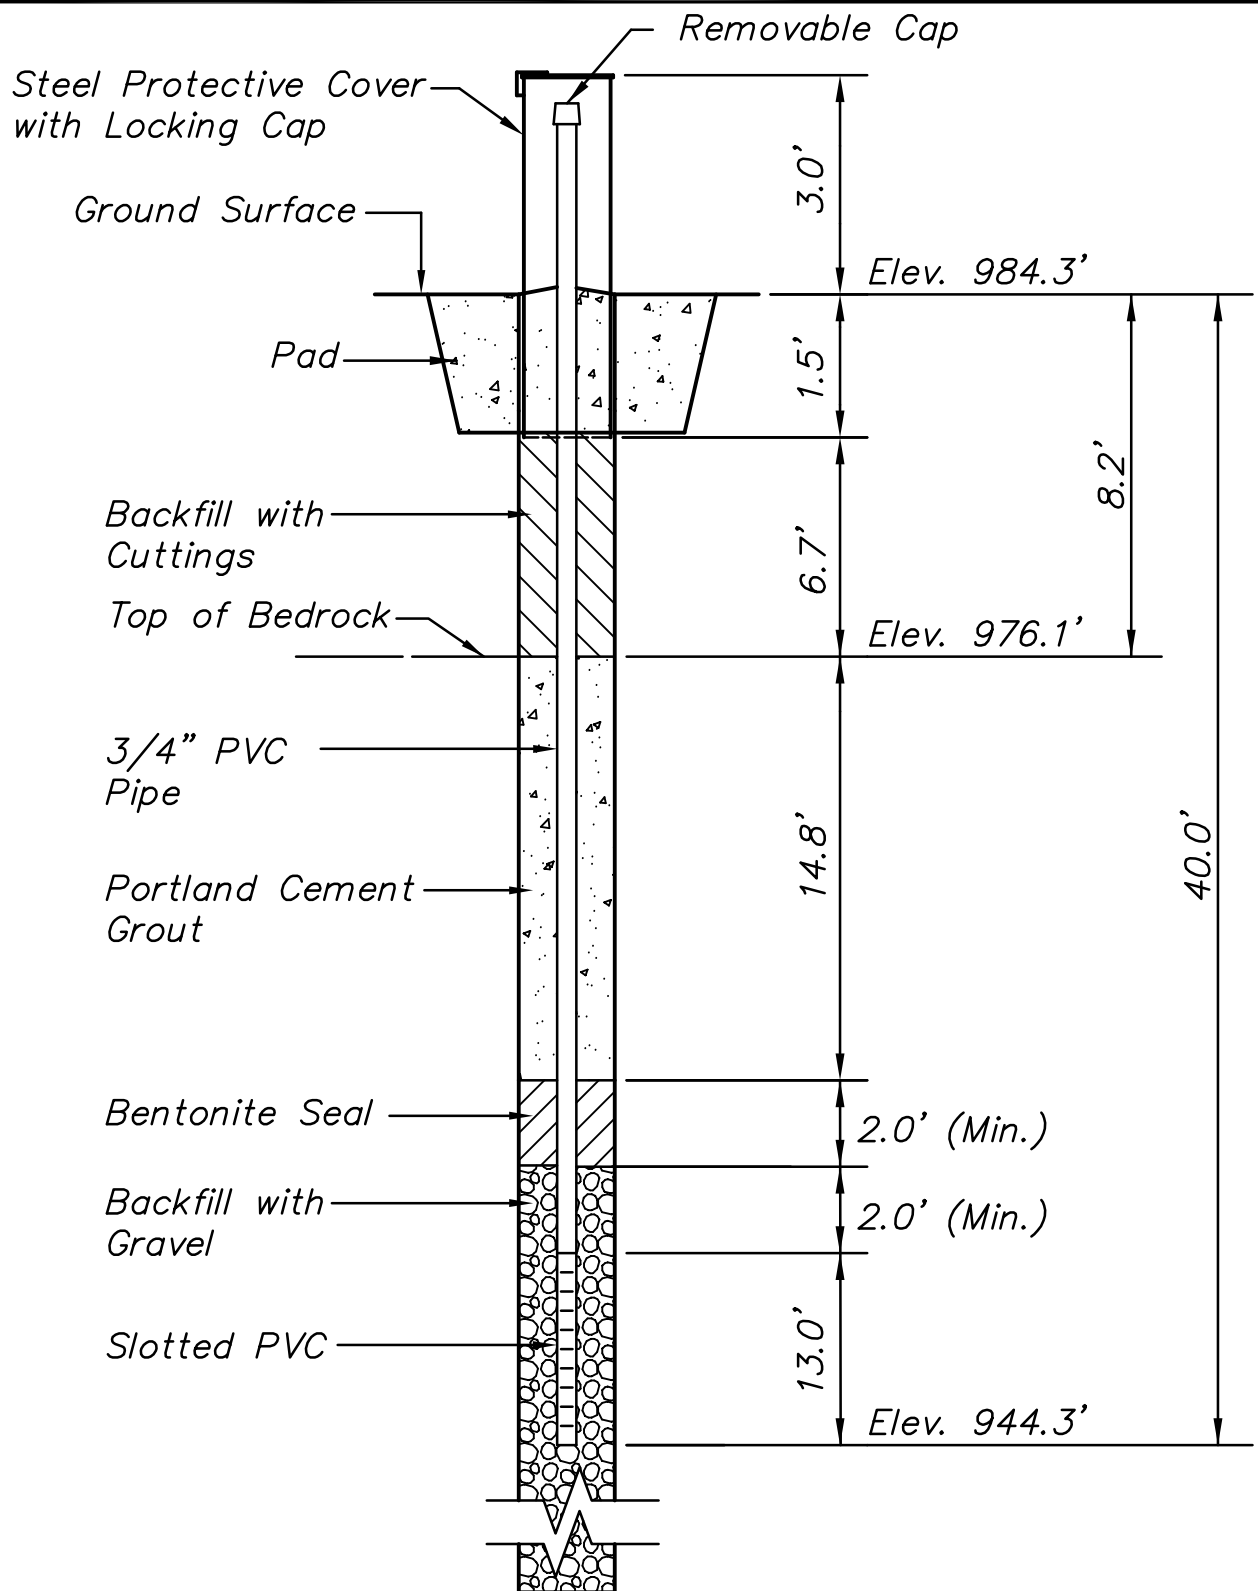

**OBSERVATION WELL
INSTALLATION
Boring No. 1**

LAW 7-17.40/18.45
Lawrence County, Ohio
NOT TO SCALE