


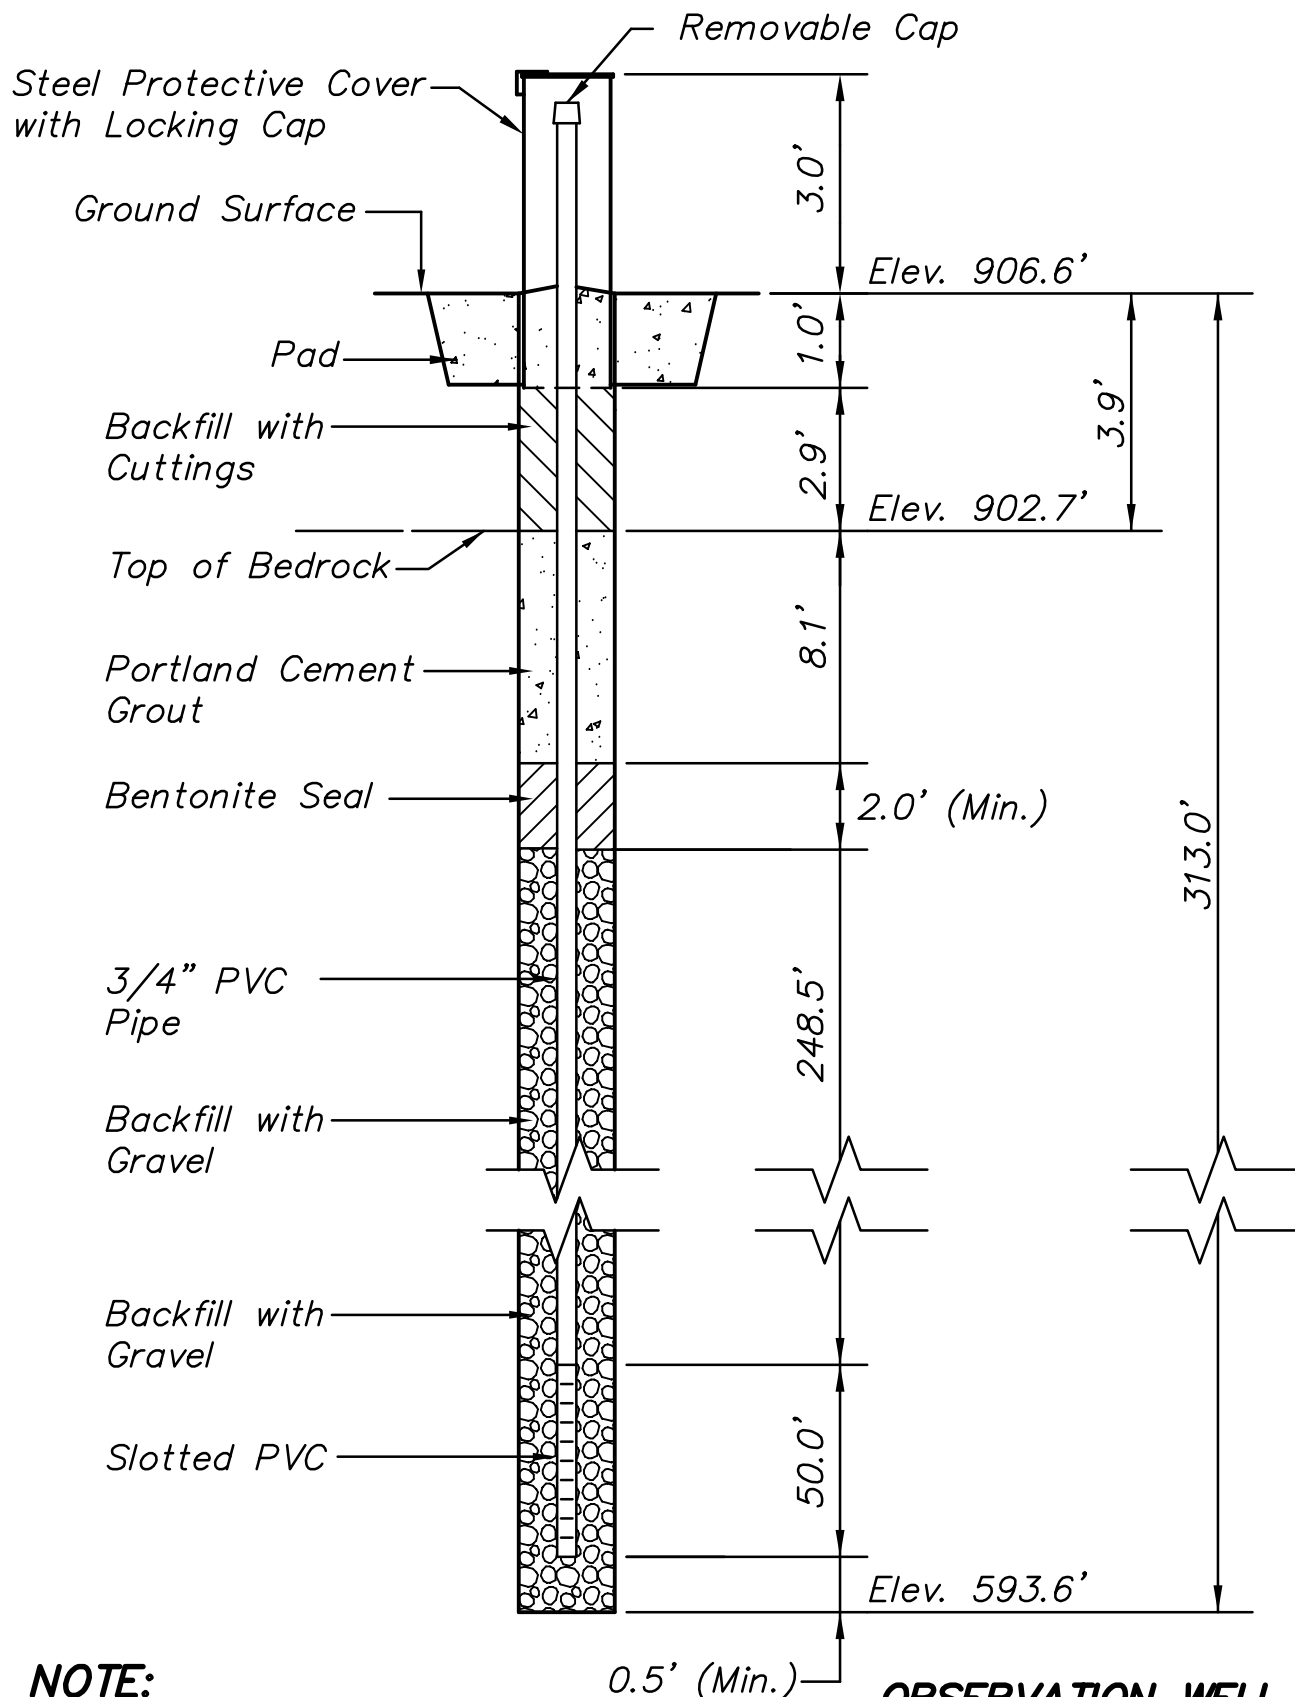

NOTE:

The Observation Well was installed on 3-26-04.

**OBSERVATION WELL
INSTALLATION
Boring No. 3**

LAW 7-17.40/18.45
Lawrence County, Ohio
NOT TO SCALE

