


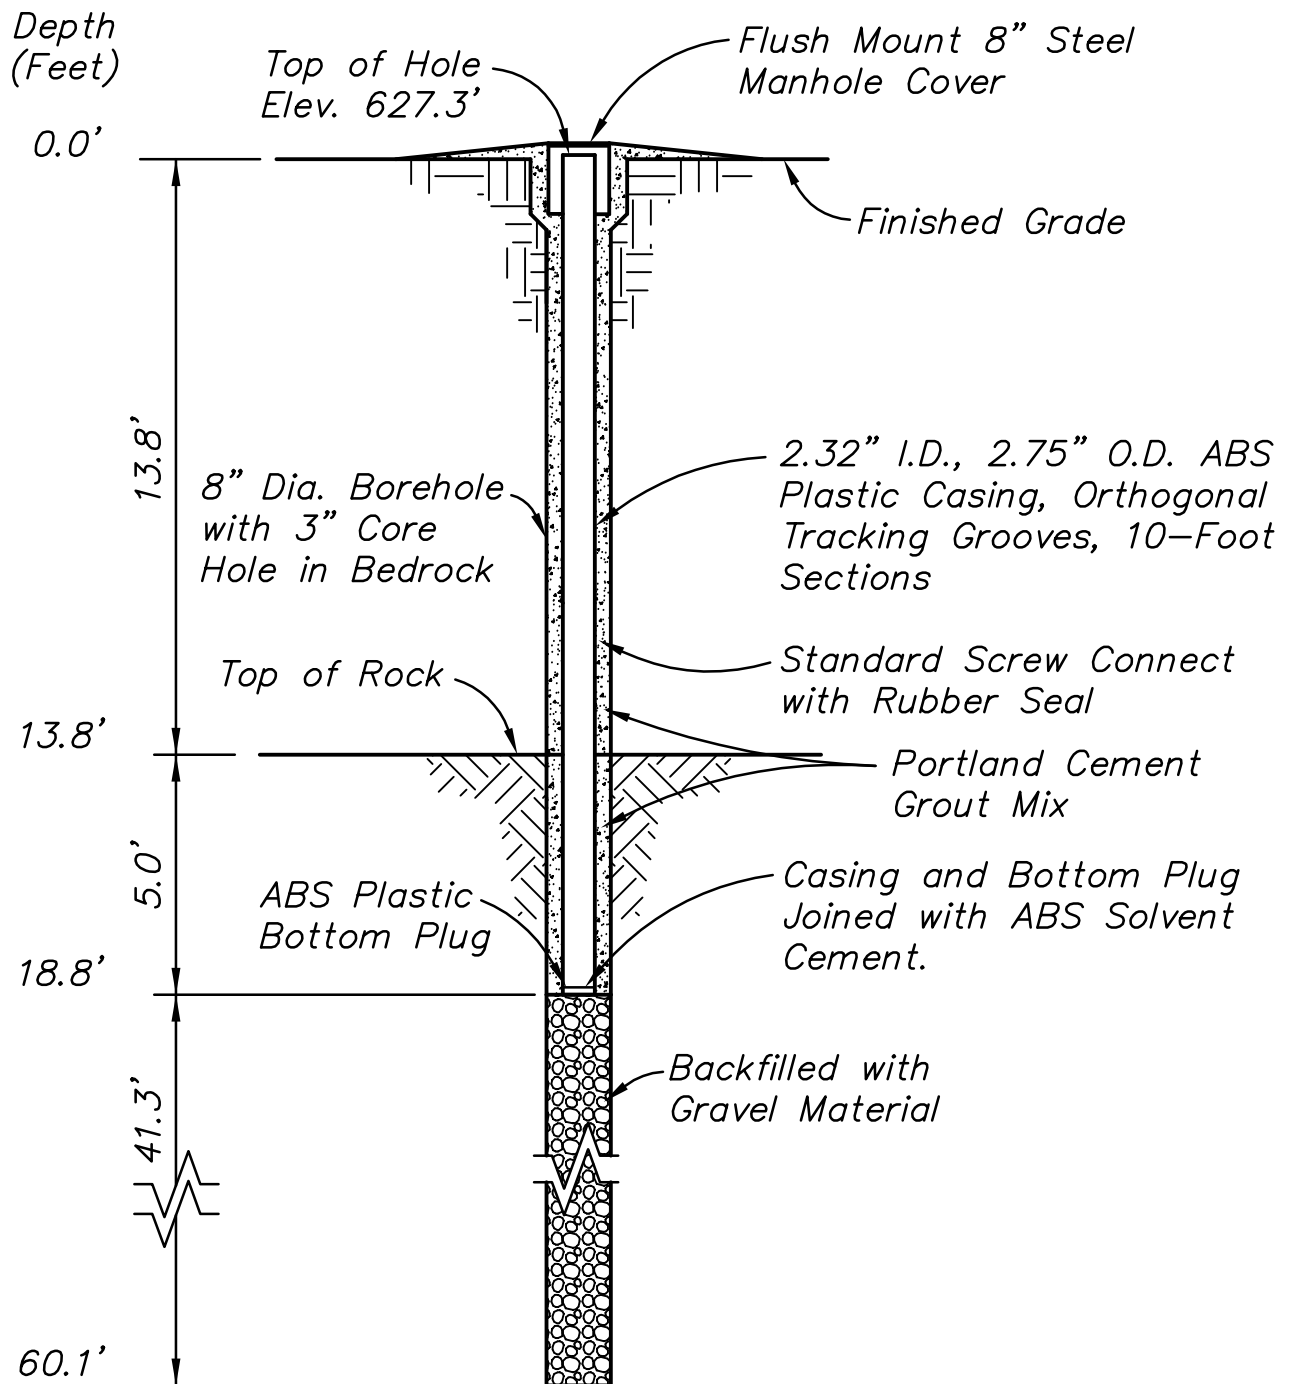

NOTES:

1. Fill around casing shall be compacted using hand operated tamping equipment.
2. The Inclinometer was installed on 3-24-04.

INCLINOMETER INSTALLATION DETAIL BORING NO. 4

LAWRENCE COUNTY, OHIO
LAW 7-17.40/18.45

NOT TO SCALE

