



STATE OF OHIO  
DEPARTMENT OF HIGHWAYS

INTER-OFFICE COMMUNICATION

County of ADAMS Div. 9

S. H. 125 Sec. Panhandle

Date 2-25-69

To Fred C. Tarbox, Engineer, Bureau of Traffic

Attention: John W. Clark, Traffic  
Operations Engineer

From W.R. Wright DTE


Subject Signal Up-grading.

This will advise you that the signal heads for Signal No. 628, located at S.R. 125 & S.R. 136, ADAMS Co, were up-graded on the following date 2-25-69.

We removed the following heads (number, size and type): ONE 8" 2WAY double unit.

We installed the following heads (number, size and type): TWO 8" 4WAY single unit.

The sketch below shows how the signal heads were displayed when the job was finished:

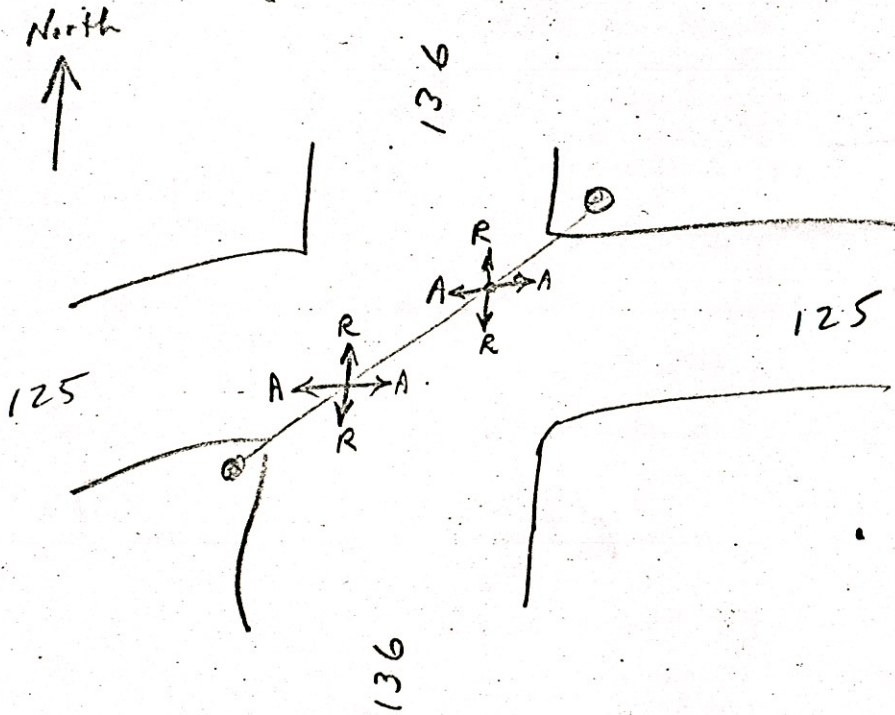

RVS  
file  
letter file

Druggan - Stout