

SR 125 & SR 136

Sight Distance is Good in All Directions



WEST UNION 4  
GEORGETOWN 19

STOP  
125  
136




STOP BAR  
IN BAD  
SHAPE  
ALL MOST  
Nothing  
Left of them

NORTH  
136

HOUSE

STOP  
125  
136

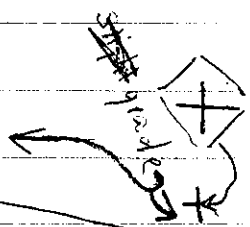


WEST  
125

STANDARD  
710

STOP

125 R

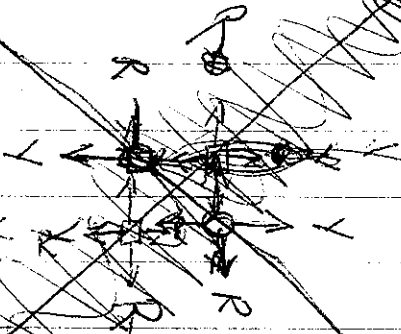

EAST  
125

136

Road Side  
PARK

PAN HANDLE

STOP  
125

STOP

CHERRY FORK 6  
MANCHESTER 9

136  
SOUTH  
HINDS

STOP BAR ARE  
IN REAL BAD  
SHAPE

← GEORGETOWN 19

STOP  
125

STOP  
AHEAD



Present volumes do not meet any of the standard warrants for a traffic signal at this intersection.