

STATE OF OHIO
 for the benefit of
 the Ohio Department of
 Rehabilitation and
 Correction

6.03 Ac

0.35 Ac

1.73 Ac

**ROSS COUNTY COMMUNITY
 IMPROVEMENT CORP.**

P.I. = 36+83.05
 Ls = 350.00'
 fs = 5° 15' 00"
 LT = 233.44'
 ST = 116.76'
 x = 349.71'
 y = 10.68'
 k = 174.95'
 p = 2.67'
 P.I. Sta = 39+79.71
 Dc = 21° 02' 20" (RT)
 Dc = 3° 00' 00"
 R = 1,909.86'
 Ls = 350.00'
 Theta = 5° 15' 00"
 LT = 233.44'
 ST = 116.76'
 x = 349.71'
 y = 10.68'
 k = 174.95'
 p = 2.67'
 Dc = 10° 32' 20" (RT)
 Lc = 351.30'
 Ts = 530.09'
 Es = 35.37'

CORP. LINE
 CITY OF CHILLICOTHE
Rt Juan Law
Op. Trust Lane
 P.I. = 42+67.67
 Ls = 350.00'
 fs = 5° 15' 00"
 LT = 233.44'
 ST = 116.76'
 x = 349.71'
 y = 10.68'
 k = 174.95'
 p = 2.67'

P & M LEASING
 GATEWAY INTERCHANGE
 INDUSTRIAL PARK
 (UNDER DEVELOPMENT)


**PREFERRED
 ALTERNATIVE "E"**

CLOSED ACCESS POINT 

 TEMPORARY R/W 

 PERMANENT R/W 

Figure 4c

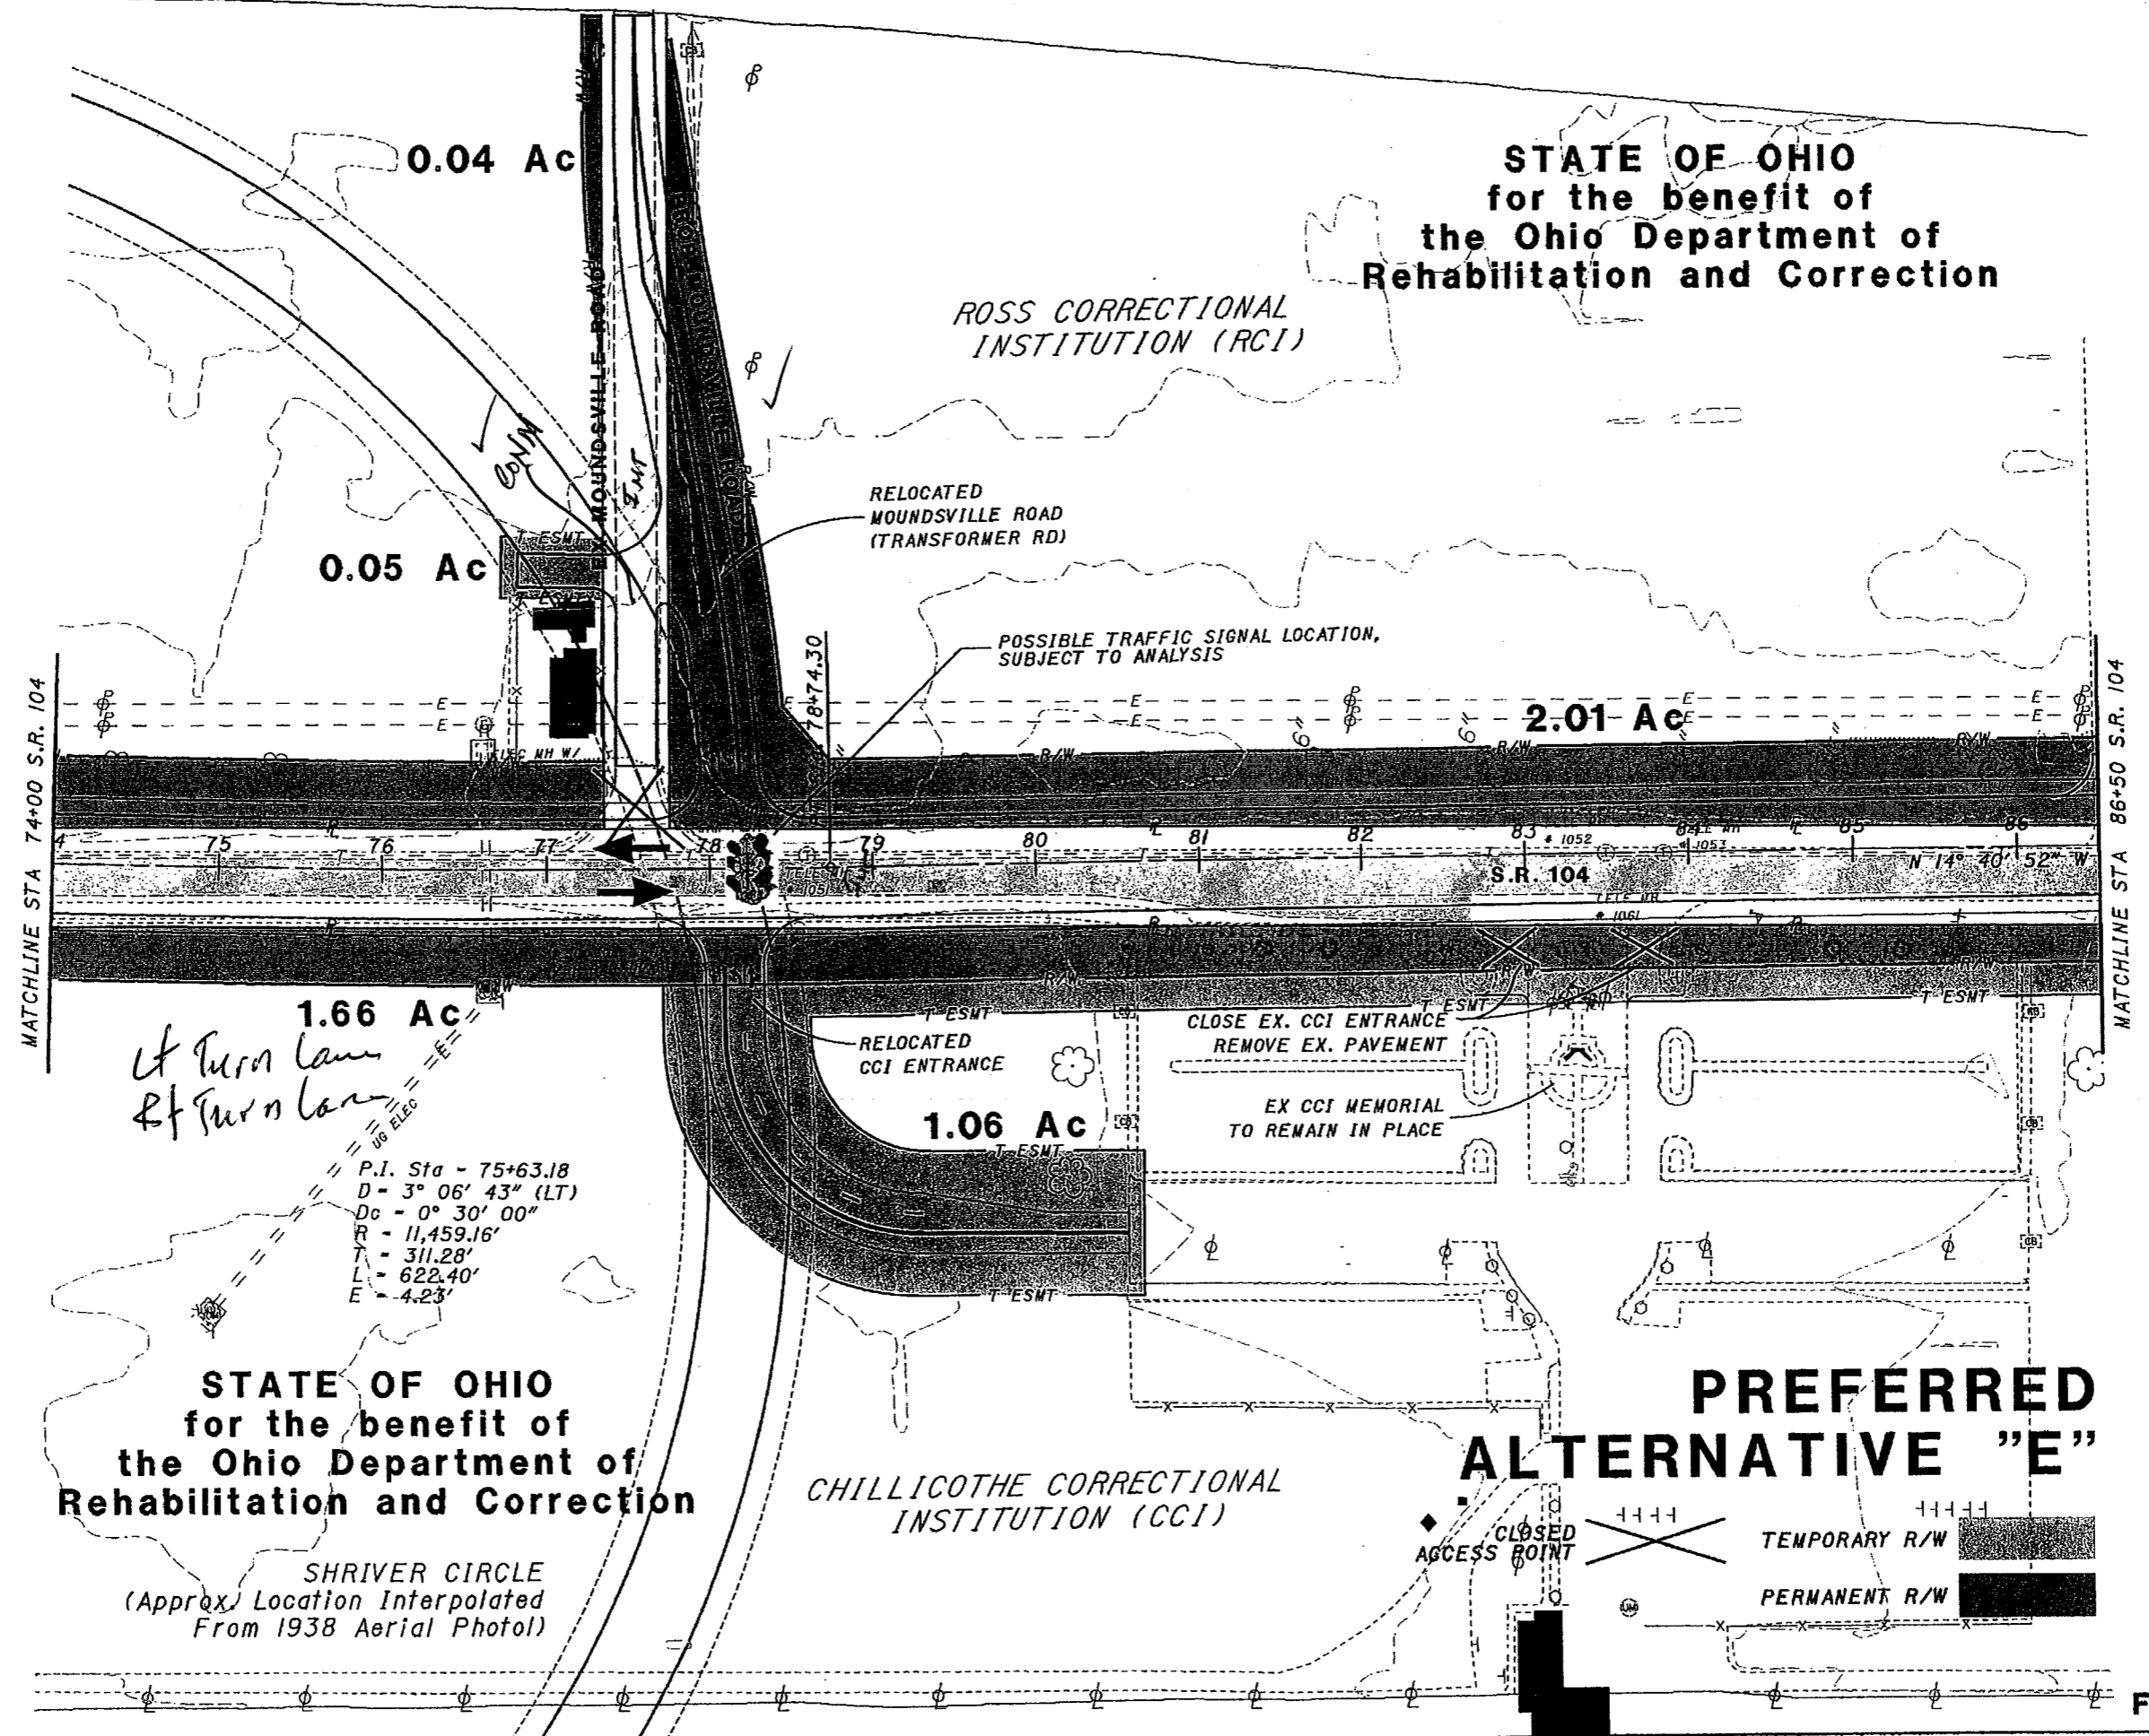

STATE OF OHIO
 for the benefit of
 the Ohio Department of
Rehabilitation and Correction

ROSS CORRECTIONAL
 INSTITUTION (RCI)

RELOCATED
 MOUNDSVILLE ROAD
 (TRANSFORMER RD)

POSSIBLE TRAFFIC SIGNAL LOCATION,
 SUBJECT TO ANALYSIS

2.01 Ac

S.R. 104

0.05 Ac

0.04 Ac

1.66 Ac

1.06 Ac

STATE OF OHIO
 for the benefit of
 the Ohio Department of
Rehabilitation and Correction

SHRIVER CIRCLE
 (Approx) Location Interpolated
 From 1938 Aerial Photo)

CHILLICOTHE CORRECTIONAL
 INSTITUTION (CCI)

**PREFERRED
 ALTERNATIVE "E"**

CLOSED
 ACCESS POINT

TEMPORARY R/W

PERMANENT R/W

Figure 4f