



N:\2020\100001\PROJECT\PLANES\CONCRETE-STRIPING & SIGNALIZING - JMS - 10/20/2020\100001\CONCRETE-STRIPING & SIGNALIZING.dwg - 2020 10 20 11:52:51 - 3042 - 3040

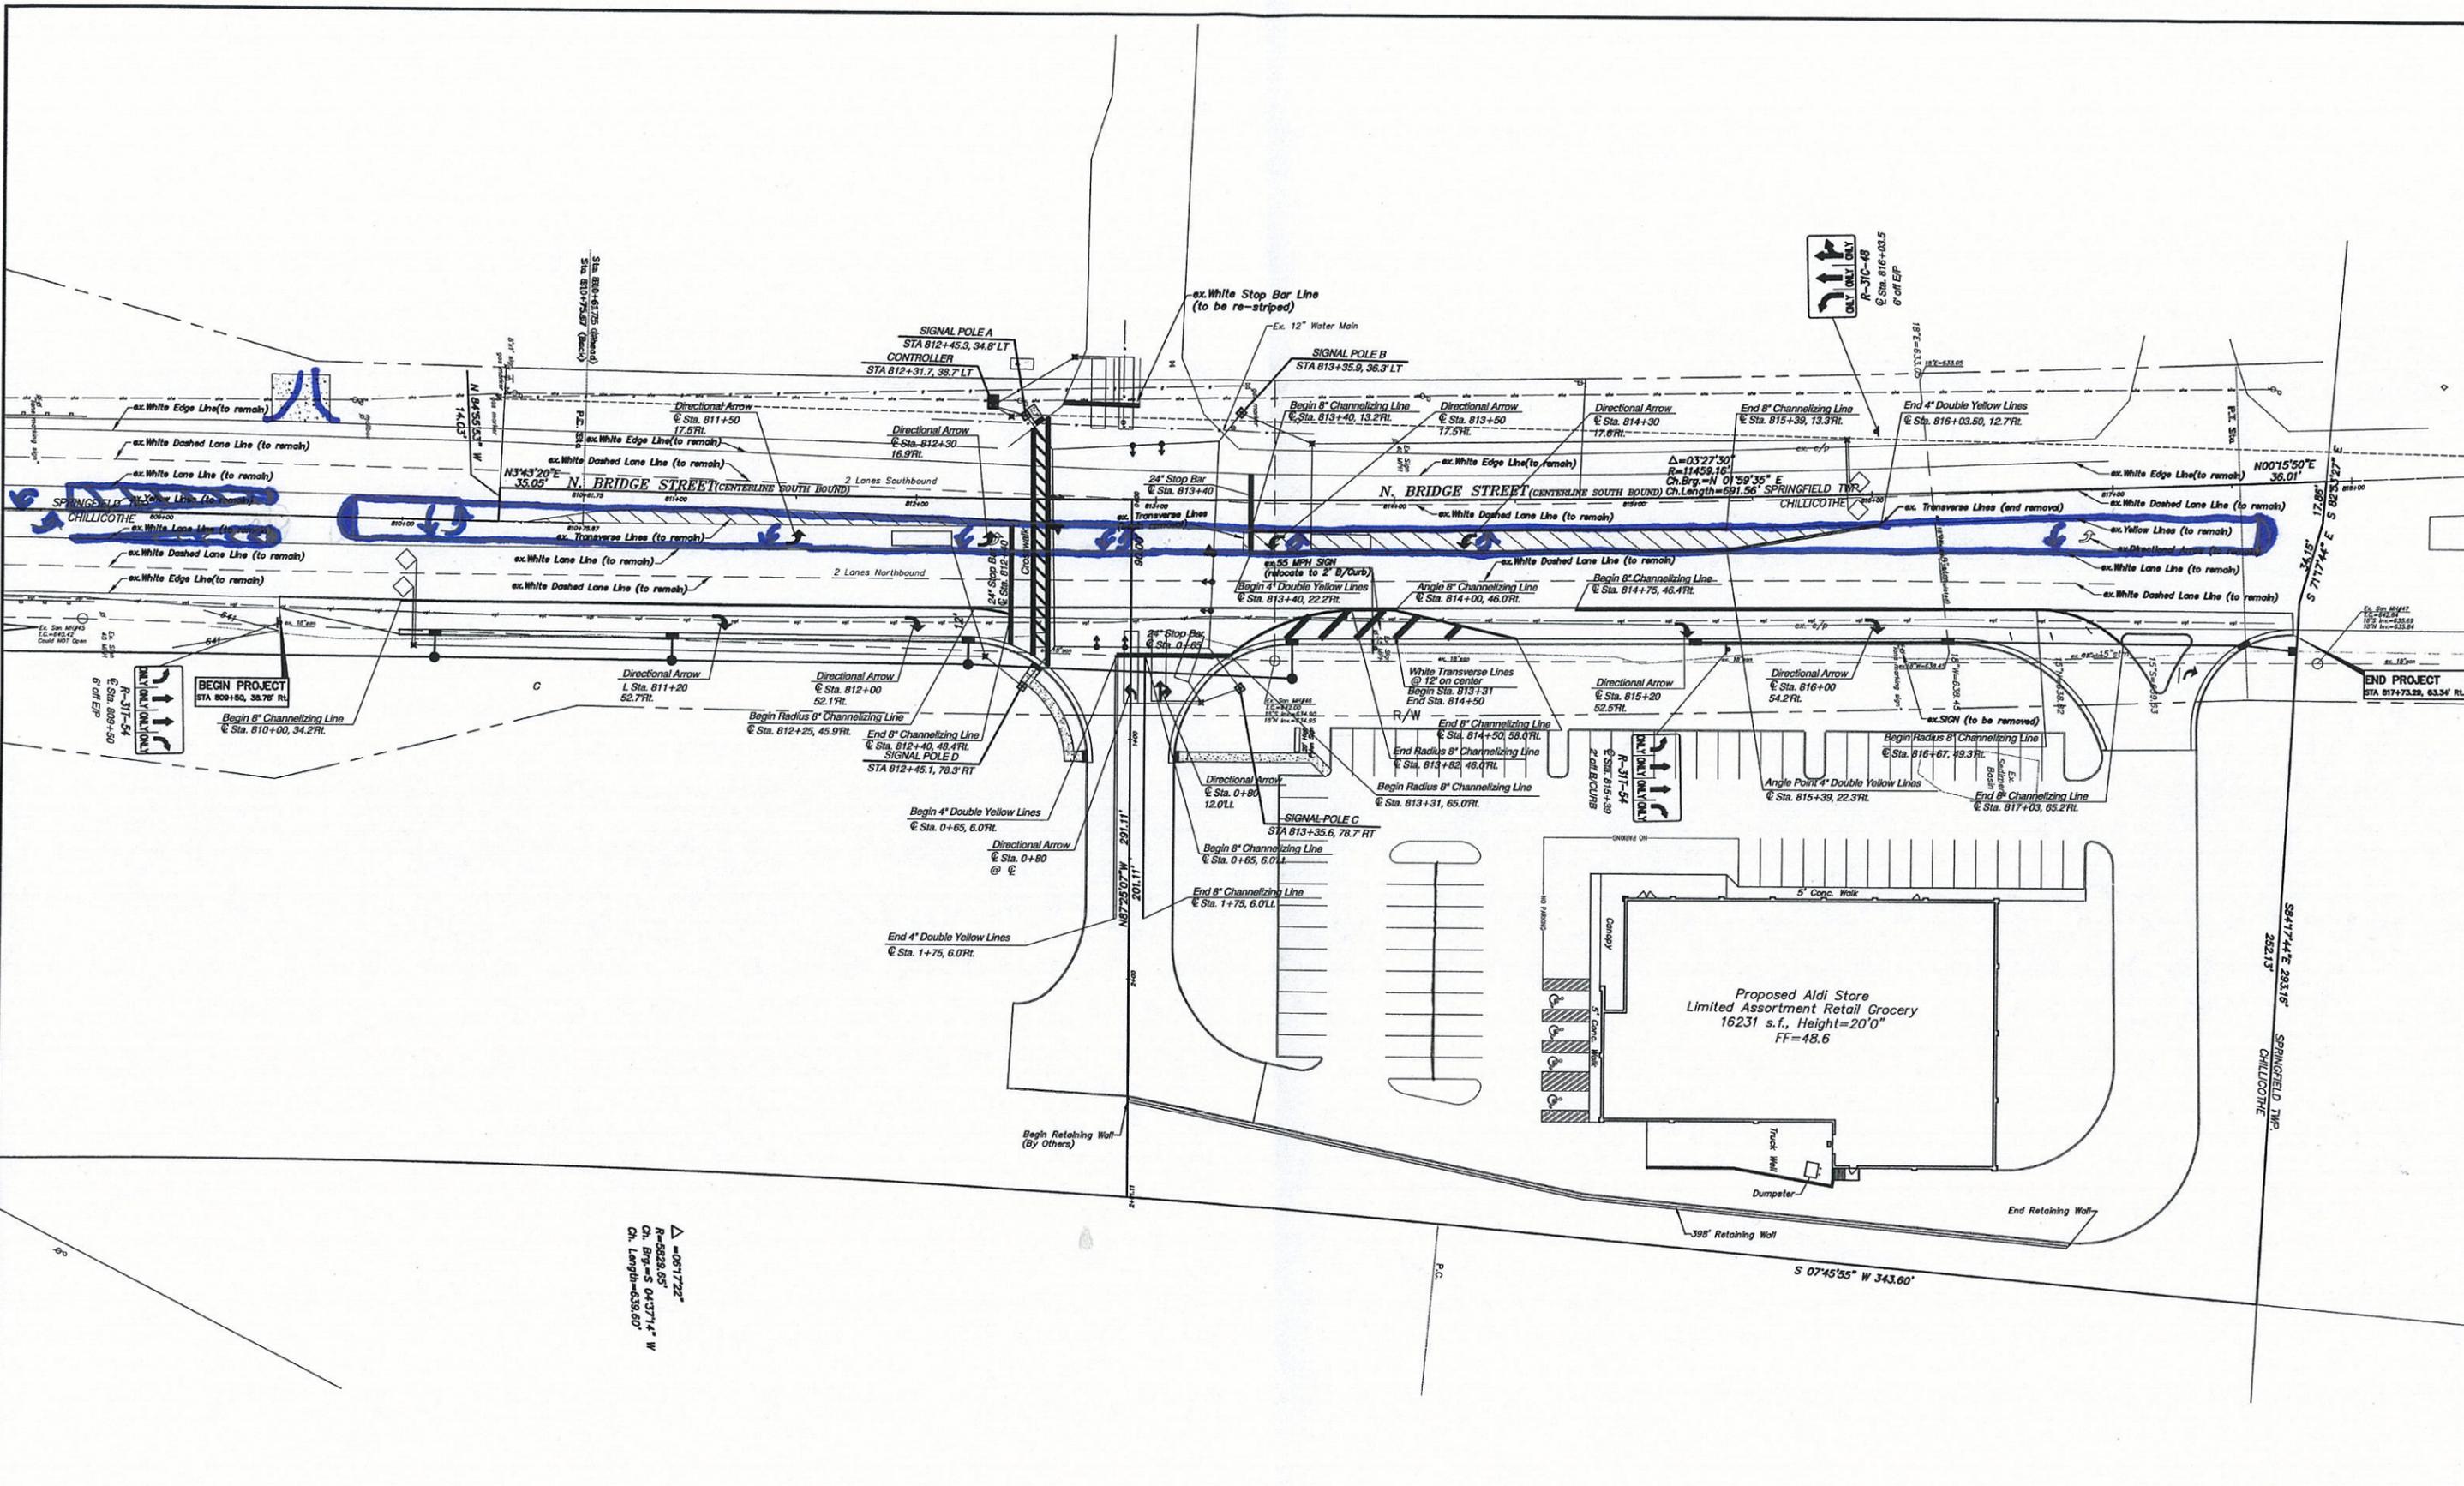

$\Delta$  0617'22"  
 R=2928.05'  
 Ch. Brg.=S 0437'14" W  
 Ch. Length=639.60'

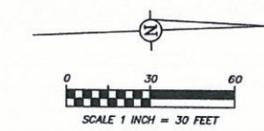

**Geo-Graphics Inc.**  
 Land Surveying & Civil Engineering  
 3331 Livingston Avenue Columbus, Ohio 43227  
 Phone: 614-231-2016 Fax: 614-231-2018


REGISTERED IN AND BEING PART OF  
 SECTION 4, TOWNSHIP 1 N, RANGE 22 N  
 CITY OF COLUMBUS & COUNTY OF FRANKLIN, OHIO COUNTY, OHIO

**NORTH BRIDGE STREET**








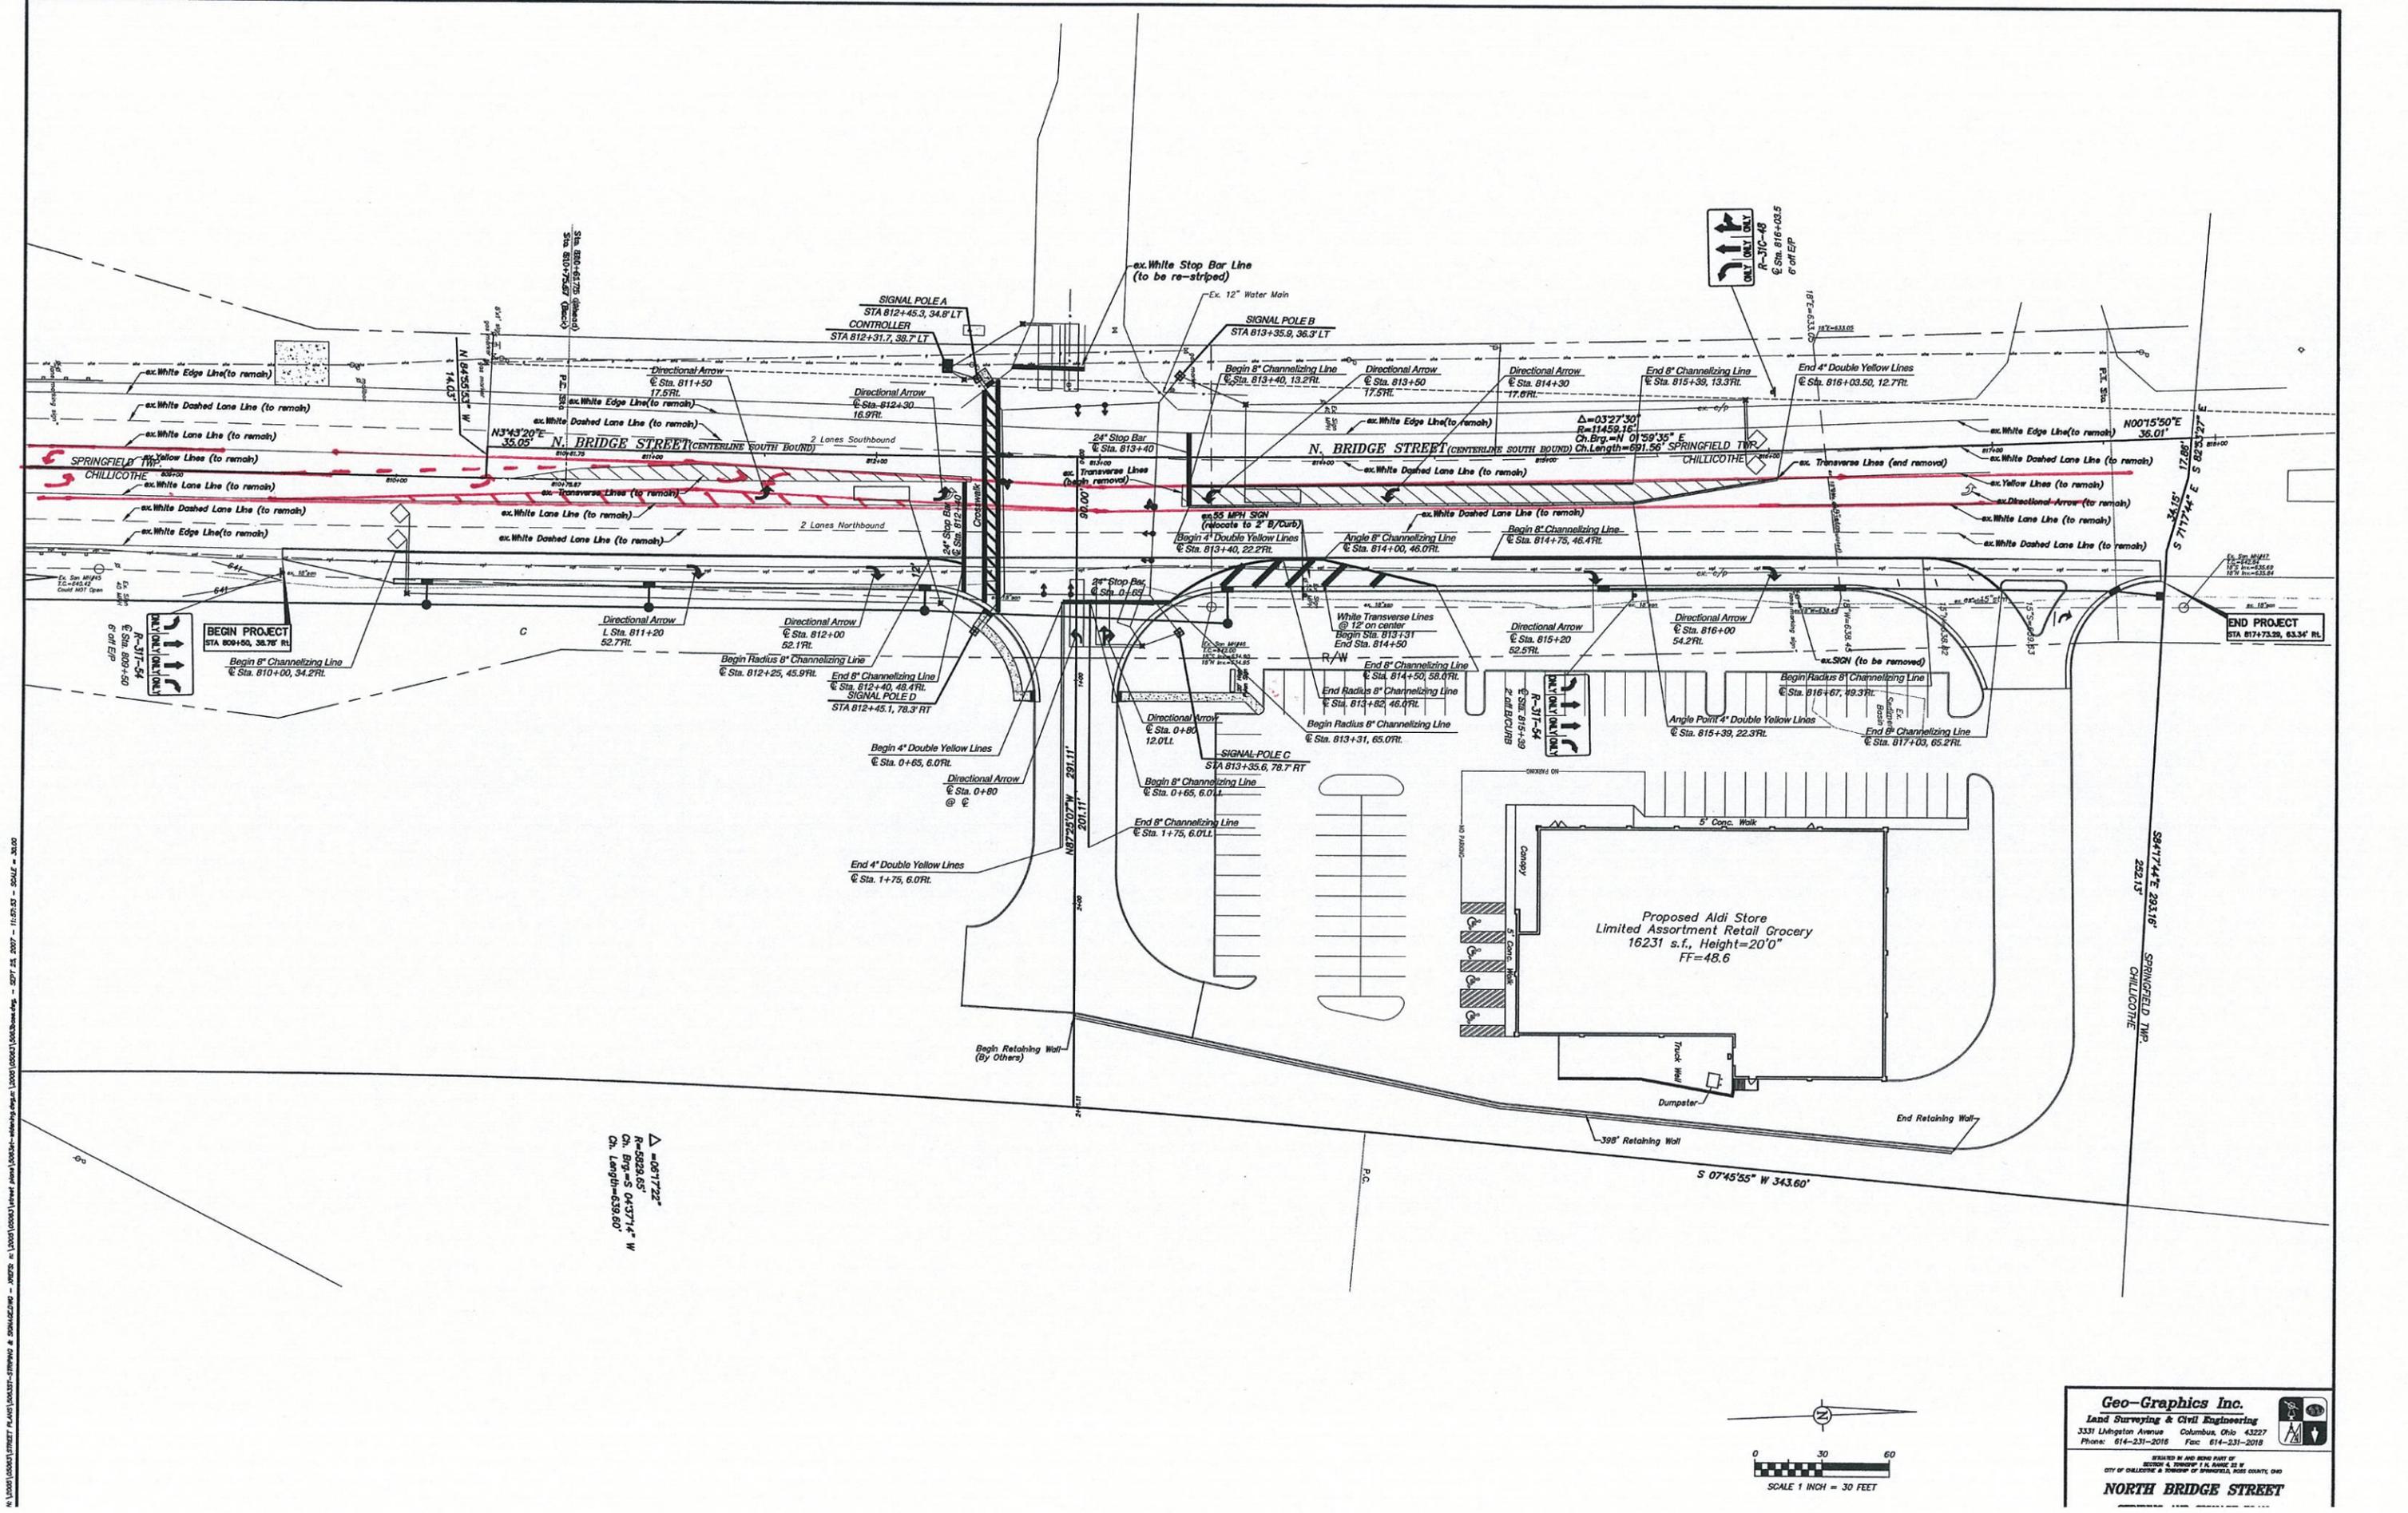

N:\L2000\100001\PROJECT\PLAN\PLAN\SSA\SSA-STRIPE\SSA-STRIPE.dwg - 09/11/2017 11:05:53 - SCALE = 30.00  
 N:\L2000\100001\PROJECT\PLAN\PLAN\SSA\SSA-STRIPE\SSA-STRIPE.dwg - 09/11/2017 11:05:53 - SCALE = 30.00

$\Delta = 0617'22"$   
 $R = 693.05'$   
 $Ch. Beg = S 0437'14" W$   
 $Ch. Length = 639.00'$

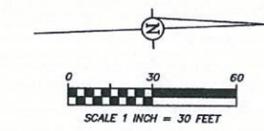

**Geo-Graphics Inc.**  
 Land Surveying & Civil Engineering  
 3331 Livingston Avenue Columbus, Ohio 43227  
 Phone: 614-231-2018 Fax: 614-231-2018

PREPARED BY AND BEING PART OF  
 SECTION 4, TOWNSHIP 1 N, RANGE 12 N  
 CITY OF COLUMBUS, A DIVISION OF FRANKLIN COUNTY, OHIO  
**NORTH BRIDGE STREET**