

STATE OF OHIO  
DEPARTMENT OF TRANSPORTATION  
REHABILITATION OF  
**MAIN AVENUE BRIDGE NO. 193 BHF-73(51)**  
CUY-2-14.66  
CITY OF CLEVELAND  
CUYAHOGA COUNTY

FHWA REGION	STATE	PROJECT	1
5	OHIO	BHF - 73 (51)	547

CUYAHOGA COUNTY  
CUY-2-14.66

DESIGNATION: 1-HH

CURRENT A.D.T.	(1989) 46,800
DESIGN YEAR A.D.T.	(2009) 67,730
D.H.V.	6800
D. (DIRECTIONAL DISTRIBUTION)	49-51
T. (PERCENT B.&C. TRUCKS)	5%
V. (DESIGN SPEED)	50 MPH
V. (POSTED SPEED)	50 MPH

MICROFILMED  
AUG 18 1993

FUNCTIONAL CLASSIFICATION	URBAN ARTERIAL
DESIGN EXCEPTIONS	APPROVAL DATE
STOPPING SIGHT DISTANCE	6-15-87
SHOULDER WIDTH	6-15-87
DESIGN SPEED	6-15-87

MICROFILMED  
JUL 20 1994

BOARD OF COMMISSIONERS, CUYAHOGA COUNTY

APPROVED: Mary O. Boyle  
DATE: 10-17-89  
APPROVED: Thomas J. Brown  
DATE: 10-17-89 COUNTY ENGINEER

CONVENTIONAL SIGNS

COUNTY LINE	LIMITED ACCESS	LA	LA
TOWNSHIP LINE	RIGHT OF WAY	RW	RW
SECTION LINE	TEMPORARY RIGHT OF WAY	T	T
CORPORATION LINE	EXISTING RIGHT OF WAY		
FENCE LINE (EXISTING)	PROPERTY LINE	P	(IN EXISTING FENCE)
CENTER LINE	RAILROAD		
TREES STUMPS (TO BE REMOVED)	GUARD RAIL (EXISTING)		(PROPOSED)
UTILITY POLES TELEPHONE	WORK LIMITS		
POWER			


INDEX OF SHEETS  
FOR INDEX SEE SHEET NUMBERS 2/547, 3/547, & 4/547

- SECTION G — GENERAL SECTION 1/547 THROUGH 98/547
- SECTION I — WEST APPROACH 99/547 THROUGH 206/547
- SECTION II — MAIN TRUSS SPANS 207/547 THROUGH 295/547
- SECTION III — EAST APPROACH - FORWARD SECTION 296/547 THROUGH 349/547
- SECTION IV — EAST APPROACH - LAKEFRONT TRESTLE 350/547 THROUGH 420/547
- SECTION V — EAST APPROACH - LAKEFRONT RAMP AND FILL SECTION 421/547 THROUGH 466/547
- SECTION VI — MAINTENANCE OF TRAFFIC 467/547 THROUGH 547/547


LINE DATA

	PROJECT	WORK
	MAIN AVENUE	
BEGIN	102+50*	95+20*
END	180+85.97	186+32*
LENGTH	7835.97 L.F.	9112 L.F.
NET LENGTH	7835.97 OR 1.484 MILES	9112 L.F. OR 1.726 MILES

\* SEE STATION EQUATIONS ON SHEET 5/547

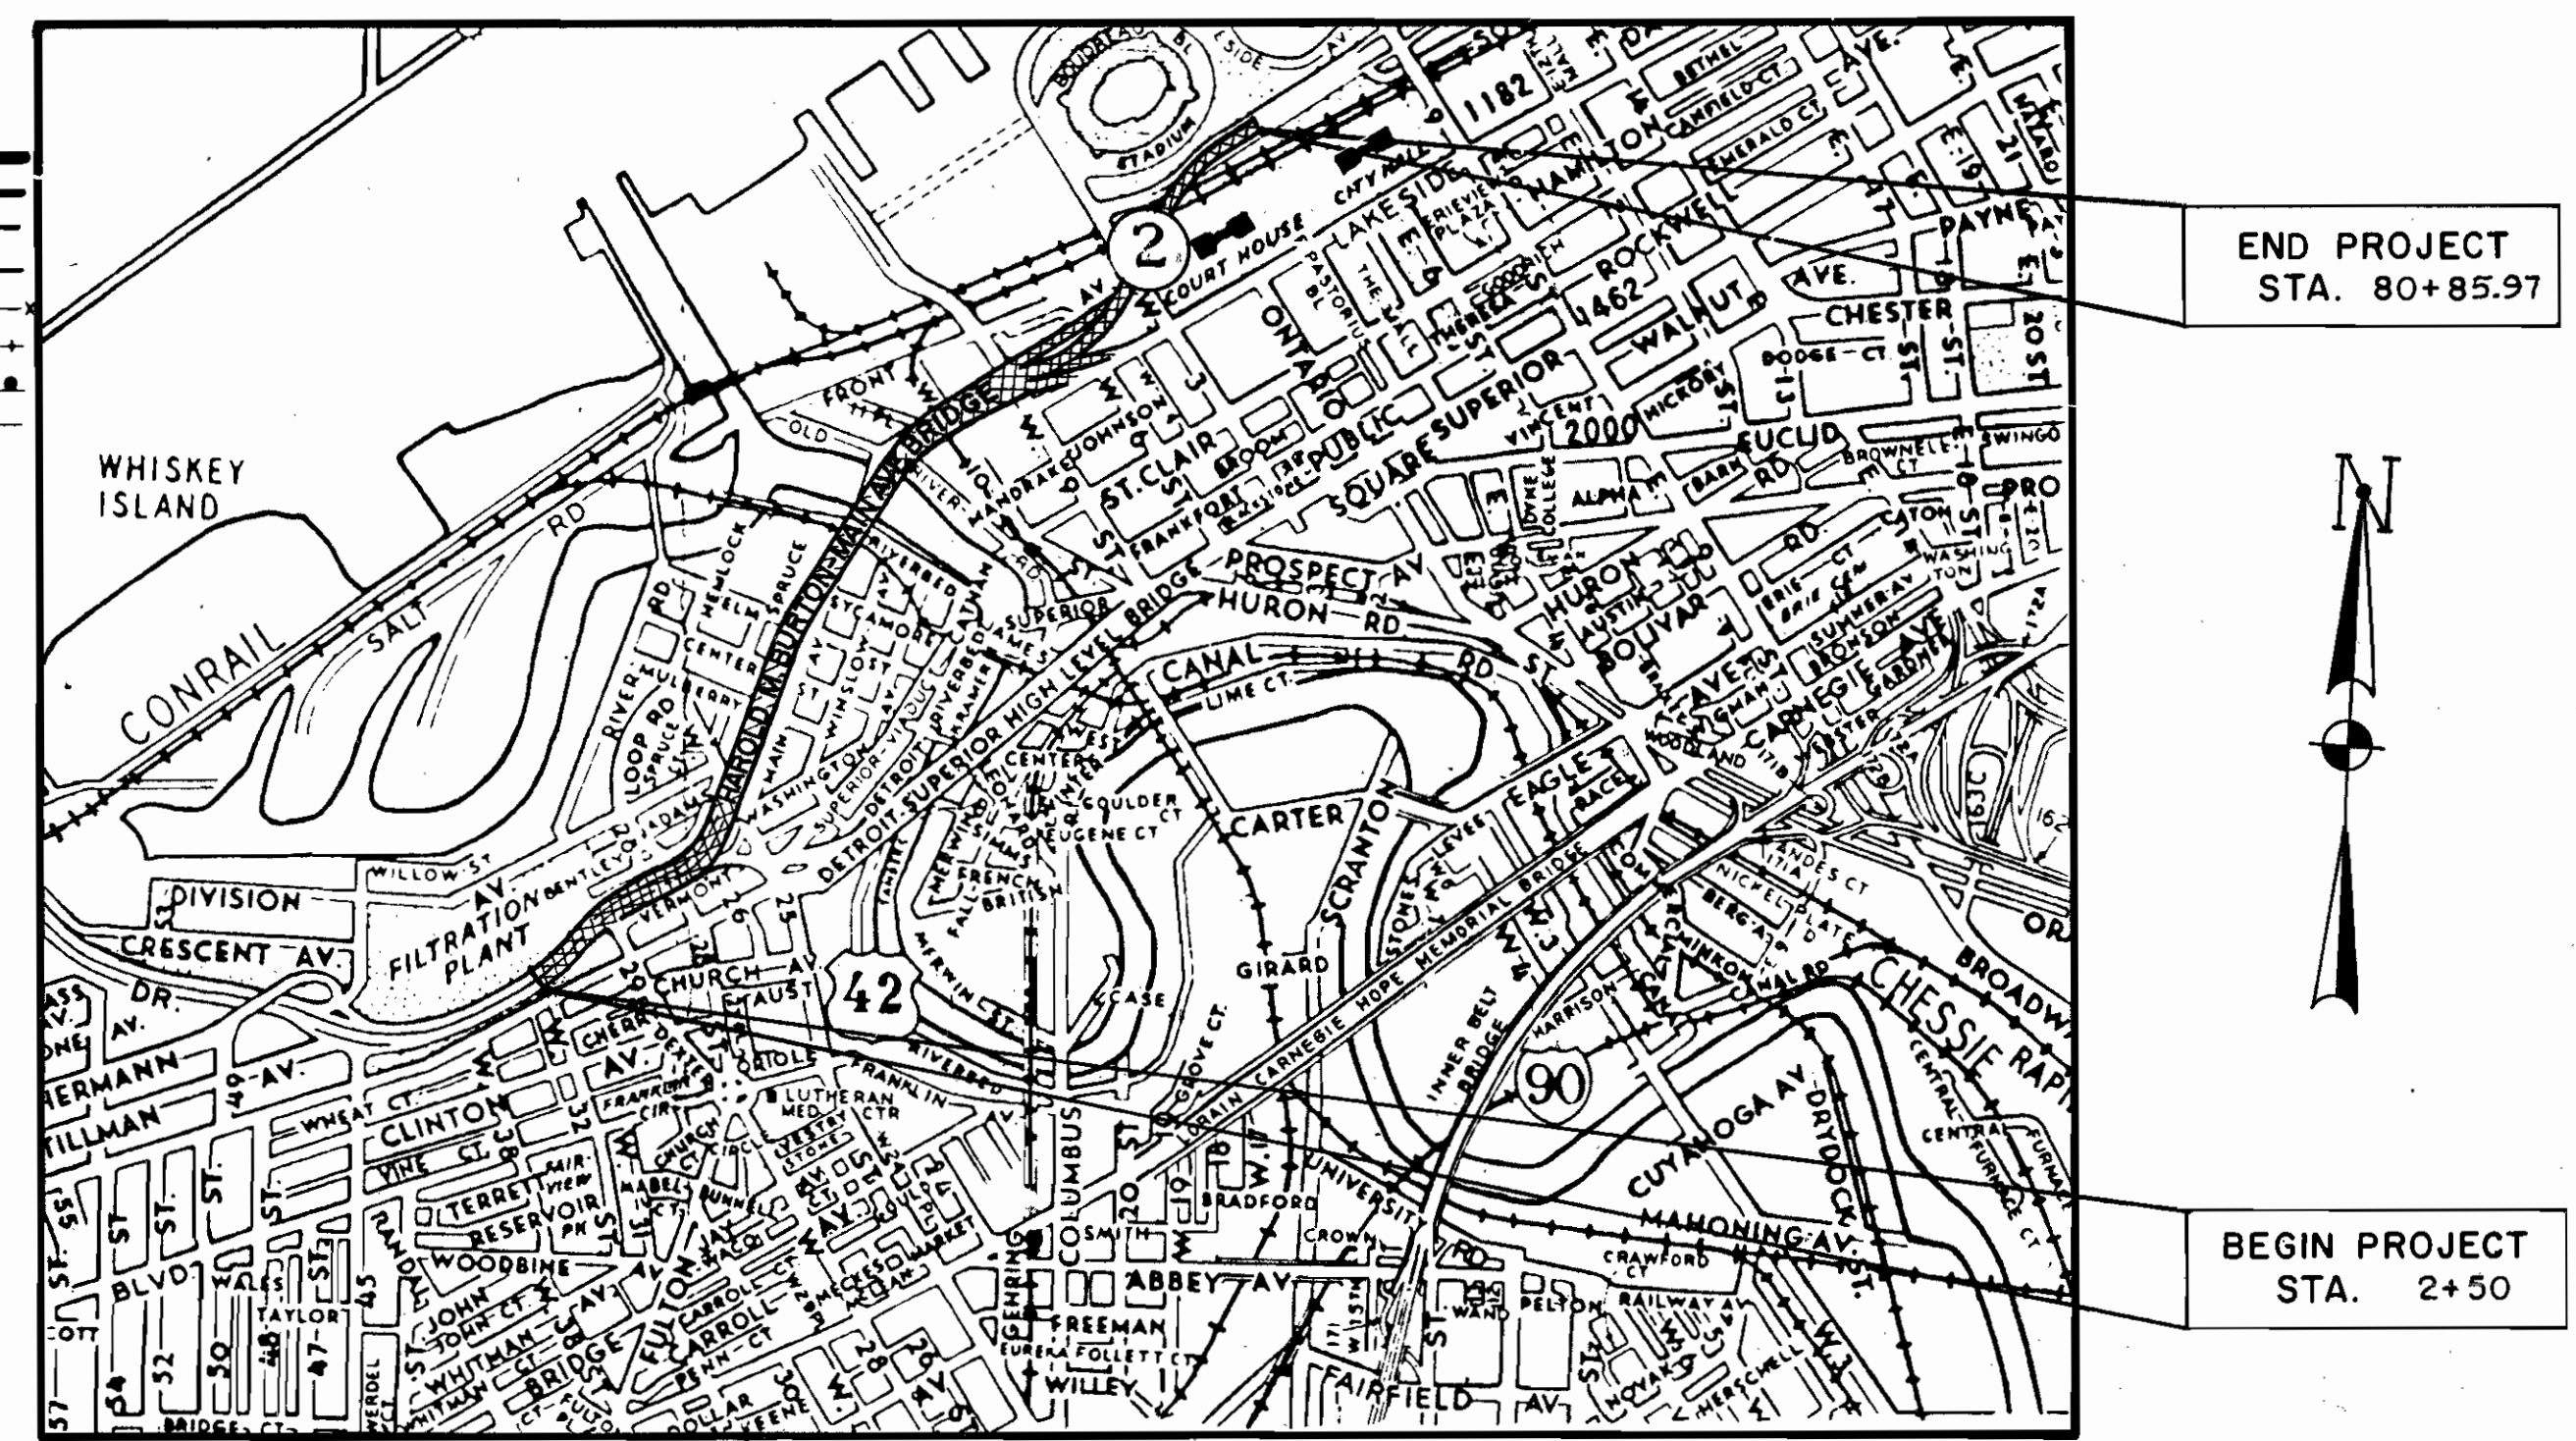

LOCATION MAP  
SCALE IN FEET

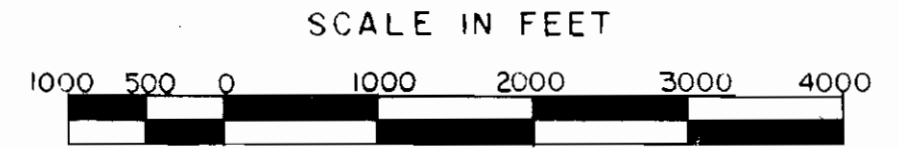


UNDERGROUND UTILITIES  
3 WORKING DAYS BEFORE YOU DIG  
Call 800-362-2764 (Toll free)

PORTION TO BE IMPROVED  
STATE HIGHWAYS  
U.S. HIGHWAYS  
INTERSTATE HIGHWAYS

PLAN  
PROFILE - HORIZONTAL  
PROFILE - VERTICAL  
CROSS SECTIONS  
RIGHT OF WAY  
OTHERS

SCALES

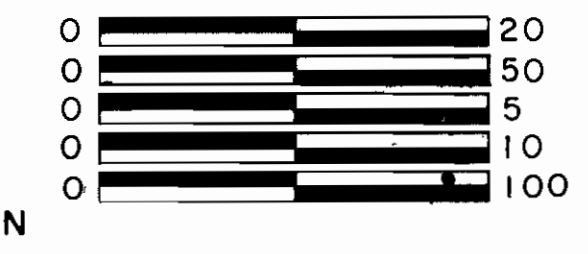

SUPPLEMENTAL SPECIFICATIONS	SPECIAL PROVISIONS
802 - 5-4-88	947 - 10-17-83
839 - 12-21-87	949 - 9-26-86
845 - 5-31-88	952 - 12-14-88
847 - 10-17-83	953 - 8-21-80
849 - 12-24-85	956 - 6-26-78
852 - 6-10-87	962 - 1-23-90
853 - 6-26-78	
862 - 12-16-88	

DATE: 2-16-90

Subsummaries and reinforcing steel tables have not been verified as built

Use of the phrase, "AS BUILT," indicates that changes in the project design made during construction have been incorporated into these pages. Not all details of the work are shown. Reference is made to the project shop drawings for details of new and rehabilitated members.

RICHLAND ENGINEERING LIMITED  
MANSFIELD, OHIO  
FEBRUARY 1994

FILE NO.	CUYAHOGA COUNTY N#
DATE OF LETTING	19
CONTRACT N#	

REVIEWED BY: David A. Smith DATE: 10-17-89  
DESIGN DEPT.  
REVIEWED BY: Steven Dalal, P.E. DATE: 10-18-89  
BRIDGE DEPT.  
APPROVED: David A. Smith  
DATE: 10/18/89 ENGINEER OF DESIGN  
APPROVED: William A. Dobish, P.E.  
DATE: 10/18/89 BRIDGE ENGINEER  
APPROVED: Thomas J. Brown  
DATE: 10/17/89 LAND DEPUTY  
APPROVED: Ronald M. G.  
DATE: 10/17/89 TRAFFIC ENGINEER


PREPARED AND RECOMMENDED BY  
PAVLO ENGINEERING CO., P.C.  
OHIO NEW YORK  
HOWARD, NEEDLES, TAMMEN & BERGENDOFF  
CONSULTING ENGINEERS OHIO

PAVLO ENGINEERING AND H.N.T.B. SHALL BE RESPONSIBLE FOR THEIR RESPECTIVE DRAWINGS

SUPPLEMENTAL PRINTS OF STANDARD CONSTRUCTION DRAWINGS

BP-2	1-11-85	HL-10.11	05-01-87	TC-7.65	03-01-79	TC-32.11	03-21-79	TC-65.11	04-05-82
BP-3	12-6-76	HL-10.12	05-01-87	TC-12.30	01-20-84	TC-41.10	08-29-84	TC-71.10	04-09-79
BP-4	10-1-87	HL-10.13	05-01-87	TC-15.15	03-01-79	TC-41.20	03-26-79	TC-72.20	02-26-82
BP-5	10-1-87	HL-20.11	05-01-87	TC-18.24	04-25-79	TC-41.40	06-18-79	TC-35.10	08-29-84
BP-10	1-30-84	HL-20.14	05-01-87	TC-21.10	01-20-84	TC-42.10	08-19-77	MT-99.10	11-14-86
MC-9	1-30-84	HL-20.15	05-01-87	TC-21.20	01-20-84	TC-42.20	03-26-79	MC-6	1-30-84
EXJ-3-82	8-1-84	HL-20.31	05-01-87	TC-21.40	03-01-79	TC-51.10	01-20-84	PSF-1-87	6-1-87
EXJ-1-81	9-1-81	HL-30.11	05-01-87	TC-22.10	03-01-79	TC-51.11	01-20-84	EXJ-2-81	4-02-84
BP-7	10-1-87	HL-50.21	05-01-87	TC-22.20	03-01-79	TC-52.10	04-03-79	EXJ-4-87	1-5-89
BP-13	5-8-87	HL-60.11	05-01-87	MC-4	7-26-76	TC-52.20	04-03-79	MH-1-87	12-18-84
GR-1	1-11-85	GR-2B	2-5-82	TC-31.21	03-06-79	TC-61.10	04-05-82	HL-30.22	5-1-87
GR-2C	2-5-82	GR-3	1-21-85	TC-32.10	03-08-79	TC-65.10	02-26-82	HL-30.31	5-1-87
GR-4	2-5-82	GR-F	2-5-82					HL-60.31	5-1-87

DEPARTMENT OF TRANSPORTATION  
FEDERAL HIGHWAY ADMINISTRATION  
APPROVED: \_\_\_\_\_  
DIVISION ADMINISTRATOR  
DATE: \_\_\_\_\_

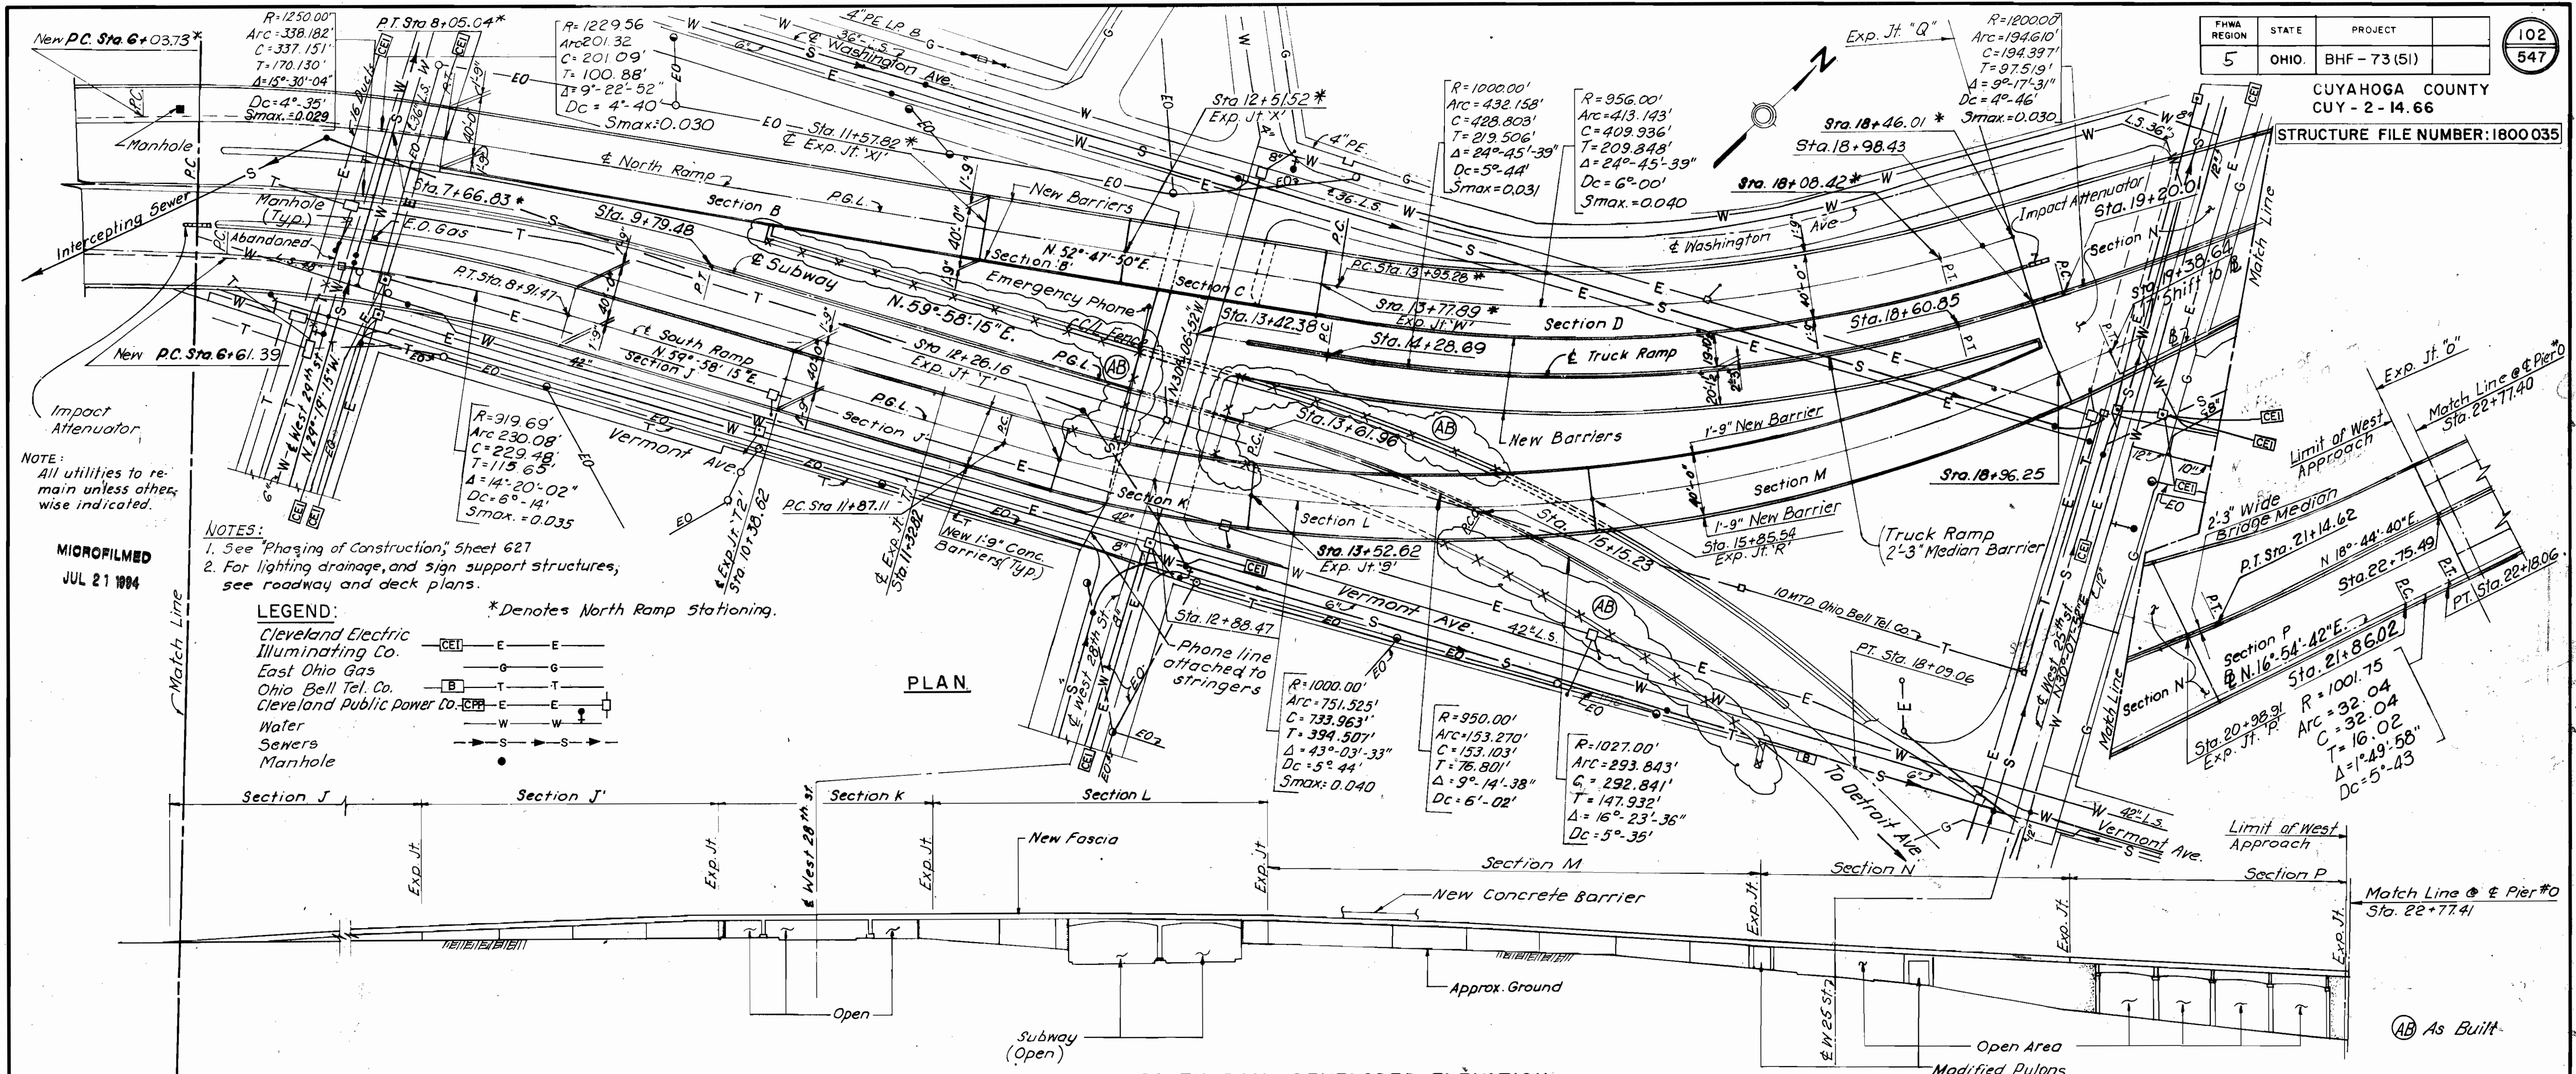

NOTE: All utilities to remain unless otherwise indicated.


MICROFILMED  
JUL 21 1984

NOTES:  
1. See "Phasing of Construction," Sheet 627  
2. For lighting, drainage, and sign support structures, see roadway and deck plans.

**LEGEND:**

Cleveland Electric Illuminating Co. — CEI — E — E  
East Ohio Gas — G — G  
Ohio Bell Tel. Co. — B — T — T  
Cleveland Public Power Co. — CPP — E — E  
Water — W — W  
Sewers — S — S  
Manhole — ●

\* Denotes North Ramp Stationing.

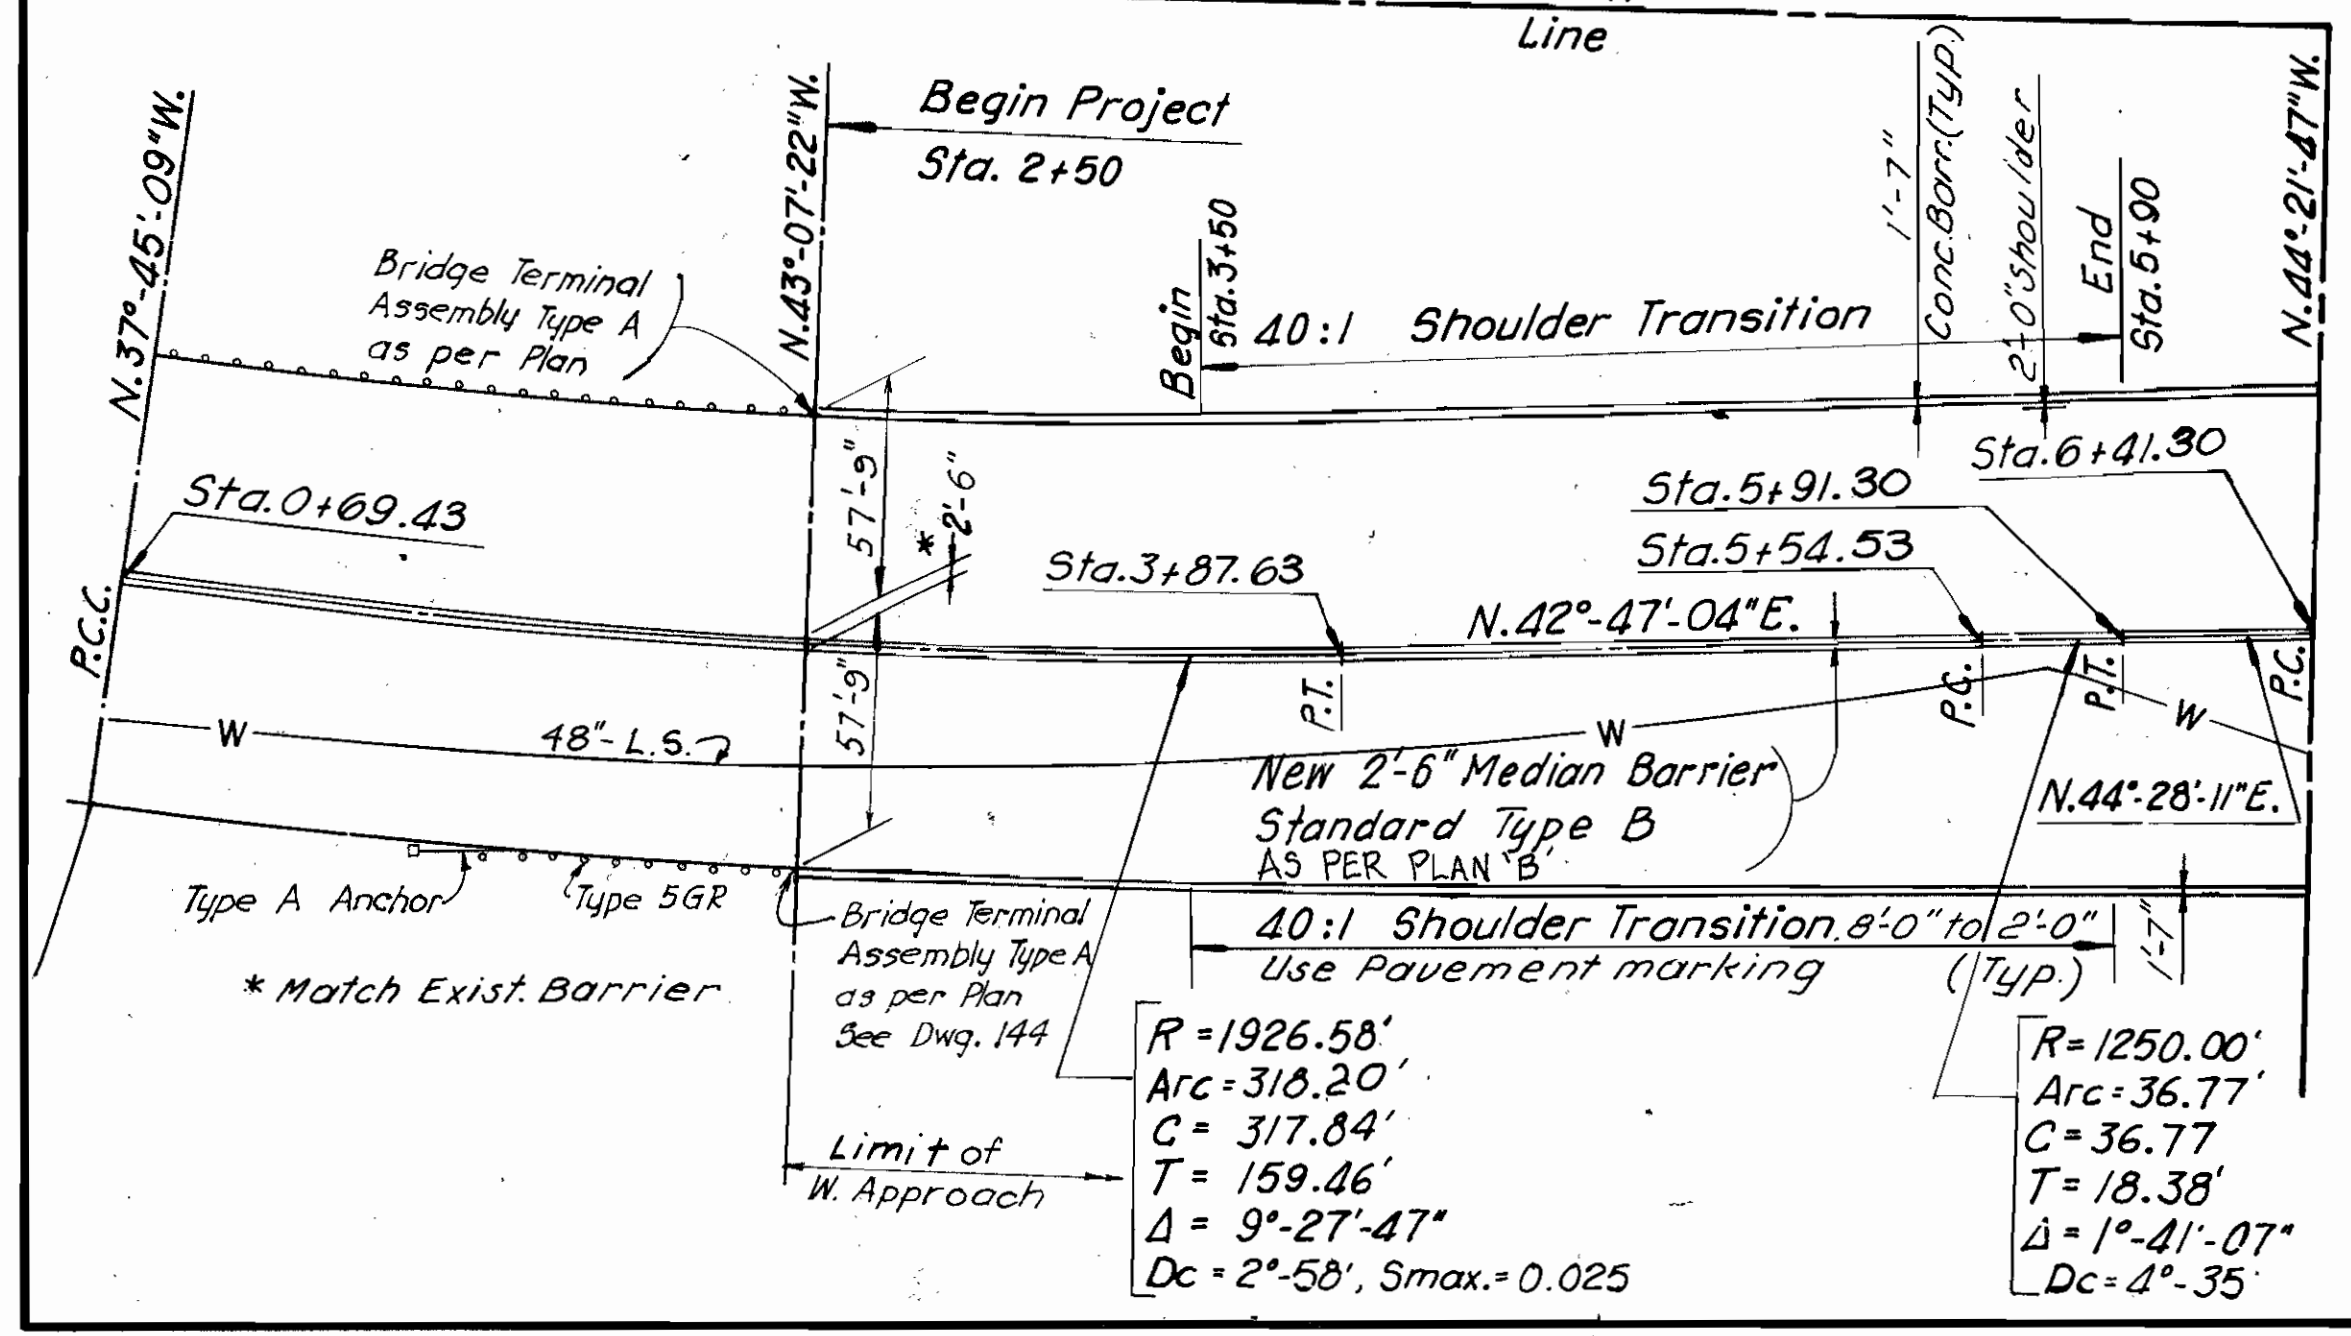

**SOUTH RAMP DEVELOPED ELEVATION**



THE SECTION CONSISTS OF THE FOLLOWING:

- TWO 1400 FOOT LONG, THREE LANE RAMPS (NORTH AND SOUTH), PART CONCRETE PAVEMENT ON GRADE, AND PART ELEVATED STRUCTURE OF CONCRETE AND STEEL FRAMING; INCLUDING SECTION N, 225 FEET LONG, A SIX LANE DIVIDED STRUCTURE WITH STEEL FRAMING, ADJOINING SECTION P, 177 FEET LONG, A SIX LANE DIVIDED STRUCTURE WITH CONCRETE FRAMING.
- A 400 FOOT LONG, EIGHT LANE, DIVIDED, EXISTING PAVEMENT ON GRADE (WEST SHOREWAY), WEST OF RAMPS.
- TWO 400 FOOT LONG, FOUR LANE, DIVIDED, GRADE SUPPORTED CONCRETE OR ASPHALT PAVEMENTS, PROVIDING EXIT AND ENTRANCE TO THE HIGHWAY (SUBWAY AND TRUCK RAMPS).

**WORK TO BE DONE:**

- REMOVAL OF THE ENTIRE DECK (I-BEAM-LOK AND CONCRETE), THE RAILINGS, DRAINAGE, FASCIA PLATES, STRINGERS, ETC.
- INSTALLATION OF NEW STEEL STRINGERS ON THE STRUCTURE.
- REINFORCEMENT AND REPAIR OF REMAINING CONCRETE AND STEEL MEMBERS.
- CONSTRUCTION OF A NEW LIGHTWEIGHT CONCRETE DECK SLAB.
- CONSTRUCTION OF A NEW 10" CONCRETE PAVEMENT ON THE WEST SHOREWAY.

- REPLACEMENT OF PAVEMENT AT SUBWAY RAMP.
- CONSTRUCTION OF NEW 9" CONCRETE PAVEMENT AND 1 1/4" WEARING SURFACE ON TRUCK RAMP.
- ALTERATION OF EXISTING RETAINING WALLS TO PROVIDE FOR ROAD WIDENING AND FOR NEW BARRIERS.
- ALTERATION OF FOUR STONE PYLONS AT 25TH STREET.
- INSTALLATION OF NEW DRAINAGE SYSTEM.
- INSTALLATION OF NEW LIGHTING AND TRAFFIC CONTROL SYSTEMS.
- FIELD COATING OF SOME EXISTING STRUCTURAL STEEL, AND PAINTING OF NEW STRUCTURAL STEEL.
- COATING OF THE EXPOSED EXISTING AND NEW CONCRETE SURFACES

The Contractor shall make provisions to protect all areas under the Bridge used by Pedestrians or vehicles from falling debris during removal of the existing superstructure and during erection.

**REFERENCES:**

General Notes	DWG. No. 66-623
Typical Cross Sections	106-116
Developed North Ramp Elevation	105
Alignment	G35-G37

PAVLO ENGINEERING CO., P.C.  
NEW YORK, NEW YORK

**CUYAHOGA COUNTY ENGINEER**  
CLEVELAND OHIO


**MAIN AVENUE BRIDGE**  
CITY OF CLEVELAND  
BRIDGE OVER THE CUYAHOGA RIVER VALLEY

**WEST APPROACH  
PROPOSED PLAN & ELEVATION - I**

BRIDGE NO. 193 REPORT NO. 7119 DATE Nov. 11, 1989

**NO. B-136** 104 991

DESIGN S.H.	DRAWN C.P.J.	CHECKED C.K.D.	REVISED TO AS BUILT AS BUILT 2/94
----------------	-----------------	-------------------	--------------------------------------

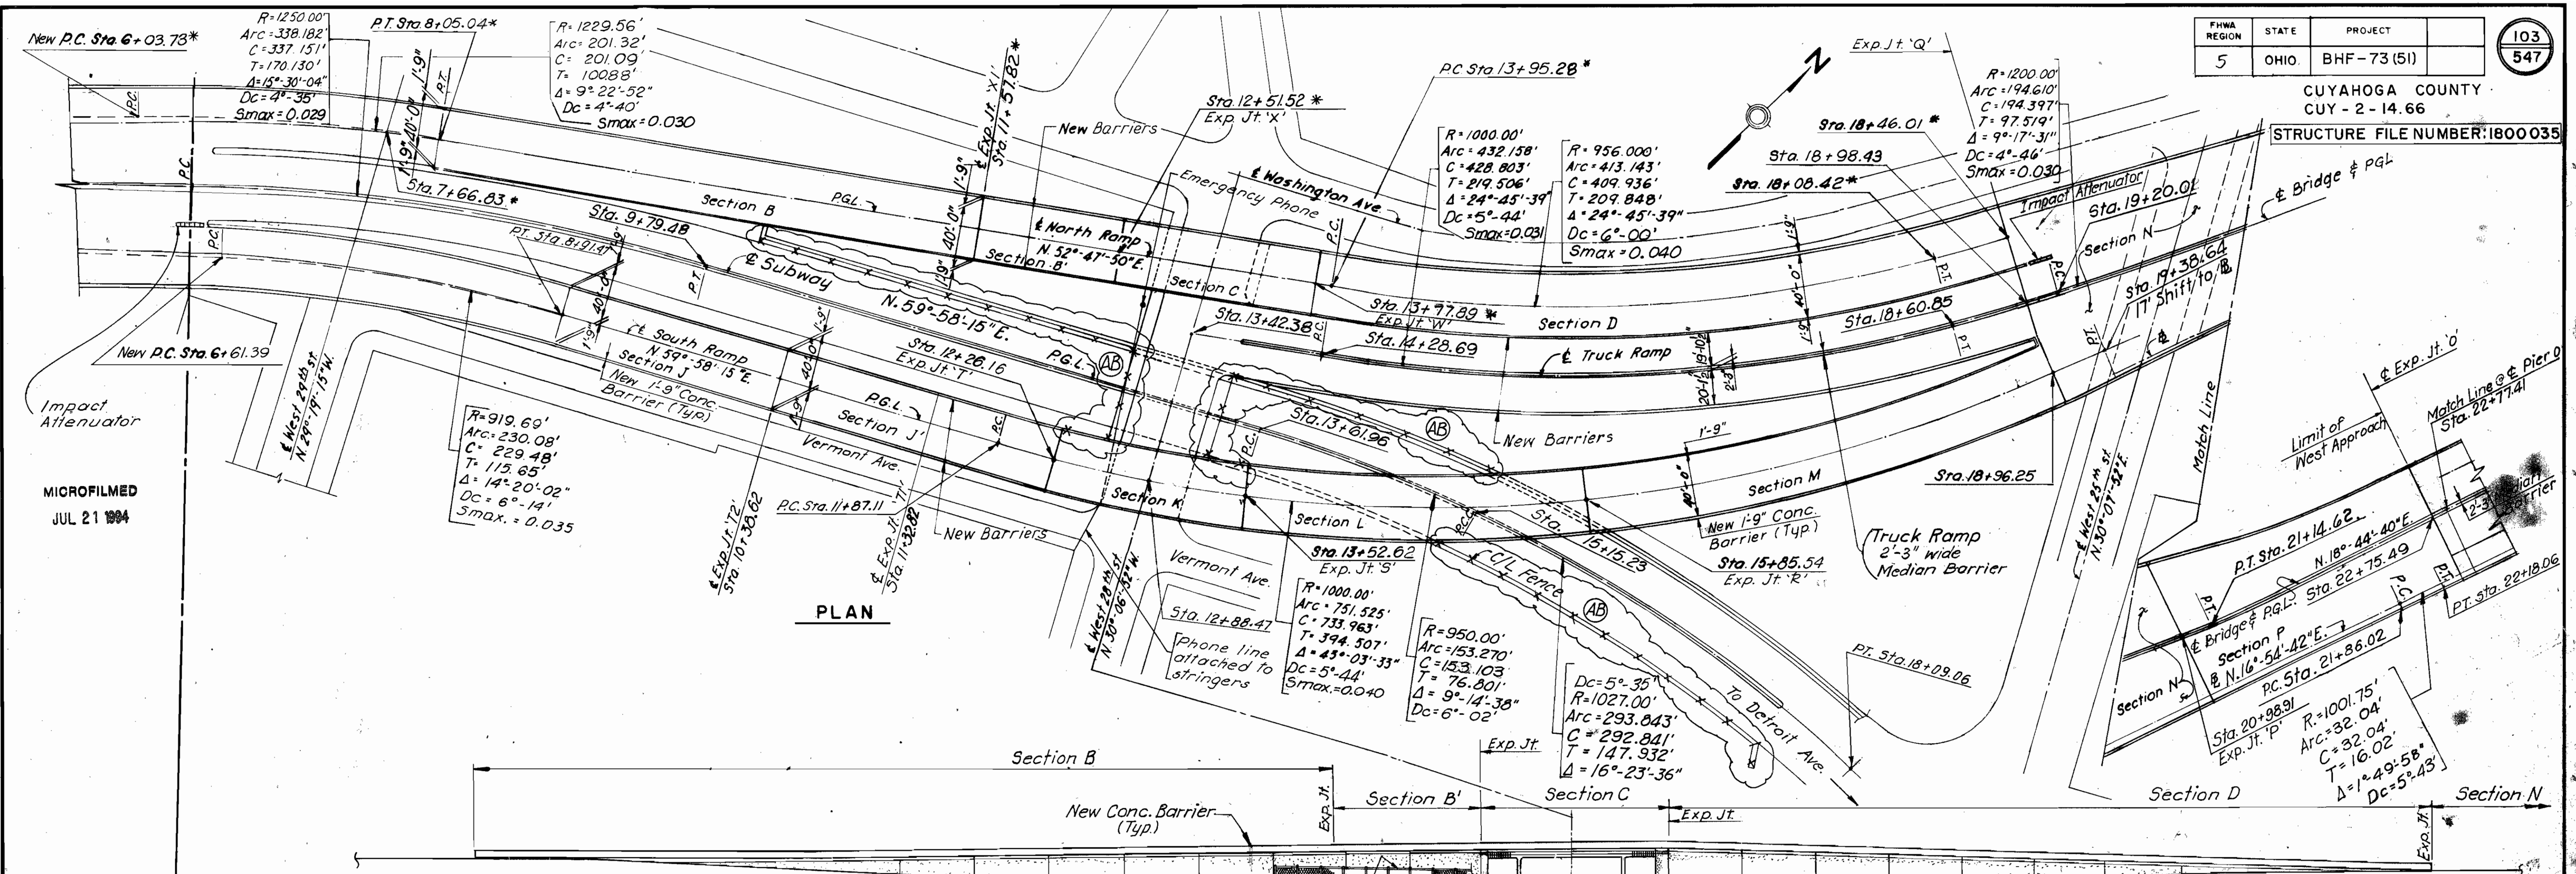

MICROFILMED  
JUL 21 1984

**NOTES:**  
For Existing Utilities see Dwg. 104 & 142.  
See "Staging of Construction", Dwg. 627



**C.V.N. NOTE**  
Structural steel for new or repaired Main Load Carrying members subjected to tension or stress reversal, shall meet the "Longitudinal Charpy V-notch" requirements of 15 Ft-Lb @ 40°F. Main load carrying members for this section are limited to: Stringers, Floor beam, Flanges & Web, Bracket Top Flange and Web & Tie Plates.


See also "GENERAL NOTES" Item 5/3

(AB) As Built

REFERENCE	DWG. NO.
General Notes	66-623
Typical Cross-Sections	106-416
Developed South Ramp Elevation	104
Subway Ramp	620

Note 1: \* Denotes North Ramp Stationing.

The Contractor shall make provisions to protect all areas under the Bridge used by Pedestrians or vehicles from falling debris during removal of the existing superstructure and during erection.

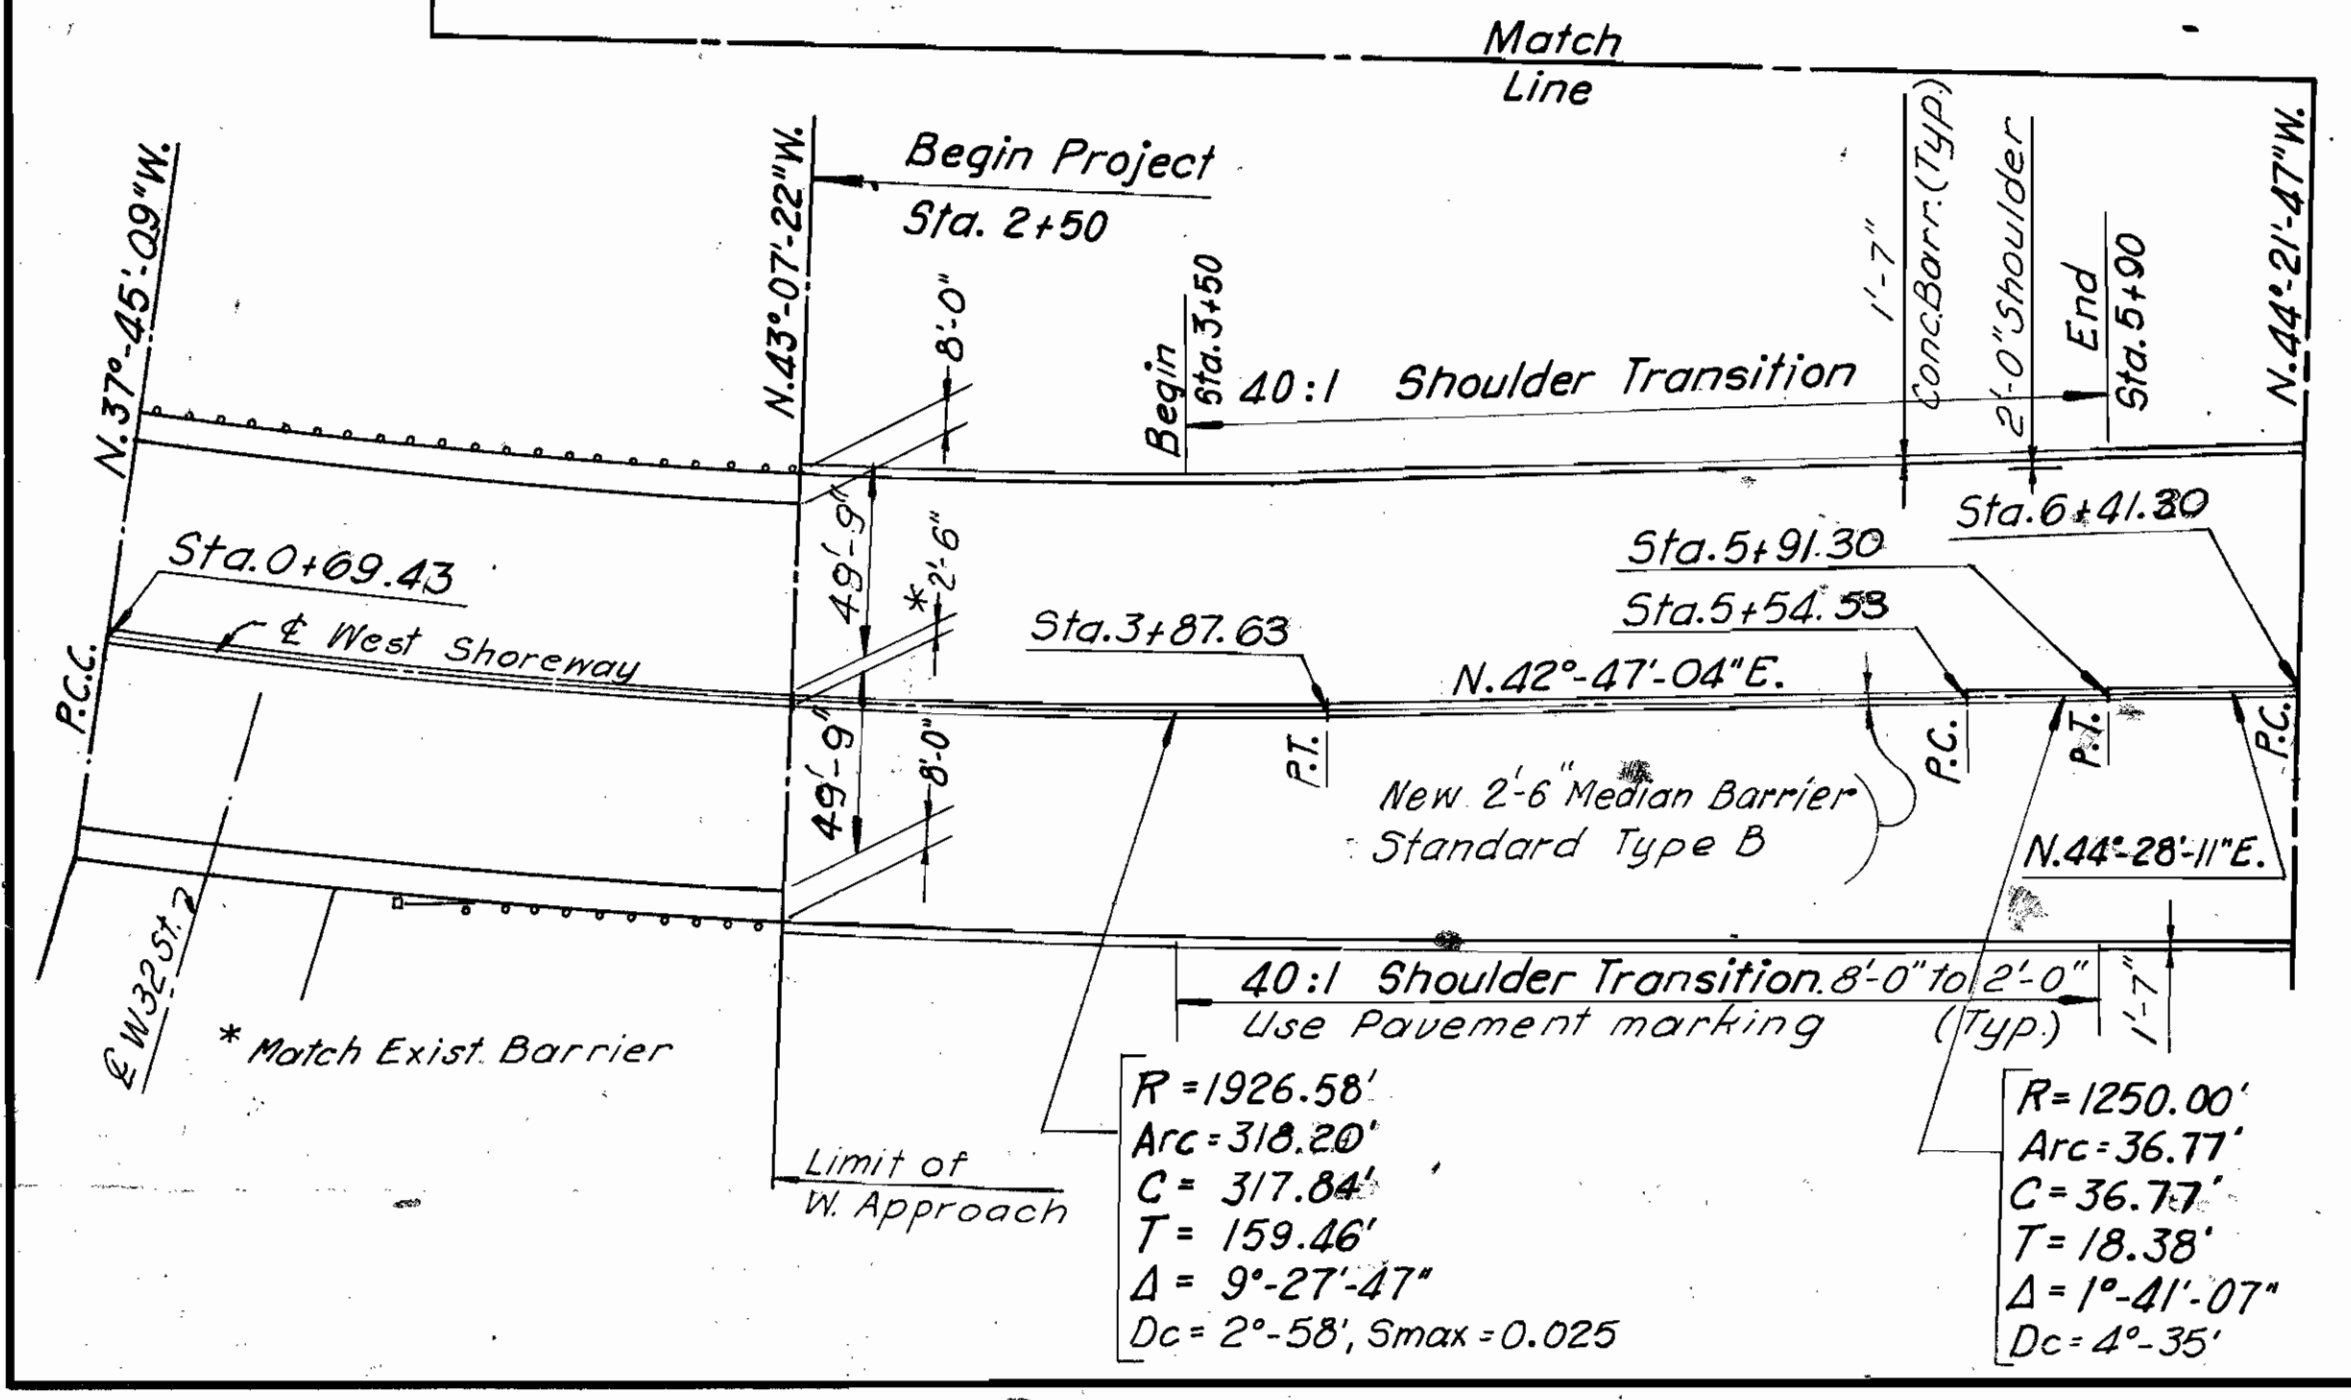


PAVLO ENGINEERING CO., P.C. NEW YORK, NEW YORK	
CUYAHOGA COUNTY ENGINEER CLEVELAND OHIO	
<b>MAIN AVENUE BRIDGE</b> CITY OF CLEVELAND BRIDGE OVER THE CUYAHOGA RIVER VALLEY	
WEST APPROACH <b>PROPOSED PLAN &amp; ELEVATION-II</b>	
BRIDGE NO. 193	REPORT NO. 7119 DATE Nov. 11, 1982
<b>NO. B-136</b>	105 991
DESIGN S.H.	DRAWN C.P.J.
CHECKED C.K.D.	REVISED TO AS BUILT AS BUILT 2/94

MICROFILMED  
JUL 21 1994


FHWA REGION	STATE	PROJECT
5	OHIO	BHF -73(51)

109  
547


CUYAHOGA COUNTY  
CUY - 2 - 14.66

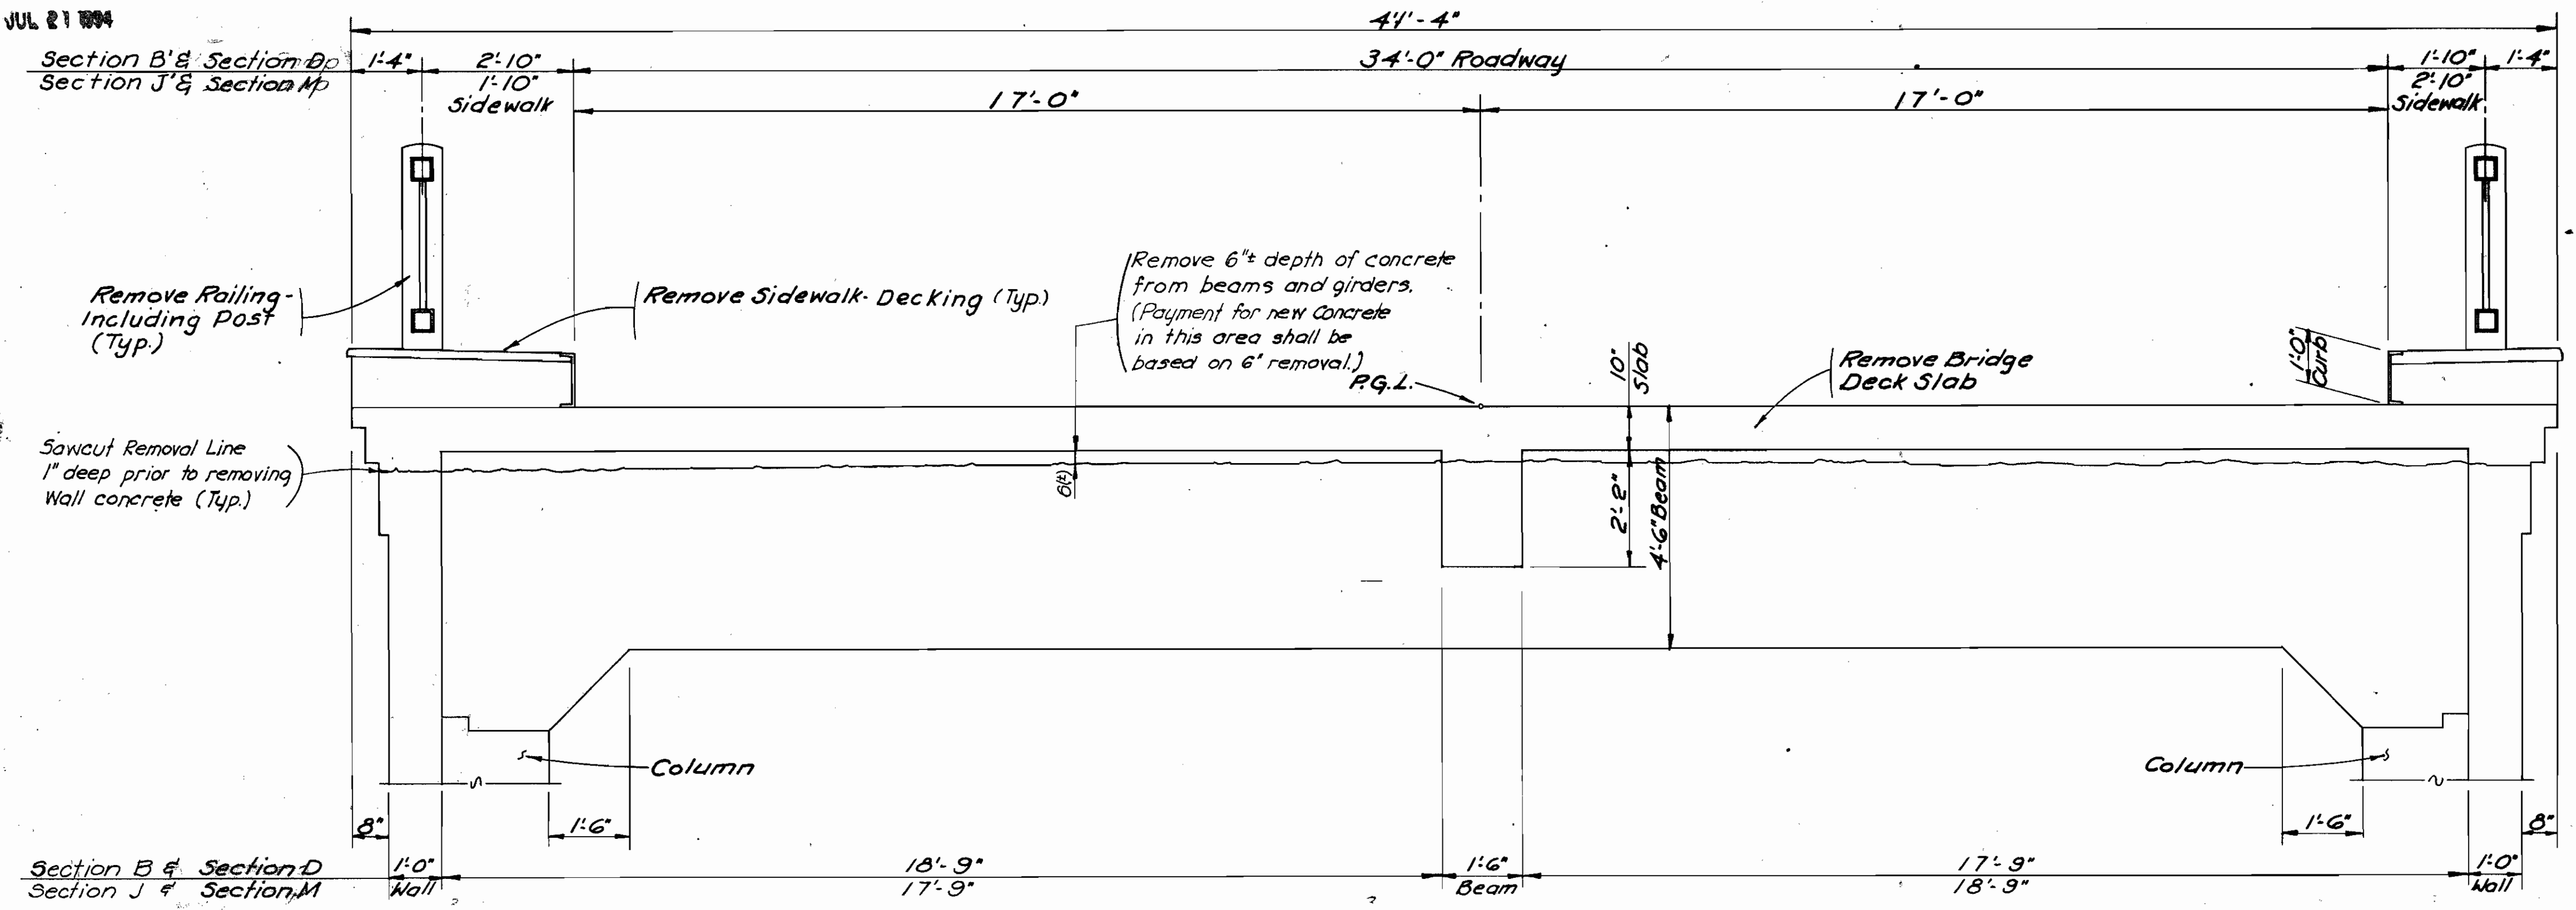

EXISTING CROSS SECTION (Looking East)

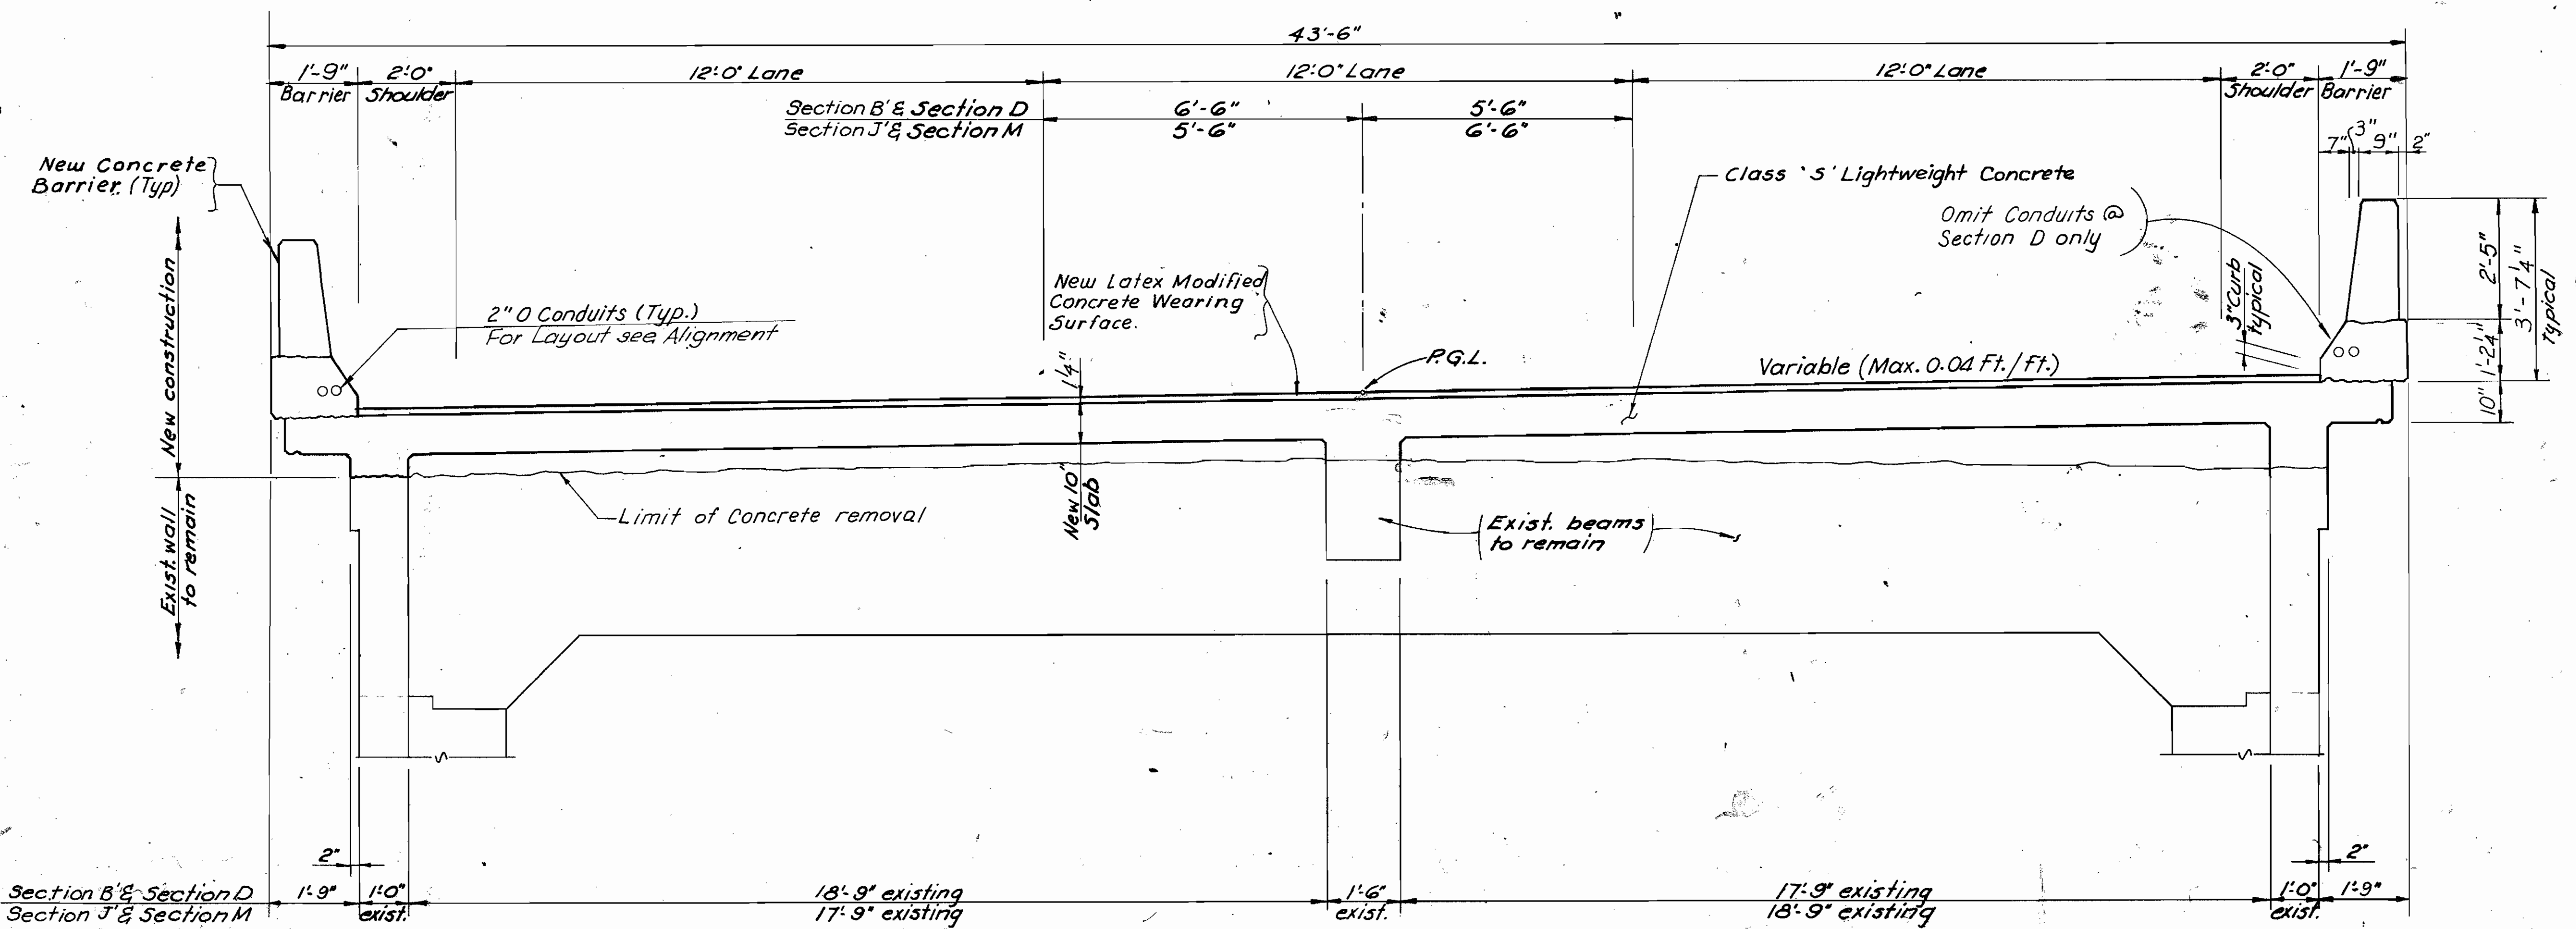



PROPOSED CROSS SECTION (Looking East)

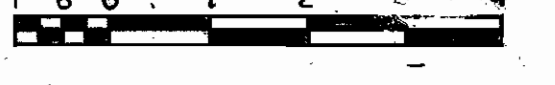


REFERENCES:  
Existing Plan & Elevation  
Proposed Plan & Elevation  
Bridge Lighting Plan  
Alignment

DWG. NO.  
101 & 102  
104 & 105  
664  
G36

PAVLO ENGINEERING CO., P.C. NEW YORK, NEW YORK			
CUYAHOGA COUNTY ENGINEER CLEVELAND OHIO			
<b>MAIN AVENUE BRIDGE</b> CITY OF CLEVELAND BRIDGE OVER THE CUYAHOGA RIVER VALLEY			
WEST APPROACH - SECTIONS B, D, J & M <b>TYPICAL CROSS SECTIONS</b>			
BRIDGE NO. 193	REPORT NO. 7119	DATE Nov 11, 1988	
<b>NO. B-136</b>			991
DESIGN AS	DRAWN TC/RS	CHECKED CK/D	REVISED TO AS BUILT AS BUILT 27/91

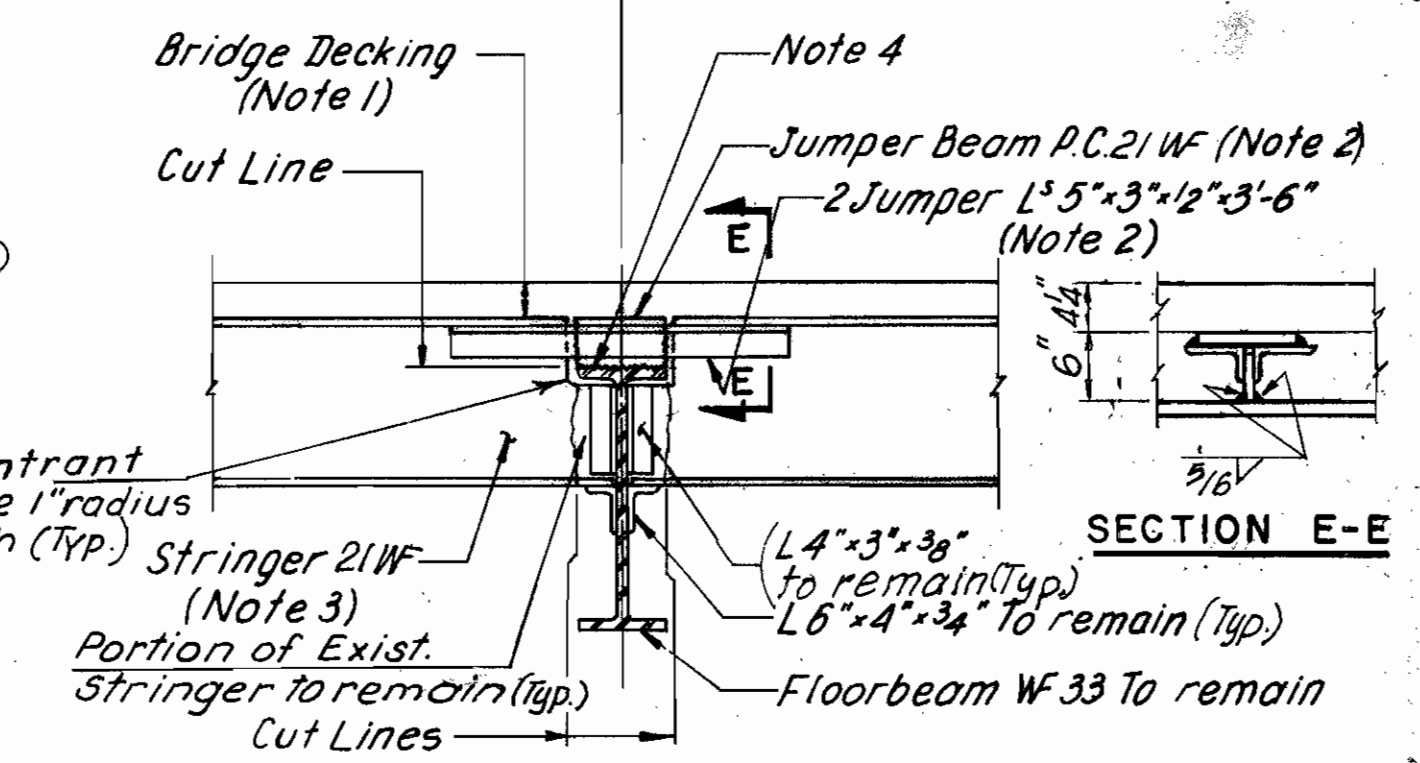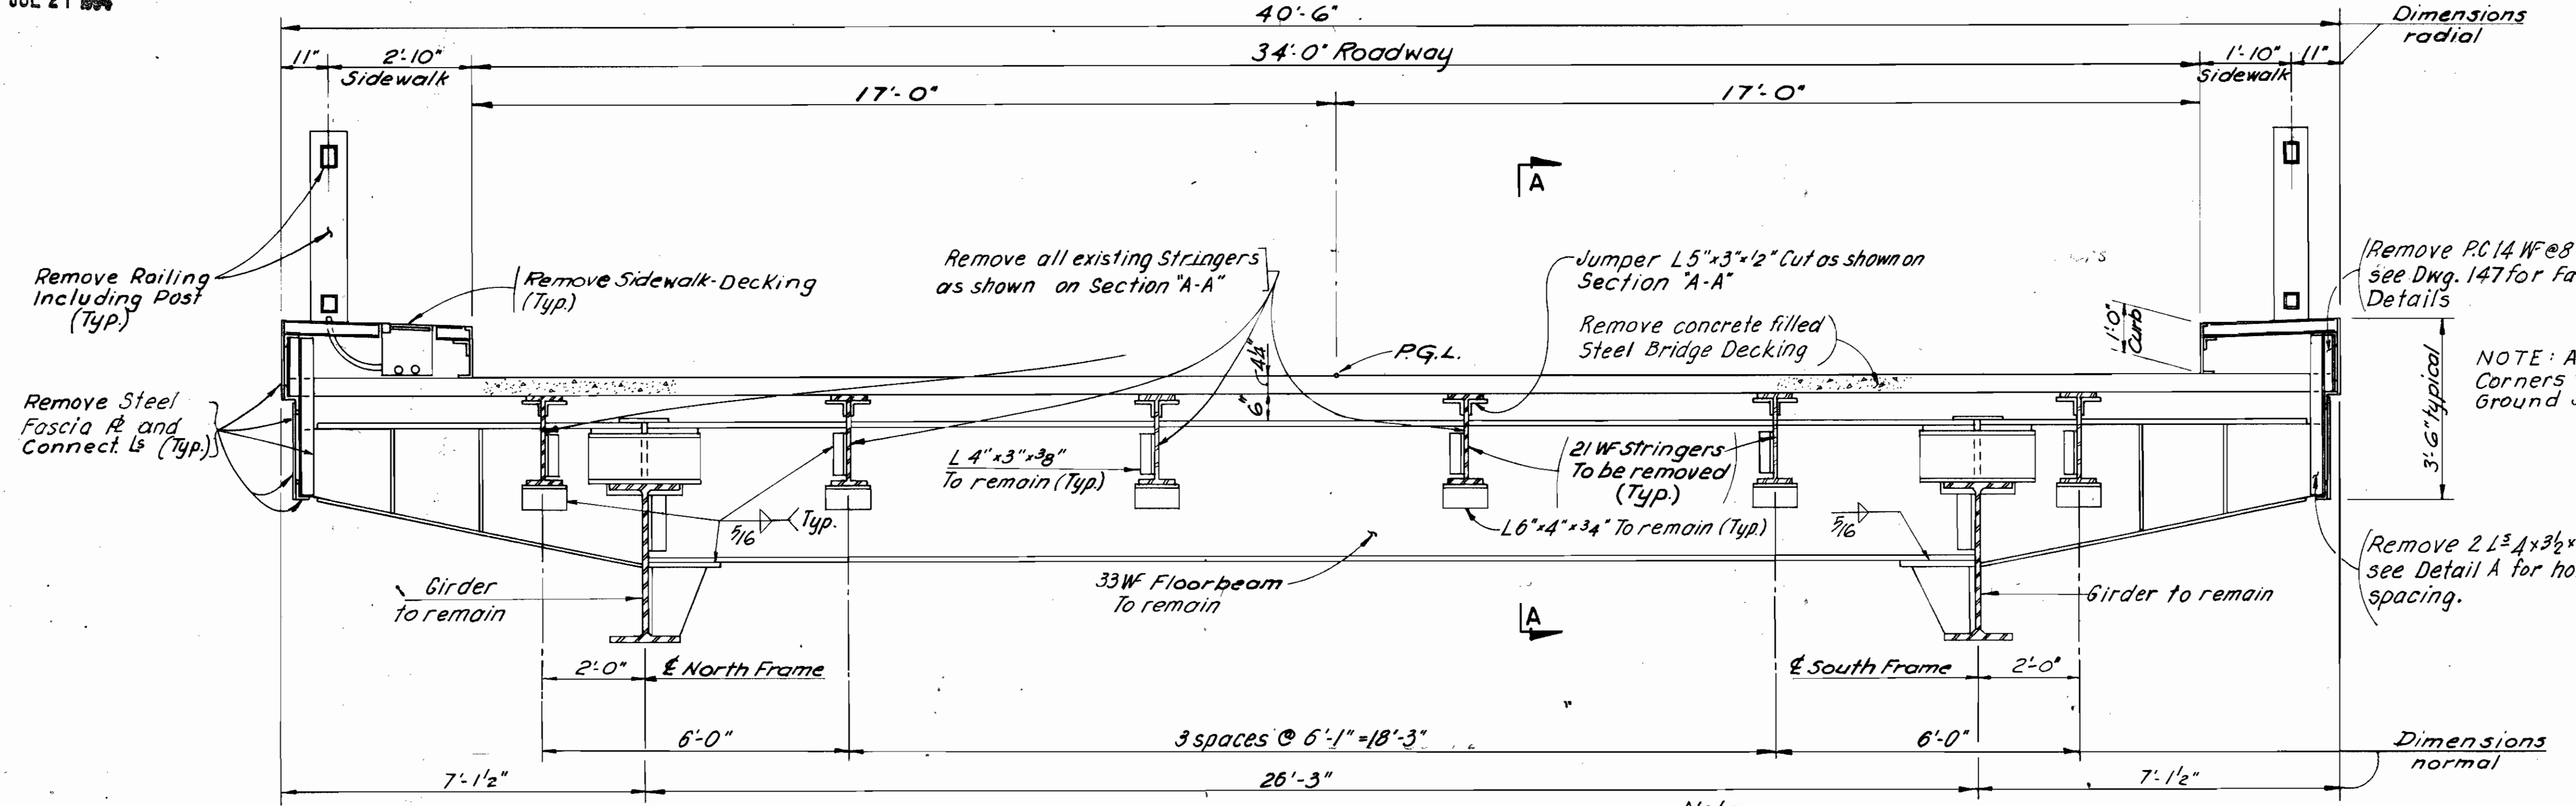

- Notes:**
1. Remove Bridge Decking.
  2. Remove Jumper Beam and Angles.
  3. Remove existing Stringers
  4. Grind smooth top flange of Floorbeam, in direction of Stress, taking care not to gouge or undercut flange.

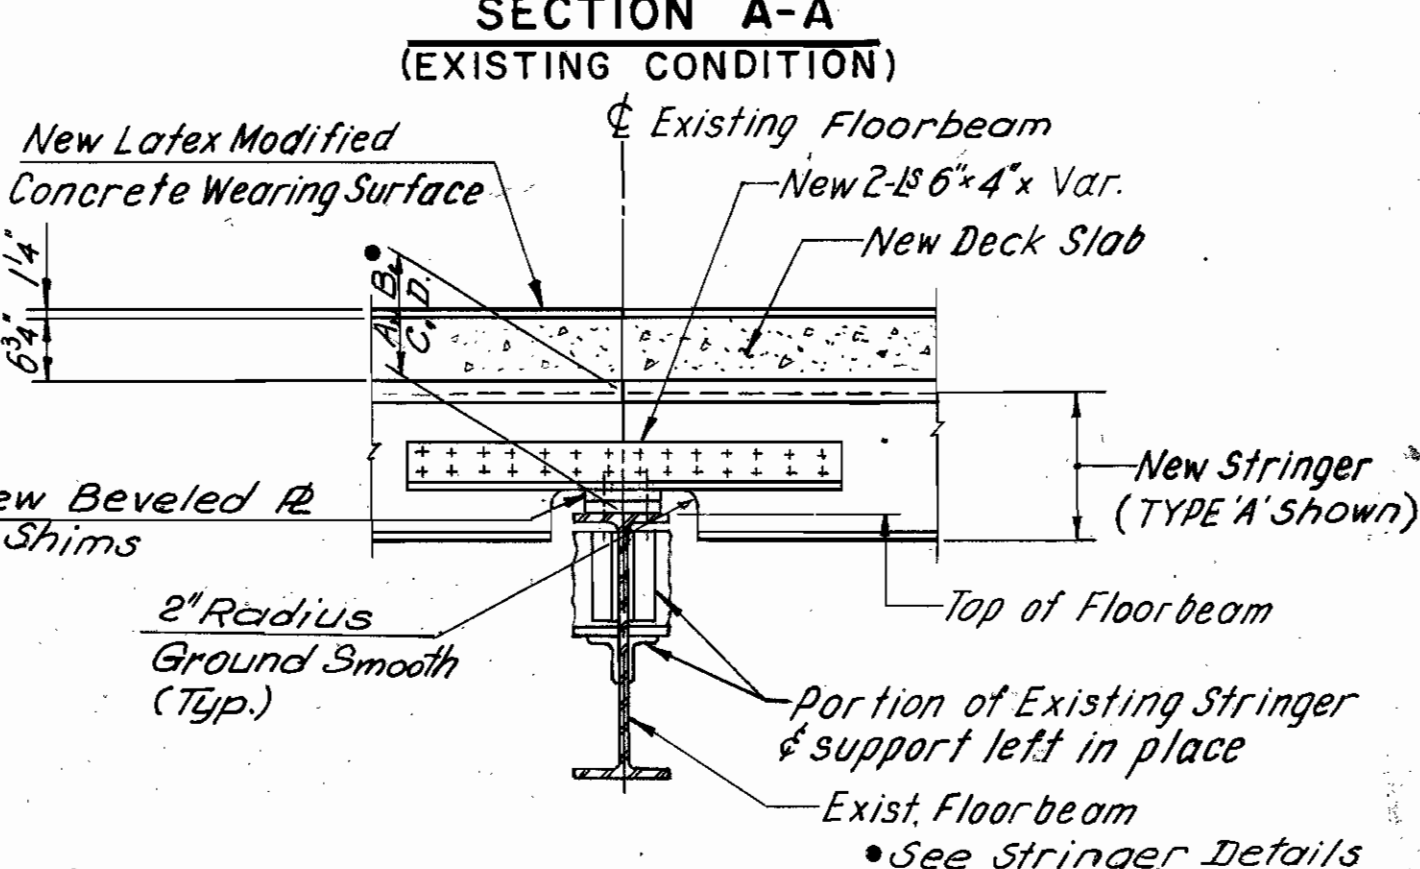

**REFERENCES:**

Existing Plan & Elevation	101 & 102
Proposed Plan & Elevation	104 & 105
Bridge Lighting Plan	664
Framing Plan	147
Stringer Details & Schedules	158 & 160
Fascia Stringer Setting Dim. H & Camber	163
Alignment Details	G36
Floor beam Replacement	159

PAVLO ENGINEERING CO., P.C.  
NEW YORK, NEW YORK

CUYAHOGA COUNTY ENGINEER  
CLEVELAND OHIO





**MAIN AVENUE BRIDGE**  
CITY OF CLEVELAND  
BRIDGE OVER THE CUYAHOGA RIVER VALLEY

WEST APPROACH - SECTION C  
**TYPICAL CROSS SECTIONS**

BRIDGE NO. 193 REPORT NO. 7119 DATE Nov 11, 1989

**NO. B-136**

DESIGN	DRAWN	CHECKED	REVISED TO AS BUILT
BG / DG	A. D.	J. B. M.	AS BUILT 2/94

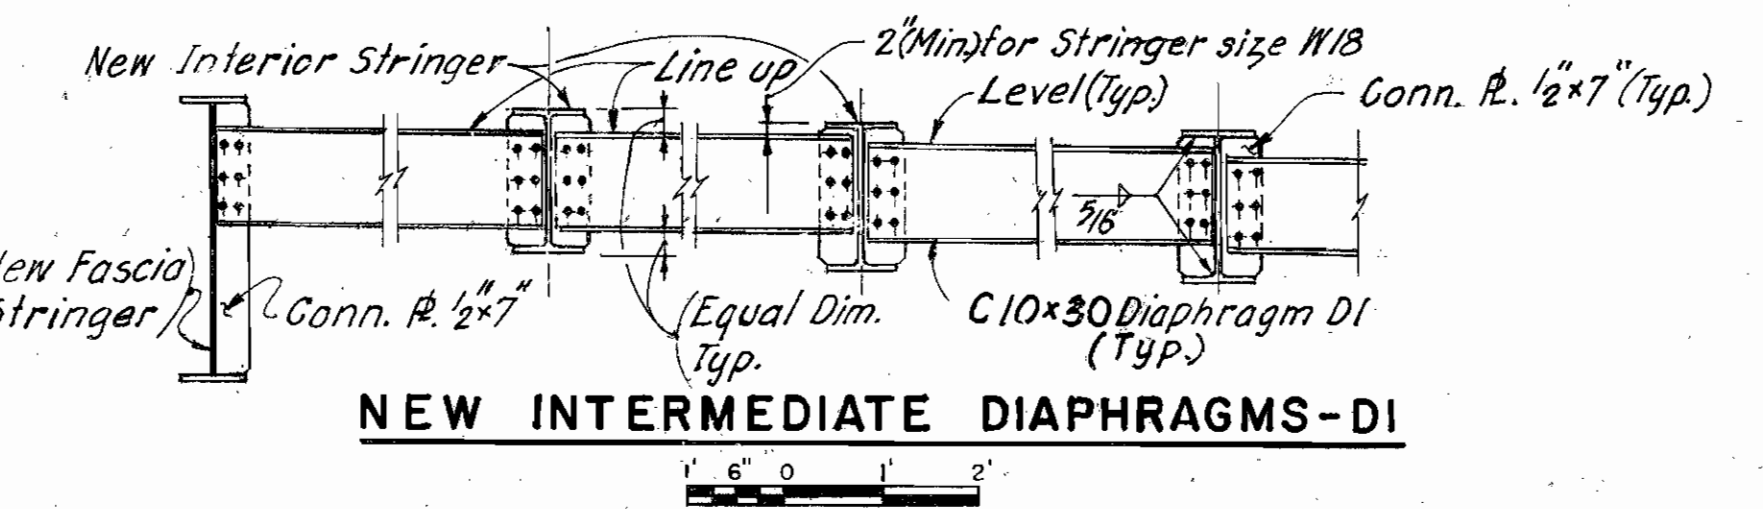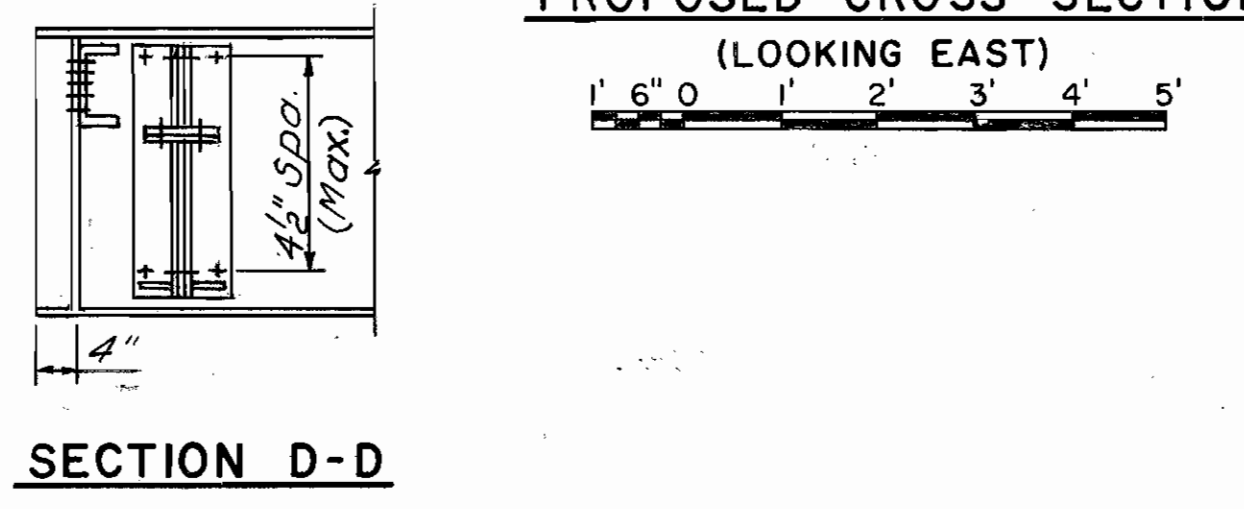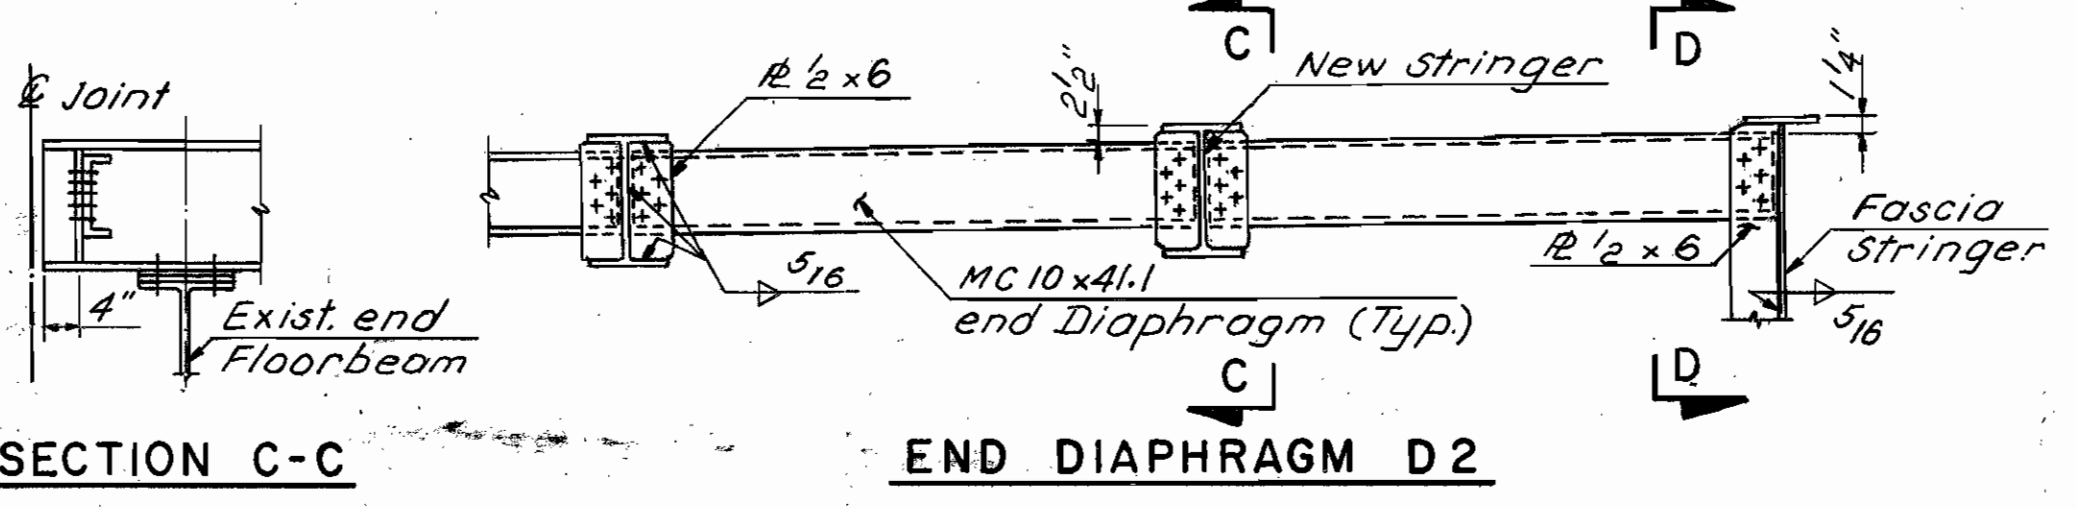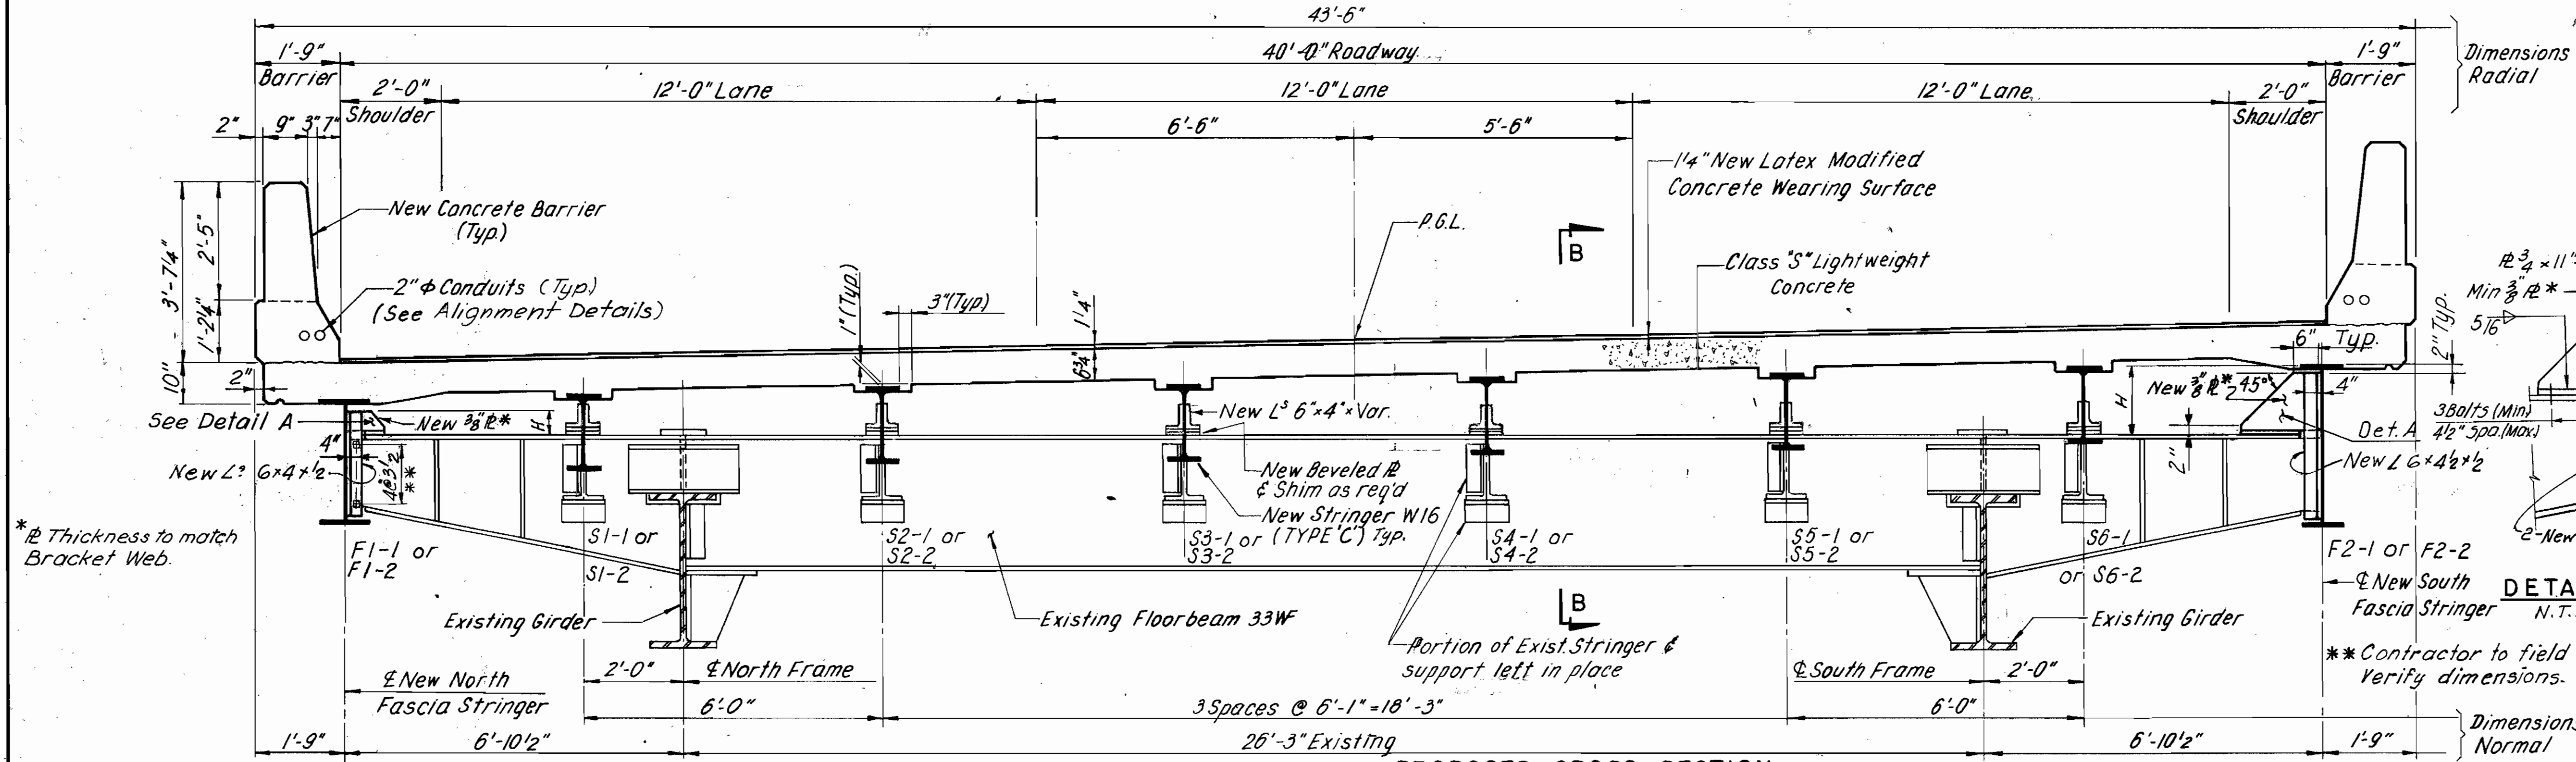


MICROFILMED  
JUL 21 1994

FHWA REGION	STATE	PROJECT
5	OHIO	BHF-73(51)


III  
547

CUYAHOGA COUNTY  
CUY-2-14.66

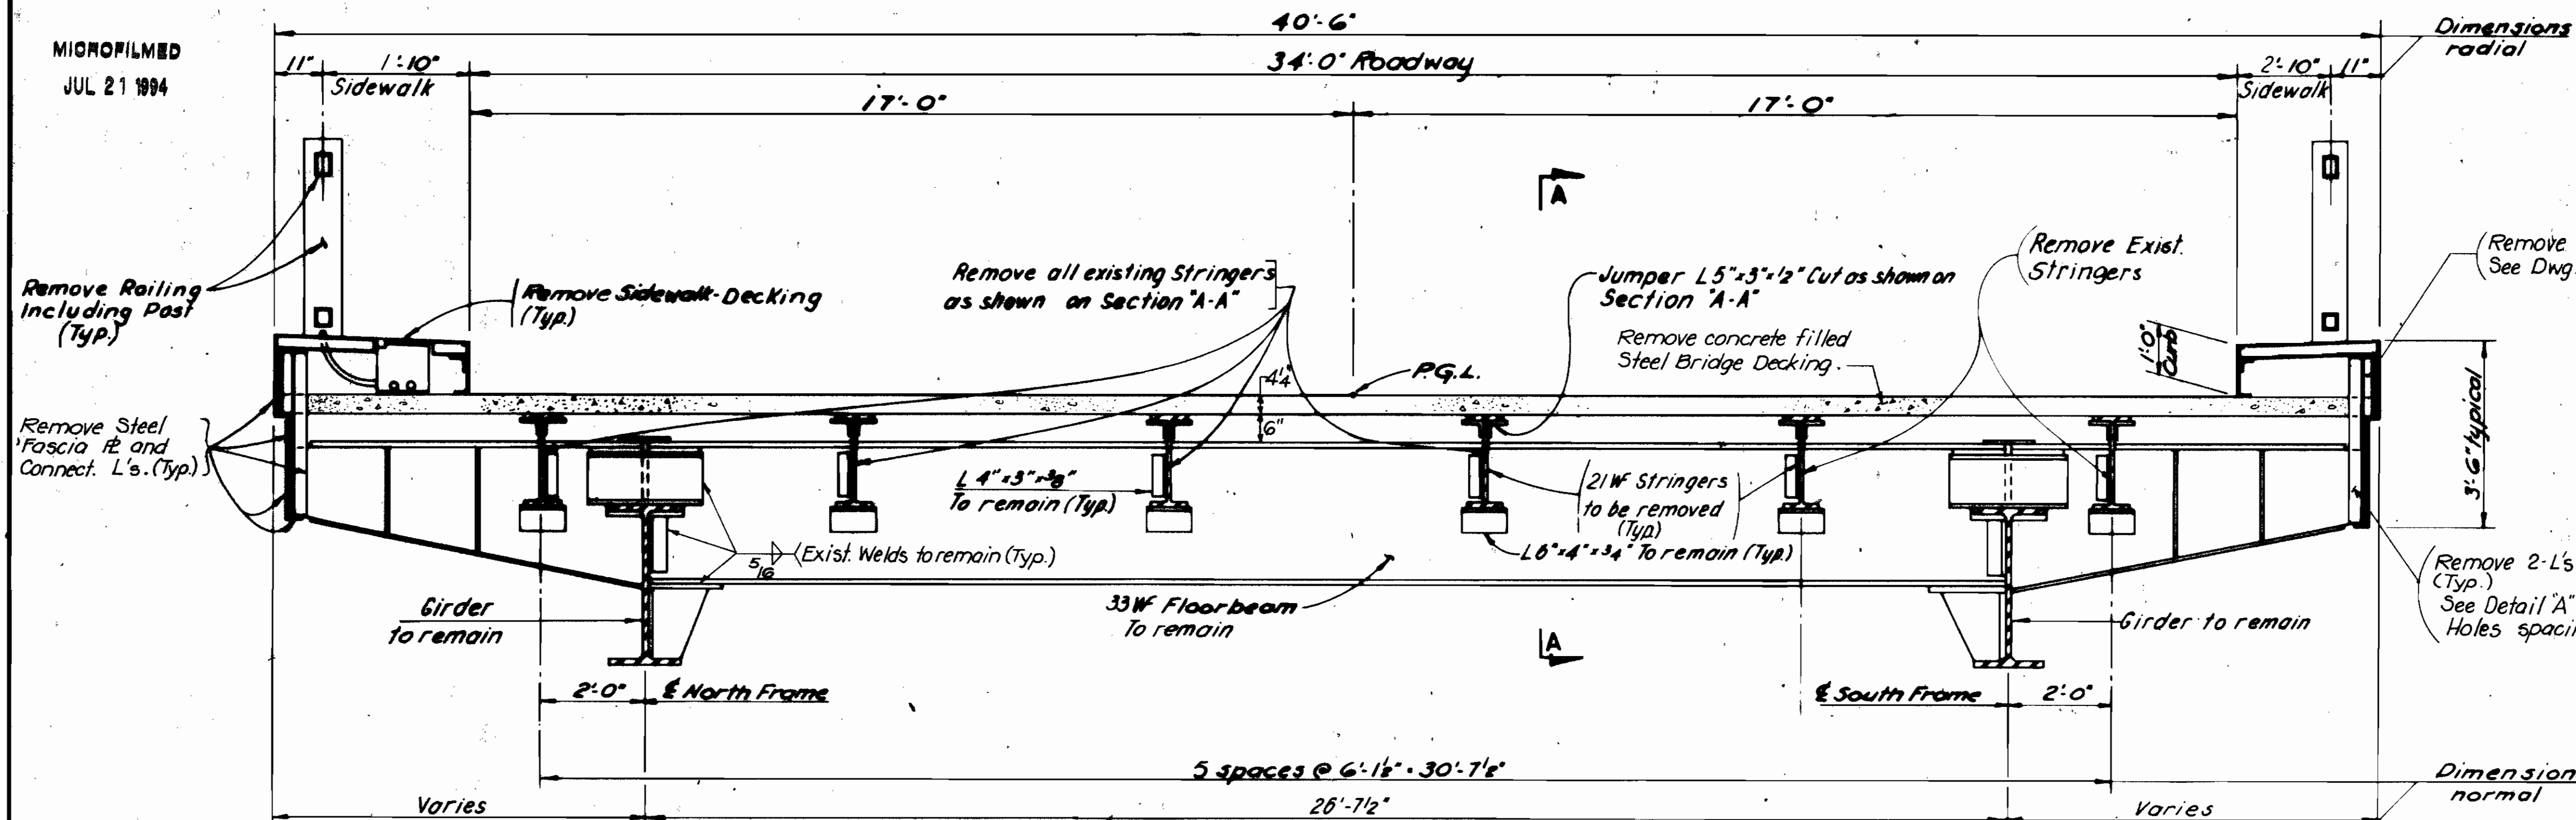


EXISTING CROSS SECTION (Looking East)


Note: All Removal shall be paid for under Item 202, "Portions of structures Removed, As Per Plan".

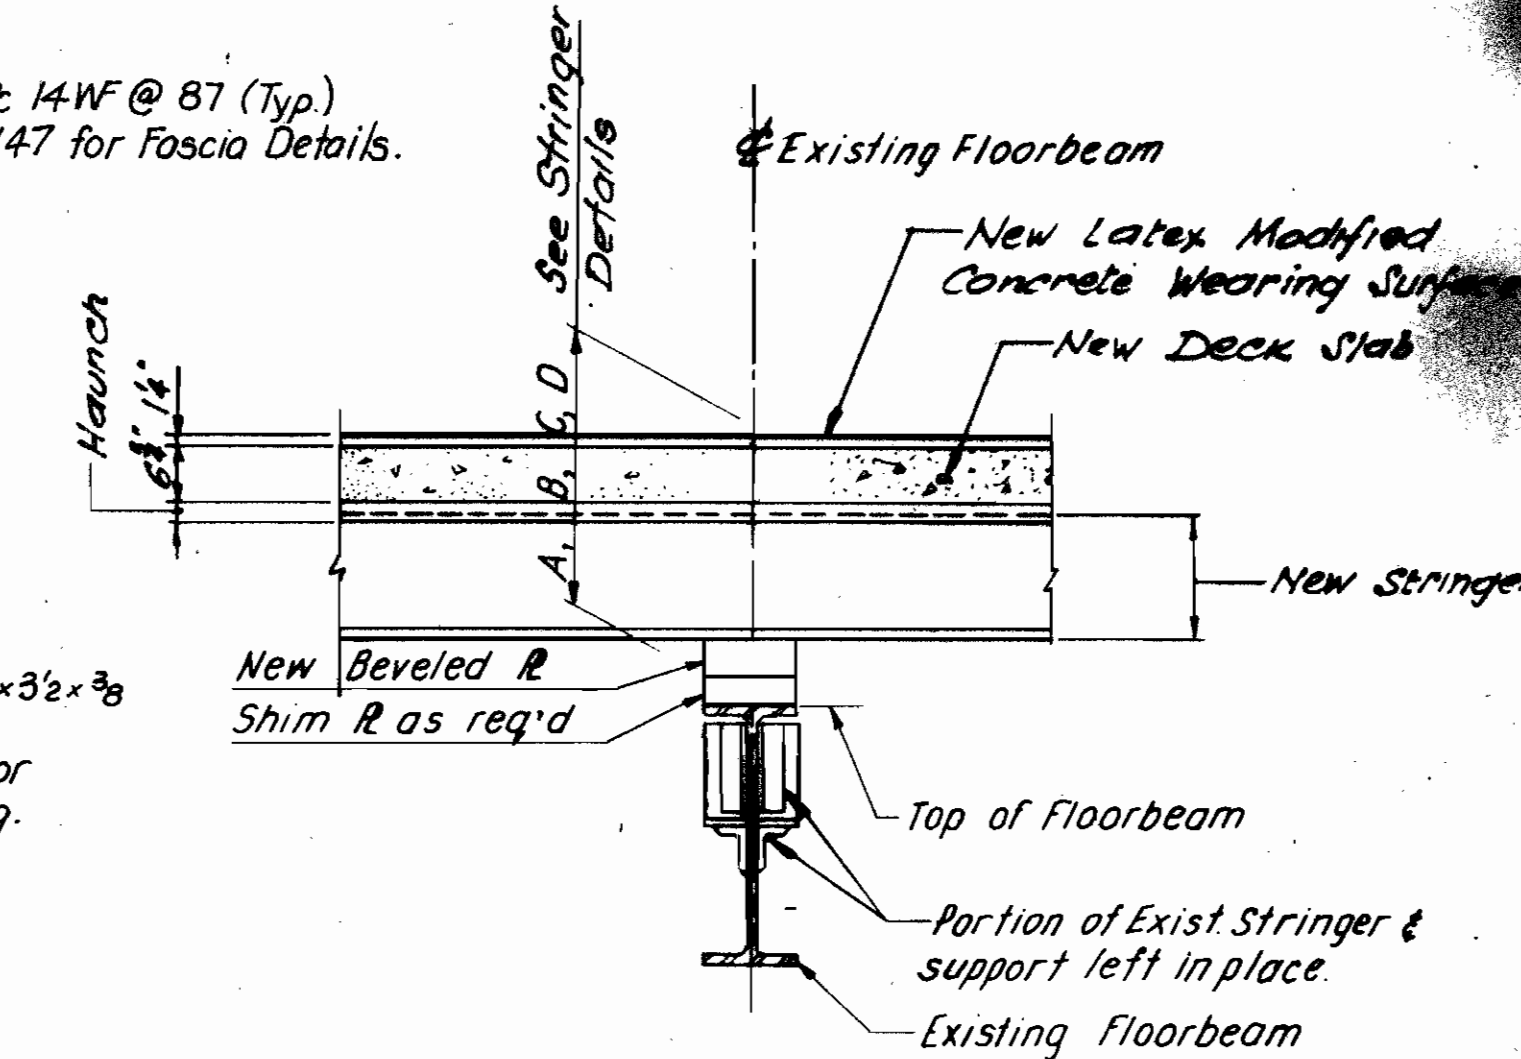

SECTION C-C

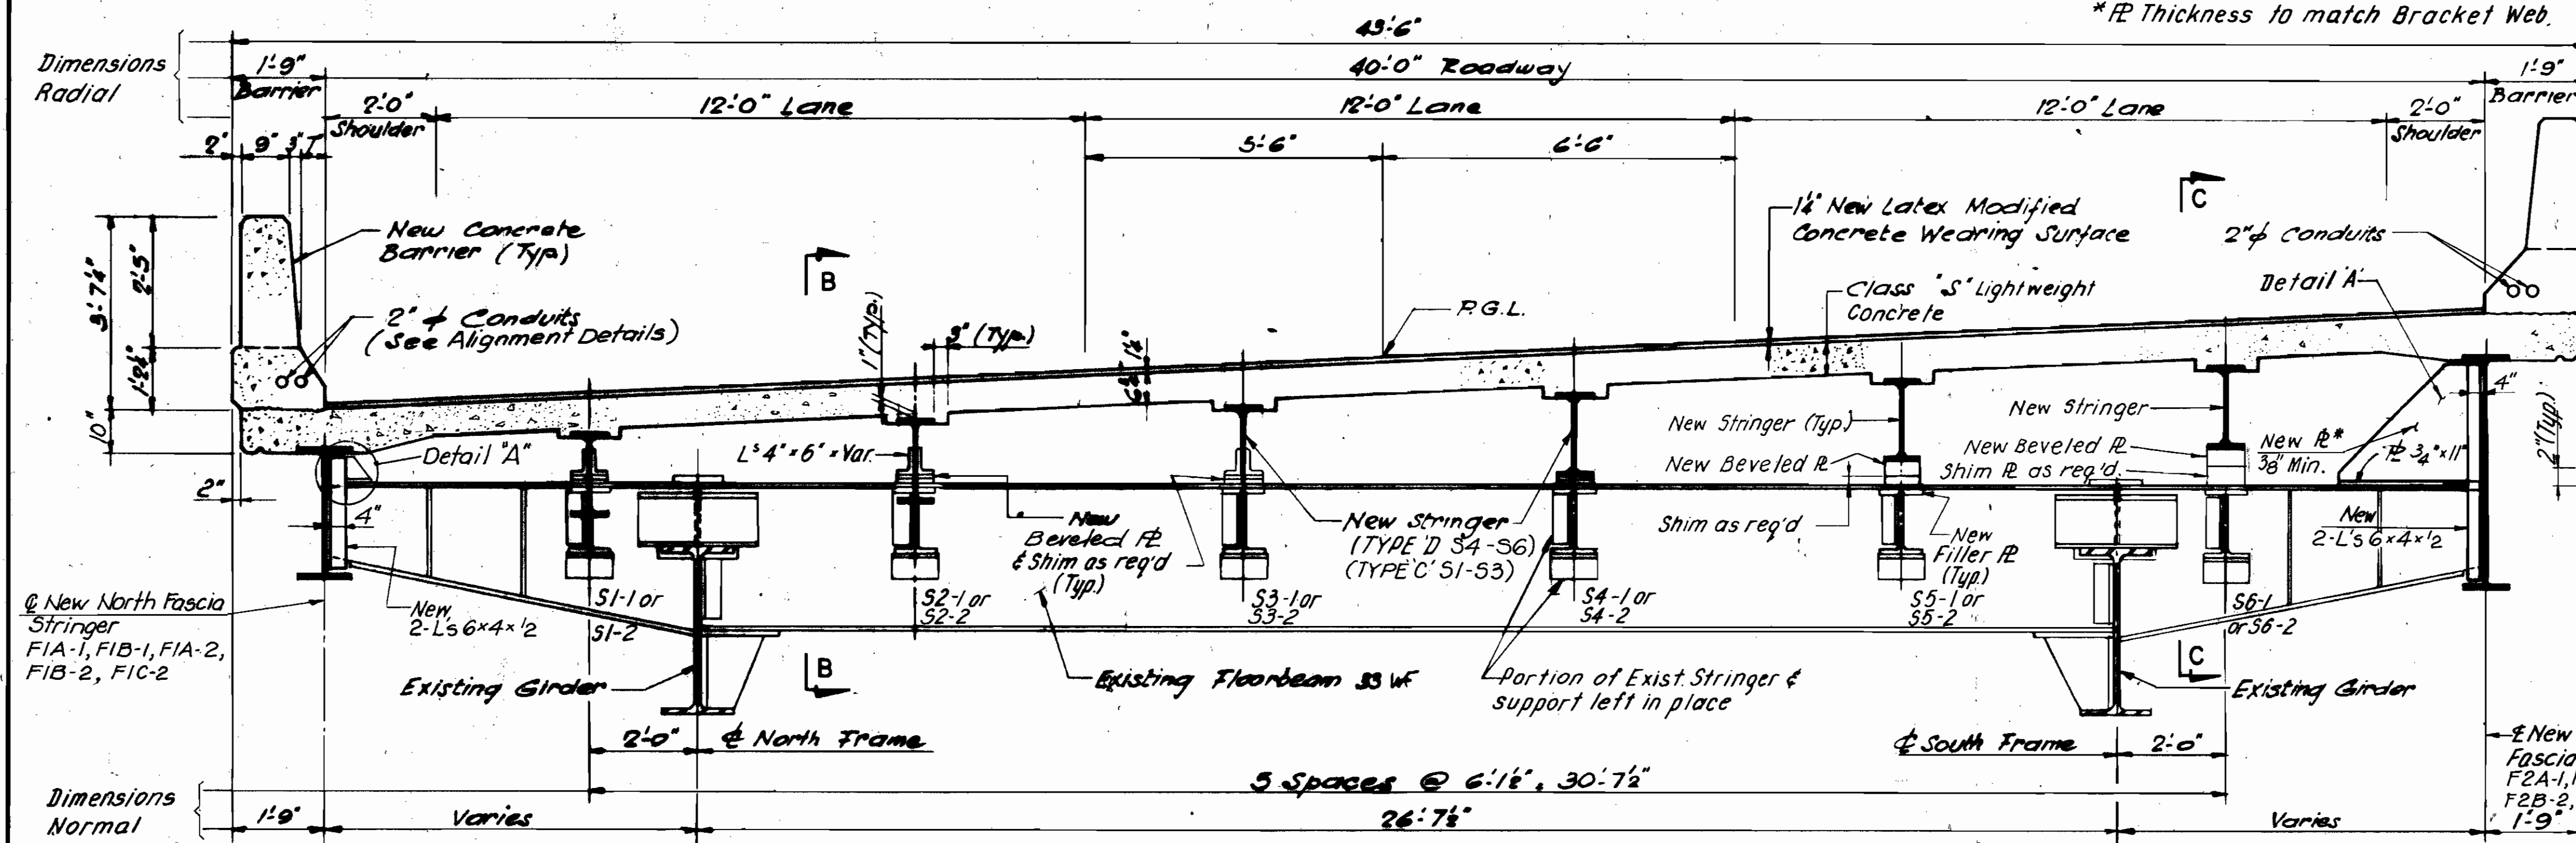




PROPOSED CROSS SECTION (Looking East)

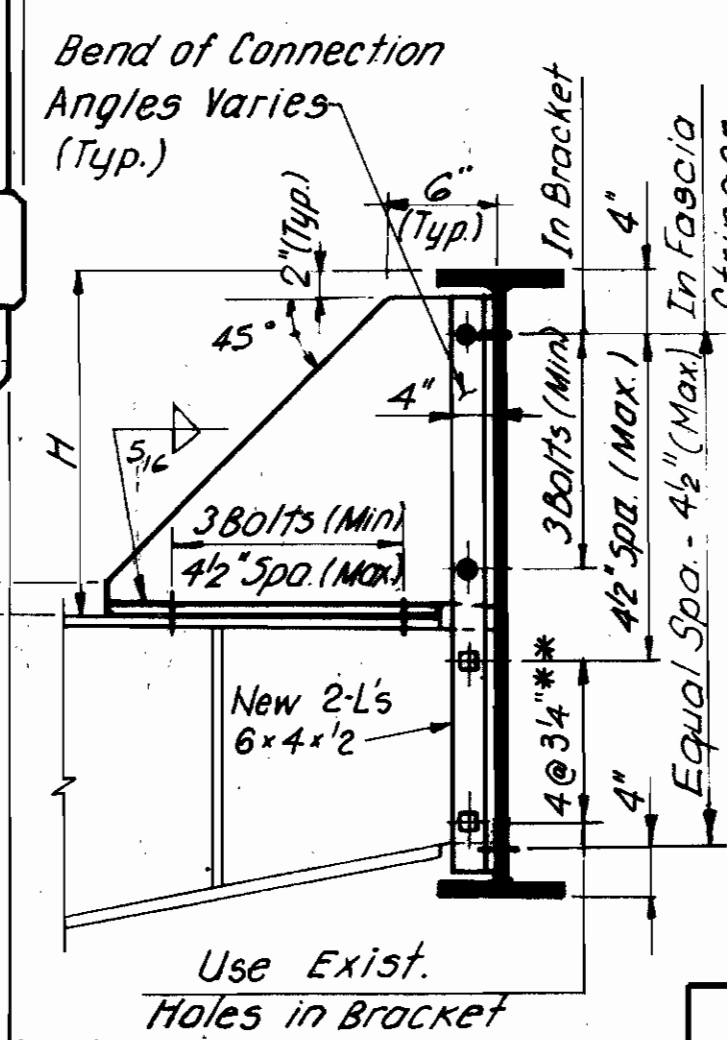

REFERENCES:

REFERENCE	DWG. NO.
Existing Plan & Elevation	101 & 102
Proposed Plan & Elevation	104 & 105
Bridge Lighting Plan	664
Framing Plan	147
Stringer Details	158
Stringer Schedules	160
Fascia Stringer Setting Dim. H & Camber	163
Sections A-A & B-B	112
Alignment Details	G36
Floorbeam Replacements	155

Note: All bolts to be 3/8" φ H.S.

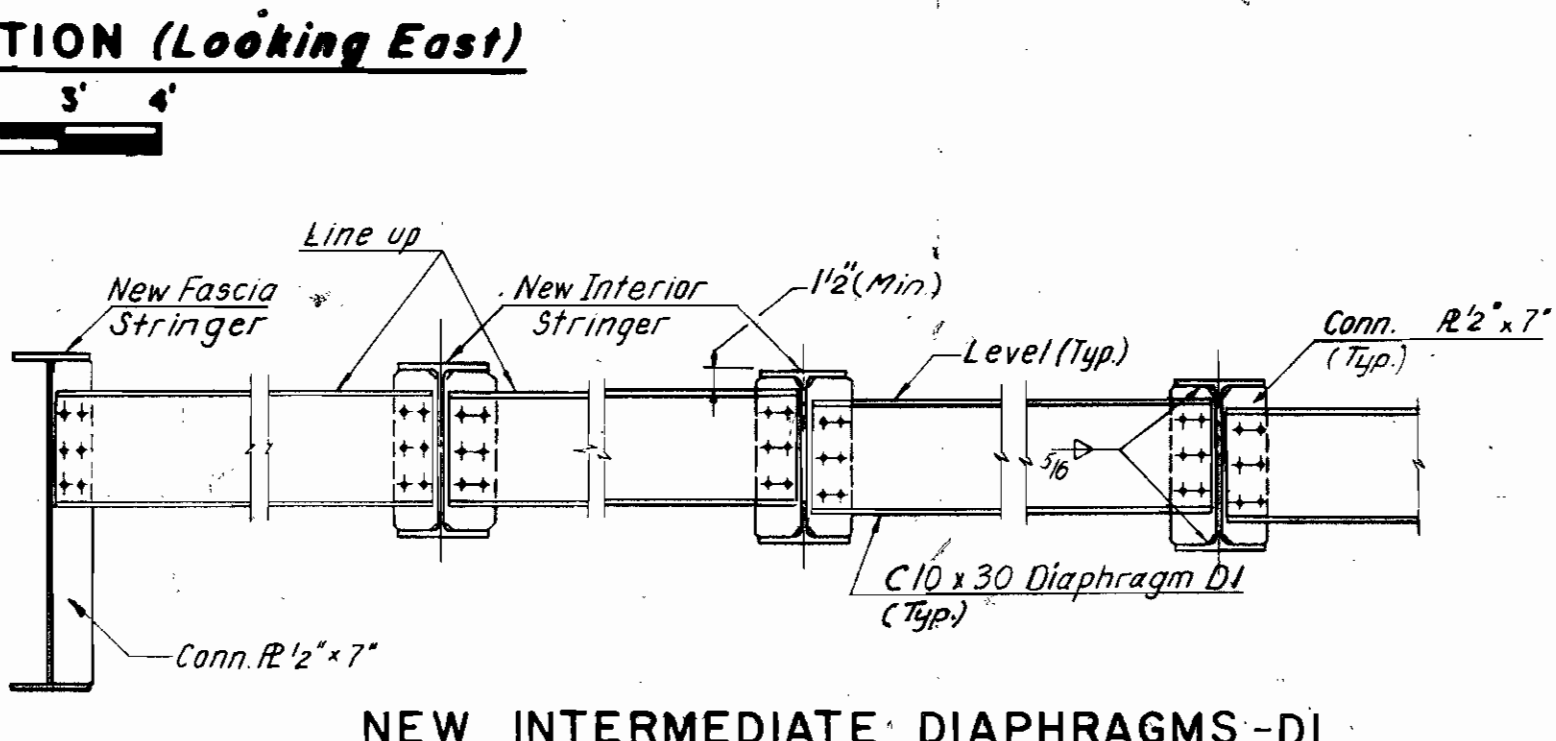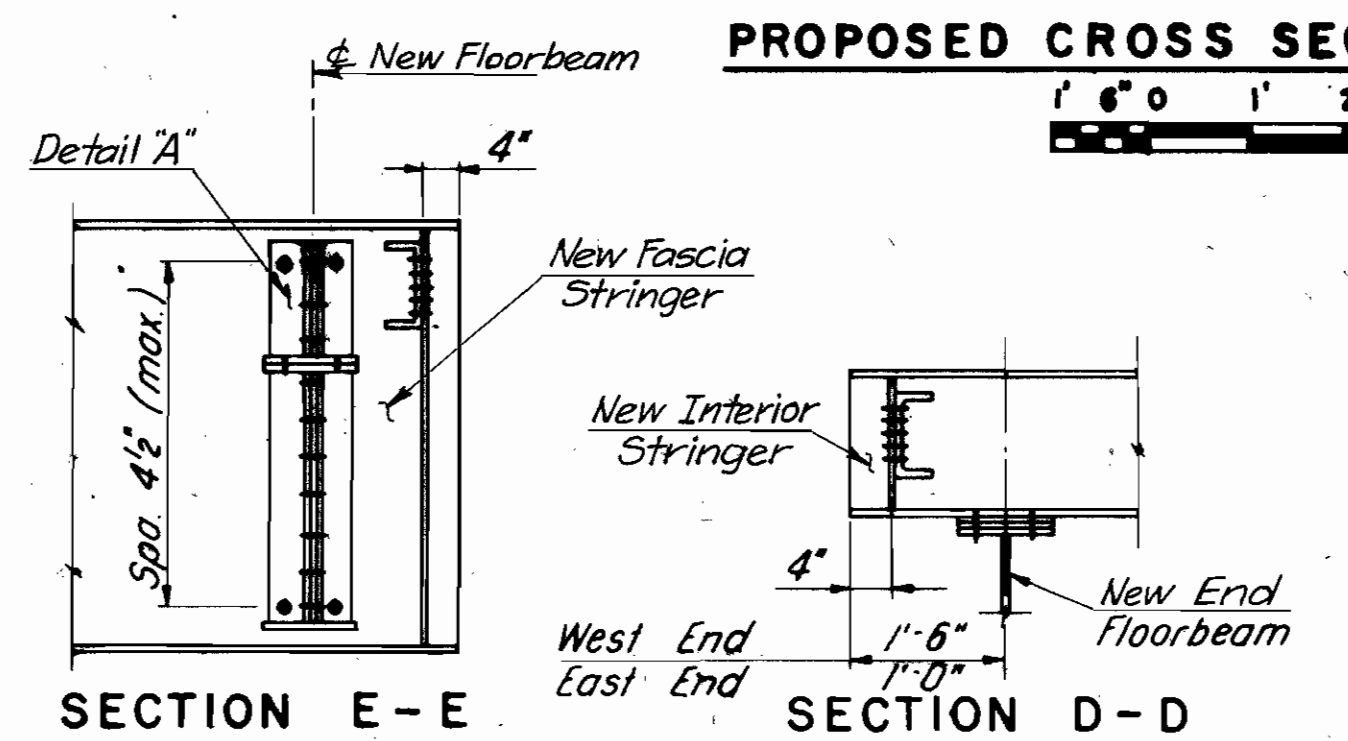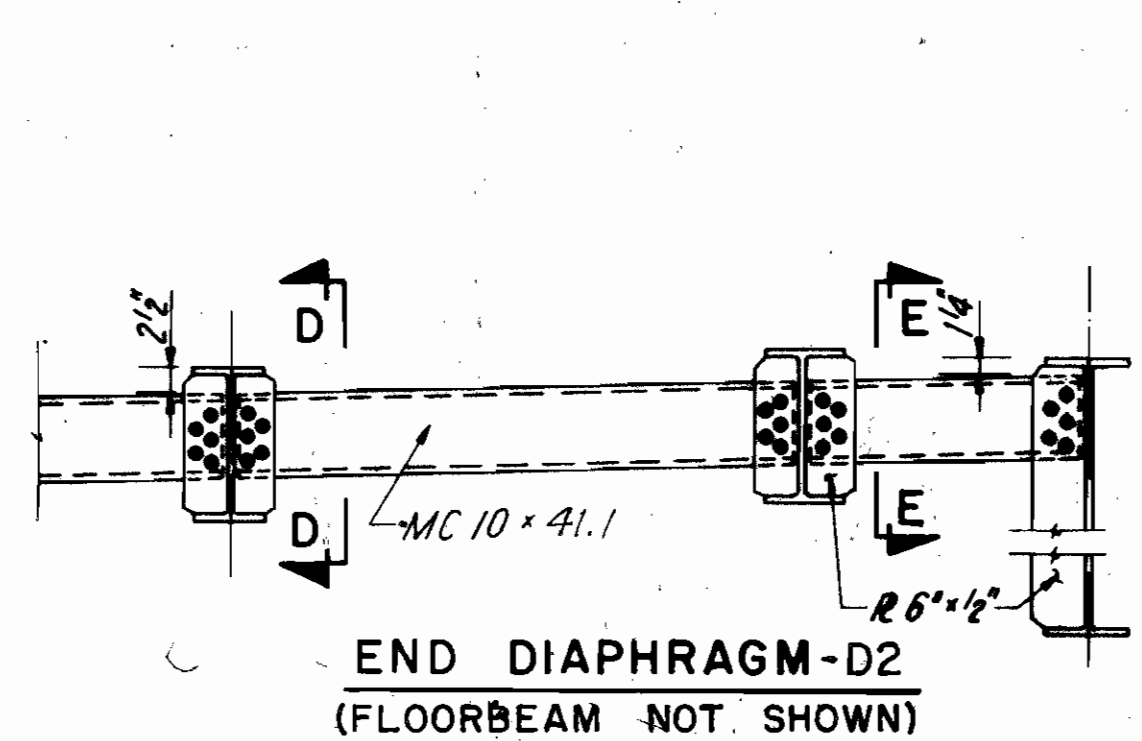

PAVLO ENGINEERING CO., P.C.  
NEW YORK, NEW YORK

CUYAHOGA COUNTY ENGINEER  
CLEVELAND OHIO

**MAIN AVENUE BRIDGE**  
CITY OF CLEVELAND  
BRIDGE OVER THE CUYAHOGA RIVER VALLEY

WEST APPROACH - SECTION K  
**TYPICAL CROSS SECTIONS**

BRIDGE NO. 193 REPORT NO. 7119 DATE Nov. 11, 1999

NO. B-136





DESIGN B.G/D.G.	DRAWN A.D.	CHECKED J.B.M.	REVISED TO AS BUILT AS BUILT 2/94
--------------------	---------------	-------------------	--------------------------------------

113  
991


FHWA REGION	STATE	PROJECT	NO.
5	OHIO	BHF-73(51)	112

547
-----




CUYAHOGA COUNTY  
CUY-2-14.66

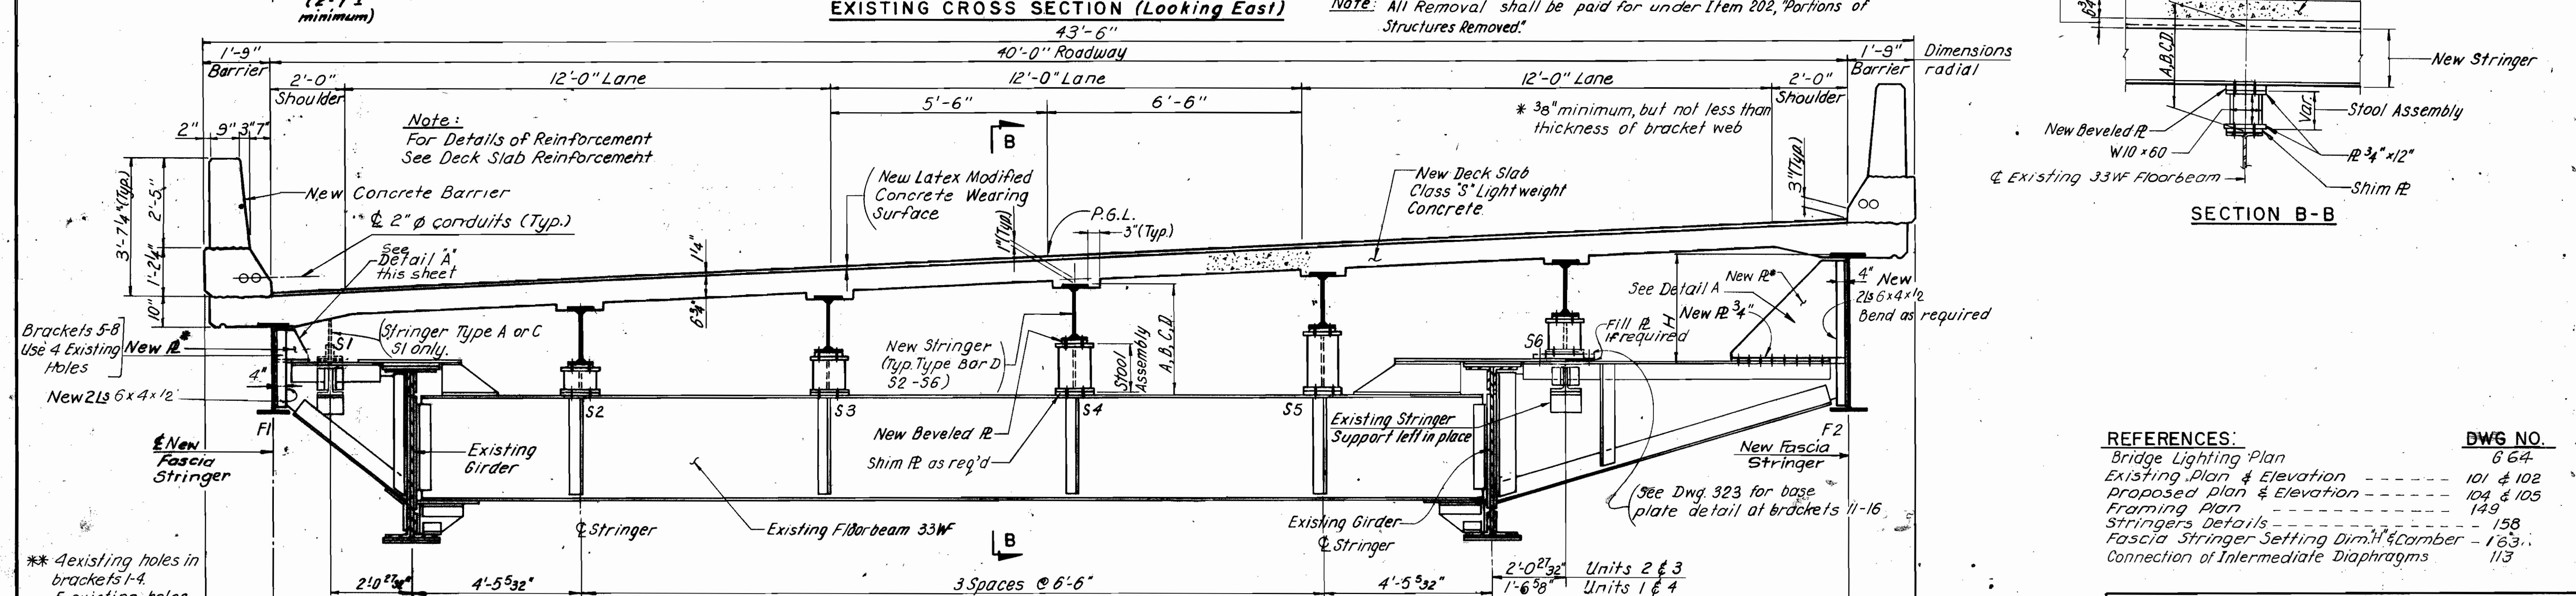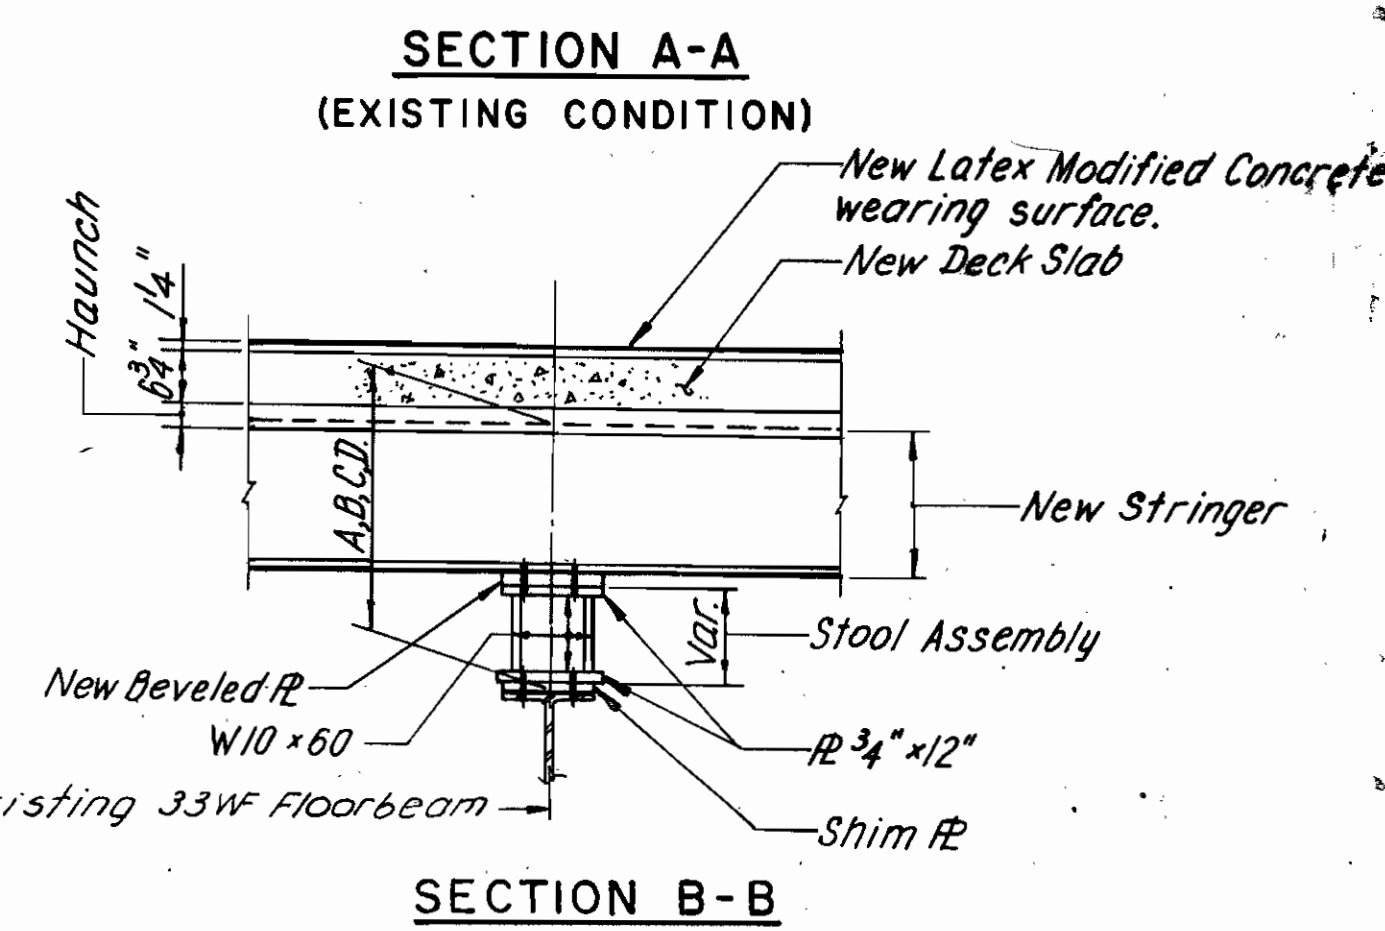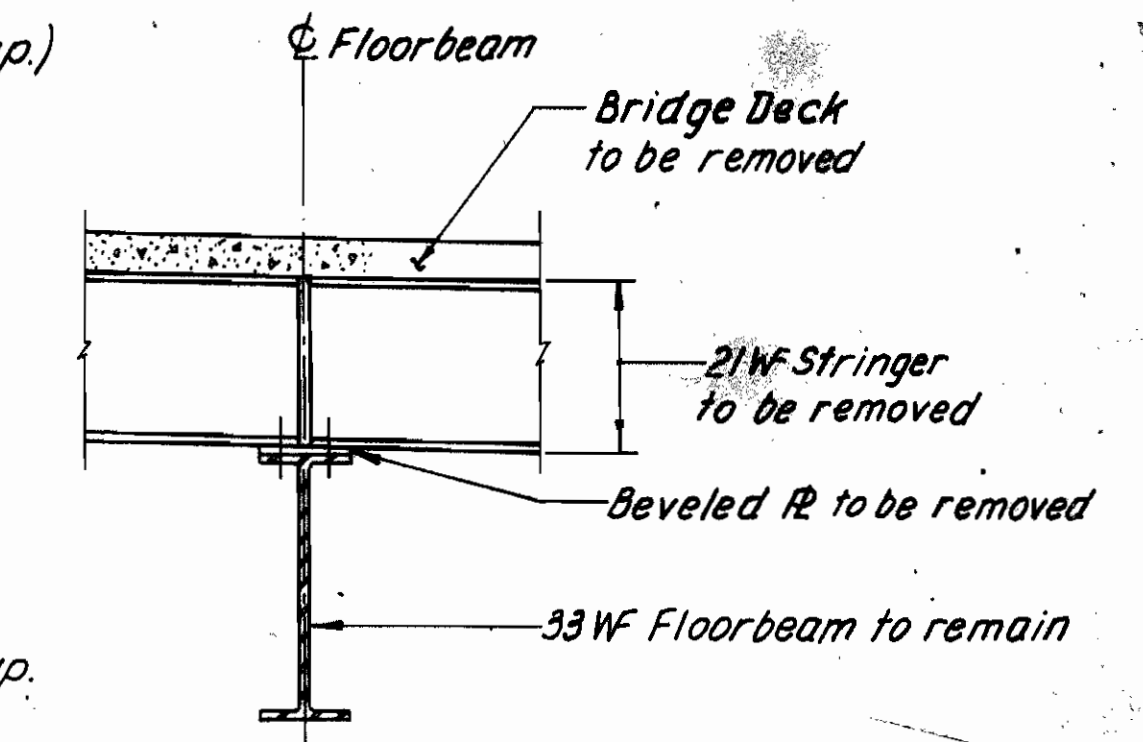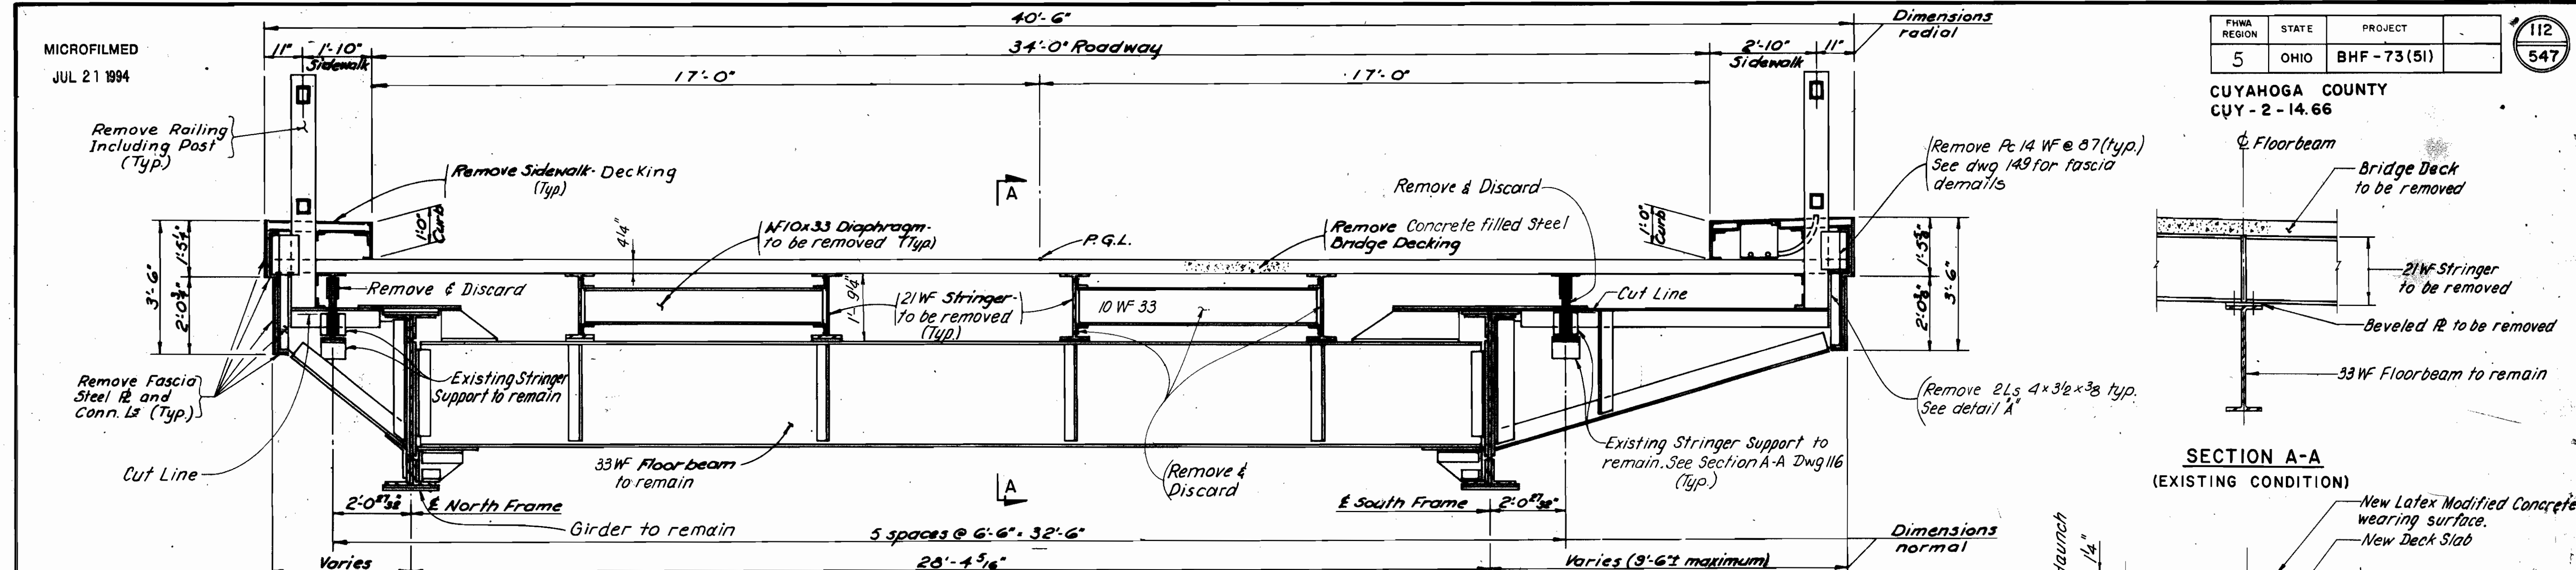

- | REFERENCES:                             | DWG NO.   |
|---|-----------|
| Bridge Lighting Plan                    | 664       |
| Existing Plan & Elevation               | 101 & 102 |
| Proposed Plan & Elevation               | 104 & 105 |
| Framing Plan                            | 149       |
| Stringers Details                       | 158       |
| Fascia Stringer Setting Dim. H & Camber | 163       |
| Connection of Intermediate Diaphragms   | 113       |

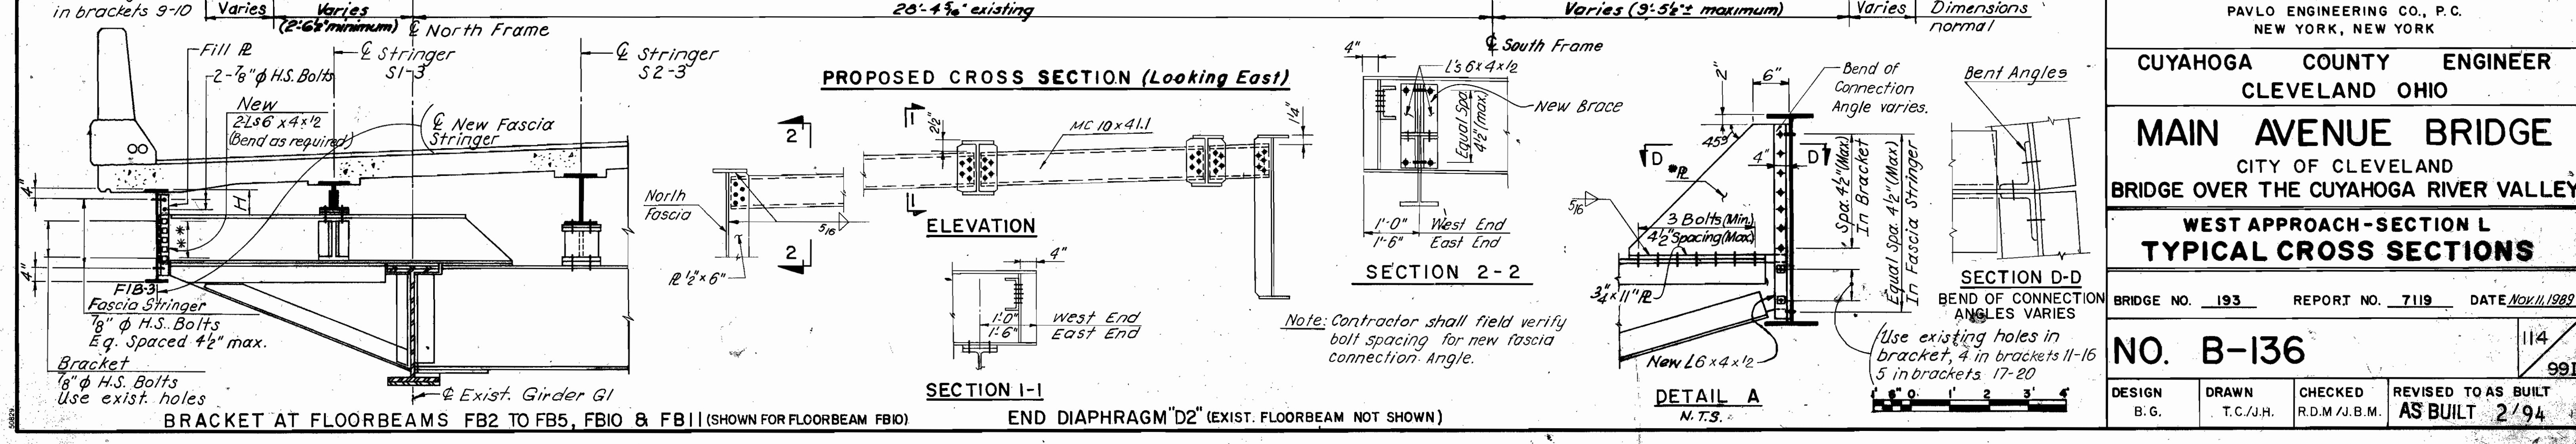

PROPOSED CROSS SECTION (Looking East)

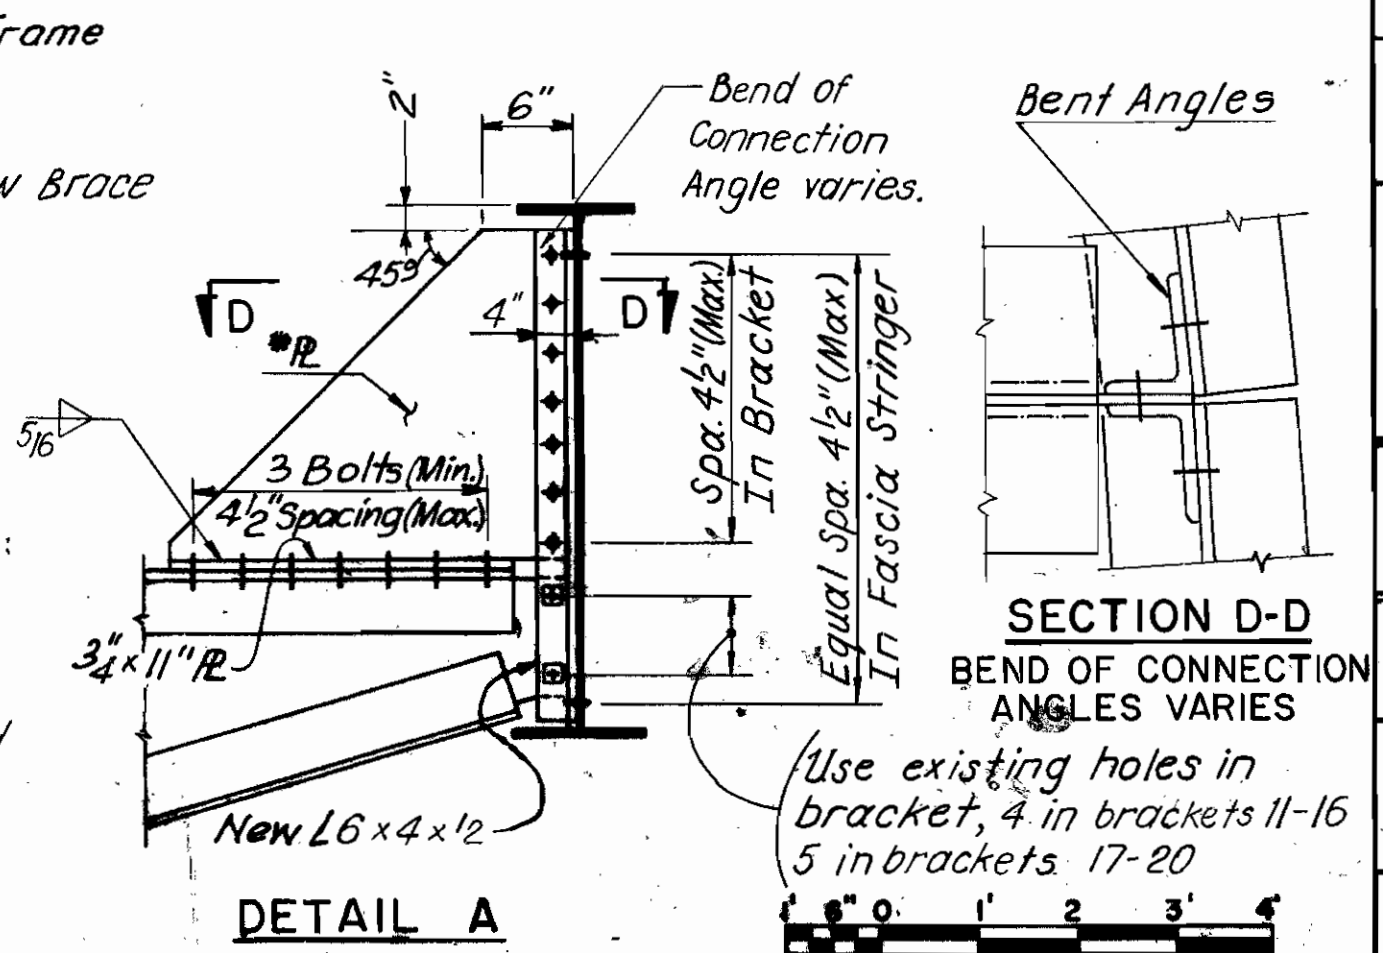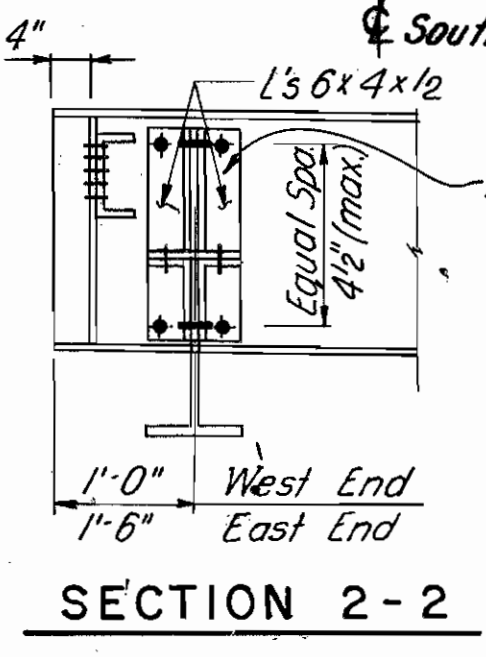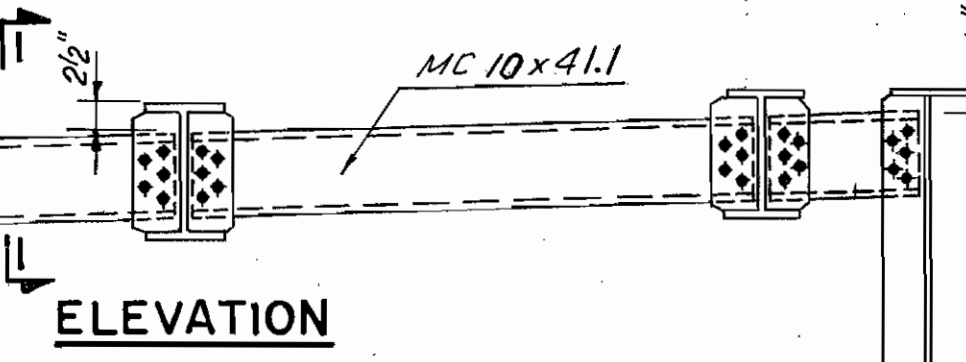

PAVLO ENGINEERING CO., P.C.  
NEW YORK, NEW YORK

CUYAHOGA COUNTY ENGINEER  
CLEVELAND OHIO


**MAIN AVENUE BRIDGE**  
CITY OF CLEVELAND  
BRIDGE OVER THE CUYAHOGA RIVER VALLEY

**WEST APPROACH-SECTION L**  
**TYPICAL CROSS SECTIONS**

BRIDGE NO. 193 REPORT NO. 7119 DATE NOV. 11, 1989

**NO. B-136**


DESIGN	DRAWN	CHECKED	REVISED TO AS BUILT
B.G.	T.C.J.H.	R.D.M./J.B.M.	AS BUILT 2/94

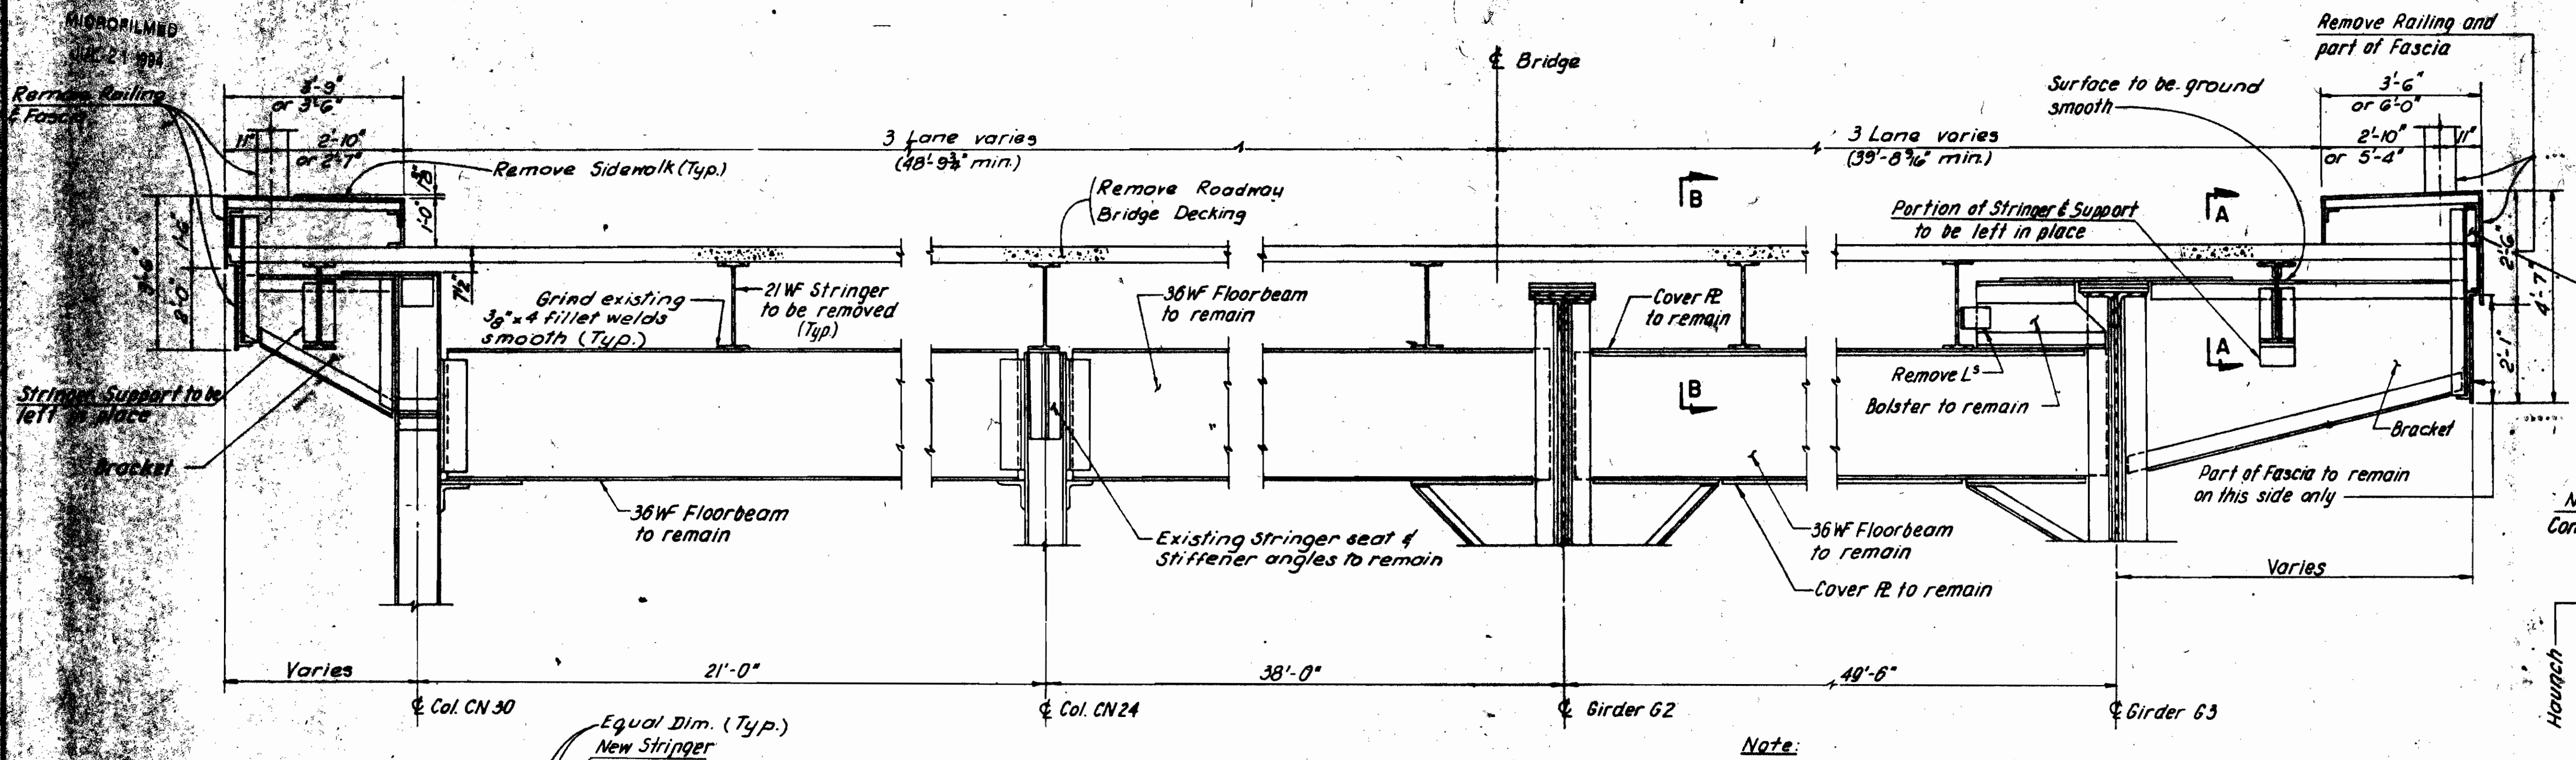


**EXISTING CROSS SECTION (Looking East)**

**Note:**  
 All Removal shall be Paid for under Item 202, "Portions of Structures Removed."  
 At locations where existing floorbeam rivets interfere with the installation of new stringers, see typical base plate detail - Dwg. 165  
 Contractor shall field verify bolt spacing for new fascia connection angle to existing brackets.



**CONNECTION OF DIAPHRAGM - DI (TYP.)**

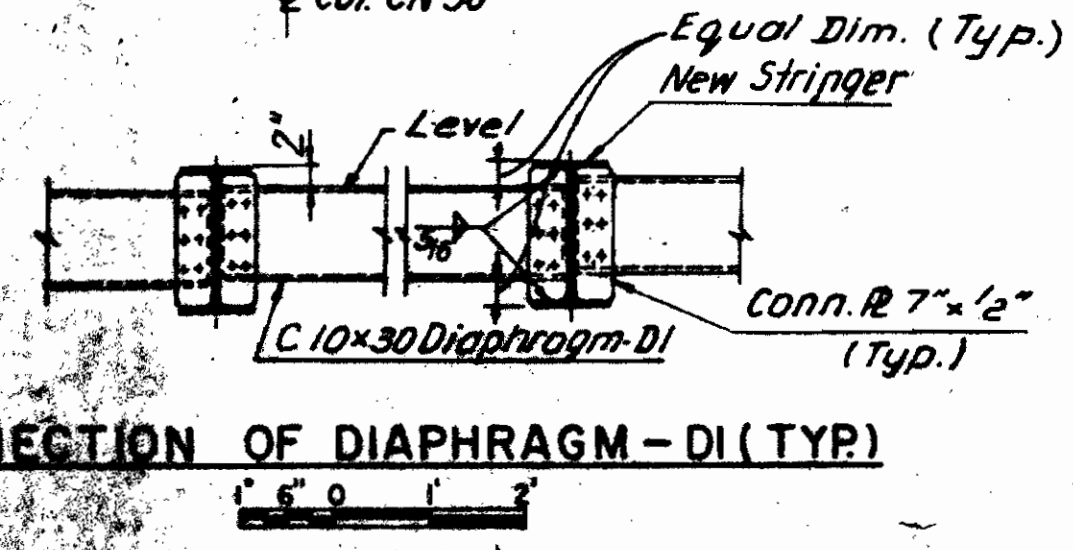

**SECTION B-B**

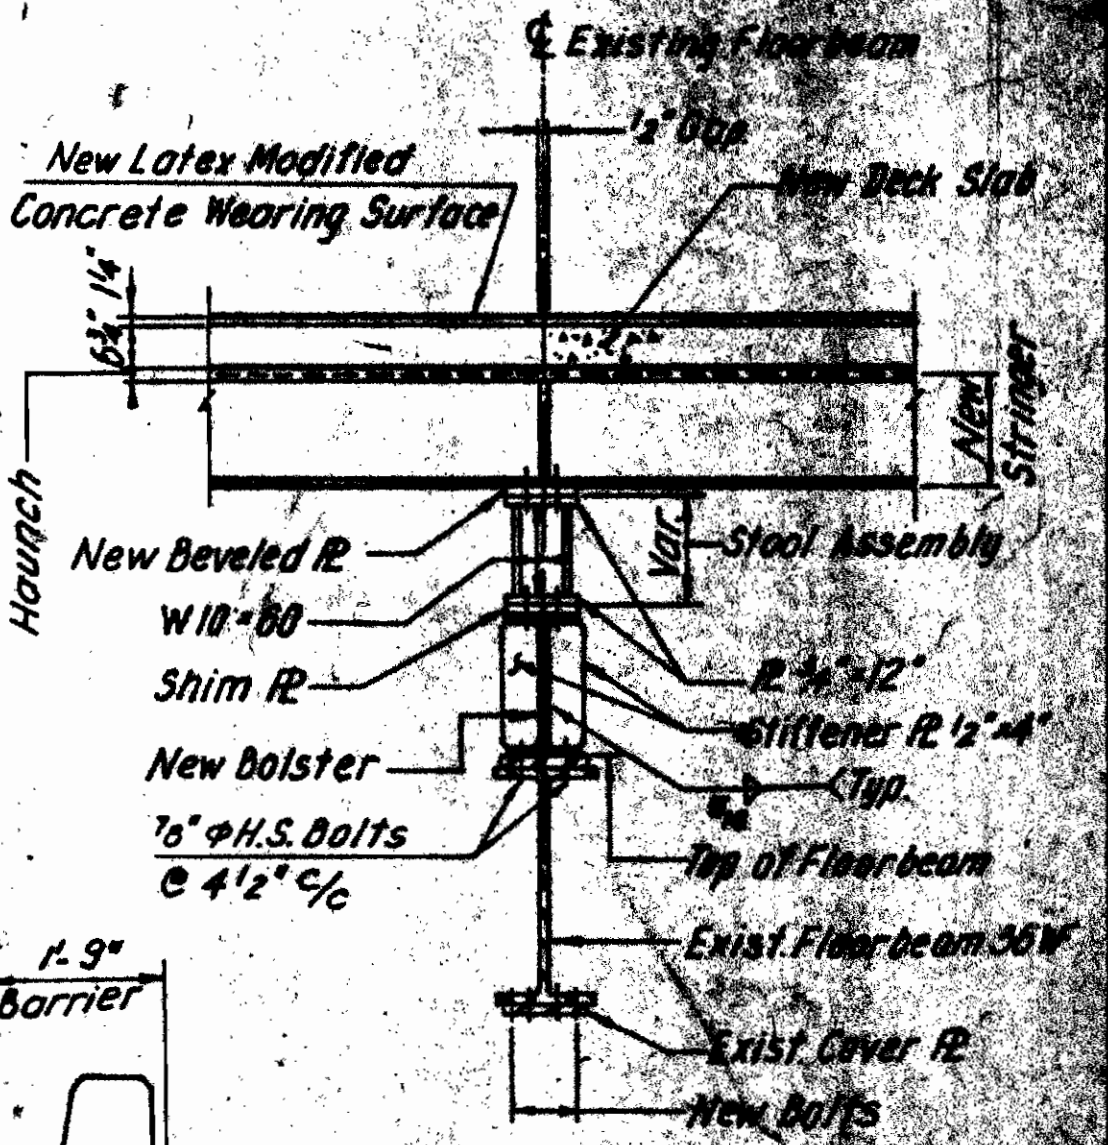

**SECTION C-C**

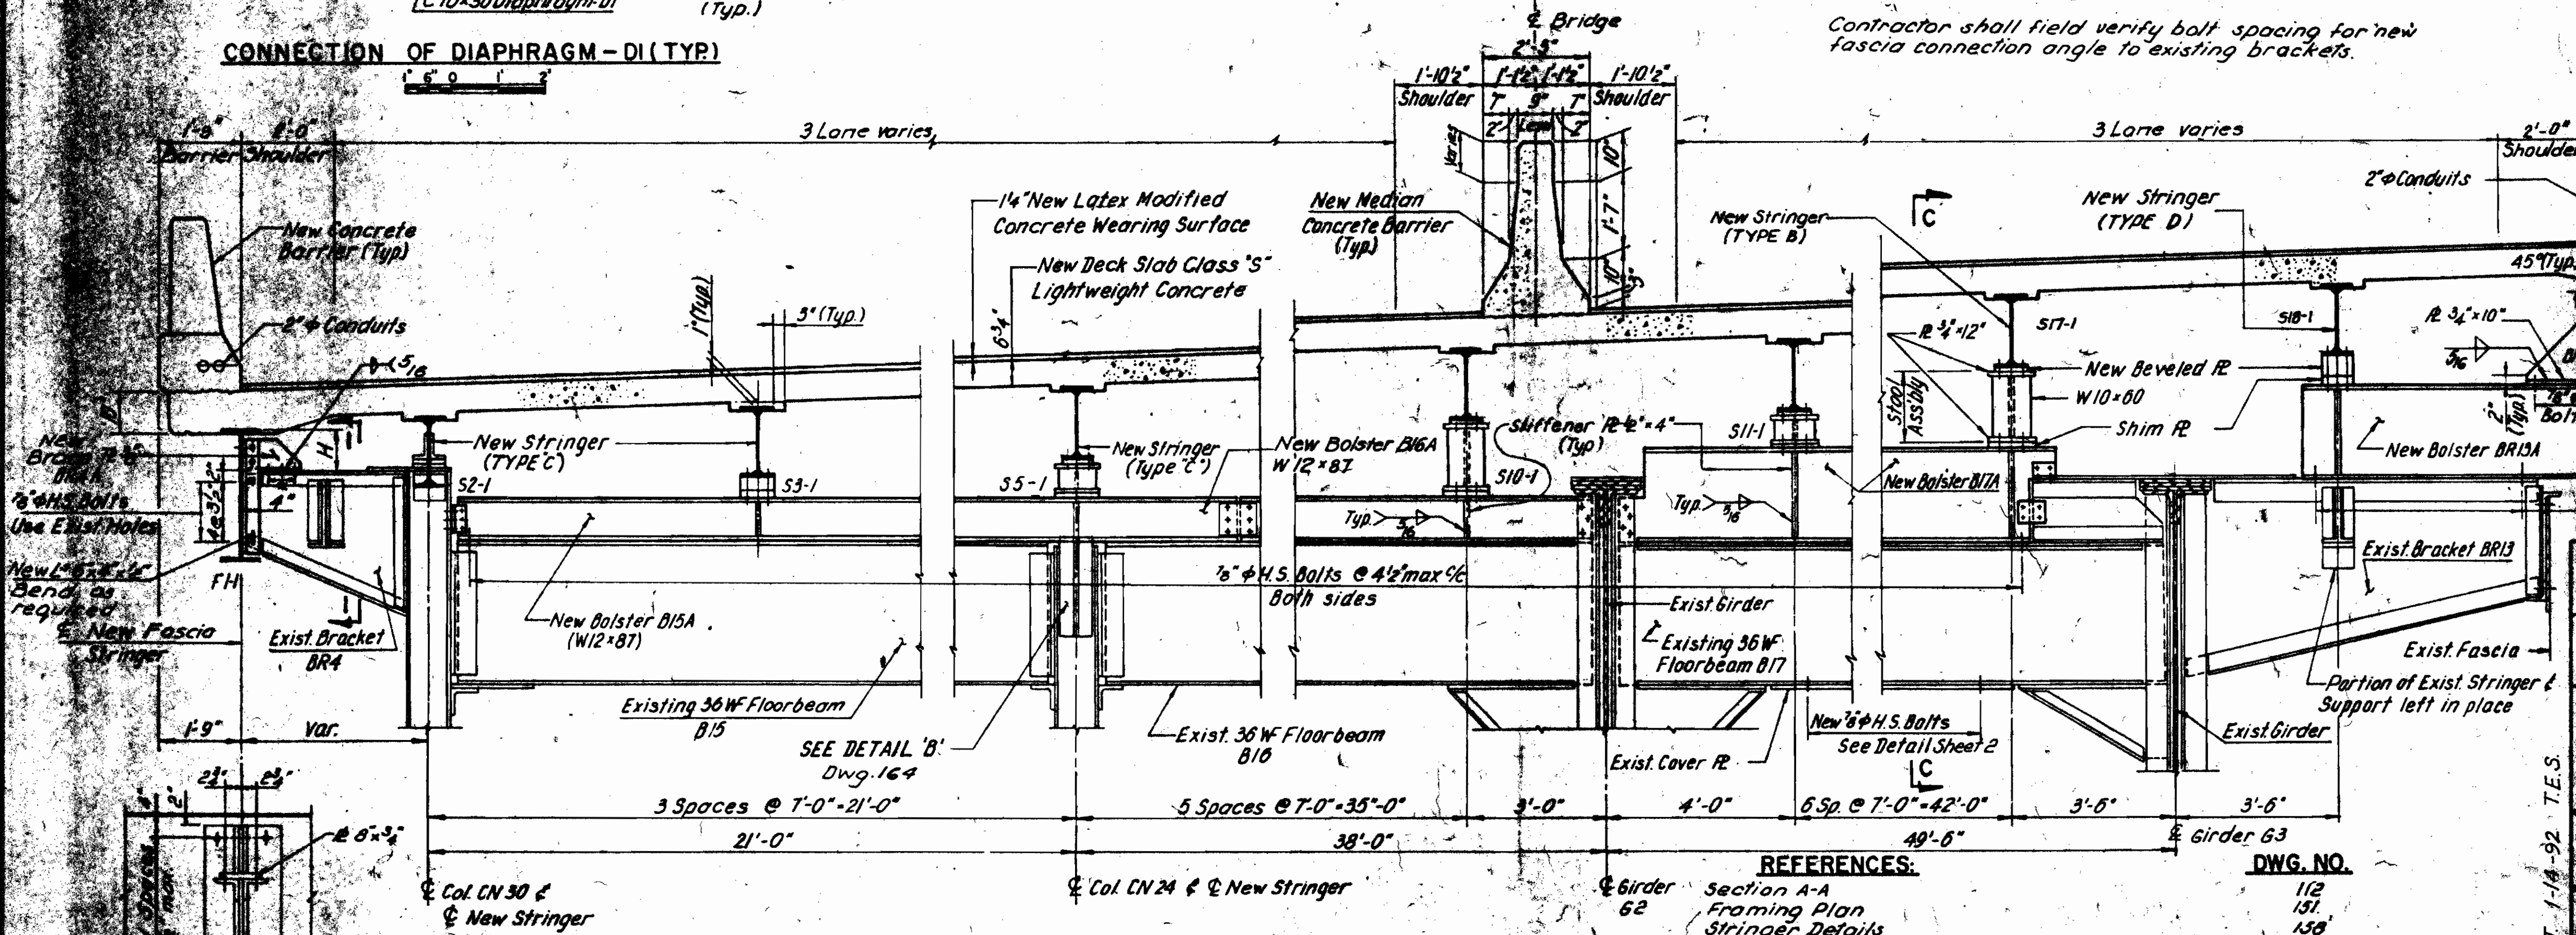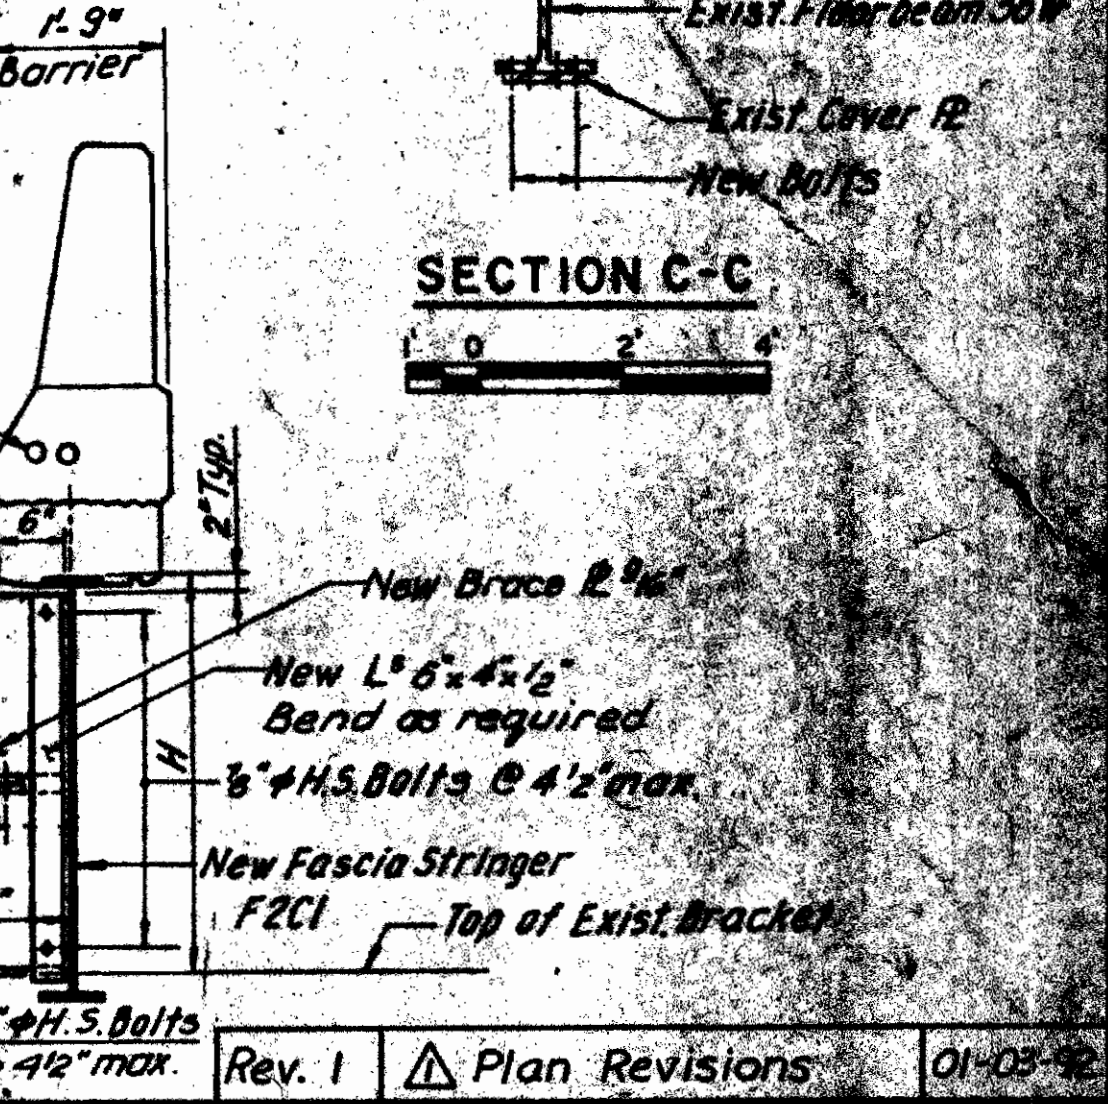

**PROPOSED CROSS SECTION (Looking East)**

(Floorbeam B15, B16, B17 Shown)

**REFERENCES:**

Section A-A	112
Framing Plan	151
Stringer Details	158
Stringer Schedules	162
Fascia Stringer Setting Dim. H & Camber	163
Bolster Schedule & Floorbeams - Schematic Elevations	154
Fascia Stringer Elevation	159
Detail Sheets 1 Thru 9	164 Thru 168 D
Floorbeam Bent Replacement Details	168E Thru 168J

Rev. 1 Plan Revisions 01-03-92

PAVLO ENGINEERING CO., P.C.  
 NEW YORK, NEW YORK

CUYAHOGA COUNTY ENGINEER  
 CLEVELAND OHIO

**MAIN AVENUE BRIDGE**

CITY OF CLEVELAND  
 BRIDGE OVER THE CUYAHOGA RIVER VALLEY

WEST APPROACH - SECTION N  
 TYPICAL CROSS SECTION

BRIDGE NO. 133 REPORT NO. 100 DATE 10/2/92

**NO. B-136**

DESIGN B.G. / D.G.	DRAWN A.D.	CHECKED J. BM.	DATE AS BUILT 2/94
-----------------------	---------------	-------------------	-----------------------

\* Equal Spacing 3'-4 1/2" (max.) minimum of 2 fasteners

O.D.T. 1-14-92 T.E.S.




MICROFILMED  
JUL 21 1994


FHWA REGION	STATE	PROJECT
5	OHIO	BHF-73(51)

114  
547

CUYAHOGA COUNTY  
CUY-2-14.66

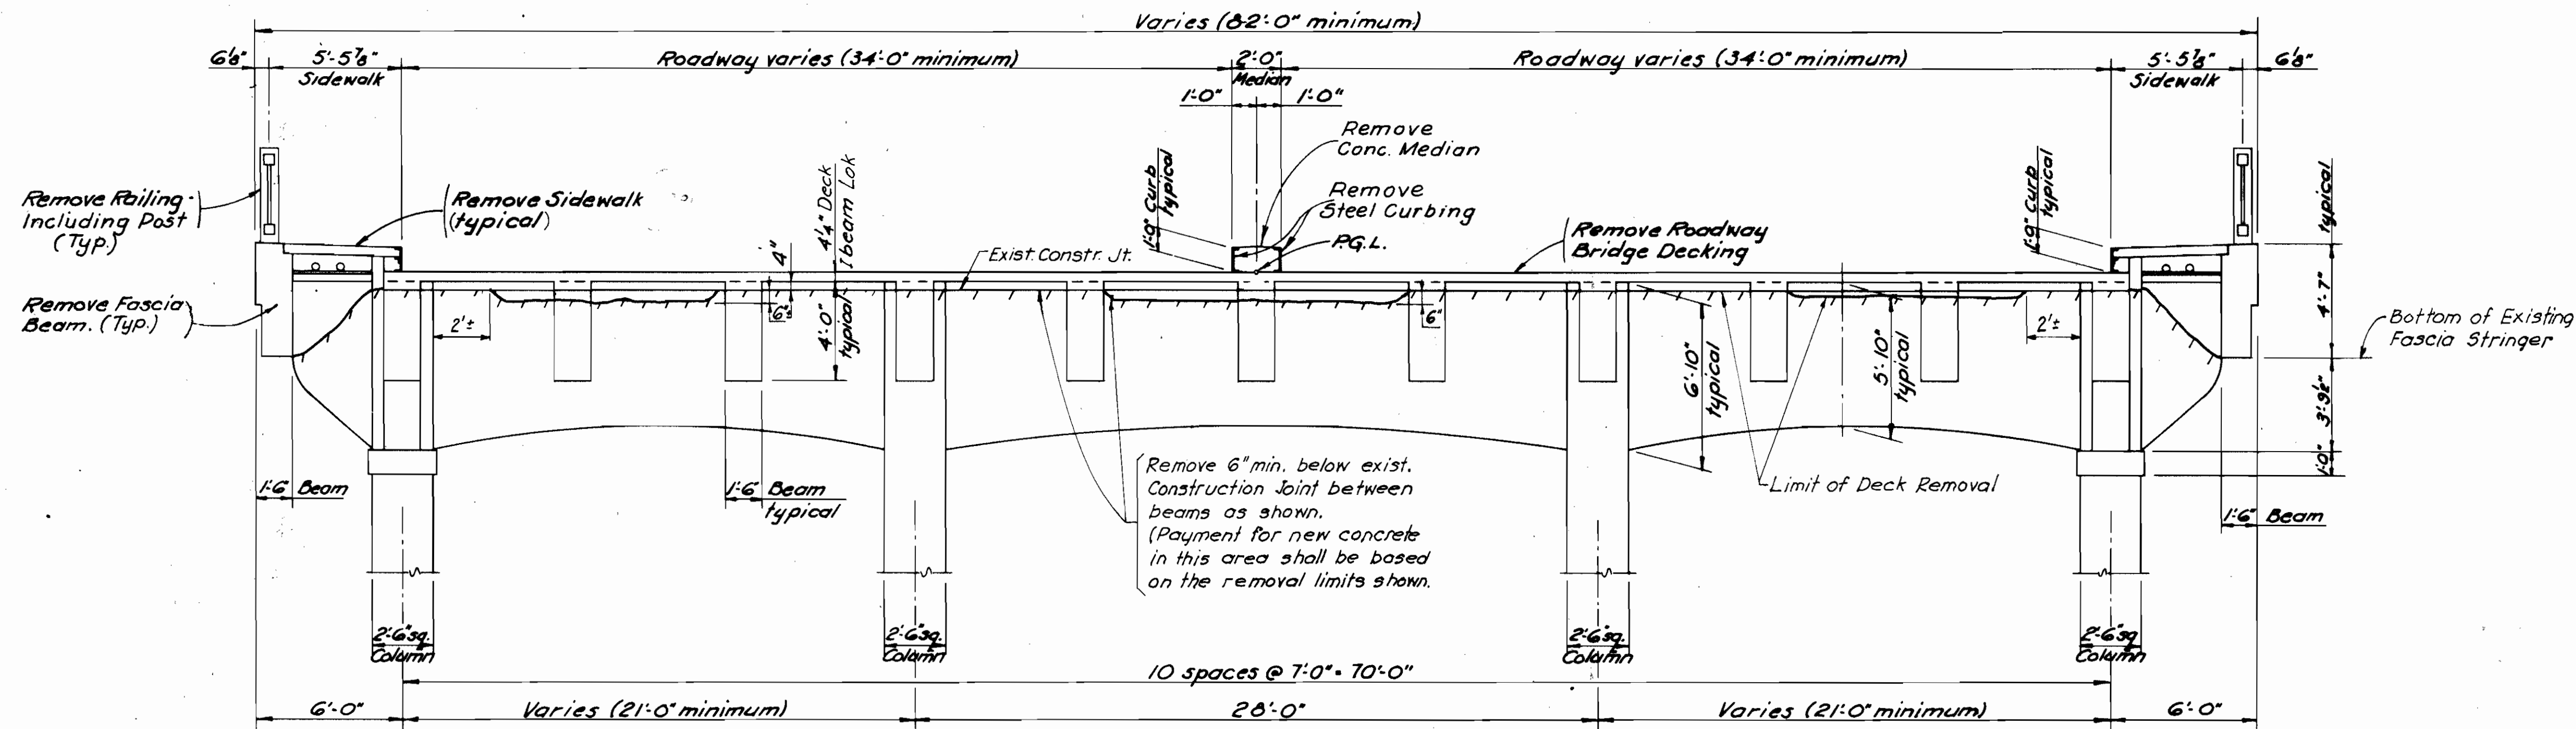

NOTE:  
All Removal shall be paid for Under Item 202, "Portions of Structures Removed".

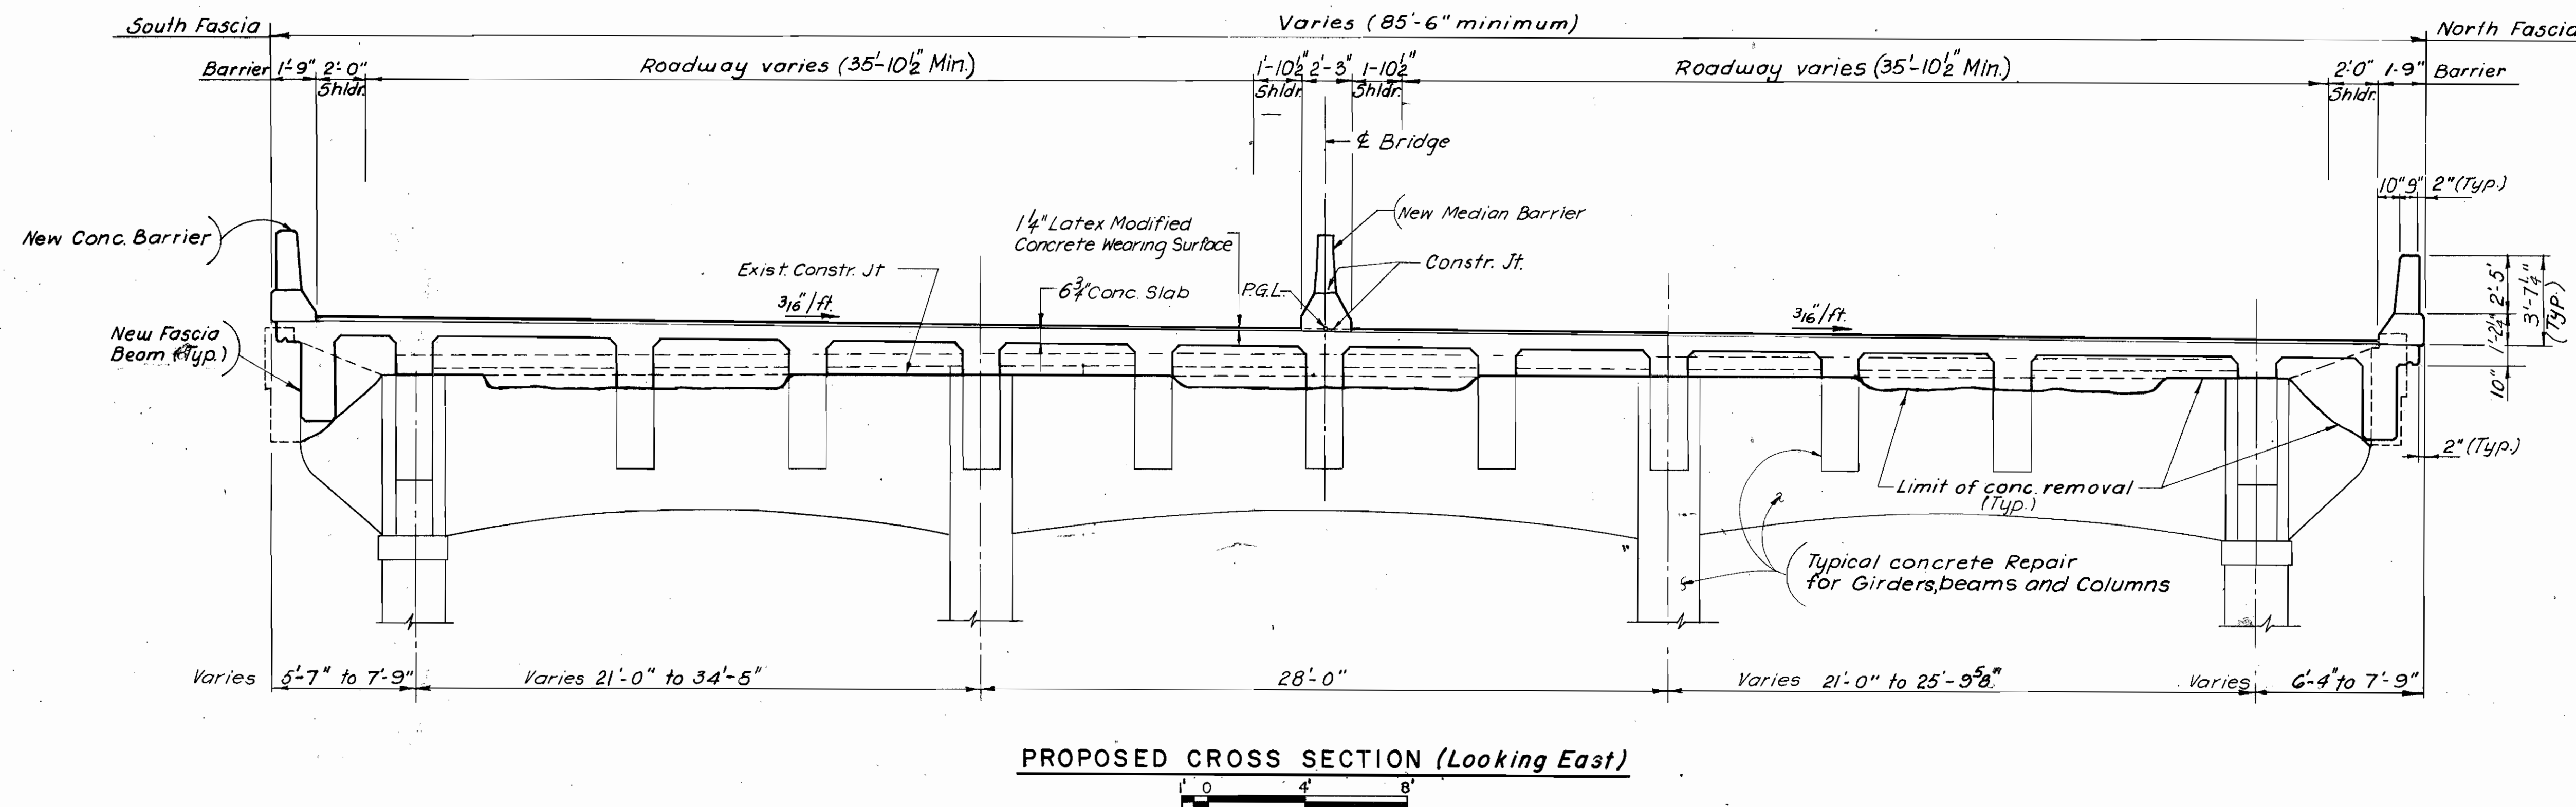

References and Notes See Dwg. No. 179.

PAVLO ENGINEERING CO., P.C.  
NEW YORK, NEW YORK

CUYAHOGA COUNTY ENGINEER  
CLEVELAND OHIO



**MAIN AVENUE BRIDGE**  
CITY OF CLEVELAND  
BRIDGE OVER THE CUYAHOGA RIVER VALLEY

WEST APPROACH—SECTION P  
**TYPICAL CROSS SECTION**

BRIDGE NO. 193 REPORT NO. 7119 DATE Nov. 11, 1989

**NO. B-136** 116  
991

DESIGN AS.	DRAWN RS.	CHECKED C.K.D.	REVISED TO AS BUILT AS BUILT 2/94
------------	-----------	----------------	-----------------------------------

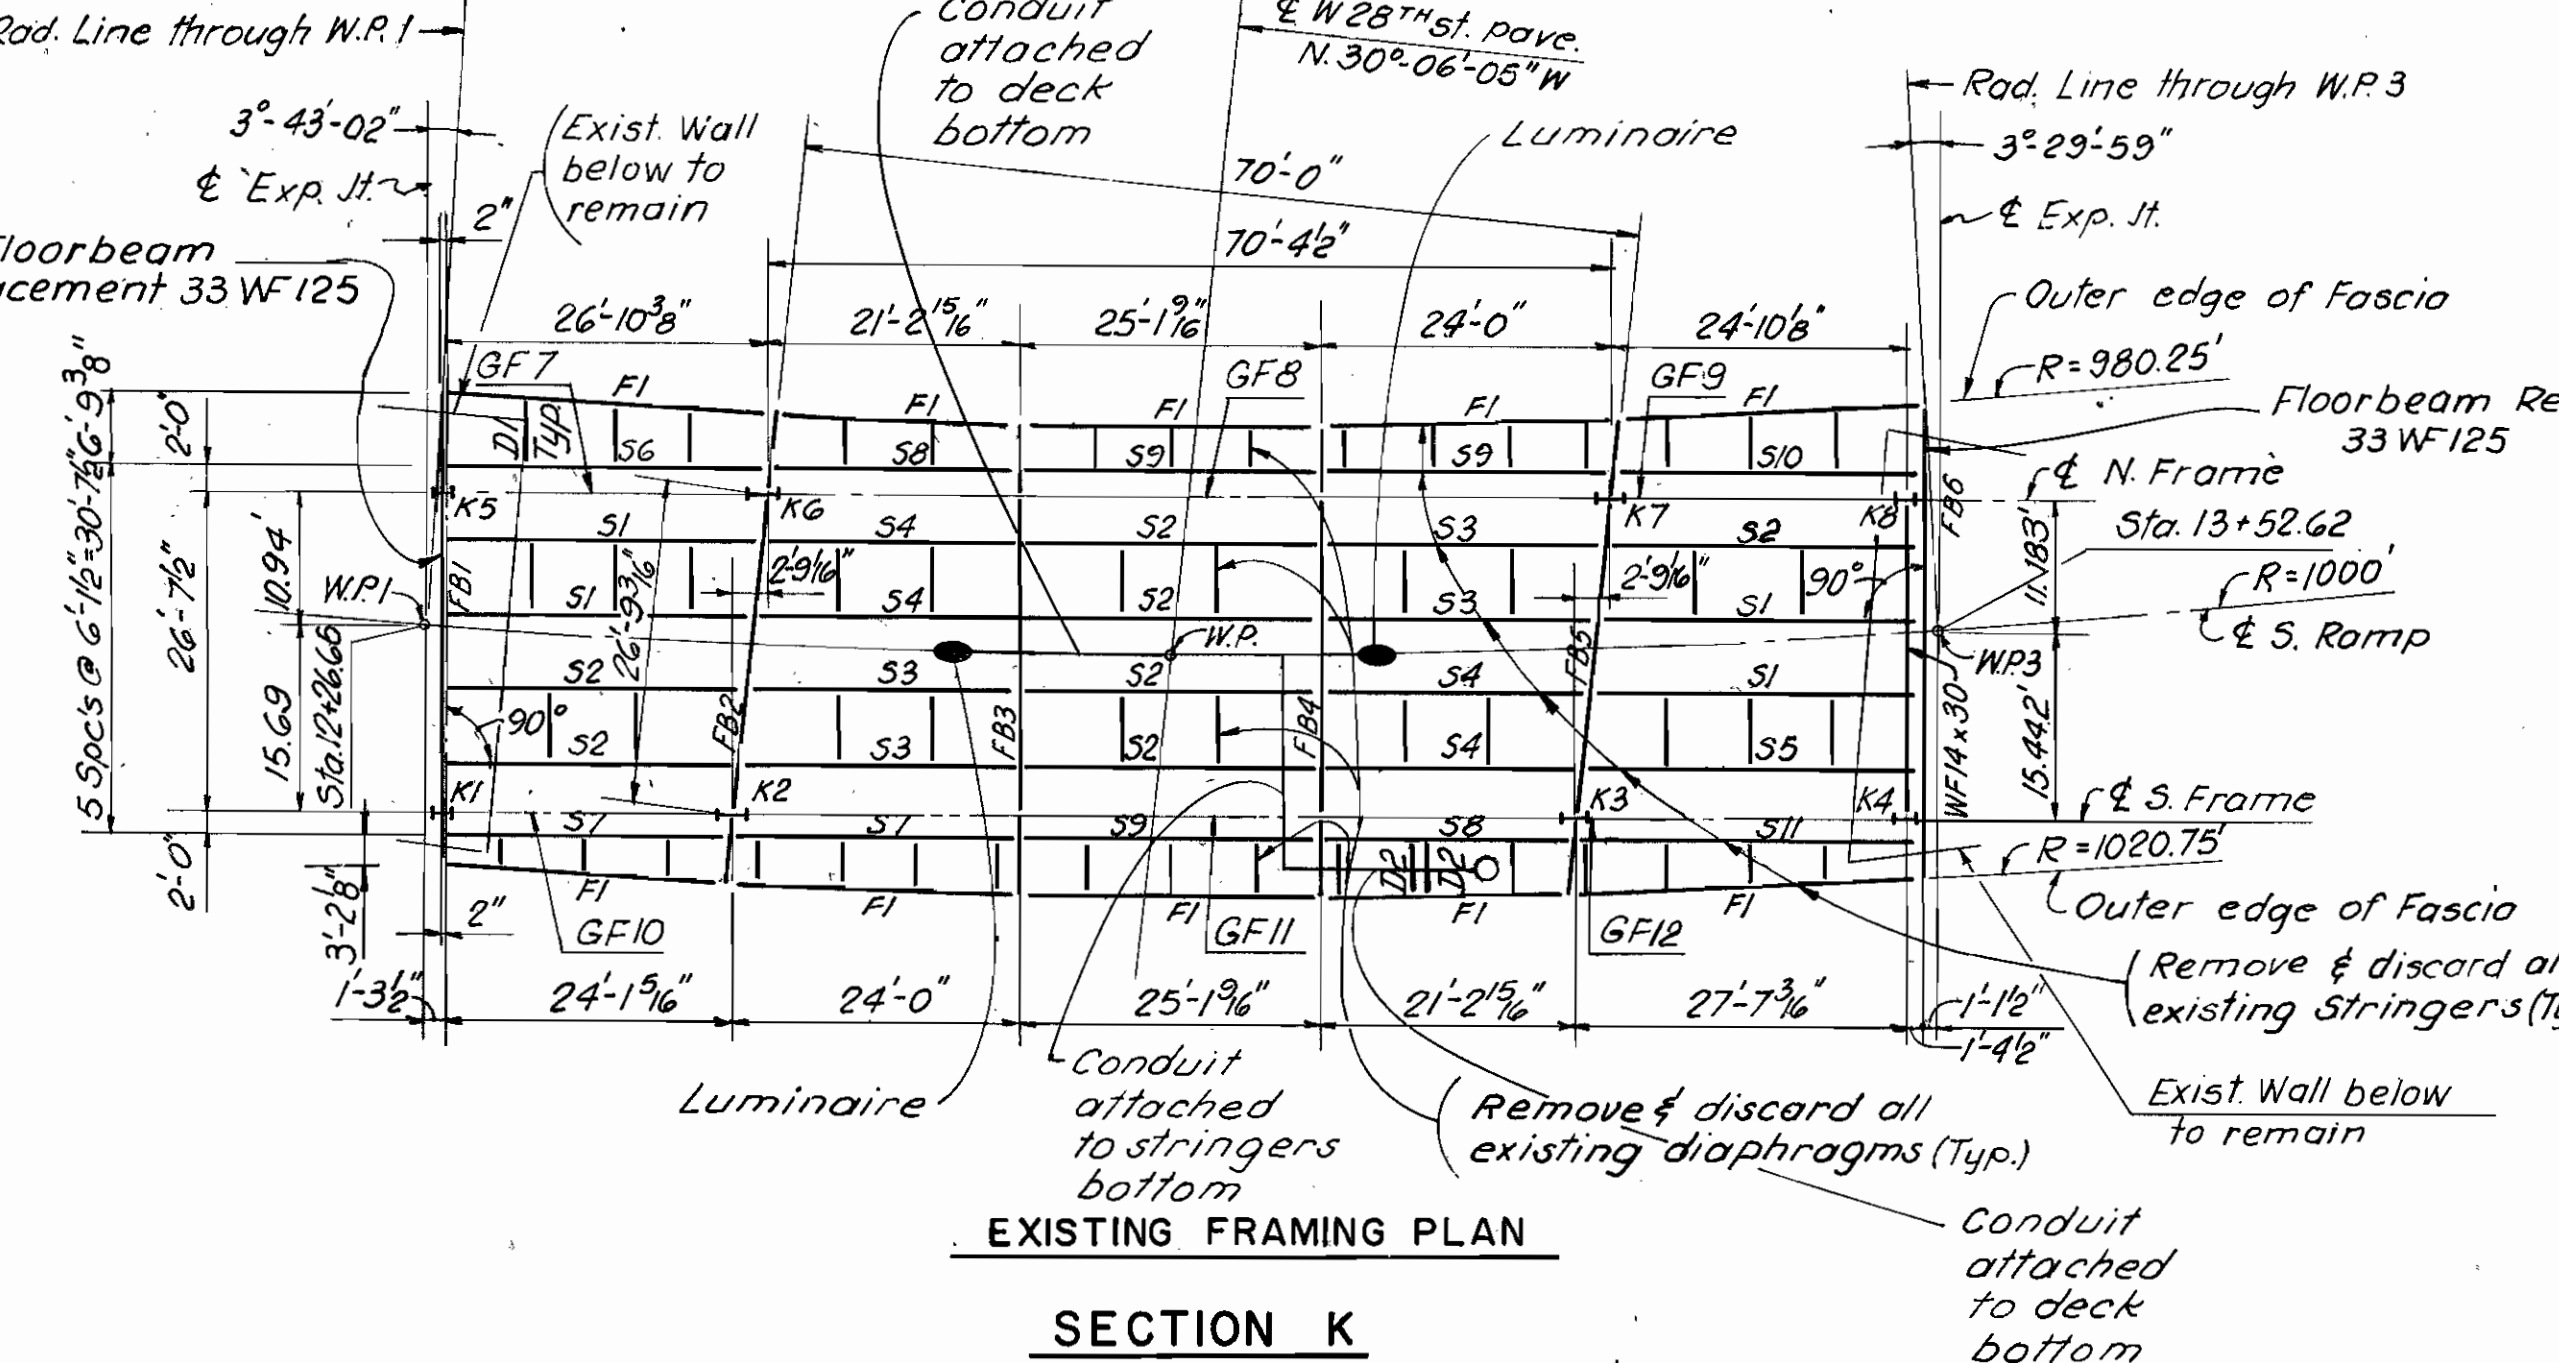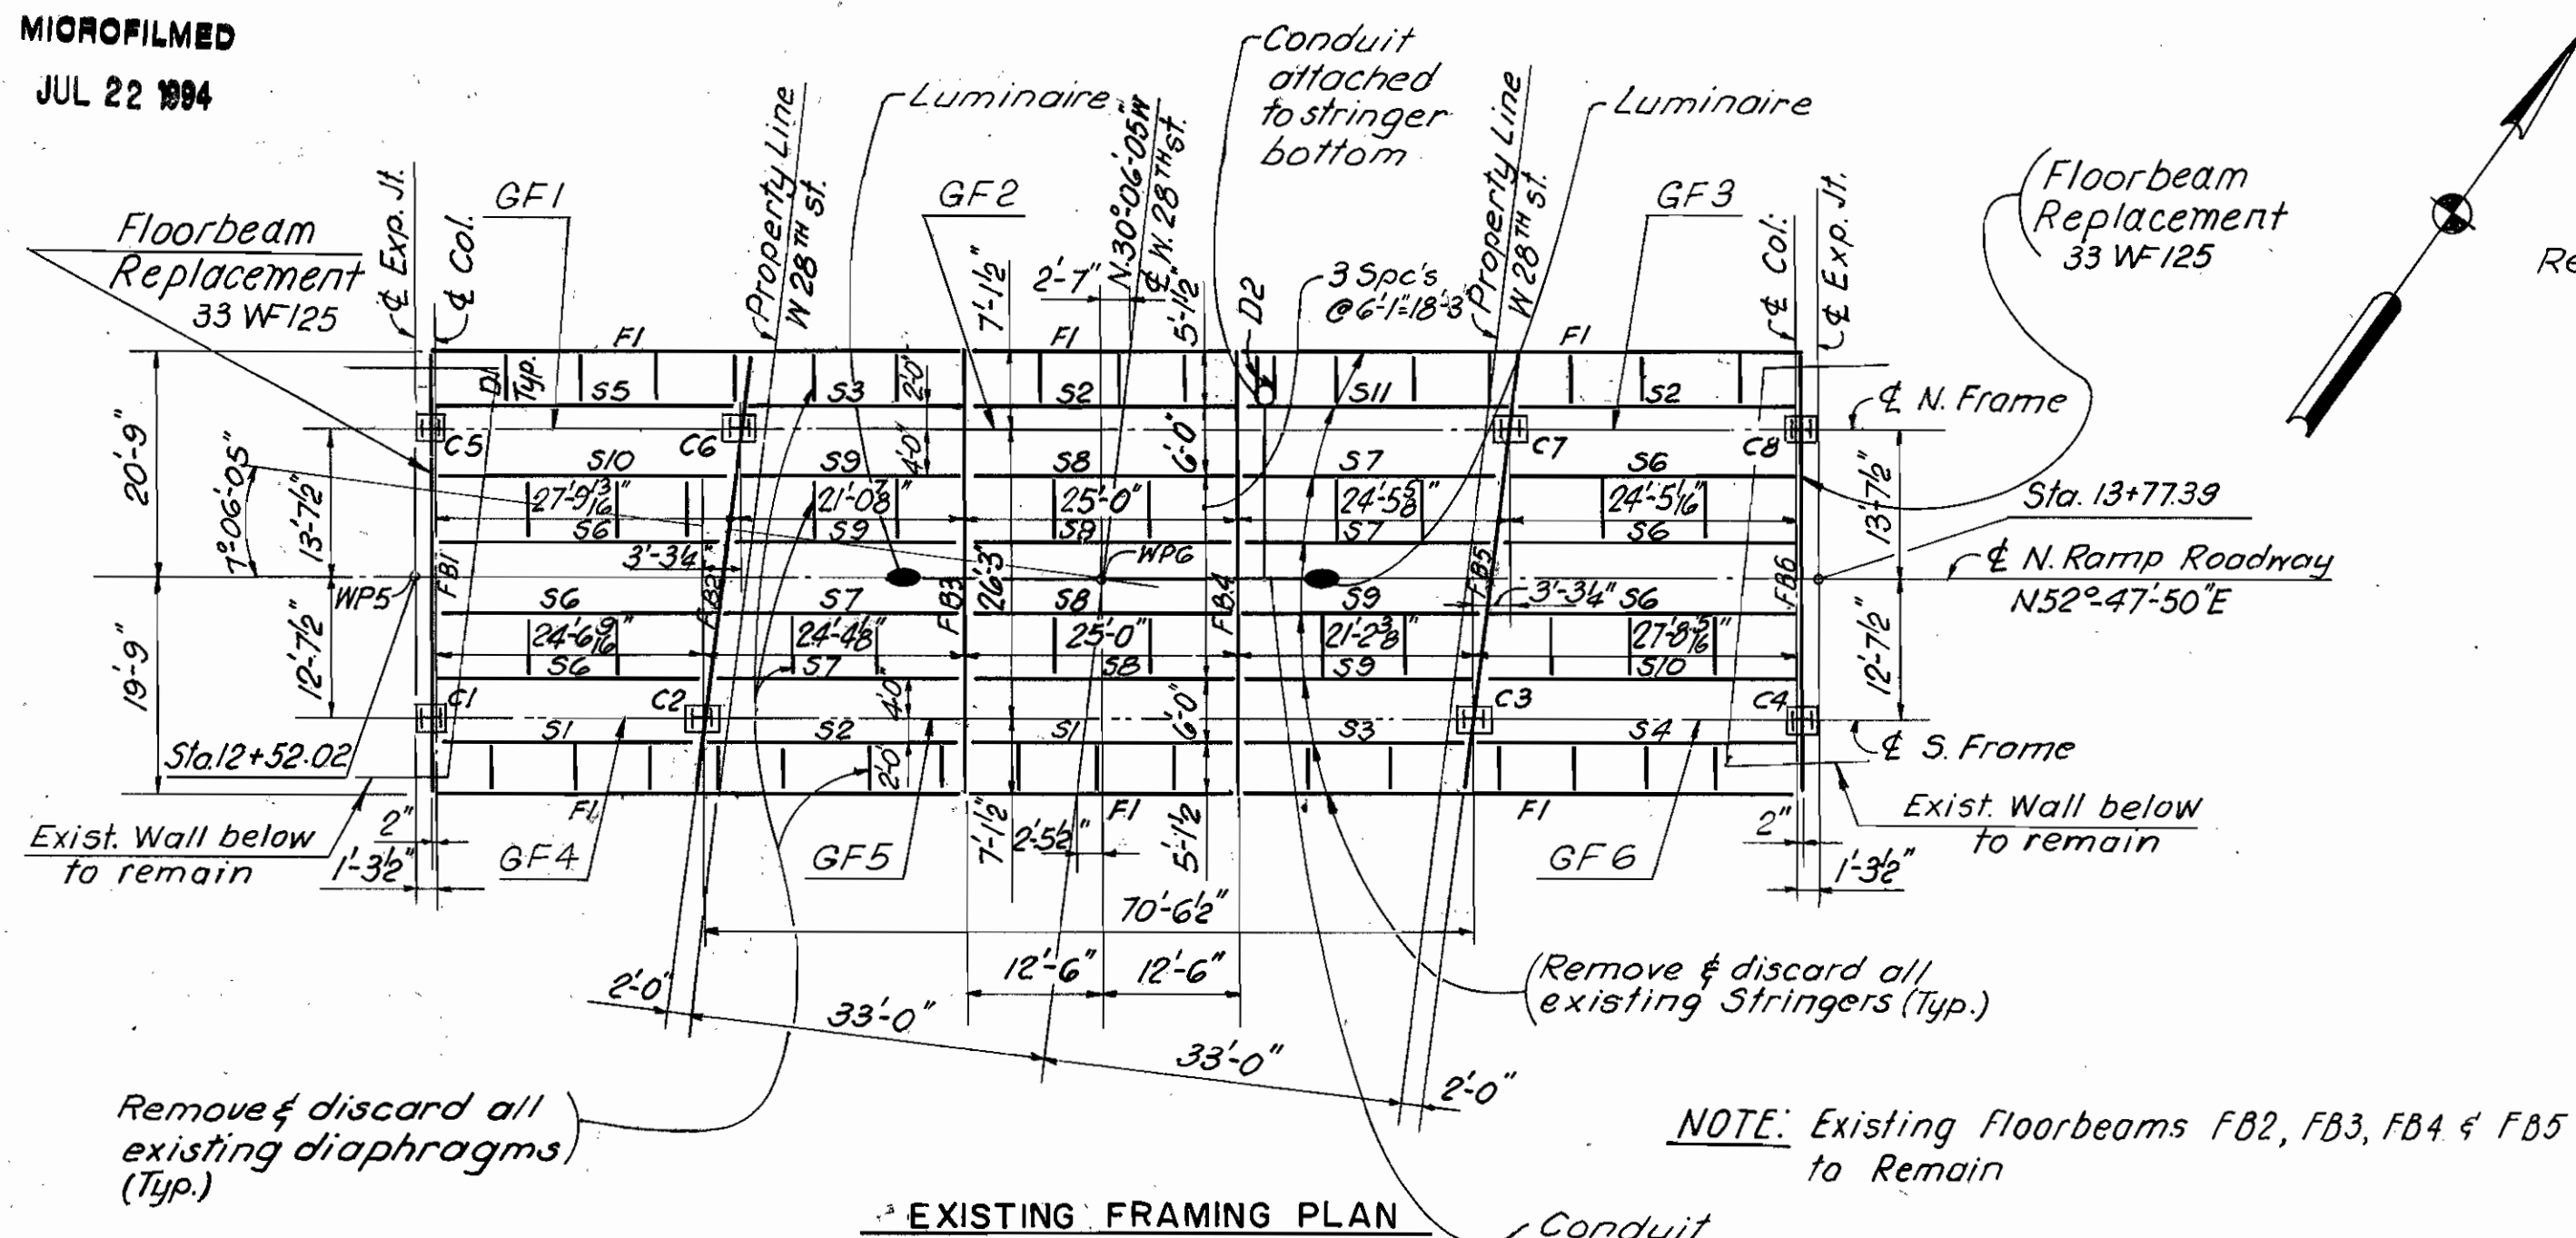

**EXISTING SPAN**

MARK	SECTION C STRINGERS	SECTION K STRINGERS
S1	21W 73	21W 96
S2	21W 69	21W 89
S3	21W 59	21W 82
S4	21W 89	21W 73
S5	21W 82	21W 96
S6	21W 89	21W 96
S7	21W 73	21W 59
S8	21W 82	21W 68
S9	21W 68	21W 73
S10	21W 96	21W 89
S11	21W 63	21W 68



**DIAPHRAGMS**

D1	10 W 33
D2	8 W 17 (at Lamppost)

**FASCIAS**

FI	1-2-18 x 3/8
	1-L-4 x 3 x 3/8
	1-Z-3 x 2 1/8 x 3/8
	1-2-24 x 3/8
	1-L-4 x 3 1/2 x 3/8

Note: For Existing Underbridge Lighting see General Notes. Existing Underbridge Lighting.

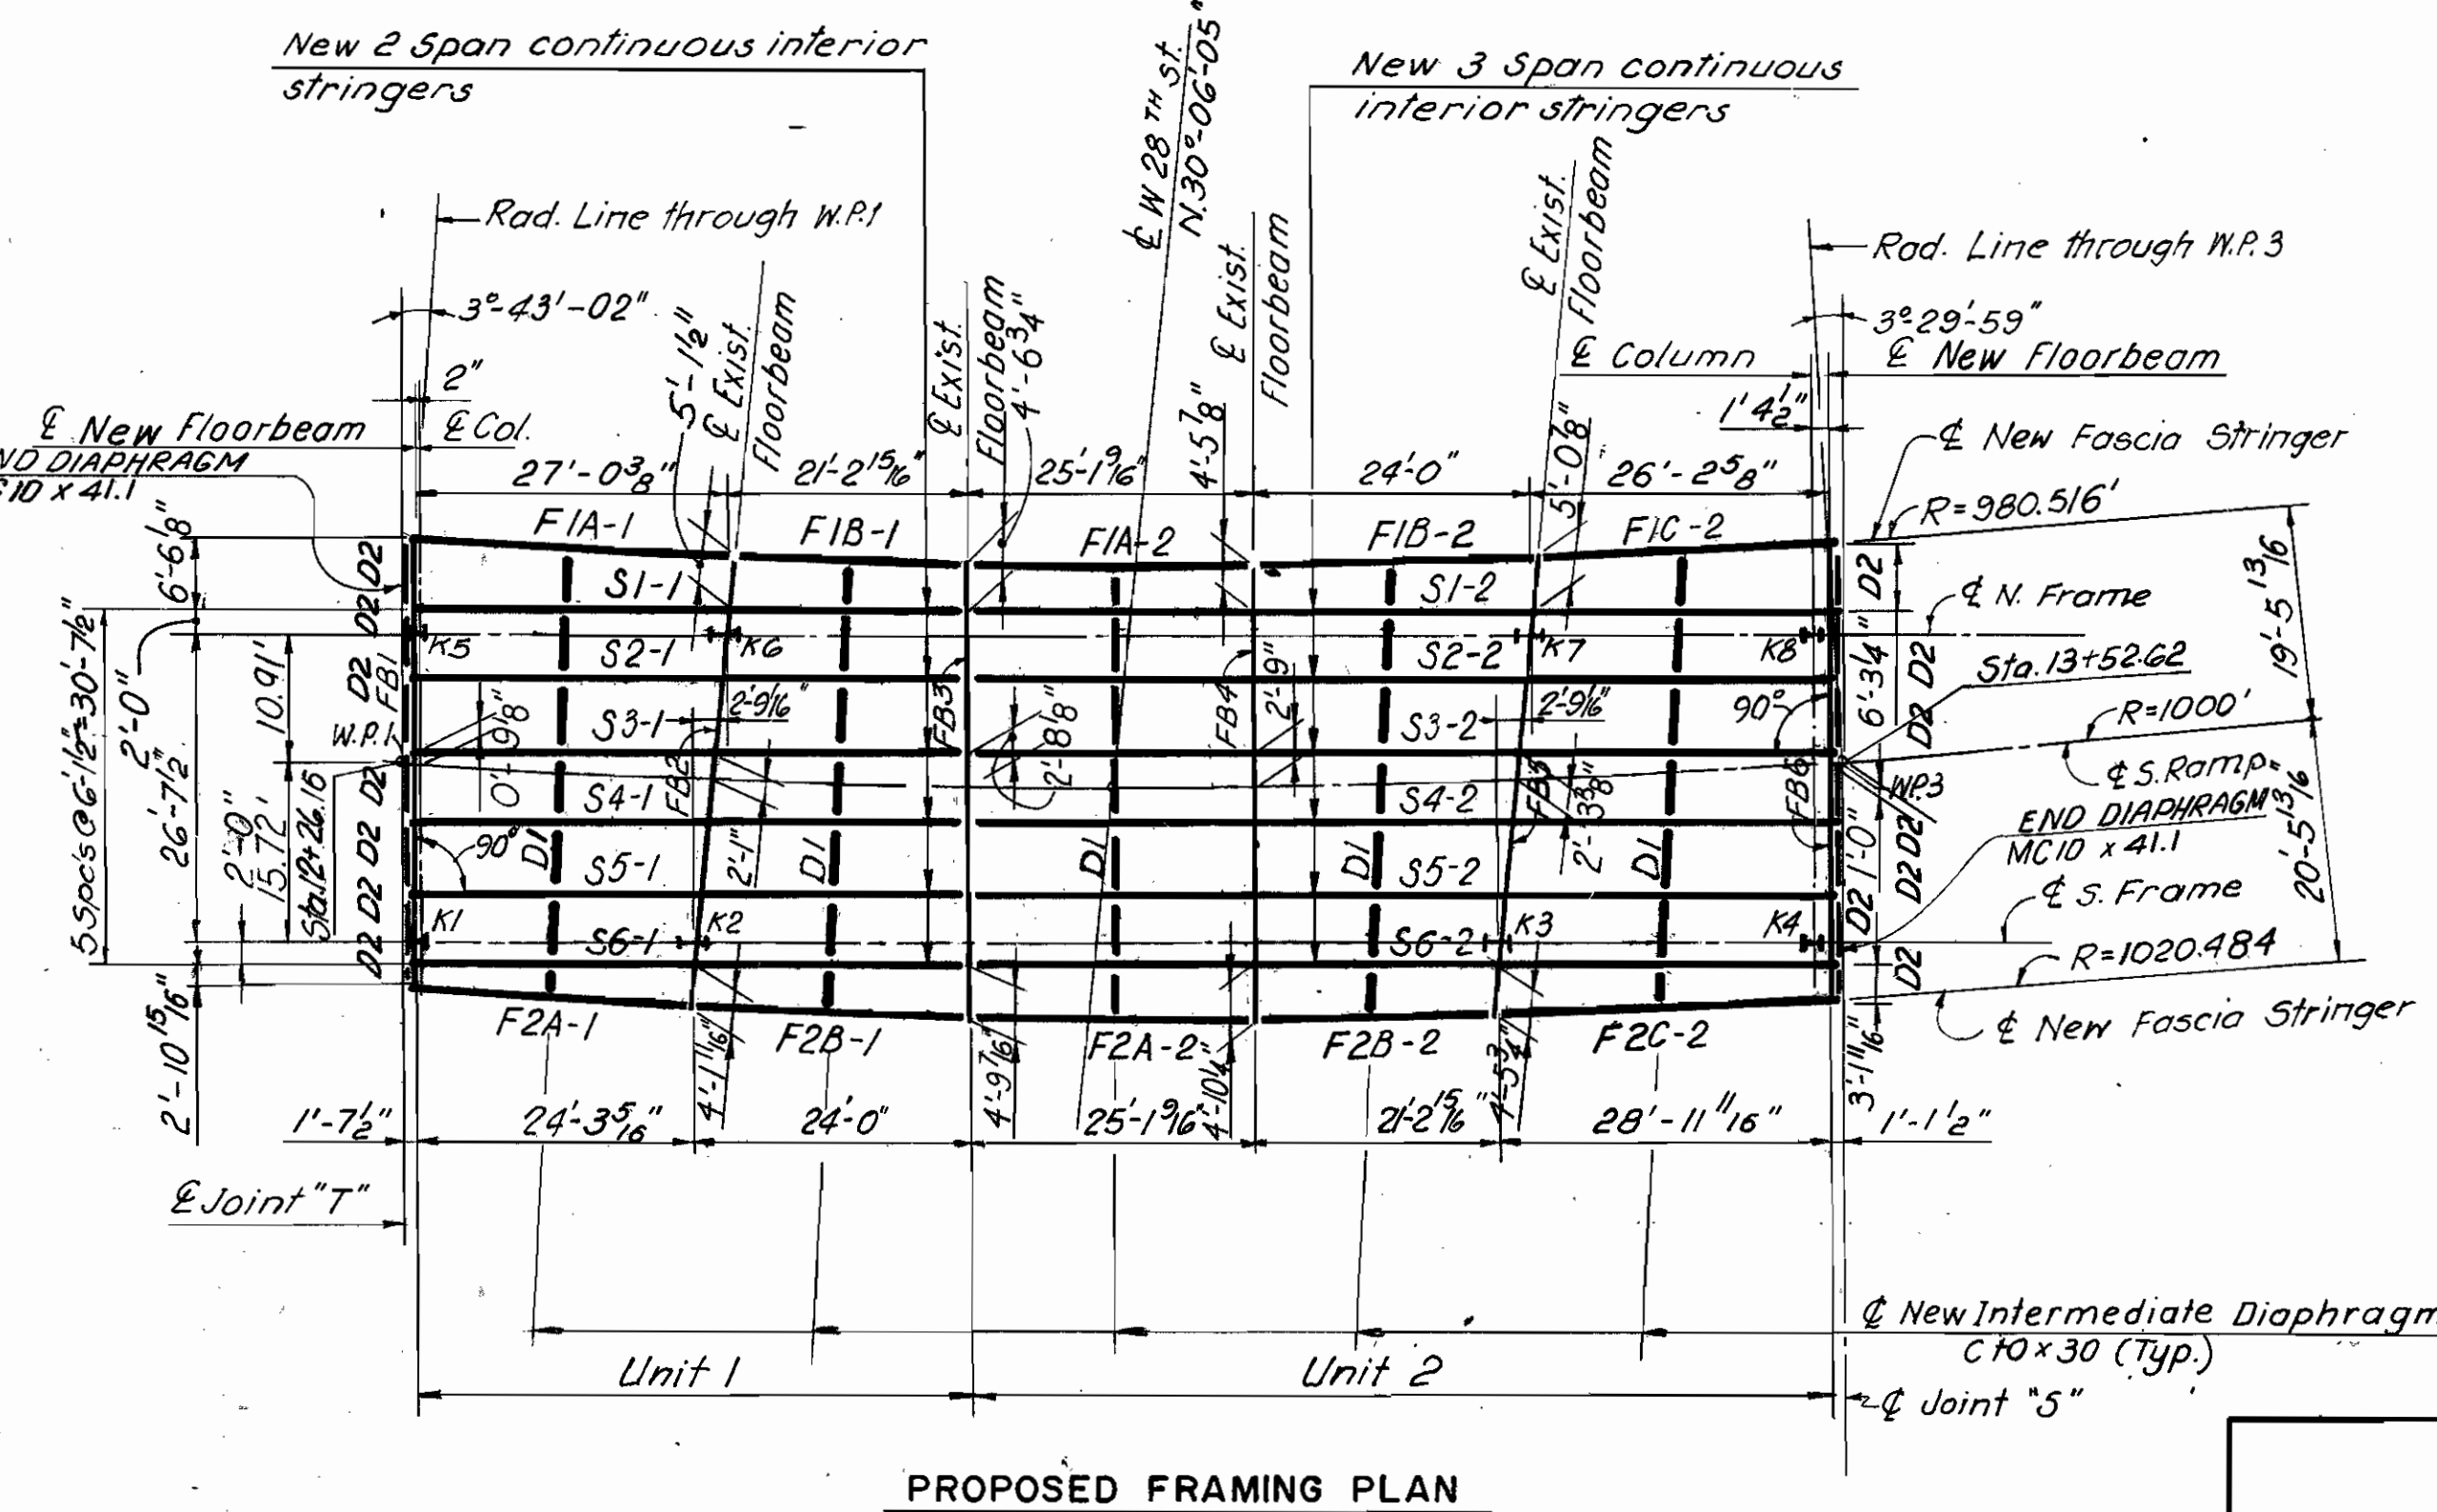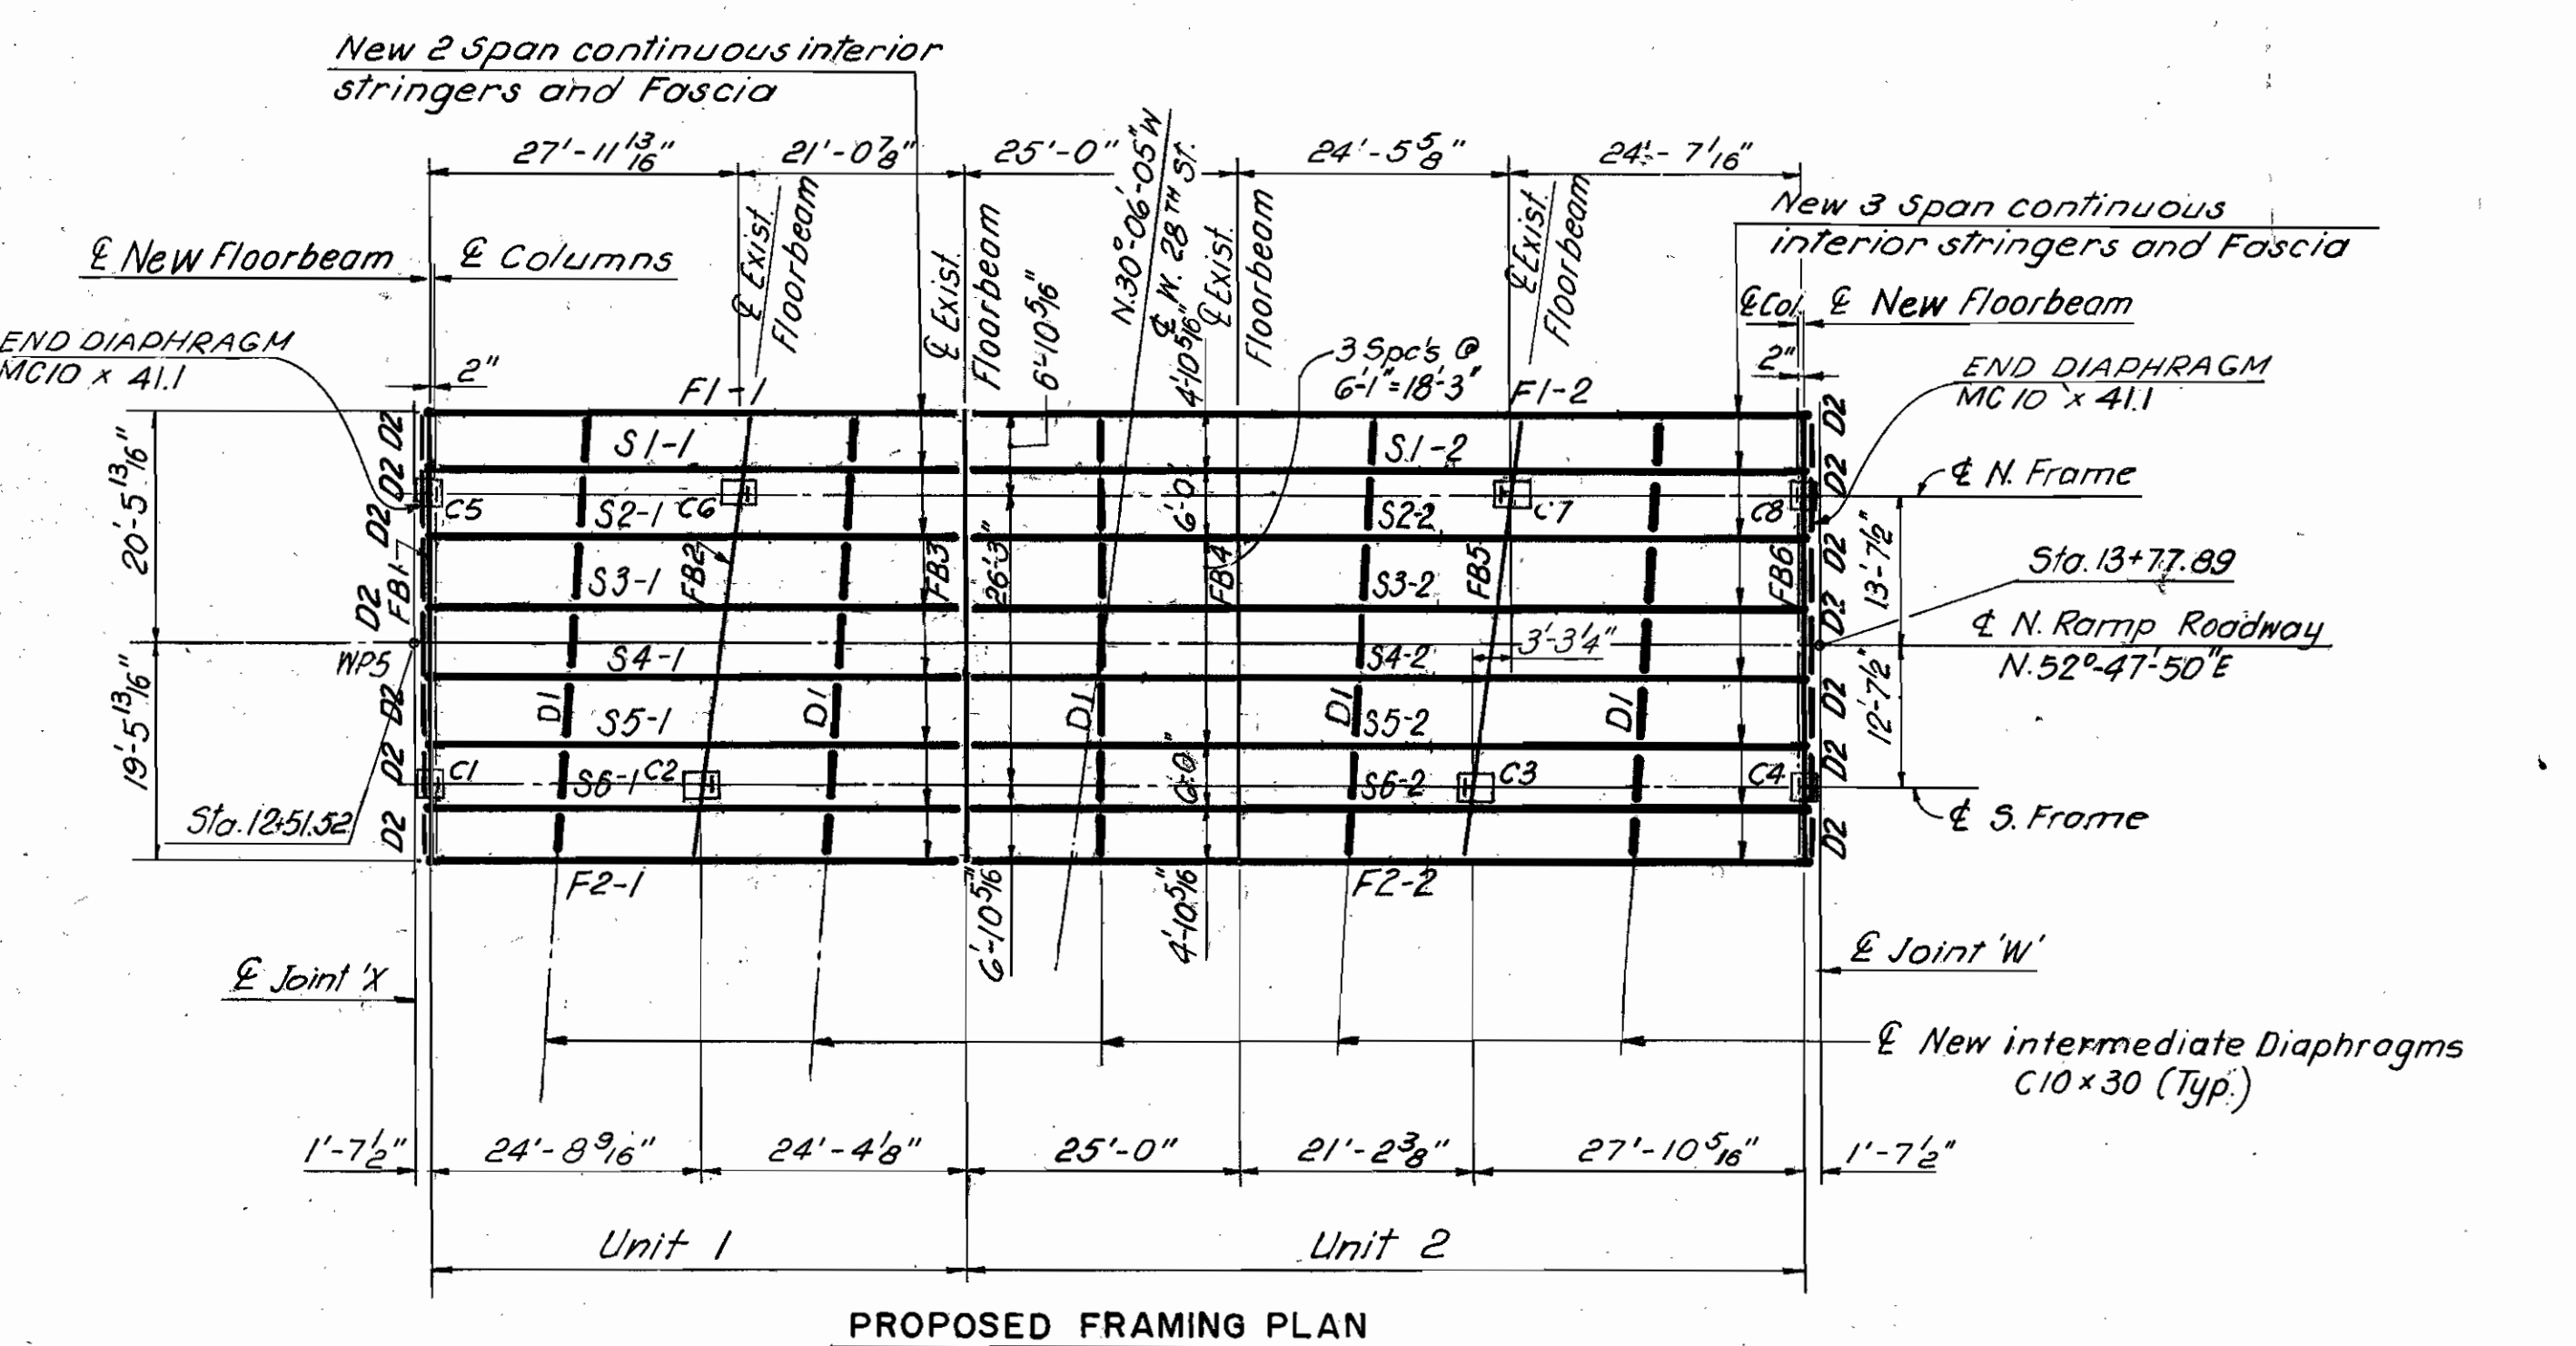


- Notes:**
- All new stringers shall be installed vertical
  - For finishing machine support notes, see Dwg. 69
  - Welding of attachments shall not be permitted in the tension zone of the stringers.
  - Tension zone is 4'-0" each side of interior supports.
  - All new Rolled Beams, Shapes and Plates shall be ASTM A36, AISC Category I
  - All new Welded members including Fascia Stringers, Replacement Floor Beams, and Brackets shall be ASTM A36, AISC Category III

Note:  $\phi$  of new intermediate diaphragms between Floorbeams to be located at the midpoints of the various fascia stringer elements.

**REFERENCES**

Floor Beam Replacements	155
Typical Cross Sections	112 & 113
Stringer Details	158
Stringer Schedules	160
CVN Note	105
Existing Underbridge Lighting	B20

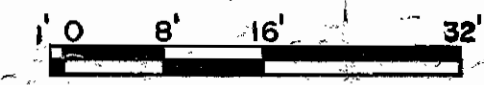

PAVLO ENGINEERING CO., P.C.  
NEW YORK, NEW YORK

**CUYAHOGA COUNTY ENGINEER**  
CLEVELAND OHIO

**MAIN AVENUE BRIDGE**  
CITY OF CLEVELAND  
BRIDGE OVER THE CUYAHOGA RIVER VALLEY

WEST APPROACH SECTION C & K  
**EXISTING & PROP. FRAMING PLAN**

BRIDGE NO. 193 REPORT NO. 7119 DATE Nov. 11, 1983

**NO. B-136** 147  
991


DESIGN	DRAWN	CHECKED	REVISED TO AS BUILT
B.G.	L.T.	R.D.M.	AS BUILT 2/94

MICROFILMED  
JUL 22 1994


FHWA REGION	STATE	PROJECT
5	OHIO	BHF - 73 (51)

146  
547

CUYAHOGA COUNTY  
CUY - 2-14.66

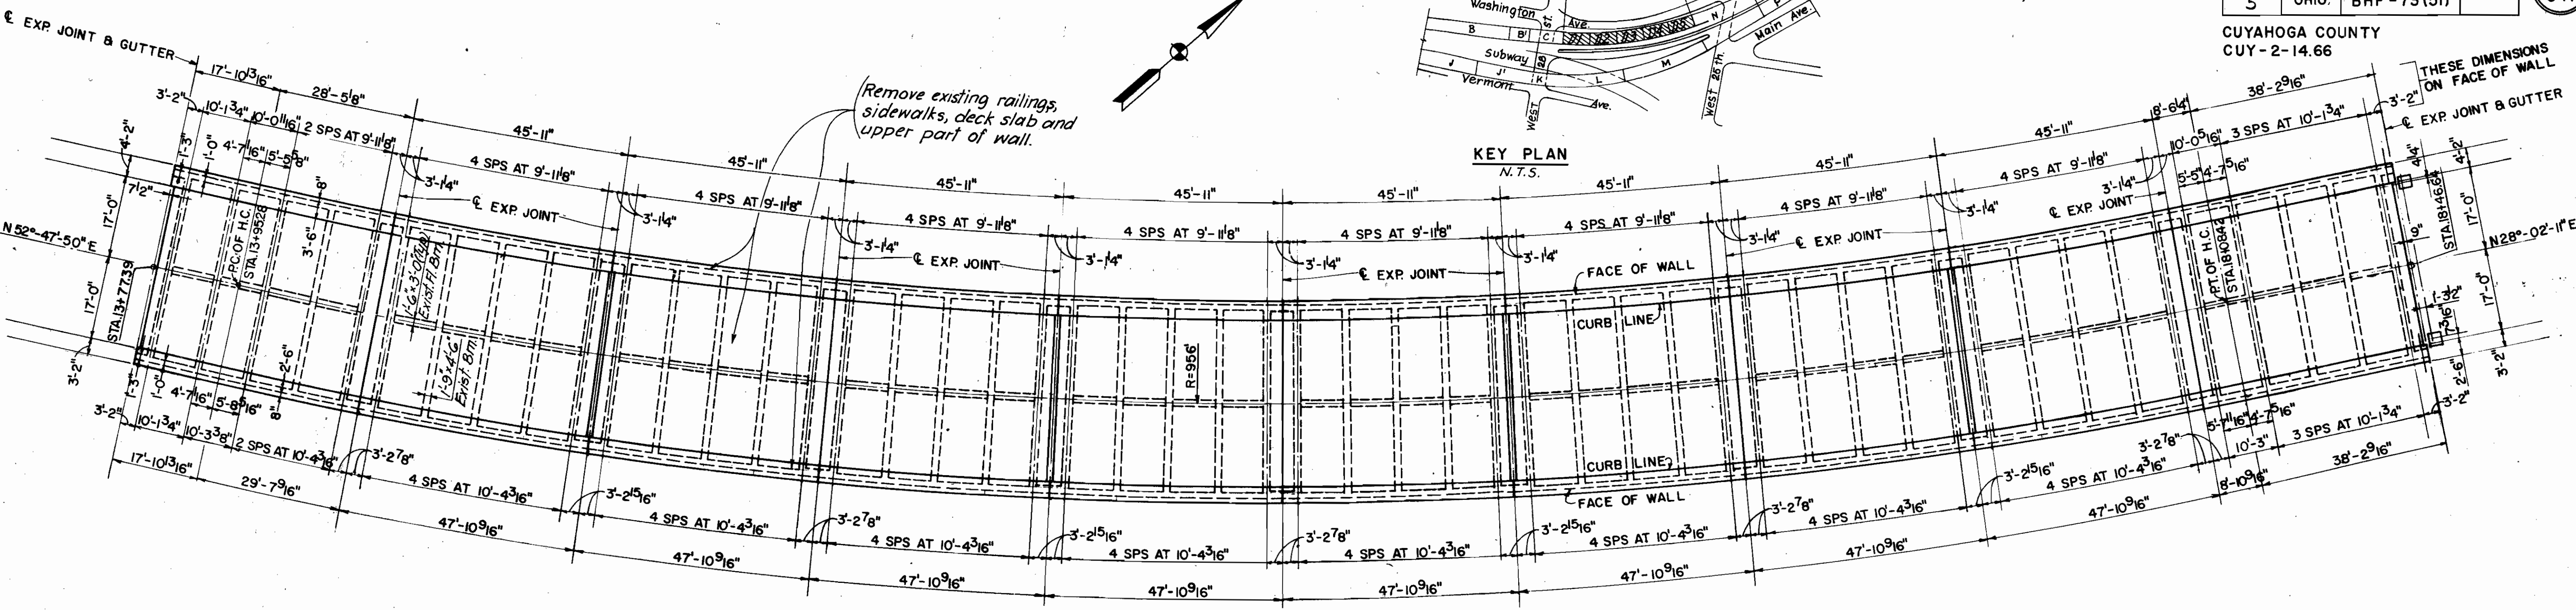


EXISTING DECK PLAN

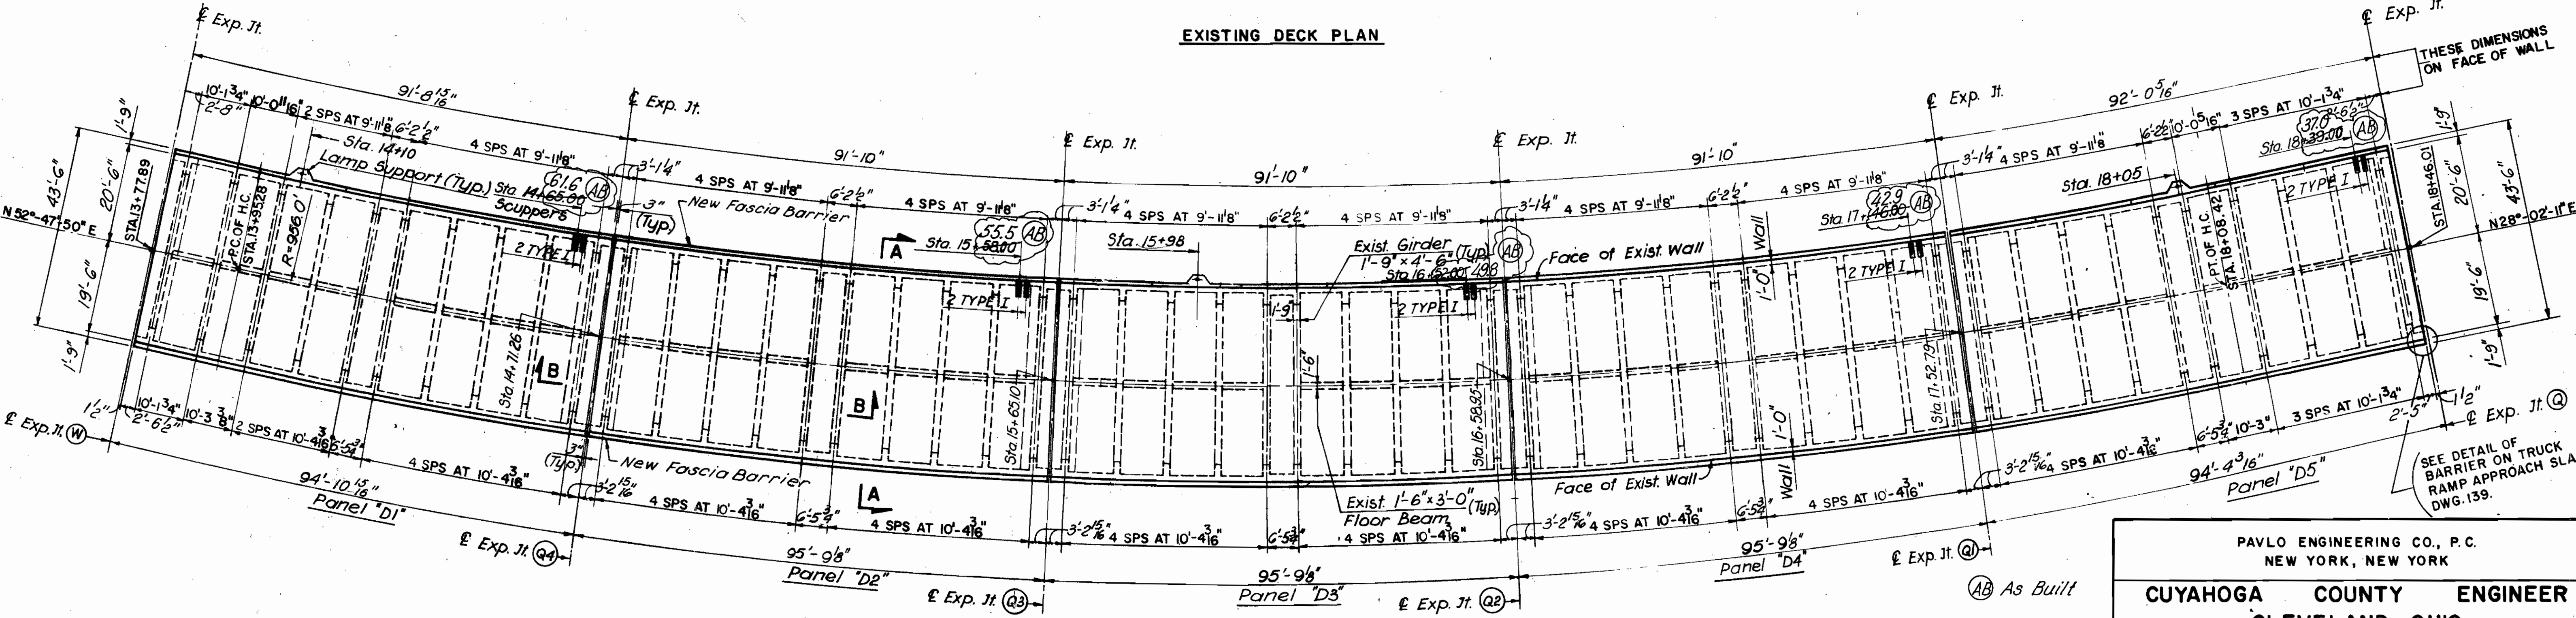

PROPOSED DECK PLAN

SECTION D

Remove existing railings, sidewalks, deck slab and upper part of wall.

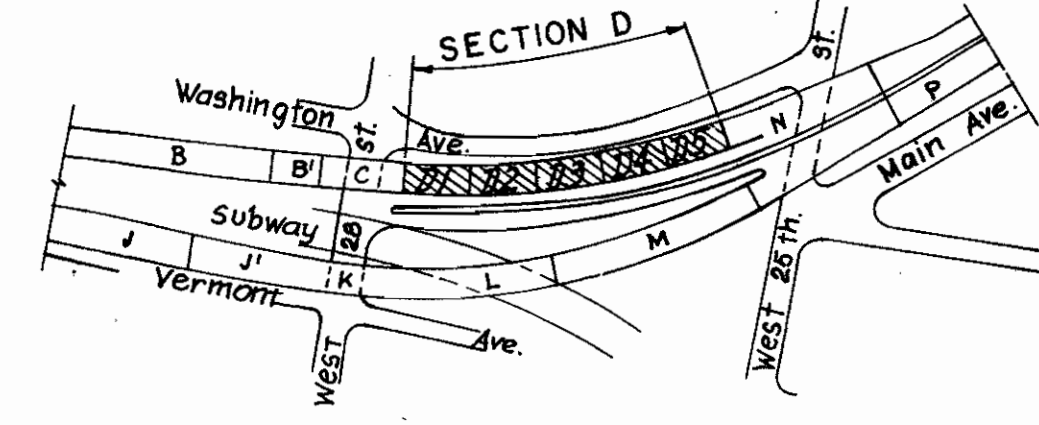


KEY PLAN  
N.T.S.

NOTE:  
For notes 1 to 4 see Dwg. 145


REFERENCES  
 Sections A-A & B-B  
 Summary of concrete repairs.  
 Expansion Joints  
 Scupper Details

DWG. NO.  
 173  
 190  
 191 & 194  
 654 & 655

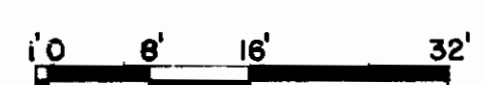


PAVLO ENGINEERING CO., P.C. NEW YORK, NEW YORK			
CUYAHOGA COUNTY ENGINEER CLEVELAND OHIO			
MAIN AVENUE BRIDGE CITY OF CLEVELAND BRIDGE OVER THE CUYAHOGA RIVER VALLEY			
WEST APPROACH - SECTION D EXIST. & PROP. DECK PLAN			
BRIDGE NO. 193	REPORT NO. 7119	DATE Nov. 11, 1989	
NO. B-136			148 991
DESIGN R.R./A.S.	DRAWN J.H.	CHECKED C.K.D.	REVISED TO AS BUILT AS BUILT 2/94



CUYAHOGA COUNTY  
CUY-2-14.66

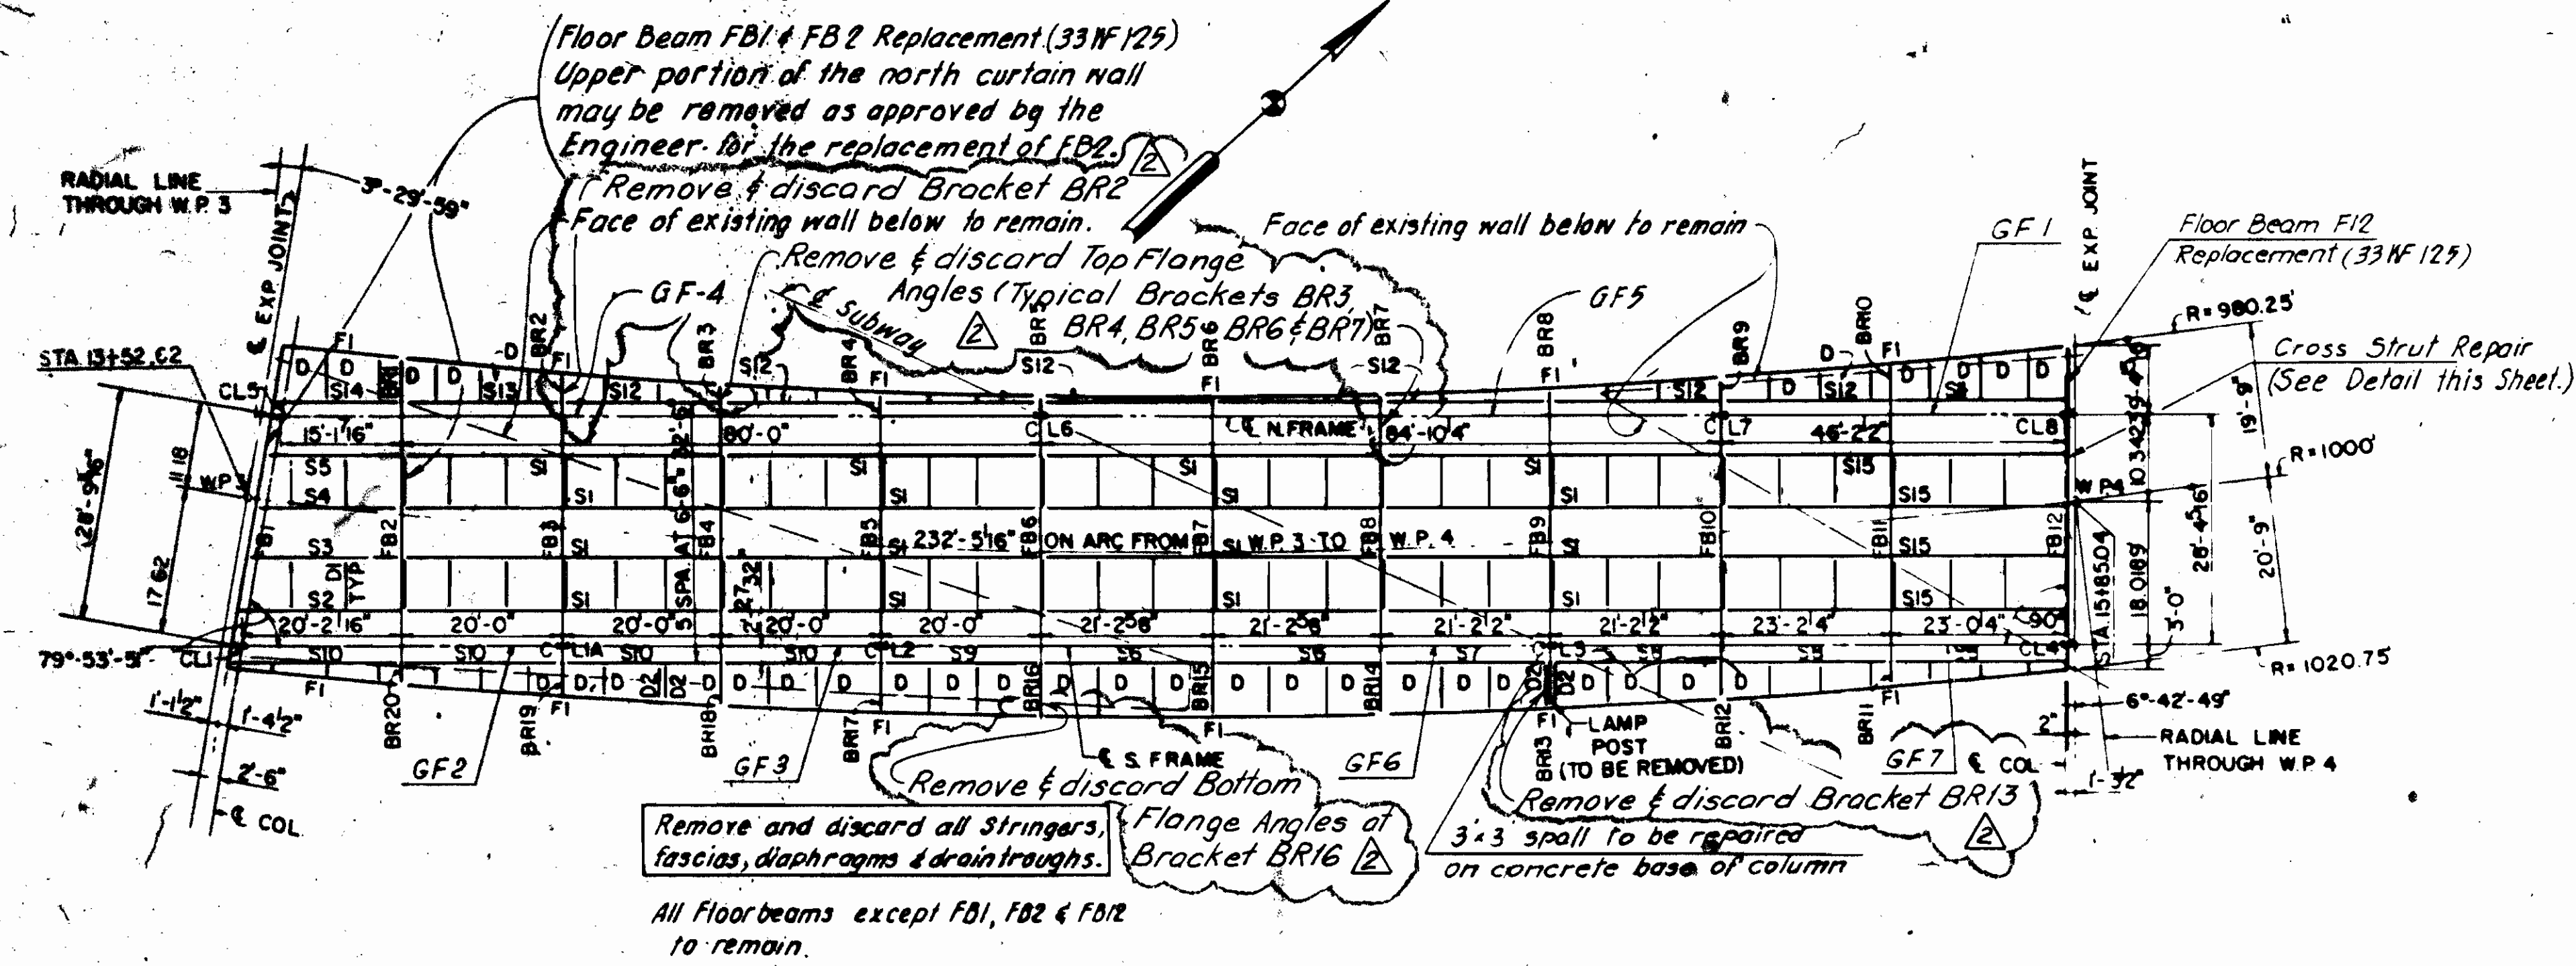

MARK	STRINGERS OF EXISTING SPAN
S1	W21x59
S2	W21x68
S3	W21x68
S4	W21x63
S5	W21x59
S6	W21x73
S7	W21x68
S8	W21x59
S9	W21x63
S10	W21x59
S11	W21x73
S12	W21x59
S13	W21x59
S14	W21x59
S15	W21x63

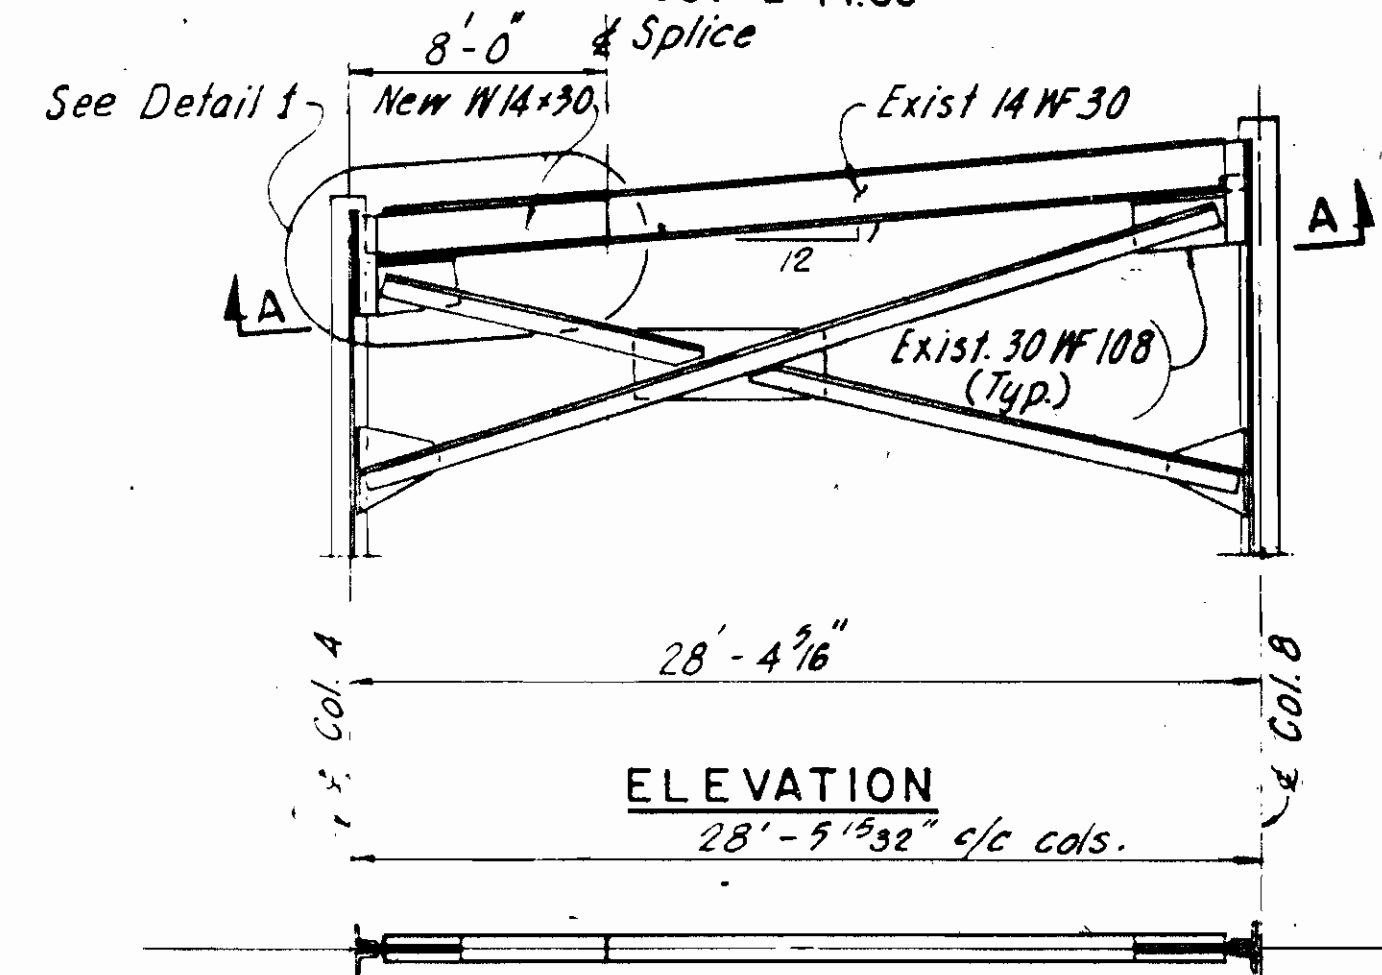

**COLUMN NOTE**  
The following Columns were found to be out of proper alignment during surveys done prior to Nov. 1988:  
CL1, CL1A & CL2.  
All out of plumb columns shall be aligned within 1/4" of vertical.

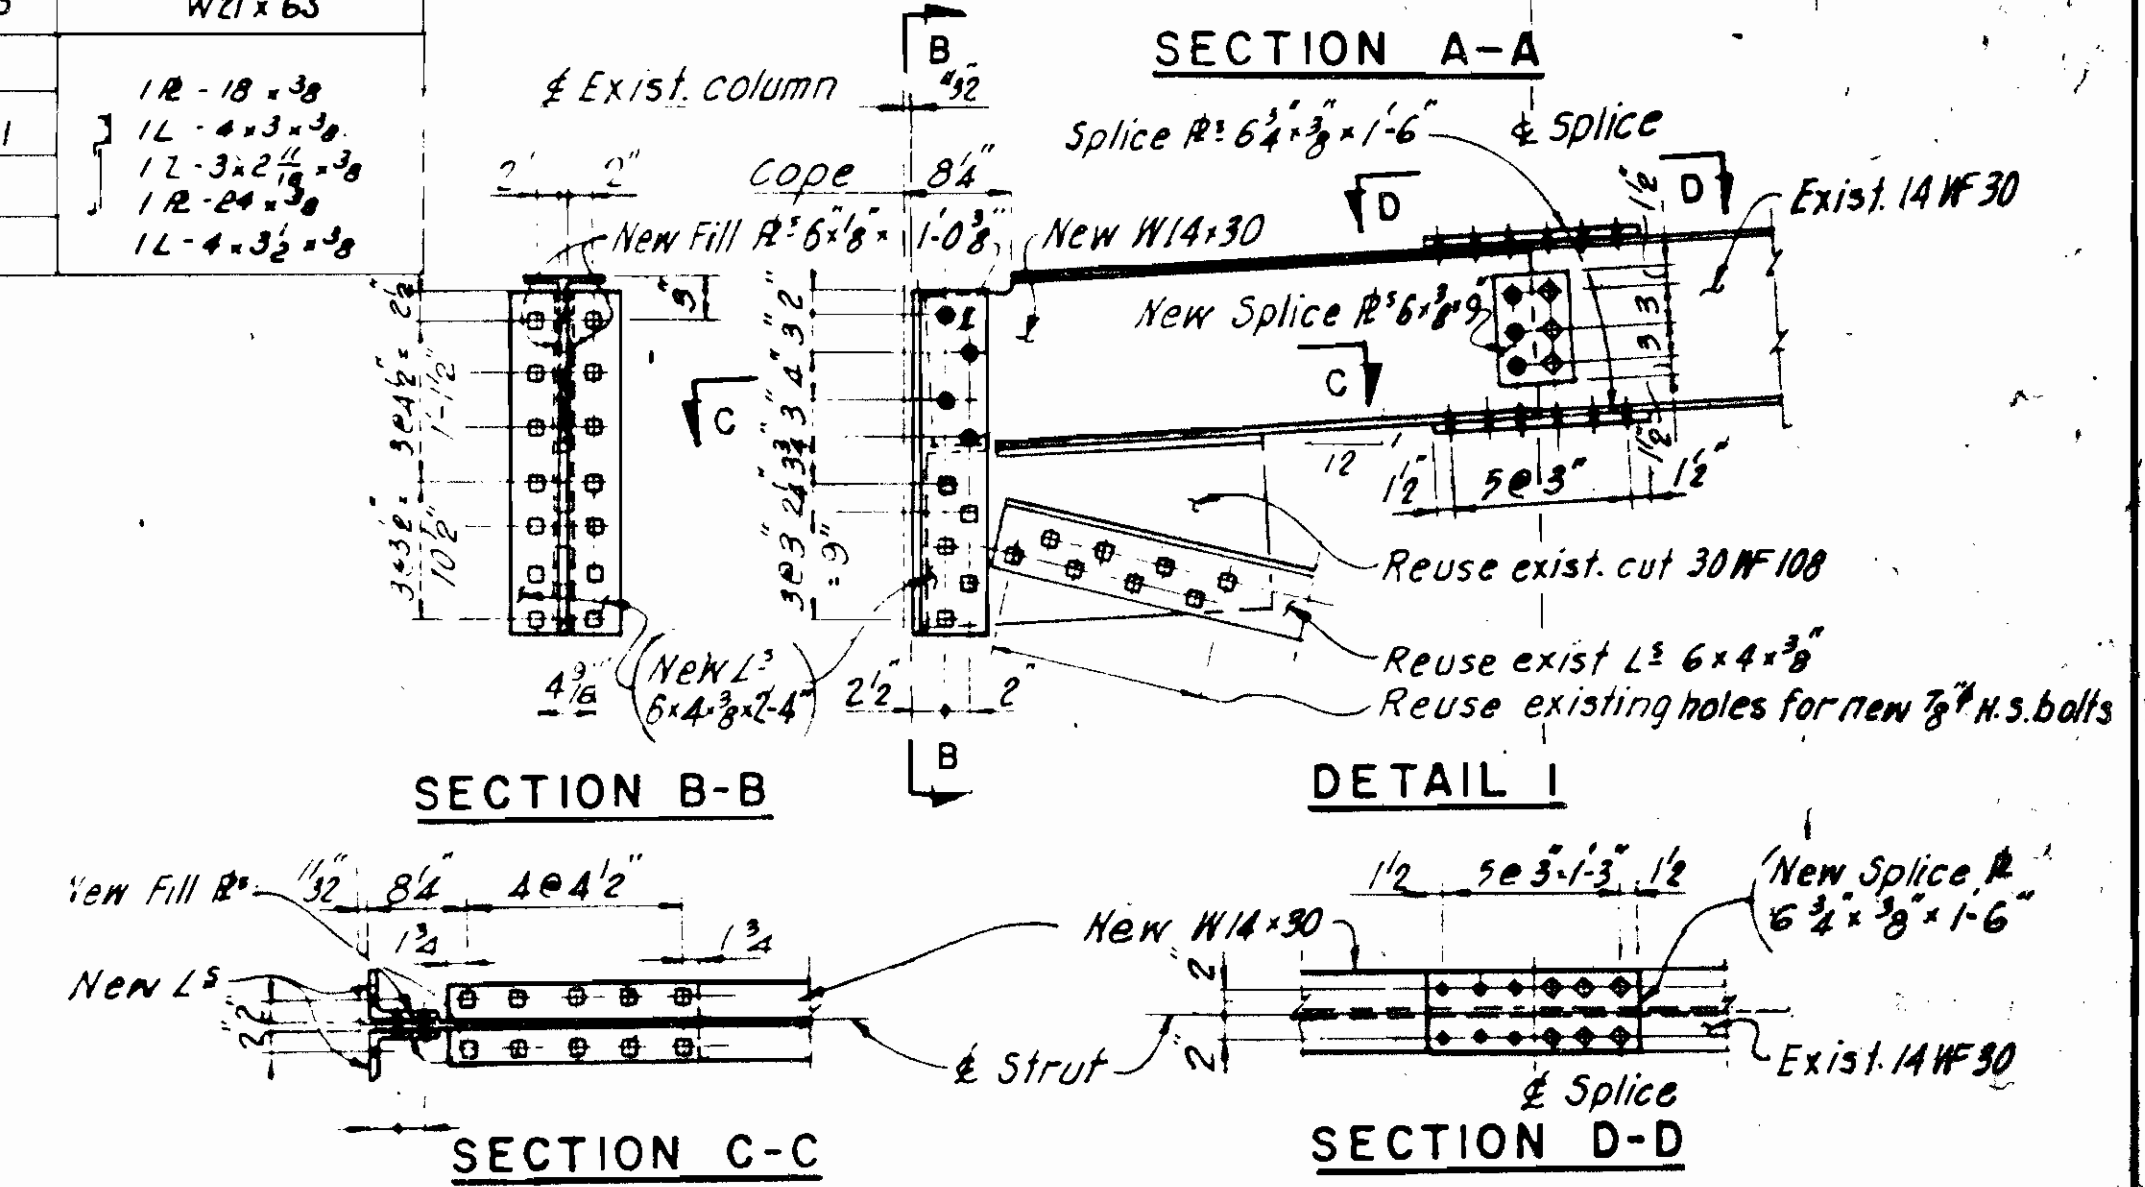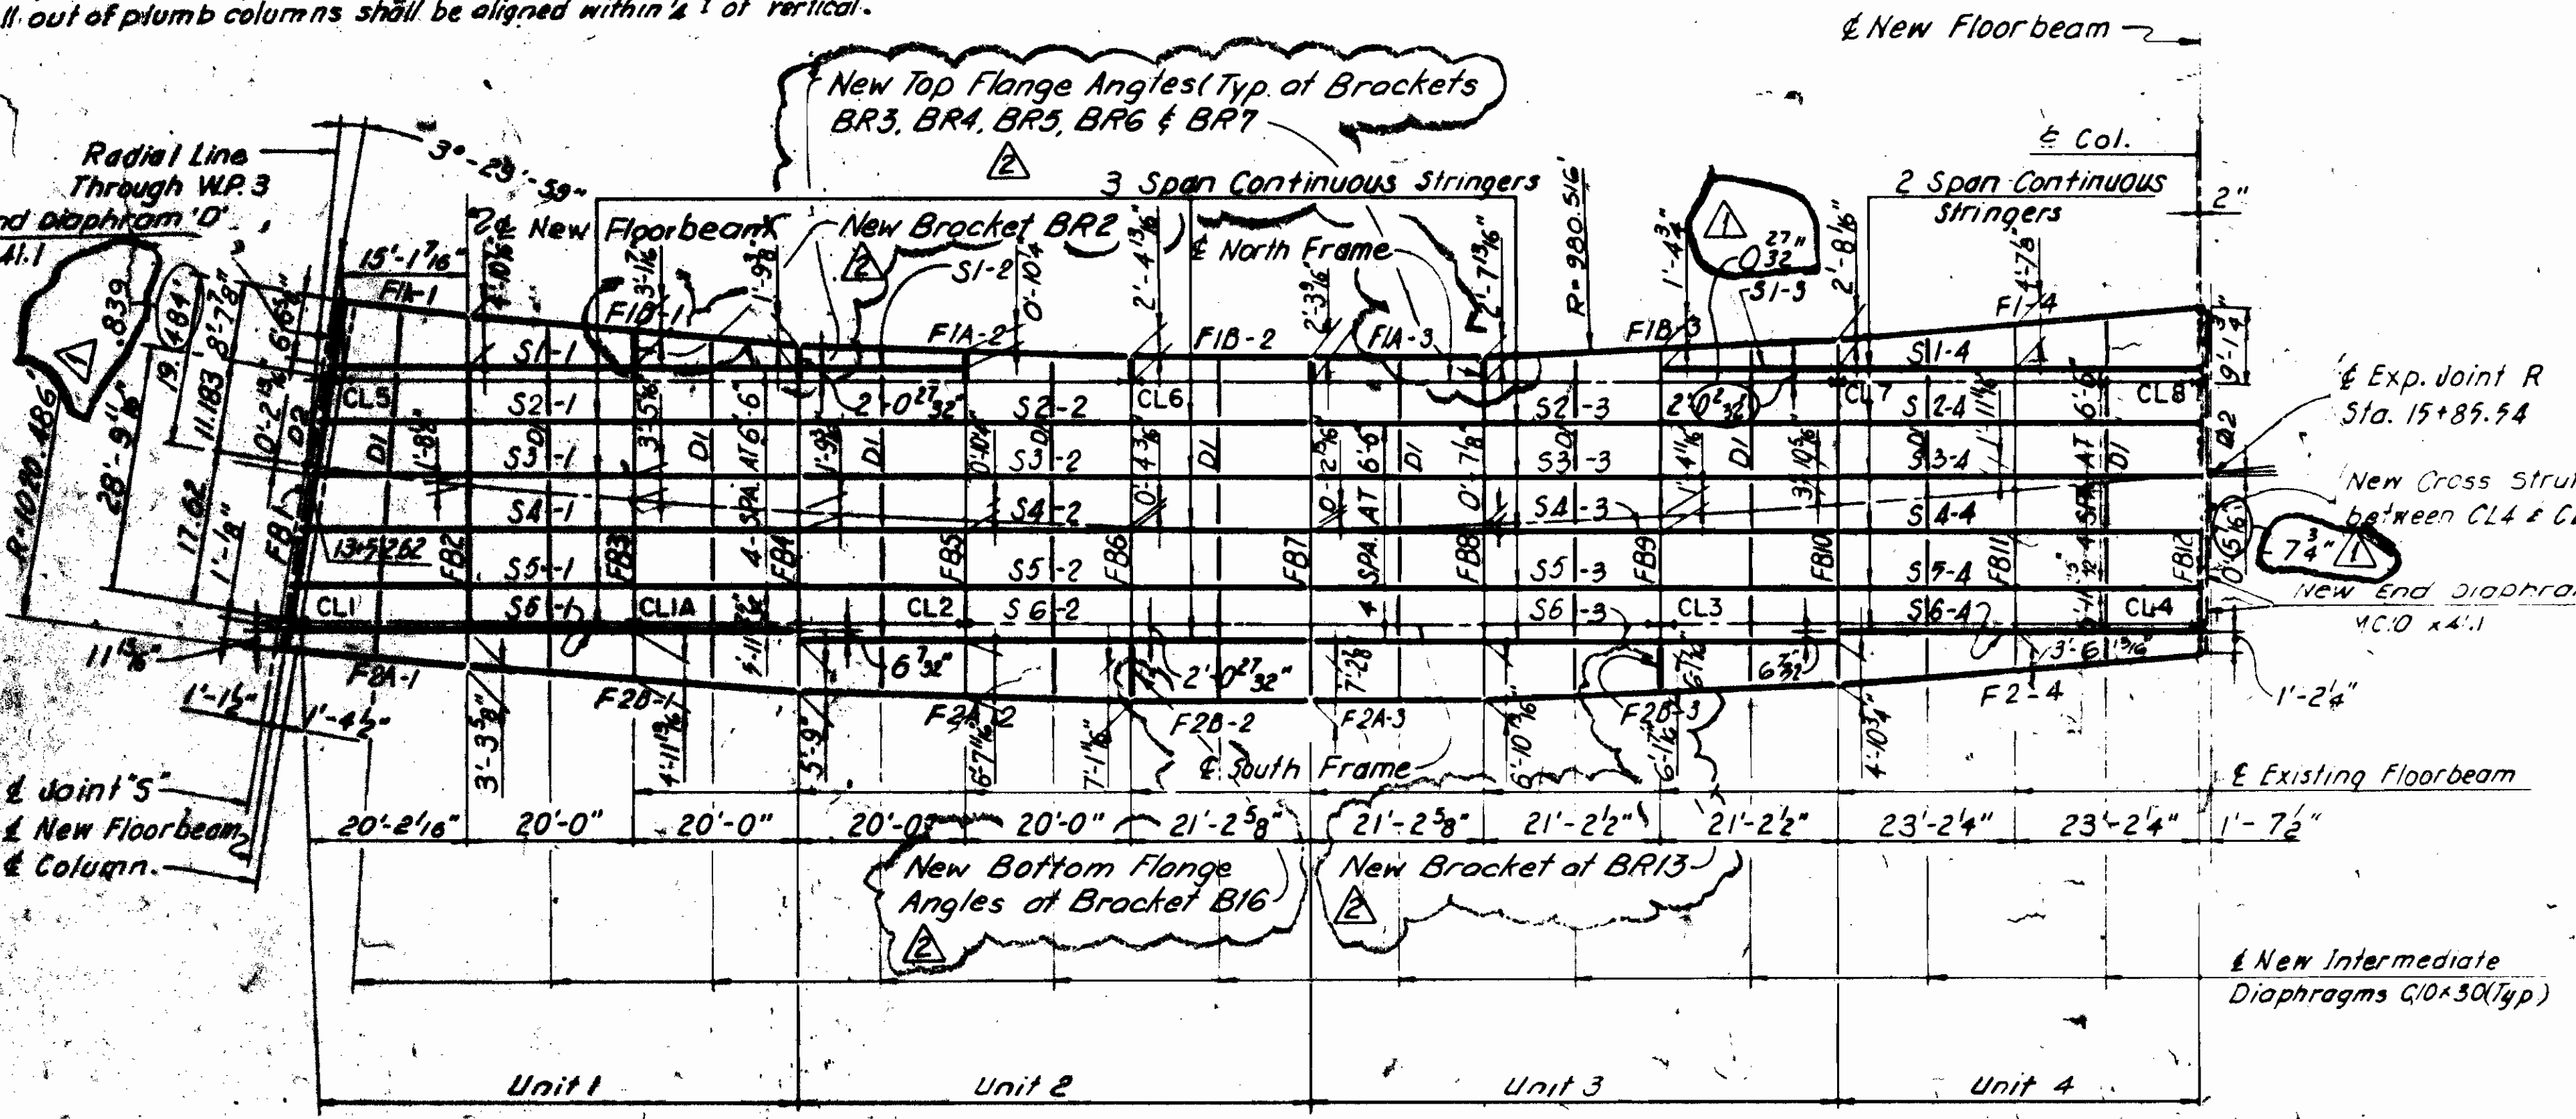

**NOTES:**  
 1. All new Rolled Beams, Shapes and Plates shall be ASTM A36, AISC Category I  
 2. All new Welded Members including Fascia Stringers, placement Floor Beams and Brackets shall be ASTM A36, AISC Category III

**REFERENCES:**

Fastener Symbols	167
Floor Beam Replacement	156 & 157
Concrete deterioration summary	190
Stringer Schedules	161
Typical Cross Section	114
CYN Note	105
Notes	147

PAVLO ENGINEERING CO., P.C.  
NEW YORK, NEW YORK

**CUYAHOGA COUNTY ENGINEER**  
CLEVELAND OHIO

**MAIN AVENUE BRIDGE**  
CITY OF CLEVELAND  
BRIDGE OVER THE CUYAHOGA RIVER VALLEY

**WEST APPROACH-SECTION L**  
EXISTING & PROP. FRAMING PLAN

Rev. 2	Plan Revisions	7/24/91
Rev. 1	Plan Revisions	3-7-91



BRIDGE NO. 193 REPORT NO. 718 DATE Nov 7/1989


**NO. B-136**

DESIGN	DRAWN	CHECKED	REVISED TO AS BUILT
B.G.	V.S.	R.D.M.	AS BUILT 2/94


MICROFILMED  
JUL 22 1994

FHWA REGION	STATE	PROJECT	148 547
5	OHIO	BHF-73(51)	


CUYAHOGA COUNTY  
CUY-2-14.66

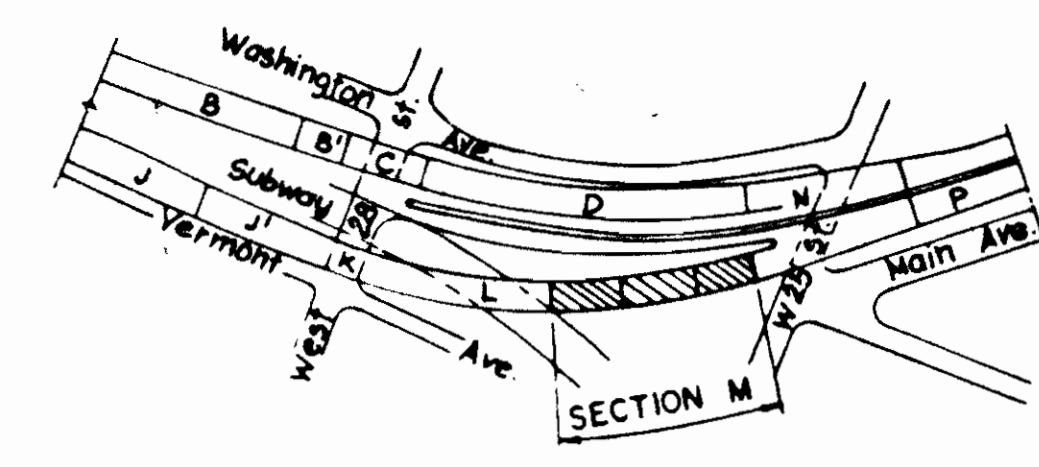

KEY PLAN  
N.T.S.

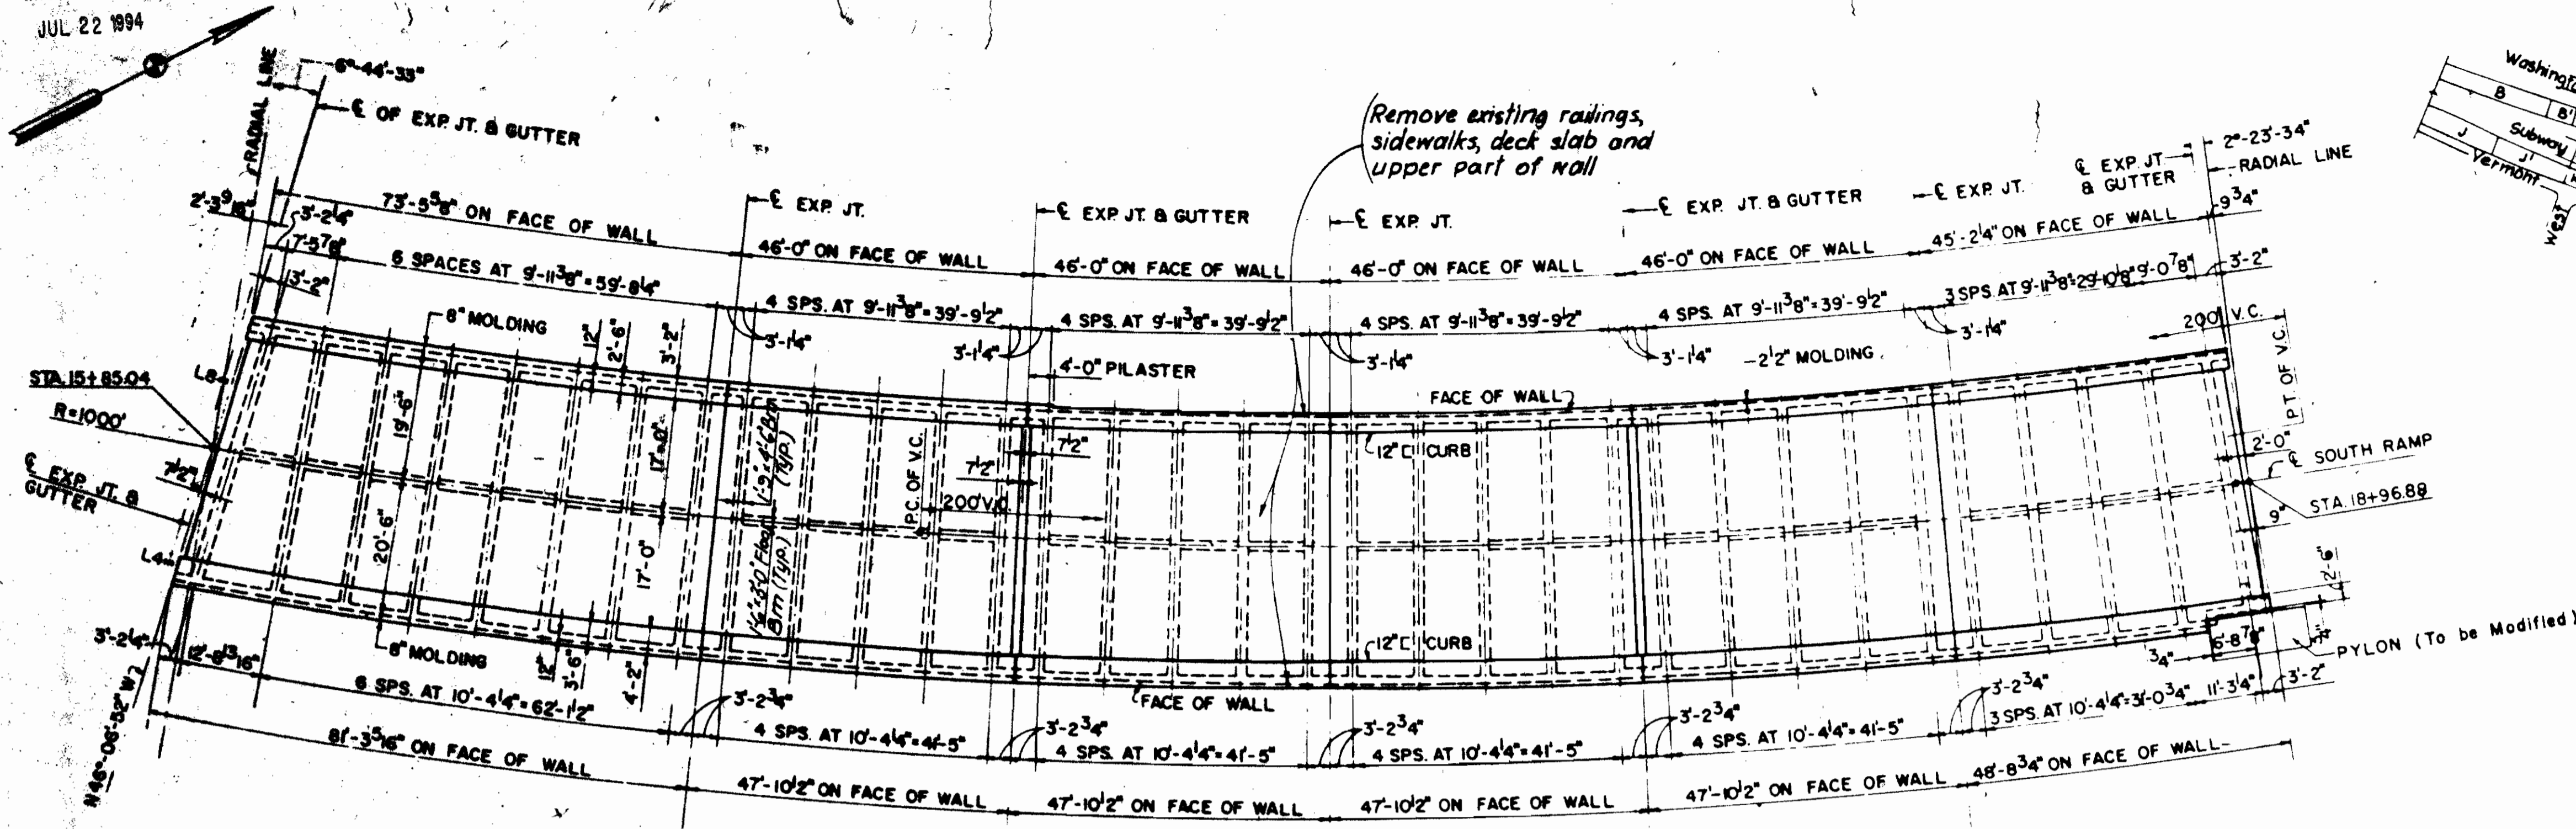

EXISTING DECK PLAN

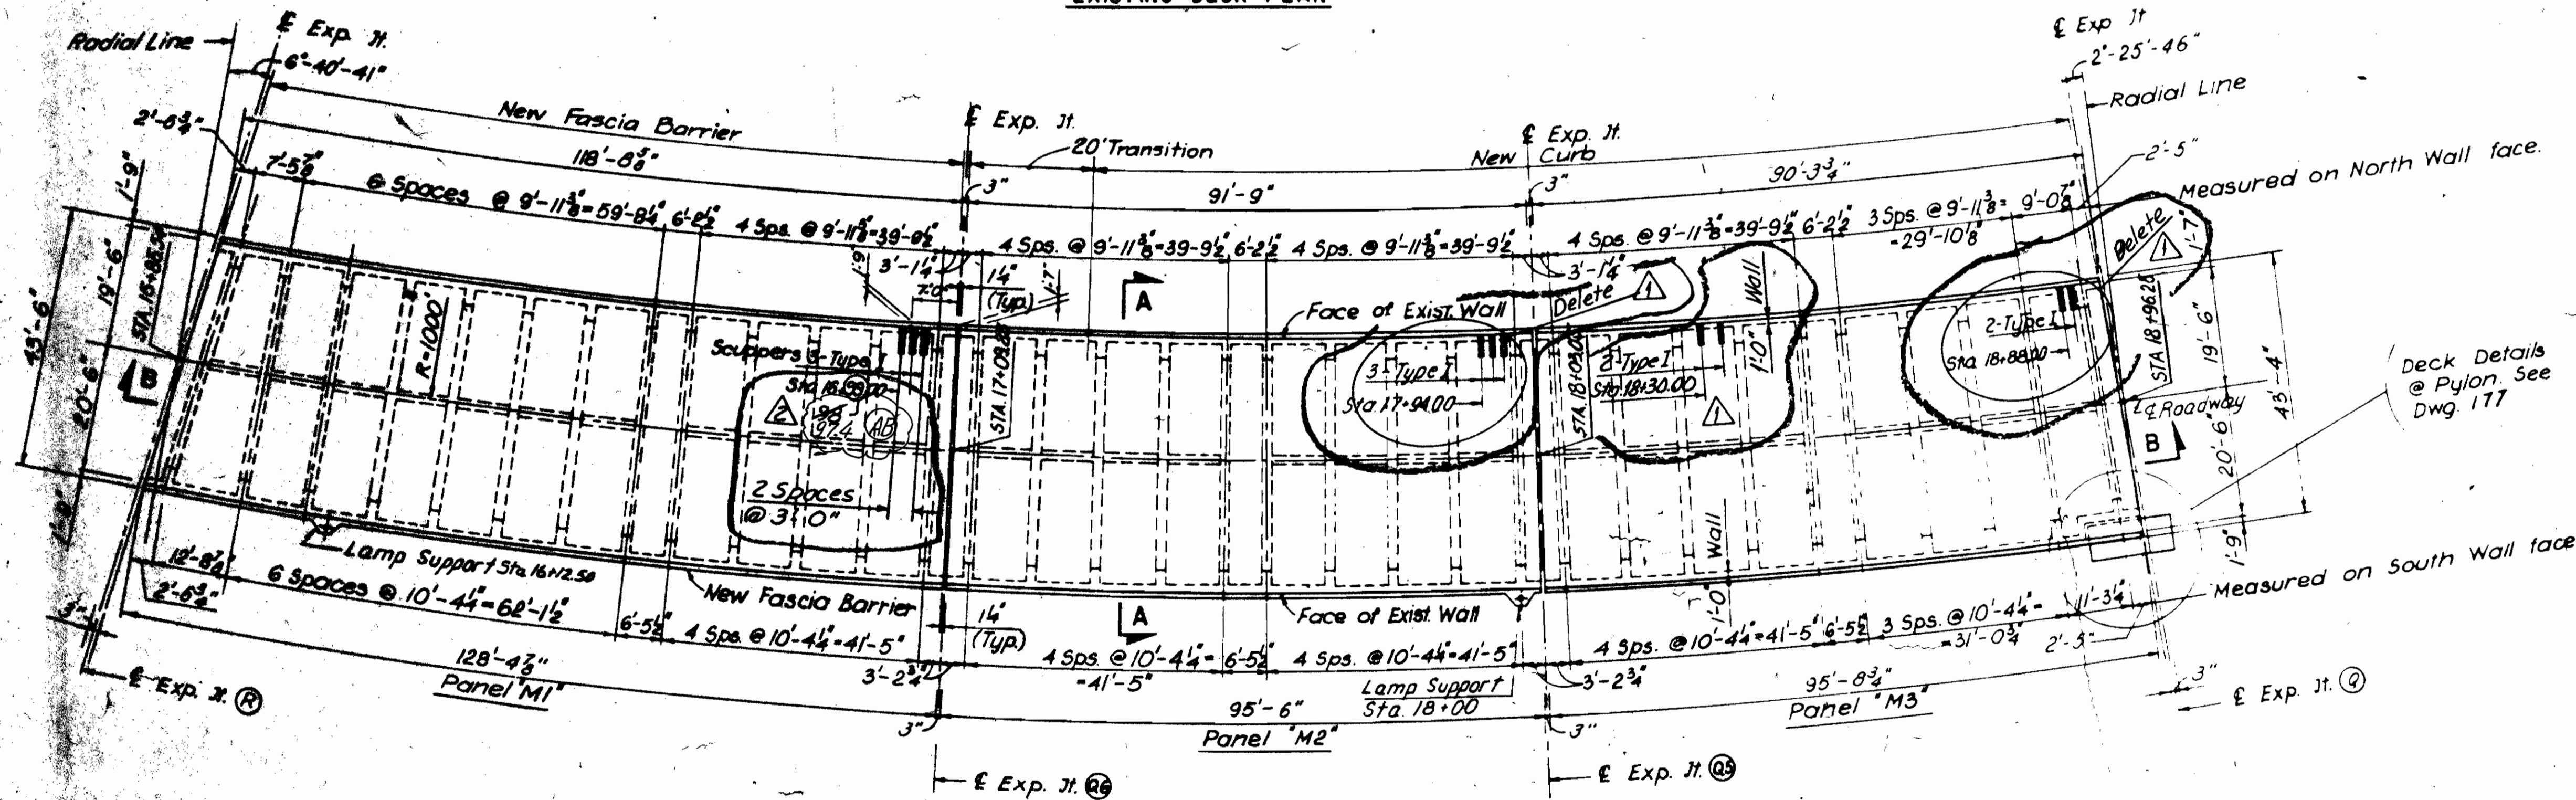

PROPOSED DECK PLAN

SECTION M

NOTES  
For notes 1 to 4 see Dwg 145.

REFERENCES	DWG No.
Section A-A & B-B	181
Summary of concrete repair	190
Expansion Joints	191 & 195
Scupper Details	654 & 655
Transition Barrier and New Curb	182

(AB) As Built

Rev 2	Plan Revisions	4-8-91
Rev 1	Plan Revisions	3-7-91

PAVLO ENGINEERING CO., P.C.  
NEW YORK, NEW YORK

CUYAHOGA COUNTY ENGINEER  
CLEVELAND OHIO

**MAIN AVENUE BRIDGE**  
CITY OF CLEVELAND  
BRIDGE OVER THE CUYAHOGA RIVER VALLEY  
WEST APPROACH-SECTION M  
**EXIST. & PROP. DECK PLAN**

BRIDGE NO. 193 REPORT NO. 7119 DATE Nov. 11, 1989

NO. B-136 150  
991

DESIGN A.S.	DRAWN J.H.	CHECKED A.K./R.M.	REVISED TO AS-BUILT AS BUILT 2/94
-------------	------------	-------------------	-----------------------------------


000T 4-18-91 T.E.S.



**NOTE 'G'**  
The Contractor shall notify the County Maintenance Department to provide temporary Support for the Garage Door during replacement of Stringers.

FHWA REGION	STATE	PROJECT	149
5	OHIO	BHF-73(SI)	547

CUYAHOGA COUNTY  
CUY-2-14.66

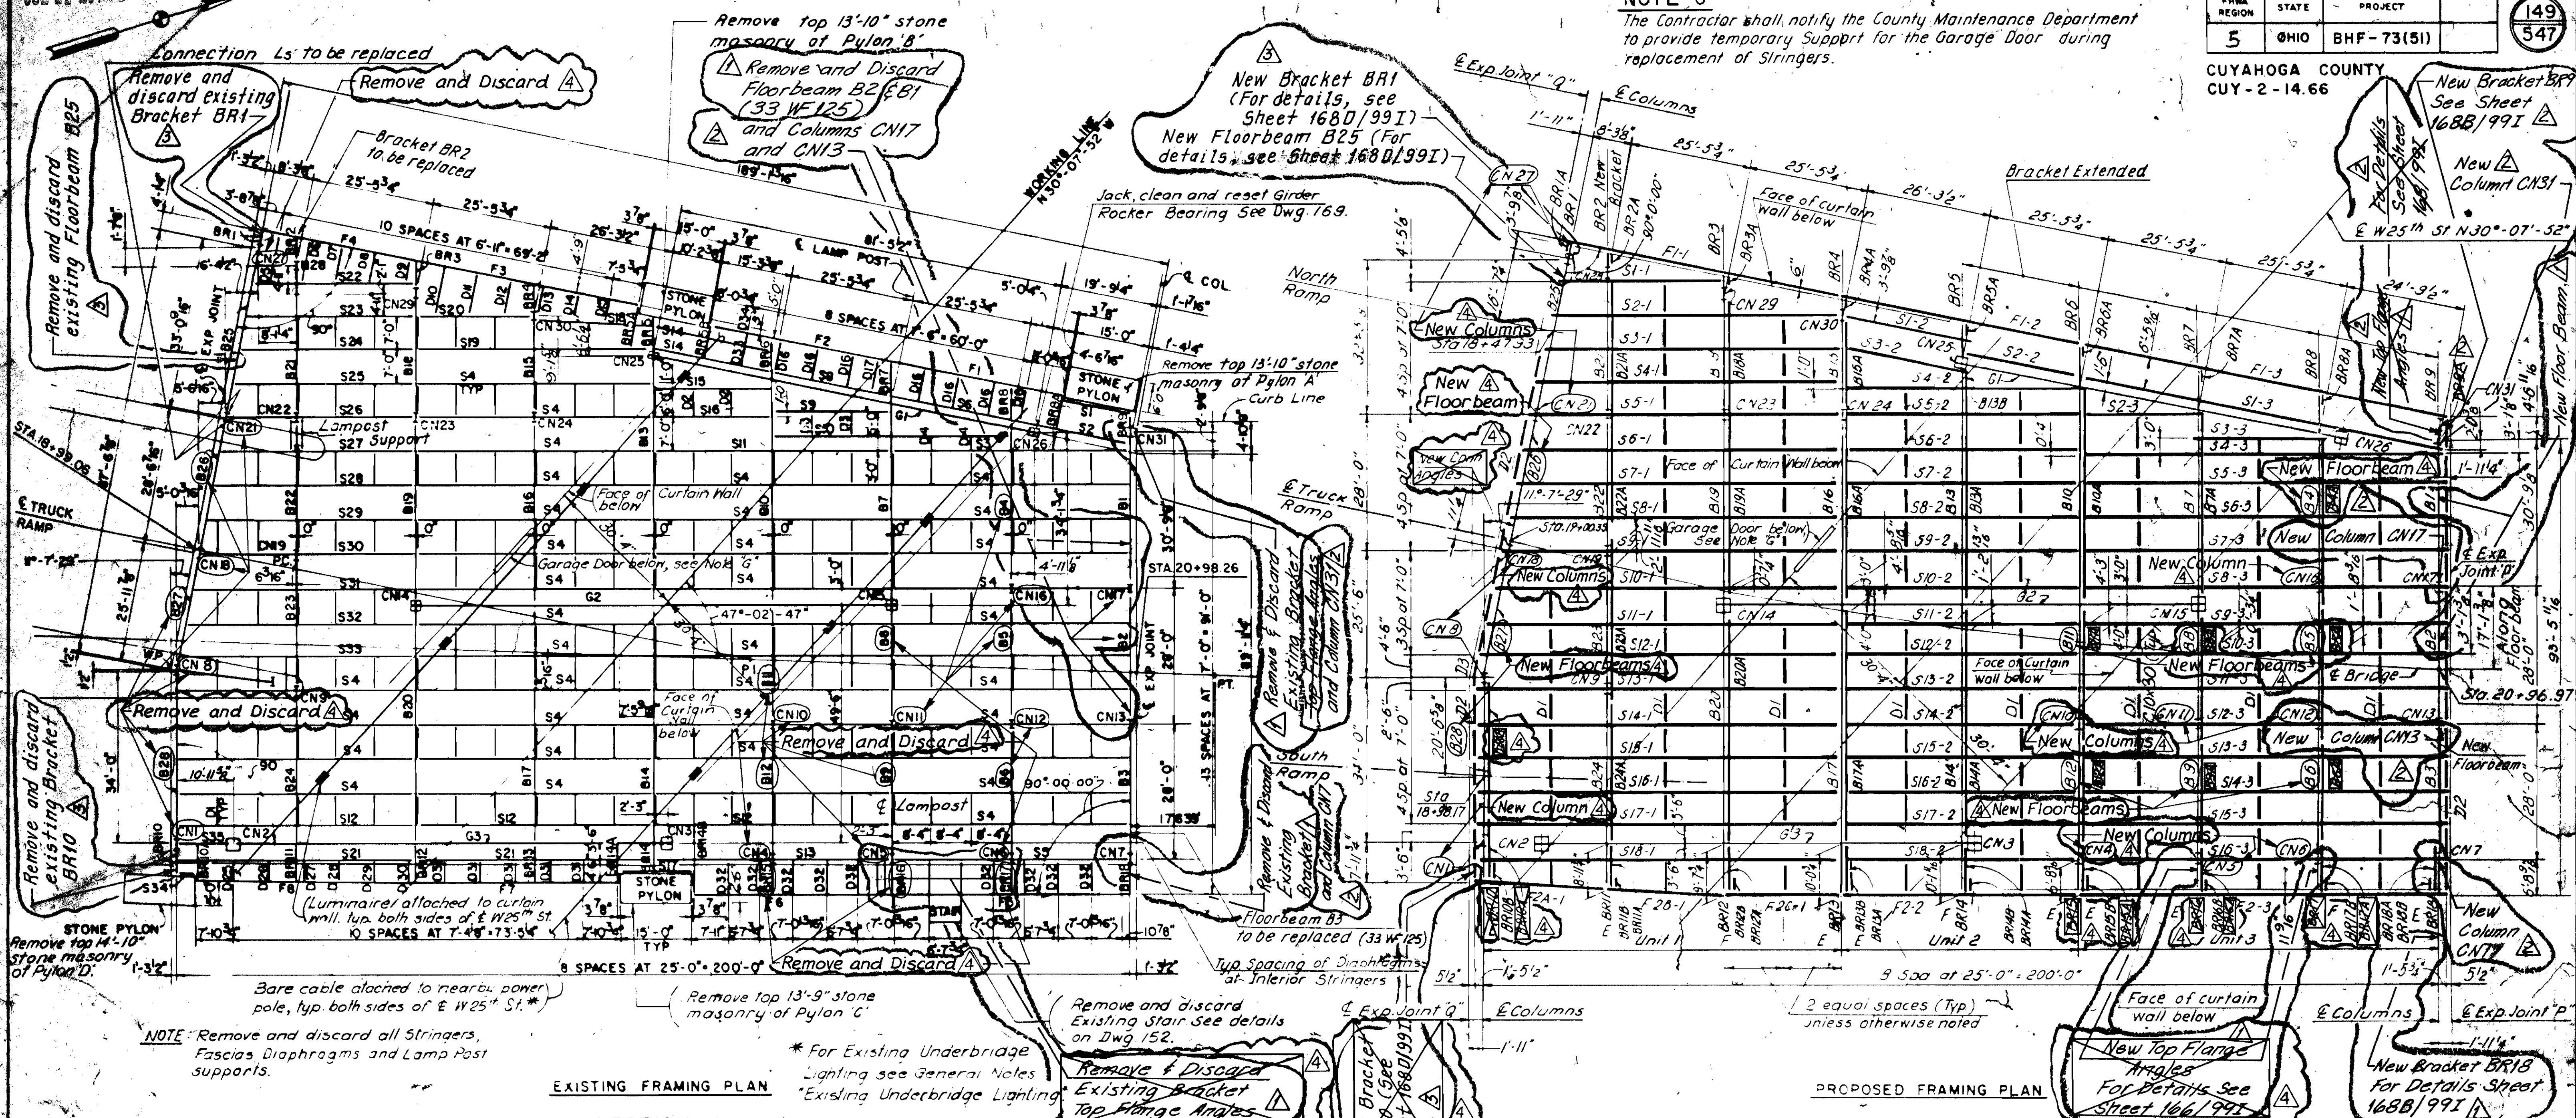

**NOTE:** Remove and discard all Stringers, Fascias Diaphragms and Lamp Post supports.

**EXISTING FRAMING PLAN**

**PROPOSED FRAMING PLAN**

**SECTION N**  
Scale: 1/6" = 1'-0"

**SECTION N**  
Scale: 1/6" = 1'-0"

**EXISTING FRAMING REMOVAL**

MARK	SECTION	MARK	SECTION	MARK	SECTION
S-1	21 WF 59	S-15	21 WF 62	F1, F2 F7, F8	1-30x3/8 R
S-2	21 WF 59	S-16	21 WF 69		1-14x3/8
S-3	21 WF 63	S-17	21 WF 59		1-19x13/4
S-4	21 WF 73	S-18	21 WF 59		1-14x3/8
S-5	20 I 65.4	S-19	21 WF 73	F3, F4	1-28x3/8
S-6	21 WF 68	S-20	21 WF 89		1-14x3/8
S-7	21 WF 59	S-21	21 WF 68		1-23x2 1/2
S-8	21 WF 68	S-22	21 WF 68		1-28x3/8
S-9	21 WF 82	S-23	21 WF 68	F5, F6	1-14x3/8
S-10	21 WF 59	S-24	21 WF 68		1-30x3/8
S-11	21 WF 73	S-32	21 WF 73		1-14x3/8
S-12	21 WF 73	S-33	21 WF 73		1-19x13/4
S-13	20 I 65.4	S-34	21 WF 59	F-5, F6	1-14x3/8
S-14	21 WF 62	S-35	21 WF 59		1-28x3/8

**ADDITIONAL REFERENCES**

DESCRIPTION	DWG. NO.
New Column CNI	168F
New Columns CN8, CN18, CN21, CN27	168E
New Columns CN4, CN10	168G
New Columns CN5, CN11	168H
New Columns CN6, CN12, CN16	168I
New Floorbeam B28	168F
New Floorbeams B26, B27	168E
New Floorbeams B11, B12	168G
New Floorbeams B8, B9	168H
New Floorbeams B4, B5, B6	168I

**COLUMN NOTE**  
The following Columns were out of project agreement during surveys done prior to Nov. 1988: CN5, CN6, CN7, CN10, CN11, CN12, CN13, CN16 & CN17. All out of project columns shall be aligned to within 1/4" of vertical.

**NOTES:**  
All new Rolled Beams, Shapes and Plates shall be ASTM A36, AISC Category I.  
All new Welded Members including Fascia Stringers, Replacement Floor Beams and Brackets shall be ASTM A36, AISC Category III.

**REFERENCES:**

DESCRIPTION	DWG. NO.
C/N Note	105
Stone Pylons Modifications	153
Stringer Details	158
Stringer Schedules	162
Floorbeams - Schematic Elev.	154
Typical Cross-Section	115
Floorbeam Replacement (B2, B3)	155, 168
Details Sheets: 1, 2, 3, 4, 5	164, 165, 166, 167, 168
Fascia Stringer Elevations	159
Fascia Stringer Setting Dim.	163
Bolster Schedule	154
Pylon modifications	153
D1 Diaphragm	115
D2 Diaphragm	112
D3 Diaphragm	155
New Connection Angles @ CN18 & Exist. Floorbeam Details	169
Column Details	168A
Floorbeam Replacement B1	168C

Rev. 4	Plan Revisions	01-03-92
Rev. 3	Plan Revisions	10-10-91

Rev. 2	Plan Revisions	8-26-91
Rev. 1	Plan Revisions	2-26-91

PAVLO ENGINEERING CO., P.C.  
NEW YORK, NEW YORK.

**GUYAHOGA COUNTY ENGINEER**  
CLEVELAND OHIO

**MAIN AVENUE BRIDGE**  
CITY OF CLEVELAND  
BRIDGE OVER THE CUYAHOGA RIVER VALLEY



**WEST APPROACH-SECTION N**  
**EXISTING & PROPOSED FRAM PLAN**

BRIDGE NO. 132 REPORT NO. 719 DATE Nov. 11, 1992


**NO. B-136**

DESIGN	DRAWN	CHECKED	REVISED TO AS BUILT
B.G.	A.D.	J.B.M.	AS BUILT 2/94




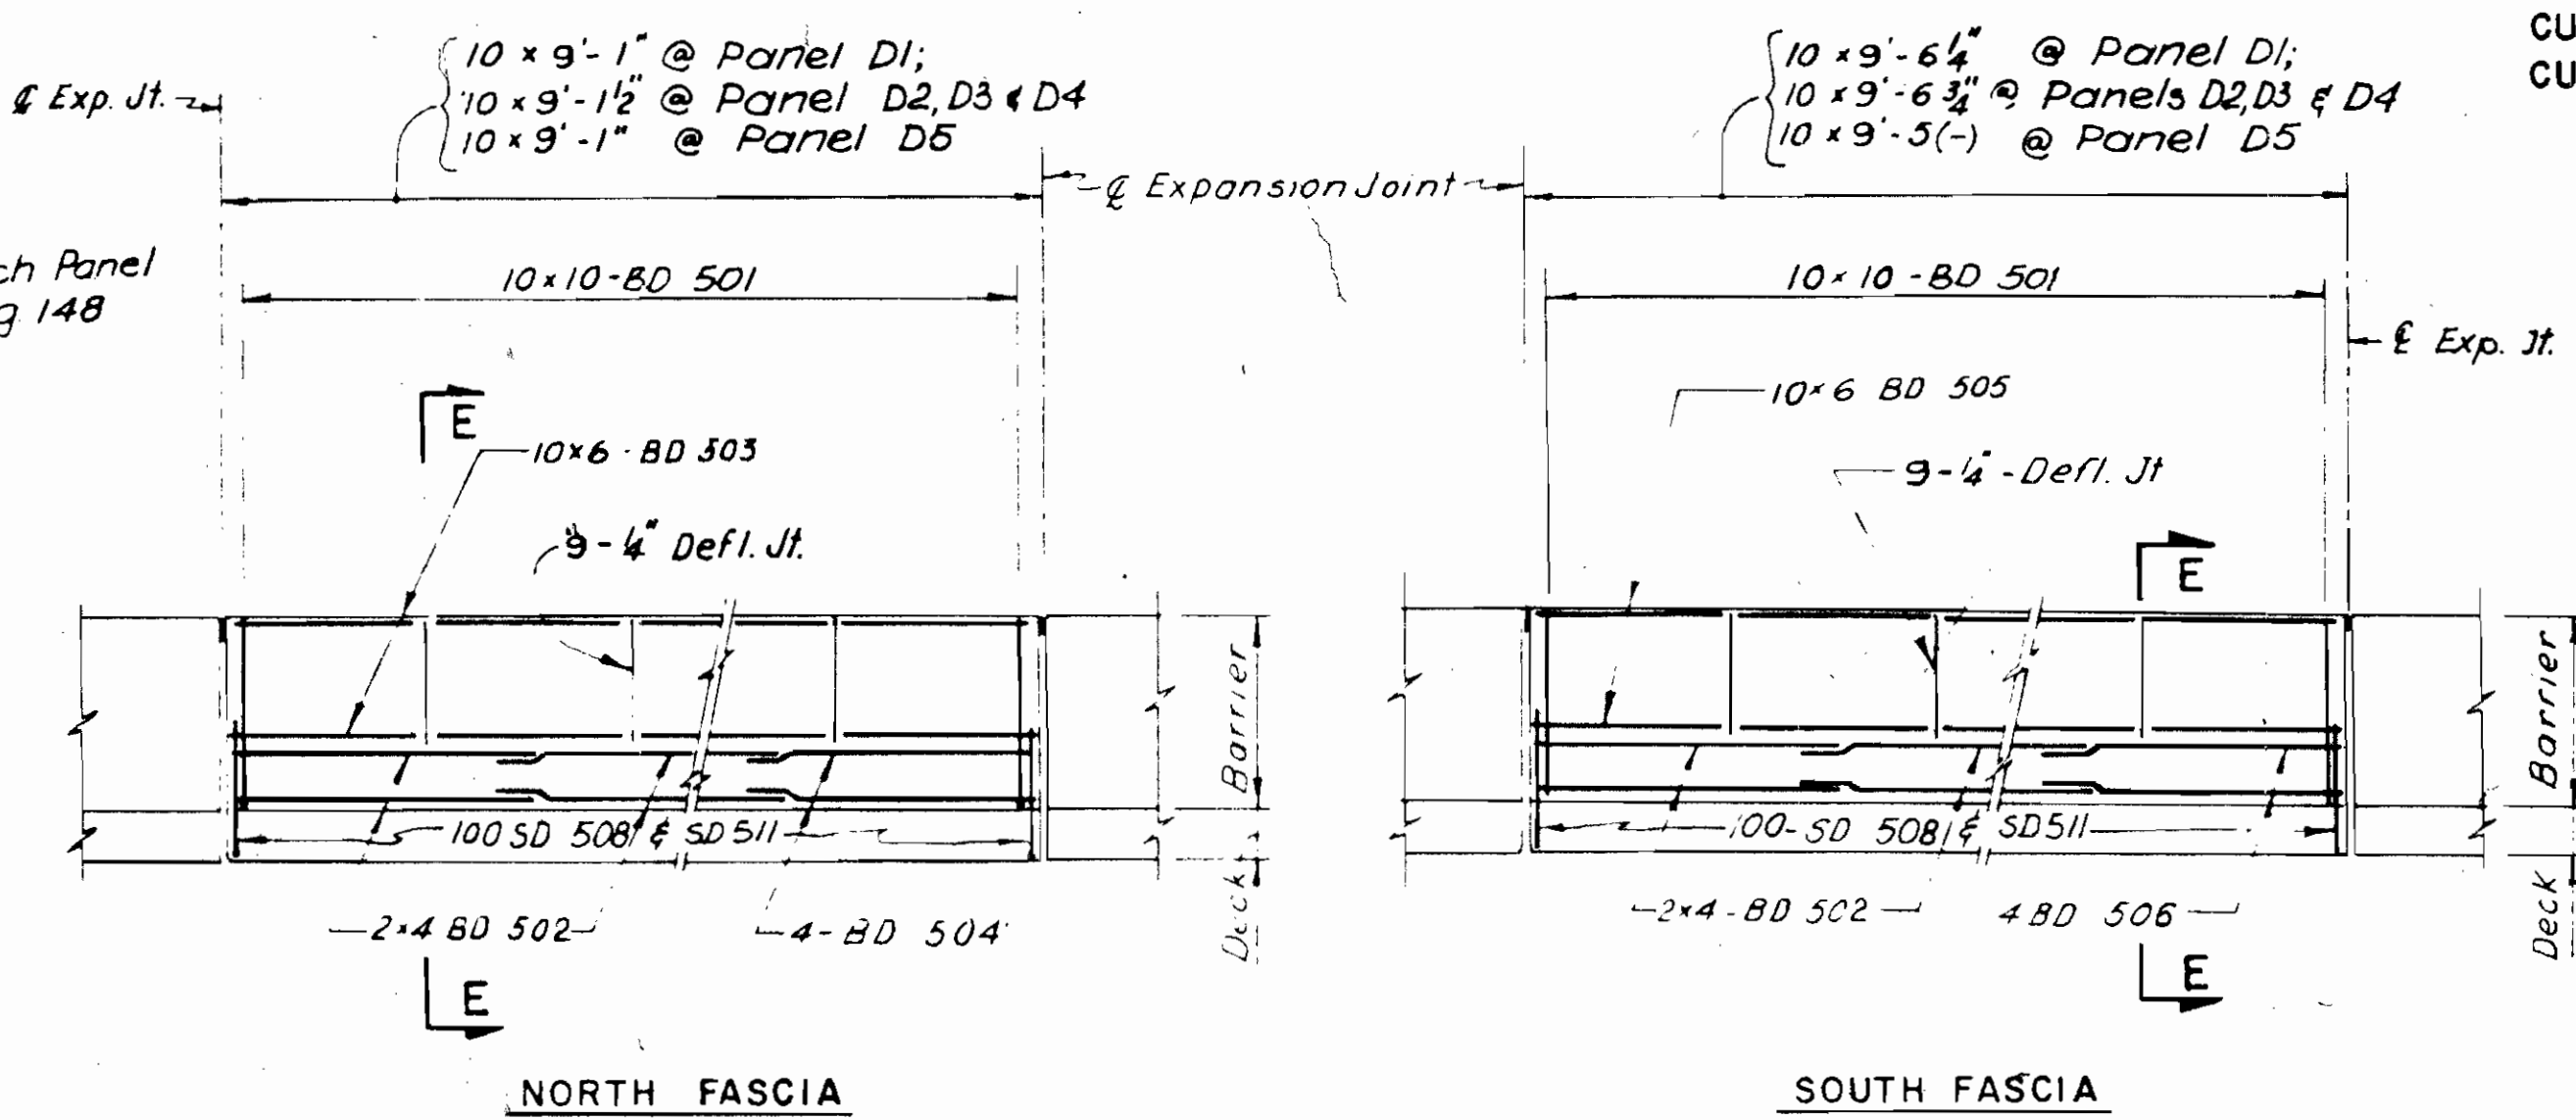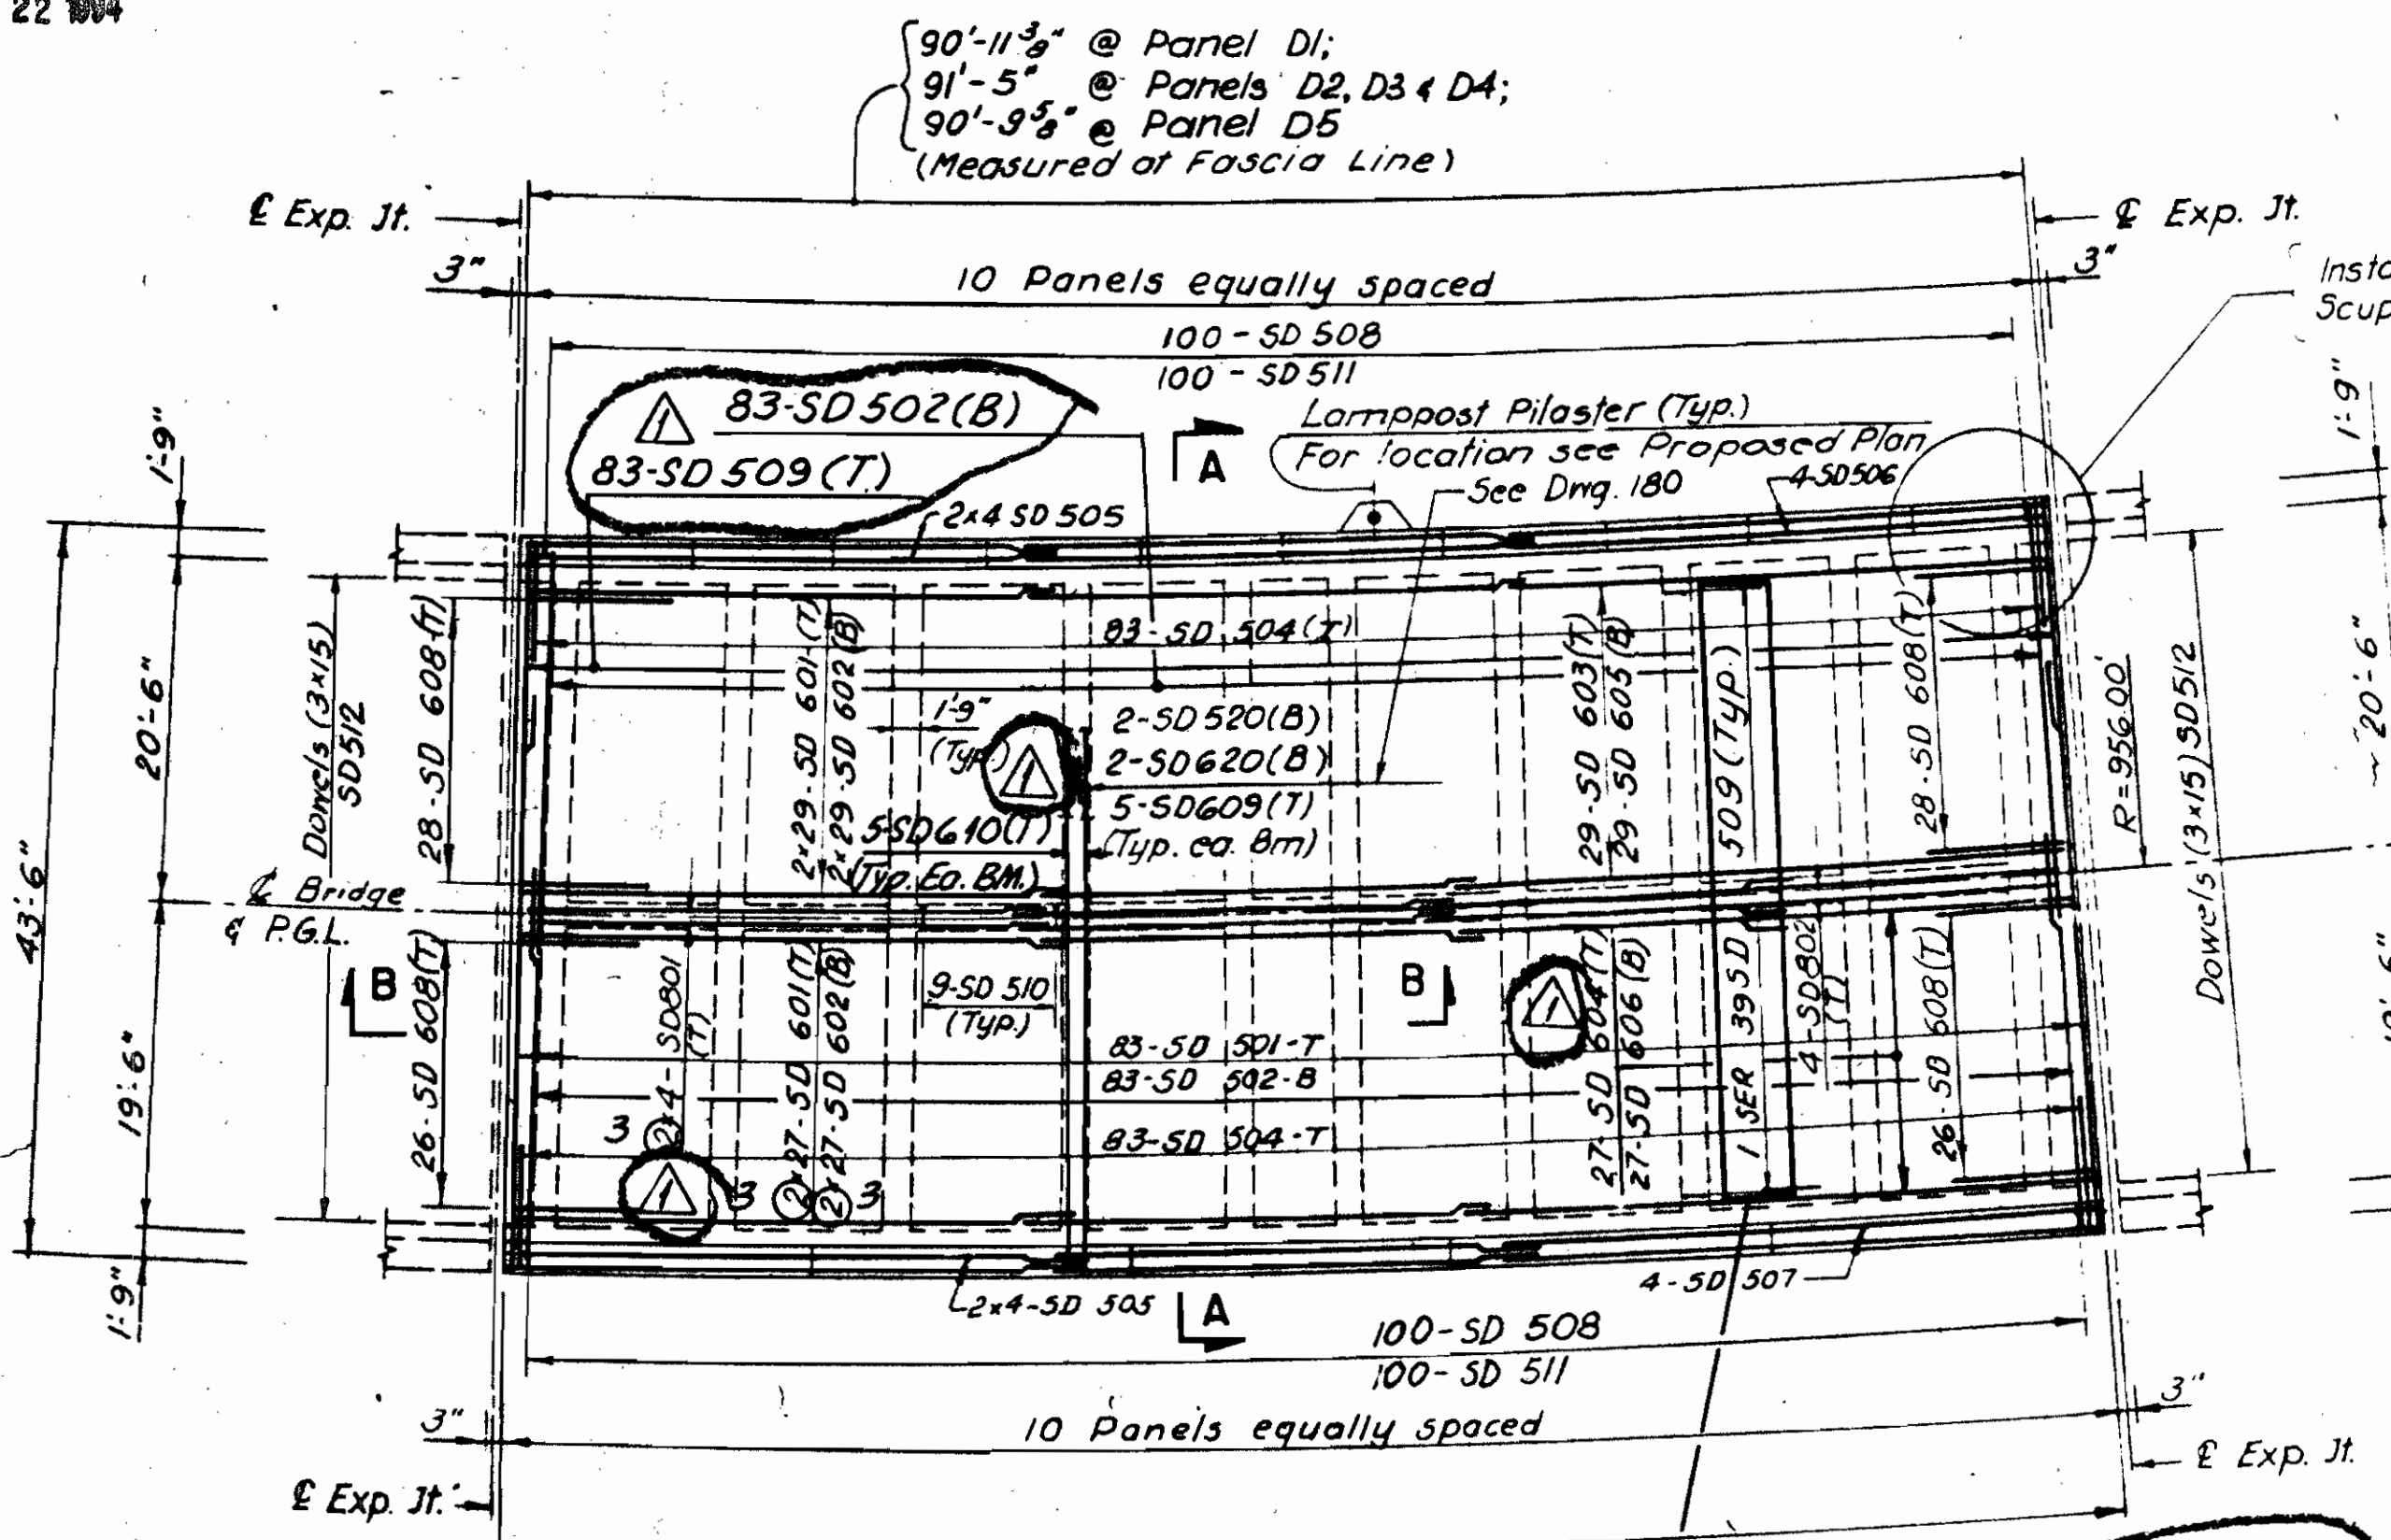

BARRIER DETAILS  
N.T.S.

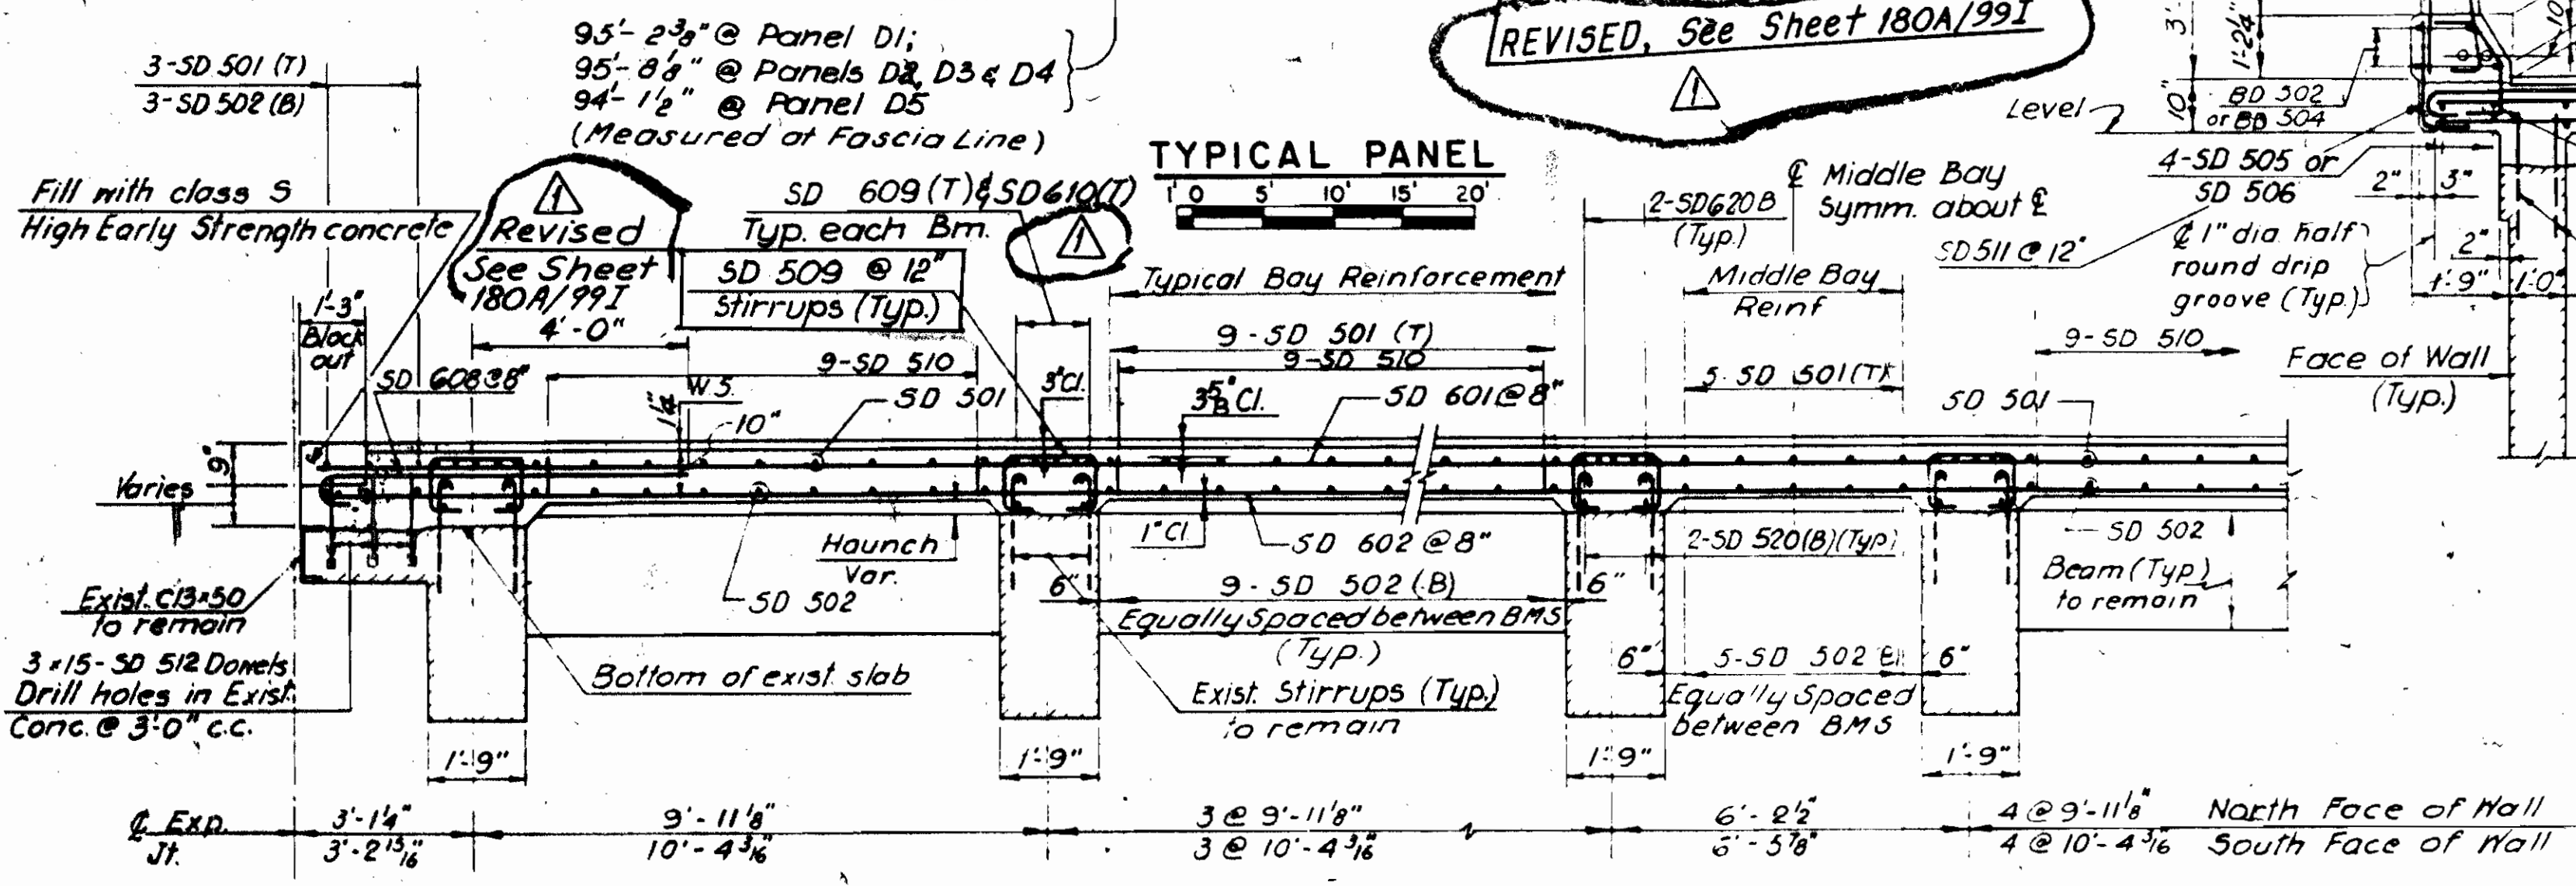

SECTION B-B

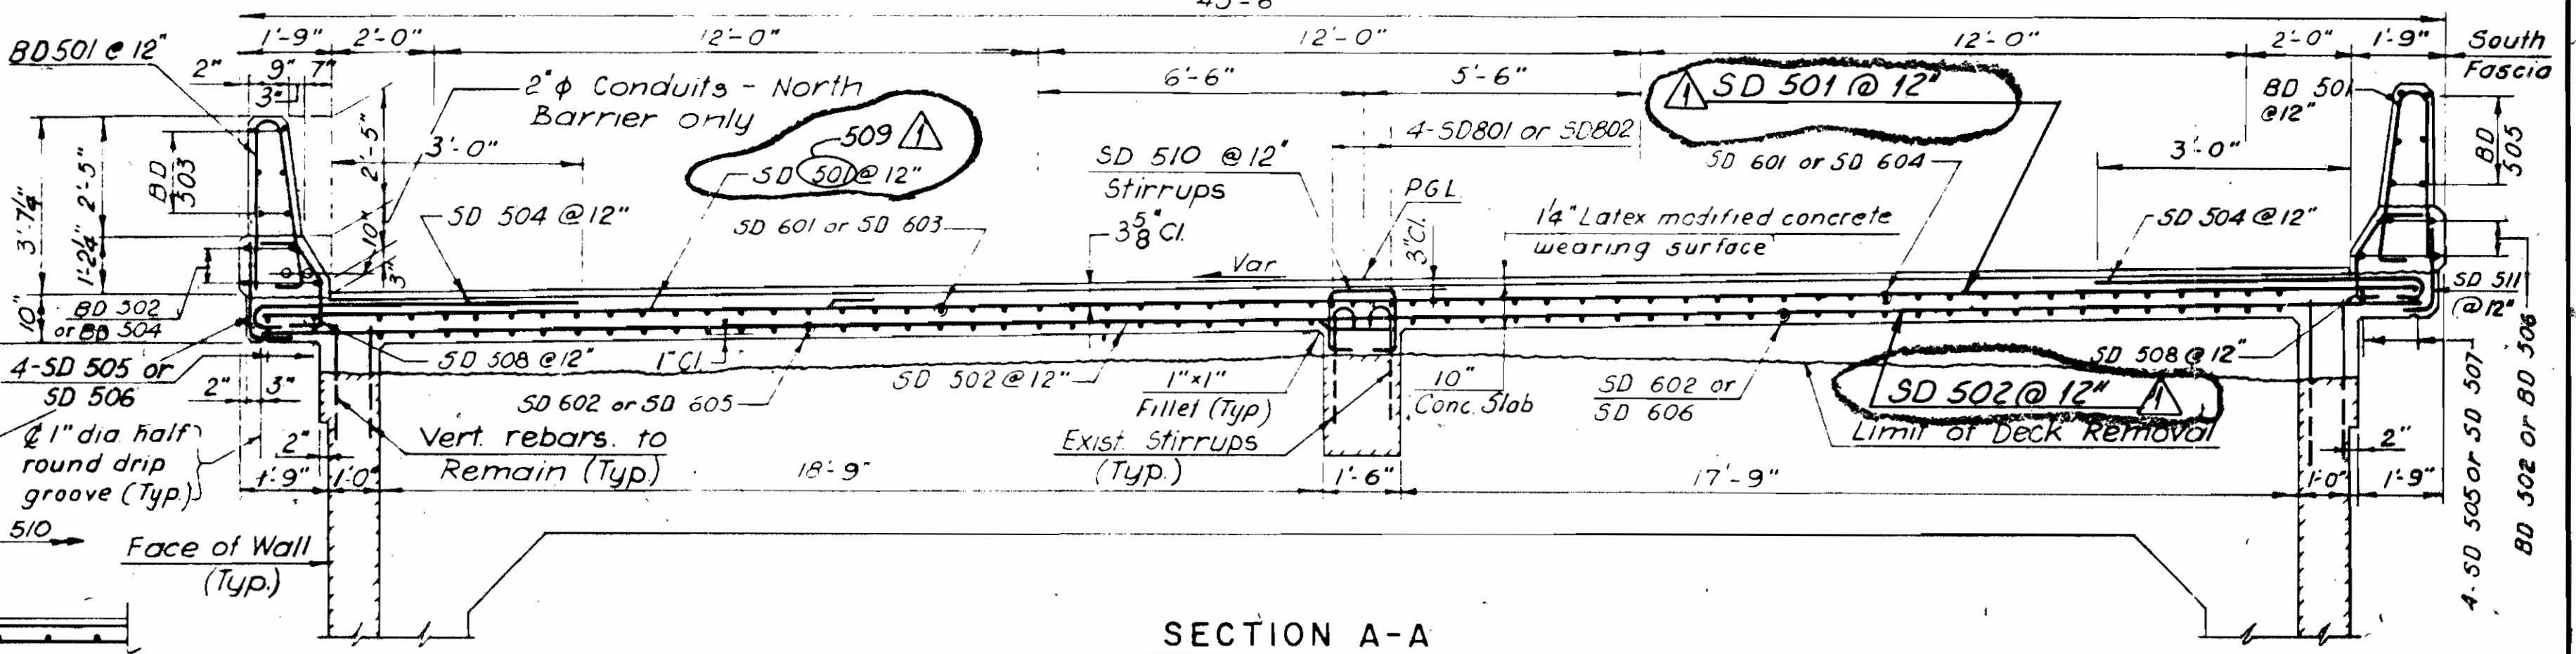

SECTION A-A

MINIMUM LAP LENGTHS (TYPICAL UNLESS NOTED)

BAR SIZE	LENGTH REQD.
#5	2'-3"
#6	2'-8"
#8	4'-7"

\*Lightweight Concrete

NOTES

- For Notes 1 to 4 see Dwg. 145
- 5. Deck reinforcing details are for all 5 panels of bridge Section D
- 6. See Dwg. 145 for suggested temporary frame support.
- 7. All new reinforced concrete in slab and beams shall be lightweight Class 'S'.

REFERENCES

REFERENCES	DWG. No.
Existing & Proposed Deck Plan	148
Beam modifications	180
Lamp support pilaster	G68
Bar List	199C
Scupper Details & Reinforcement	654 & 955

PAVLO ENGINEERING CO., P.C.  
NEW YORK, NEW YORK

CUYAHOGA COUNTY ENGINEER  
CLEVELAND OHIO

**MAIN AVENUE BRIDGE**  
CITY OF CLEVELAND  
**BRIDGE OVER THE CUYAHOGA RIVER VALLEY**

WEST APPROACH - SECTION D  
**DECK SLAB REINFORCEMENT**

BRIDGE NO. 193 REPORT NO. 7119 DATE Nov. 11, 1992



**NO. B-136** 173  
991

DESIGN	DRAWN	CHECKED	REVISED TO AS BUILT
A.S.	L.T.	A.K./R.M.	AS BUILT 2/94

Rev 1 Plan Revisions 3-10-91

ODOT 3-27-91 TES




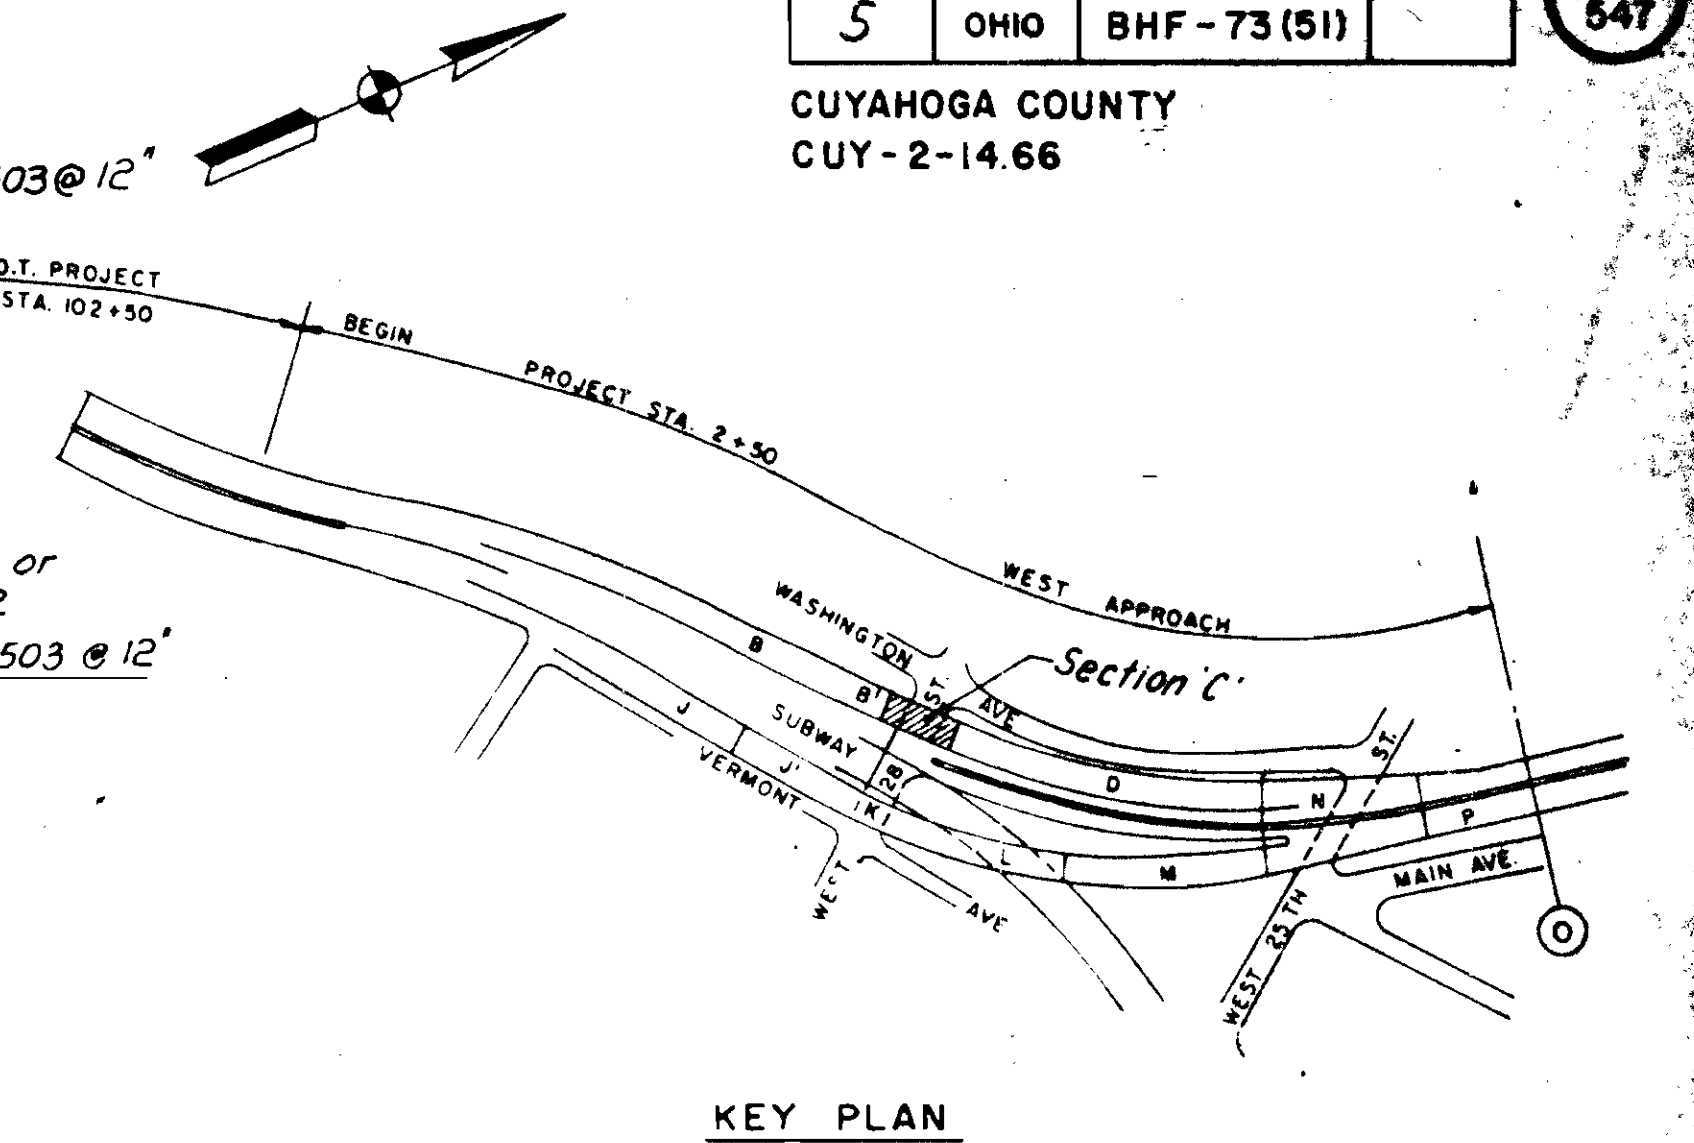
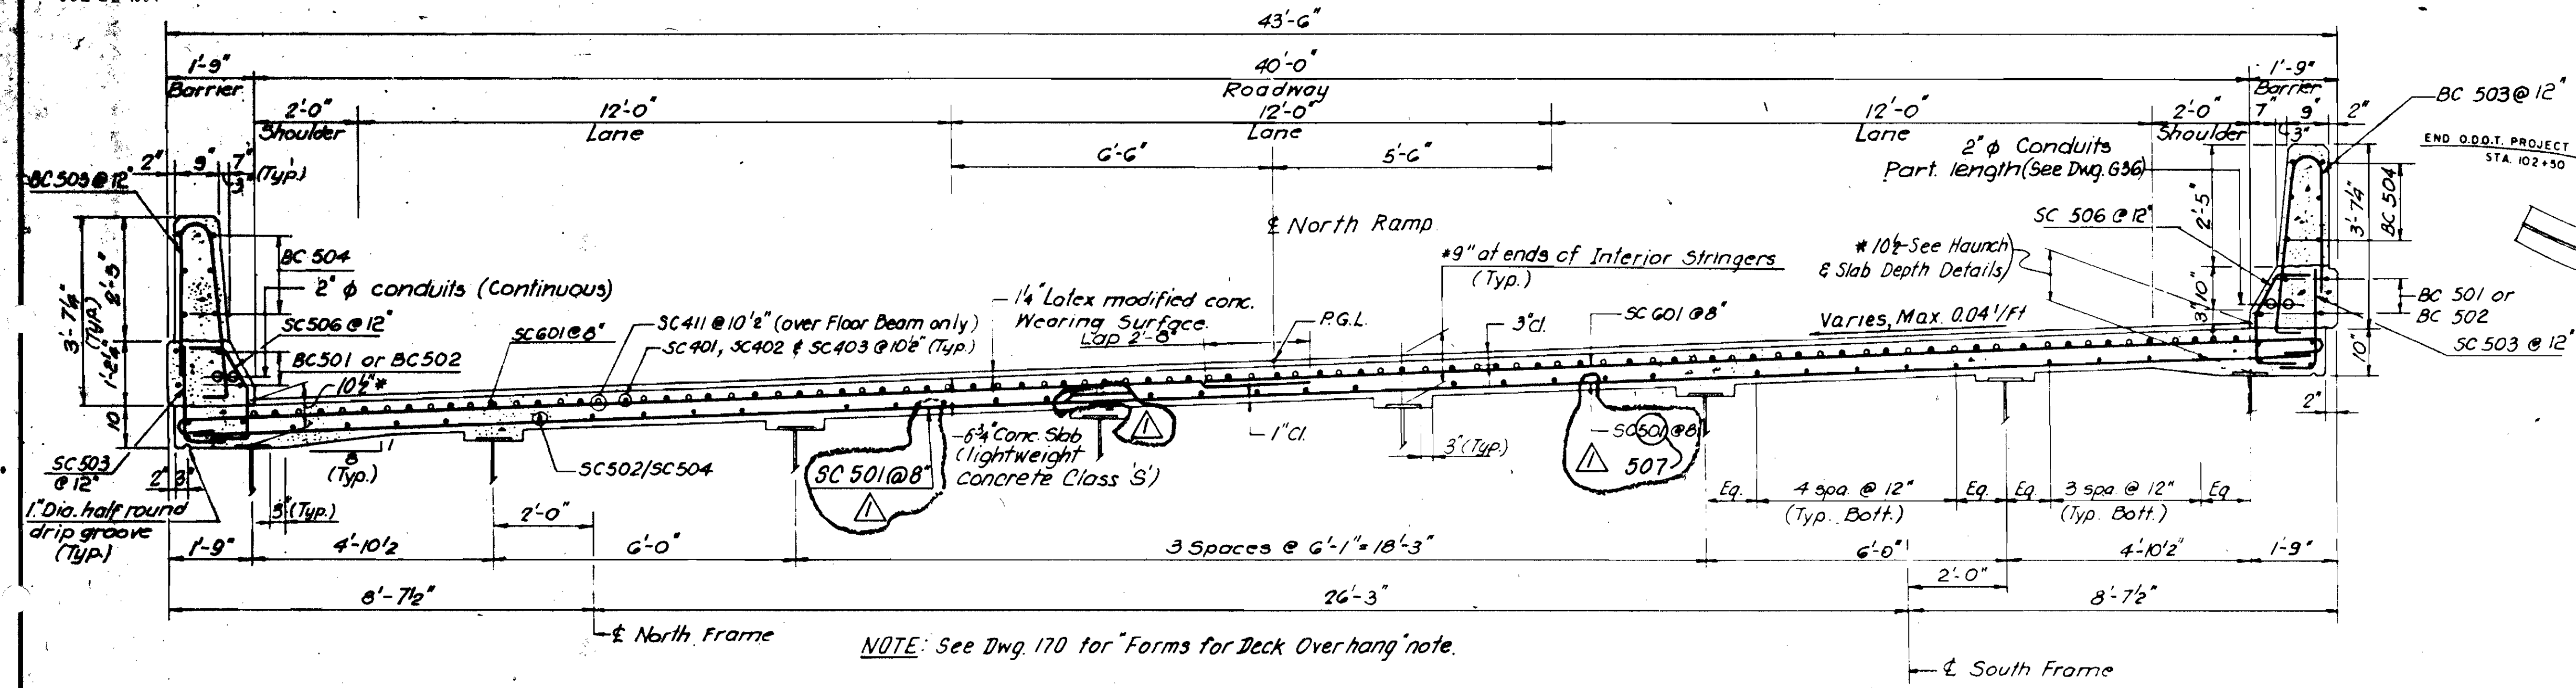


**NOTES:**

A Haunch Width as shown on Haunch & Depth of Slab Details shall be used for computing quantity of concrete. DECK SLAB DEPTH: The distance shown from top of Deck Slab to top of Steel Beam is the design dimension. The quantity of deck concrete to be paid for shall be based on this dimension, less 1/4" wearing surface, even though deviation from it may be necessary because the top flange of the beam may not have the exact camber or configuration required to place it parallel to the finished grade.

\* This is the design dimension. The quantity of deck concrete to be paid for shall be based upon this dimension, less 1/4" wearing surface, even though deviation from it may be necessary because the top flange of the girder may not have the exact camber or conformation required to place it parallel to the finished grade. Deduction shall be made for volume of encased steel plates as per 511.18.

The Contractor shall bend or field cut reinforcing steel as required at scuppers.

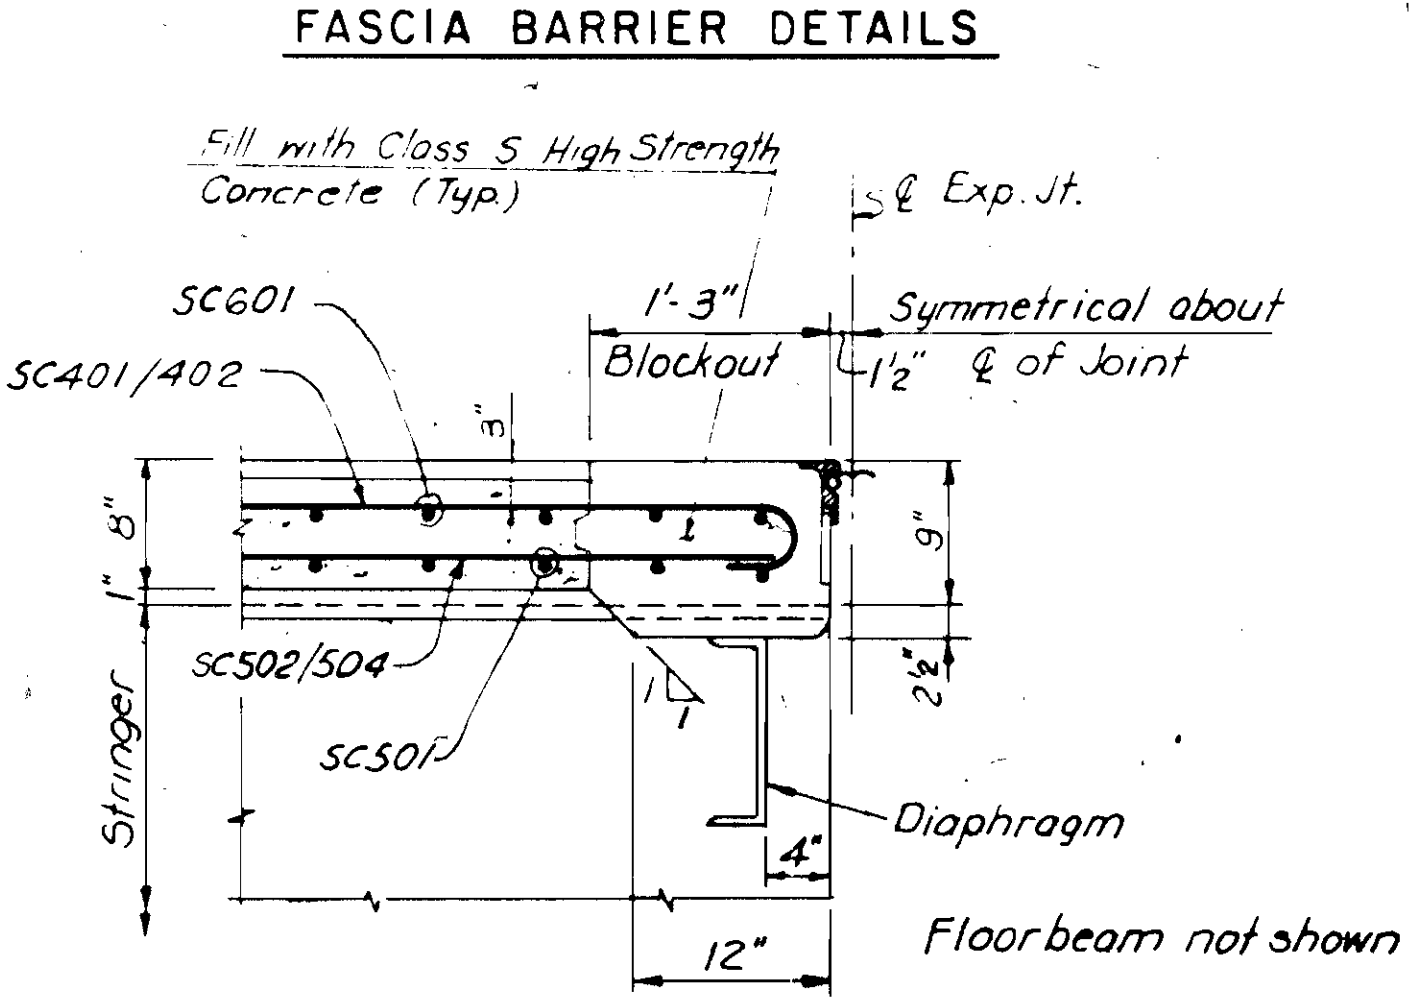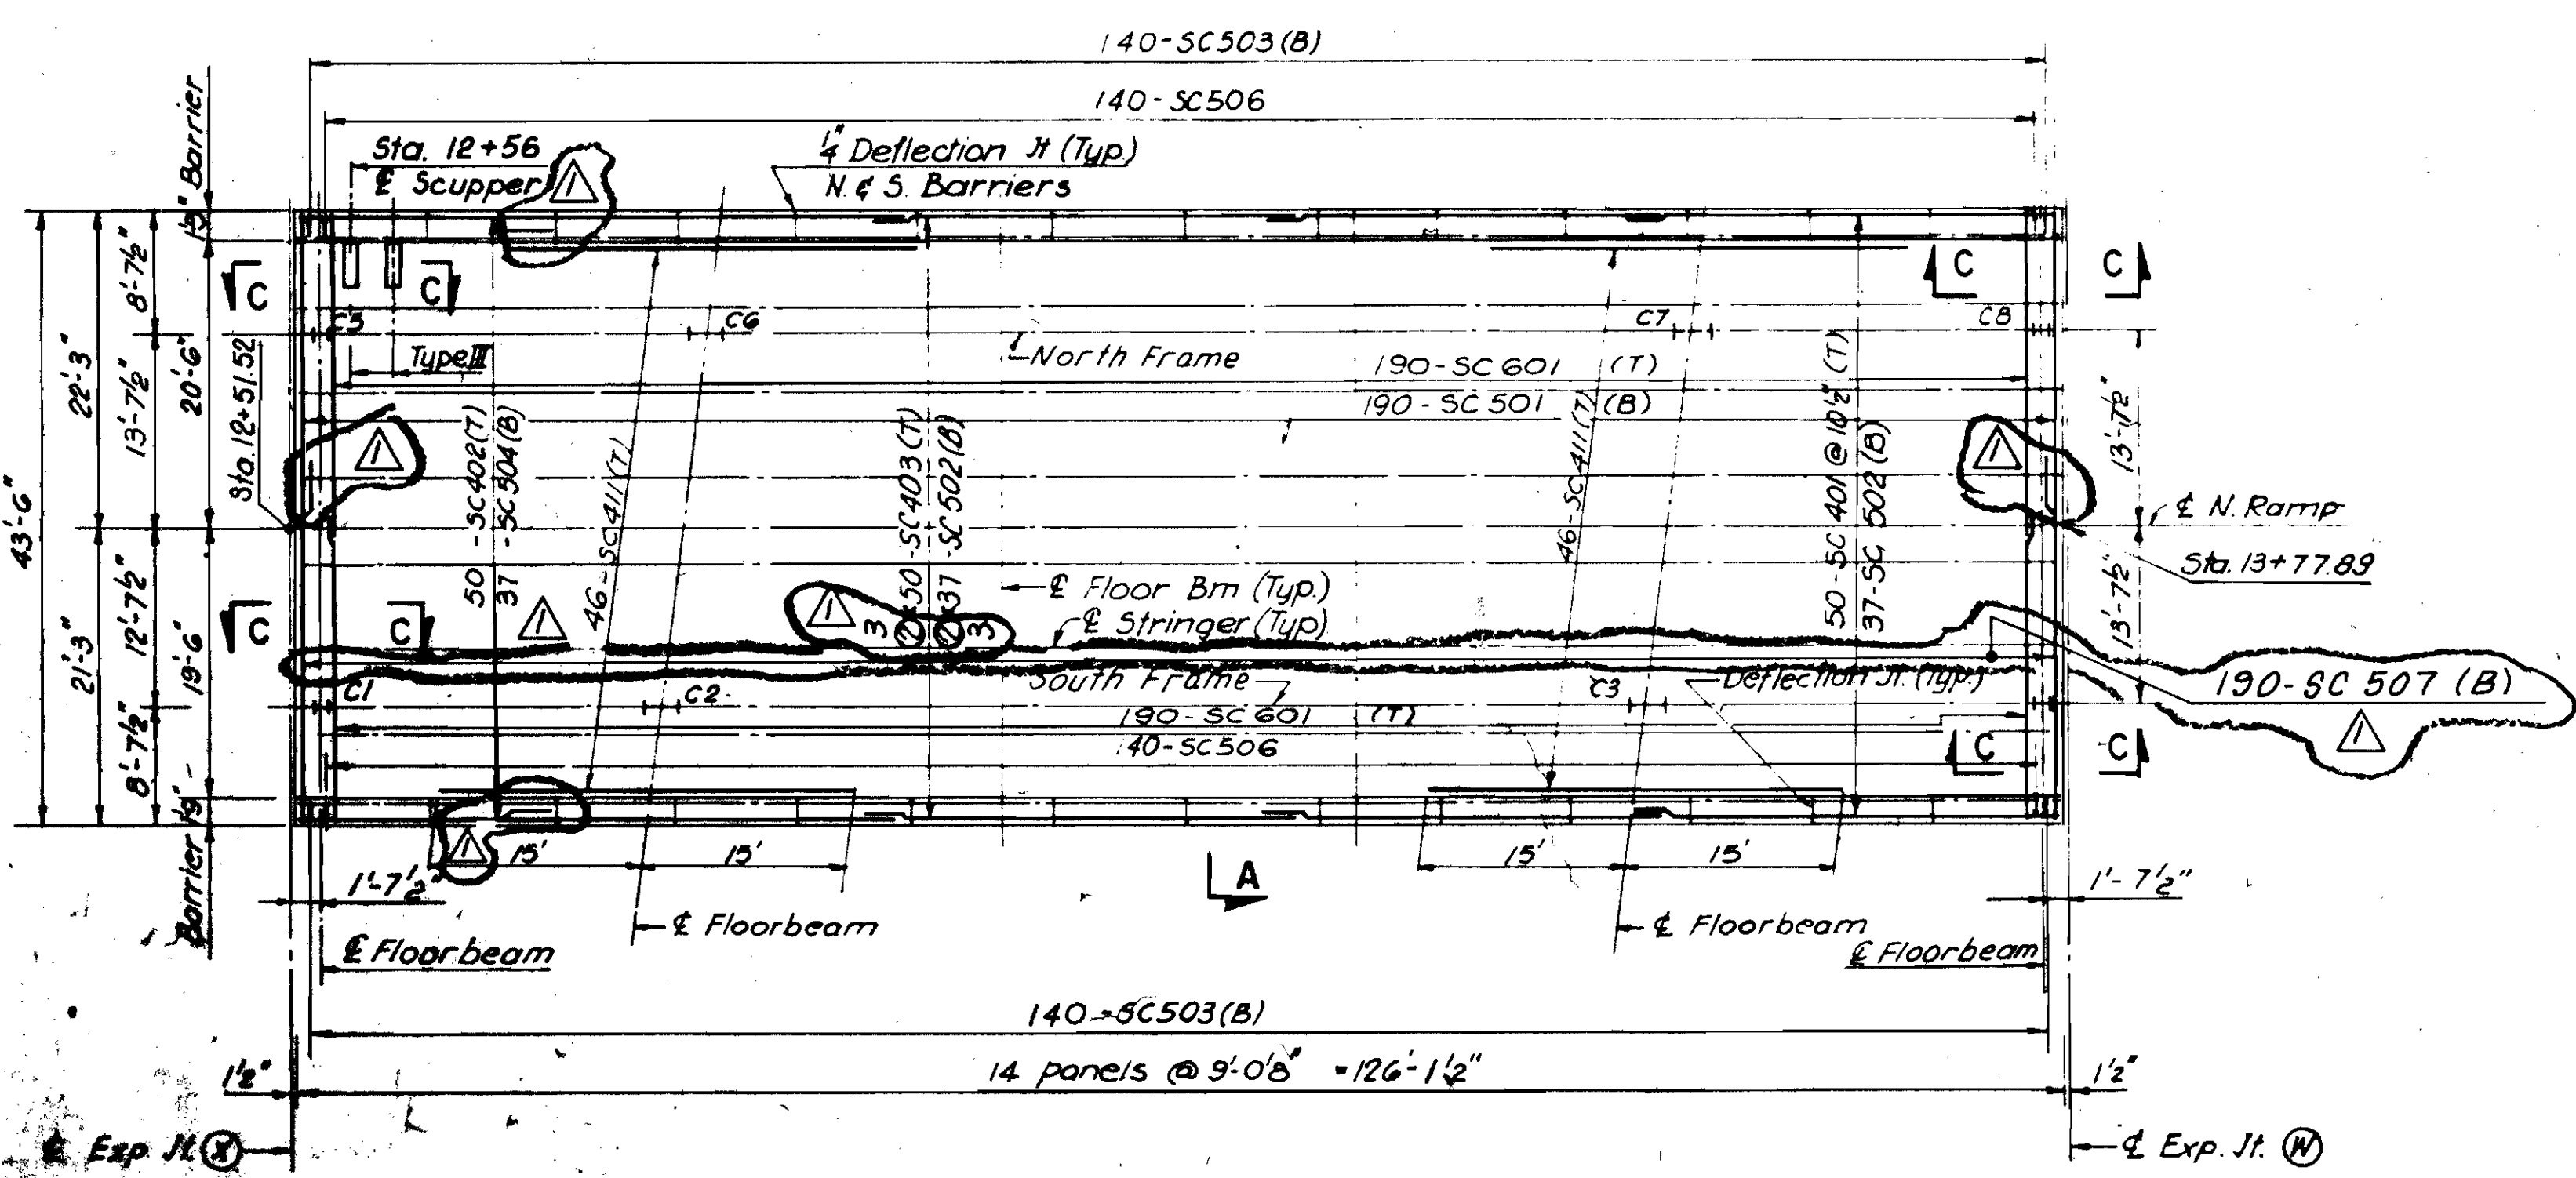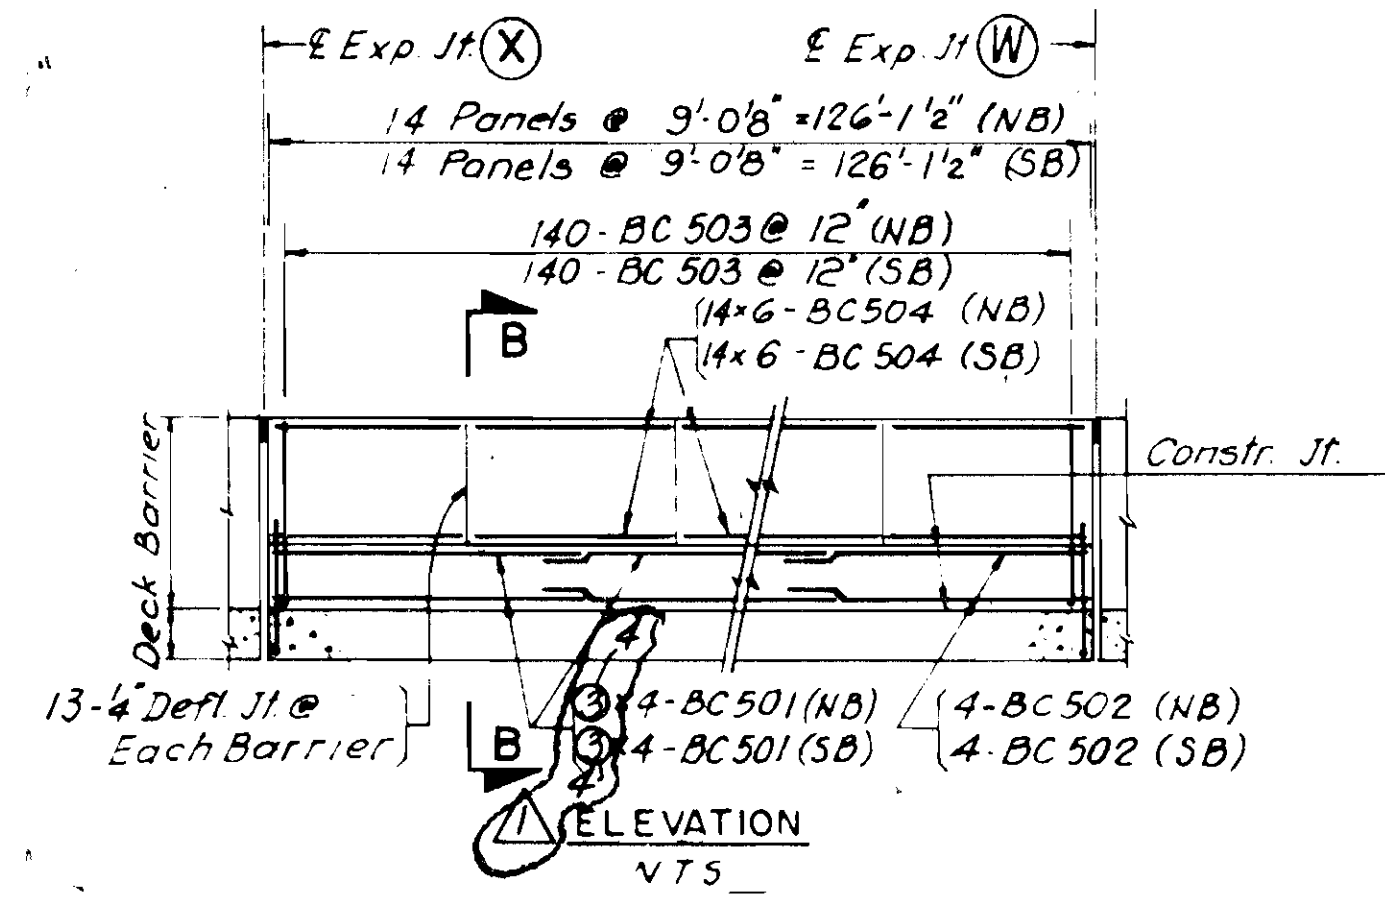

MINIMUM BAR LAP LENGTH	
BAR SIZE	MIN LAP
4	1'-10"
5	2'-3"
6	2'-8"

REFERENCES	DWG. NO.
Section B-B	176
Top of Deck Elevations & Deflections	170
Scupper Details & Reinforcement	654 & 655
Framing Plan	147
Expansion Joints	191
Bar List	199E
Haunch and Slab Depth Details	170

PAVLO ENGINEERING CO., P.C.  
NEW YORK, NEW YORK

CUYAHOGA COUNTY ENGINEER  
CLEVELAND OHIO

**MAIN AVENUE BRIDGE**  
CITY OF CLEVELAND  
BRIDGE OVER THE CUYAHOGA RIVER VALLEY

WEST APPROACH - SECTION C  
DECK SLAB REINFORCEMENT

BRIDGE NO. 195 REPORT NO. 7119 DATE 10/83

**NO. B-136** 174  
991




DESIGN: B.G. DRAWN: J.H. CHECKED: A.F. REVISIONS: AS BUILT 2/94

MICROFILMED  
JUL 22 1984

FHWA REGION	STATE	PROJECT	
5	OHIO	BHF-73(51)	

173  
547


CUYAHOGA COUNTY  
CUY-2-14.66

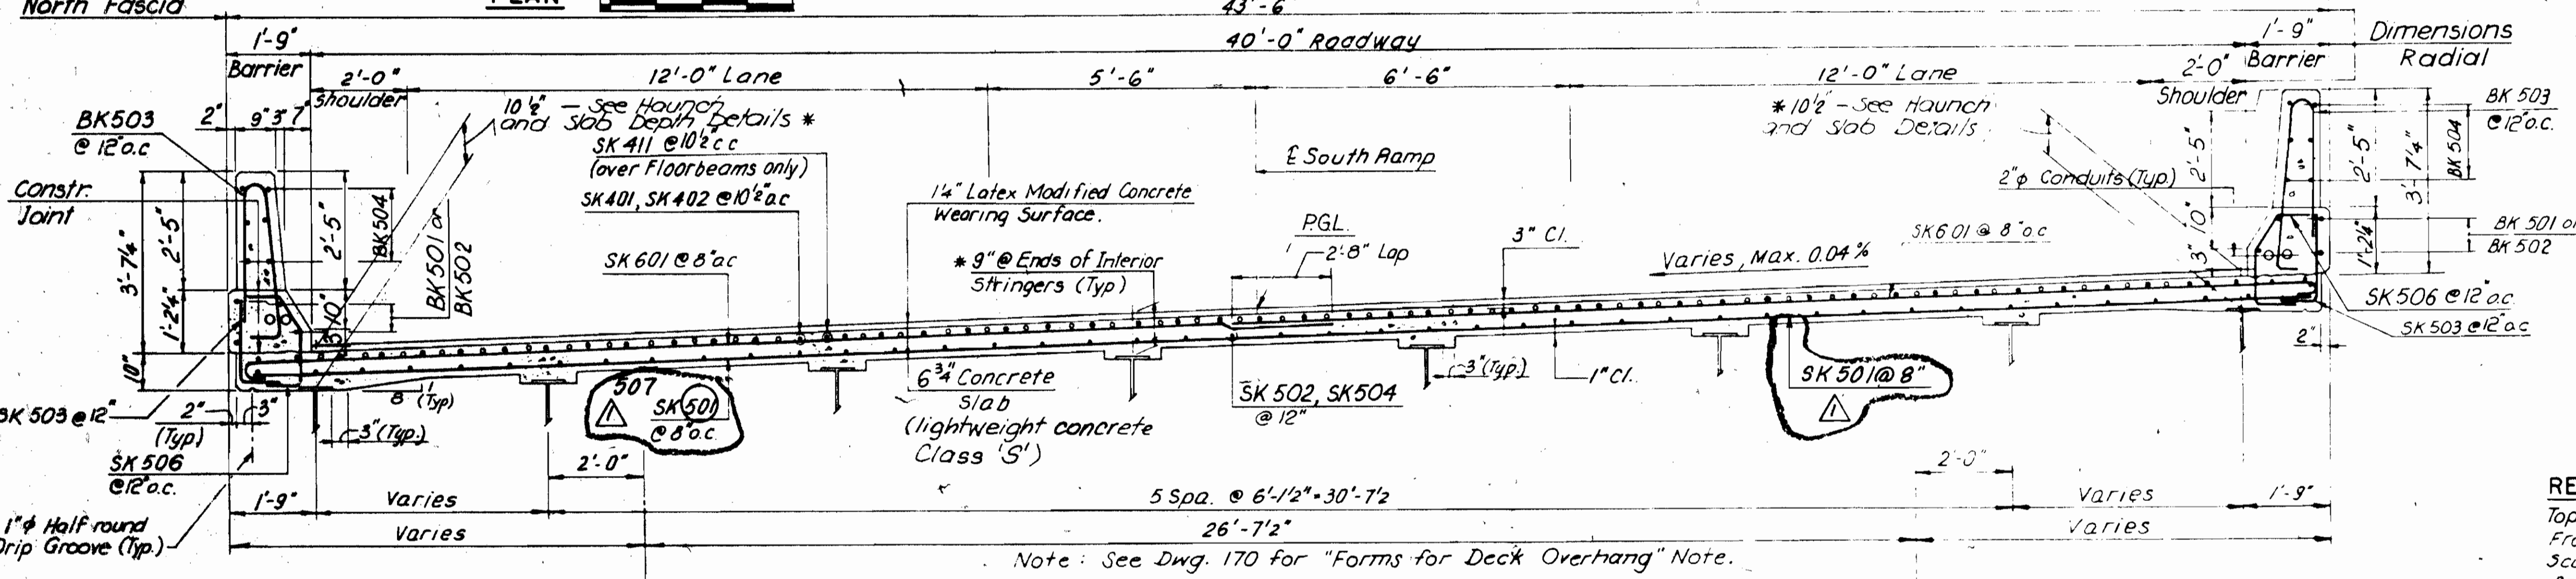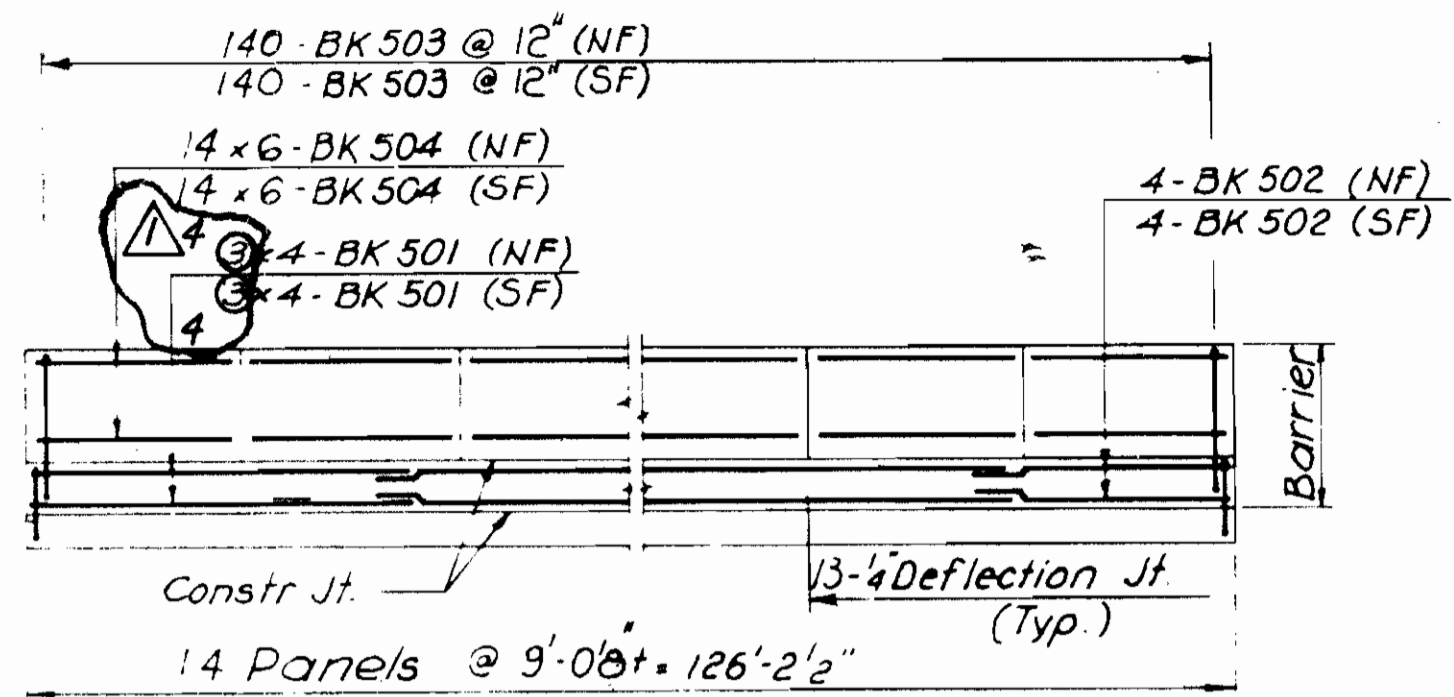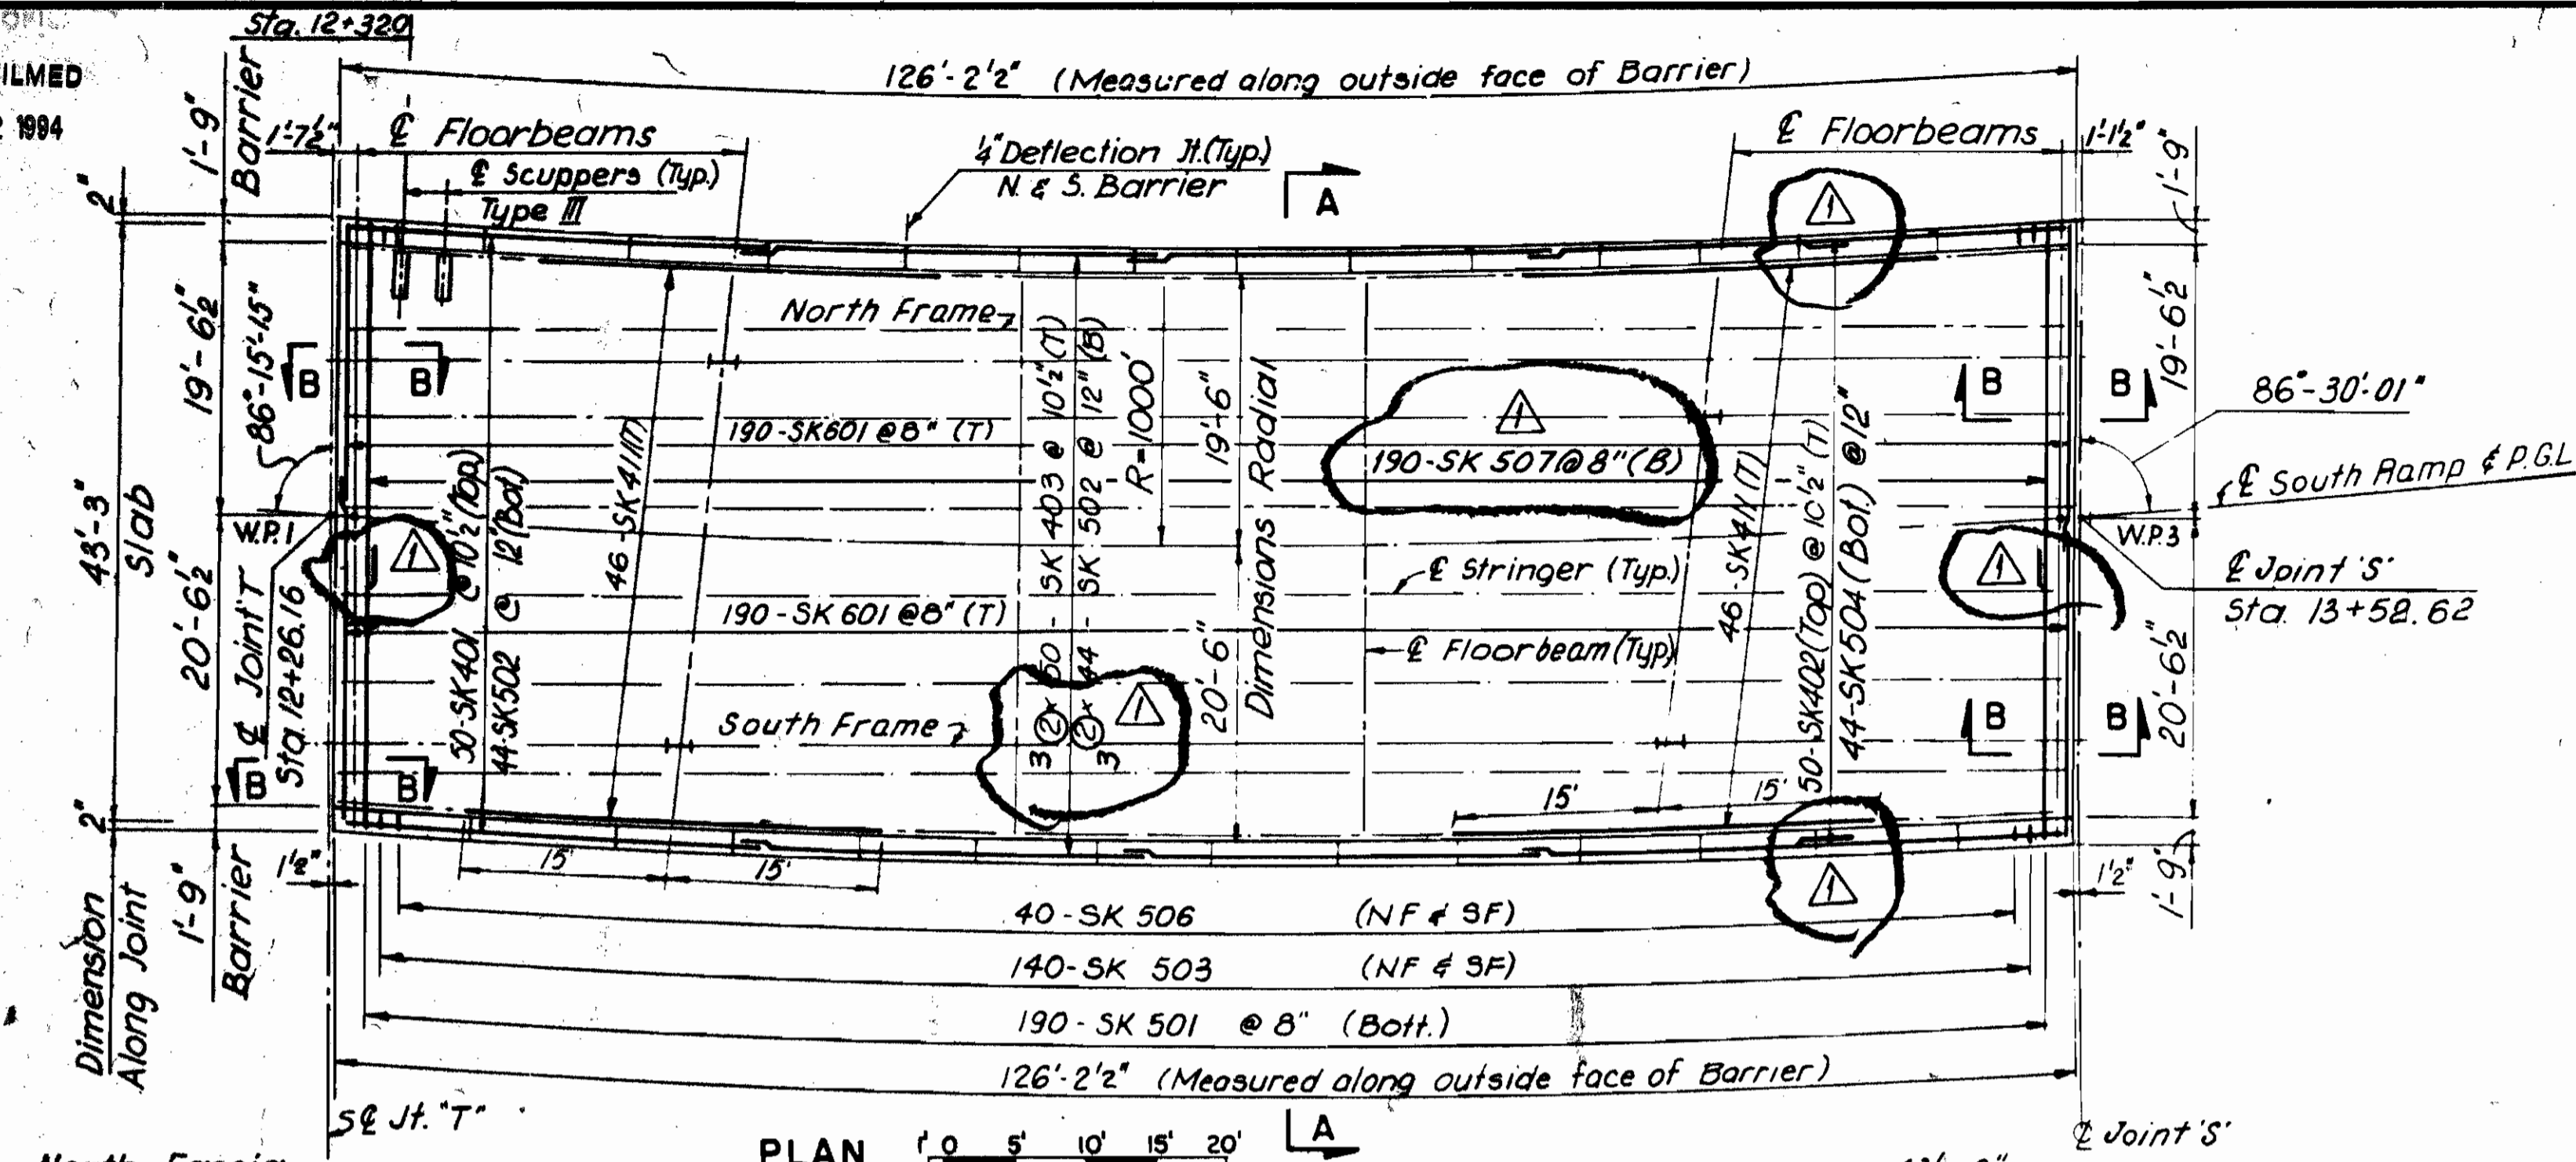

BAR SIZE	MIN. LAP
#4	1'-10"
#5	2'-3"
#6	2'-8"

Top of Deck Elevations and Deflections	170
Framing Plan	147
Scupper Details and Reinforcement	654 & 655
Bar List	199E
Haunch and Slab Depth Details	170
*Haunch and Slab Depth Notes	174

DWG. NO.

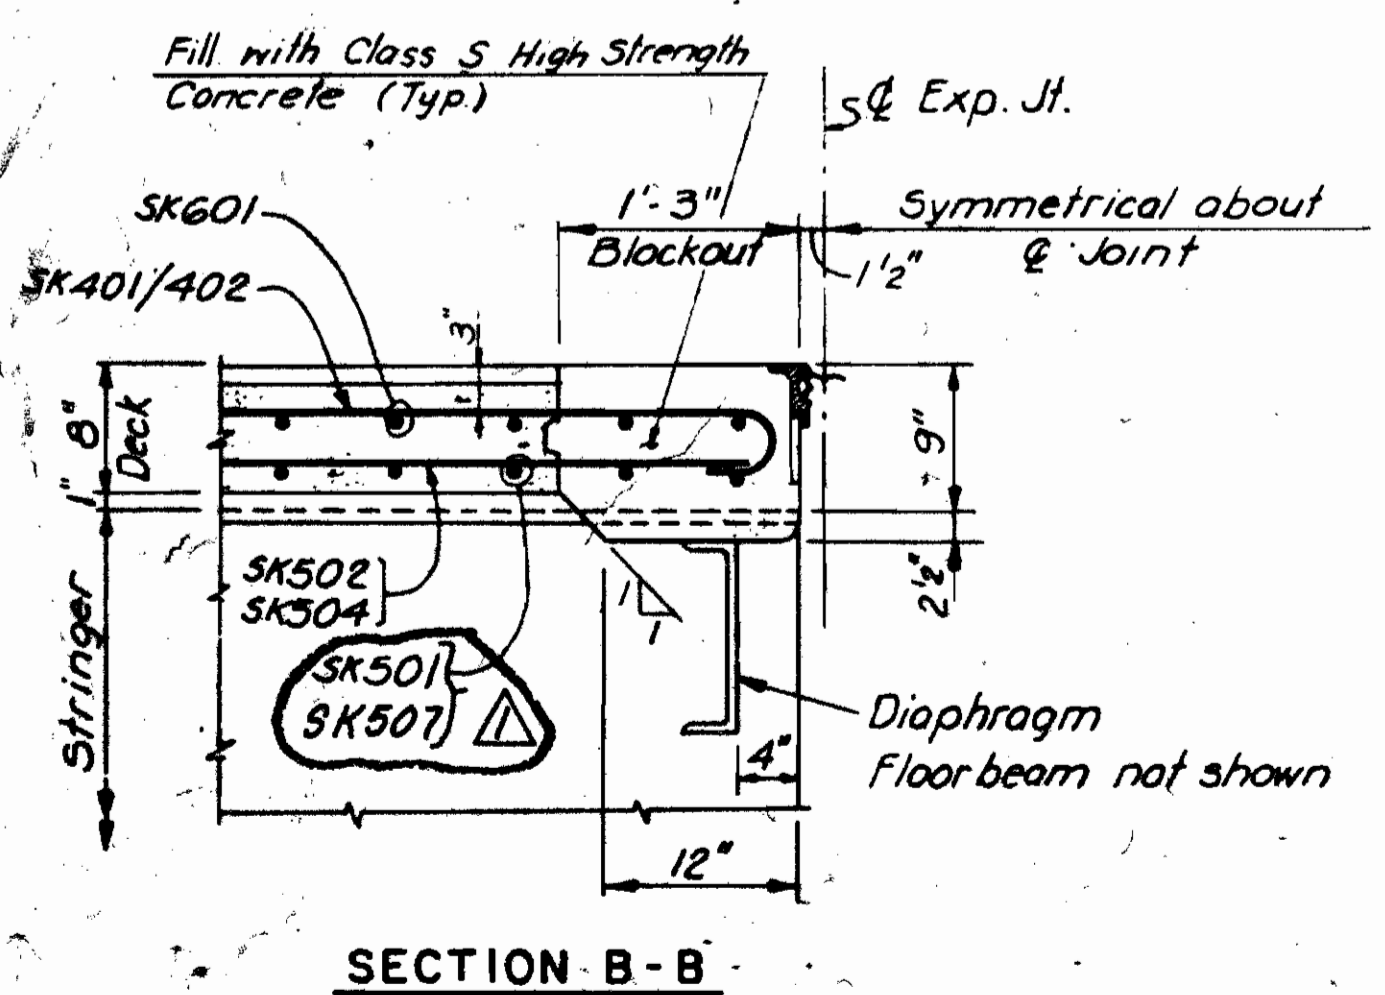

PAVLO ENGINEERING CO., P.C.  
NEW YORK, NEW YORK

CUYAHOGA COUNTY ENGINEER  
CLEVELAND OHIO

**MAIN AVENUE BRIDGE**  
CITY OF CLEVELAND  
BRIDGE OVER THE CUYAHOGA RIVER VALLEY

WEST APPROACH-SECTION K  
**DECK SLAB REINFORCEMENT**

BRIDGE NO. 193 REPORT NO. 7119 DATE Nov. 11, 1992

**NO. B-136**

DESIGN	DRAWN	CHECKED	REVISED TO AS BUILT
B.G.	A.M.	R.D.M.	AS BUILT 2/91

Rev. 1 Plan Revisions 2-25-91


FHWA REGION	STATF	PROJECT	
5	OHIO	BHF-73(51)	

REFERENCES:


- Top of Deck Elevations and Deflections 171
- Framing Plan 149
- Scupper Details and Reinforcement 654, 655
- Lamp Support Pilasters & Reinforcement 663
- Bar List 199F
- Haunch and Slab Depth Details 170
- \* Haunch and Slab Depth Notes 174

DWG. NO.


- 171
- 149
- 654, 655
- 663
- 199F
- 170
- 174

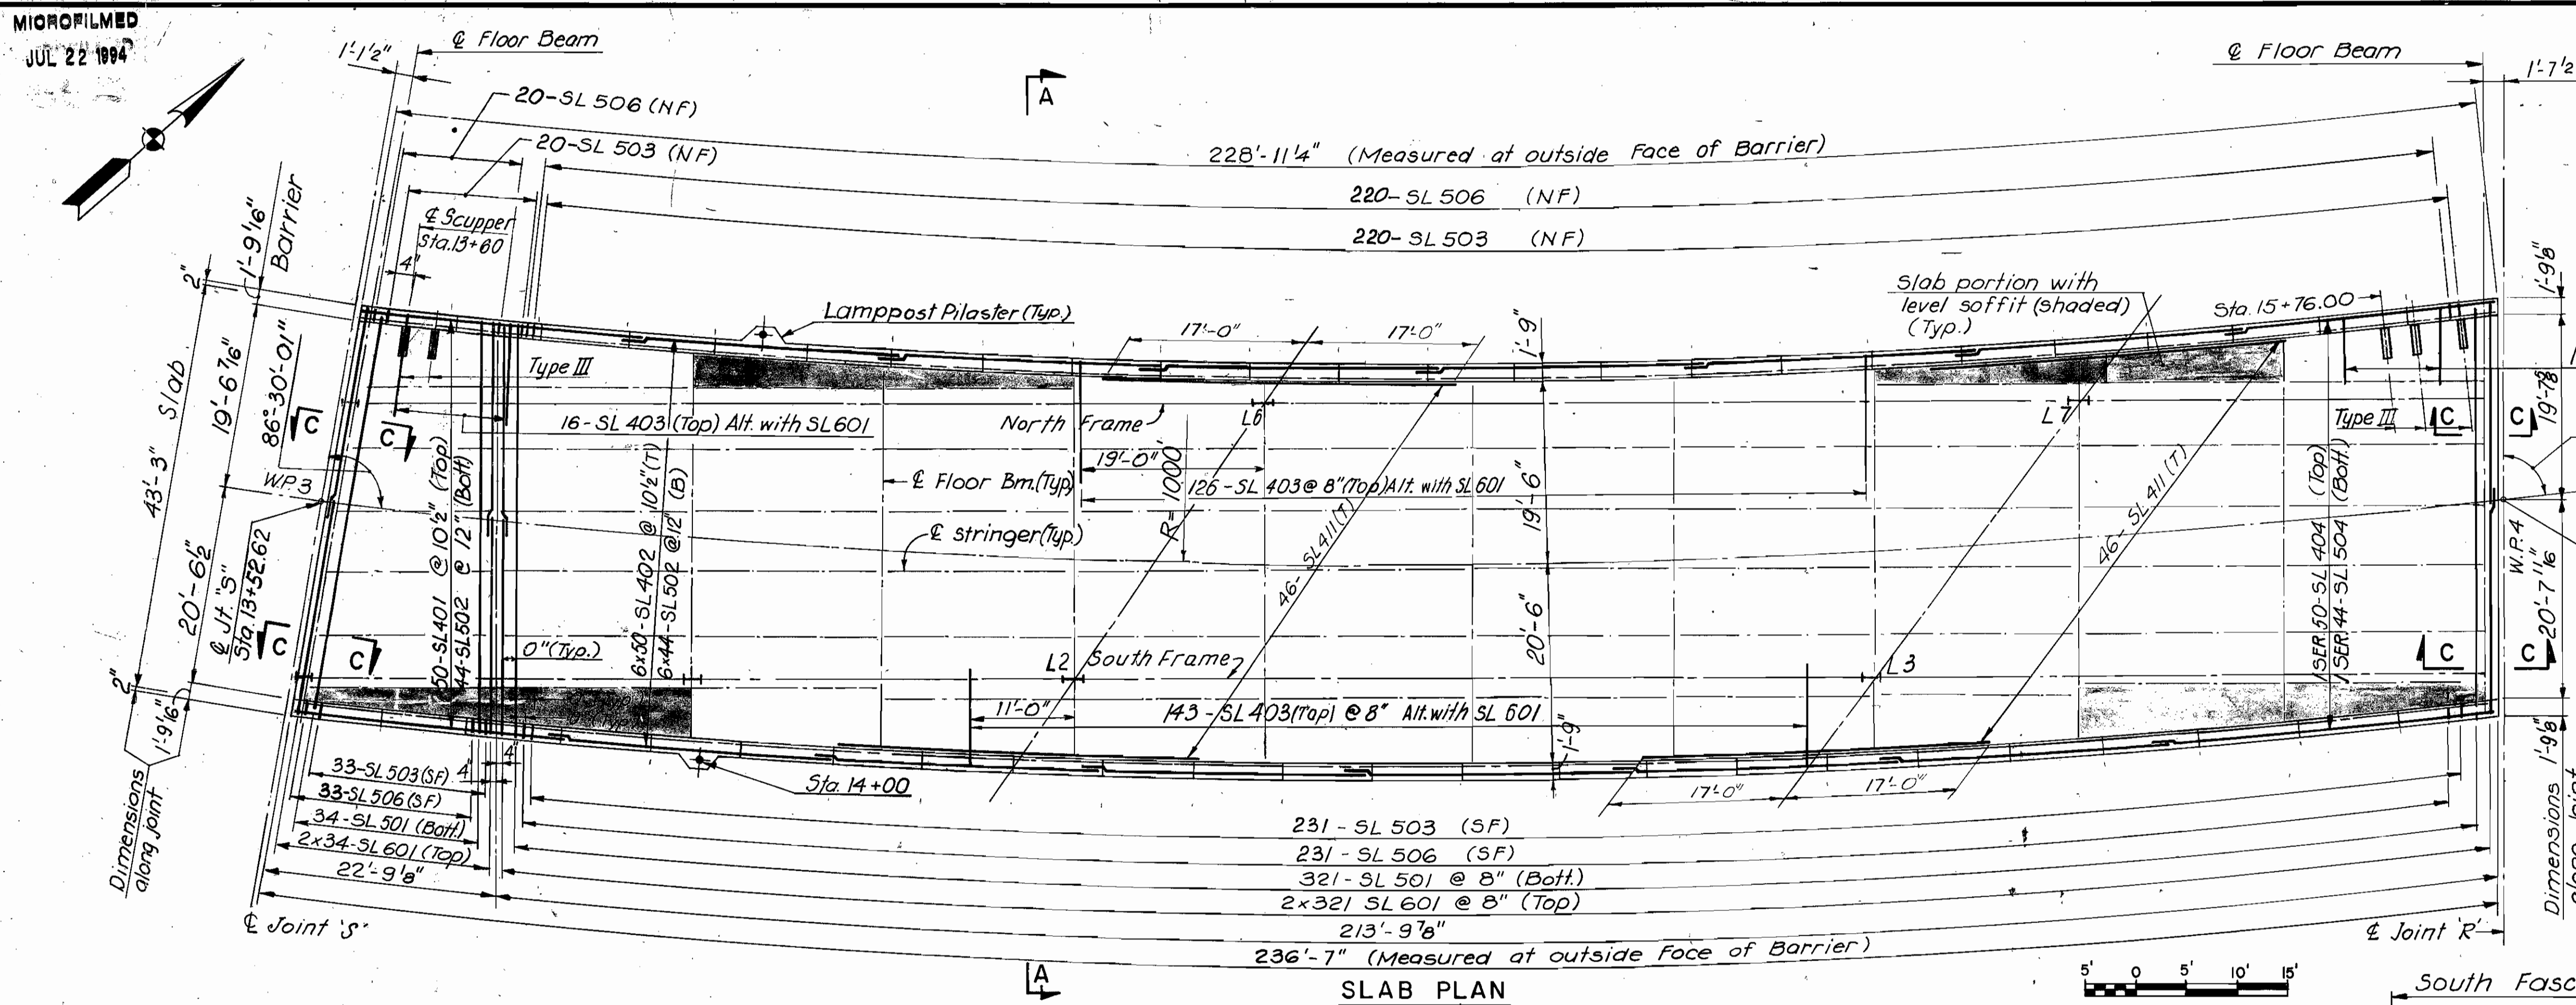


SLAB PLAN

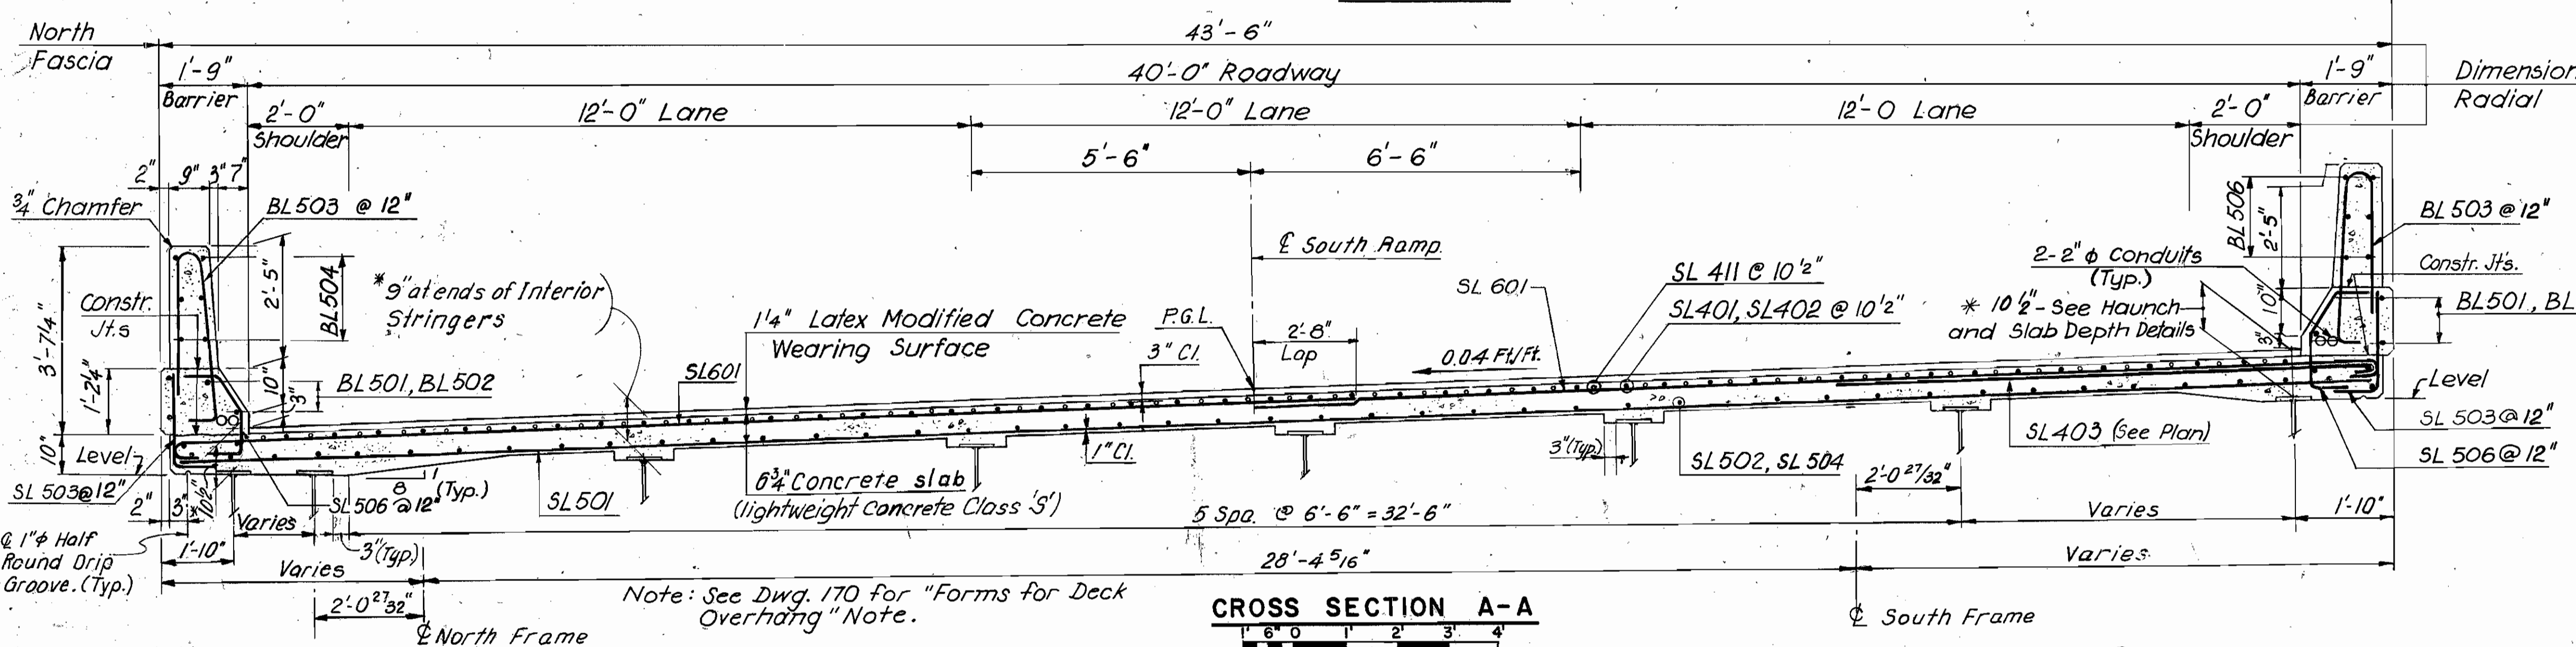


CROSS SECTION A-A

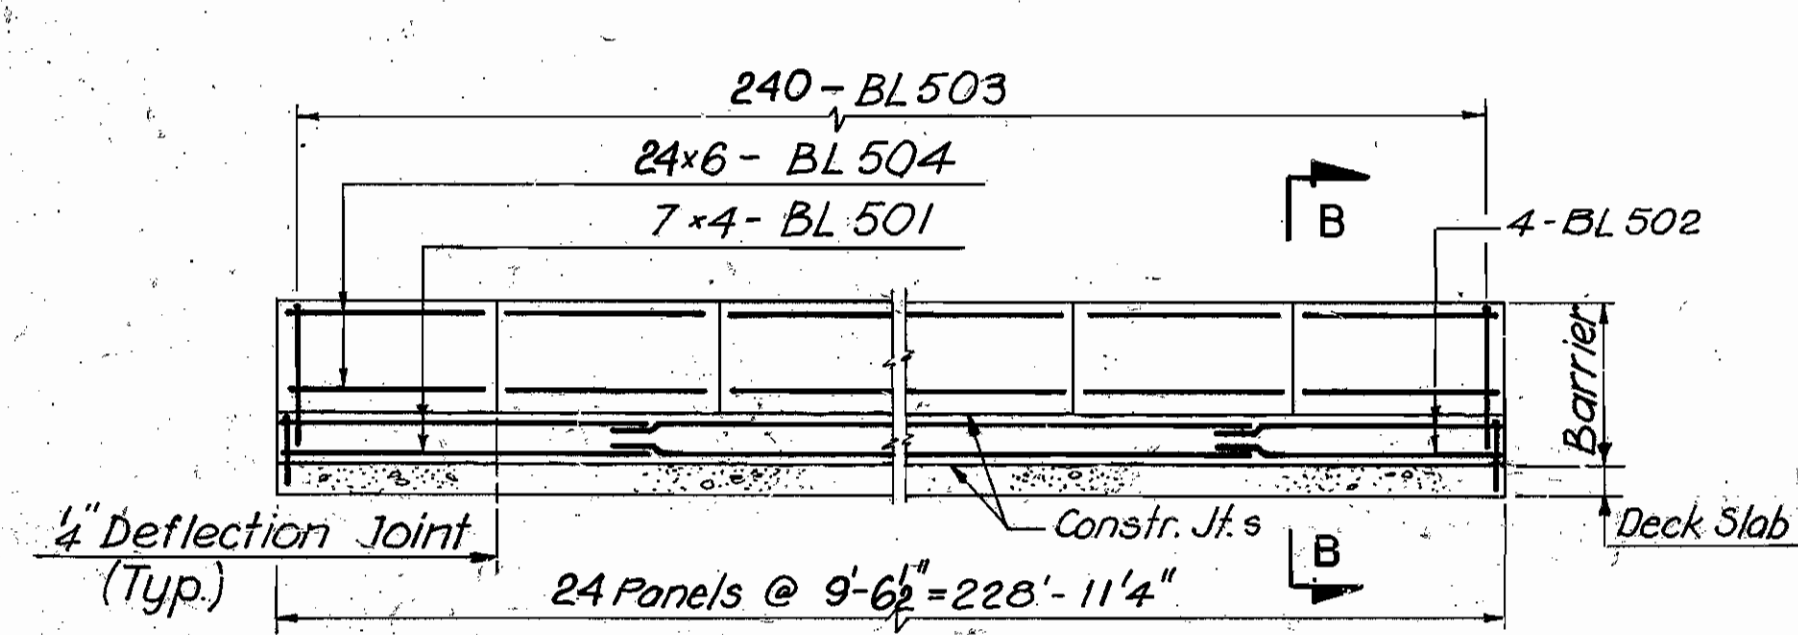


BARRIER (North Fascia)  
N.T.S.

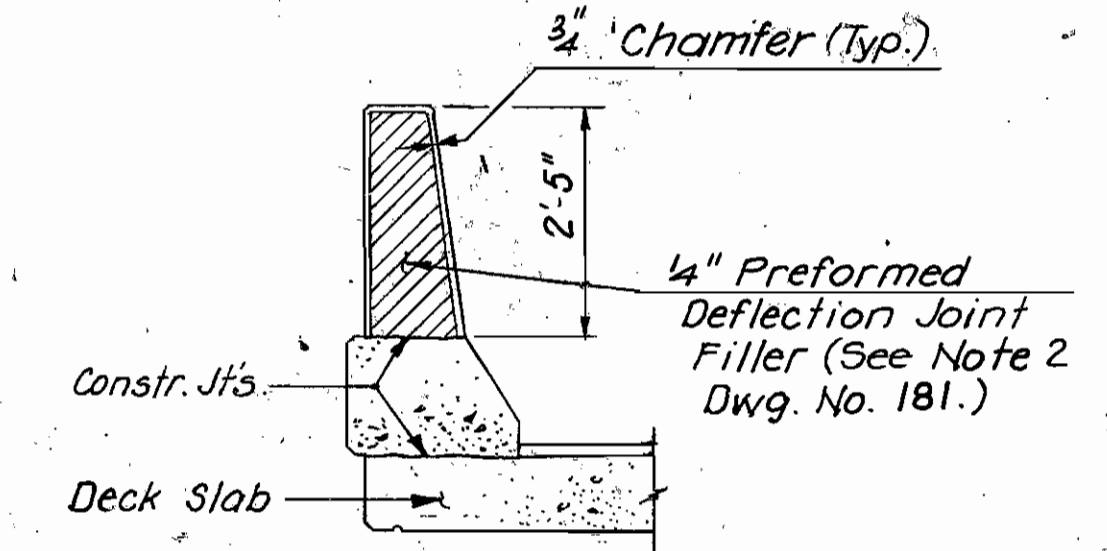

SECTION B-B  
TYPICAL BARRIER JOINT DETAIL  
N.T.S.

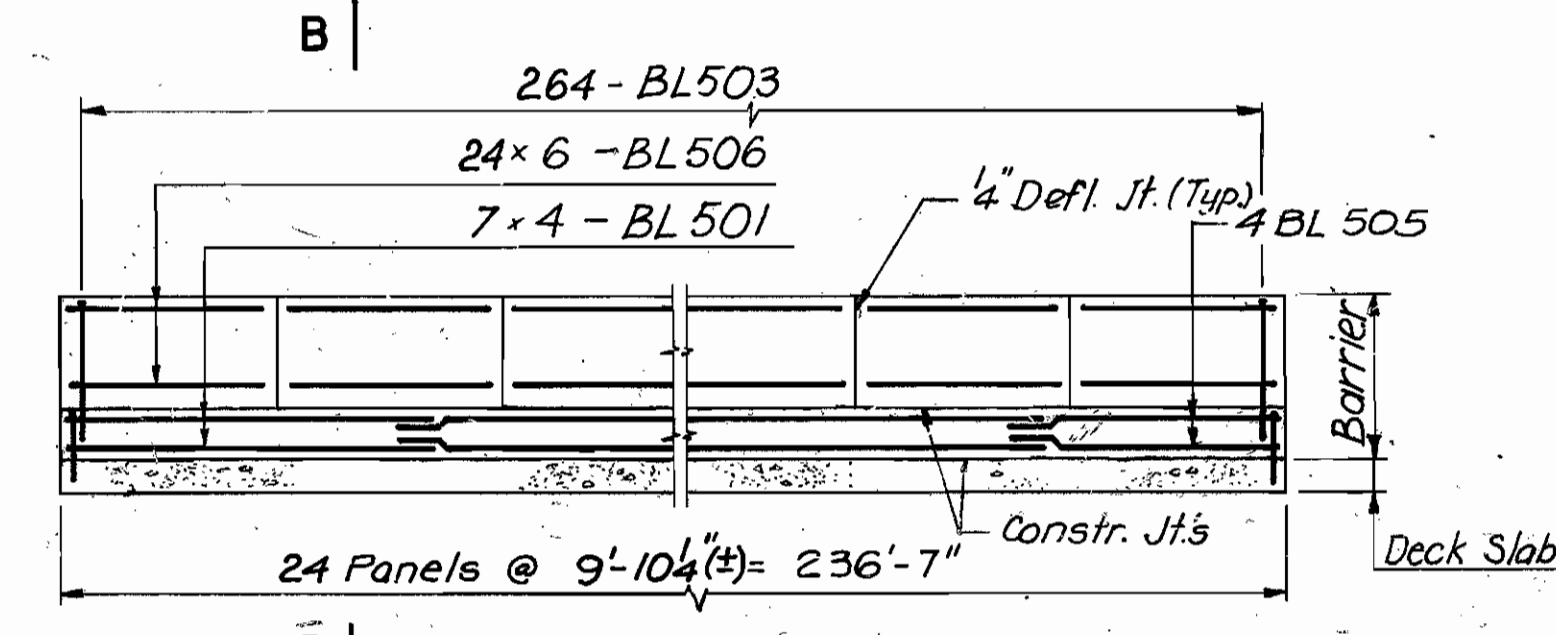

BARRIER (South Fascia)  
N.T.S.

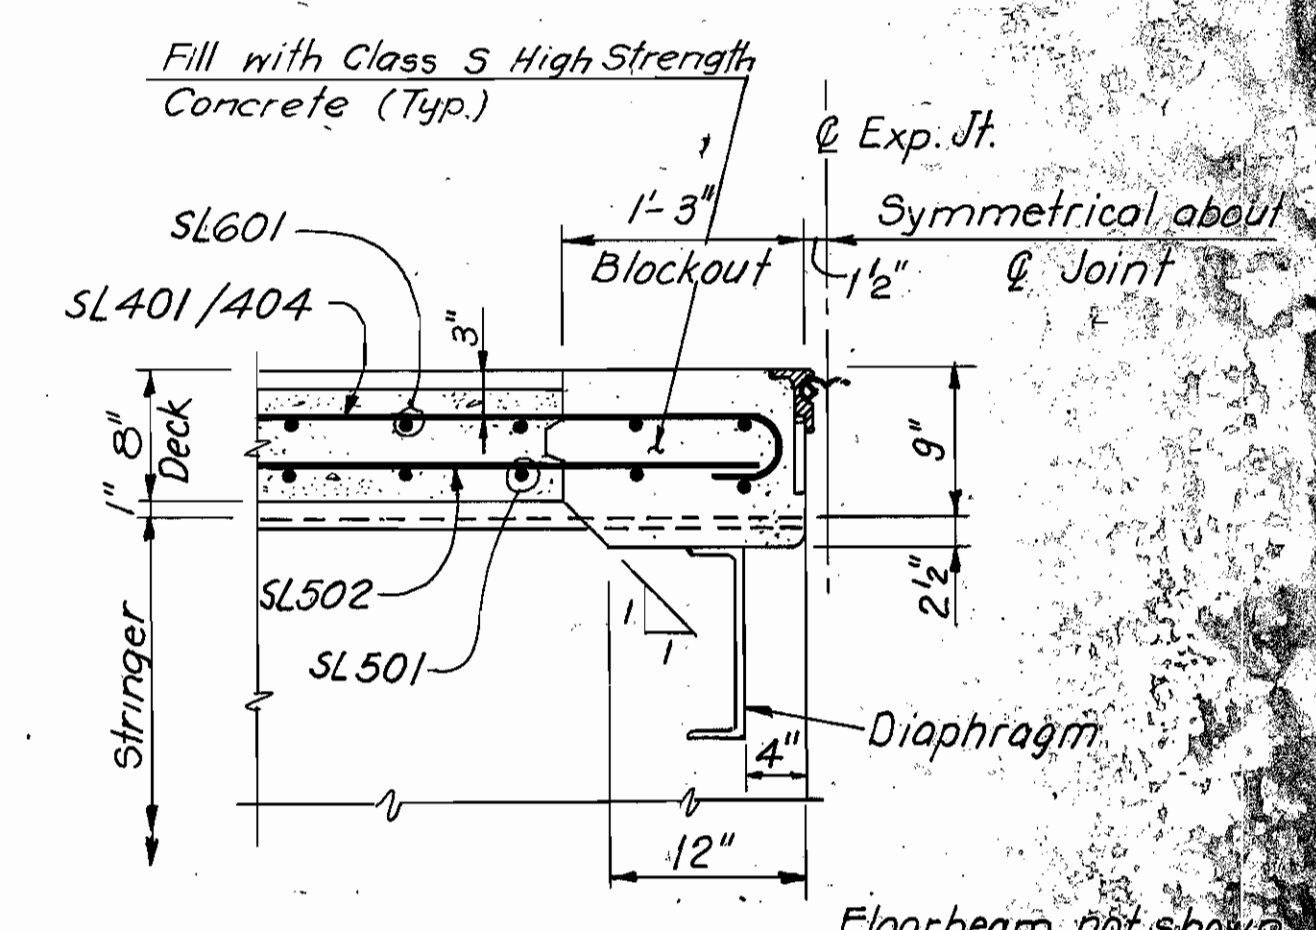

SECTION C-C

PAVLO ENGINEERING CO., P.C.  
NEW YORK, NEW YORK

CUYAHOGA COUNTY ENGINEER  
CLEVELAND OHIO



**MAIN AVENUE BRIDGE**  
CITY OF CLEVELAND  
BRIDGE OVER THE CUYAHOGA RIVER VALLEY

WEST APPROACH SECTION L  
**DECK SLAB REINFORCEMENT**

BRIDGE NO. 193 REPORT NO. 7119 DATE 11/22/66

**NO. B-136**




DESIGN B.G.	DRAWN A.M.	CHECKED R.D.M.	REVISION TO AS BUILT
----------------	---------------	-------------------	-------------------------

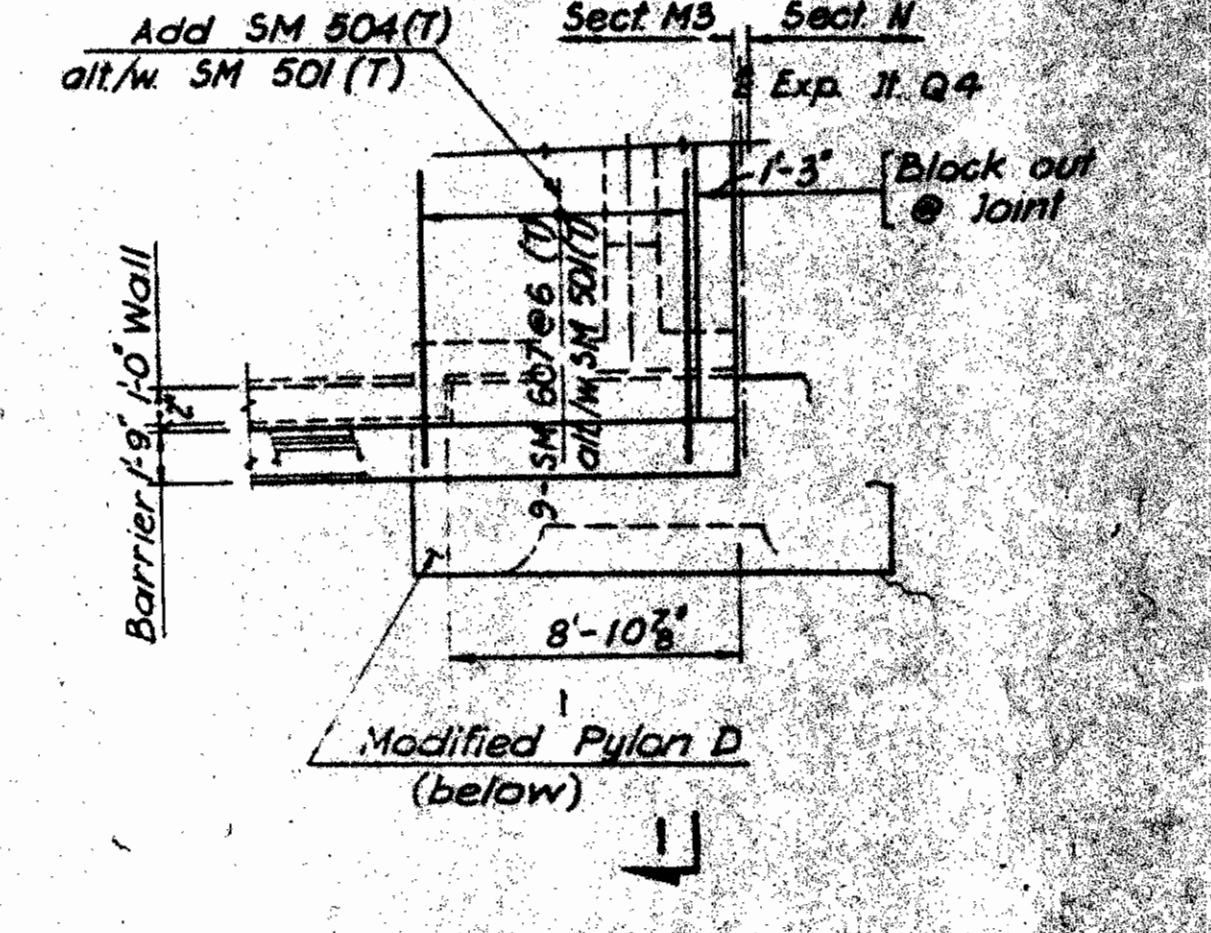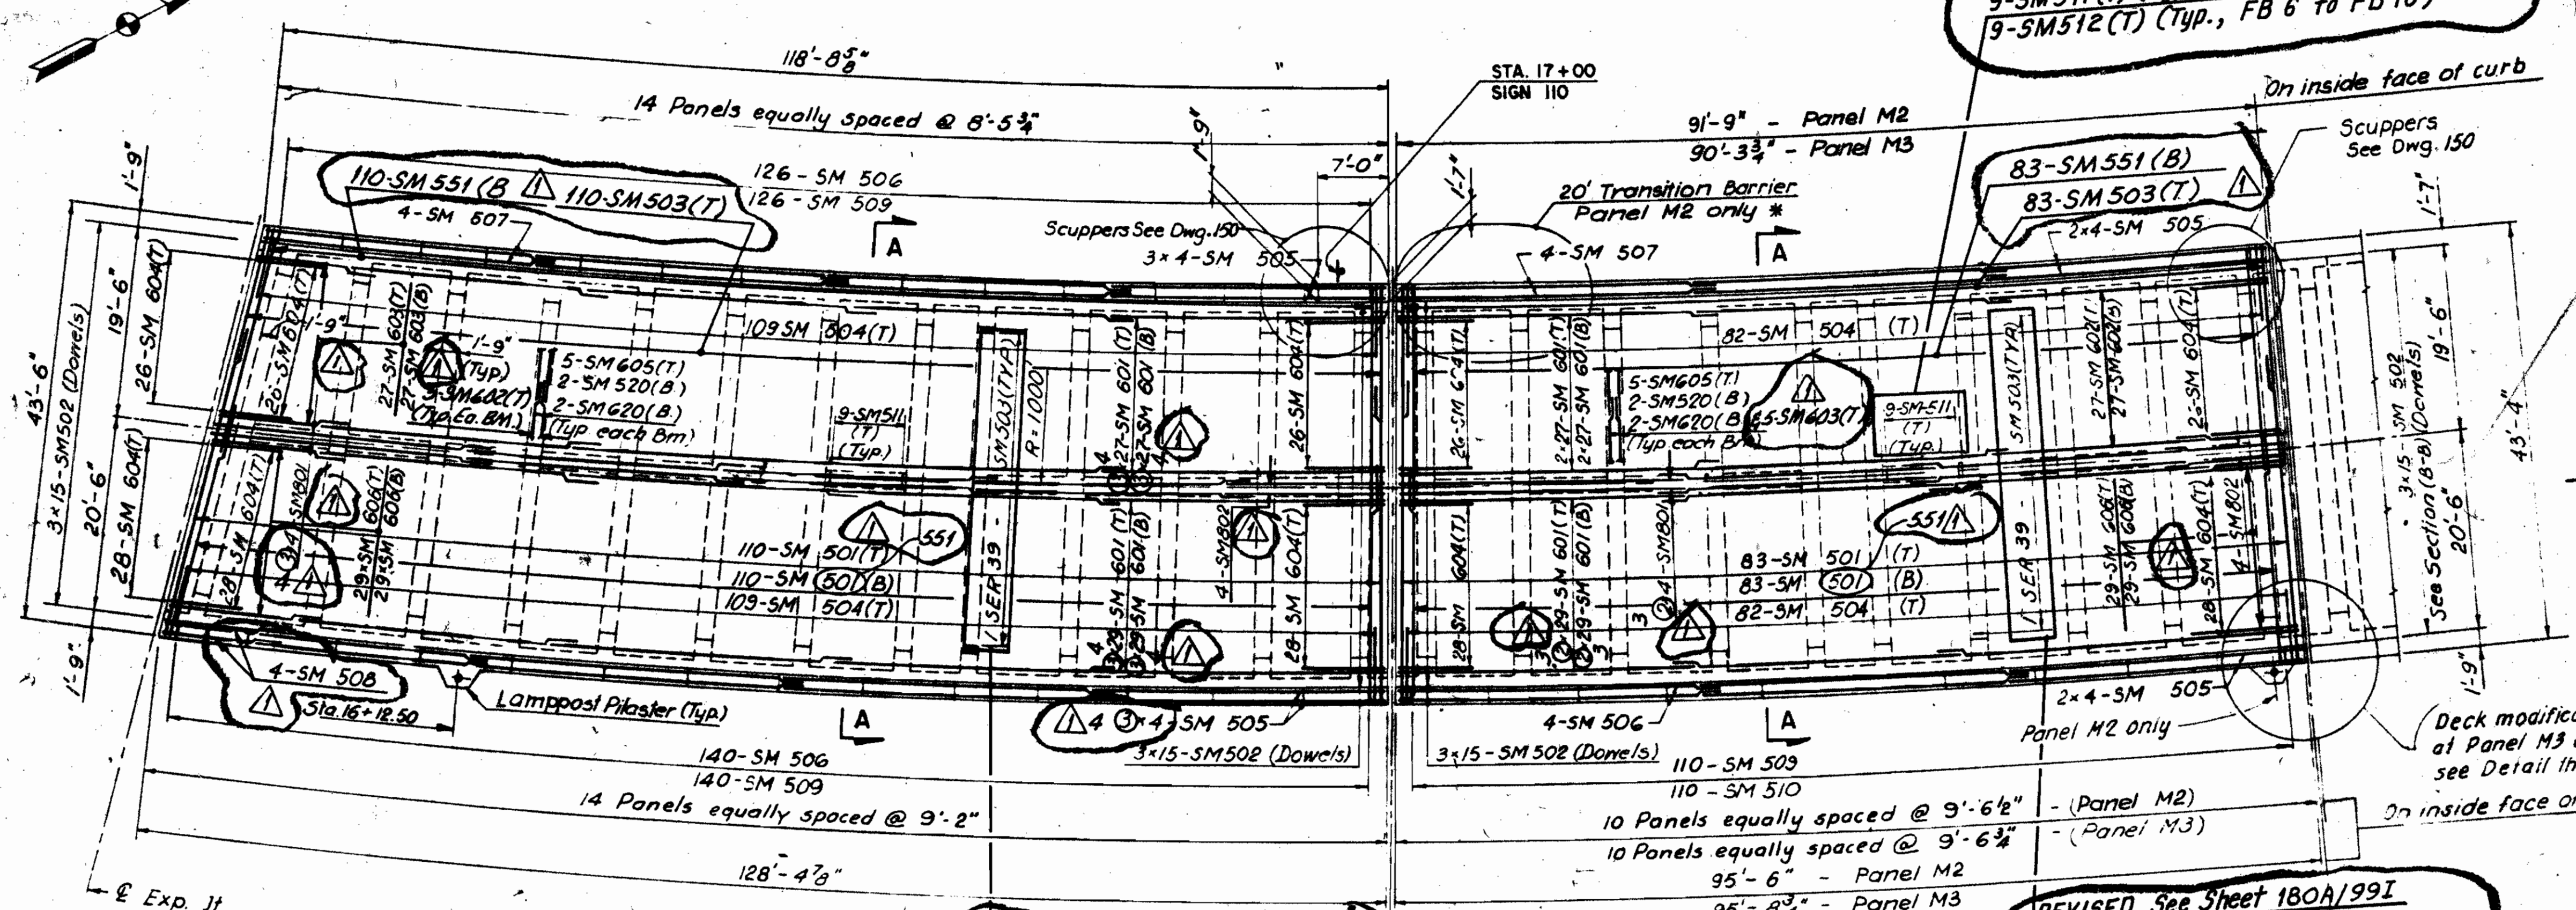

**MINIMUM LAP LENGTHS (TYPICAL UNLESS NOTED)**

BAR SIZE	LENGTH REQ'D.
#5	2'-3"
#6	2'-8"
#8	4'-7"

\*Lightweight Concrete

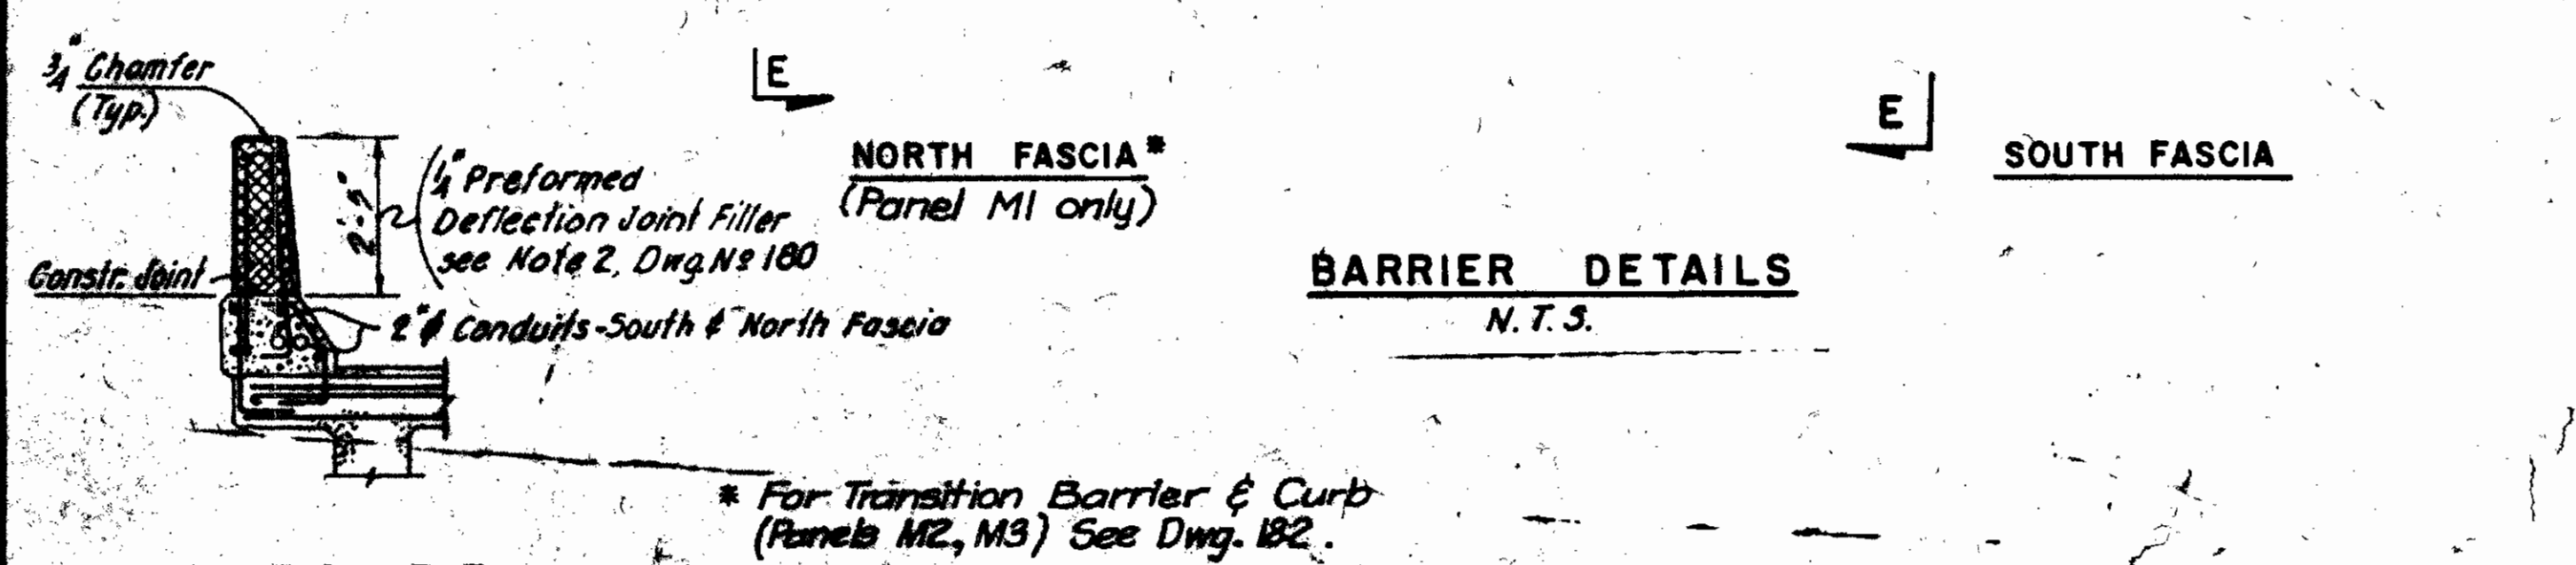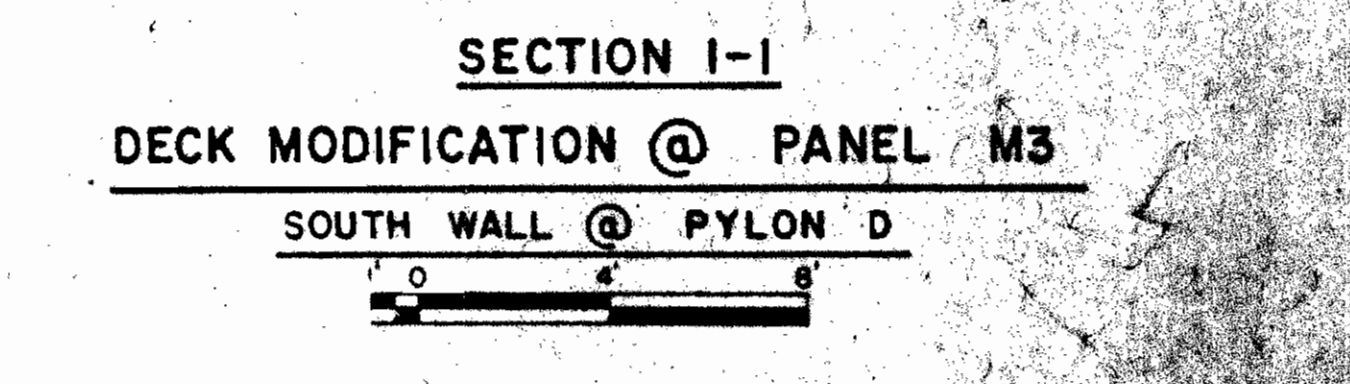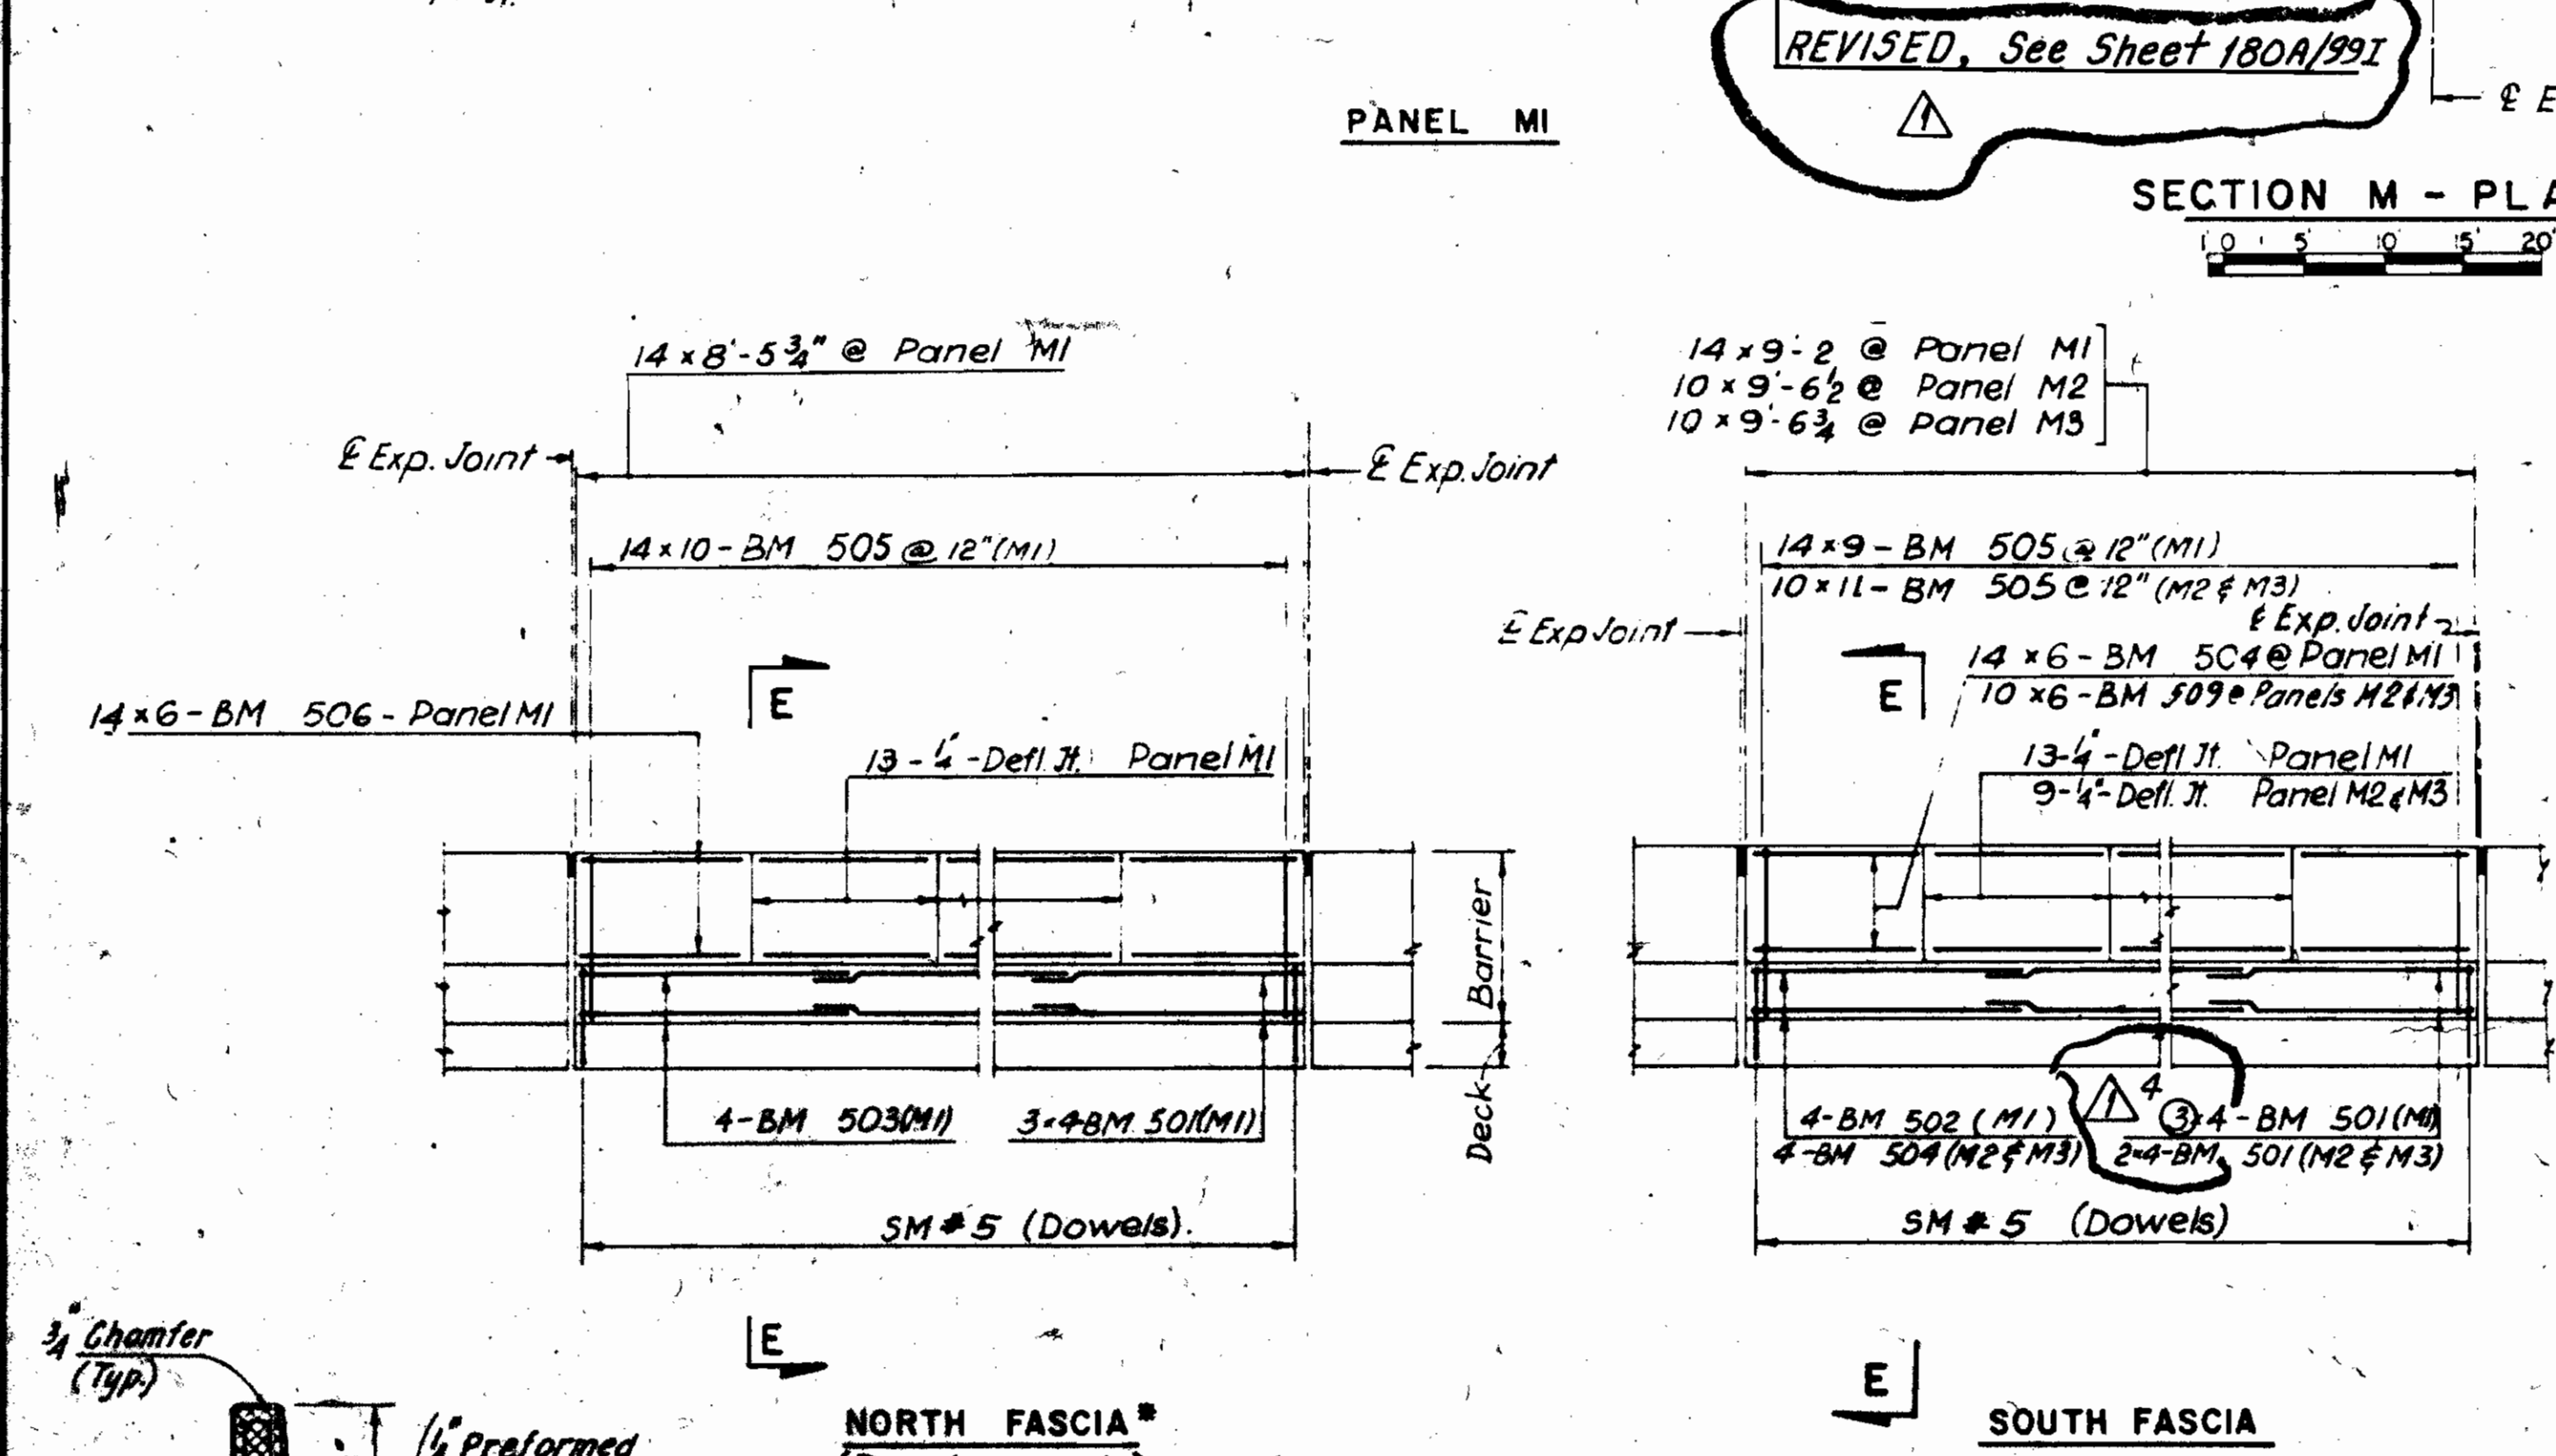

- REFERENCES:
- Sections A-A & B-B
  - Transition Barrier and Reinforcement
  - Other References
  - Notes
  - Bar List
  - Proposed Deck Plan
- DWG. NO.:
- 181
  - 182
  - 145
  - 180
  - 199A & 199B
  - 150

PAVLO ENGINEERING CO., P.C.  
 NEW YORK, NEW YORK

CUYAHOGA COUNTY ENGINEER  
 CLEVELAND OHIO

**MAIN AVENUE BRIDGE**  
 CITY OF CLEVELAND  
 BRIDGE OVER THE CUYAHOGA RIVER VALLEY

WEST APPROACH - SECTION M  
**DECK SLAB REINFORCEMENT**

BRIDGE NO. 193 REPORT NO. 7119 DATE Nov 11, 1993






**NO. B-136**

DESIGN A.S. DRAWN L.T. CHECKED R.D.M. REVISED TO AS BUILT 2/94

MICROFILMED  
JUL 22 1994

FHWA REGION	STATE	PROJECT	176
5	OHIO	BHF - 73(51)	547

CUYAHOGA COUNTY  
CUY-2-14.66

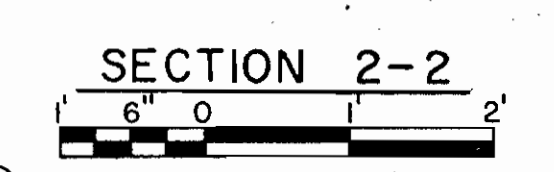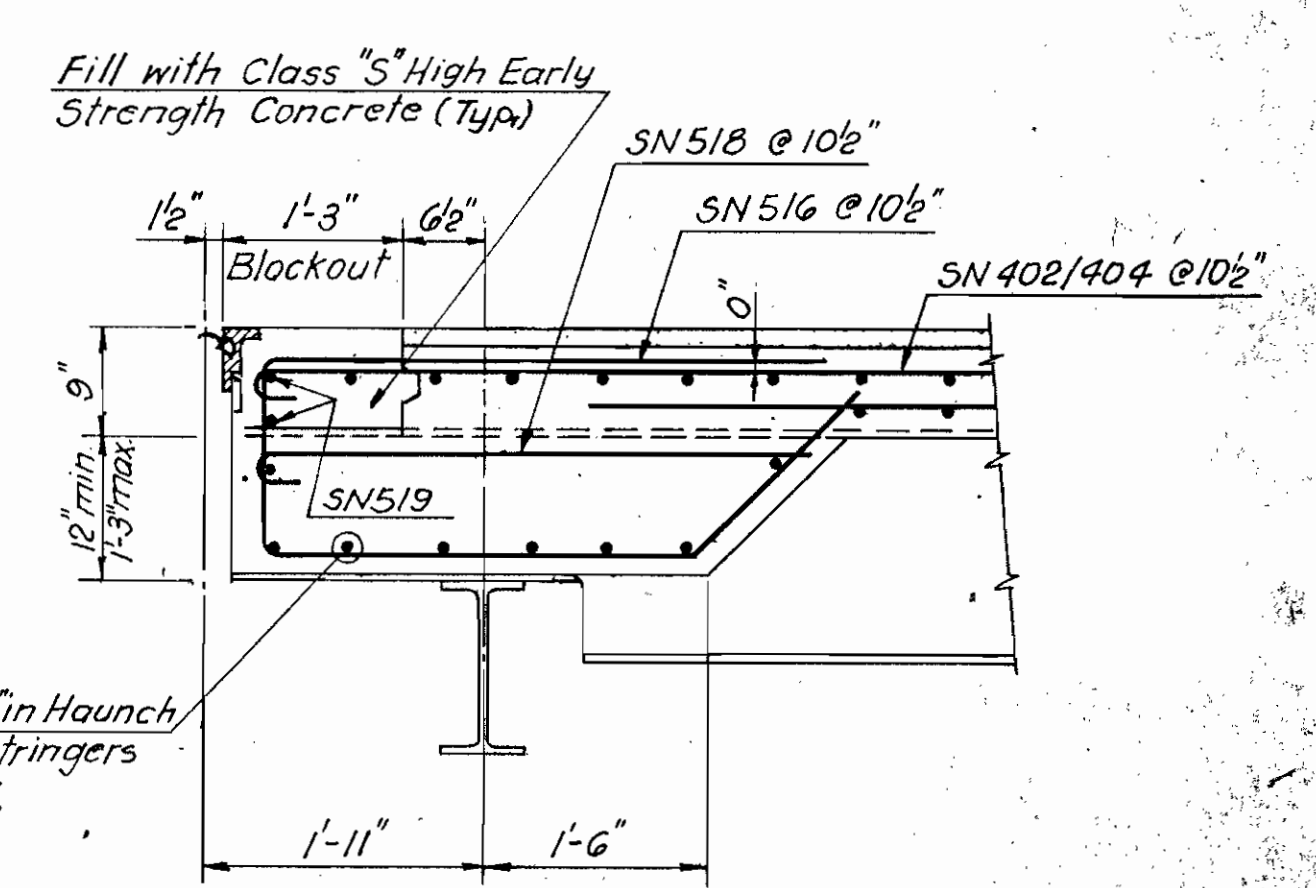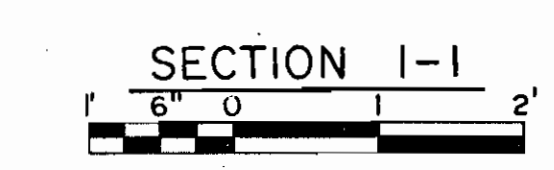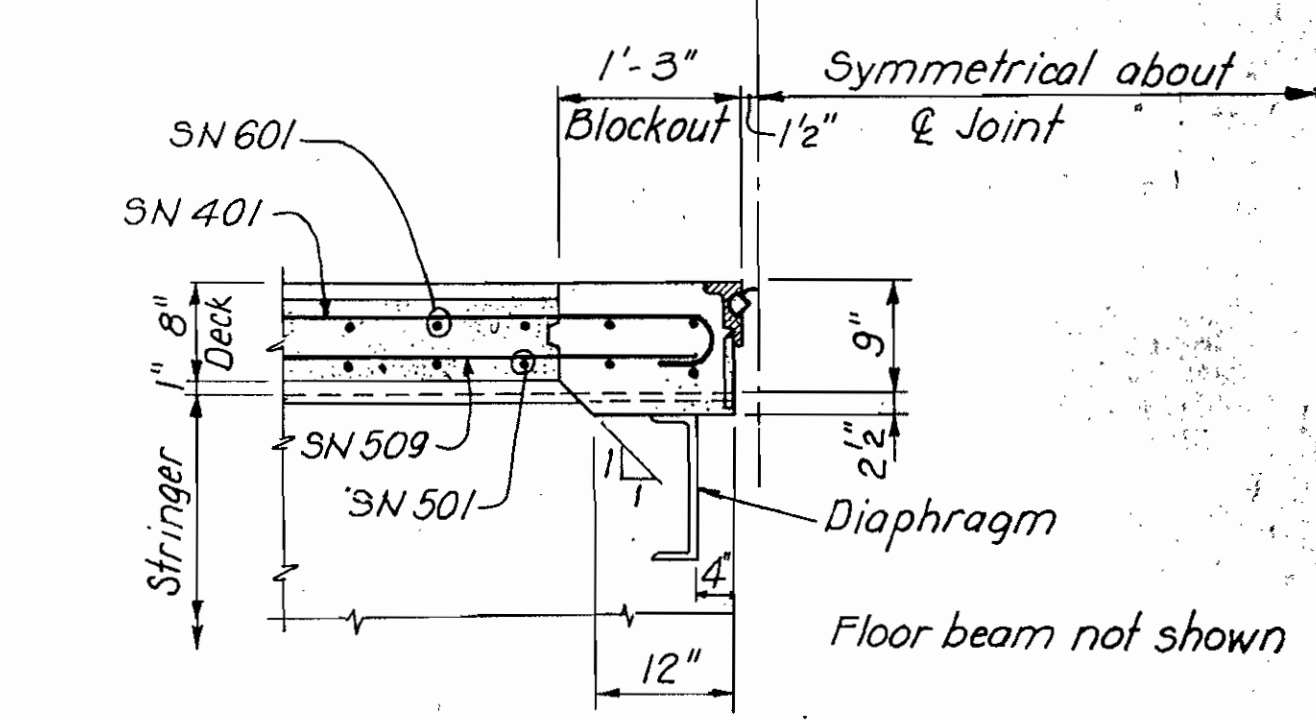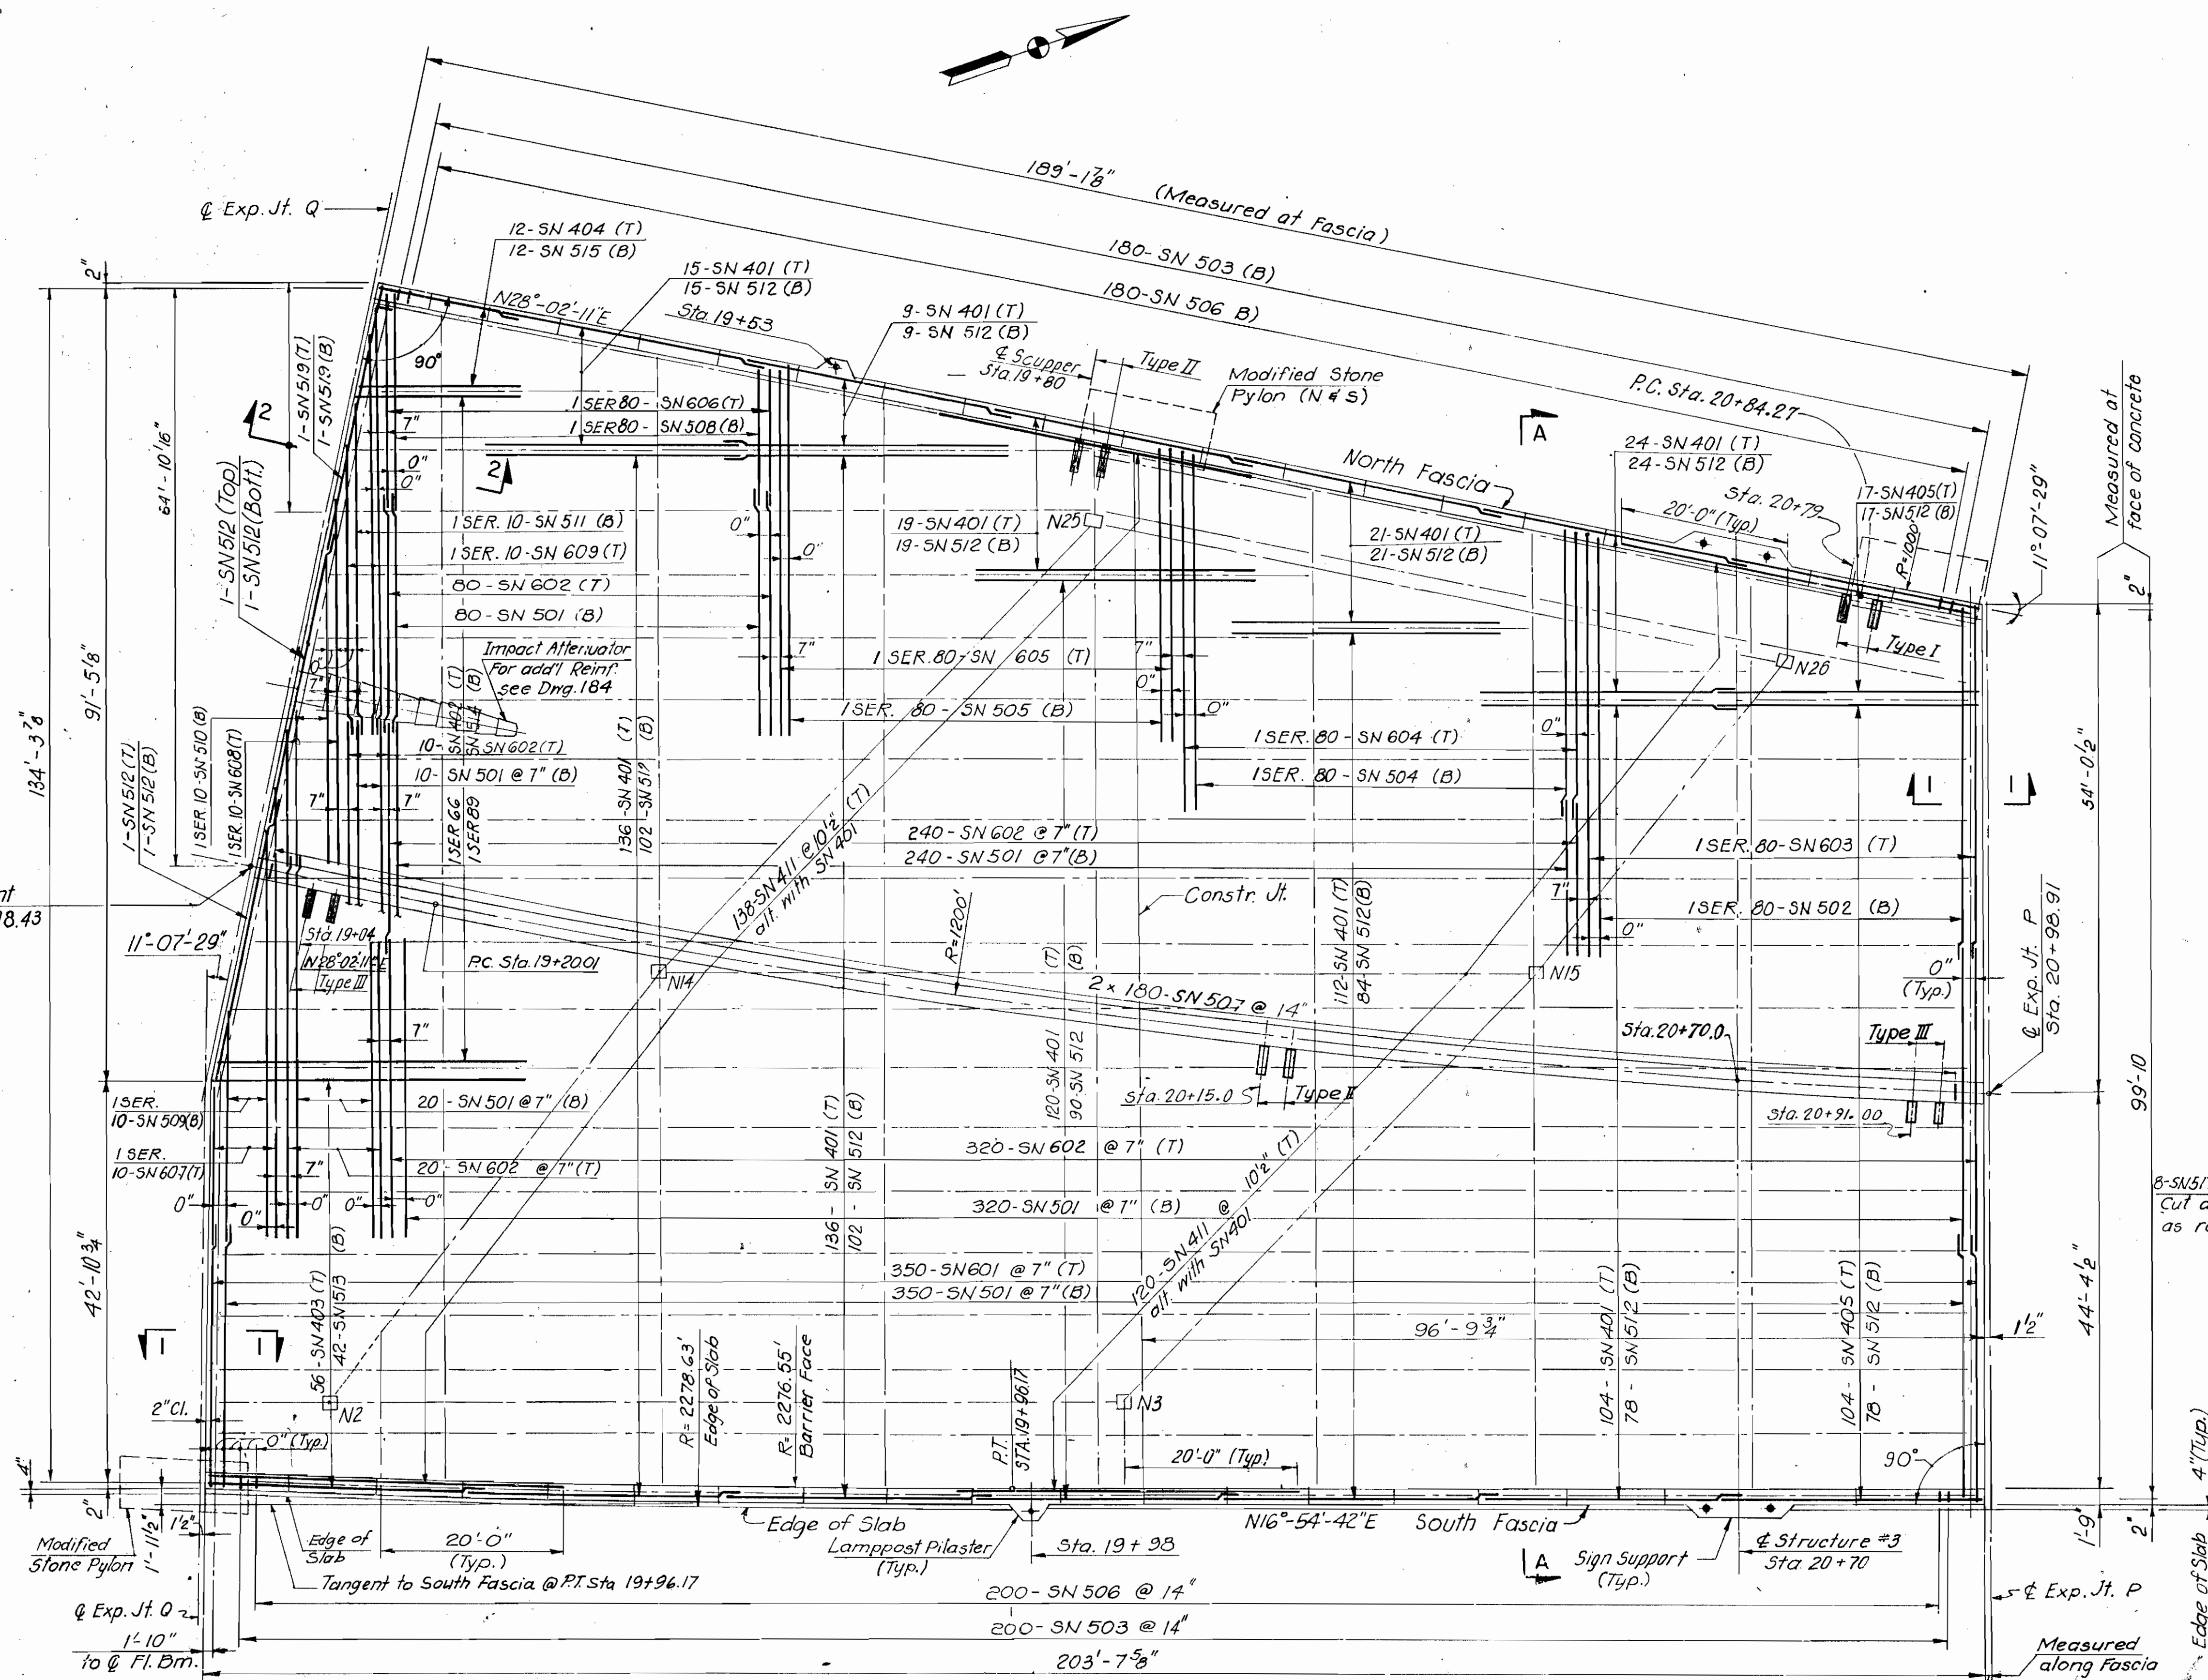

As Built

PAVLO ENGINEERING CO., P.C.  
NEW YORK, NEW YORK

CUYAHOGA COUNTY ENGINEER  
CLEVELAND OHIO

**MAIN AVENUE BRIDGE**  
CITY OF CLEVELAND  
BRIDGE OVER THE CUYAHOGA RIVER VALLEY

WEST APPROACH SECTION N  
**DECK SLAB REINFORCEMENT**


BRIDGE NO. 193 REPORT NO. 7119 DATE Nov. 11, 1989

**NO. B-136**

DESIGN B.G.	DRAWN A.M.	CHECKED R.D.M.	REVISED TO AS BUILT AS BUILT 2/94
----------------	---------------	-------------------	--------------------------------------



The Contractor shall bend or field cut reinforcing steel as required at scuppers

MINIMUM BAR LAP LENGTH	
BAR SIZE	MIN. LAP
# 4	1'-10"
# 5	2'-3"
# 6	2'-8"

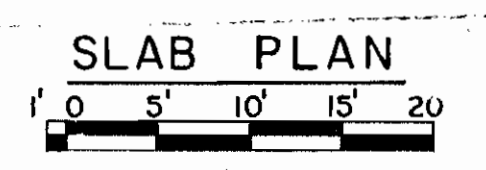


REFERENCES	DWG. NO
Proposed Plan & Elevation	104 & 105
Deck Slab Sections & Details	183
Top of Deck Elevations & Deflections	172
Framing Plan	151
Expansion Joint P	193
Expansion Joint Q	194
Sign Structure No. 3 Support Details	183

REFERENCES	DWG. NO
Pylon Modifications	153
Scupper Reinforcement	G54 & G55
Lighting Standard	668
Impact Attenuator	184
Bar List	1996
Typical Stay-in-Place Forms	69A

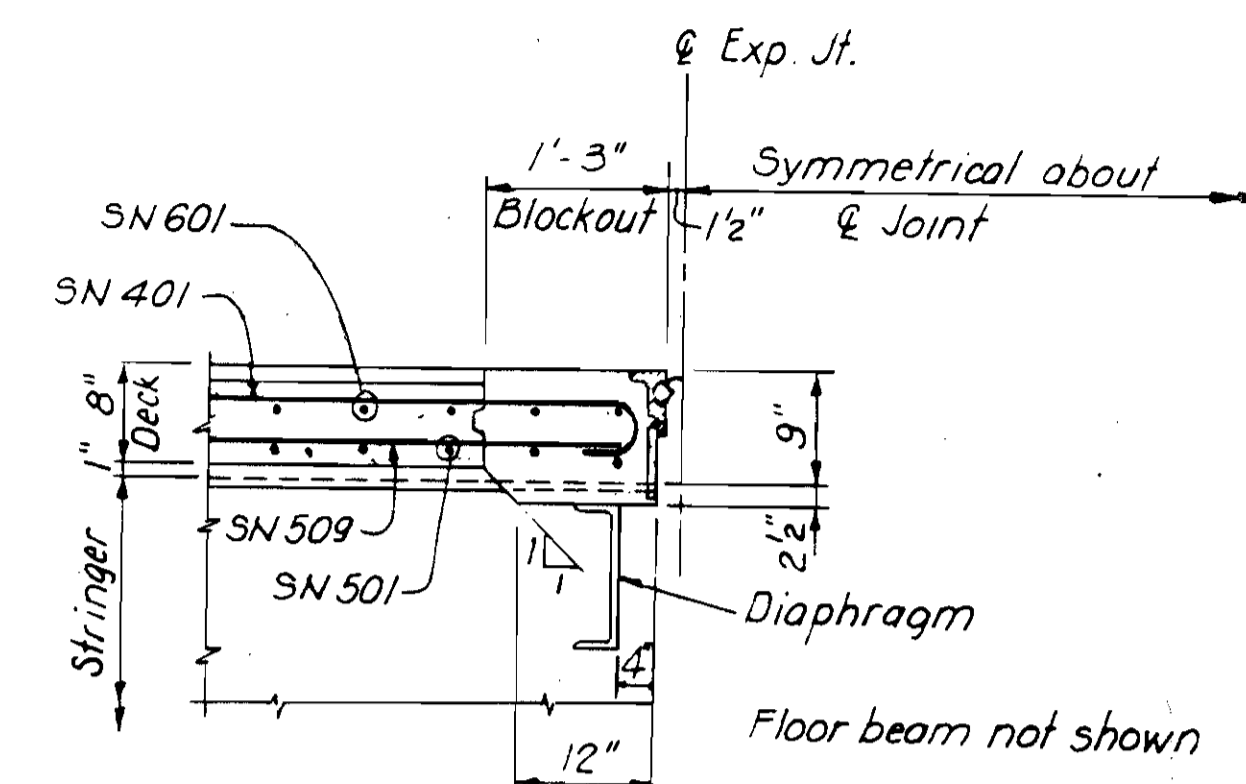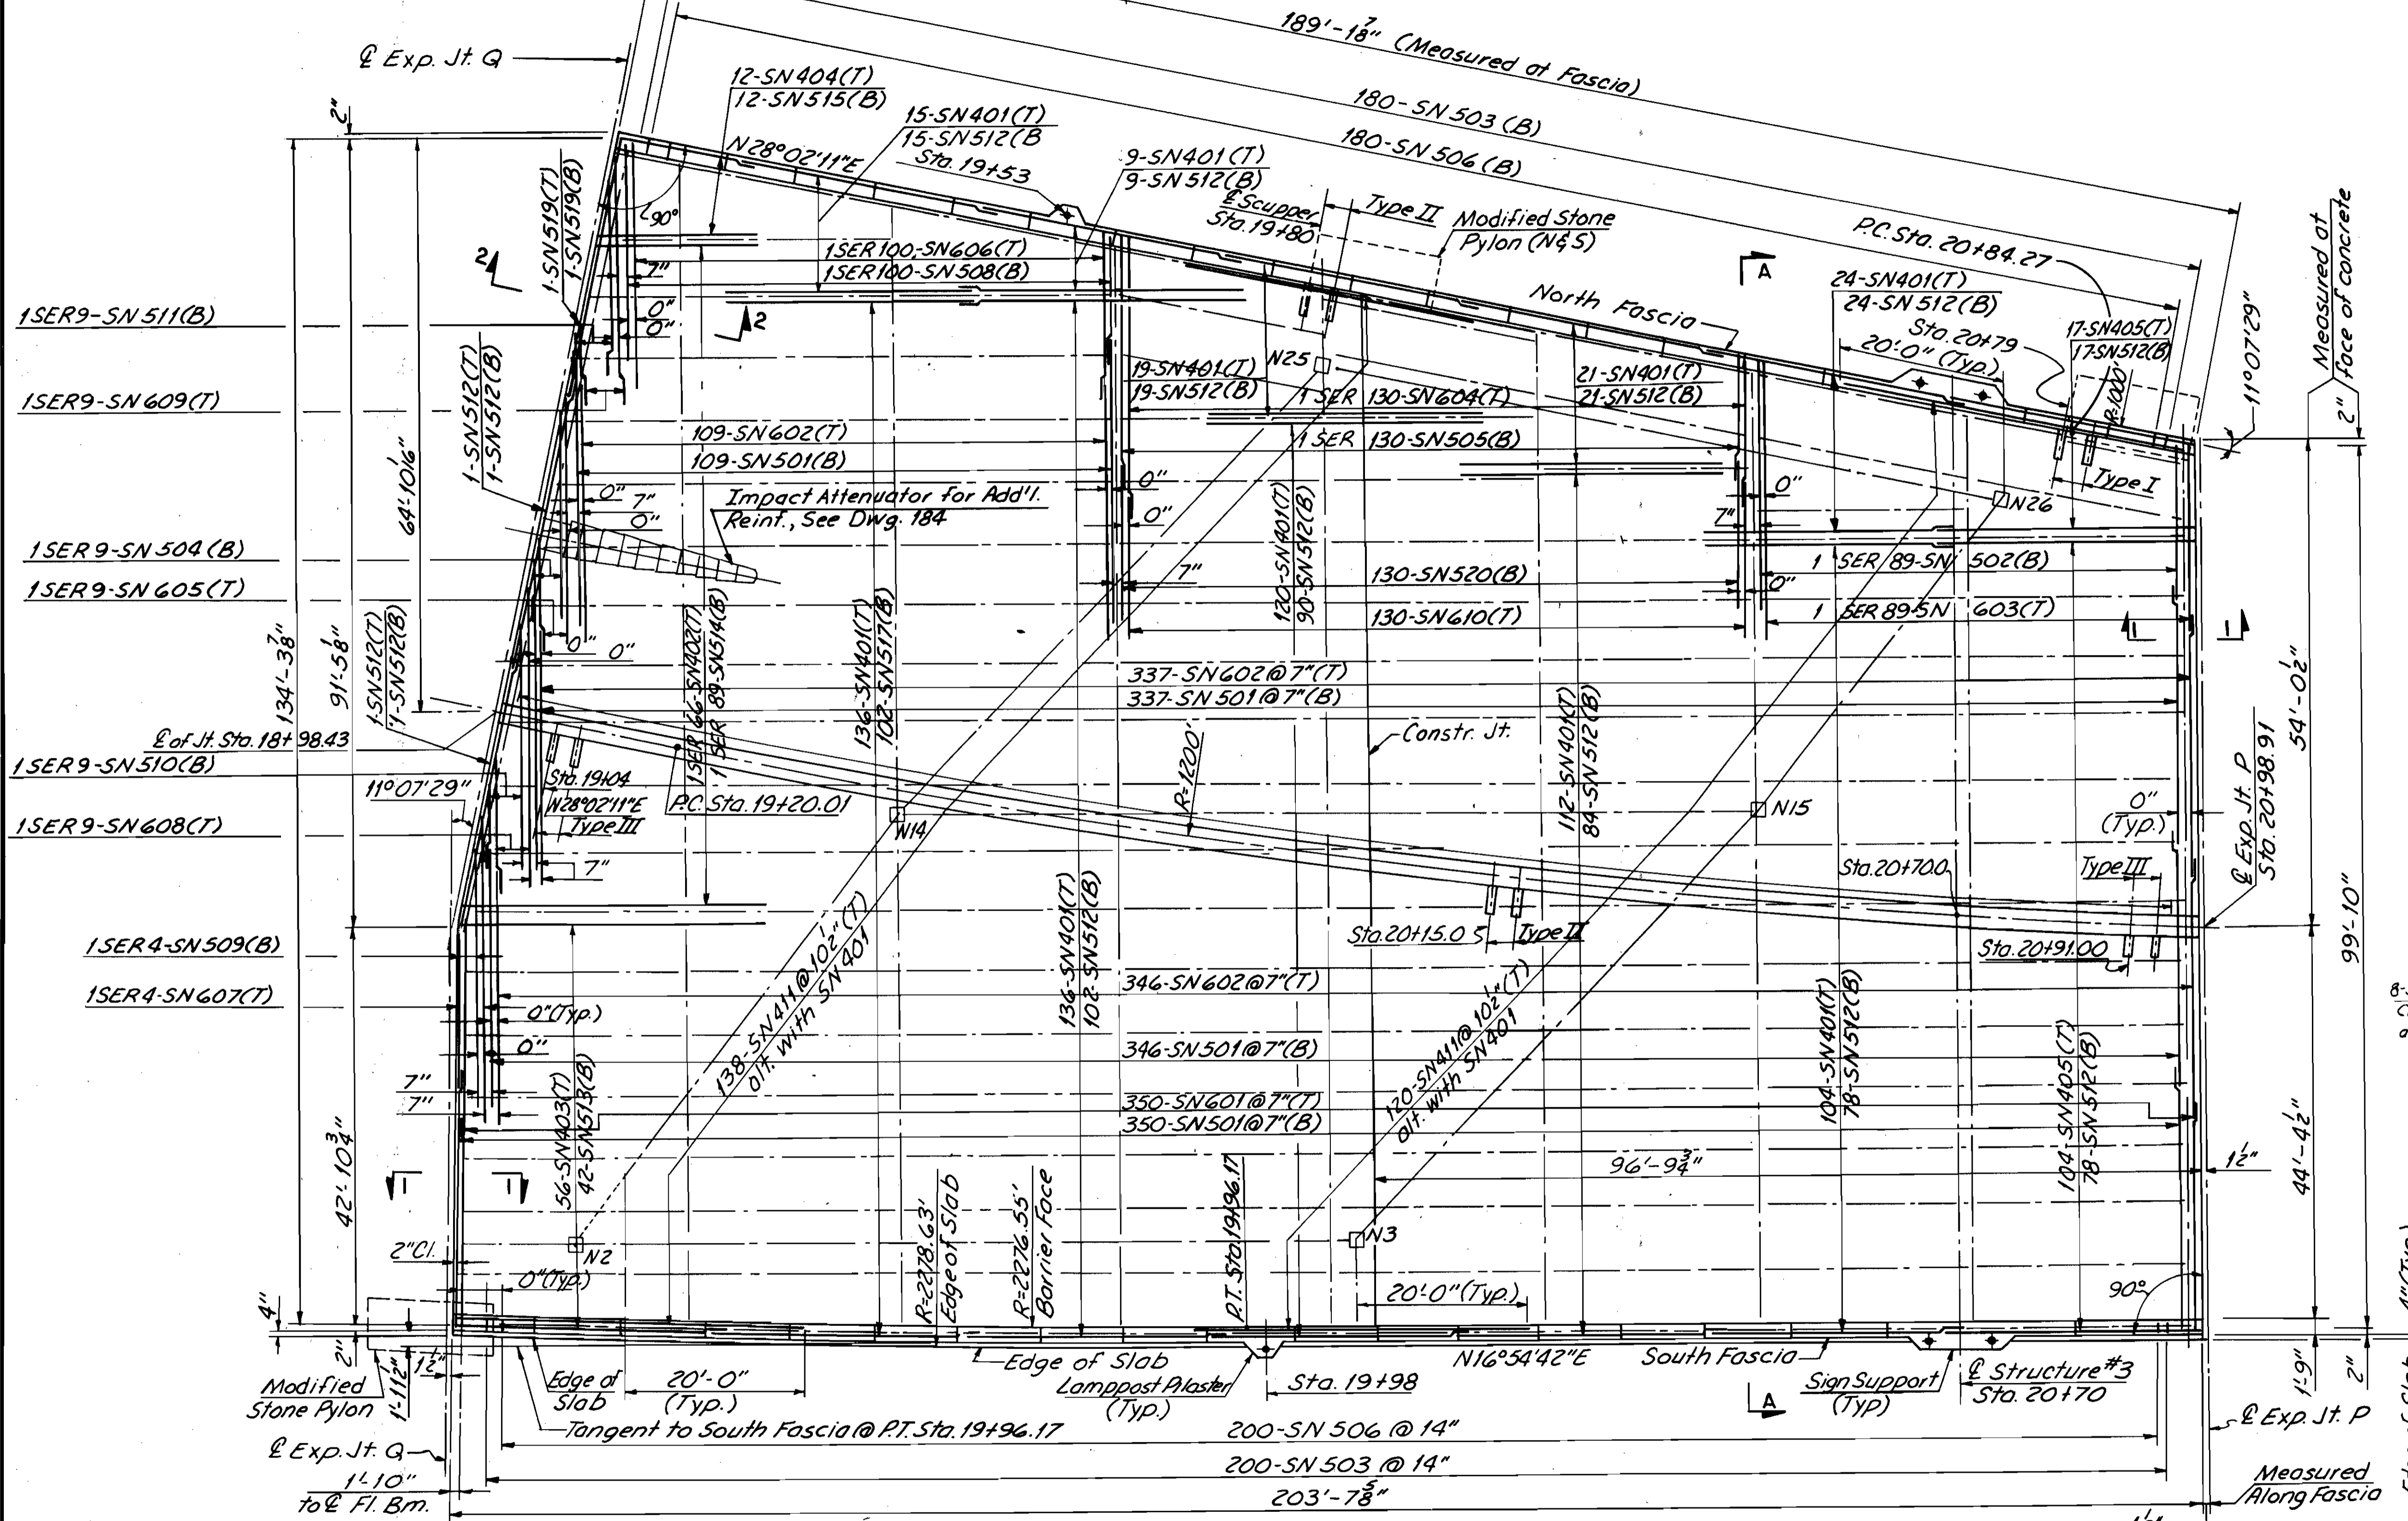

SECTION 1-1  
6" 0" 2"

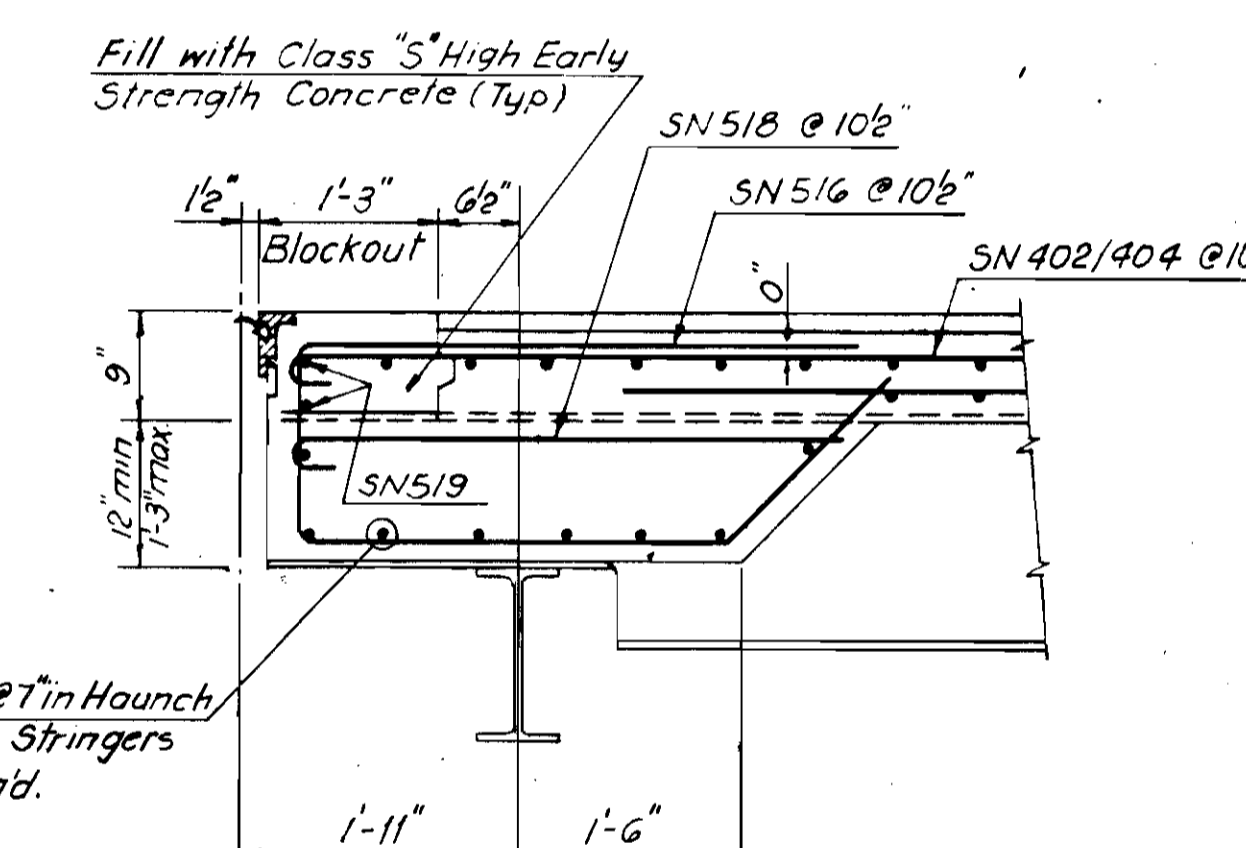

SECTION 2-2  
6" 0" 2"

SLAB PLAN  
1" 0 5 10 15 20

The Contractor shall bend or field cut reinforcing steel as required at scuppers

MINIMUM BAR LAP LENGTH	
BAR SIZE	MIN. LAP
# 4	1'-10"
# 5	2'-3"
# 6	2'-8"

REFERENCES	DWG. NO
Proposed Plan & Elevation	104 & 105
Deck Slab Sections & Details	183
Top of Deck Elevations & Deflections	172
Framing Plan	151
Expansion Joint P	193
Expansion Joint Q	194
Sign Structure No.3 Support Details	183
Pylon Modifications	153
Scupper Reinforcement G.54 & G.55	668
Lighting Standard	668
Impact Attenuator	184
Bar List	1996

AS BUILT 2/94  
**EXTRA SHEET**  
ADDITIONAL REPAIRS DETERMINED  
NECESSARY DURING  
CONSTRUCTION PHASE  
DISTRICT 12 APPVD. T.E.S. DATE 3-27-91

(AB) As Built

HOWARD NEEDLES TAMMEN & BERGENDOFF  
ARCHITECTS ENGINEERS PLANNERS **HNTB**



**WEST APPROACH SECTION N  
DECK SLAB REINFORCEMENT  
MAIN AVENUE BRIDGE**

BR. NO. 193  
CUYAHOGA COUNTY OHIO

DRAWN B.P. DATE 2-27-91	TRACED R.D.J. DATE 3-5-91	CHECKED N.A.F. DATE 3-6-91	REVIEWED C.A.B. DATE 3-23-91	REVISED
-------------------------------	---------------------------------	----------------------------------	------------------------------------	---------

SHEET 178A/991

CUYAHOGA COUNTY  
CUY-2-14.66

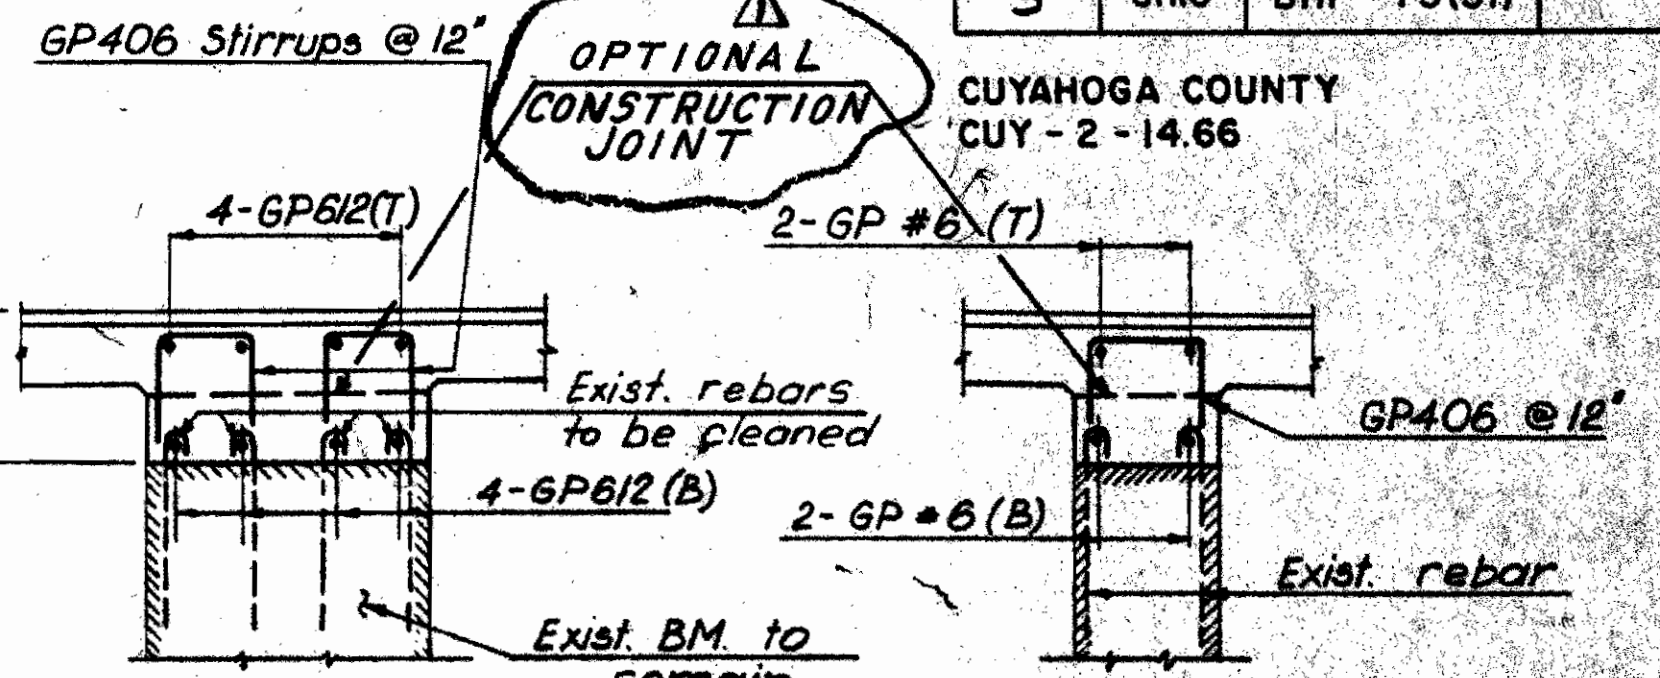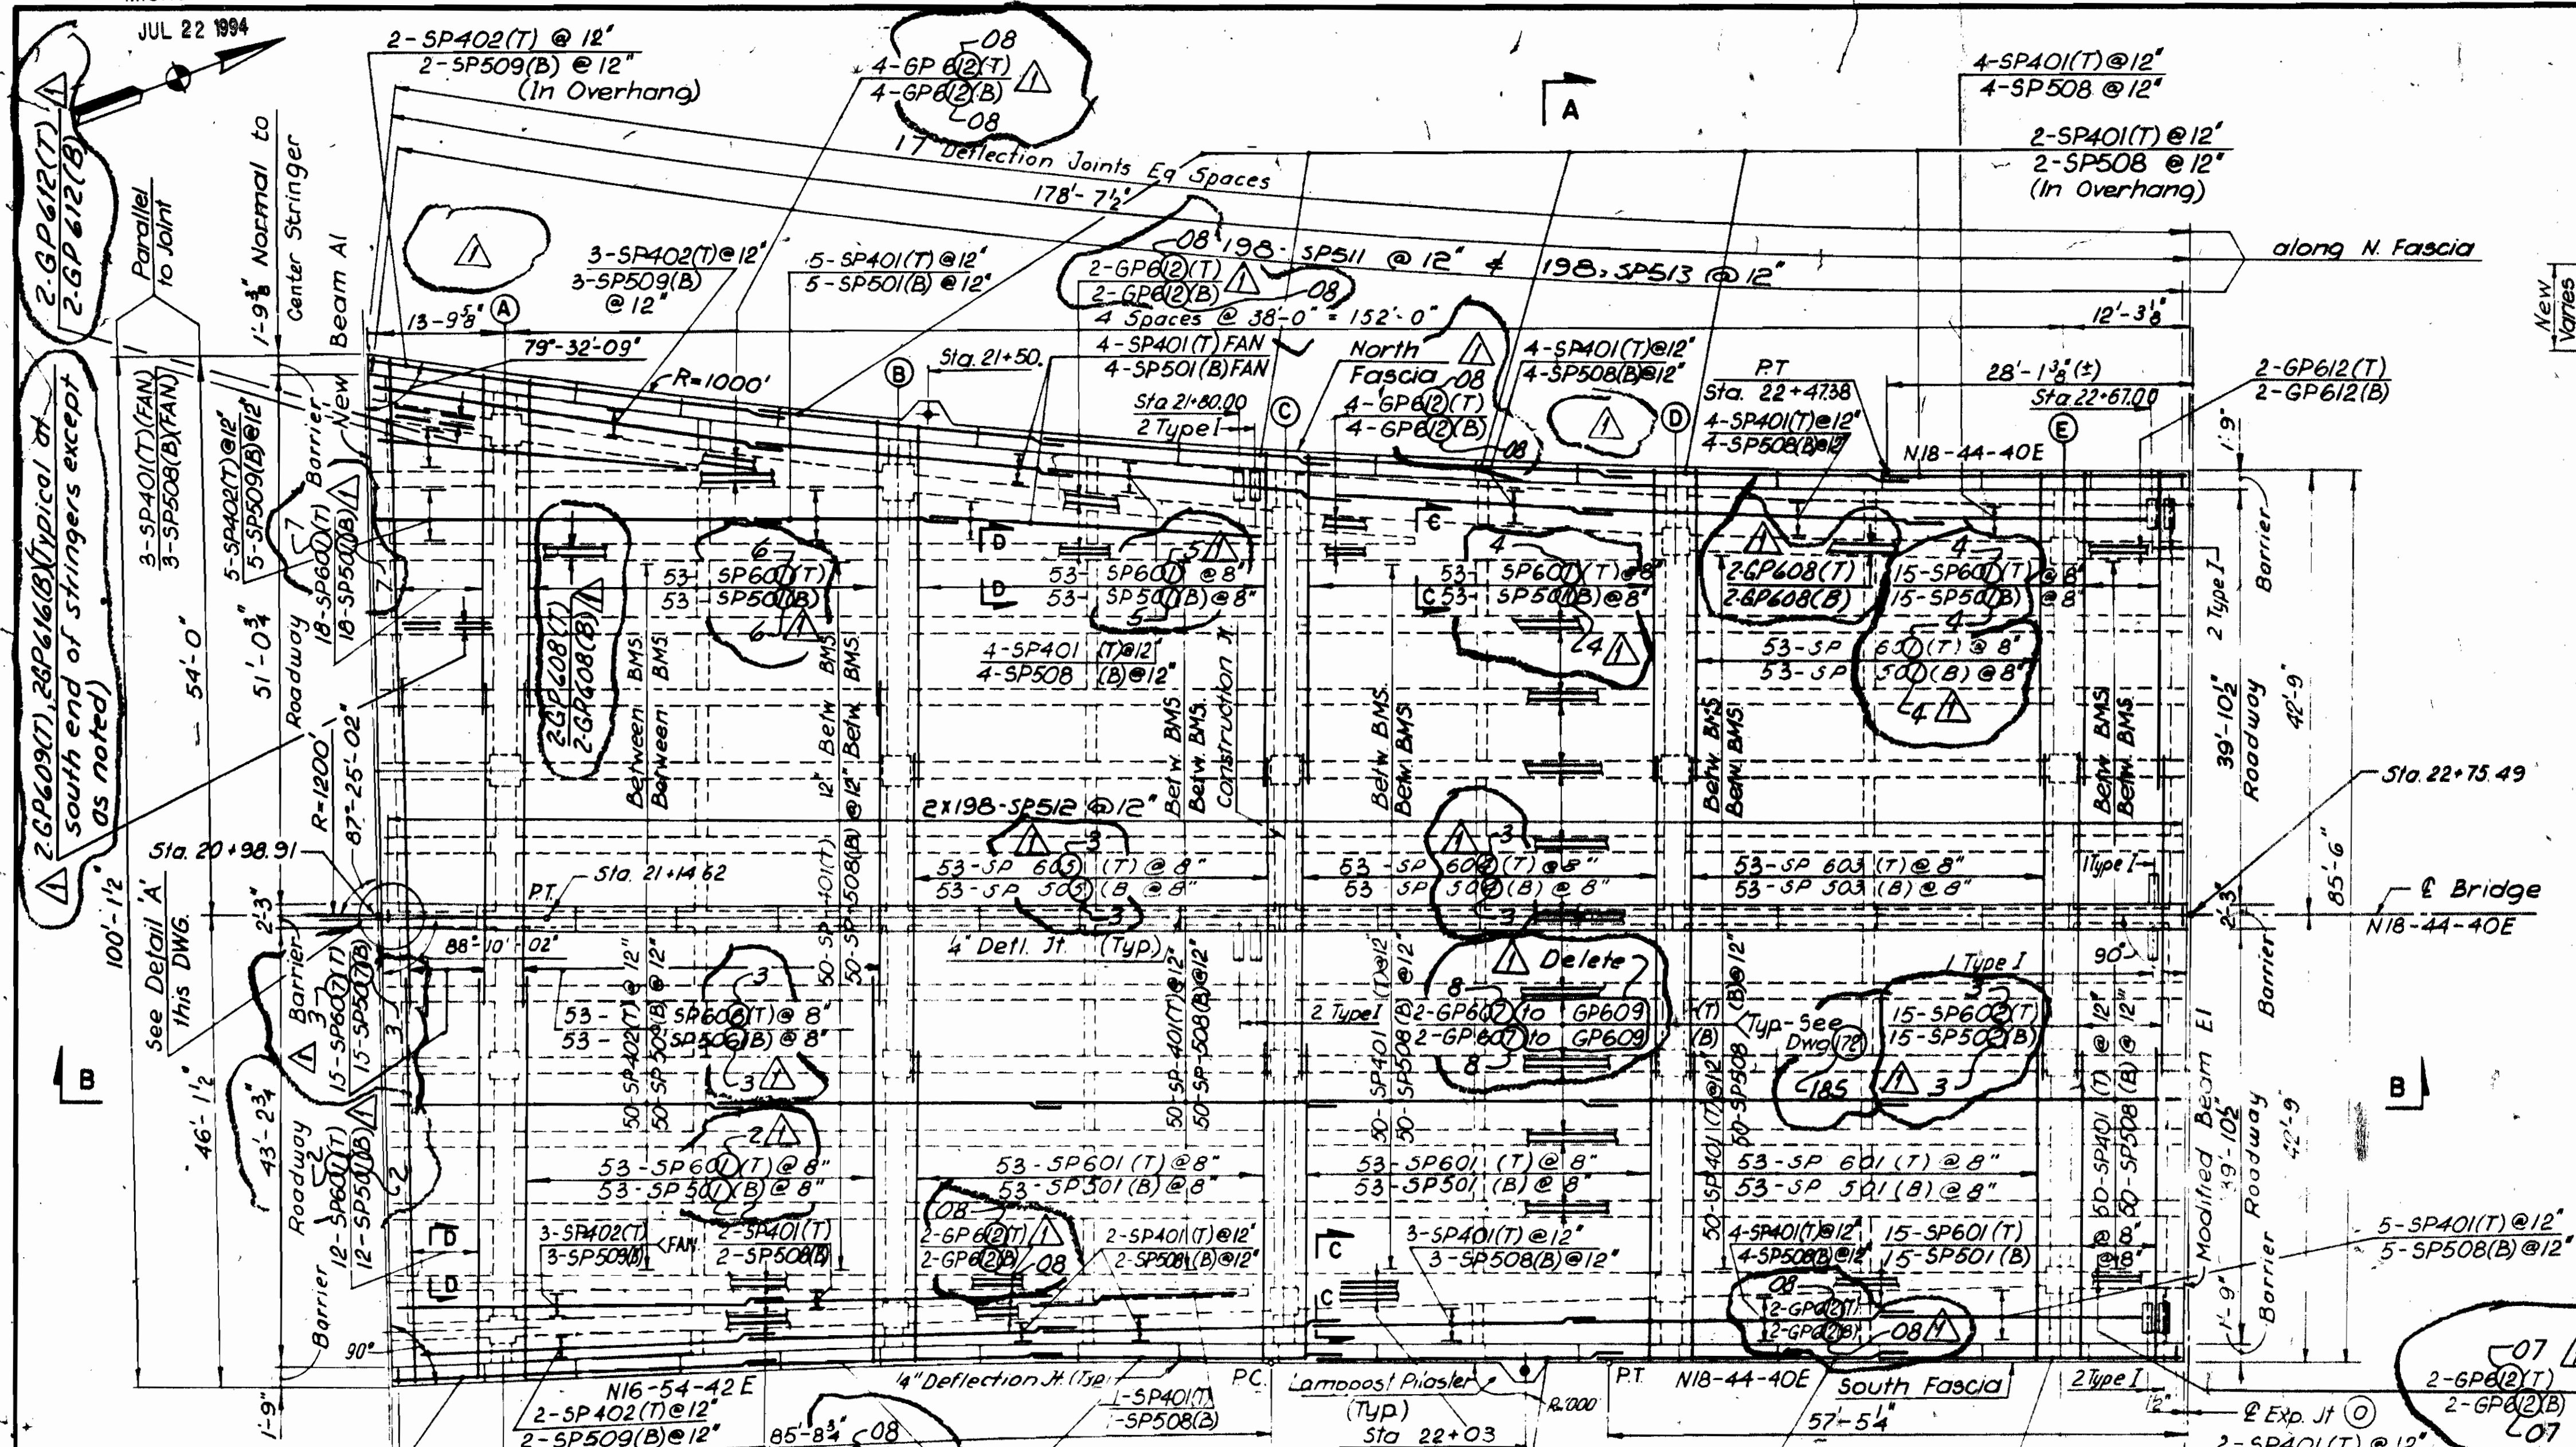

SECTION C-C Not to Scale  
SECTION D-D Not to Scale

NOTES:

- All Deck concrete shall be "Lightweight class 5"
- Preformed deflection joint filler in barriers shall be either 1/2" thick gray sponge rubber (AASHTO M-153) or 1/2" gray cellular polyvinyl chloride (PVC) sponge. Concrete parapets above upper construction joints shall be placed in alternate sections by the use of bulkheads. Closing sections shall be placed after removal of bulkheads and after placement of expansion joint filler.
- Embedded Lighting conduits (size and layout), Junction Boxes, grounding etc, are detailed in the Dwg's G64-G69 "Proposed Bridge Lighting".


REFERENCES

REFERENCES	DWG. NO.
General Notes	66-623
General Plan & Elevation (Existing and Proposed)	101-105 (Incl.)
Typical Cross Section	116
Sections A-A & B-B	185
Lamp Support Details	668
Scupper Reinforcement & Details	654 & 655
Bar list	199H & 199J


\* MINIMUM LAP LENGTHS (TYPICAL UNLESS NOTED)

BAR SIZE	LENGTH REQUIRED
# 4	1' - 10"
# 5	2' - 3"
# 6	2' - 8"
# 8	4' - 7"


\* LIGHTWEIGHT CONCRETE

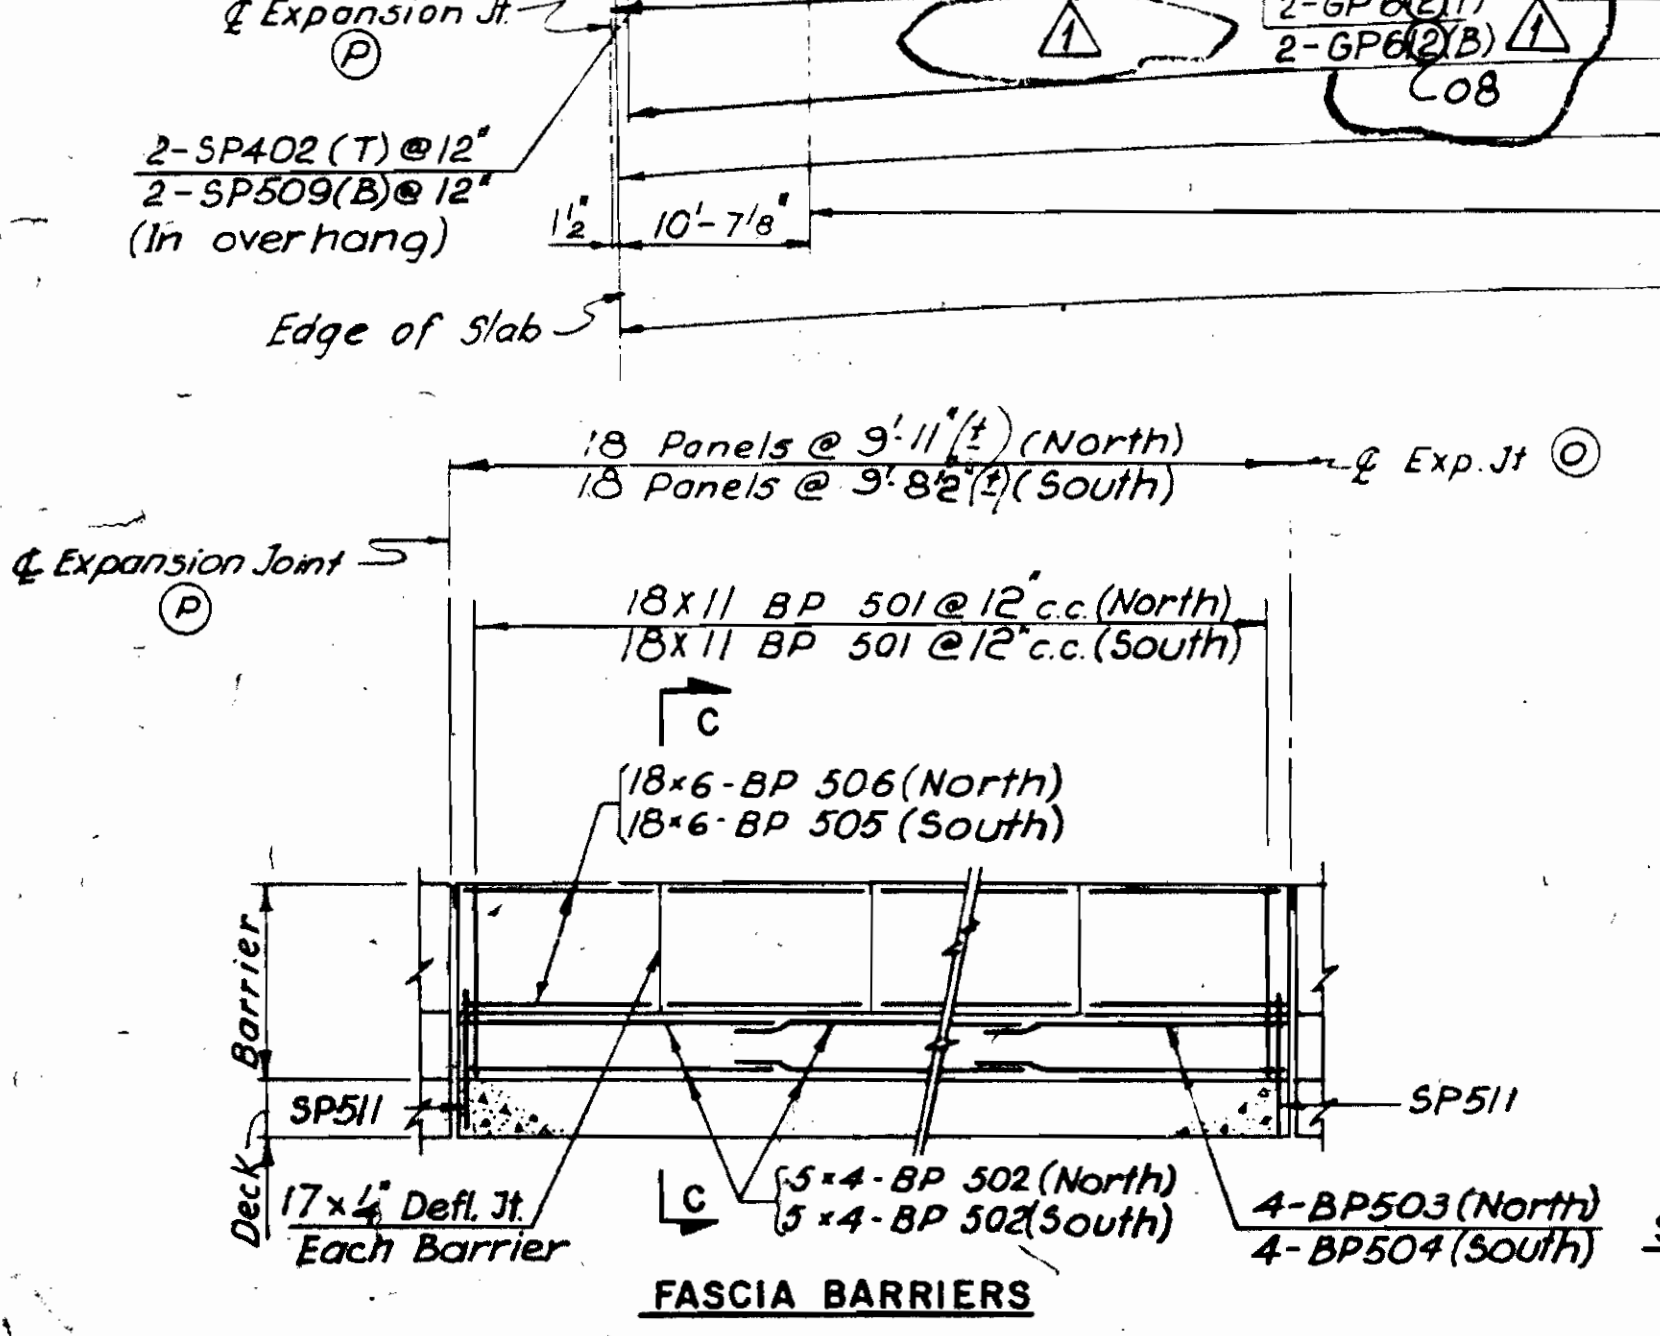

FASCIA BARRIERS

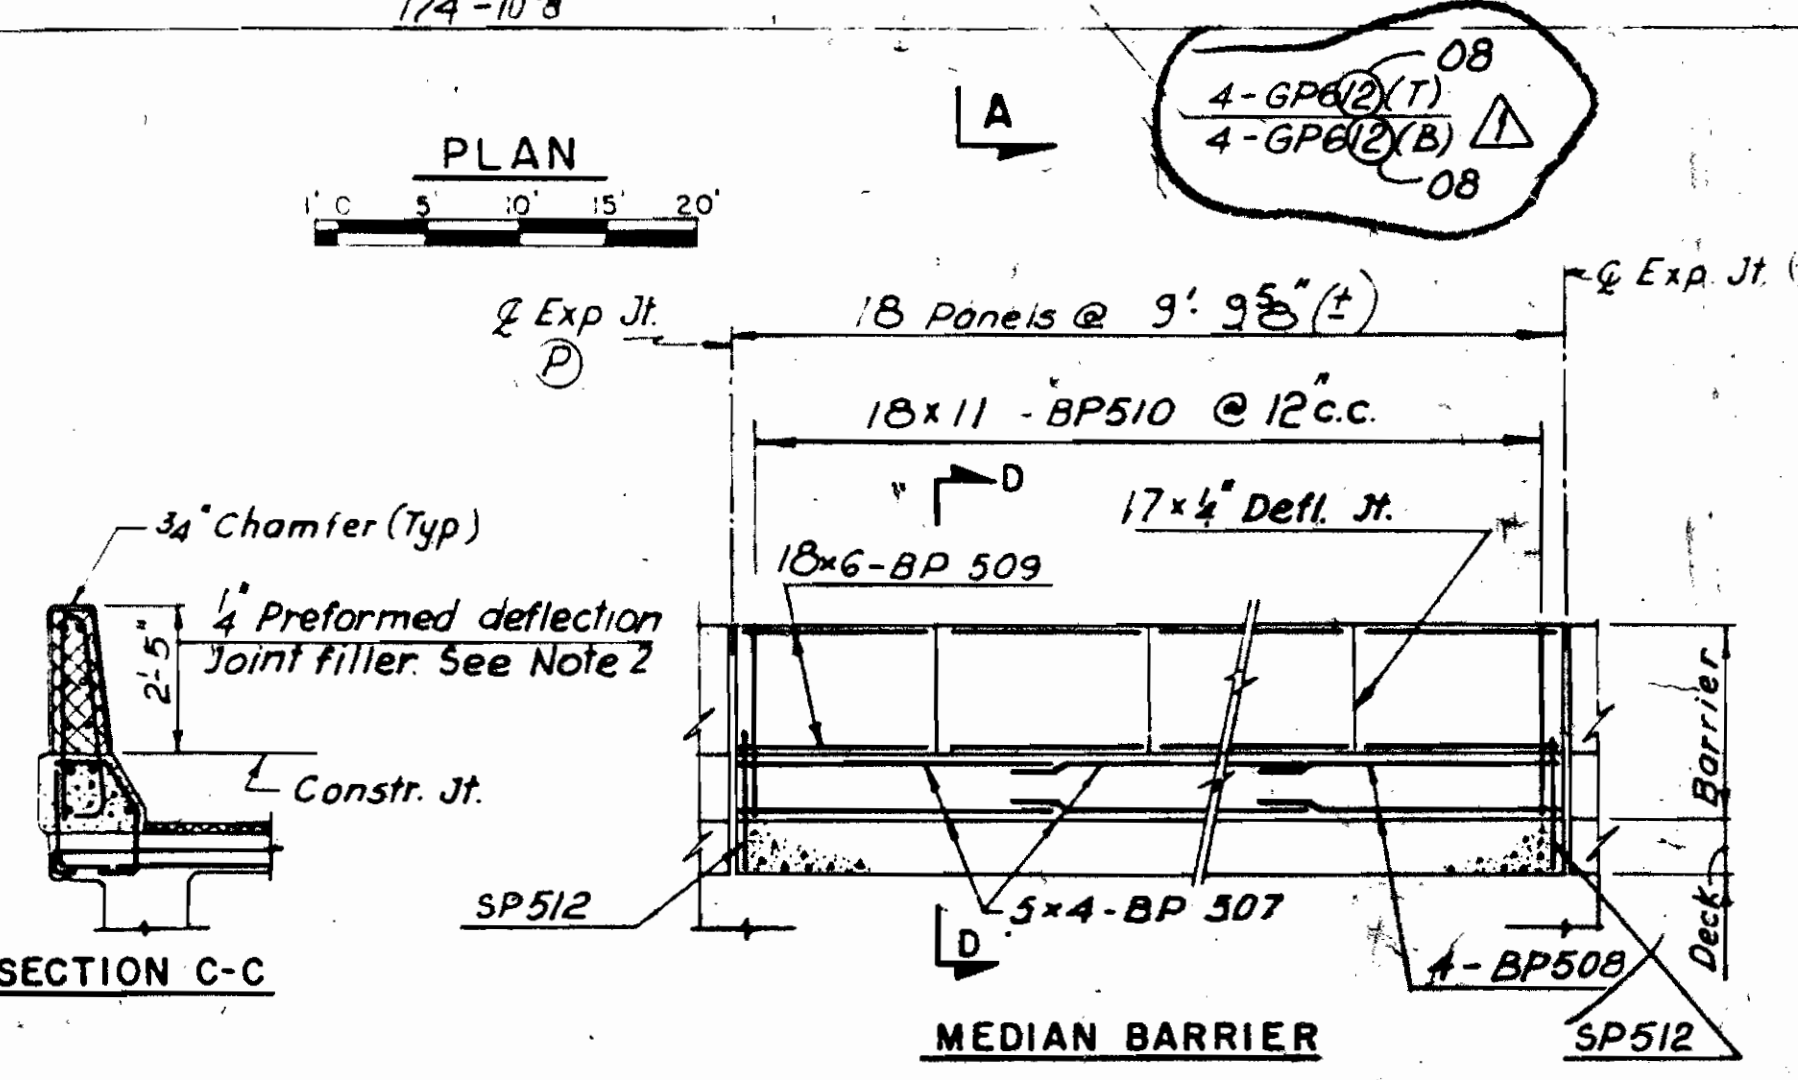


MEDIAN BARRIER

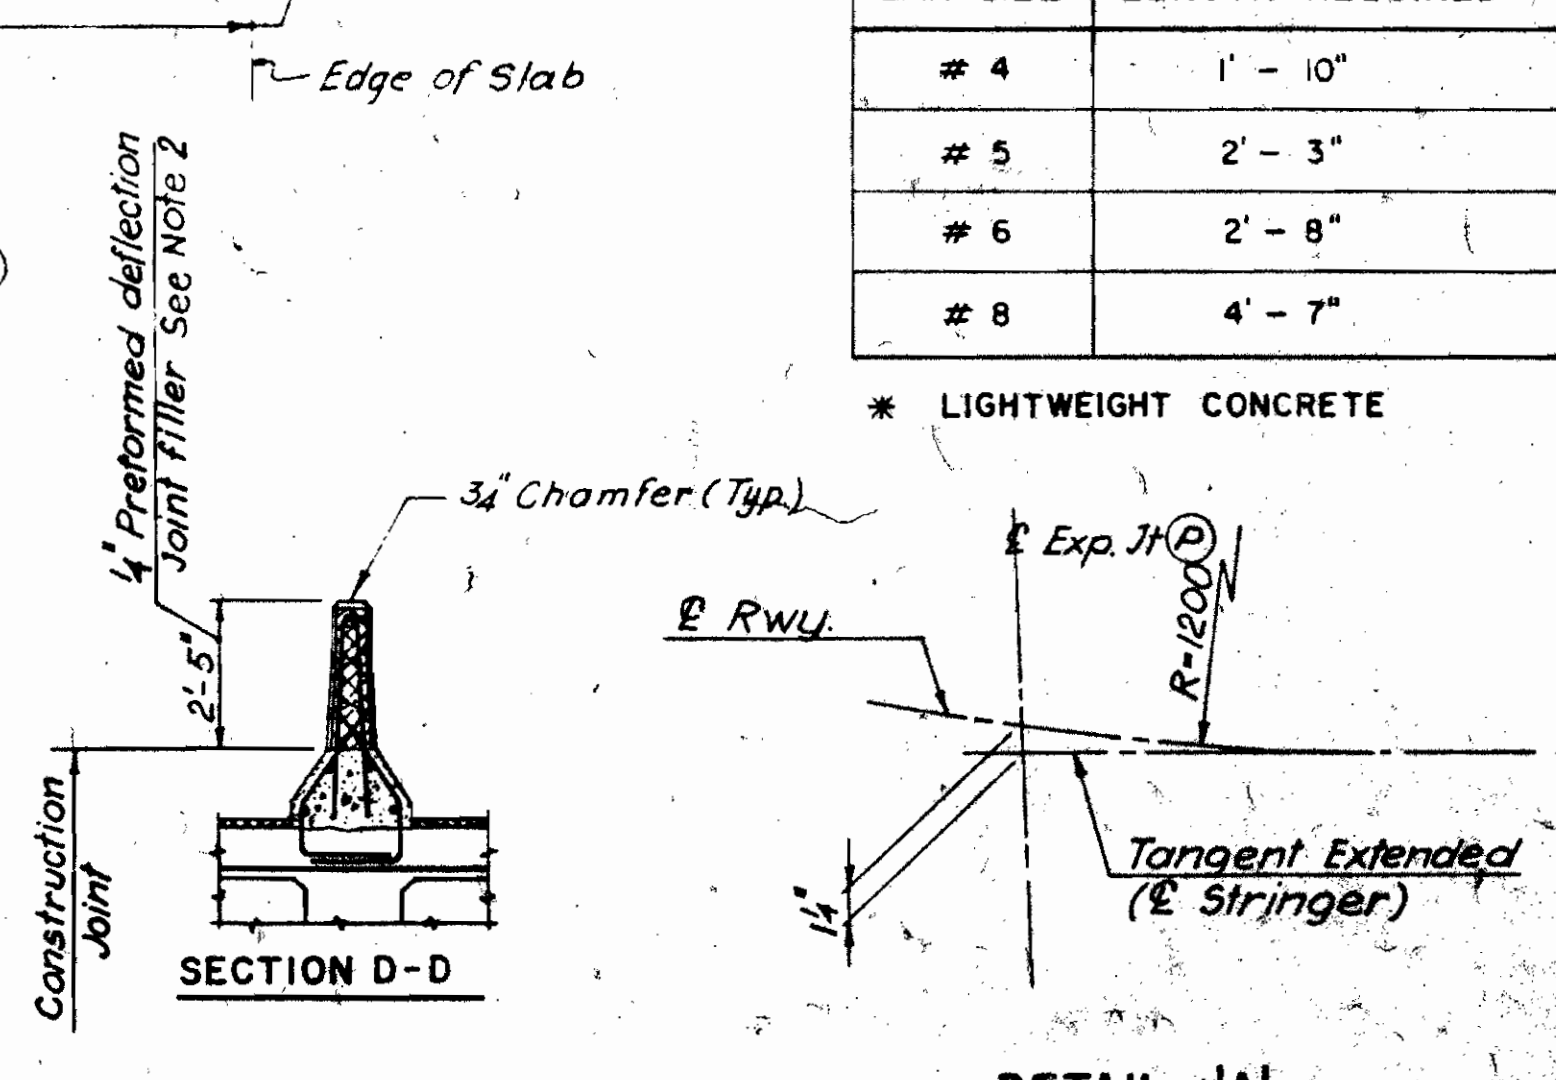

DETAIL 'A' No Scale

BARRIER DETAILS No Scale.

Rev 1	Plan Revisions	3-28-94
PAVLO ENGINEERING CO., P.C. NEW YORK, NEW YORK		
CUYAHOGA COUNTY ENGINEER CLEVELAND OHIO		
MAIN AVENUE BRIDGE CITY OF CLEVELAND BRIDGE OVER THE CUYAHOGA RIVER VALLEY		
WEST APPROACH - SECTION P DECK SLAB REINFORCEMENT		
BRIDGE NO. 193	REPORT NO. 7119	DATE Nov 1, 1993
NO. B-136		179 991
DESIGN A.S.	DRAWN R.S.	CHECKED C.K.L.
REVISED TO AS BUILT AS BUILT 2/94		

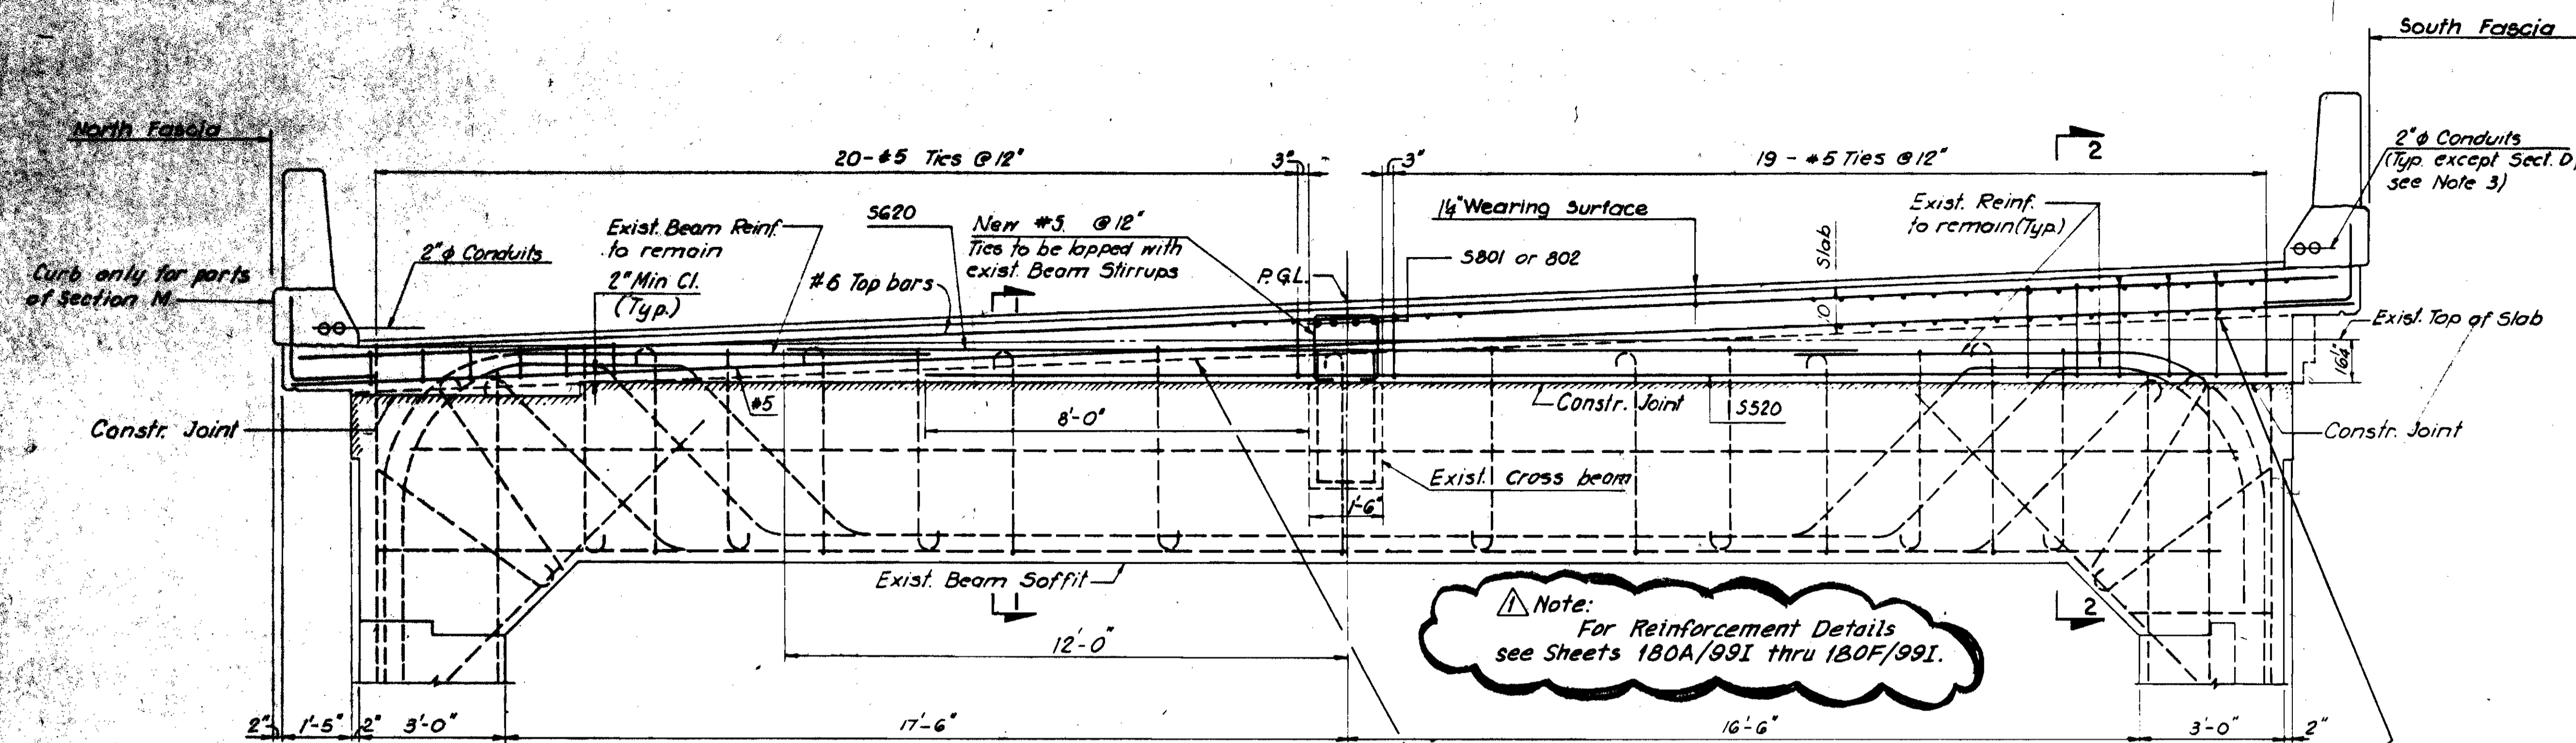


Note:  
For Reinforcement Details  
see Sheets 180A/99I thru 180F/99I.


Optional Construction Joint

TYPICAL ELEVATION (MODIFIED)


Remove existing Concrete as shown. Clean exposed reinforcement; install new rebar as shown.

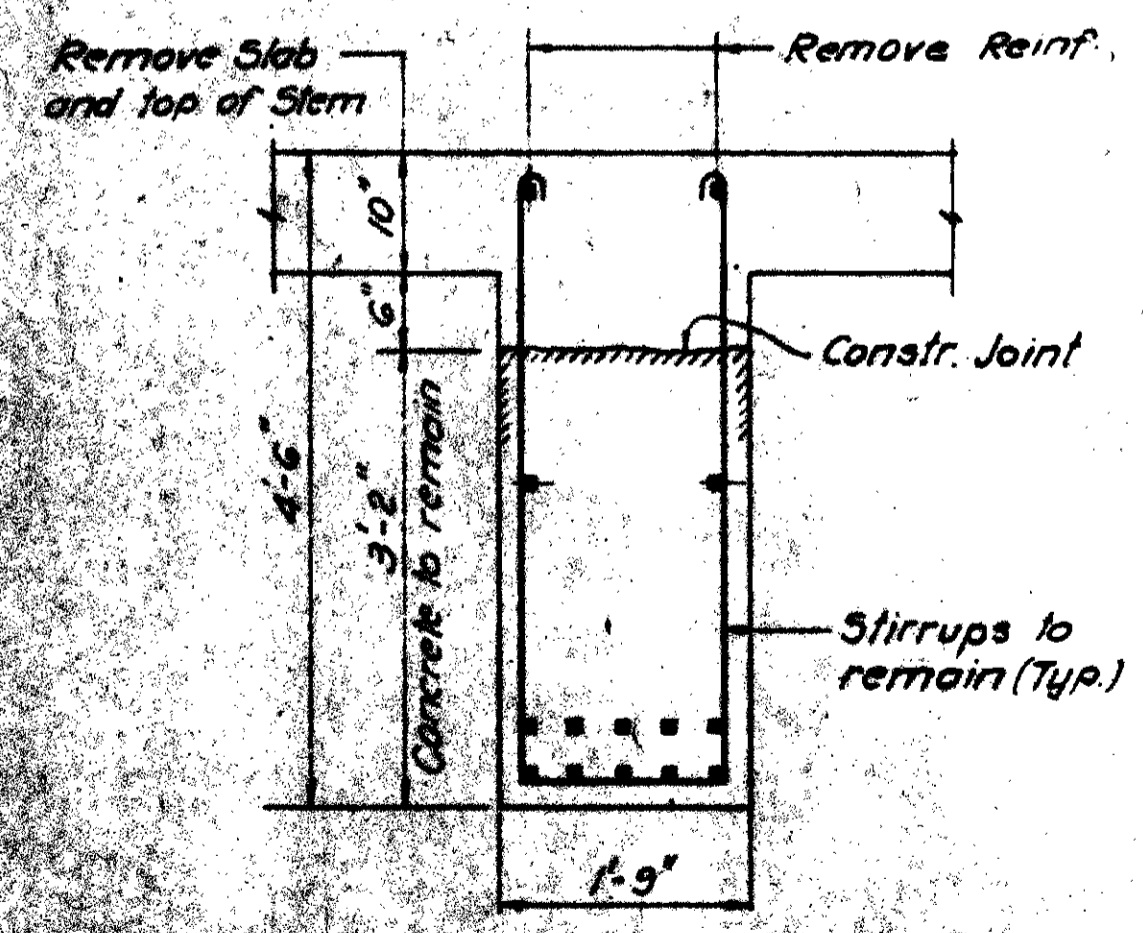


SECTION 1-1 (EXISTING)

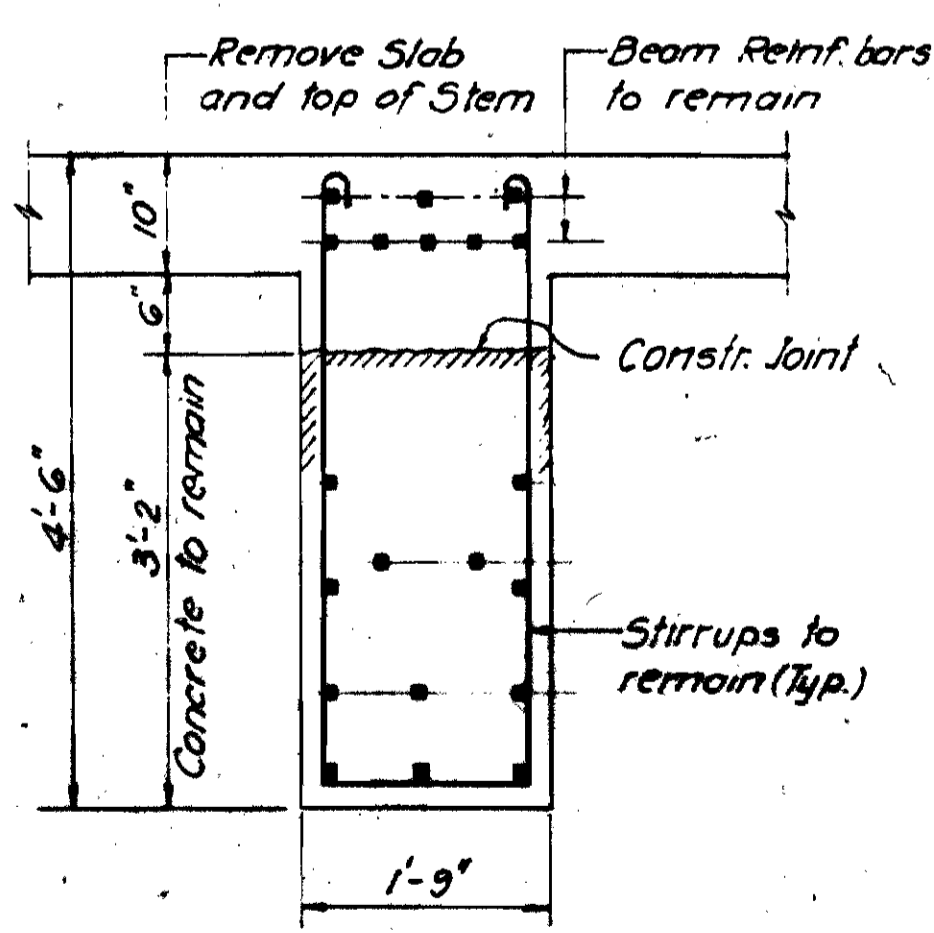

SECTION 2-2 (EXISTING)

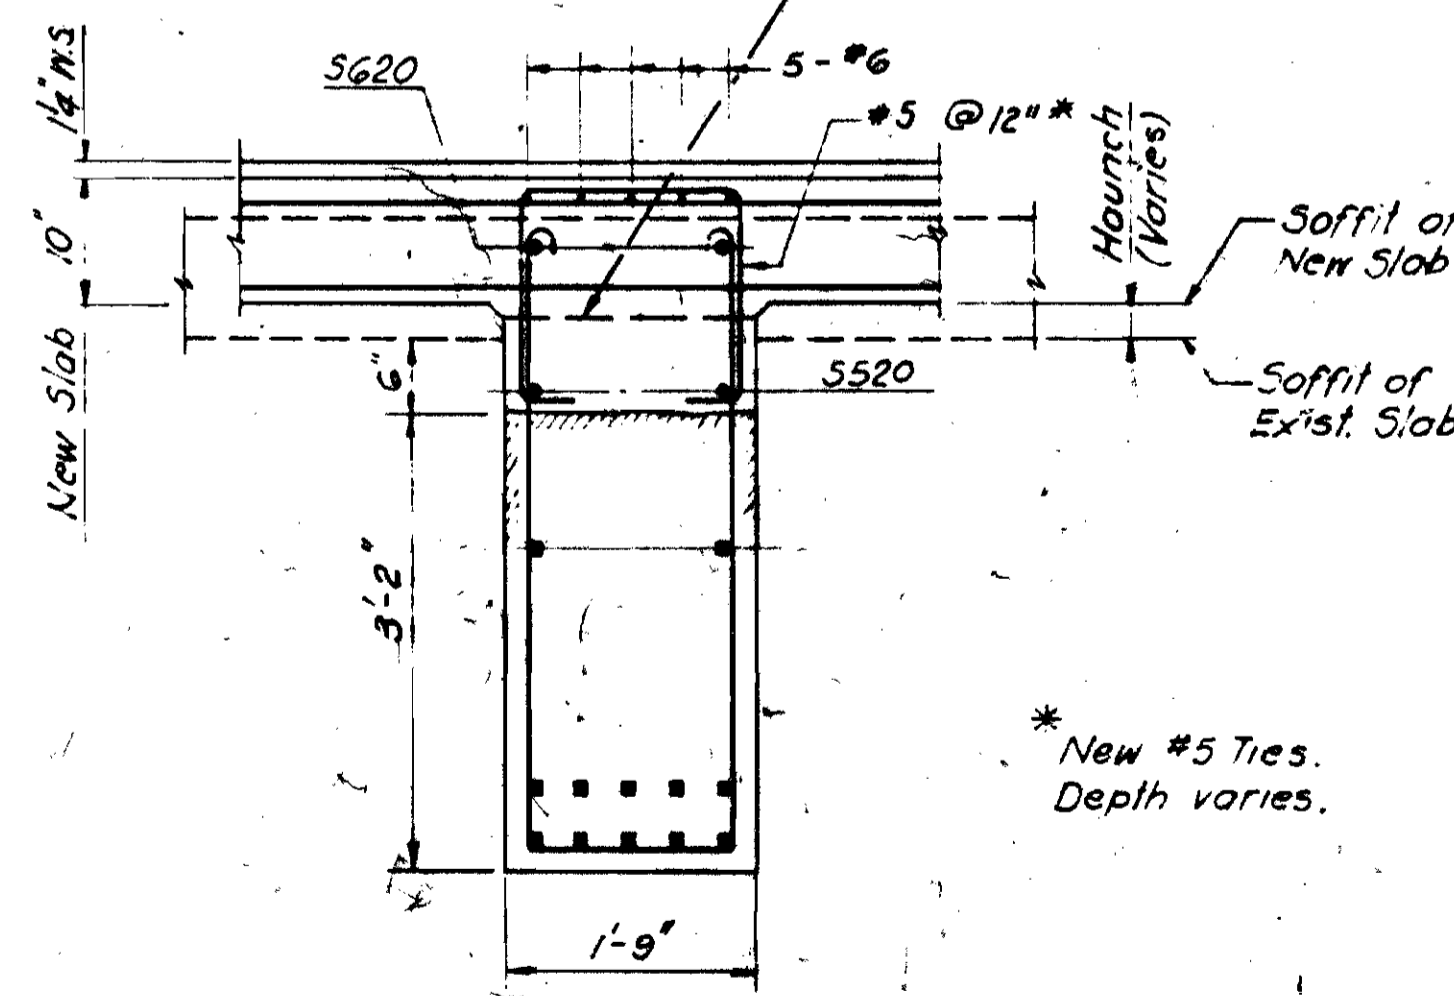

SECTION 1-1 (MODIFIED)

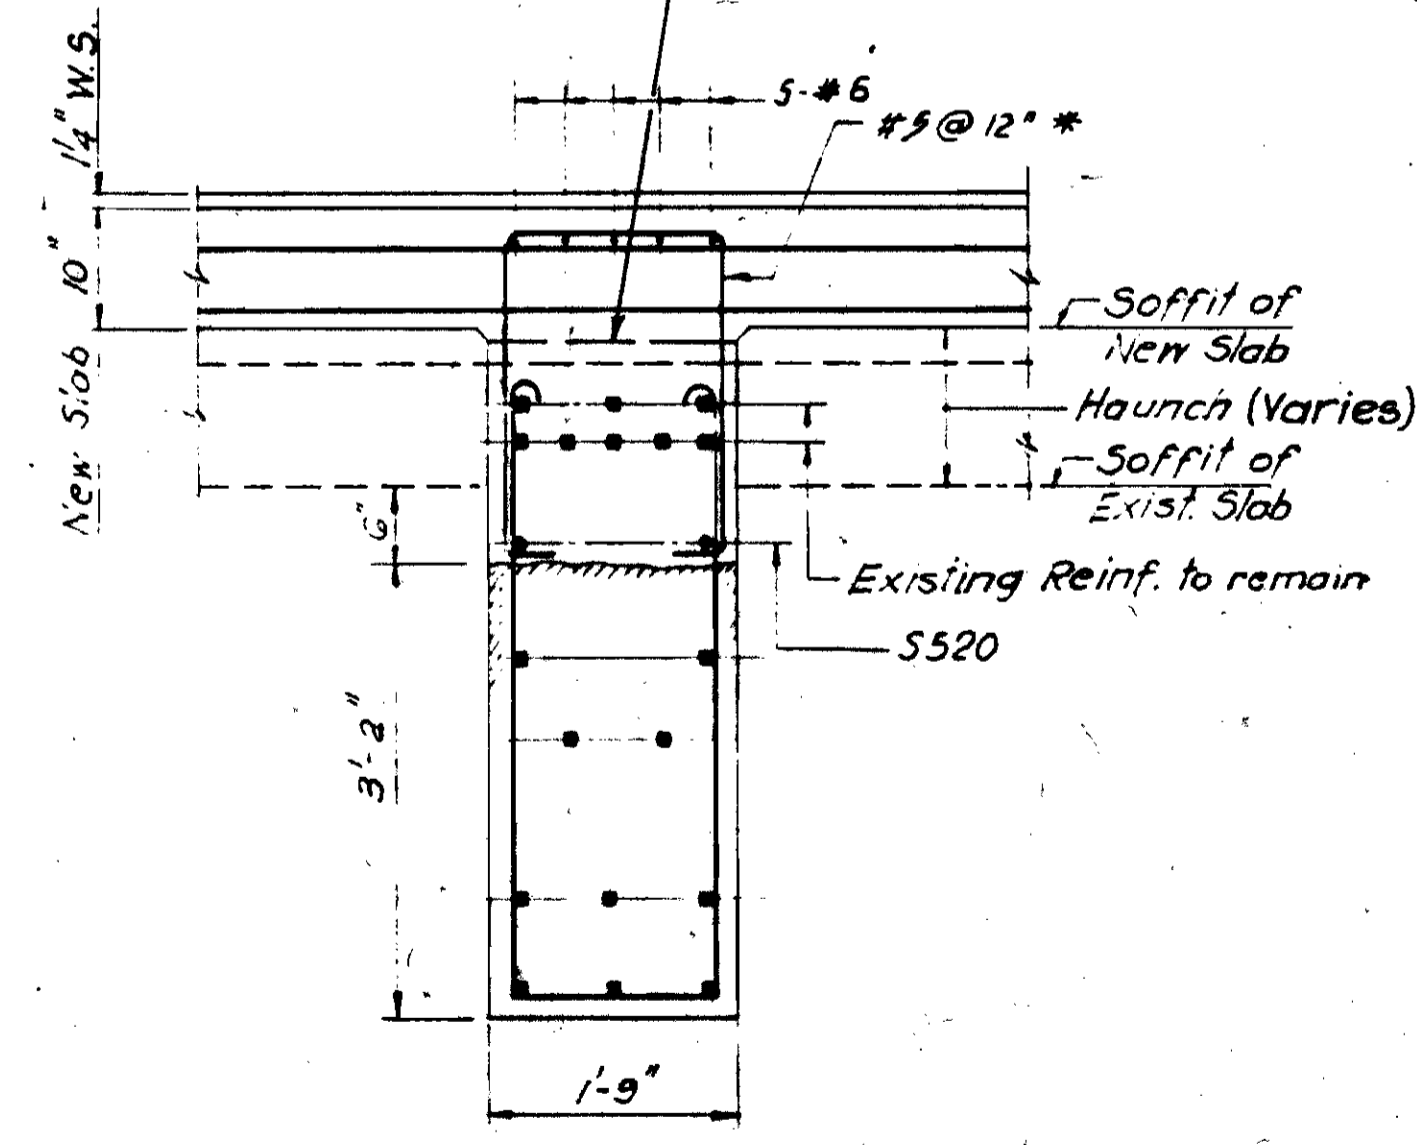

SECTION 2-2 (MODIFIED)

NOTES

- All new reinforced concrete in slab and beams shall be Lightweight Class 5
- Preformed deflection joint filler in barriers shall be either 1/2" thick gray sponge rubber (AASHTO M-153) or 1/4" gray cellular polyvinyl chloride (PVC) sponge. Concrete parapets above upper construction joints shall be placed in alternate sections by the use of bulkheads. Closing sections shall be placed after removal of bulkheads and after placement of expansion joint filler.
- Embedded lighting conduits (size and layout), junction boxes, grounding etc. are detailed in Dwg's G64 thru G68, Proposed Bridge Lighting.
- Bar numbers are prefixed with the Section designation.

REFERENCE:

REFERENCE:	DWG. No.
Temporary support Details	145
Details and procedures apply to all beams in Sections B, D, J & M.	145
Section B' Proposed Deck Plan	145
Section D Proposed Deck Plan	145
Section J' Proposed Deck Plan	146
Section M Proposed Deck Plan	150
Bridge Lighting Plan	G64
Sections B, J, M Deck Slab Details	181

Rev. 1 Plan Revisions

PAVLO ENGINEERING CO., P.C.  
NEW YORK, NEW YORK

CUYAHOGA COUNTY ENGINEER  
CLEVELAND OHIO

MAIN AVENUE BRIDGE  
CITY OF CLEVELAND  
BRIDGE OVER THE CUYAHOGA RIVER VALLEY

WEST APPROACH - SECTION B, D, J, M  
BEAM MODIFICATIONS

BRIDGE NO. 193 REPORT NO. 718 DATE 10/2/91

NO. B-136

DESIGN R.R./AS. DRAWN J.H. CHECKED C.K.D. REVIEWED TO AS BUILT AS BUILT

0 Dat 3-27-91 TES



MICROFILMED  
JUL 25 1984

**MAIN TRUSS SPAN (SECTION II)**  
**SCOPE OF REHABILITATION WORK**

THE SECTION IS A 2520 FOOT LONG, SIX LANE DIVIDED STEEL VIADUCT, CONSISTING OF TEN SUSPENDED AND CANTILEVER DECK TYPE ARCH TRUSS SPANS, WITH I-BEAM-LOK DECK, SUPPORTED BY STRINGERS AND FLOOR BEAMS.

**THE WORK INCLUDES:**

1. THE REMOVAL OF THE EXISTING DECK, SIDEWALKS, RAILINGS, STRINGERS, FASCIAS, CATWALKS, LADDERS, ETC.
2. REMOVAL, REPLACEMENT OR REPAIR OF DETERIORATED FLOOR BEAMS, BRACKETS AND TIE PLATES.
3. REPAIR AND REINFORCEMENT OF TRUSS MEMBERS.
4. INSTALLATION OF NEW STEEL STRINGERS, FASCIA BEAMS AND NEW INSPECTION WALK.
5. CONSTRUCTION OF NEW LIGHTWEIGHT CONCRETE DECK SLABS, BARRIERS, LUMINAIRE SUPPORTS, DRAINAGE DEVICES AND ARMORED JOINTS.
6. INSTALLATION OF NEW LIGHTING SYSTEM AND TRAFFIC SIGNS.
7. FIELD COATING OF SOME EXISTING STRUCTURAL STEEL & PAINTING OF NEW STRUCTURAL STEEL.
8. COATING OF THE EXPOSED EXISTING AND NEW CONCRETE SURFACES.
9. REPLACEMENT OF GREASE BOX AT EXPANSION BEARINGS.
10. REPLACEMENT OF PIER ACCESS LADDERS.


**C.V.N. NOTE**

All new Structural steel for Main Load Carrying members subjected to tension or stress reversal, shall meet the "Longitudinal Charpy V-notch" requirements of 15 Ft-Lb @ 40°F. Main load carrying members for this section are limited to: Stringers, Floor beam Flanges & Web, Bracket Top Flange and Web, and Tie Plates.

See also "GENERAL NOTES" Item 513.

**REFERENCES**


REFERENCES	DWG. NO.
General Notes	G6 - G23
Typical Cross Section	207
Drainage - Main Truss Span	G44
Drainage Details	G46 - G59
Lighting	G64 - G73
Pavement Marking and Traffic Signs	G75 - G83
Grease Box Details	220
Pier Access Ladders Details	259

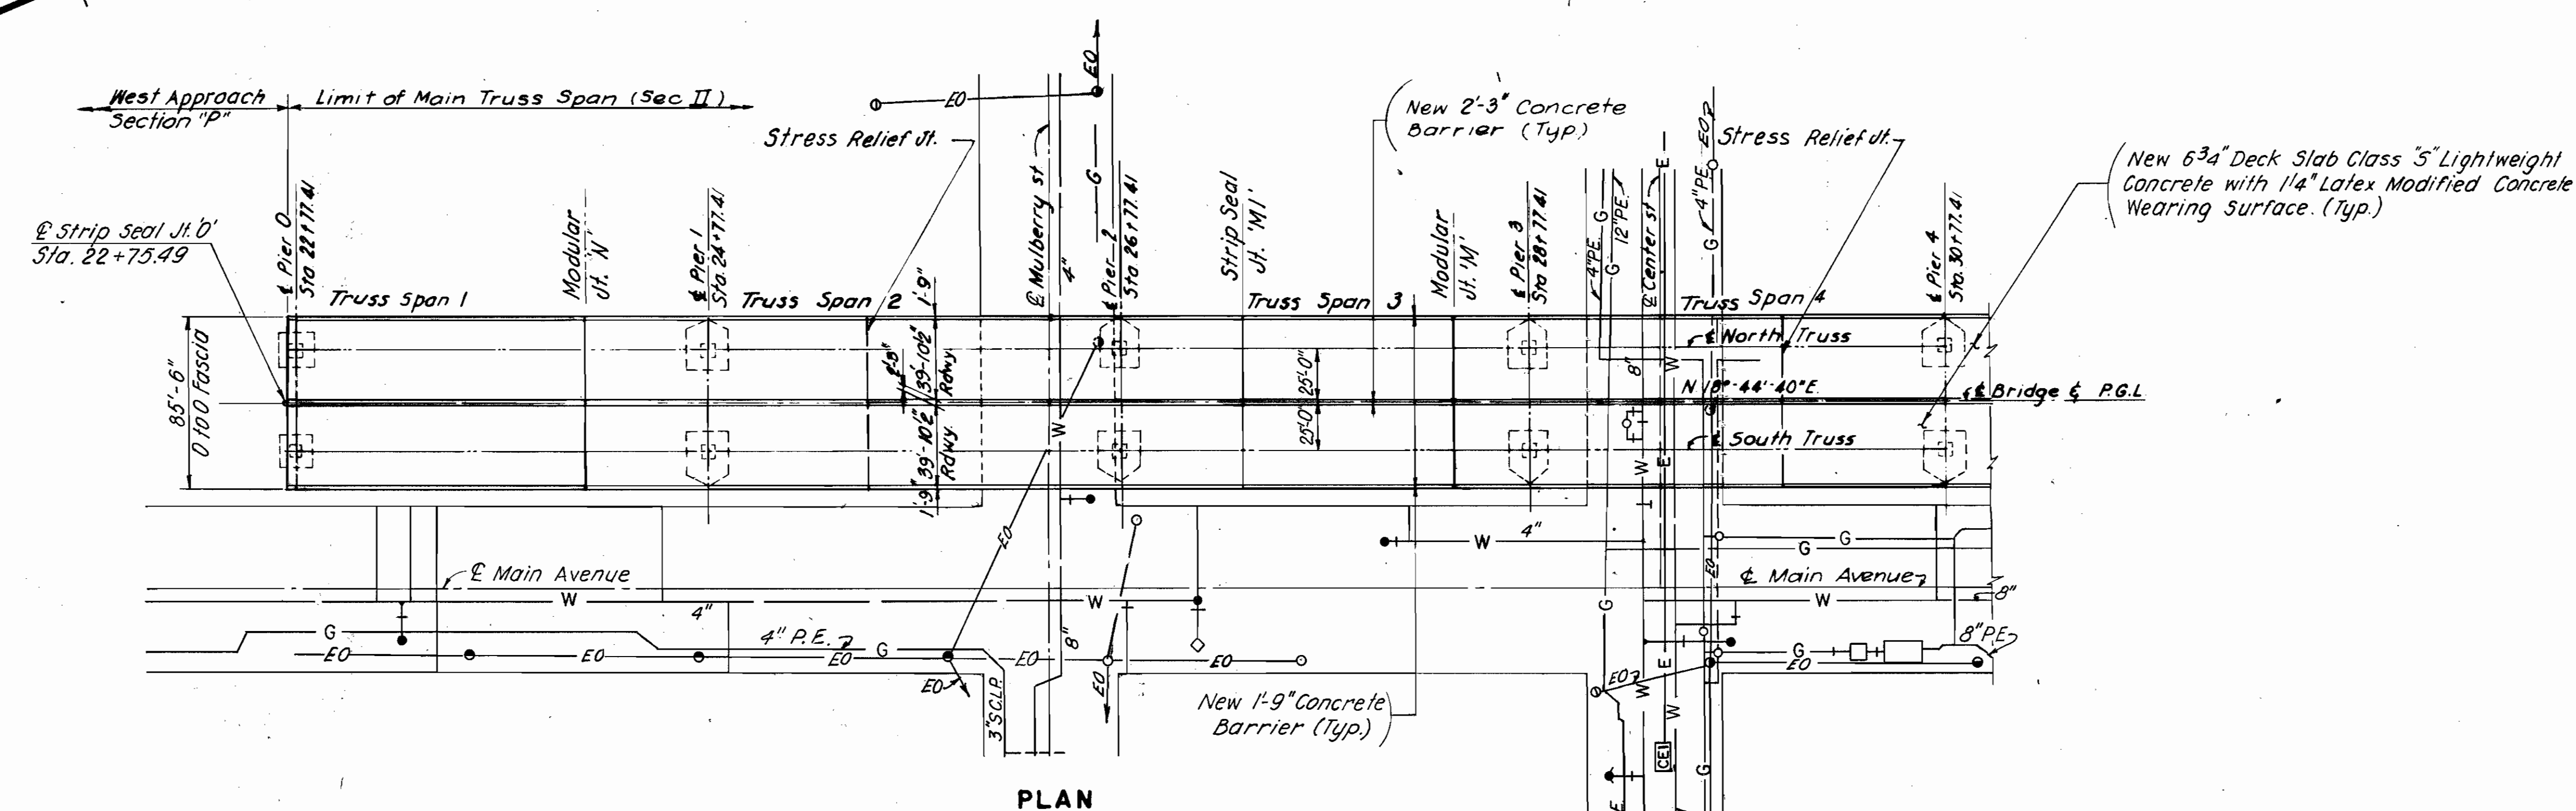

**PLAN**

**Note:**  
New Lighting, Drainage and Traffic Sign Structures are not shown.  
See Deck Plans.

The Contractor shall make provisions to protect all areas under the bridge used by Pedestrians or vehicles and over the river, from falling debris during removal of the existing superstructure and during erection.

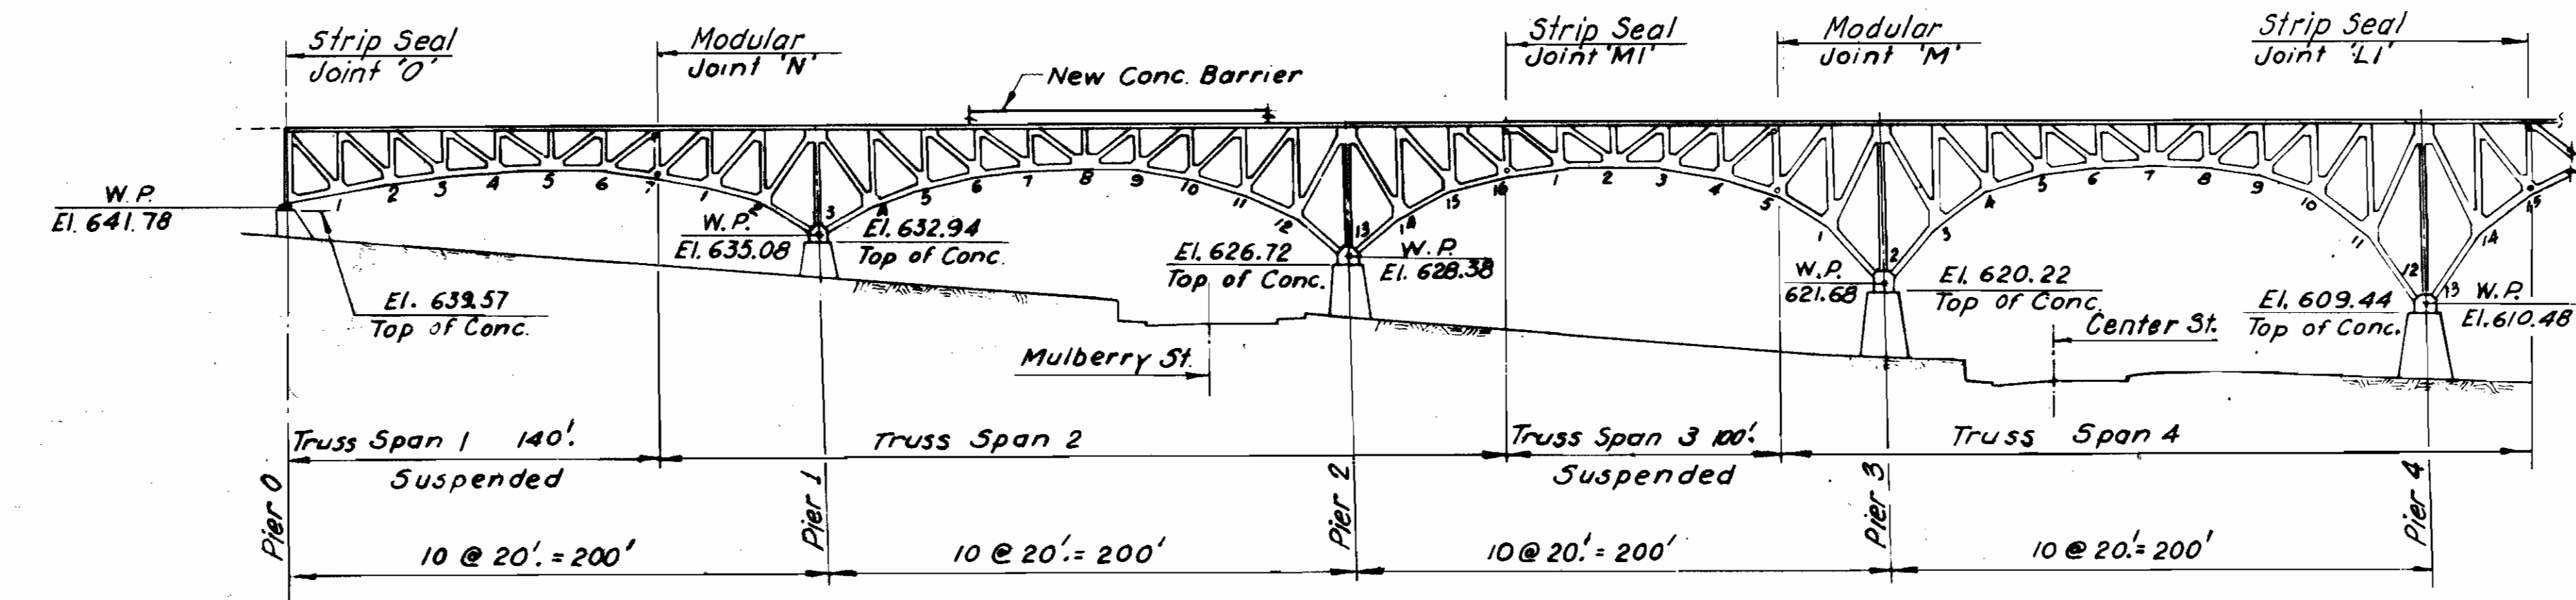

**ELEVATION**

**LEGEND**

- East Ohio Gas
- Ohio Bell Tel. Co.
- Cleveland Public Power Co.
- Water
- Sewers
- Manhole
- Cleveland Electric Illuminating Co.
- Overhead Electric Lines
- C.E.I. Utility Poles



PAVLO ENGINEERING CO., P.C.  
NEW YORK, NEW YORK

**CUYAHOGA COUNTY ENGINEER**  
**CLEVELAND OHIO**

**MAIN AVENUE BRIDGE**  
CITY OF CLEVELAND  
BRIDGE OVER THE CUYAHOGA RIVER VALLEY

**MAIN TRUSS SPAN - PART 1 OF 3**  
**PROPOSED PLAN & ELEVATION**

BRIDGE NO. 193    REPORT NO. 7119    DATE Oct. 25, 1989

**NO. B-136**    204/89



DESIGN A.T.	DRAWN C.P.J.	CHECKED A.S.	REVISED TO AS BUILT AS BUILT 2/94
----------------	-----------------	-----------------	--------------------------------------

MICROFILMED  
JUL 25 1984

FHWA REGION	STATE	PROJECT	
5	OHIO	BHF-73(51)	

211  
547

CUYAHOGA COUNTY  
CJY-2-14.66

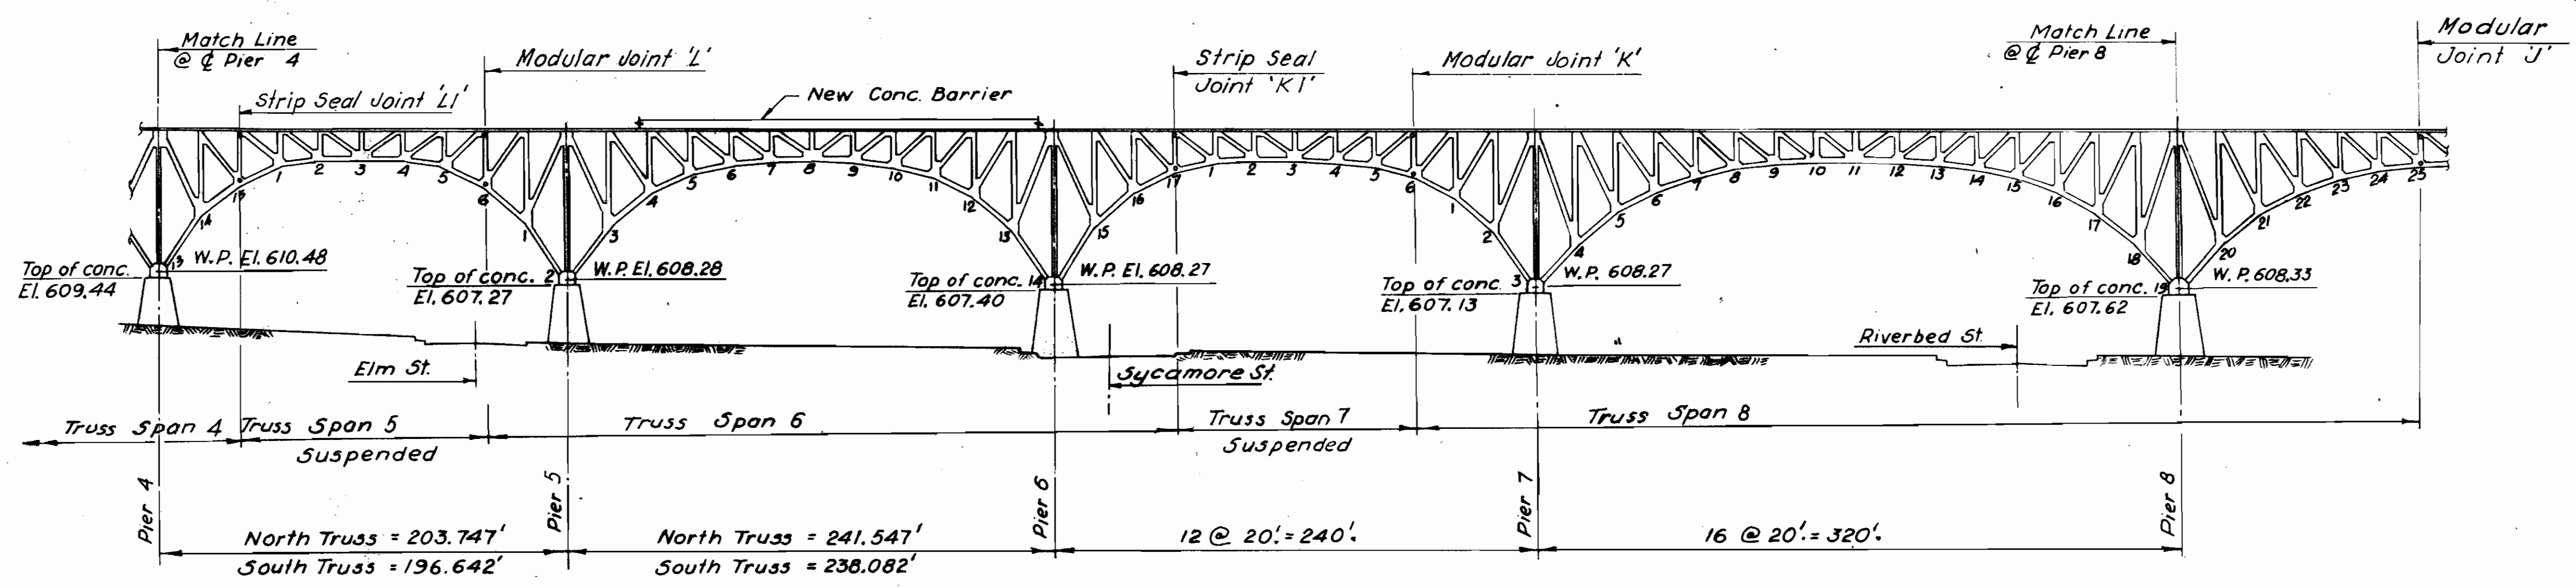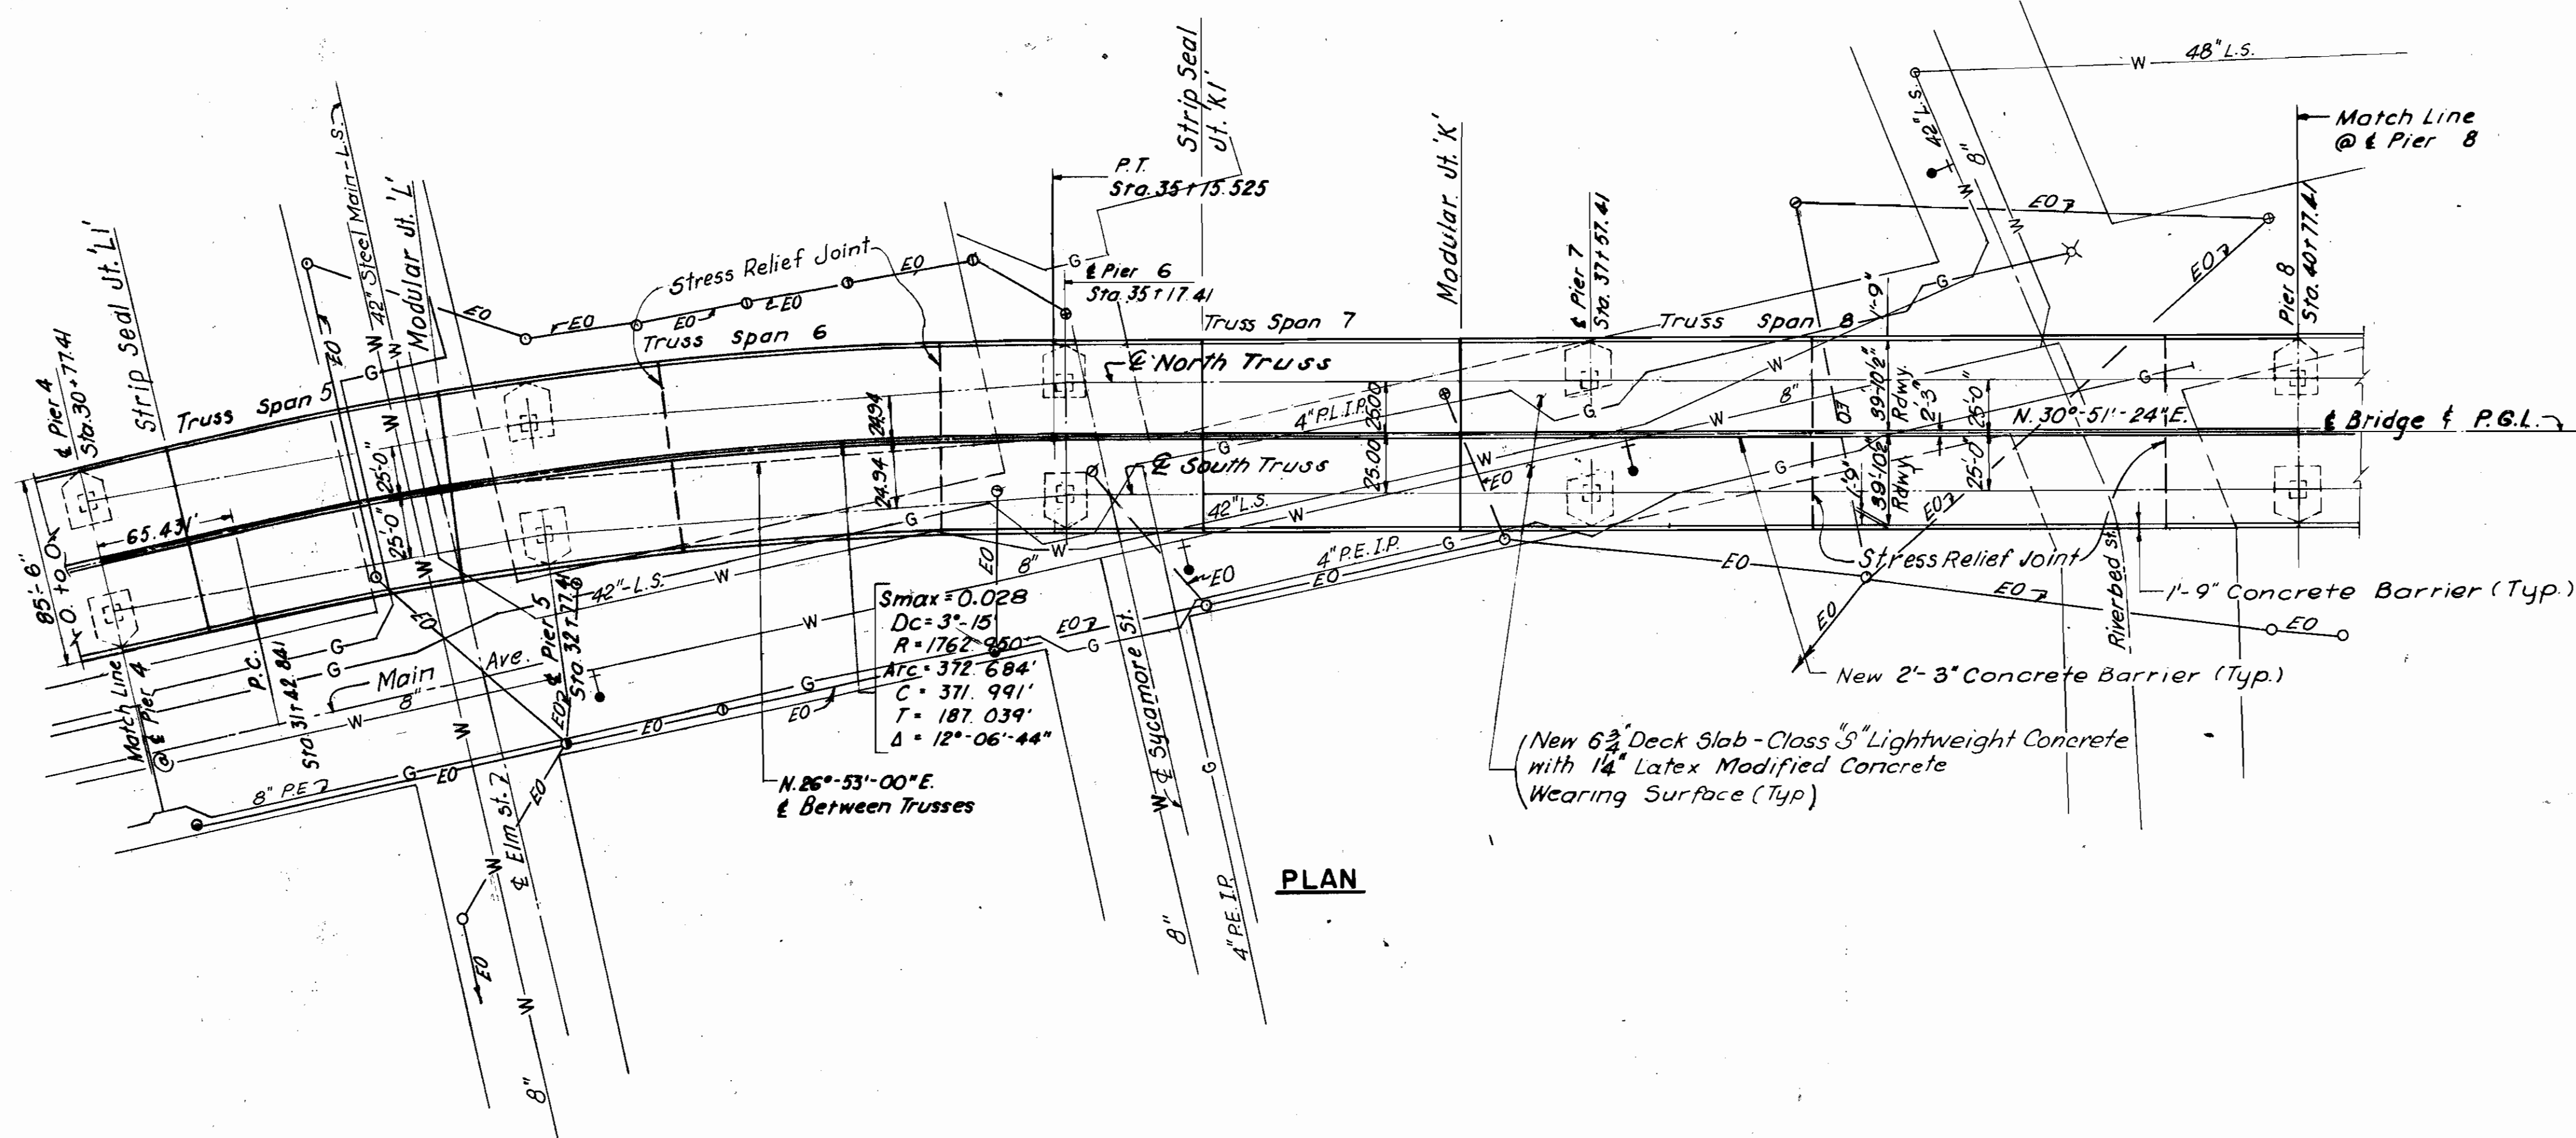

<b>REFERENCES</b>	<b>DWG. NO.</b>
Typical Cross Sections.	207
Notes, Legend, and References	20A

PAVLO ENGINEERING CO., P.C.  
NEW YORK, NEW YORK

CUYAHOGA COUNTY ENGINEER  
CLEVELAND OHIO


**MAIN AVENUE BRIDGE**  
CITY OF CLEVELAND  
BRIDGE OVER THE CUYAHOGA RIVER VALLEY



**MAIN TRUSS SPAN - PART 2 OF 3  
PROPOSED PLAN & ELEVATION**

BRIDGE NO. 193 REPORT NO. 7119 DATE Oct. 25, 1989


**NO. B-136** 205  
89

DESIGN A.T.	DRAWN C.P.J.	CHECKED A.S.	REVISED TO AS BUILT AS BUILT 2/94
----------------	-----------------	-----------------	--------------------------------------

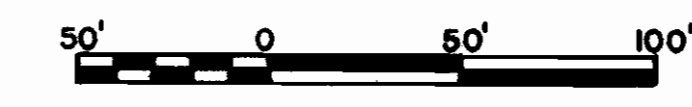

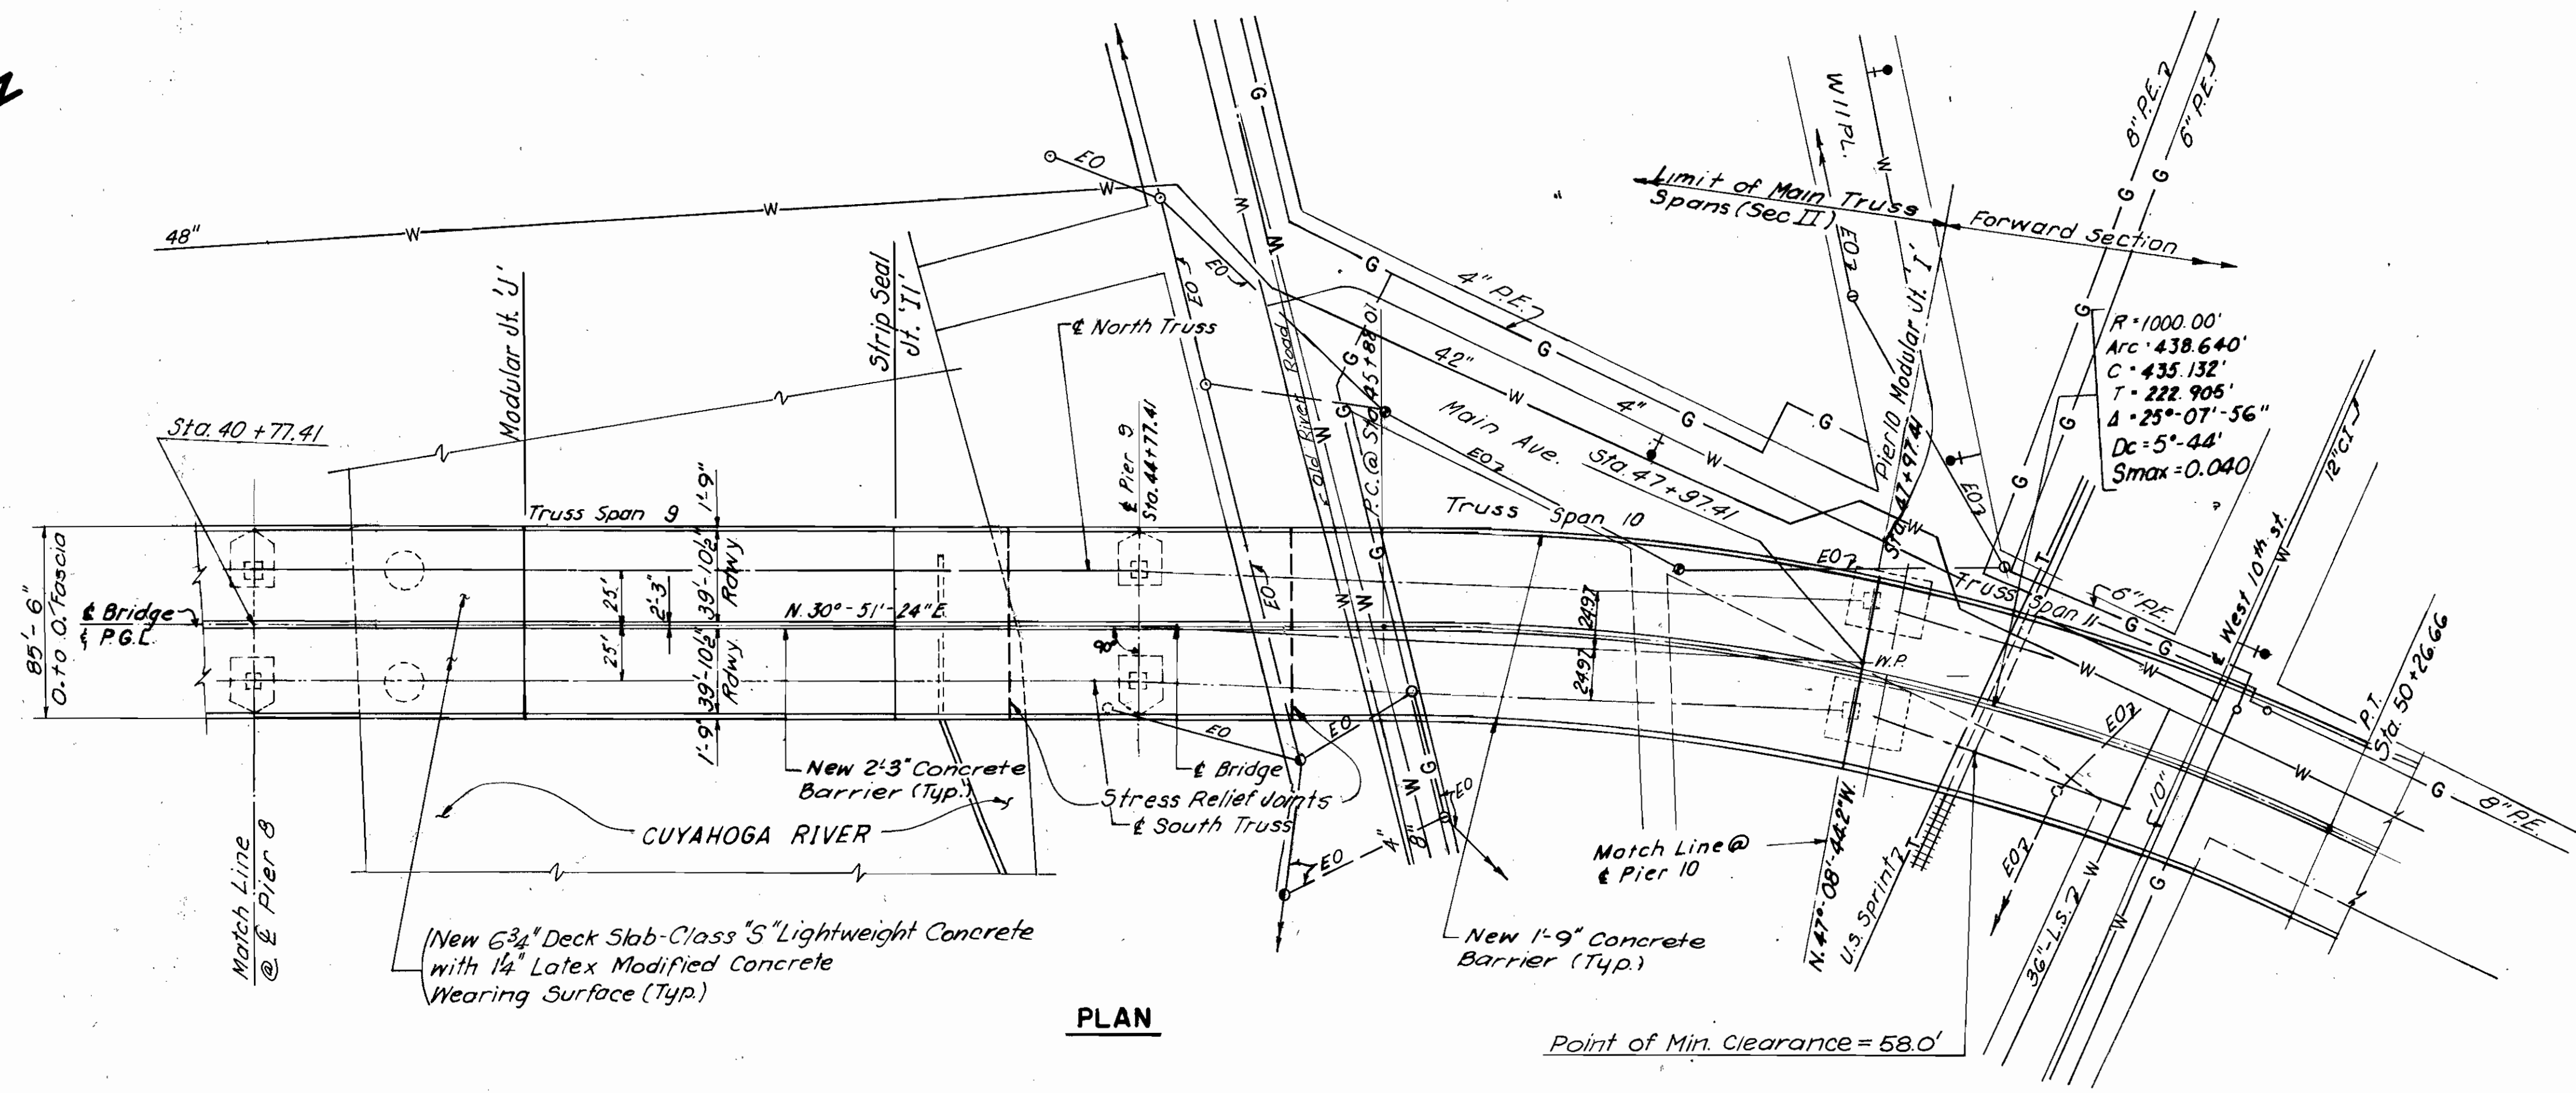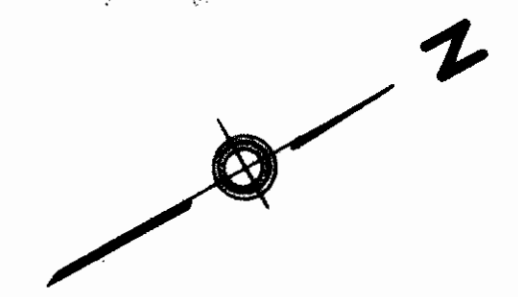

**PLAN**

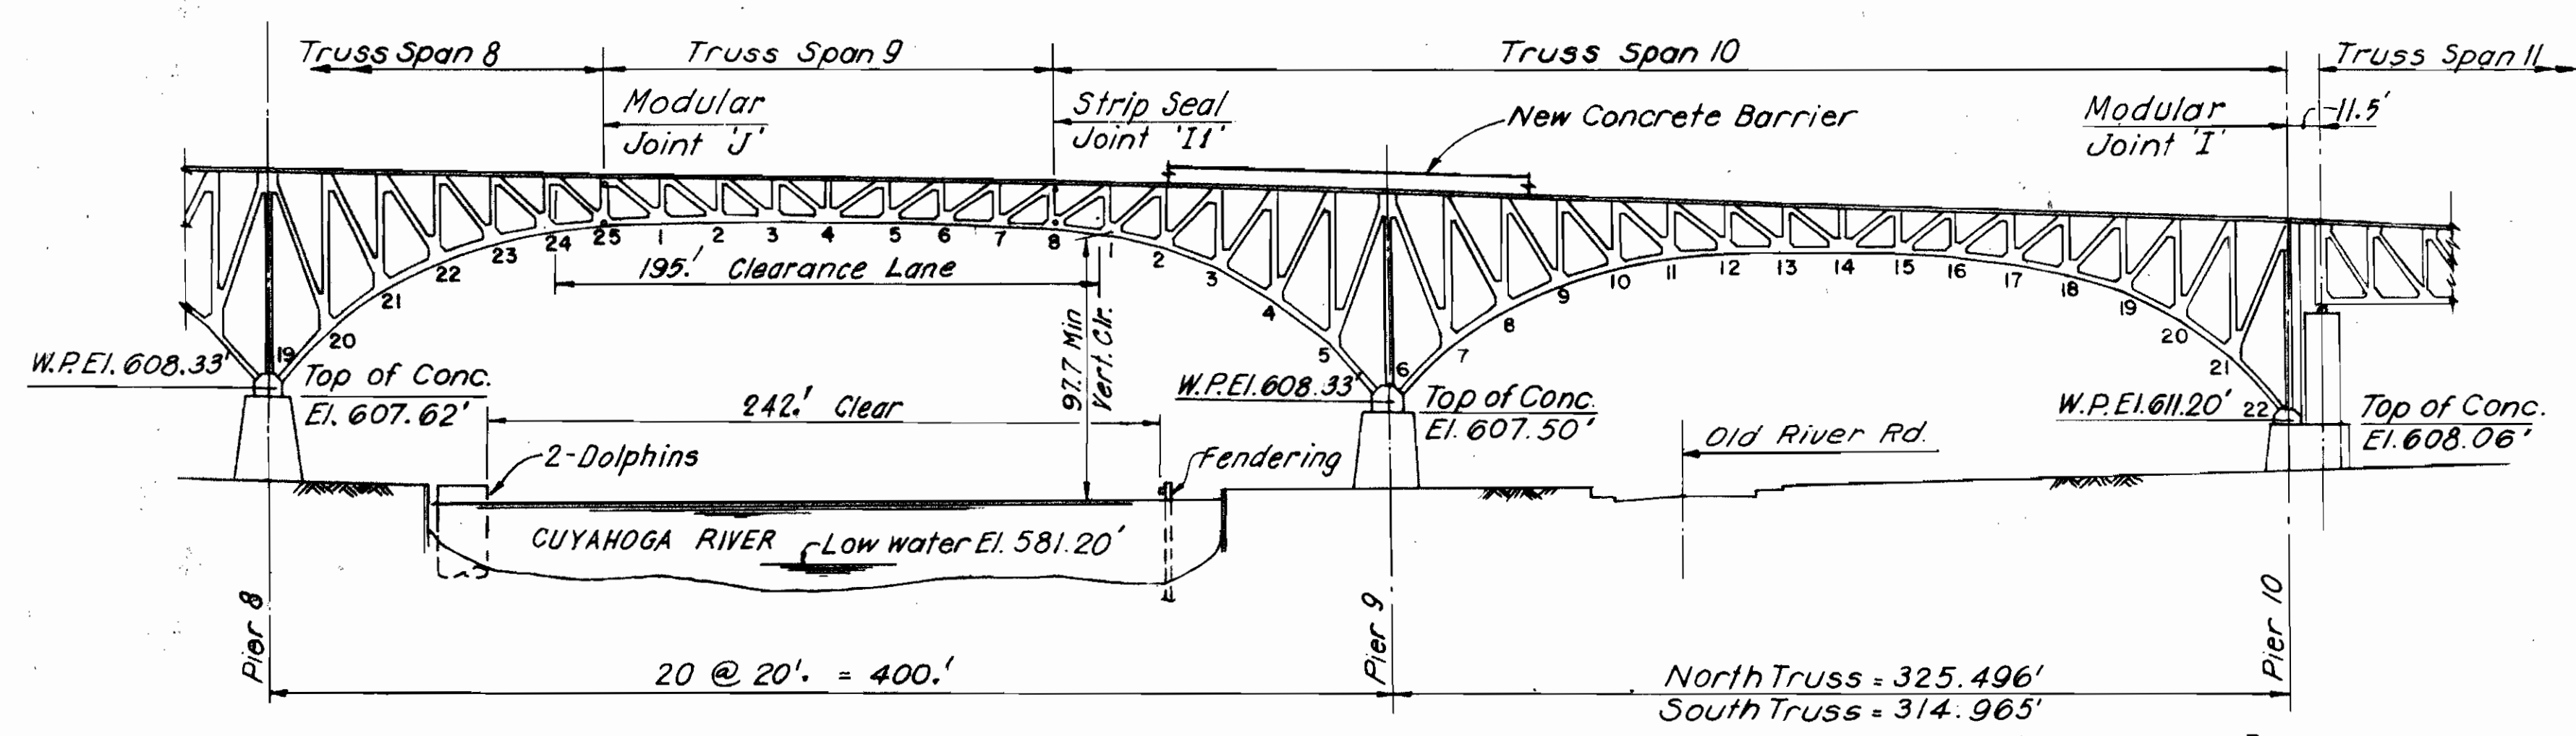

**ELEVATION**

<b>REFERENCES</b>	<b>DWG. NO.</b>
Typical Cross Sections	207
Notes, Legend, and References	204

PAVLO ENGINEERING CO., P.C.  
NEW YORK, NEW YORK

CUYAHOGA COUNTY ENGINEER  
CLEVELAND OHIO

**MAIN AVENUE BRIDGE**  
CITY OF CLEVELAND  
BRIDGE OVER THE CUYAHOGA RIVER VALLEY


**MAIN TRUSS SPAN - PART 3 OF 3  
PROPOSED PLAN & ELEVATION**

BRIDGE NO. 193 REPORT NO. 7119 DATE Oct. 25, 1989


**NO. B-136**

DESIGN A.T.	DRAWN C.P.J.	CHECKED A.S.	REVISED TO AS BUILT AS BUILT 2/94
----------------	-----------------	-----------------	--------------------------------------




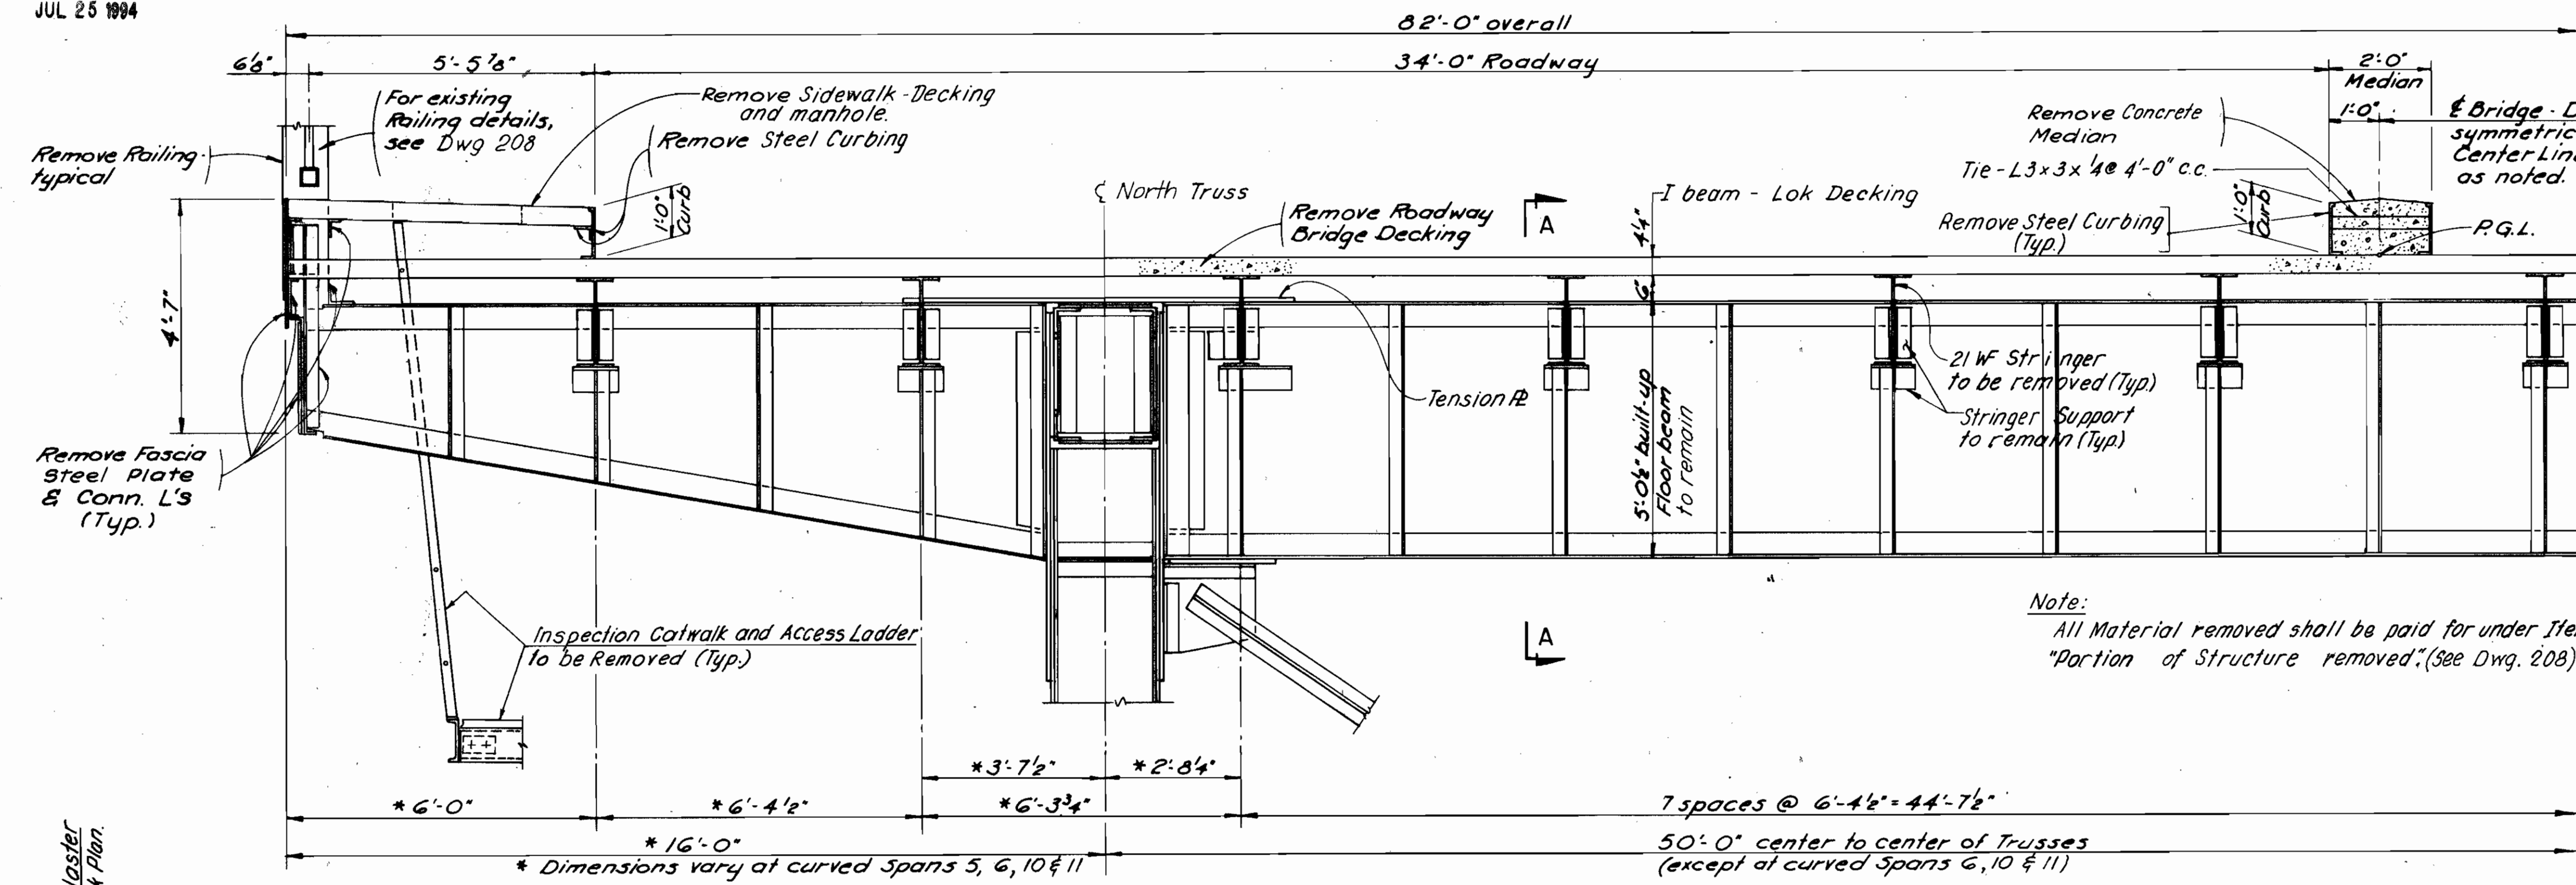


EXISTING CROSS SECTION (Looking East)

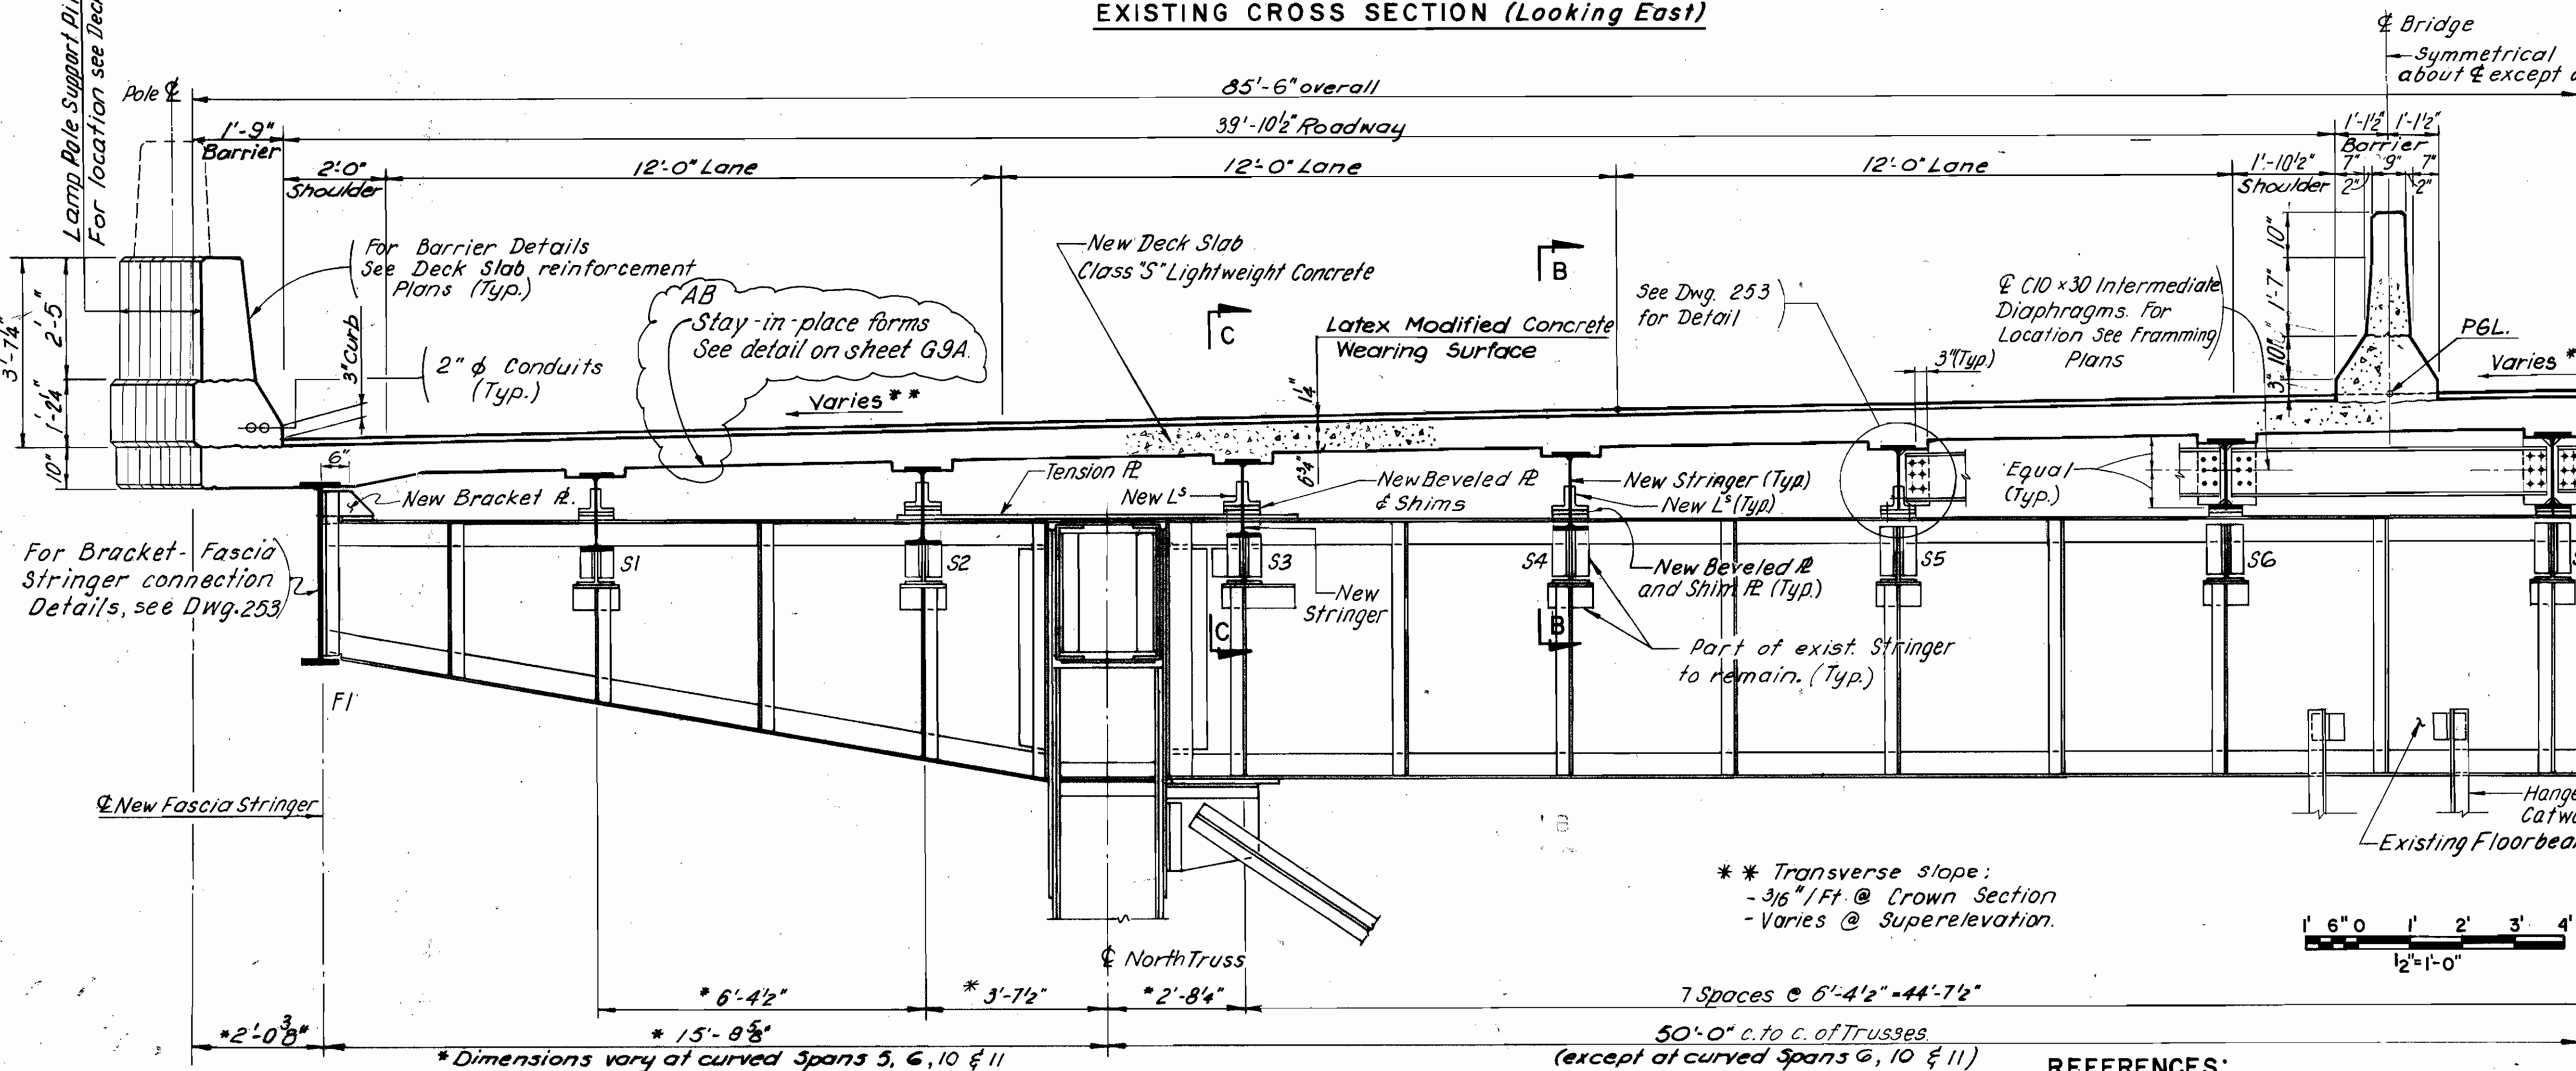


PROPOSED CROSS SECTION (Looking East)

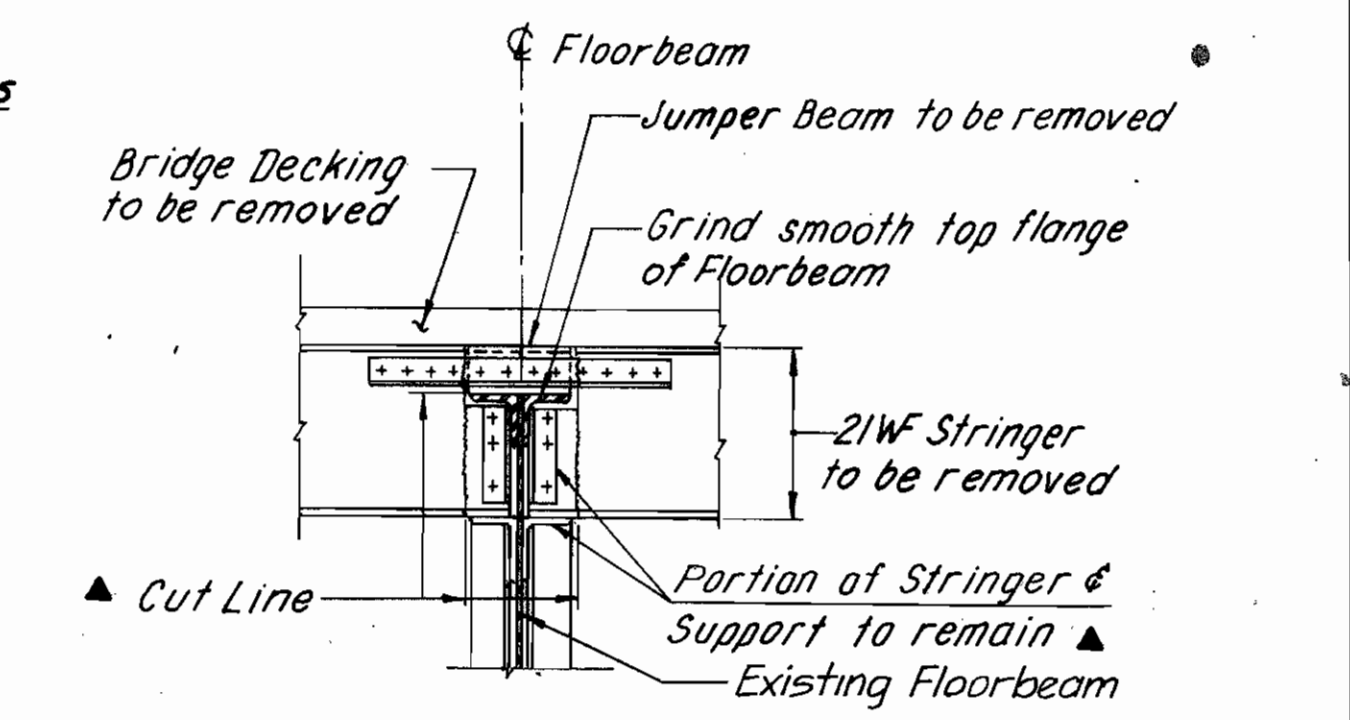

SECTION A-A EXISTING CONDITION (Expansion Joint Stringers)

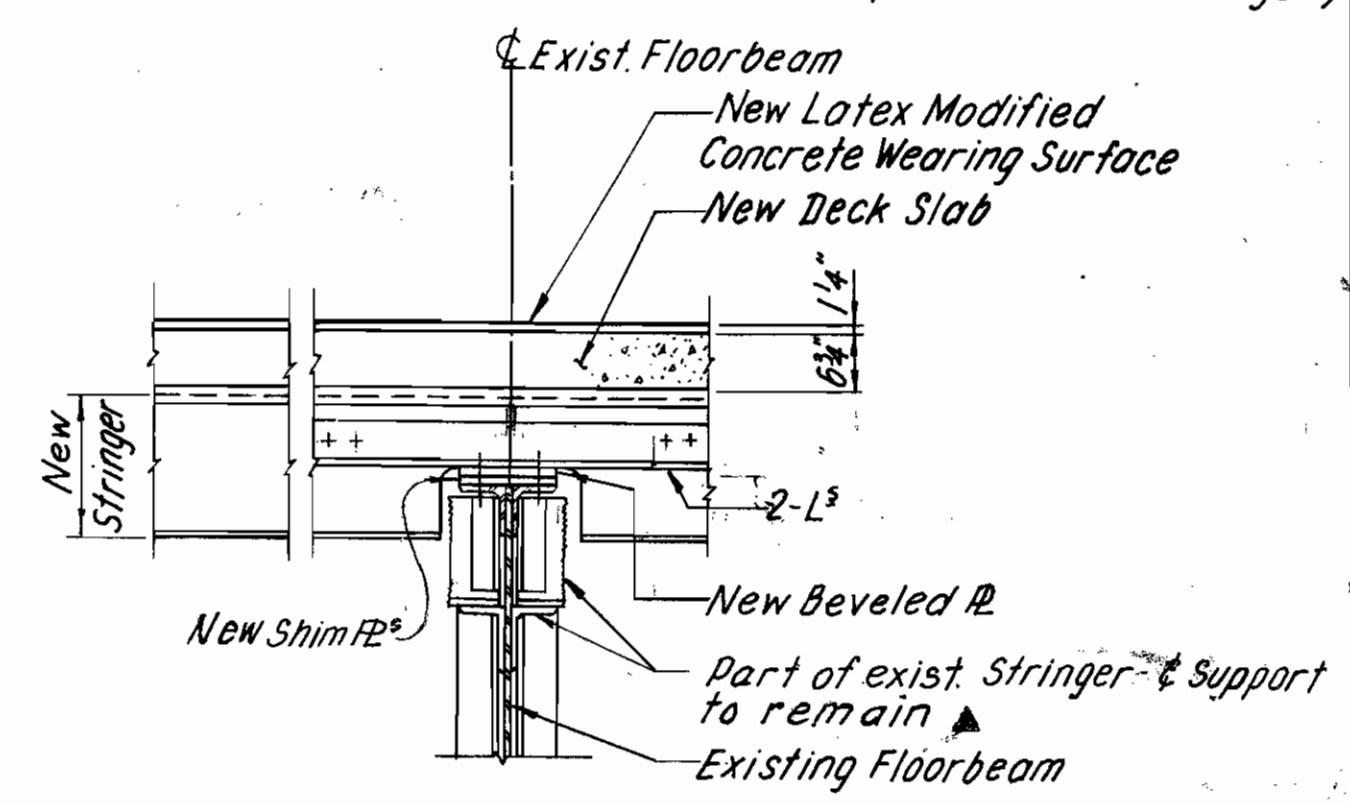

SECTION B-B EXISTING CONDITION

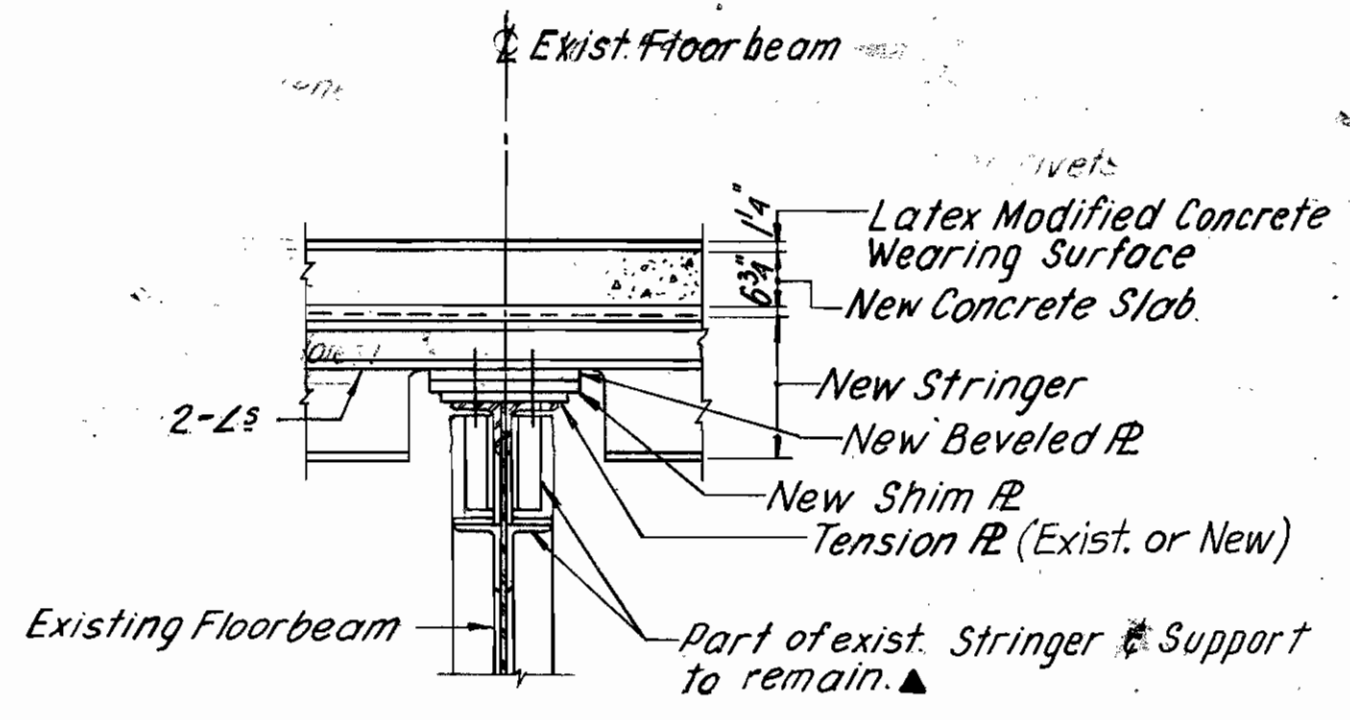

SECTION C-C AS BUILT


REFERENCES:


- General Notes
- Existing and Proposed Plan & Elevation
- Framing Plans
- Stringer Details
- Stringer Schedules

DWG. NO.

- G6 to G23
- 201 to 206
- 210 to 216
- 231 & 251 to 253
- 252 to 248

PAVLO ENGINEERING CO., P.C. NEW YORK, NEW YORK			
CUYAHOGA COUNTY ENGINEER CLEVELAND OHIO			
MAIN AVENUE BRIDGE CITY OF CLEVELAND BRIDGE OVER THE CUYAHOGA RIVER VALLEY			
MAIN TRUSS SPAN TYPICAL CROSS SECTION			
BRIDGE NO. 193	REPORT NO. 7119	DATE Oct. 25, 1989	
NO. B-136			207
DESIGN D.G.	DRAWN A.D.	CHECKED A.S.	REVISED TO AS BUILT AS BUILT 2/94

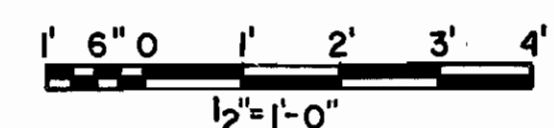

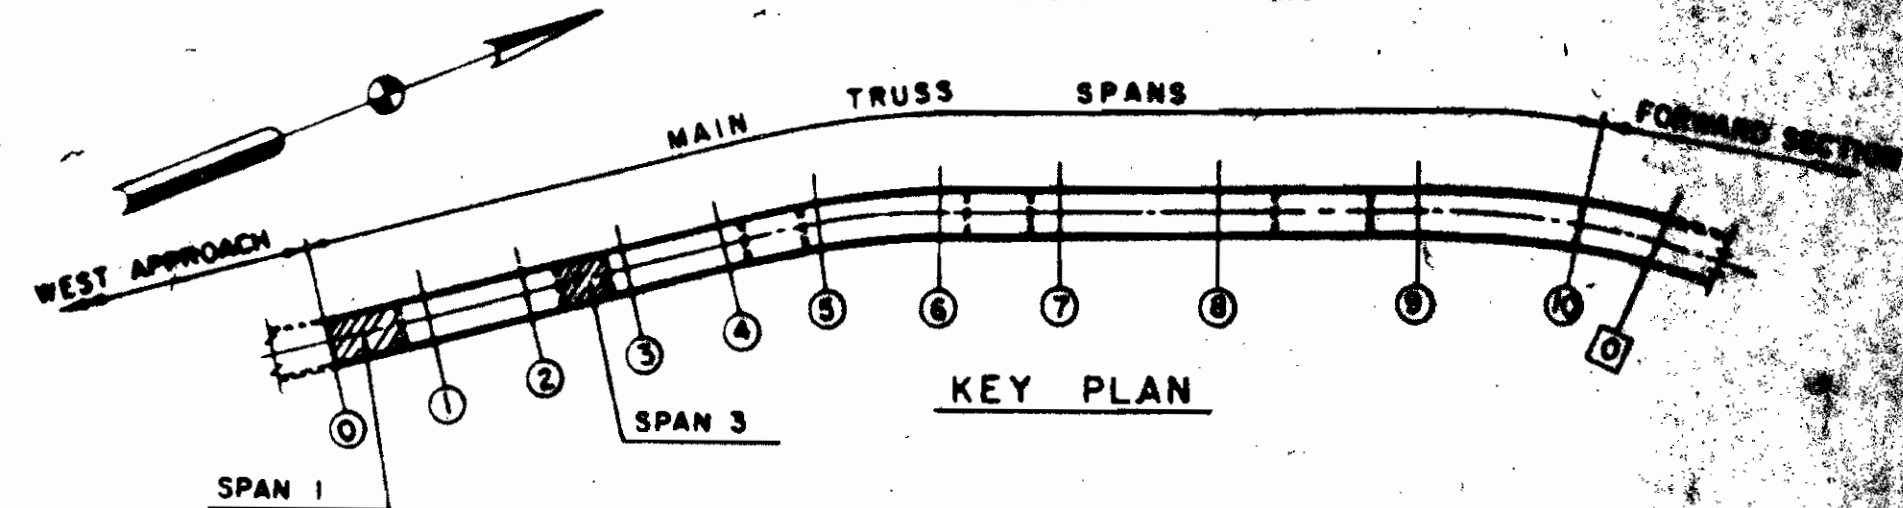

EXISTING FRAMING REMOVAL

MARK	DESIGNATION	TRUSS SPAN		REMARKS
		1	3	
S1	21W63	70	50	
S2	21W59	14	10	
D1	10W33	42	30	
D2	9C134	28	20	
F1	R 30x3 <sup>3</sup> / <sub>8</sub>	14	10	
	2-L's 4x3x <sup>3</sup> / <sub>8</sub>	28	20	
-	8W17	4	4	Lamp Support
-	15C339	2	2	Diaphragm

NOTES:

- All existing dimensions and details were obtained from original Contract Plans and Shop Dwg's, and shall be verified in field by the Contractor prior to making alterations.
- All longitudinal and transverse dimensions are measured horizontally.
- New steel (shapes and plates) shall conform to ASTM-A36 (AASHTO-M183) unless otherwise noted.
- All High Strength bolted connections shall be of the "Friction Type" unless noted otherwise.
- Welding details and procedures shall conform to the A.W.G. and A.A.S.H.T.O. latest Specifications as modified by ODOT Supplement I.
- All new stringers shall be installed vertical.
- For Finishing Machine Support notes see Dwg 68.
- Welding of attachments shall not be permitted in the tension zone of the stringers.
- For Stringers in truss spans the tension zone is 3'-0" each side of interior supports.
- All new rolled beams, Shapes and Plates shall be ASTM A36, A13C Category I.
- All new welded Members including Fascia Stringers, replacement Floor beams and Brackets shall be ASTM A36 A13C Category II.

NOTE: ELEVATIONS AT 66" FLOOR BEAMS ARE AT TOP OF FLANGE ANGLES.

PAVLO ENGINEERING CO., P.C.  
NEW YORK, NEW YORK

CUYAHOGA COUNTY ENGINEER  
CLEVELAND OHIO


**MAIN AVENUE BRIDGE**  
CITY OF CLEVELAND  
BRIDGE OVER THE CUYAHOGA RIVER VALLEY

MAIN TRUSS SPAN-1 AND 3  
**EXIST. & PROP. FRAMING PLAN**


BRIDGE NO. 193 REPORT NO. 718 DATE 7/91

**NO. B-136**


DESIGN	DRAWN	CHECKED	REVIEWED
A.S.	T.	R.V.	AS BUILT 2/94

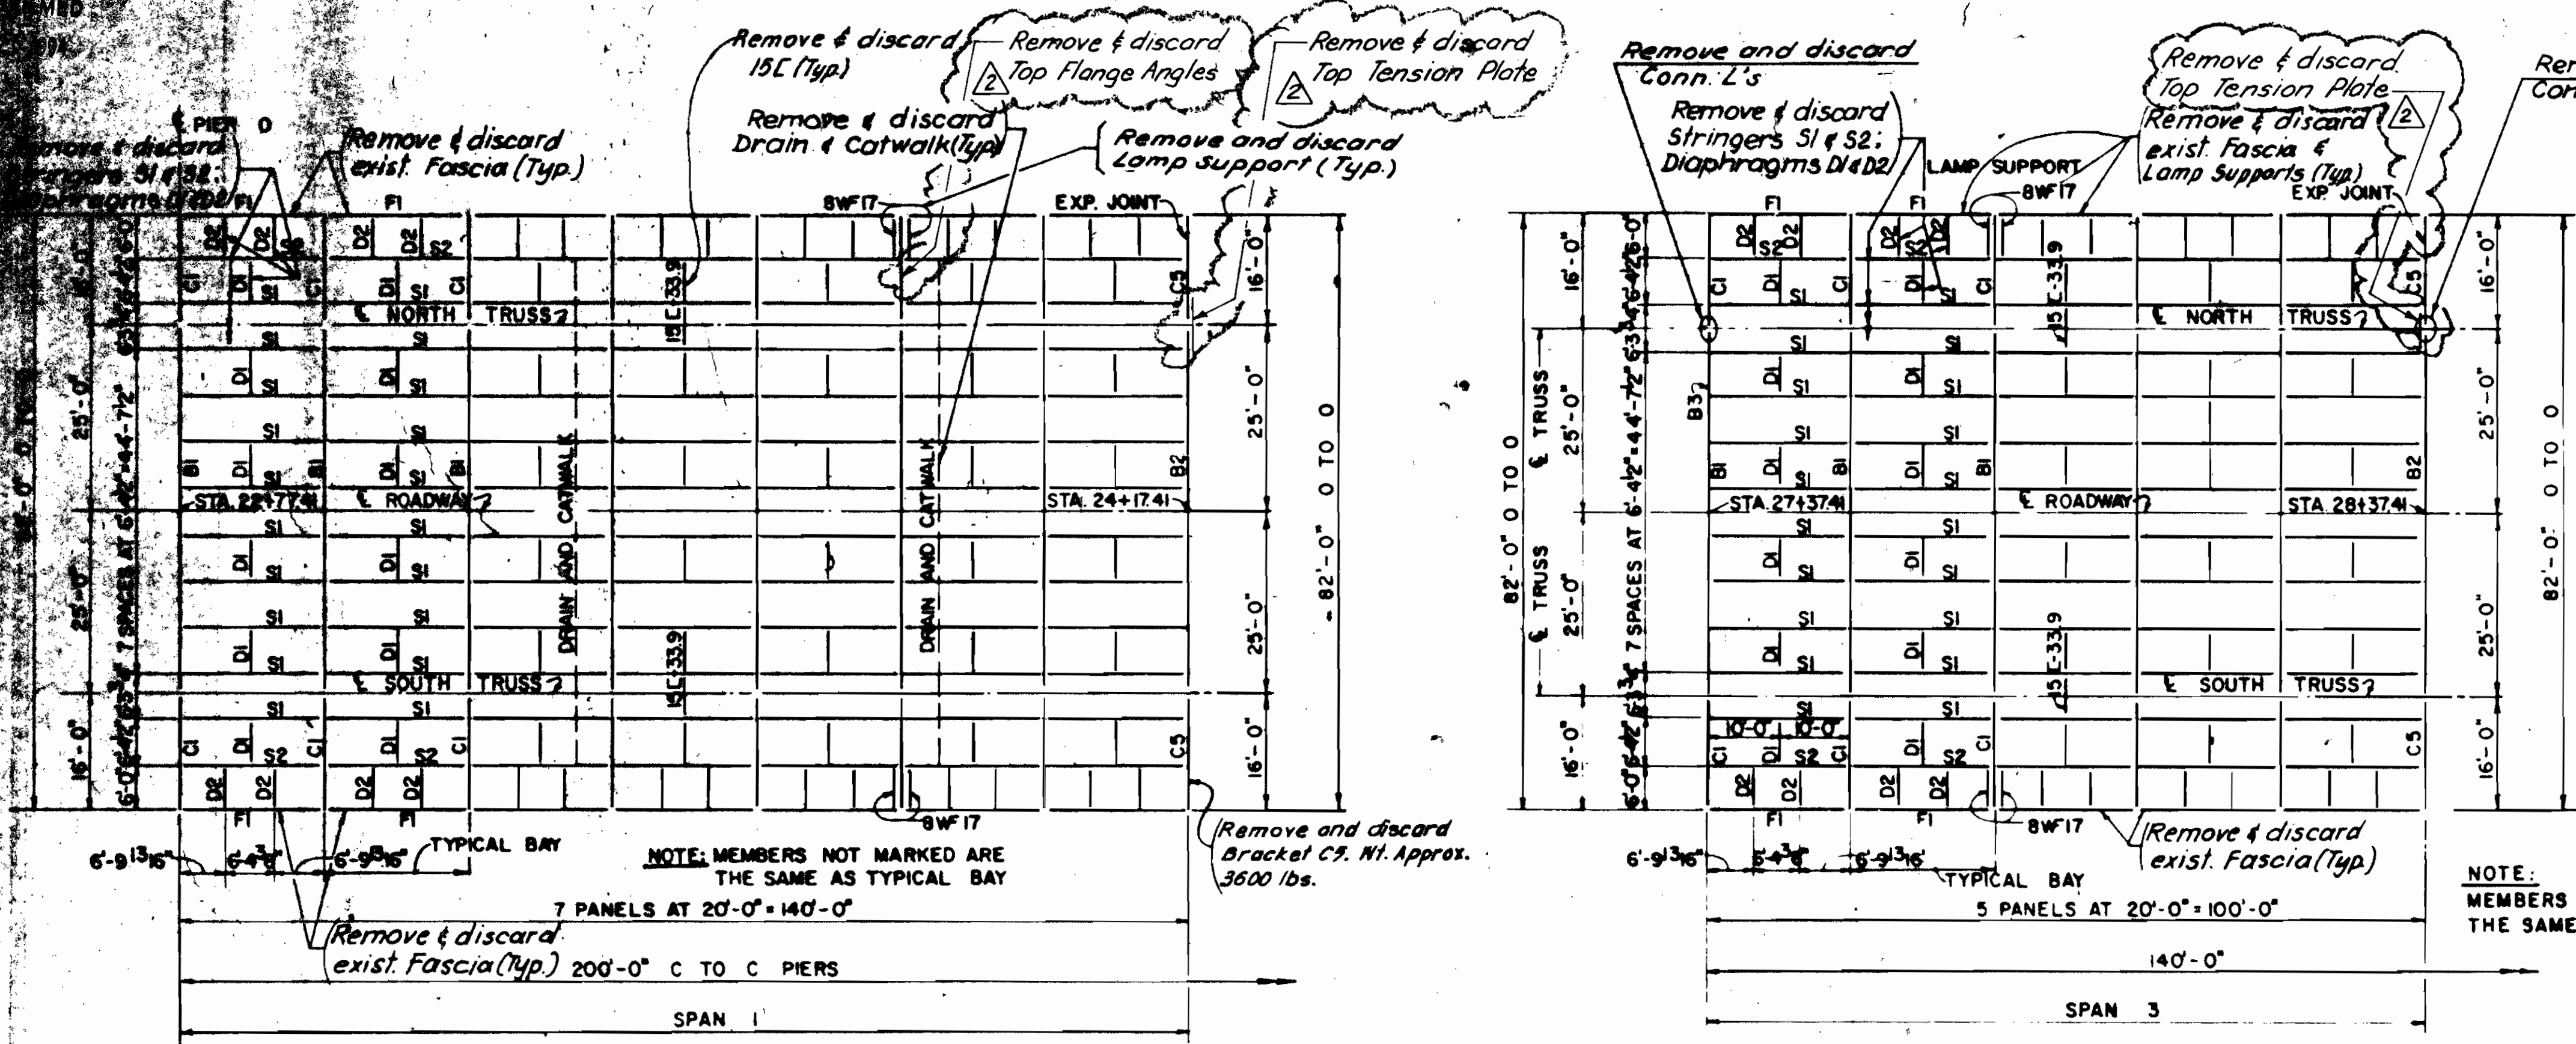

EXISTING FRAMING PLANS

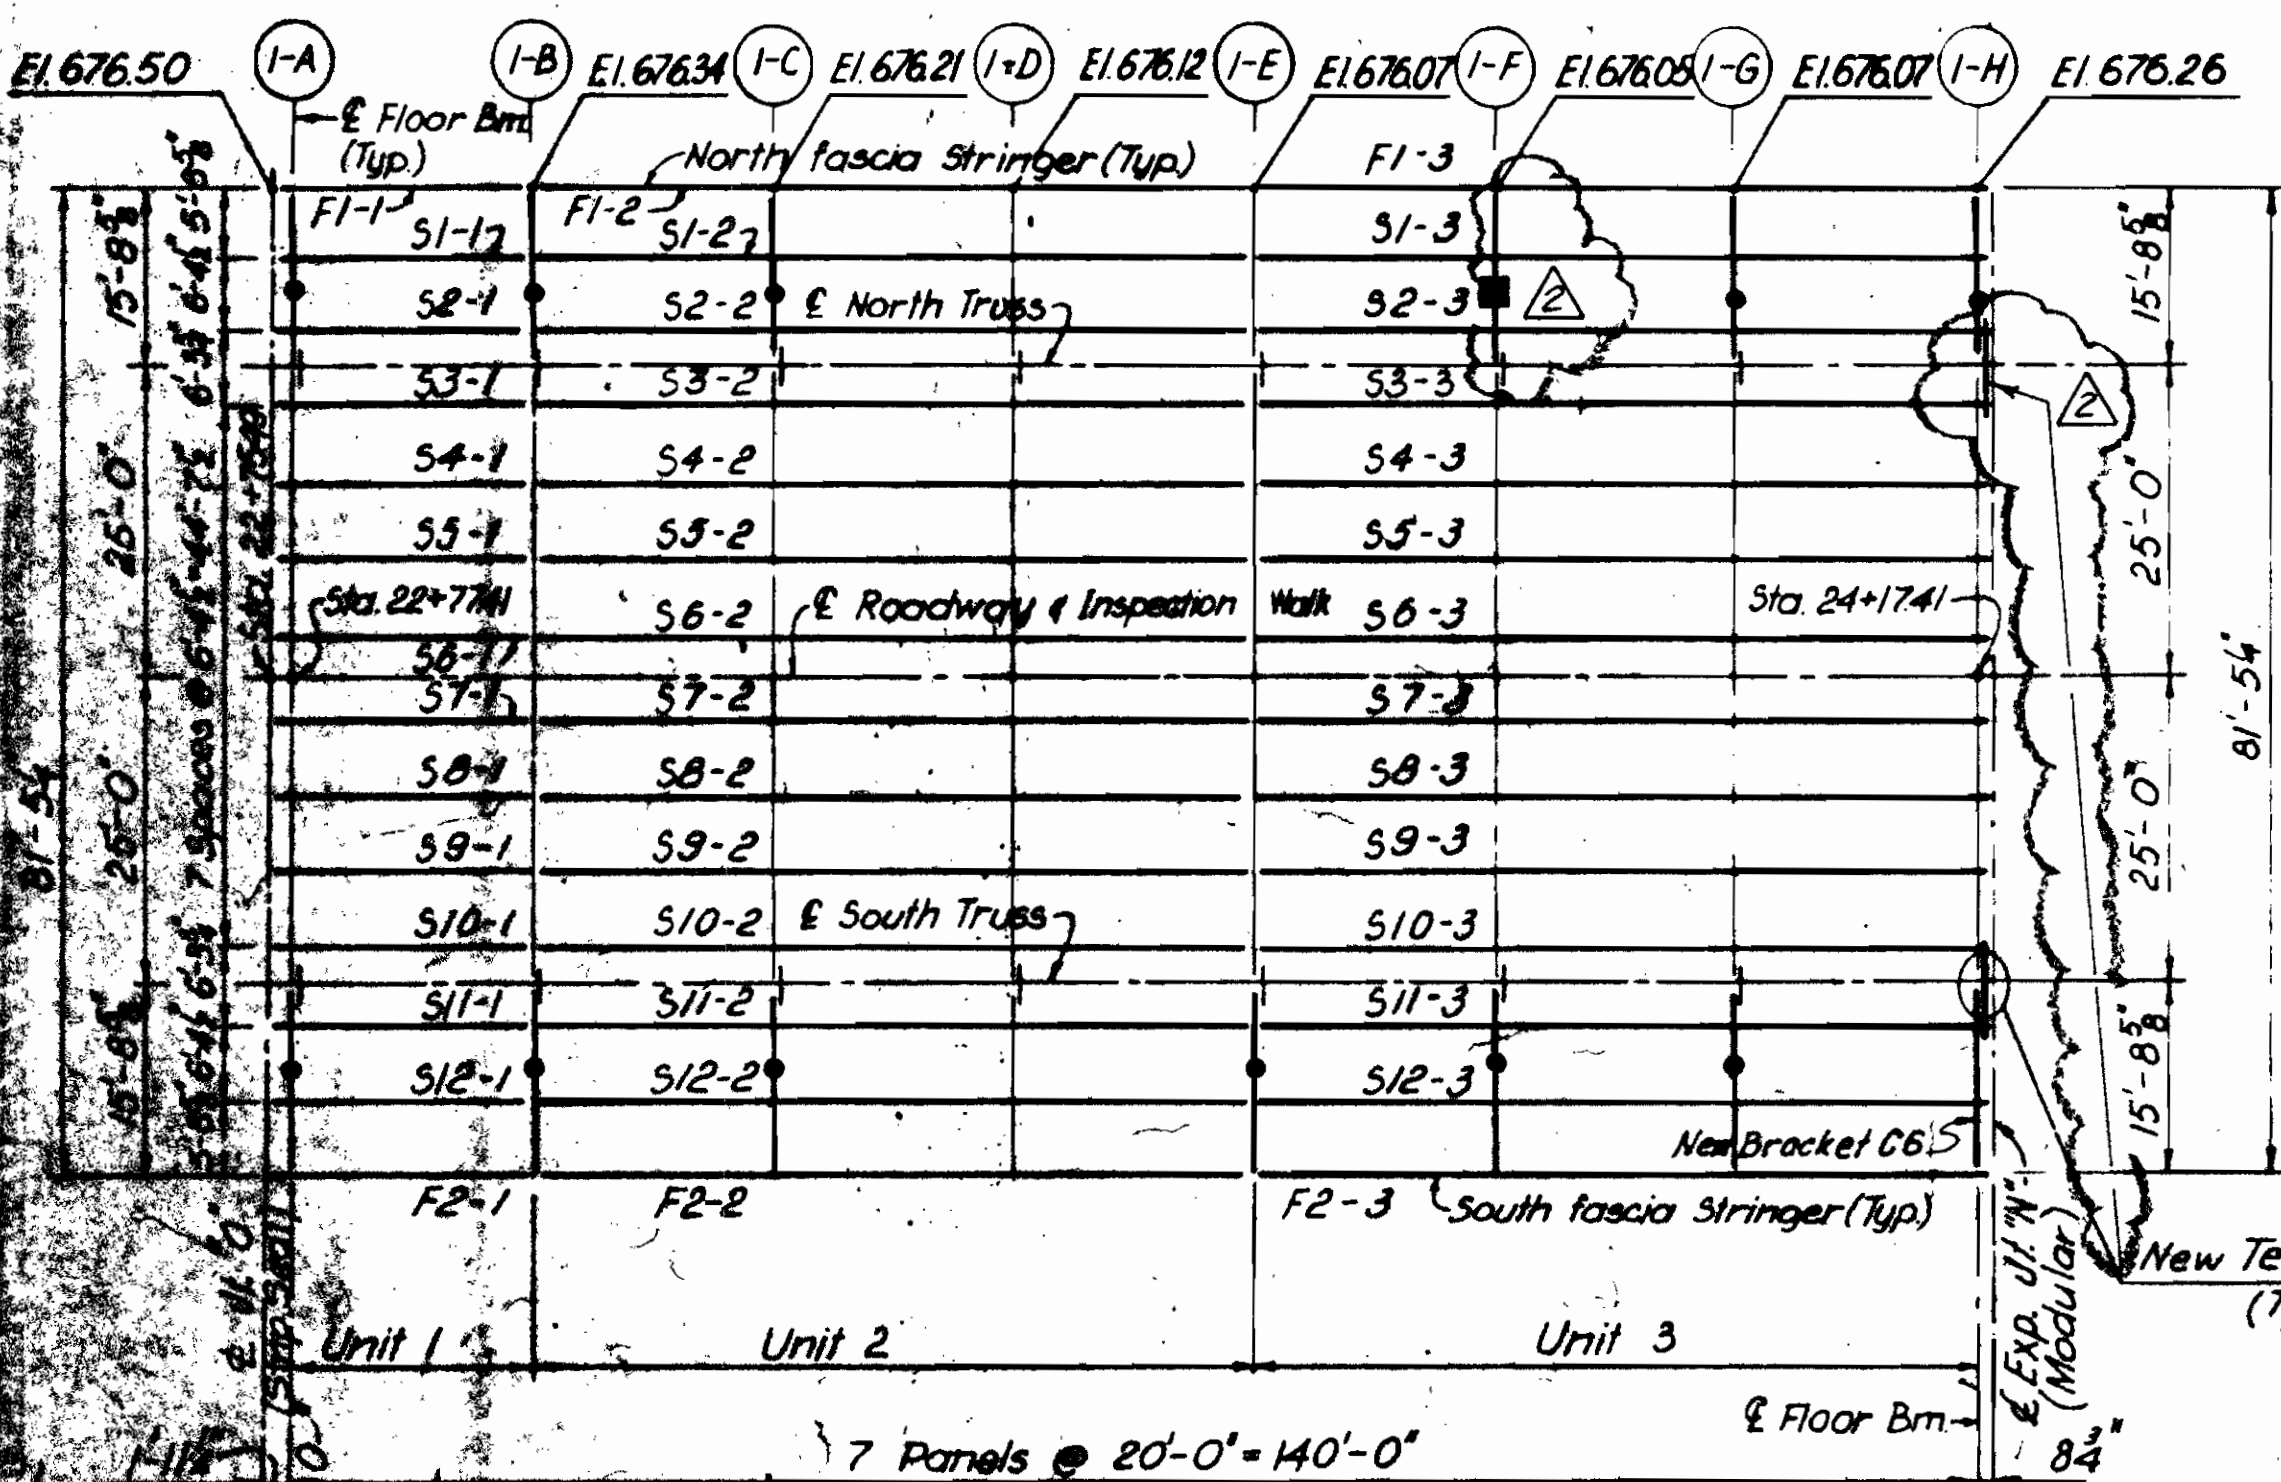

TRUSS SPAN 1 - PROPOSED FRAMING PLAN

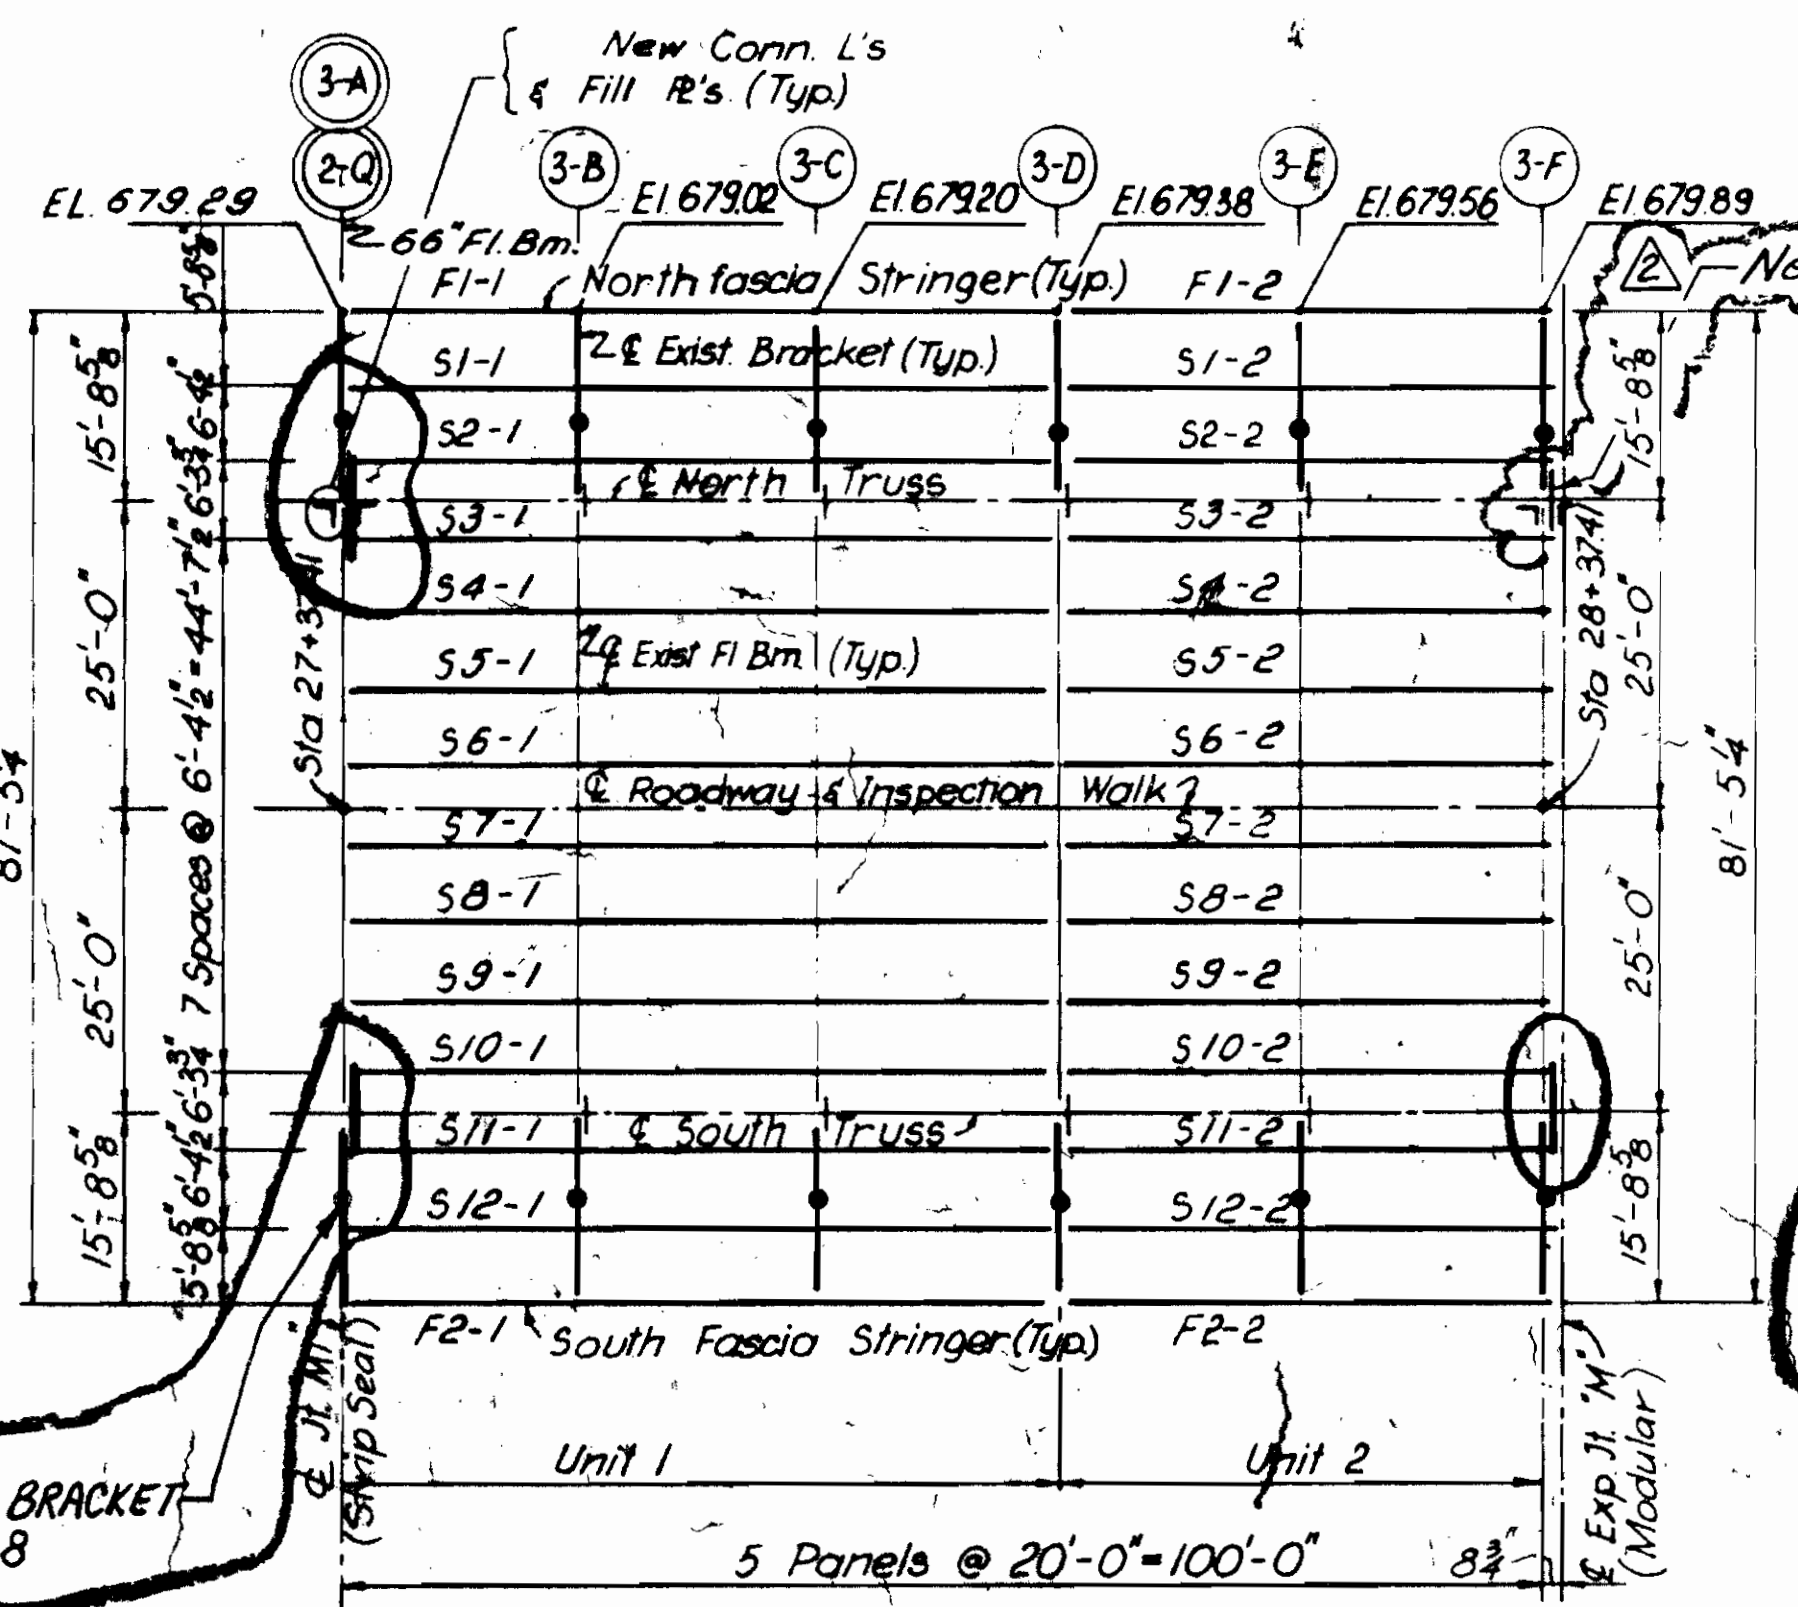

TRUSS SPAN 3 - PROPOSED FRAMING PLAN

- Denotes Bracket Replacement
- Denotes Top Flange Angles Replacement
- Denotes new or modified framing member
- Indicates elevation @ top of existing floor beam (Floor beam is horizontal)
- Denotes 66" deep Floor Beam (Typical floorbeams are 60" deep)

REFERENCES

- Typical Cross Section
- Stringer Schedules
- Stringer Details
- New Floor Beams
- New Brackets
- Fascia Stringer Camber Table
- Fascia Stringer Setting Dimensions

DWG. NO.

- 207
- 232 to 248
- 231, 251, 252 & 253
- 254
- 255
- 249
- 250



REFERENCES

- Floor Beam & Brackets repair
- Miscellaneous Structural Details
- Inspection Walk
- Stress Relief Joints
- C.V.N. Note

DWG. NO.

- 256
- 260, 261
- 257, 258, 259
- 276
- 204


Rev. 2	Plan Revisions	7/3/91
REV. 1	PLAN REVISIONS	2-1-91

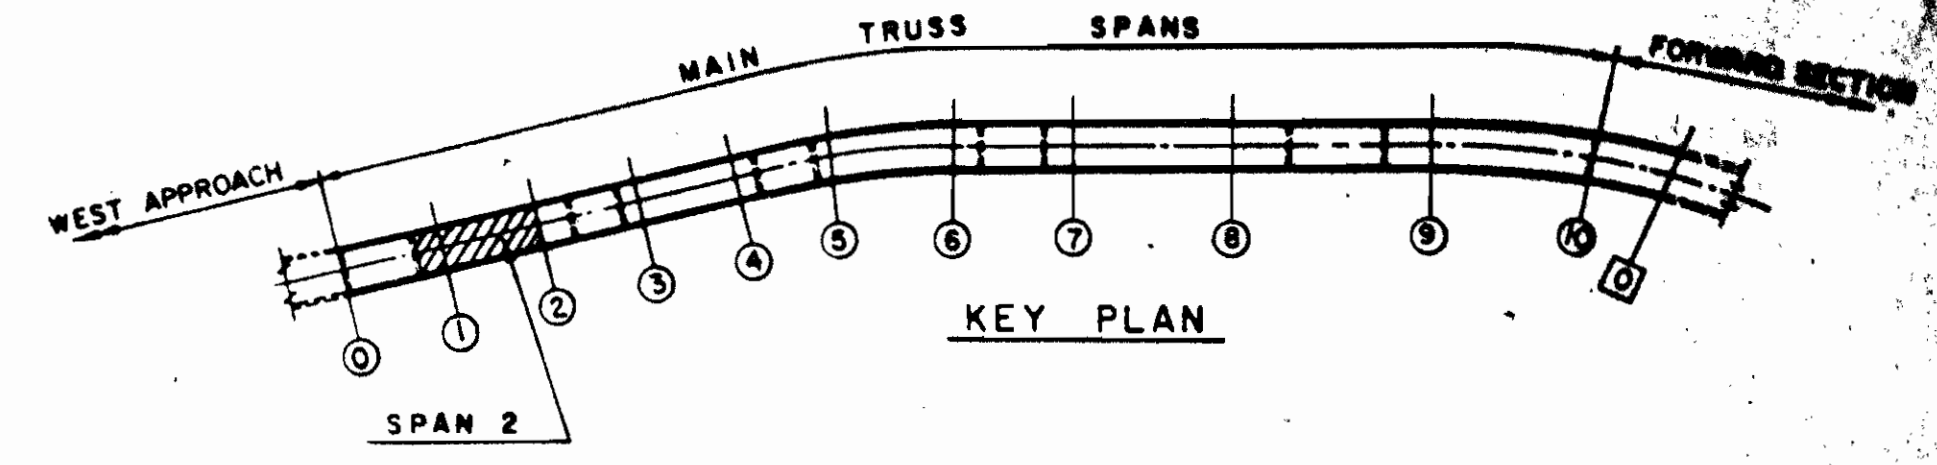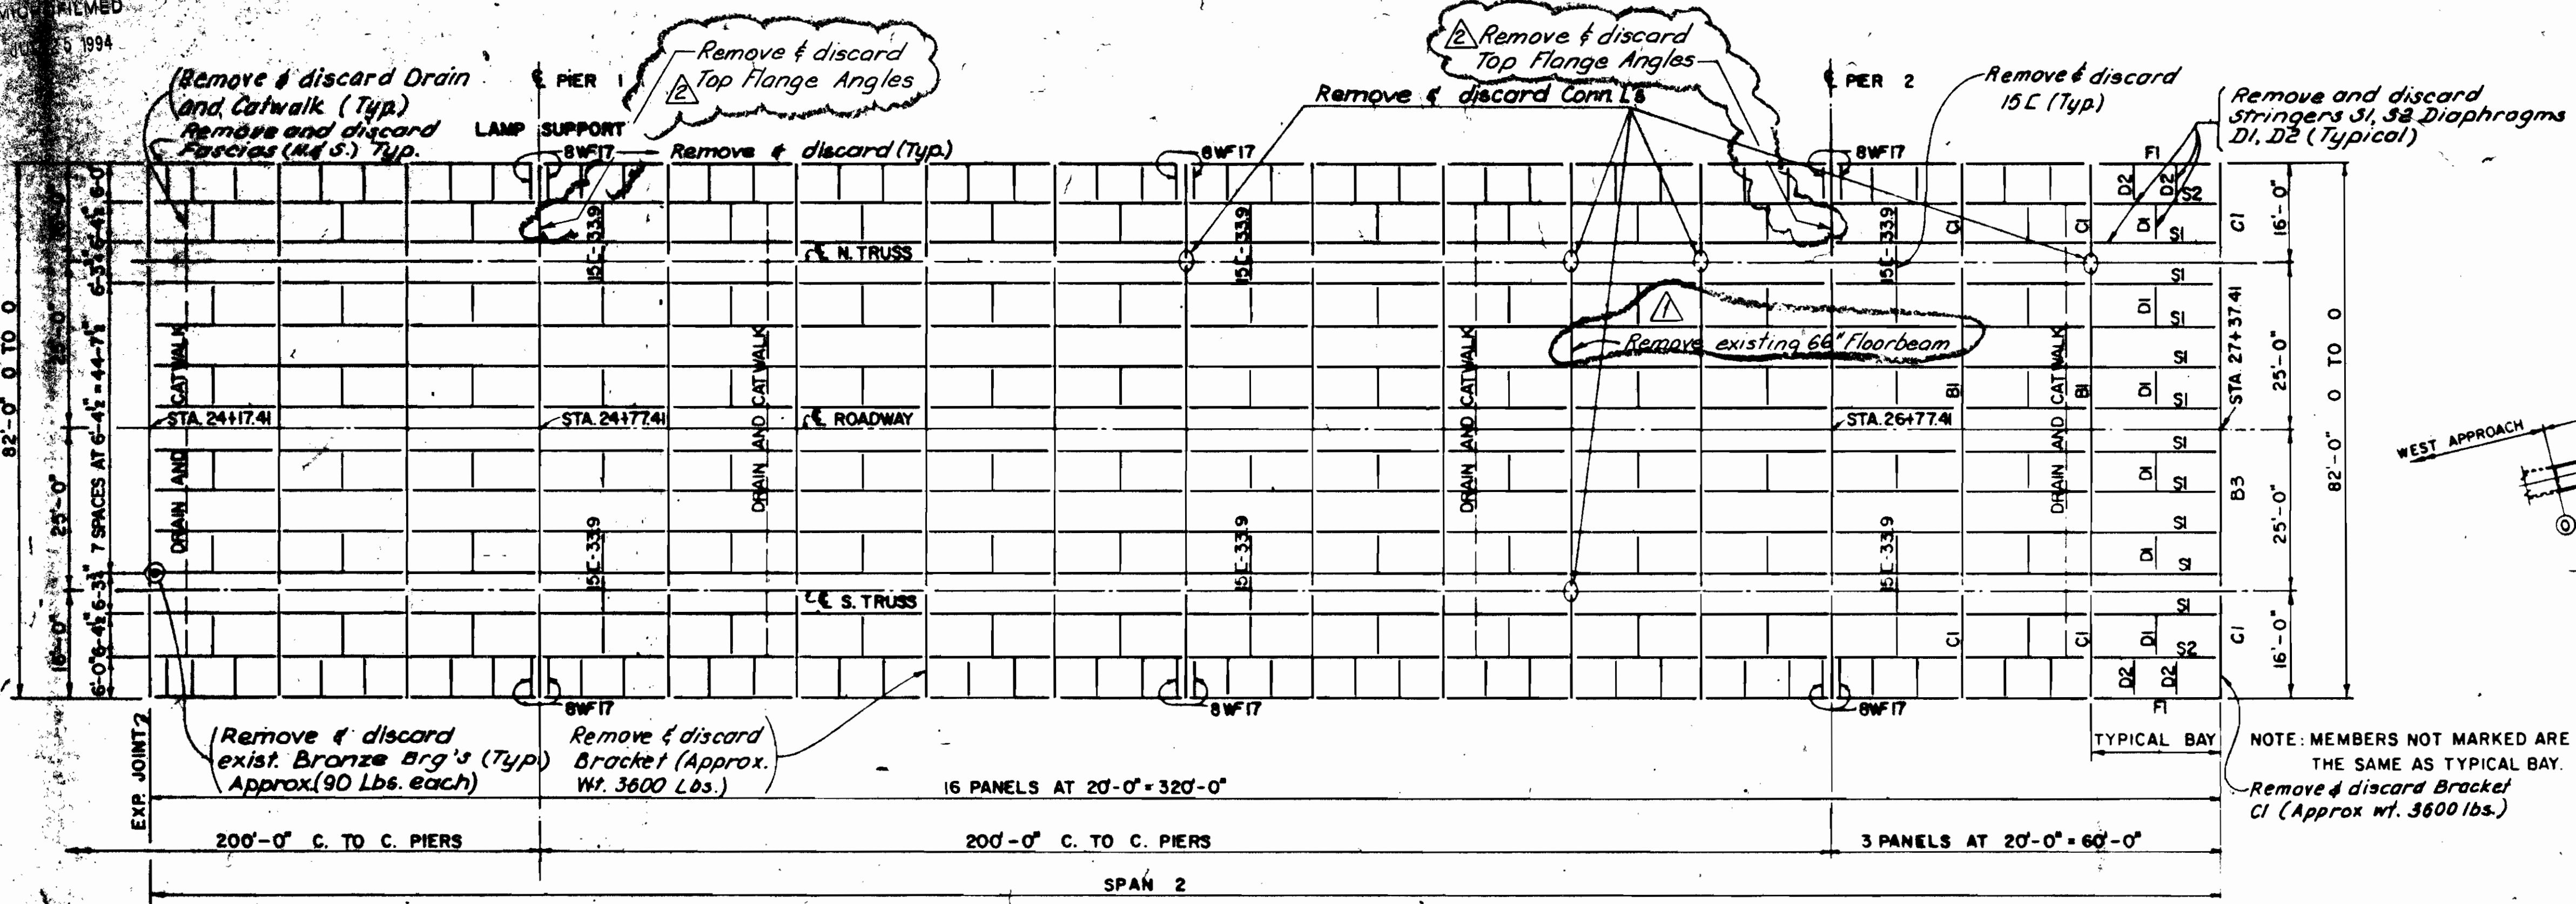

EXISTING FRAMING REMOVAL

MARK	DESIGNATION	TRUSS SPAN 2	
		QUANTITY	
S1	21W63	160	
S2	21W59	32	
D1	10W33	96	
D2	9C13.4	64	
F1	R 30 x 3/8	32	}
	2-L's 4 x 3 x 3/8	64	
-	8W17	12	Lamp Support
-	15C33.9	6	Diaphragm

EXISTING FRAMING PLAN

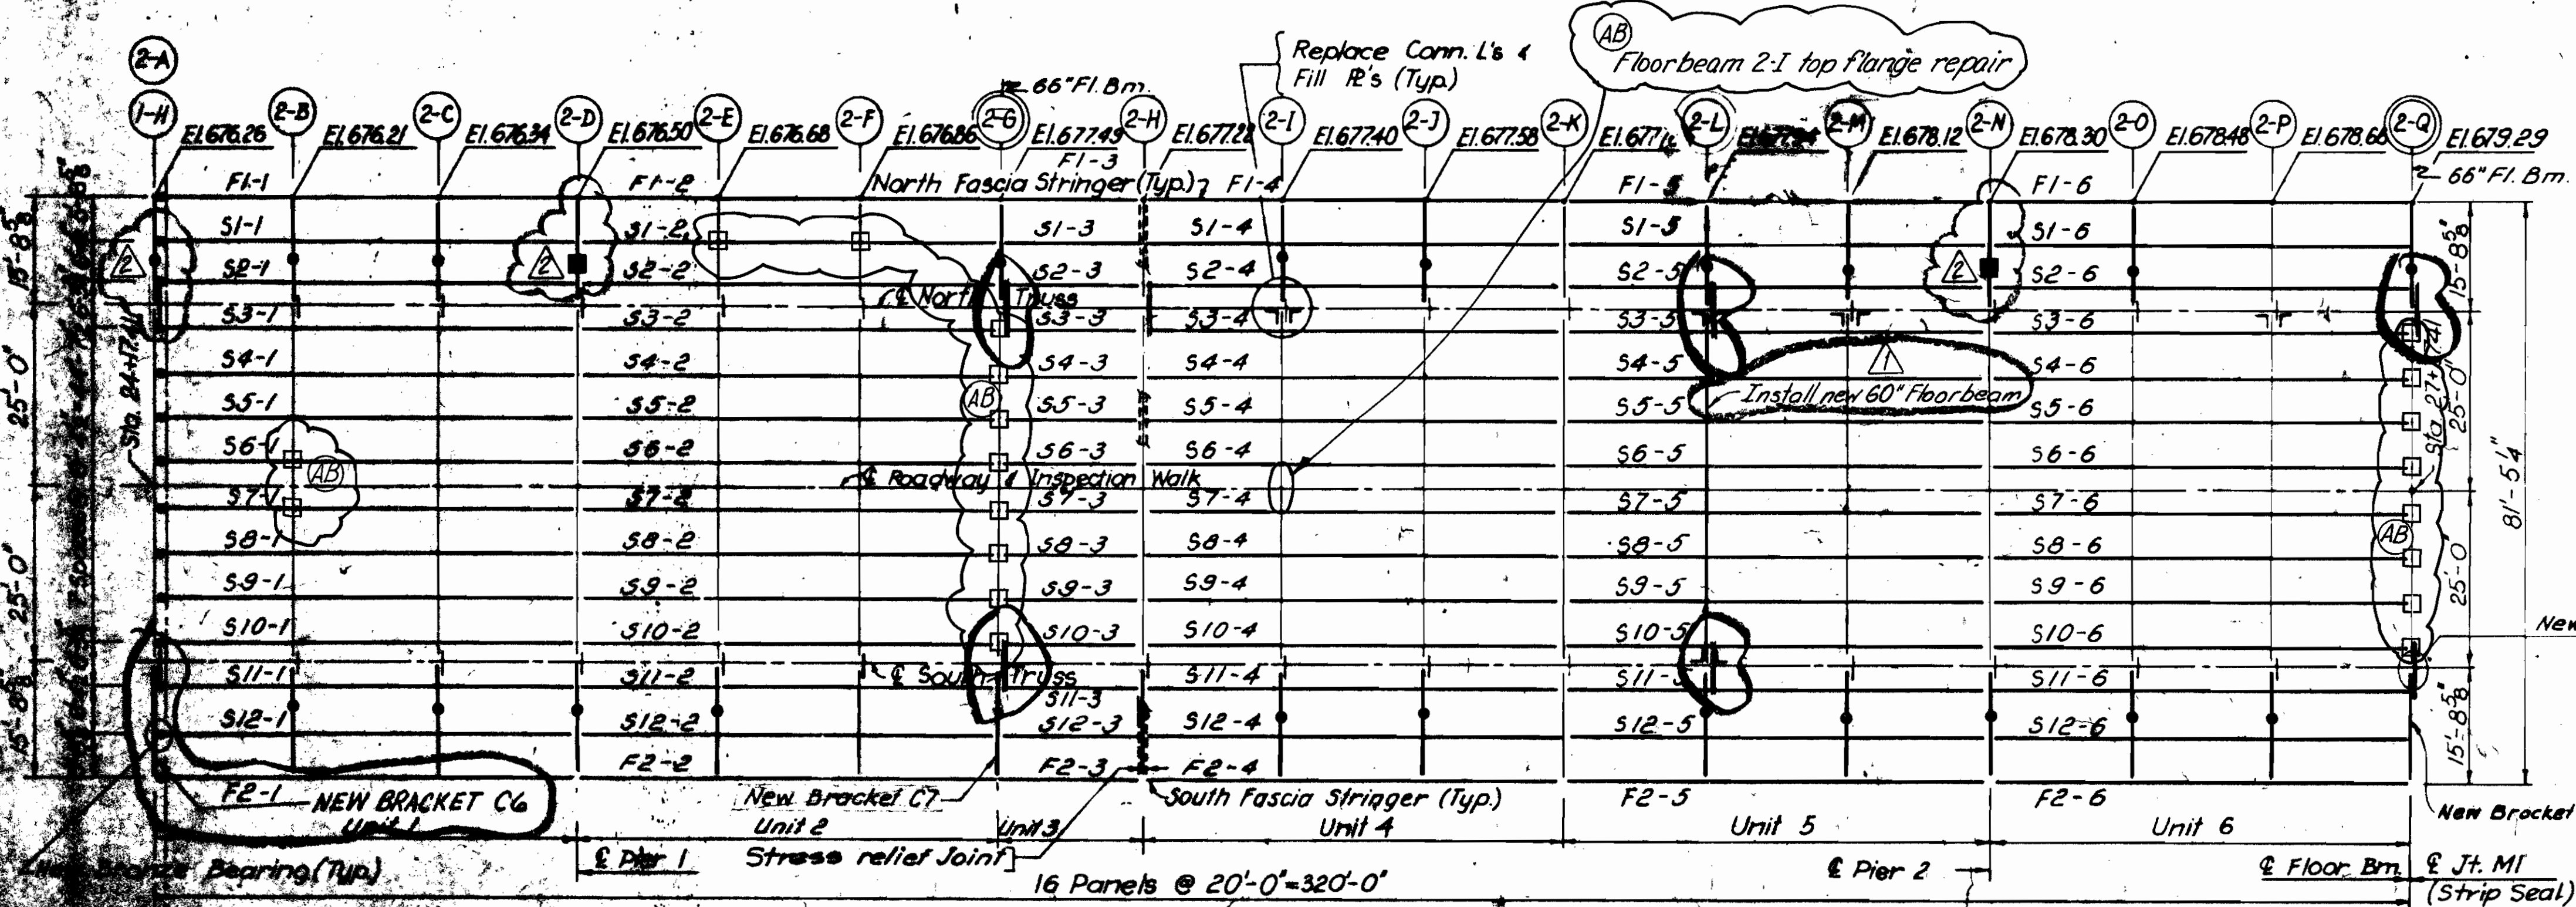

NOTES:

- All new Rolled Beams, Shapes and Plates shall be ASTM A56, AISC Category I.
- All new Welded Members including Fascia Stringers, replacement Floor Beams and brackets shall be ASTM A56, AISC Category III.

REFERENCES:

References & Notes

DWG. NO.

20

(AB) As Built

PAVLO ENGINEERING CO., P.C.  
NEW YORK, NEW YORK

CUYAHOGA COUNTY ENGINEER  
CLEVELAND OHIO

**MAIN AVENUE BRIDGE**  
CITY OF CLEVELAND  
BRIDGE OVER THE CUYAHOGA RIVER VALLEY  
MAIN TRUSS SPAN-2  
EXIST. & PROP. FRAMING

BRIDGE NO. 138

**NO. B-136**

DESIGN: [ ]  
CHECK: [ ]  
DATE: [ ]

AS BUILT 2/7/94

TRUSS SPAN 2-PROPOSED FRAMING PLAN

- Denotes Top Flange Angles Replacement
- Denotes Bracket Replacement
- Denotes existing framing member
- Denotes new or modified framing member
- Indicates elevation @ top of existing floor beam (Floor beam is horizontal)
- Denotes 66" deep Floor Beam (Typical floor beams are 60" deep)





For Brackets Type C1 to C5 See 'Existing Framing Plan' above

NOTE:  
ELEVATIONS AT 66" FLOORBEAMS ARE AT TOP OF FLANGE ANGLES.

Rev. 2	Plan Revisions	9/2/91
REV. 1	PLAN REVISIONS	1-11-91

MICROFILMED  
JUL 25 1984

FHWA REGION	STATE	PROJECT	E.I.
5	OHIO	BHF-73(51)	547
CUYAHOGA COUNTY CUY-2-14.66			

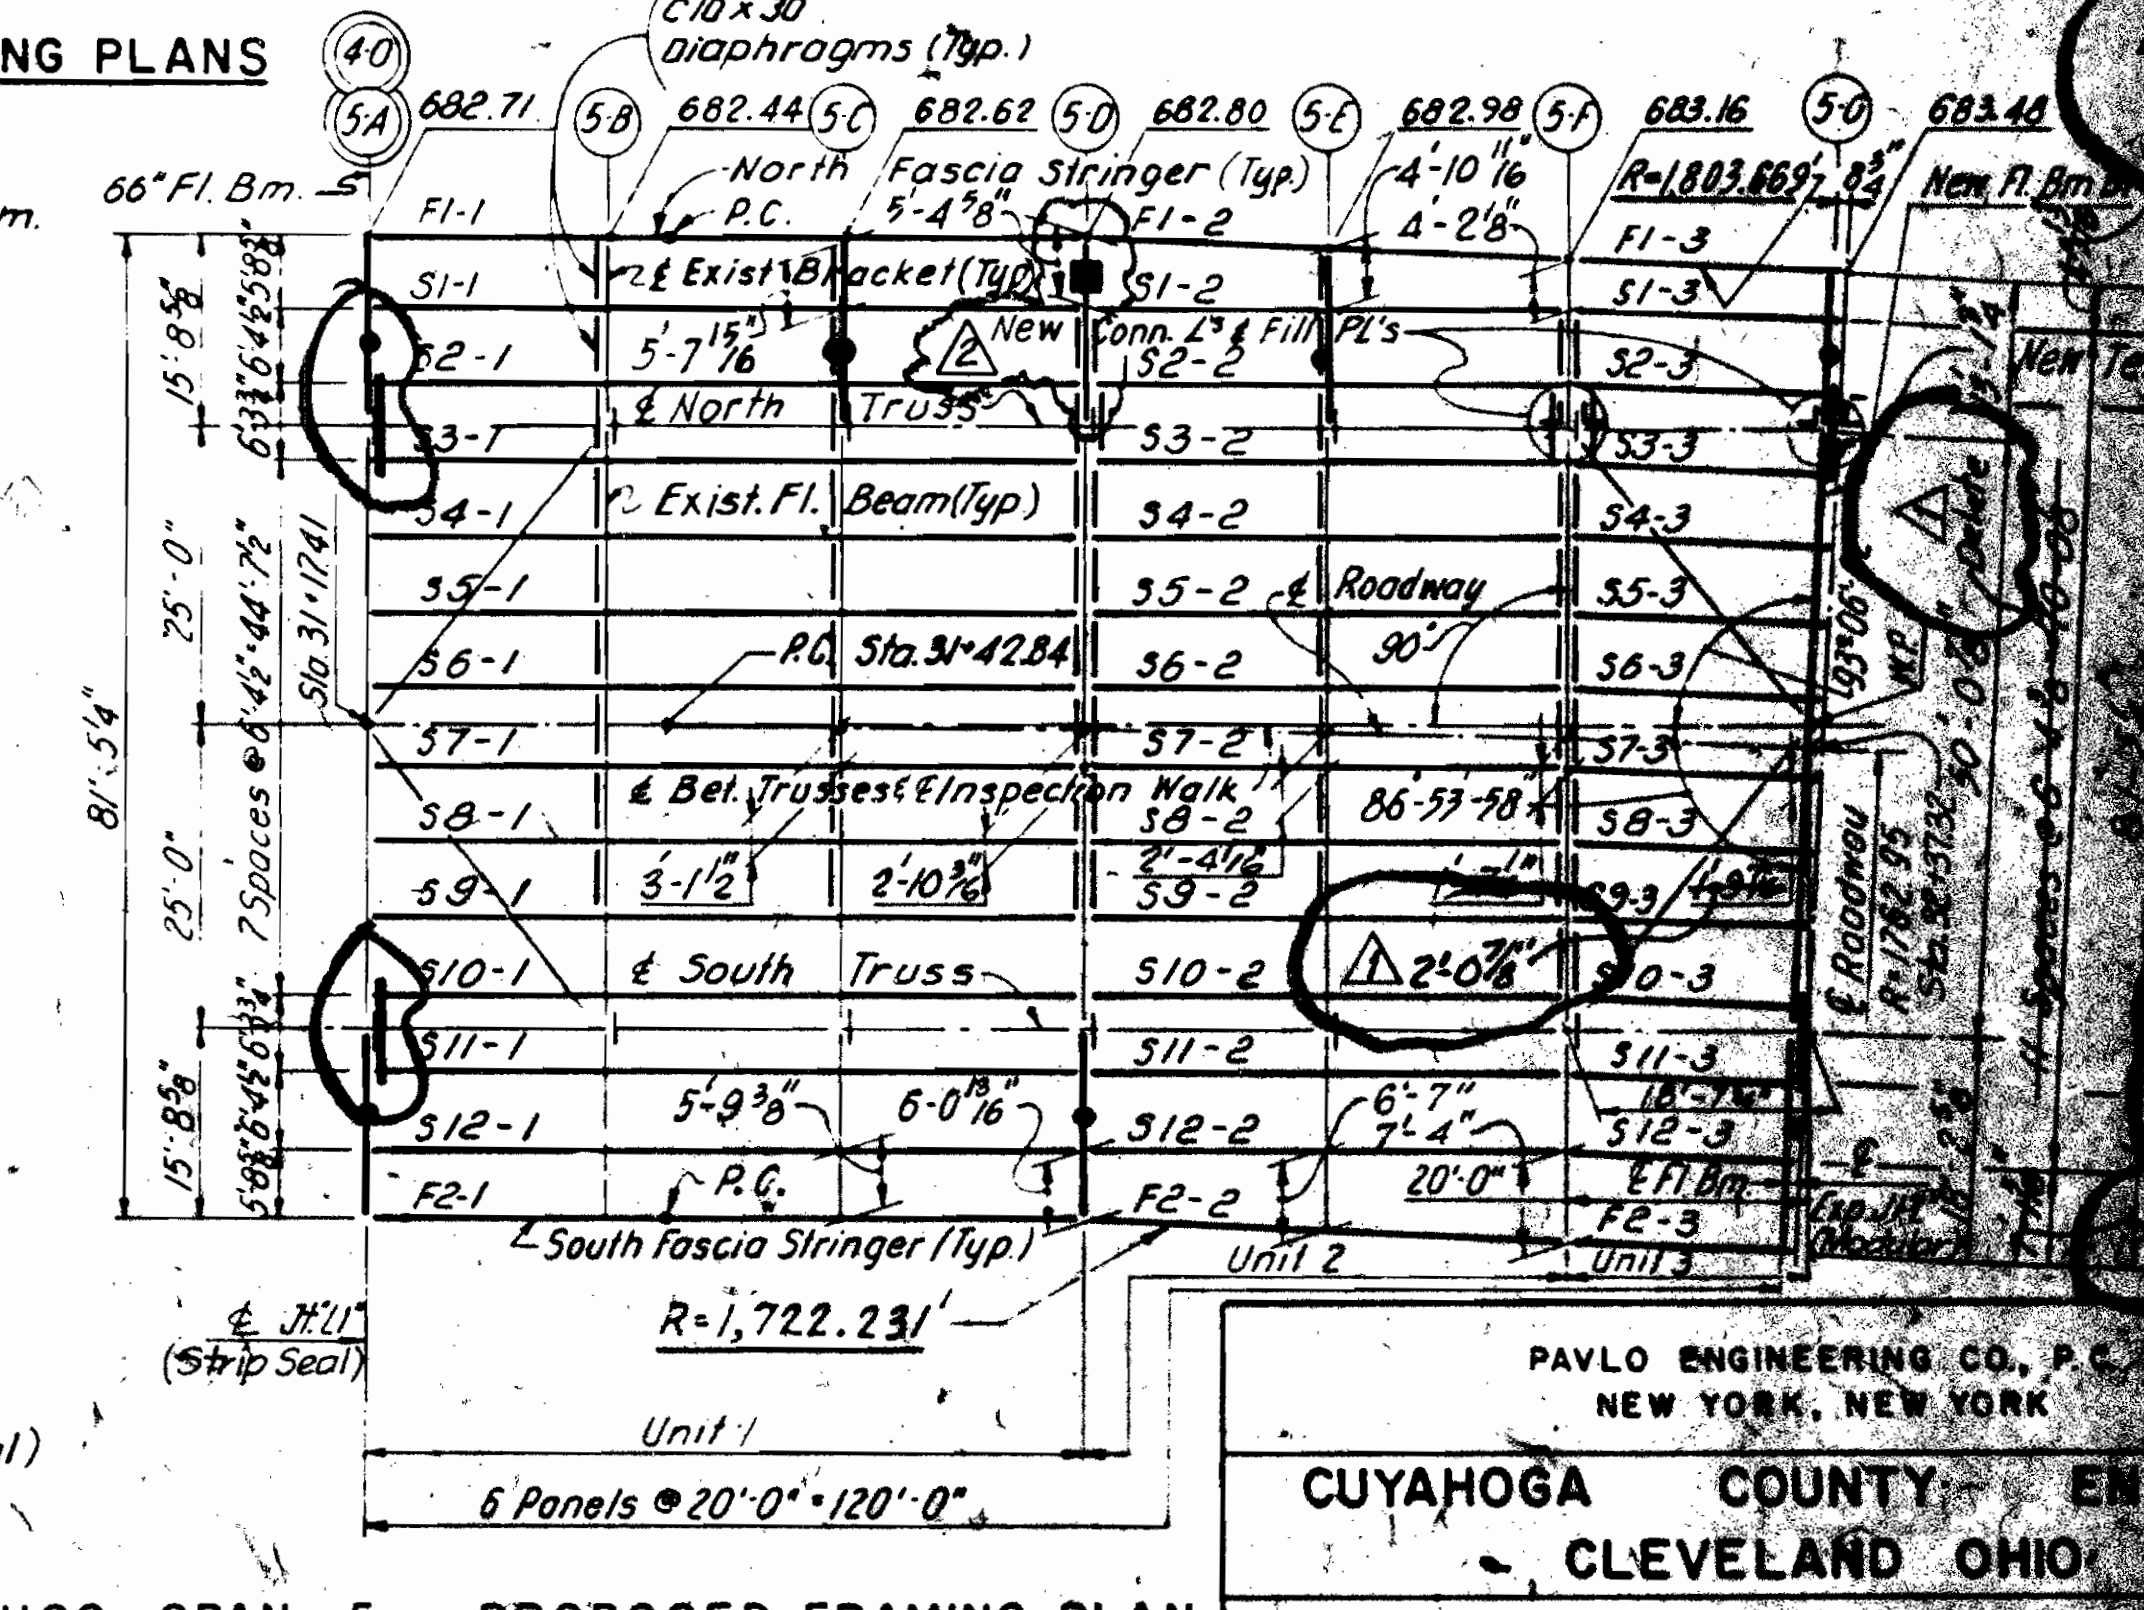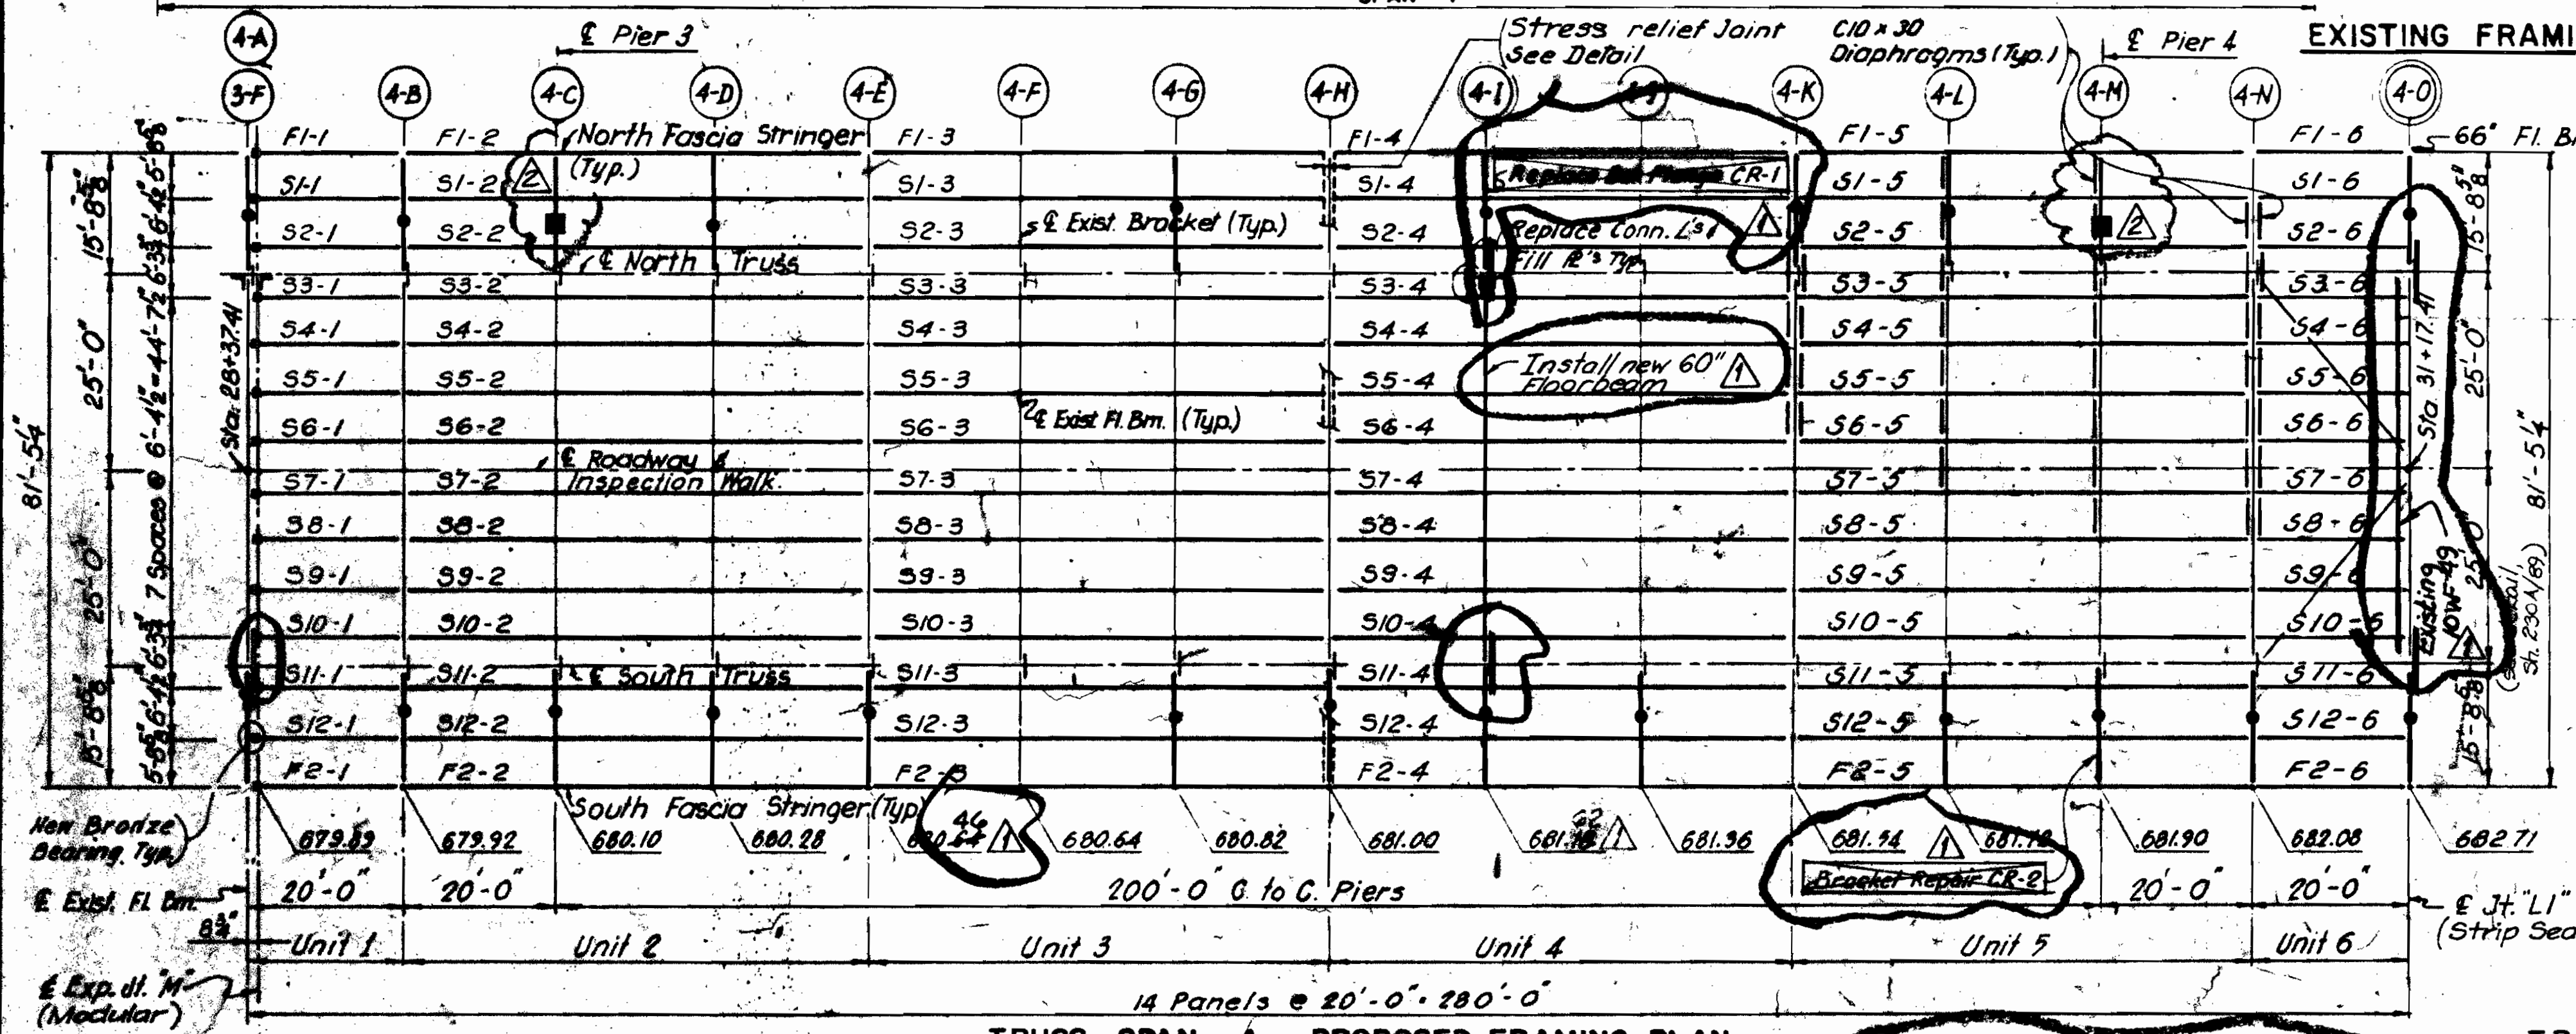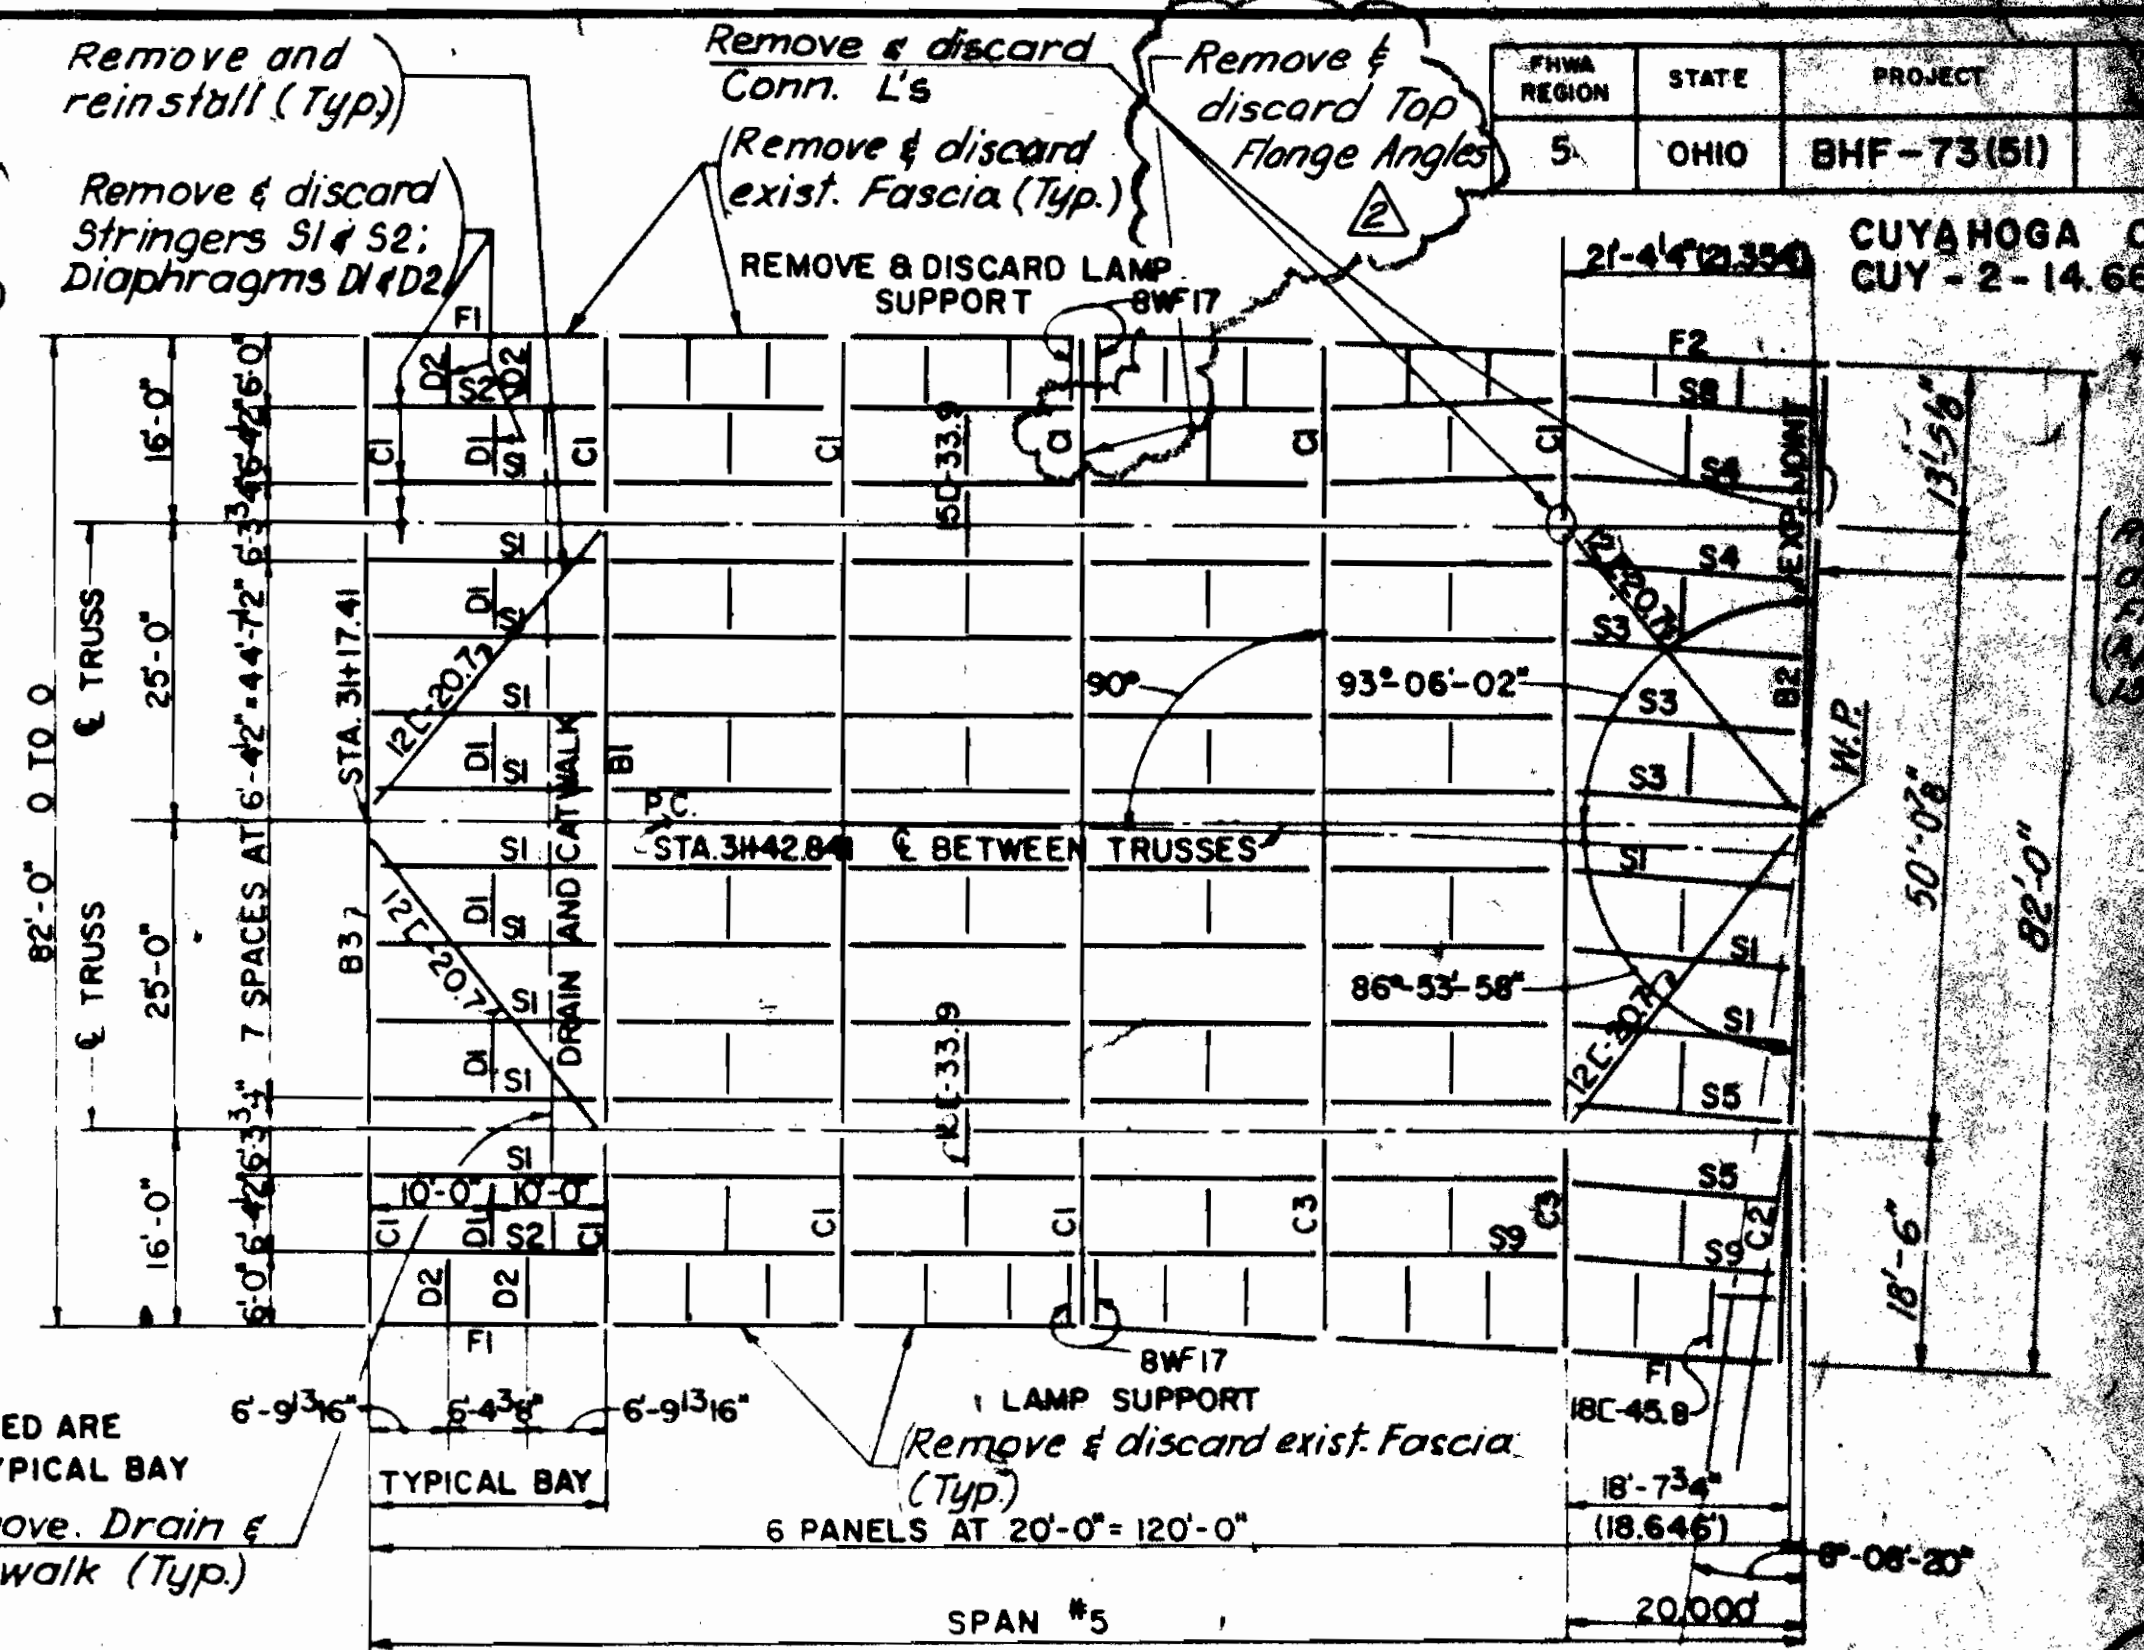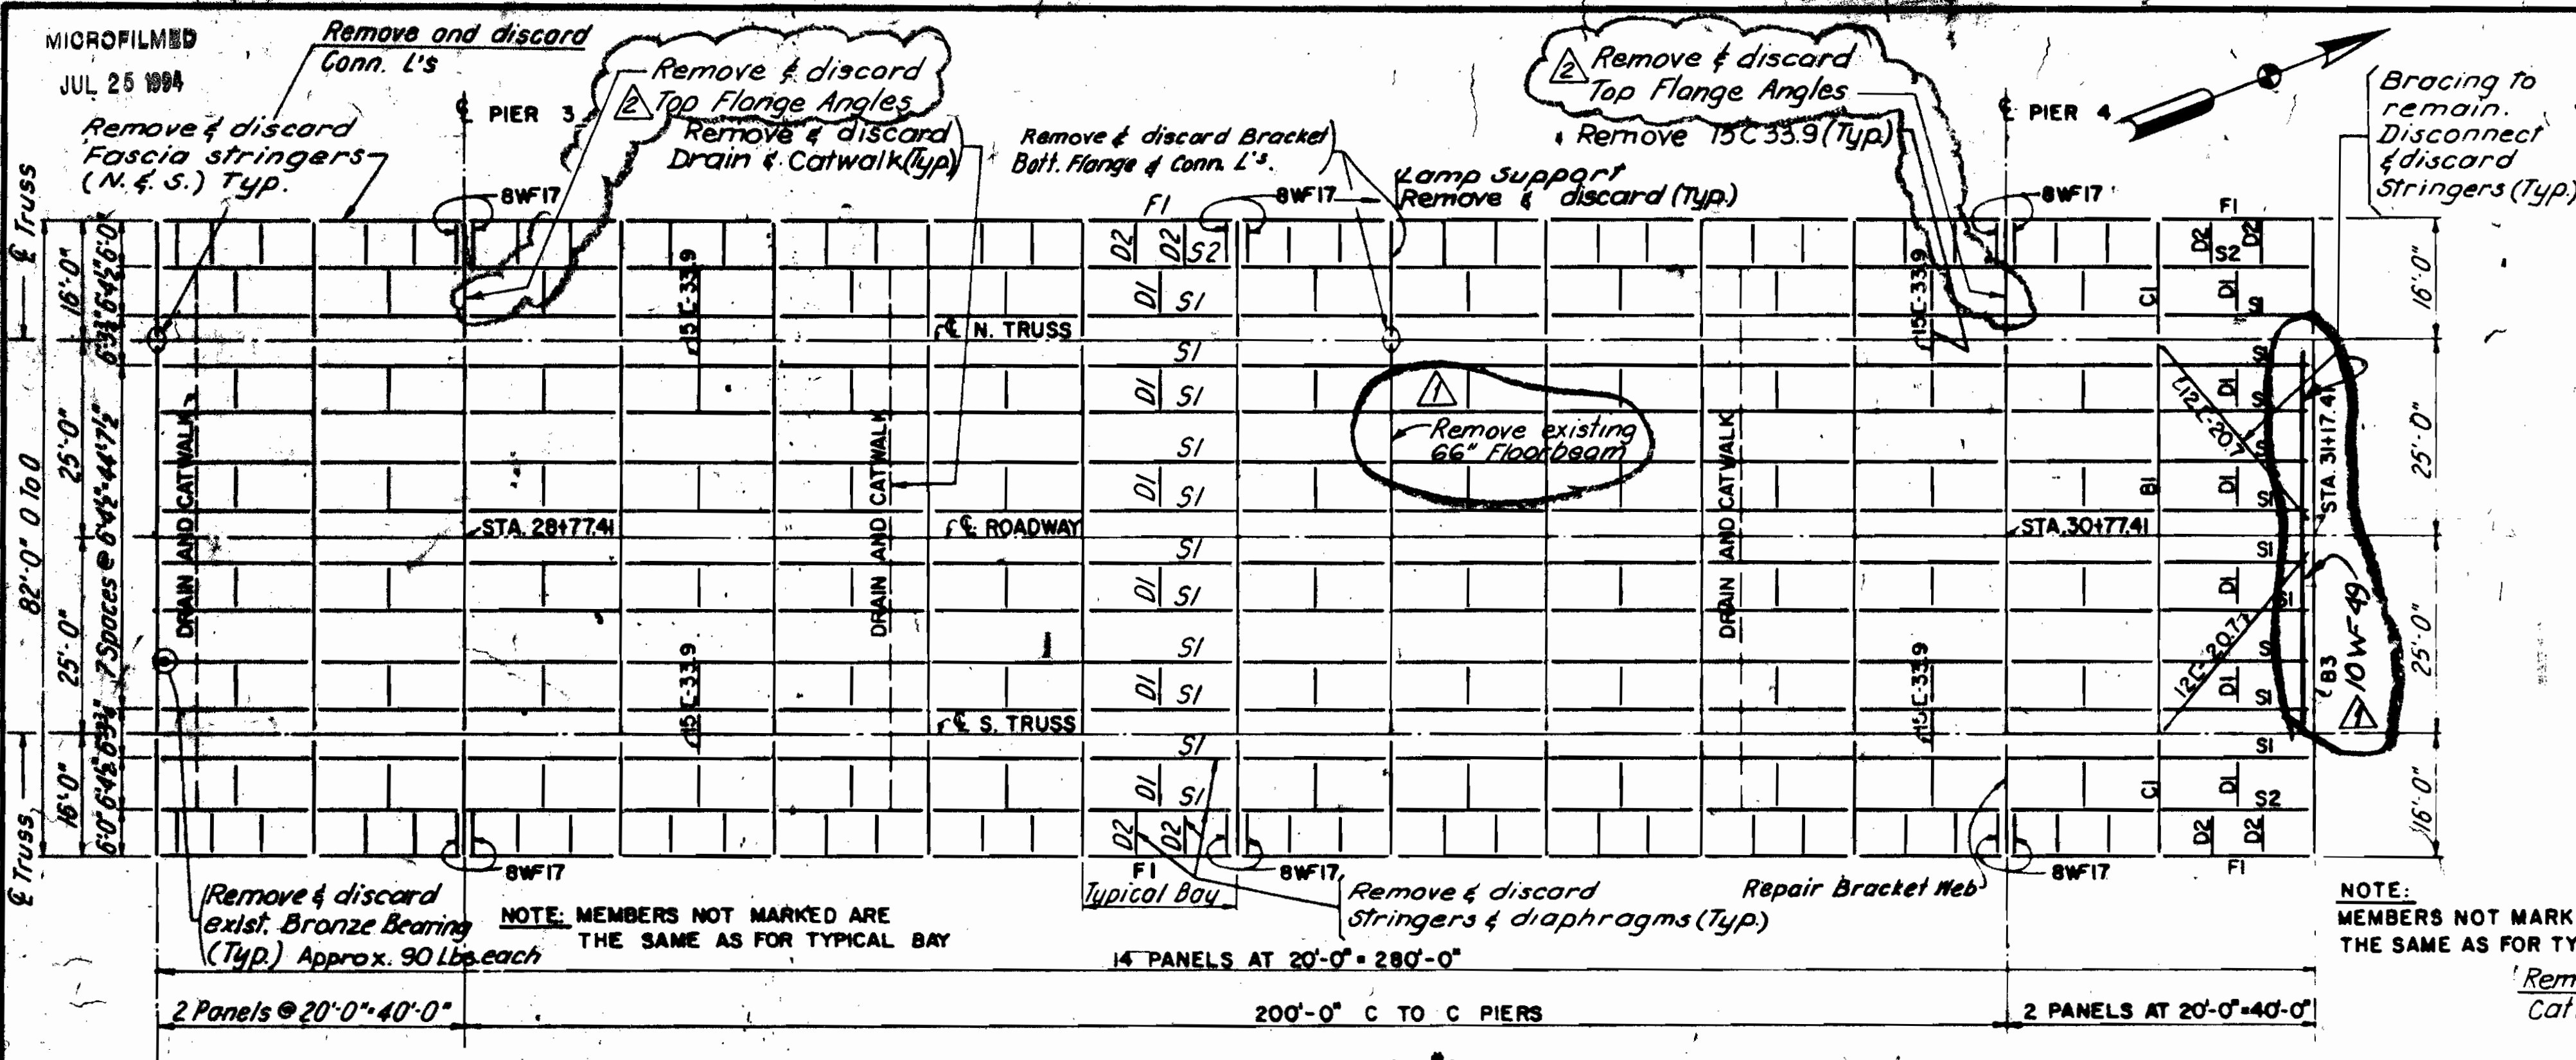

MARK	DESIGNATION	TRUSS SPAN 4 QUANT.	TRUSS SPAN 5 QUANT.	REMARKS
S1	21W63	140	53	
S2	21W59	28	14	Span 5 Start
S3	21W68	-	3	
S4	21W73	-	2	
D1	10W33	84	36	
D2	9C134	56	24	
F1	R 30 x 3/4	28	12	
	2 x 4 x 3/4	56	24	
	15C33.9	4	2	Lamp Support Diaphragms

TRUSS SPAN 4 - PROPOSED FRAMING PLAN

TRUSS SPAN 5 - PROPOSED FRAMING PLAN

- Denotes existing framing member
- Denotes new or modified framing member
- Indicates elevation at top of exist floor beam (Floor beam is horizontal)
- Denotes 66" deep floor beam (Typical Floor beam is 60" deep)
- Denotes Bracket Replacement
- Denotes Top Flange Angles Replacement

NOTE: ELEVATIONS AT 66" FLOORBEAMS ARE AT TOP OF FLANGE ANGLES.

- NOTES:
- All new Rolled Beams, Shapes and Plates shall be ASTM A36, AISC Category I
  - All new welded Members including Fascia Stringers, replacement Floor Beams and Brackets shall be ASTM A36; AISC Category III

REFERENCES:

References and Notes Intermediate Diaphragms

DWG. NO.

210  
233

Rev. 2

Plan Revisions

3/13/91

KEY

Plan Revisions

2/11/91

PAVLO ENGINEERING CO., P.C.  
NEW YORK, NEW YORK


CUYAHOGA COUNTY ENGINEER  
CLEVELAND OHIO

**MAIN AVENUE BRIDGE**  
CITY OF CLEVELAND  
BRIDGE OVER THE CUYAHOGA RIVER VALLEY  
MAIN TRUSS SPAN 4 AND 5  
EXIST. & PROP. FRAMING PLAN

BRIDGE NO. 133 REPORT NO. 210



**NO. B-136**

DESIGNER: AS DRAWN: JPN CHECKED: [Signature] AS BUILT: 2/94

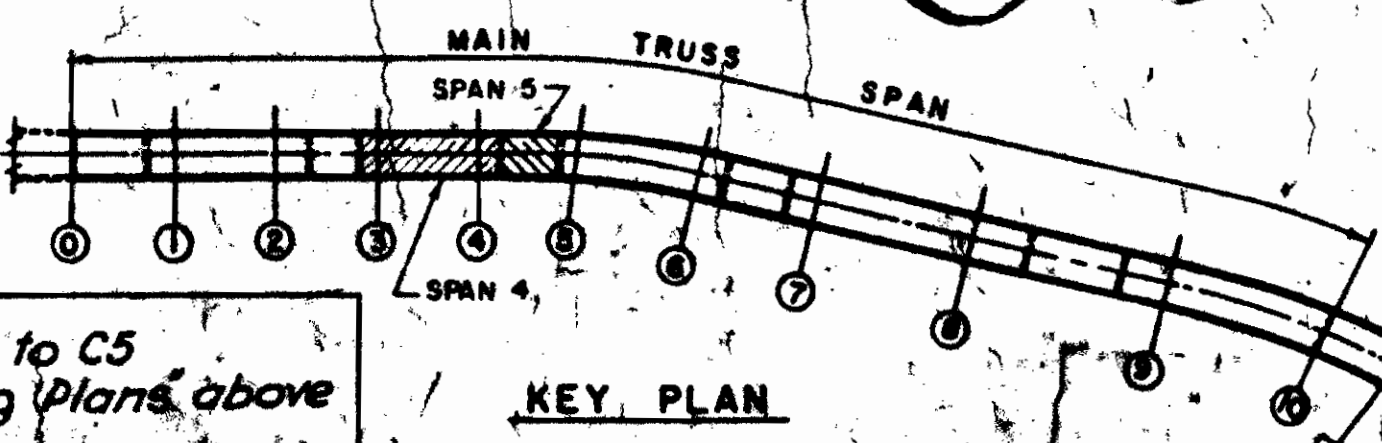

For Brackets Type C1 to C5 See Existing Framing Plans above


NOTE: MEMBERS NOT MARKED ARE THE SAME AS TYPICAL BAY.

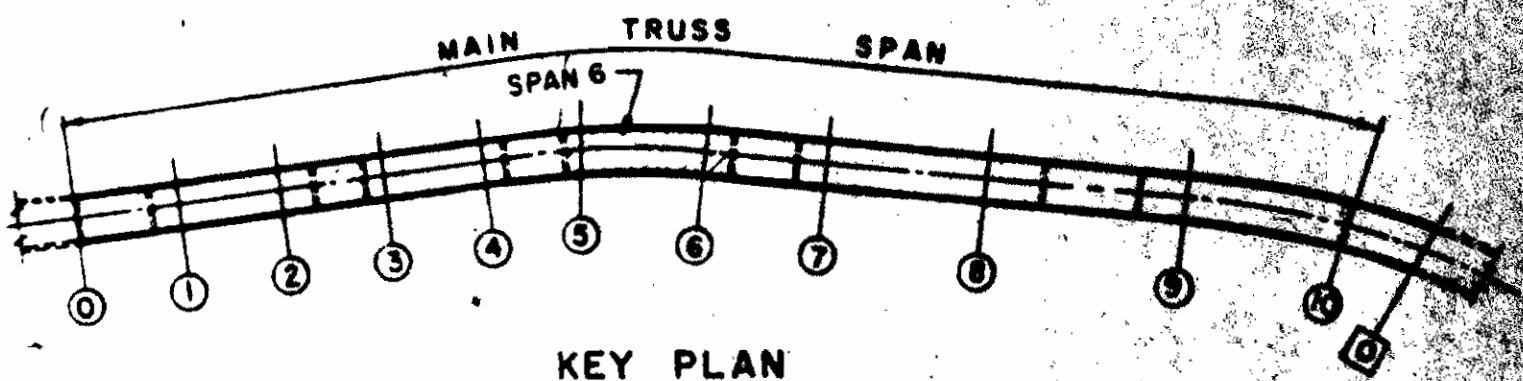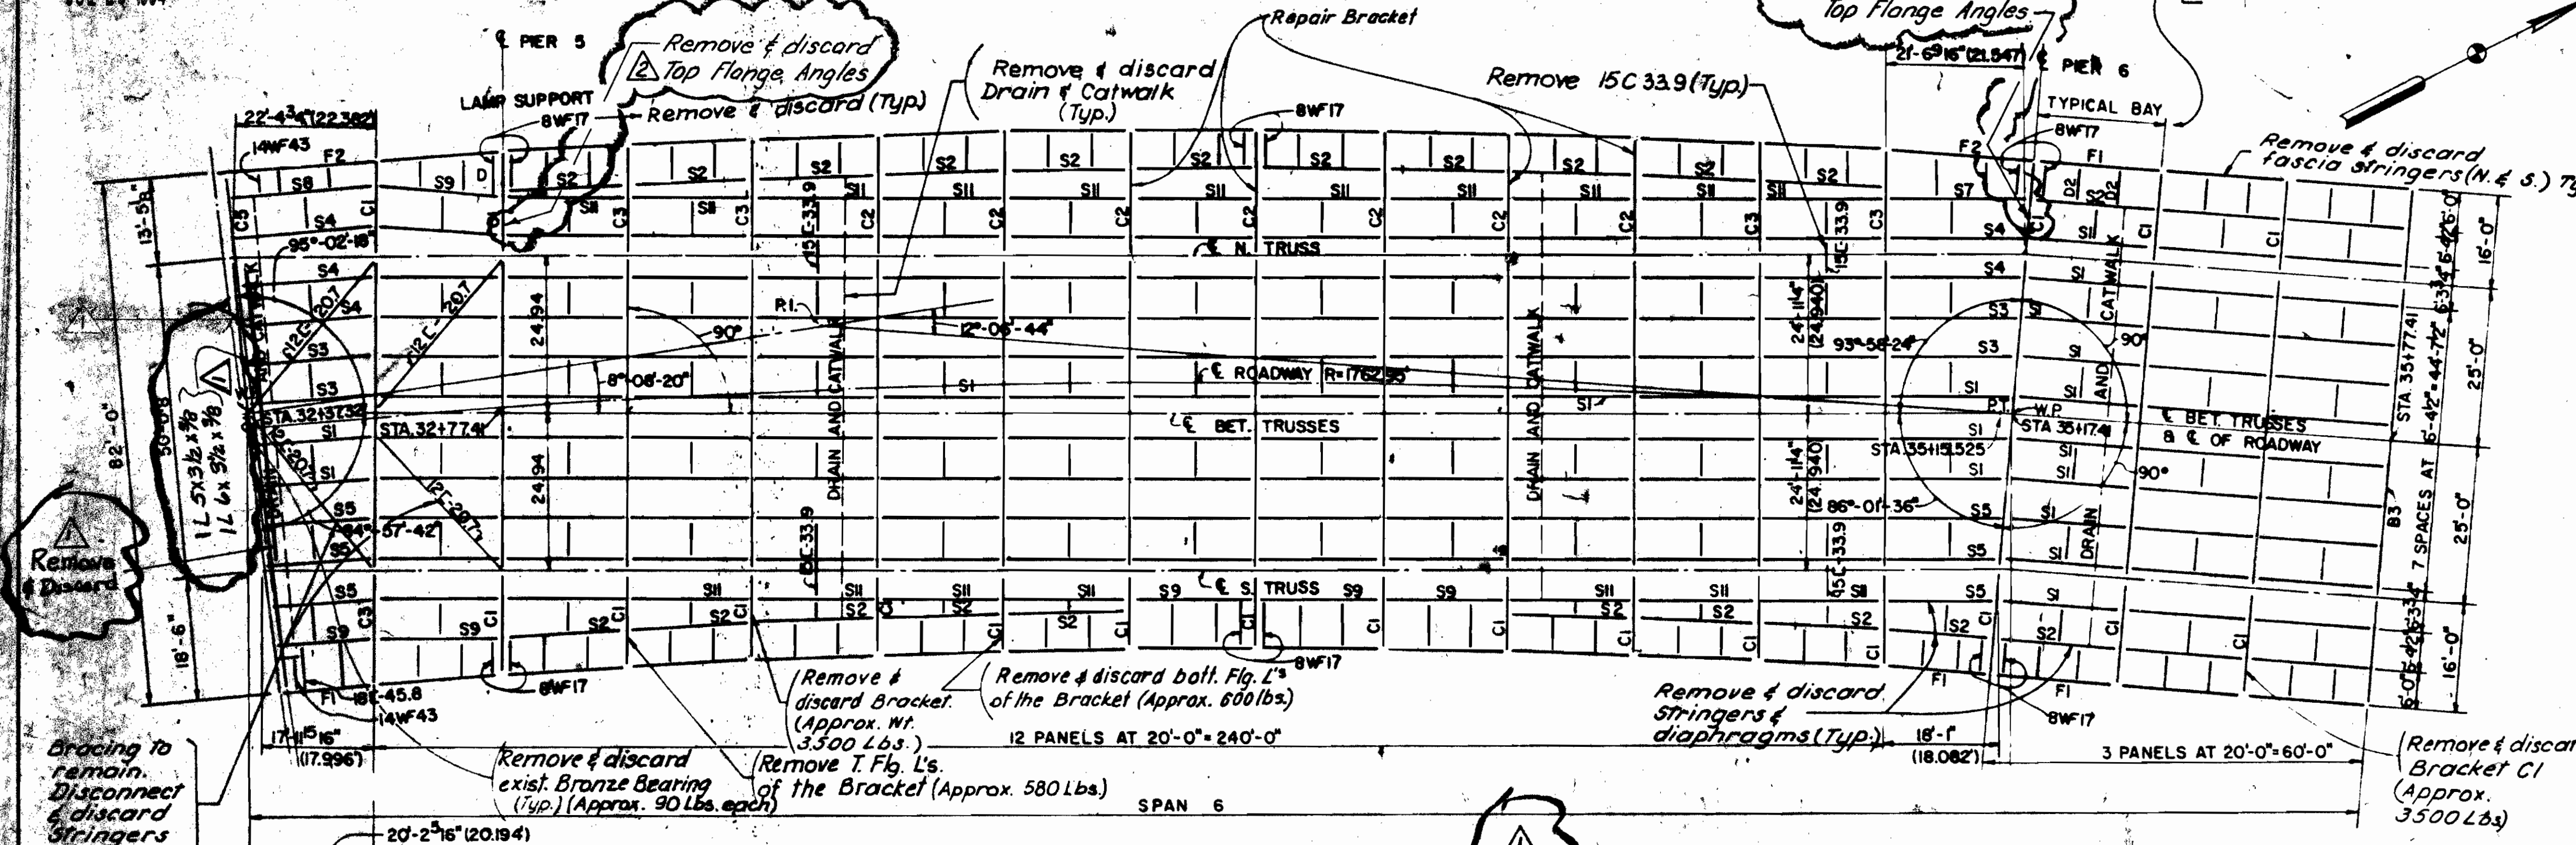

EXISTING FRAMING REMOVAL

MARK	DESIGNATION	TRUSS SPAN 6 QUANT.	REMARKS
S1	2IWB63	144	
S2 & S5 to S9 & S11	2IWB59	59	
S3	2IWB68	4	
S4	2IWB73	5	
D1	10WB33	99	
D2	9C13A	68	
F1	R 30 x 3/8	34	
	2-L's 4 x 3 x 3/8	68	
-	8W17	12	Lamp Support
-	15C 33.9	4	Diaphragms

EXISTING FRAMING PLAN 5.40

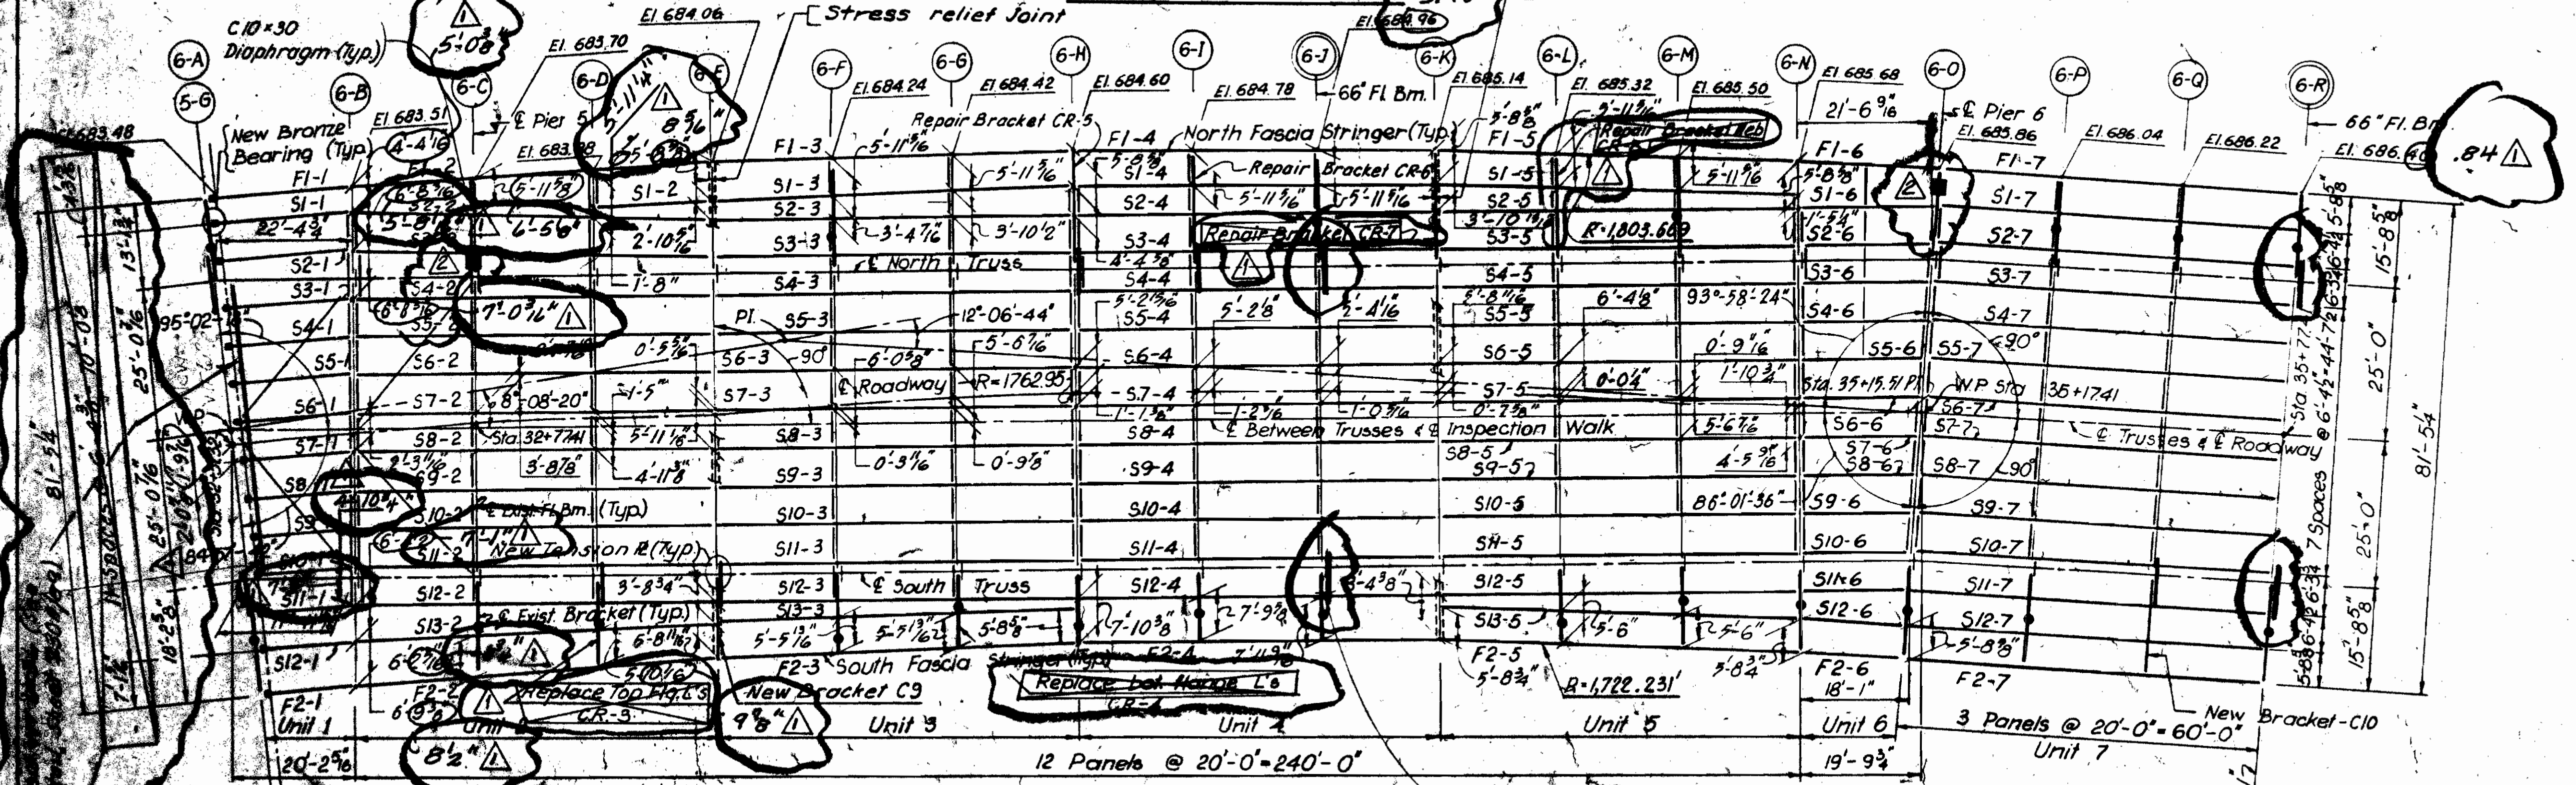

TRUSS SPAN 6 - PROPOSED FRAMING PLAN

For Brackets Type C1 to C5  
See "Existing Framing Plan" above.

Denote Top Flange  
Angles Replacement

- Denotes existing framing member
- Denotes new or modified framing member
- Indicates elevation at top of exist floor beam (Floor beam is horizontal)
- Denotes 66" deep floor beam (Typical floor beams are 60" deep)
- Denotes Bracket Replacement

Note  
Elevations at 66" floor beams  
are at top of flange angles

REFERENCES:

References & Notes  
Intermediate Diaphragms

NOTES:

All new Rolled Beams, Shapes and Plates shall be ASTM A36, AISC Category I

All new Welded Members including Fascia Stringers, Replacement Floor Beams and Brackets shall be ASTM A36, AISC Category I

PAVLO ENGINEERING CO., P.E.  
NEW YORK, NEW YORK

CUYAHOGA COUNTY ENGINEER  
CLEVELAND OHIO

MAIN AVENUE BRIDGE  
CITY OF CLEVELAND

BRIDGE OVER THE CUYAHOGA RIVER

MAIN TRUSS SPAN 6  
EXIST. & PROP. FRAMING

BRIDGE NO. 136

NO. B-136

DESIGN	DRAWN	CHECKED	DATE
REV. 2	Plan Revisions		7/23/91
REV. 1	Plan Revisions		2/11/91



AS BUILT 2/94



FYMA REGION	STATE	PROJECT
5	OHIO	BHP-73(5)



CUYAHOGA COUNTY  
CUY - 2 - 14.66

Remove & discard Bracket (Wt. Approx. 3,600 Lbs.)

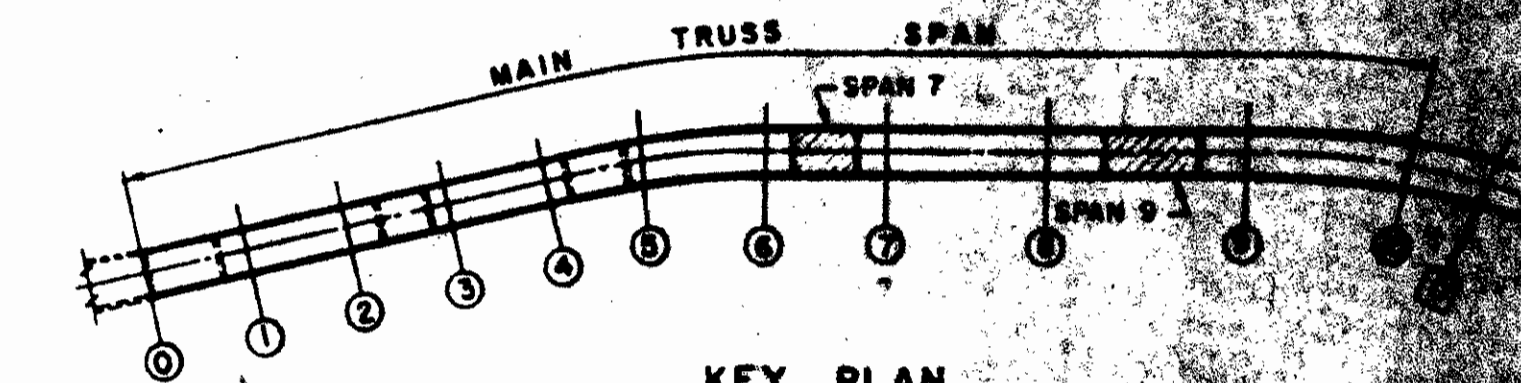
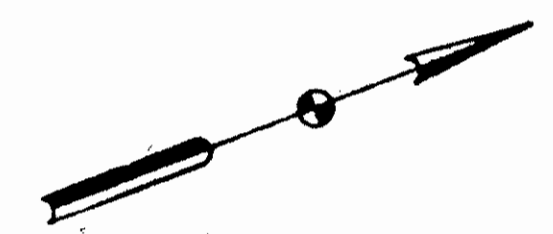


EXISTING FRAMING REMOVAL

MARK	DESIGNATION	TRUSS SPAN #7		TRUSS SPAN #9		REMARKS
		QUANT.	QUANT.	QUANT.	QUANT.	
S1	21W63	60		80		
S2	21W59	12		16		
D1	10W33	36		48		
D2	9C134	24		32		
F1	R 30x3	12		16		
	2-L's 4x3x3	24		32		
-	8W17	4		4		Lamp Support
-	15C33.9	2		2		Diaphragm

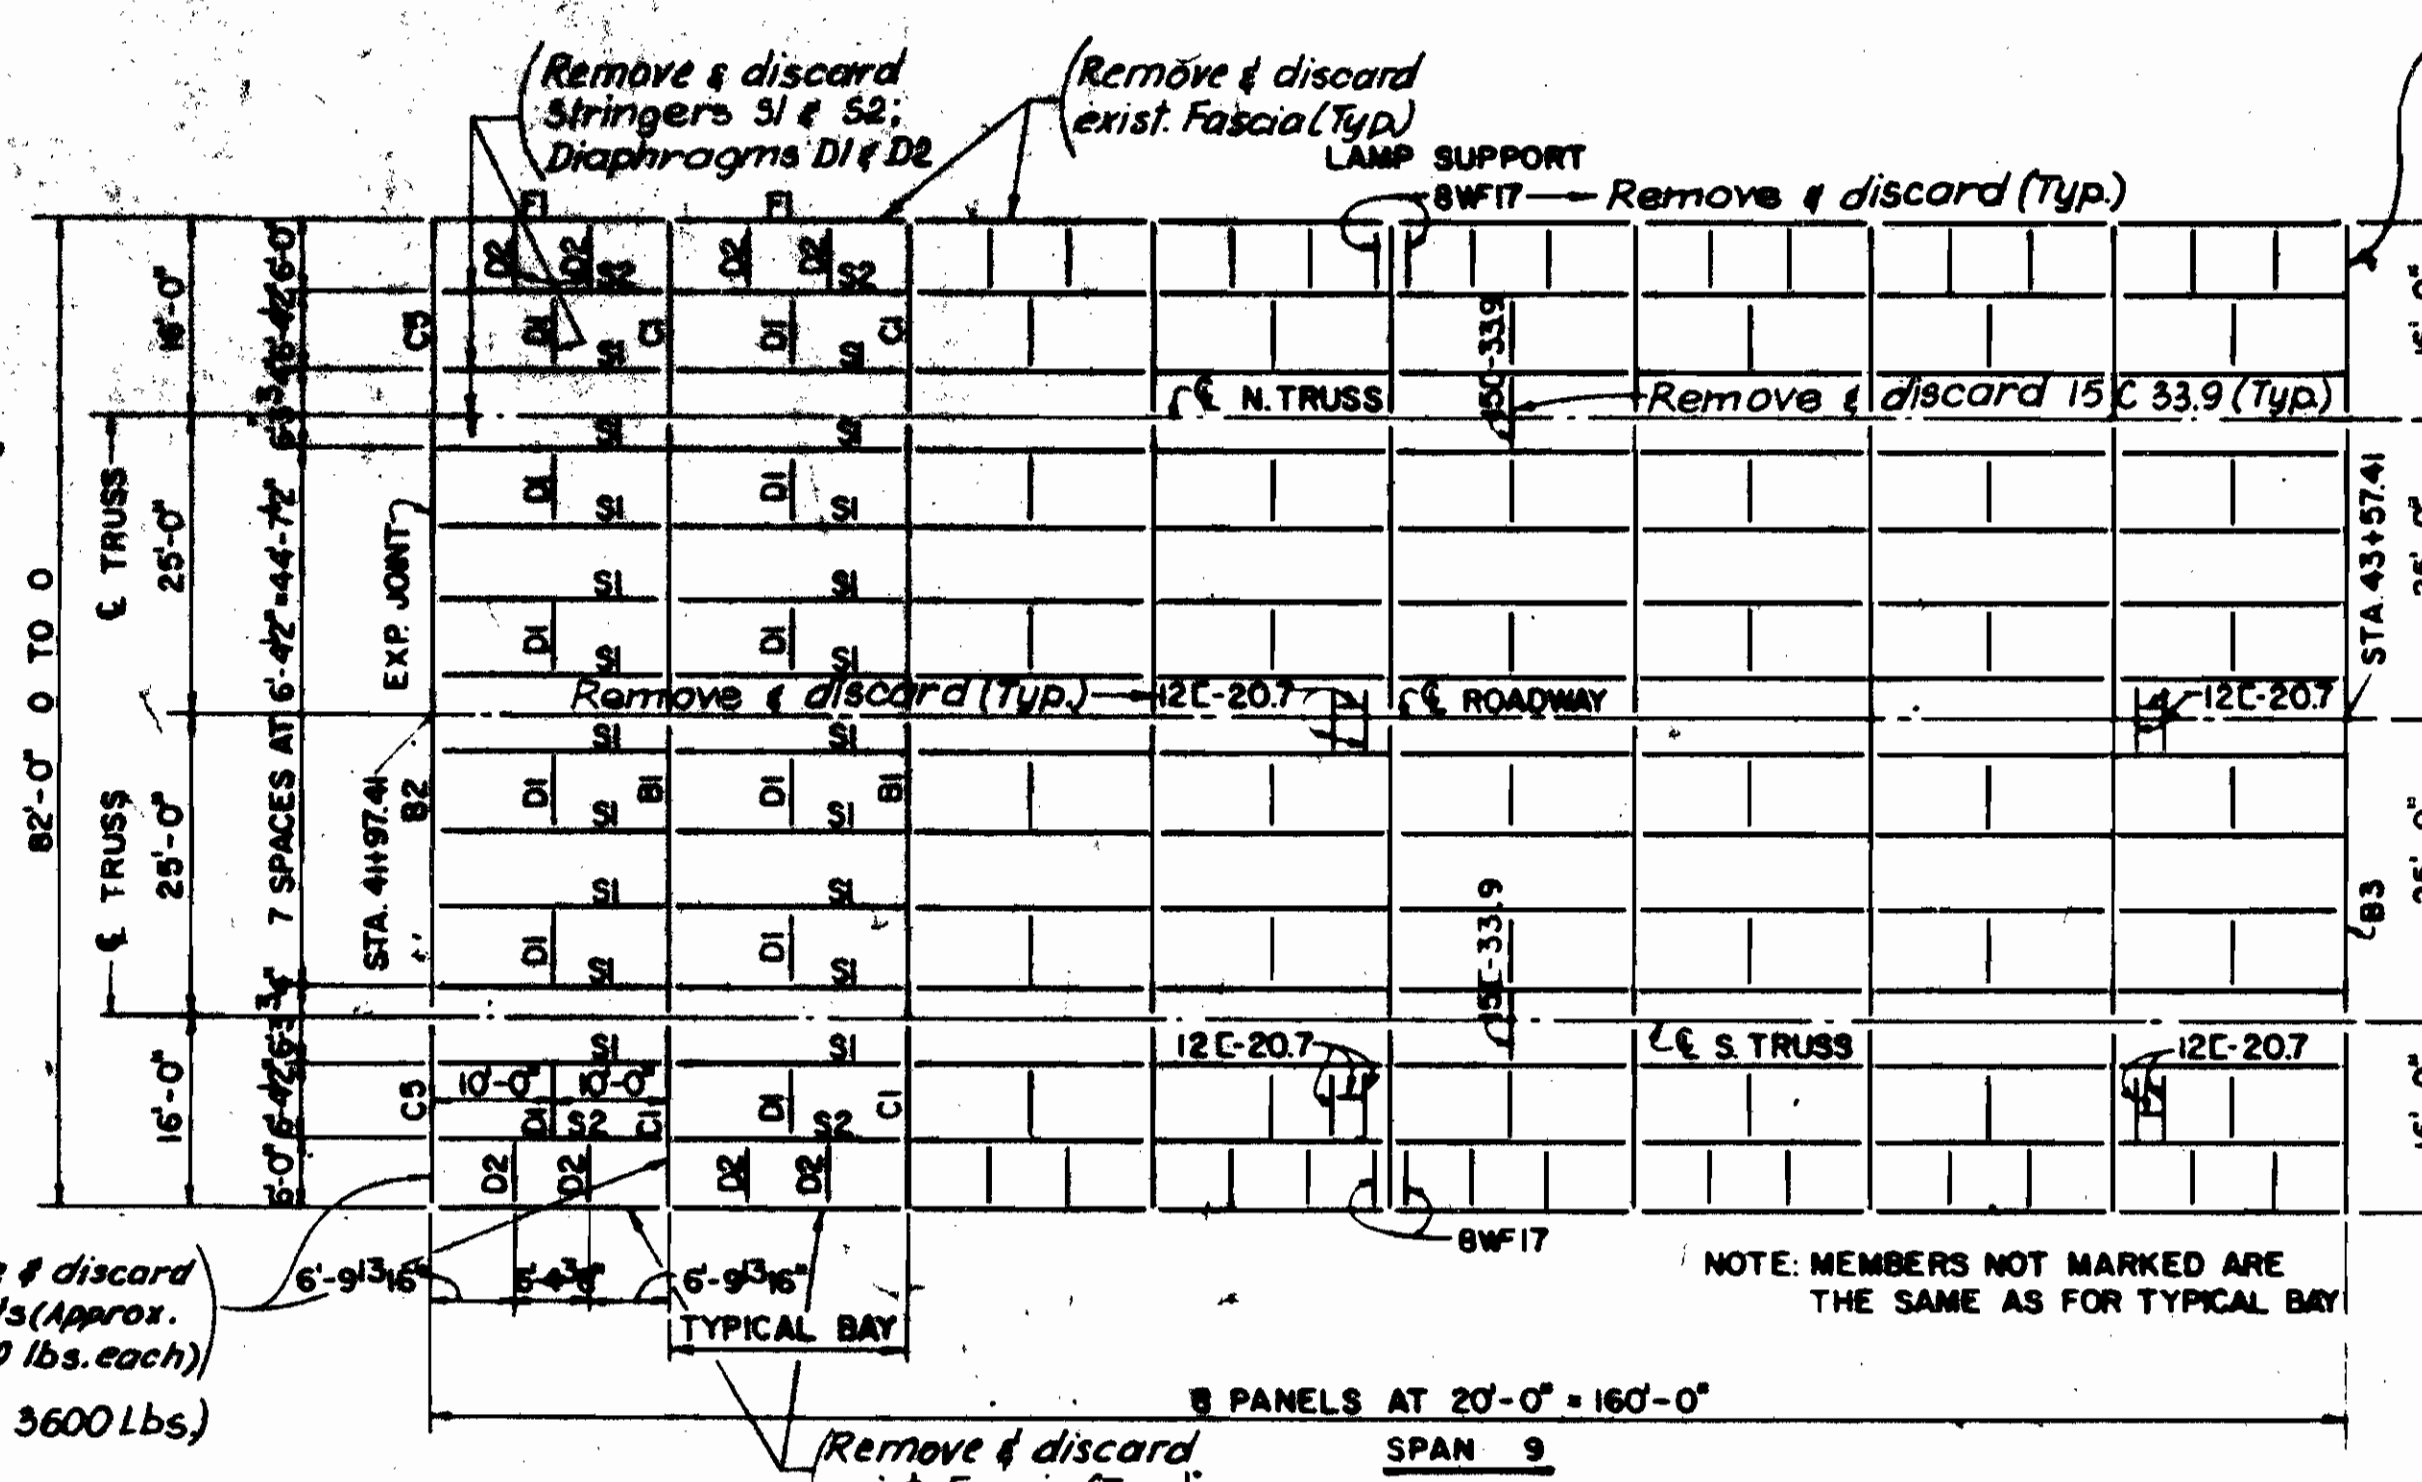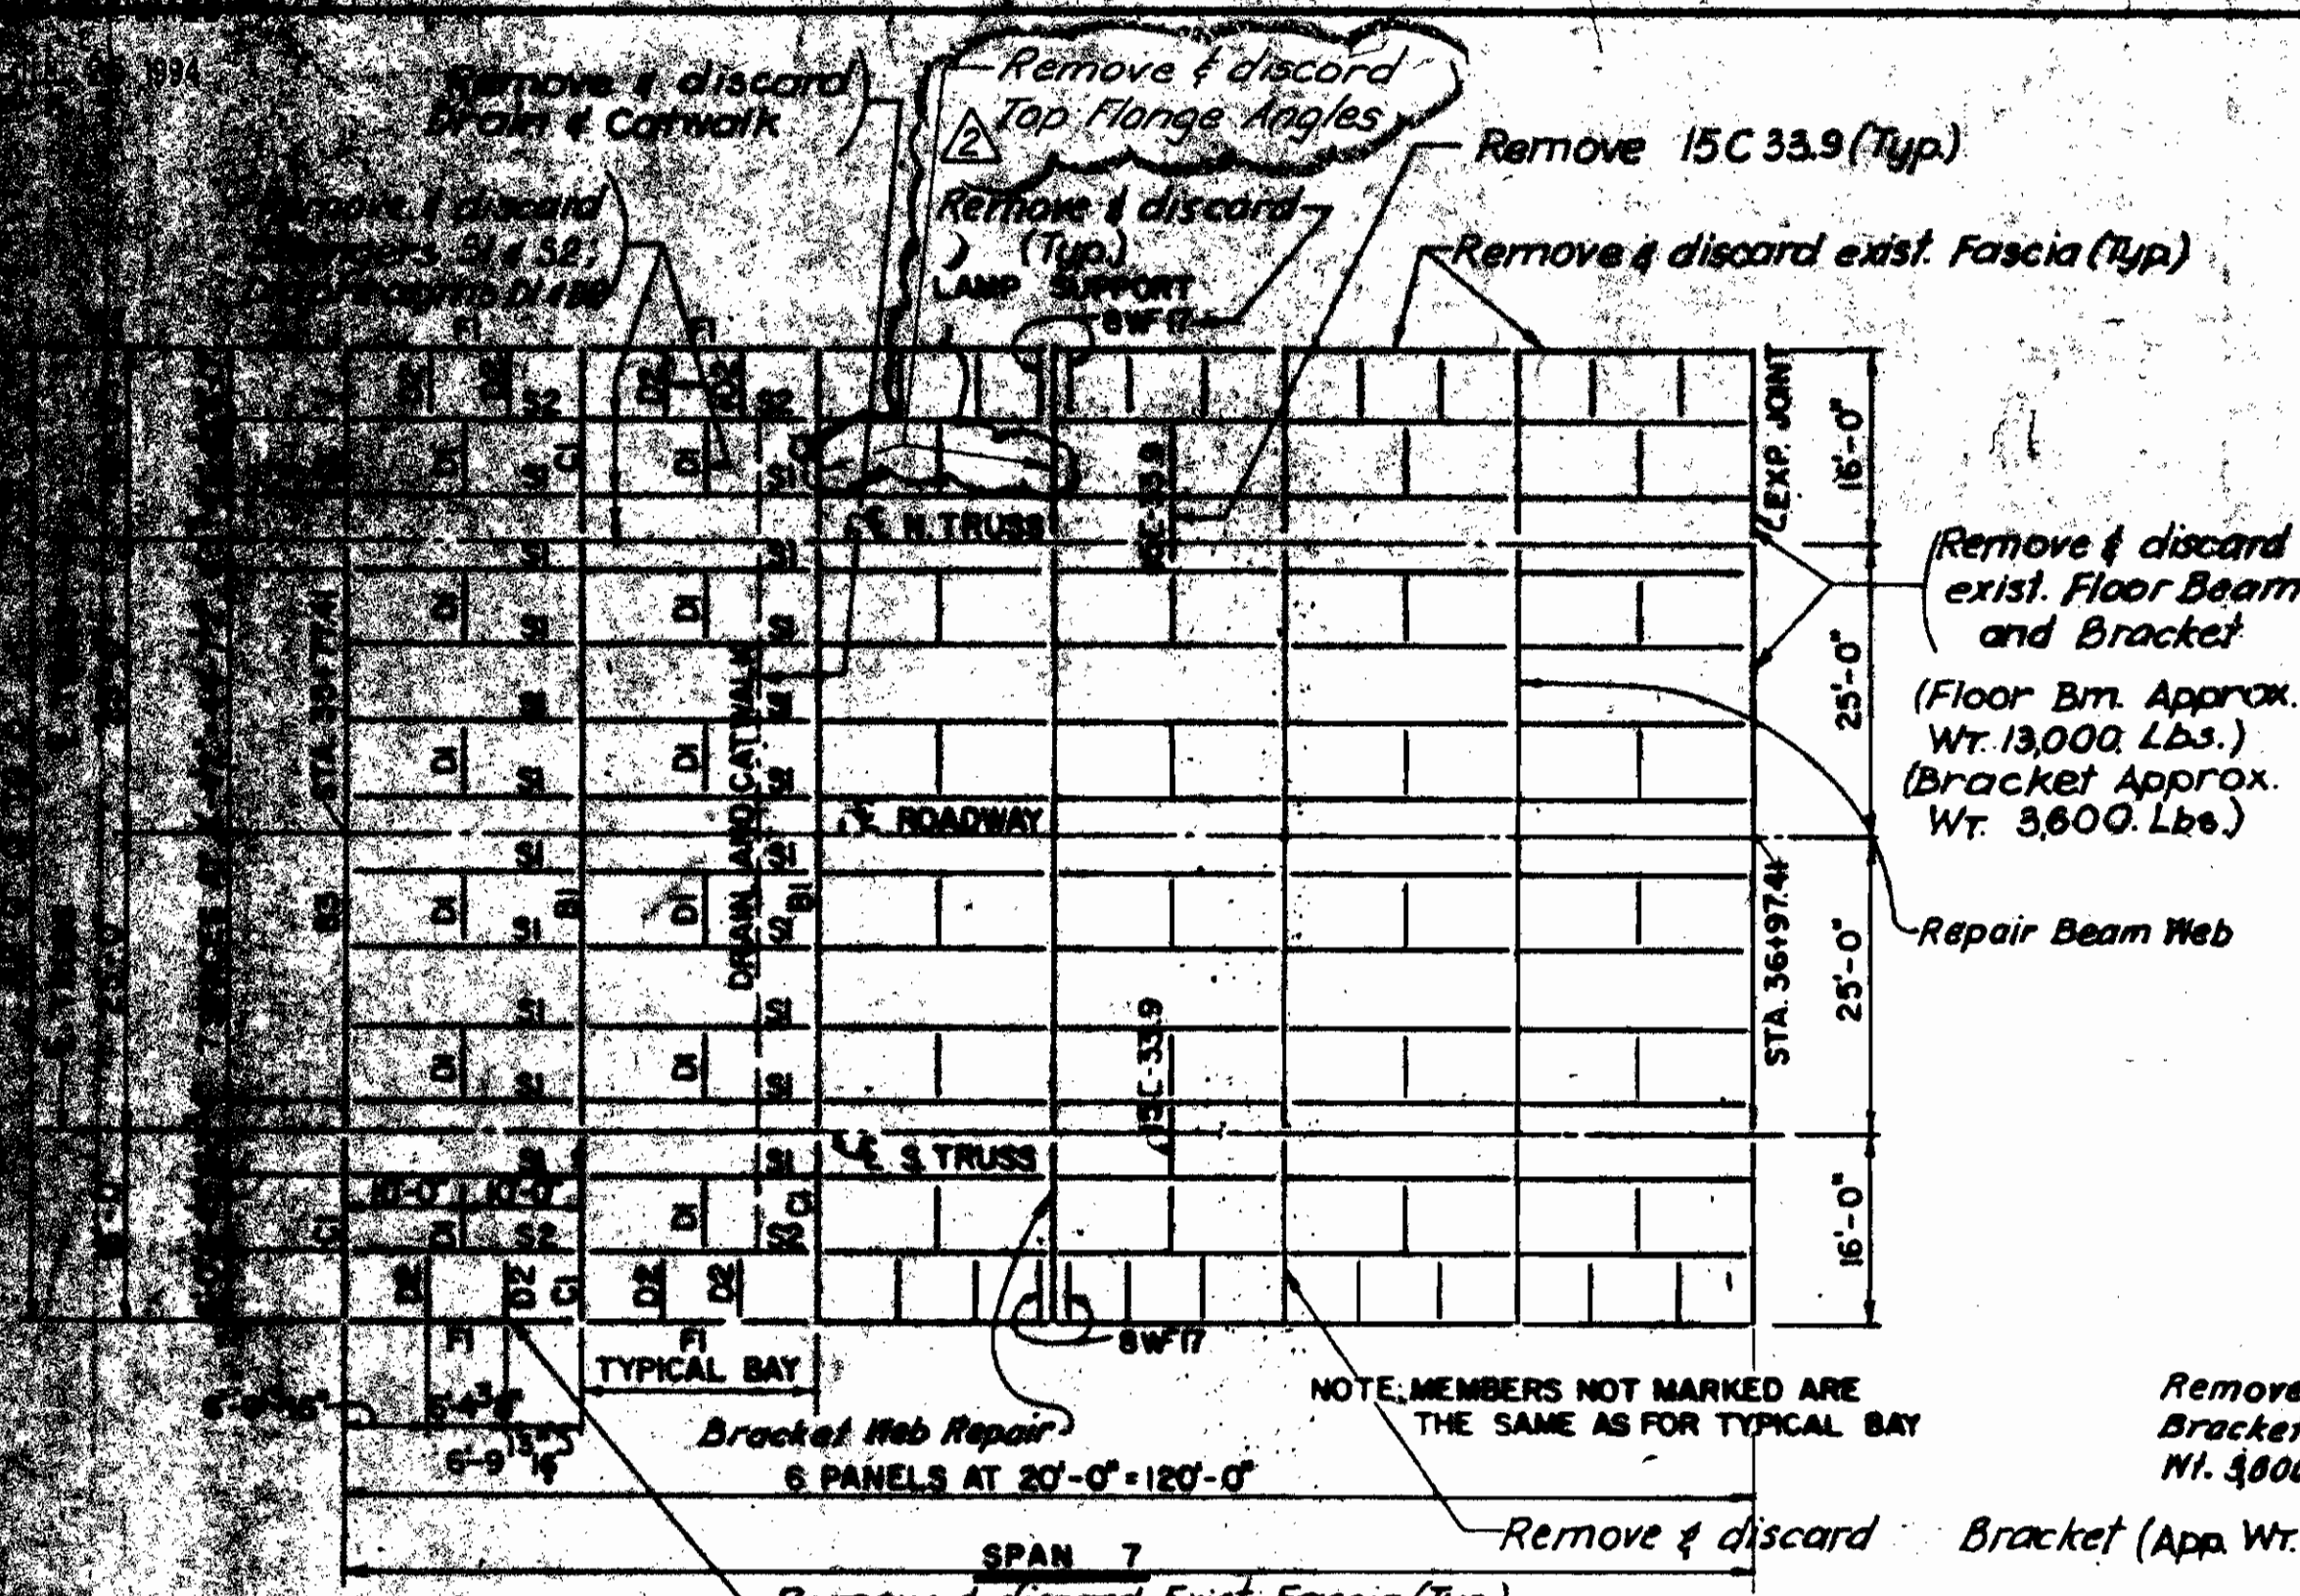

EXISTING FRAMING PLANS

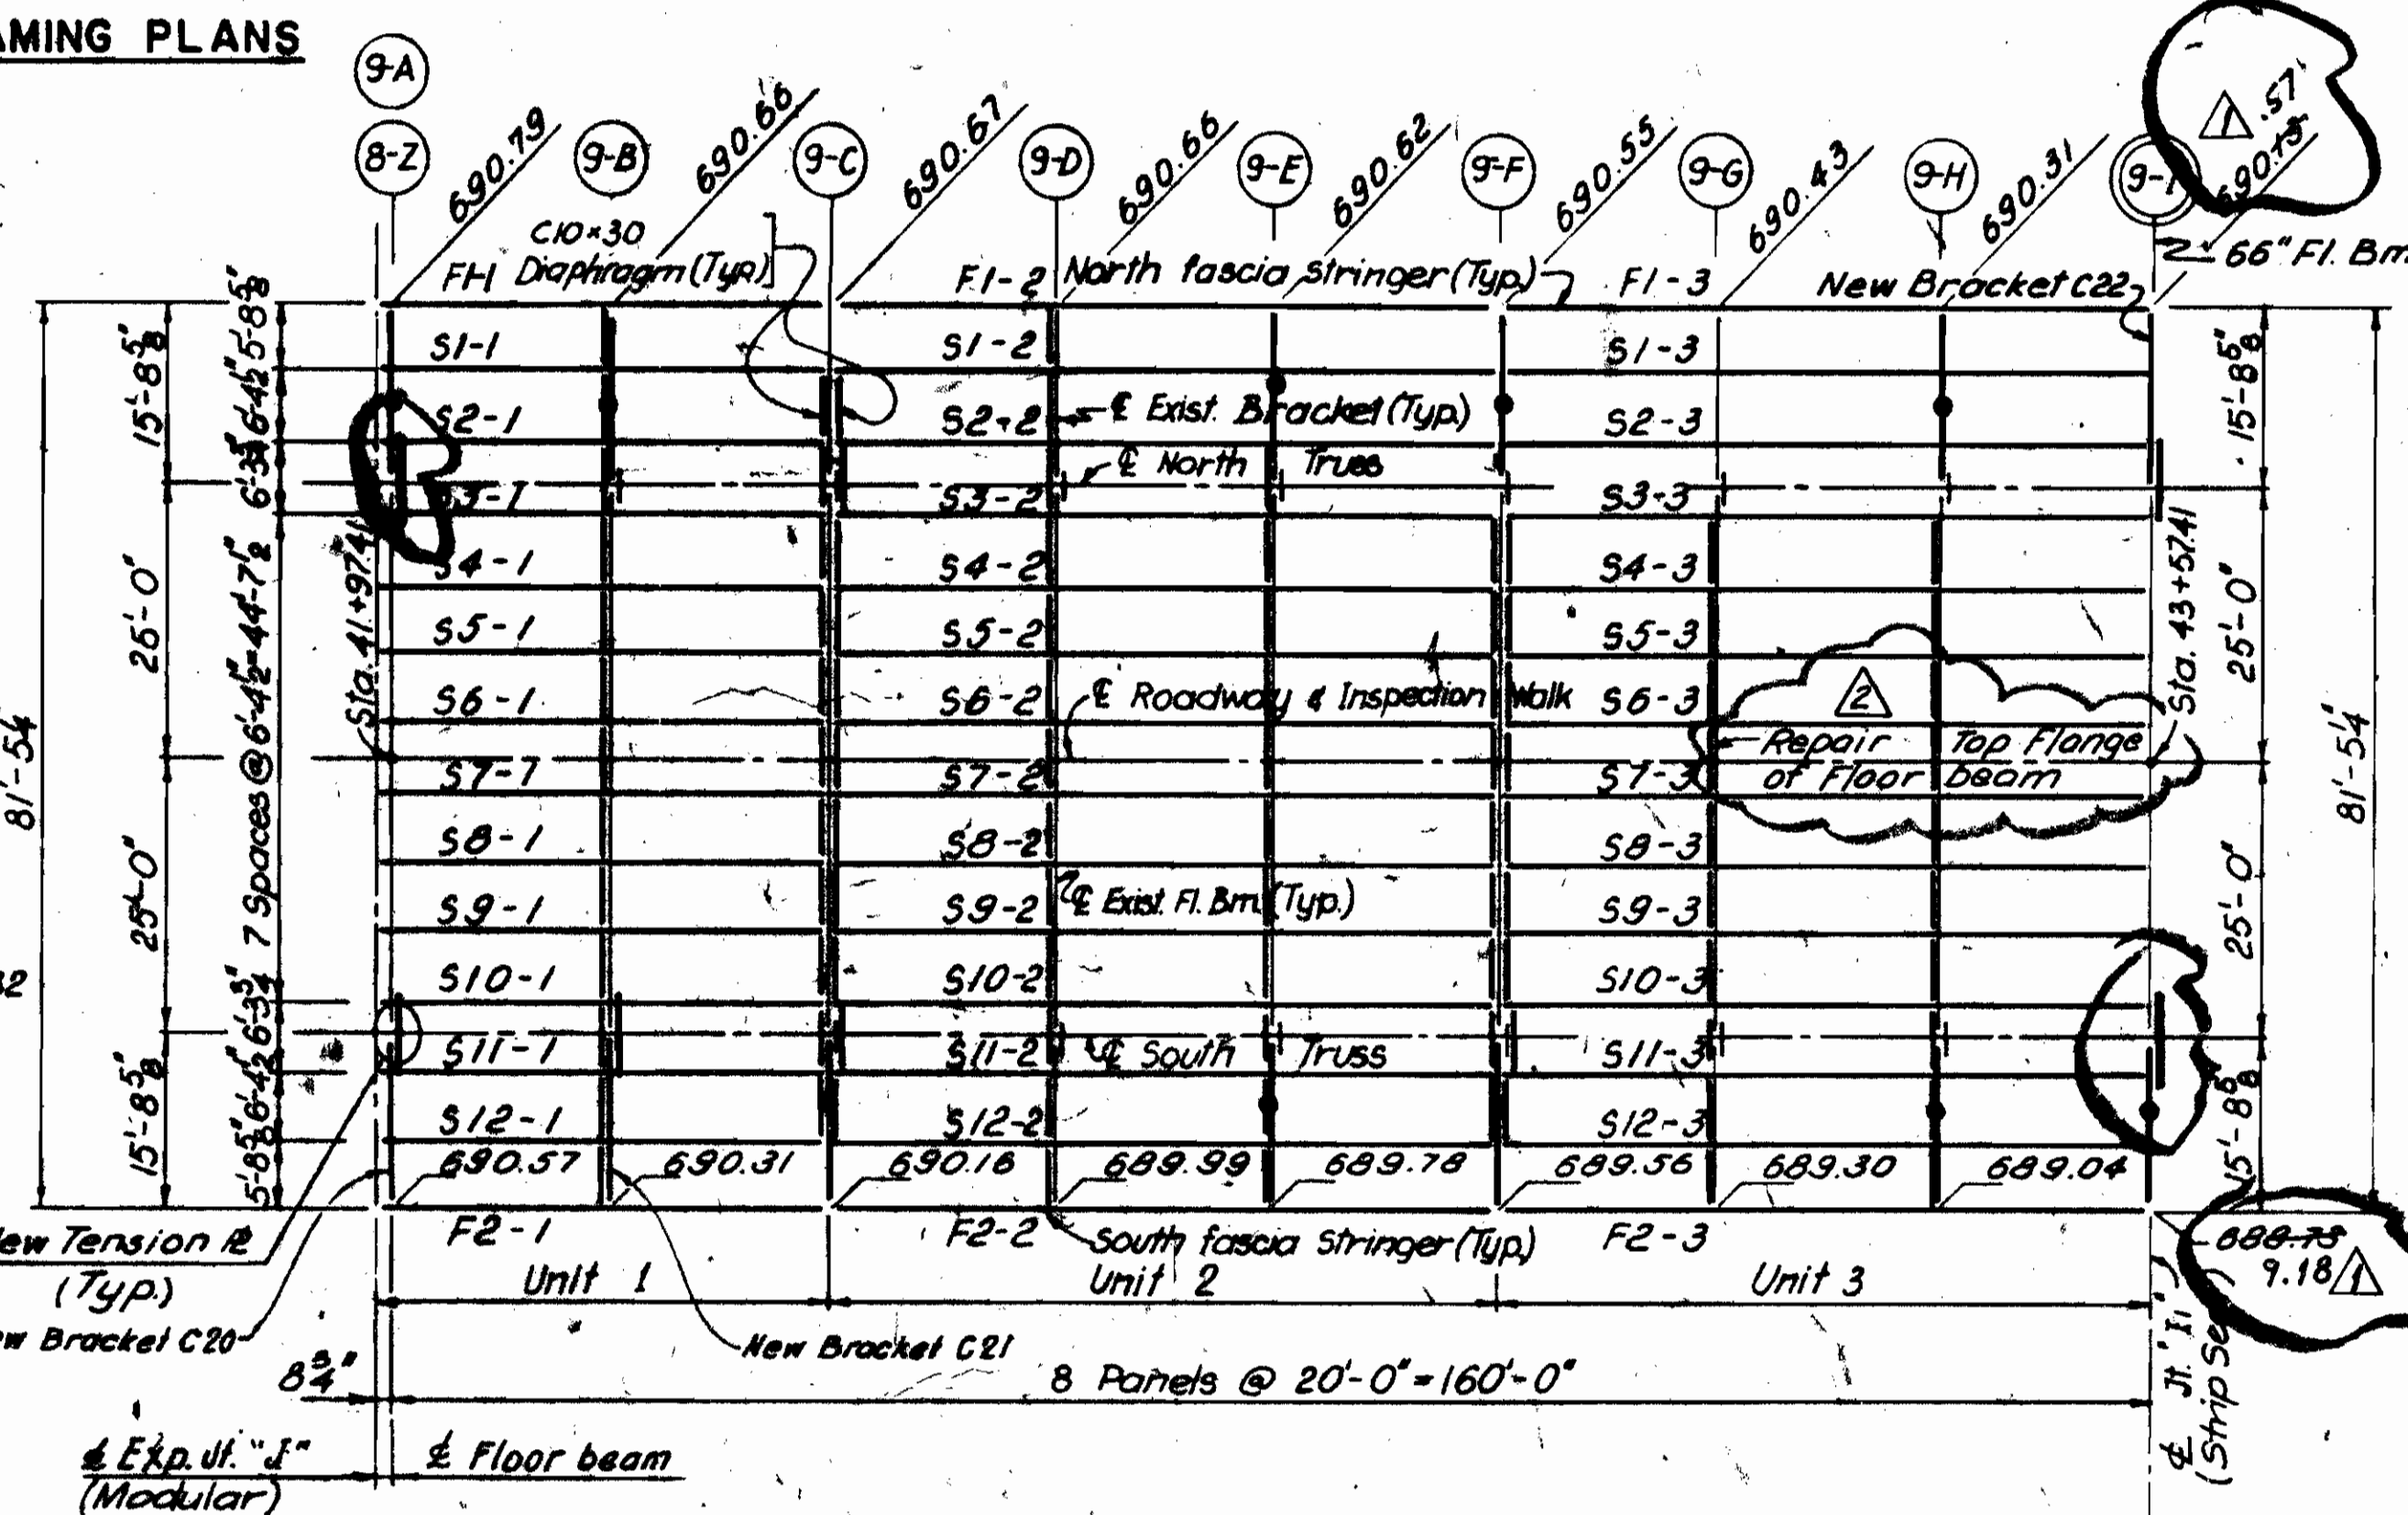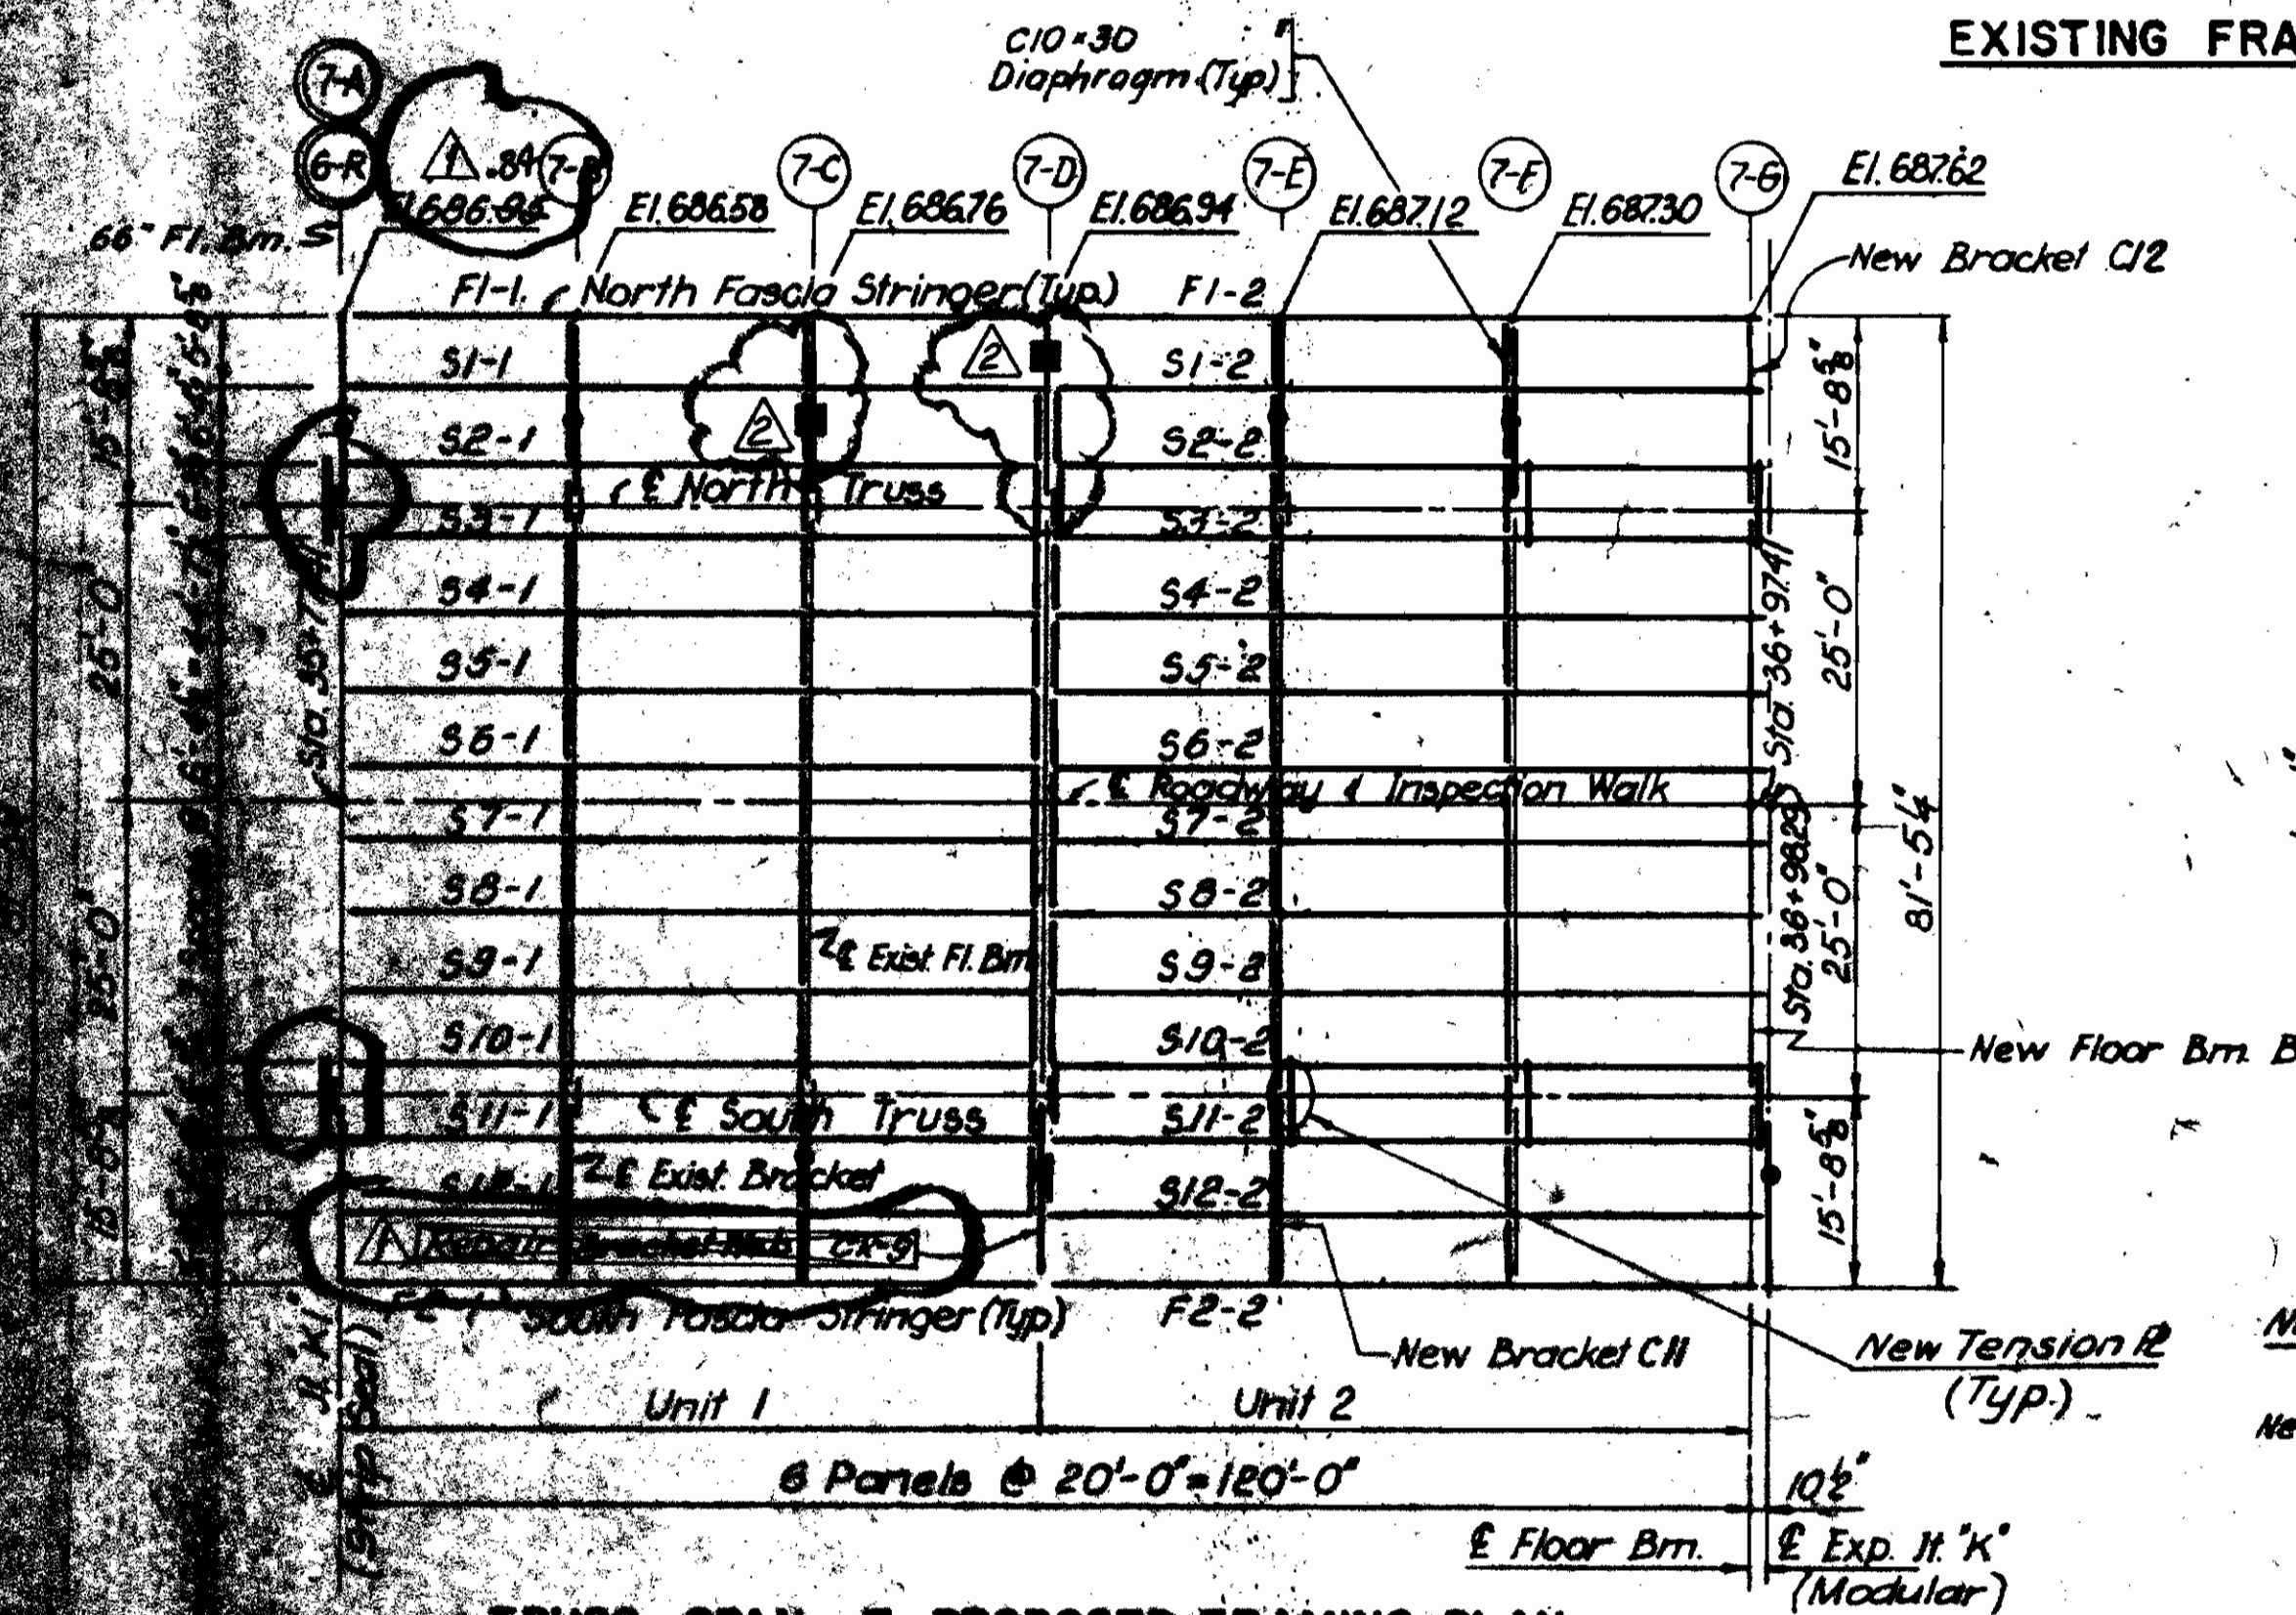

TRUSS SPAN 7 - PROPOSED FRAMING PLAN

TRUSS SPAN 9 - PROPOSED FRAMING PLAN

- Denotes existing framing member
- Denotes new or modified framing member
- Indicates elevation @ top of existing floor beam (Floor beam is horizontal)
- Denotes 66" deep floor beam (Typical floor beams are 60" deep)
- △ Denotes Top Flange Angles Replacement

For Brackets Type C1 to C5  
See: Existing Framing Plans - above

NOTE:  
ELEVATIONS AT 66" FLOORBEAMS  
ARE AT TOP OF FLANGE ANGLES.

REFERENCES:  
References and Notes  
Intermediate Diaphragms

DWG. NO.  
210  
253

NOTES:  
All new Rolled Beams, Shapes and Plates shall be ASTM A36, AISC Category I  
All new Welded Members including Fascia Stringers, Replacement Floor Beams and Brackets shall be ASTM A36, AISC Category III

PAVLO ENGINEERING CO., P.C.  
NEW YORK, NEW YORK

CUYAHOGA COUNTY ENGINEER  
CLEVELAND OHIO

**MAIN AVENUE BRIDGE**  
CITY OF CLEVELAND  
BRIDGE OVER THE CUYAHOGA RIVER VALLEY

MAIN TRUSS SPAN #7 AND  
**EXIST. & PROP. FRAMING**


BRIDGE NO. 123

**NO. B-136**

DESIGN: A.L. DRAWN: L.T. CHECKED: [ ]

AS BUILT 2/94

Rev. 2	△ Plan Revisions	9/10/91
REV. 1	△ Plan REVISIONS	1/11/91

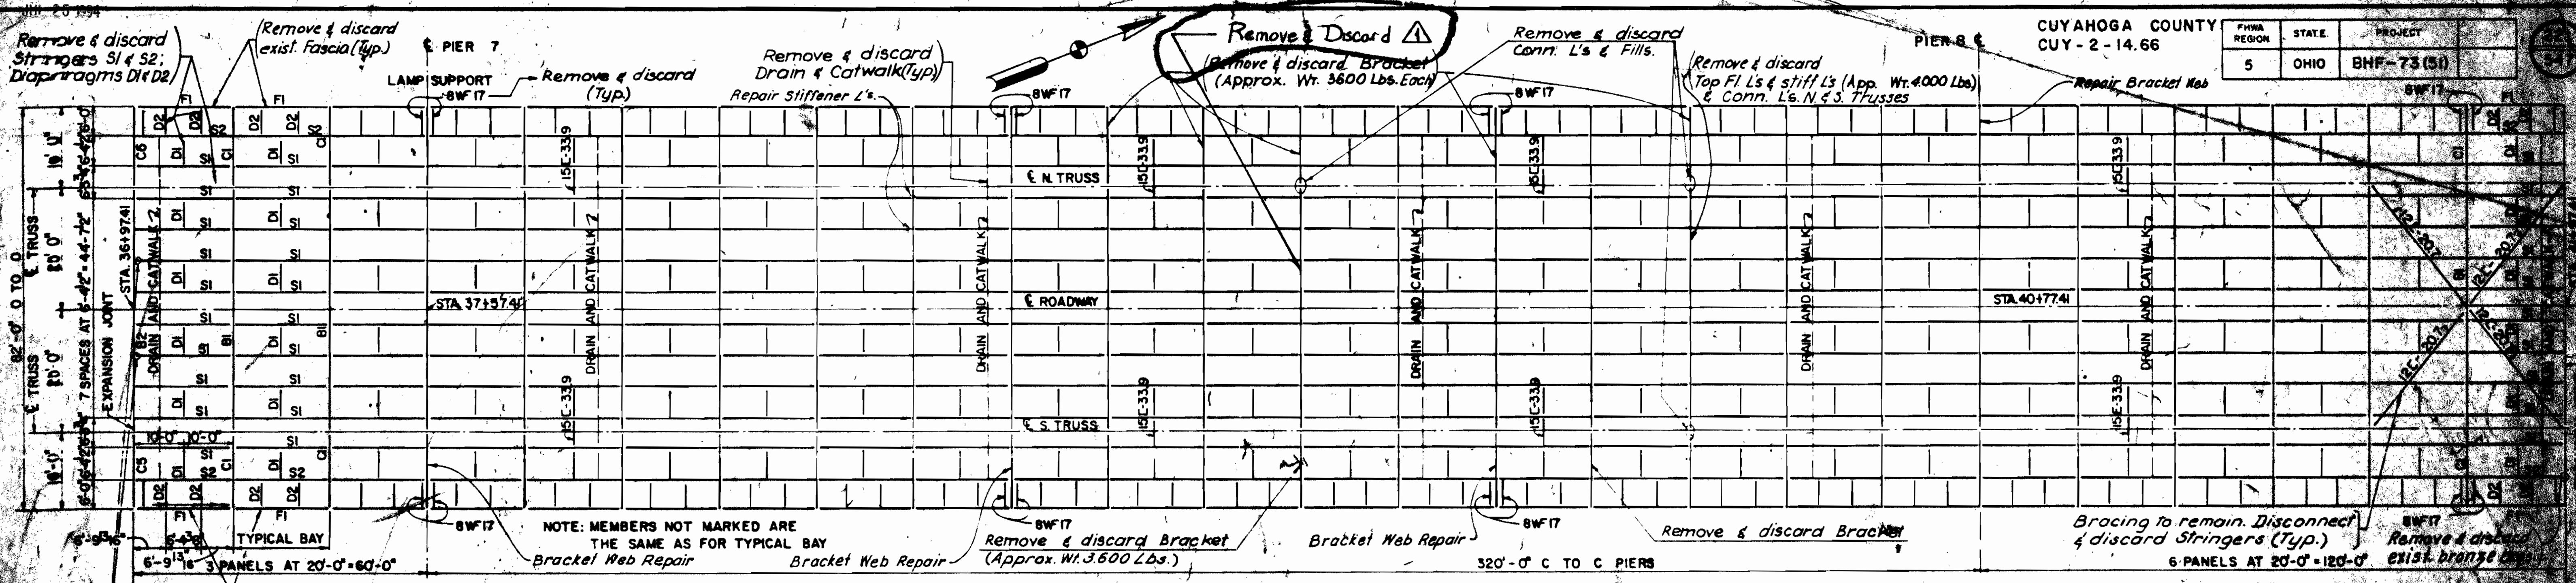

NOTE: MEMBERS NOT MARKED ARE THE SAME AS FOR TYPICAL BAY

Remove & discard Bracket (Approx. Wt. 3600 Lbs.)

Bracket Web Repair

Remove & discard Bracket

Bracing to remain. Disconnect & discard Stringers (Typ.)

Remove & discard exist. bronze bearings

EXISTING FRAMING PLAN

25 PANELS AT 20'-0" = 500'-0" SPAN 8

MARK	DESIGNATION	QUANTITY	REMARKS
SI	21W63	250	
S2	21W59	50	
DI	10W33	150	
D2	9C134	100	
F1	R 30 x 3/8	50	
	2-L 4 x 3 x 3/8	100	
-	8WF17	16	Lamp Support
-	15C339	8	Diaphragms

MARK	DESIGNATION	UNIT	ELEVATION	REMARKS
F1-1	SI-1	Unit 1	687.62	Exp. Jt. "K" (Modular)
F1-2	SI-2	Unit 1	687.66	
F1-3	SI-3	Unit 1	687.64	
F1-4	SI-4	Unit 2	689.37	Repair Bracket Web (C13)
F1-5	SI-5	Unit 2	689.10	
F1-6	SI-6	Unit 2	689.46	
F1-7	SI-7	Unit 2	689.82	
F1-8	SI-8	Unit 2	690.00	Repair Bracket Web (C19)
F1-9	SI-9	Unit 2	690.16	
F1-10	SI-10	Unit 2	690.75	
F1-11	SI-11	Unit 3	690.42	
F1-12	SI-12	Unit 3	690.21	
F1-13	SI-13	Unit 3	690.98	
F1-14	SI-14	Unit 3	690.62	
F1-15	SI-15	Unit 3	690.63	
F1-16	SI-16	Unit 3	689.63	
F1-17	SI-17	Unit 3	689.82	
F1-18	SI-18	Unit 3	689.46	
F1-19	SI-19	Unit 3	689.10	
F1-20	SI-20	Unit 3	687.64	
F1-21	SI-21	Unit 3	687.66	
F1-22	SI-22	Unit 3	687.62	

(Floor Beams are horizontal in Units 1 to 9 only)

EXISTING FRAMING REMOVAL

MARK	DESIGNATION	QUANTITY	REMARKS
SI	21W63	250	
S2	21W59	50	
DI	10W33	150	
D2	9C134	100	
F1	R 30 x 3/8	50	
	2-L 4 x 3 x 3/8	100	
-	8WF17	16	Lamp Support
-	15C339	8	Diaphragms

TRUSS SPAN 8-PROPOSED FRAMING PLAN

Denotes existing frame member

Denotes new or modified framing member

Indicates elevation @ top of existing floor beam


Denotes 66" deep Floor beam (Typical floor beams are 60" deep)

Denotes Bracket Replacement

For Brackets Type C1 to C5 - above

See: Existing Framing Plan - above

NOTE: ELEVATIONS AT 66" FLOOR BEAMS ARE AT TOP OF FLANGE ANGLES.

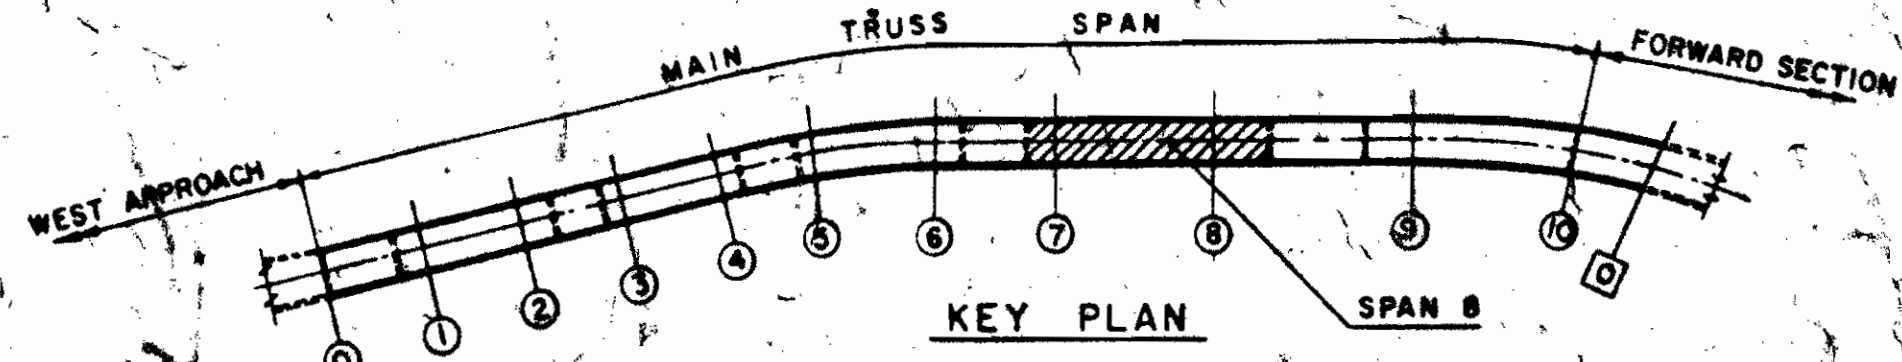

REFERENCES

References and Note's Intermediate Diaphragms

DWG. NO.

210

253

NOTES:

All new Rolled Beams, Shapes and Plates shall be ASTM A36, AISC Category I.

All new Welded Members, including Fascia Stringers, Replacement Floor Beams and Brackets shall be ASTM A36, AISC Category III.

Rev. 2	Plan Revisions	9/10/64
Rev. 1	Plan Revisions	2/11/64

PAVLO ENGINEERING CO., P.C.  
 NEW YORK, NEW YORK

CUYAHOGA COUNTY ENGINEER  
 CLEVELAND OHIO

MAIN AVENUE BRIDGE  
 CITY OF CLEVELAND  
 BRIDGE OVER THE CUYAHOGA RIVER

EXIST. & PROP. FRAMING PLAN

BRIDGE NO. 133



NO. B-136

DESIGN	DRAWN	CHECKED	REVISION
A.S.	J.P.W.	R.D.H.	AS BUILT 2/94

DATE: 12-91 E.E.S.

FHWA REGION	STATE	PROJECT
5	OHIO	BHF-73(SI)

CUYAHOGA COUNTY  
CUY-2-14-58

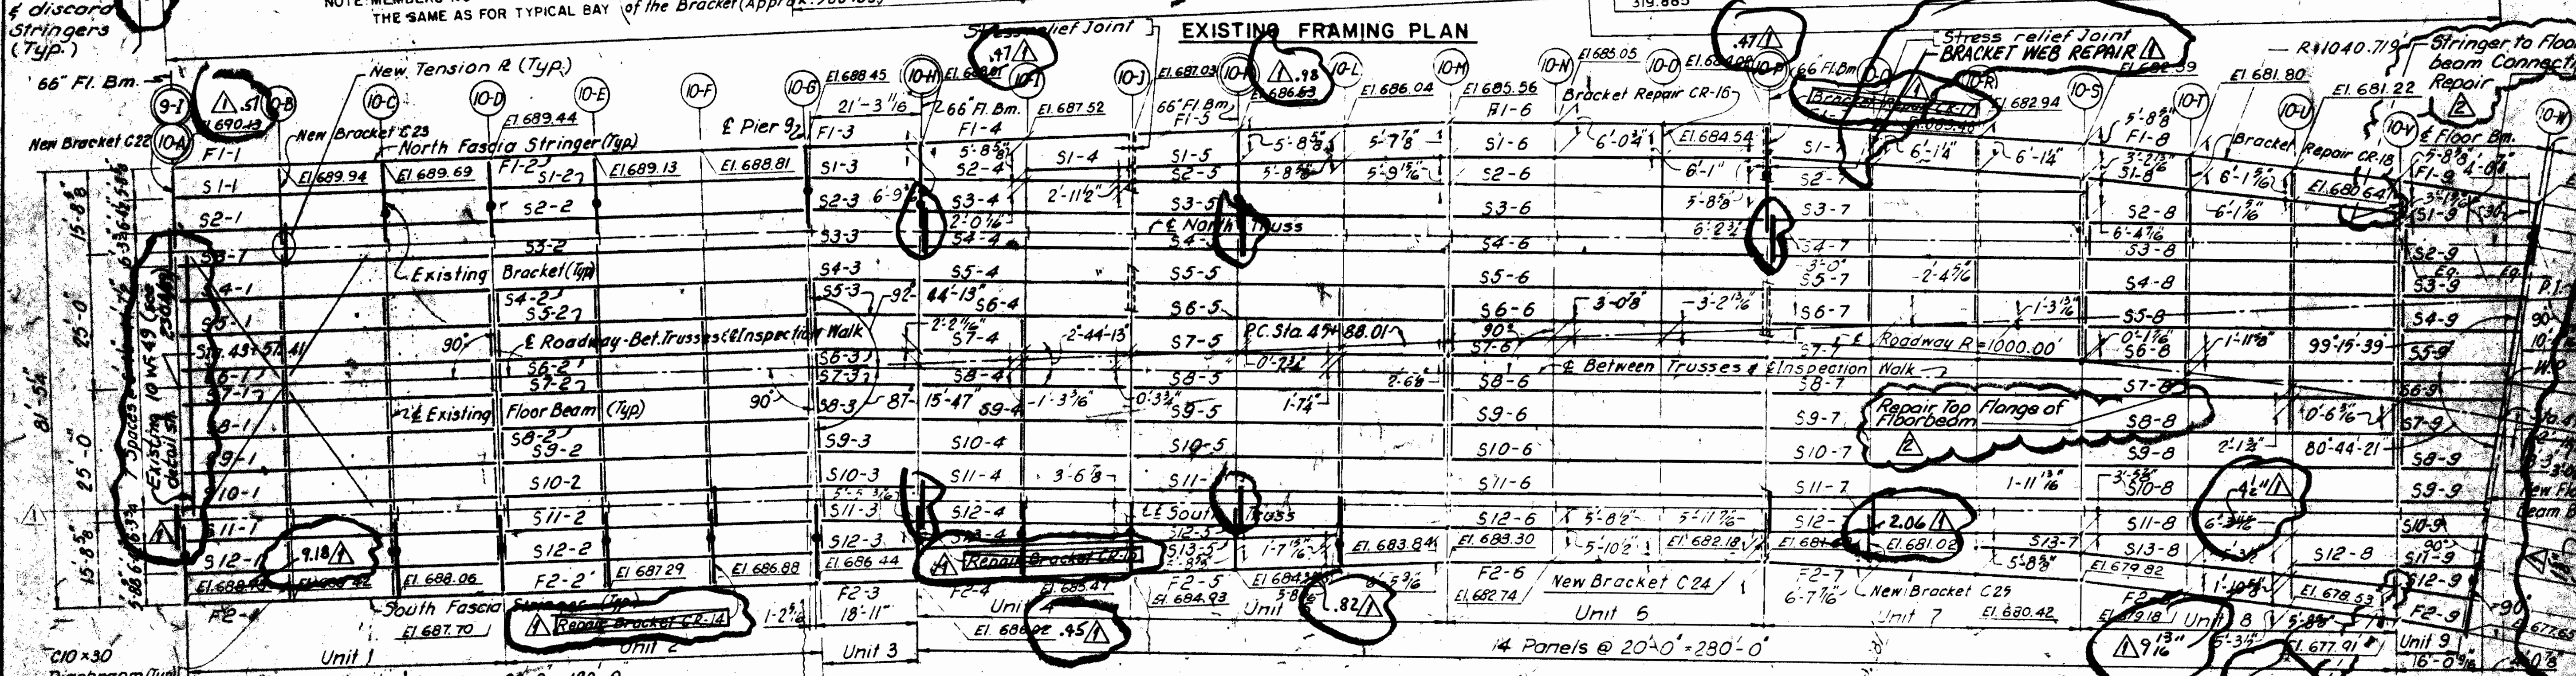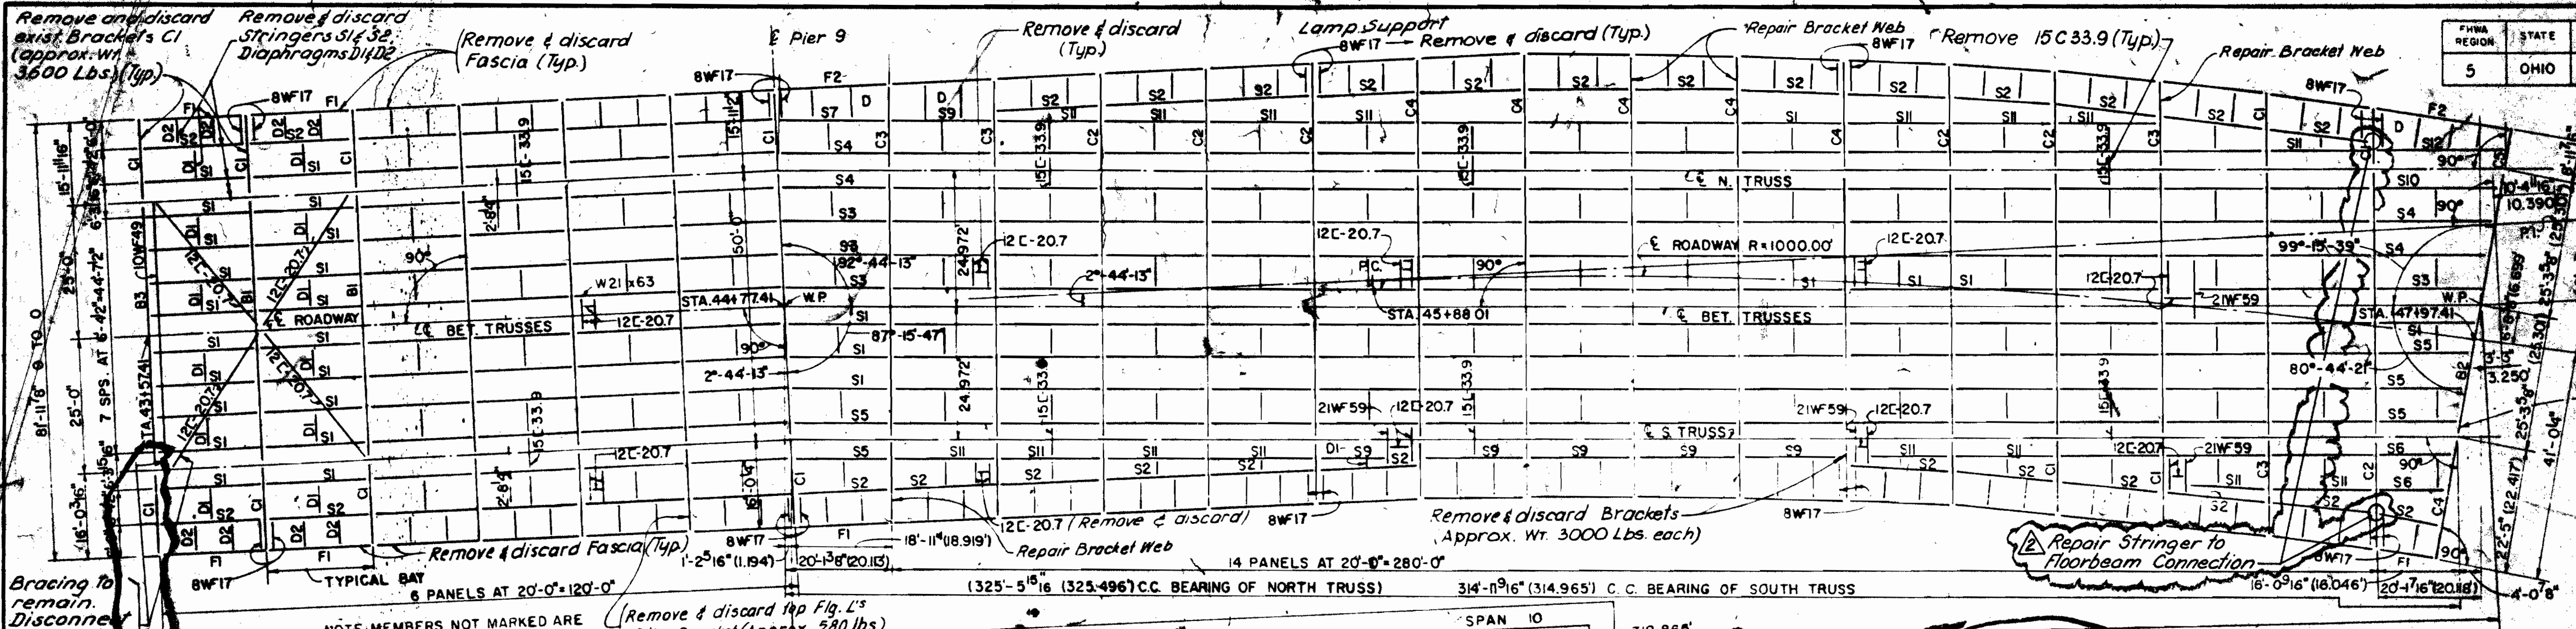

**EXISTING FRAMING REMOVAL**

MARK	DESIGNATION	TRUSS SPAN 10 QUANT.	REMARKS
S1 & S12	21W63	197	
S2 & S5 to S9 & S11	21W59	67	
S3	21W68	4	
S4	21W73	4	
S10	21W82	1	
D1	10W83	127	
D2	9C134	88	
FI	R30x38	44	Lamp Support
	2-Ls 4x3x3/8	88	
-	BWF17	20	Diaphragms
-	15C33.9	8	

**TRUSS SPAN 10 PROPOSED FRAMING PLAN**

- Denotes existing frame member.
- Denotes new or modified framing member.
- Indicates elevation at top of exist. floor beam.
- Denotes 66" deep floor beam. (Typical floor beams are 60" deep).
- Denotes Bracket Replacement

For Brackets Type C1 to C5, See: "Existing Framing Plan" - above

**NOTE:**  
ELEVATIONS AT 66" FLOOR BEAMS ARE AT TOP OF FLANGE ANGLES

**NOTES:**

All new Rolled Beams, Shapes and Plates shall be ASTM A36, AISC Category I.

All new Welded Members including Fascia Stringers, Replacement Floor Beams and brackets shall be ASTM A36, AISC Category III.

**REFERENCES:**

References and Notes Intermediate Diaphragms

**DWG. NO.**

210  
253

Rev. 2	Plot Revisions	9/10/91
Rev. 1	Plan Revisions	2/11/91

PAVLO ENGINEERING CO., P.C.  
NEW YORK, NEW YORK

CUYAHOGA COUNTY ENGINEER  
CLEVELAND, OHIO

**MAIN AVENUE BRIDGE**  
CITY OF CLEVELAND  
BRIDGE OVER THE CUYAHOGA RIVER

MAIN TRUSS SPAN 10  
**EXIST. & PROP. FRAMING**

BRIDGE NO. 103

**NO. B-136**


DESIGN: A.S. DRAWN: C.P.W. CHECKED: J.P.W.

AS BUILT 2/94

\* This is the design dimension. The quantity of deck concrete to be paid for shall be based upon this dimension less 1/4" W.S., even though deviation from it may be necessary because the top flange of the girder may not have the exact camber or conformation required to place it parallel to the finished grade. Deduction shall be made for volume of encased steel plates as per 5H.18.

Note: See Dwg. 262 for "Forms for Deck Overhang" note


MICROFILMED  
JUL 28 1994

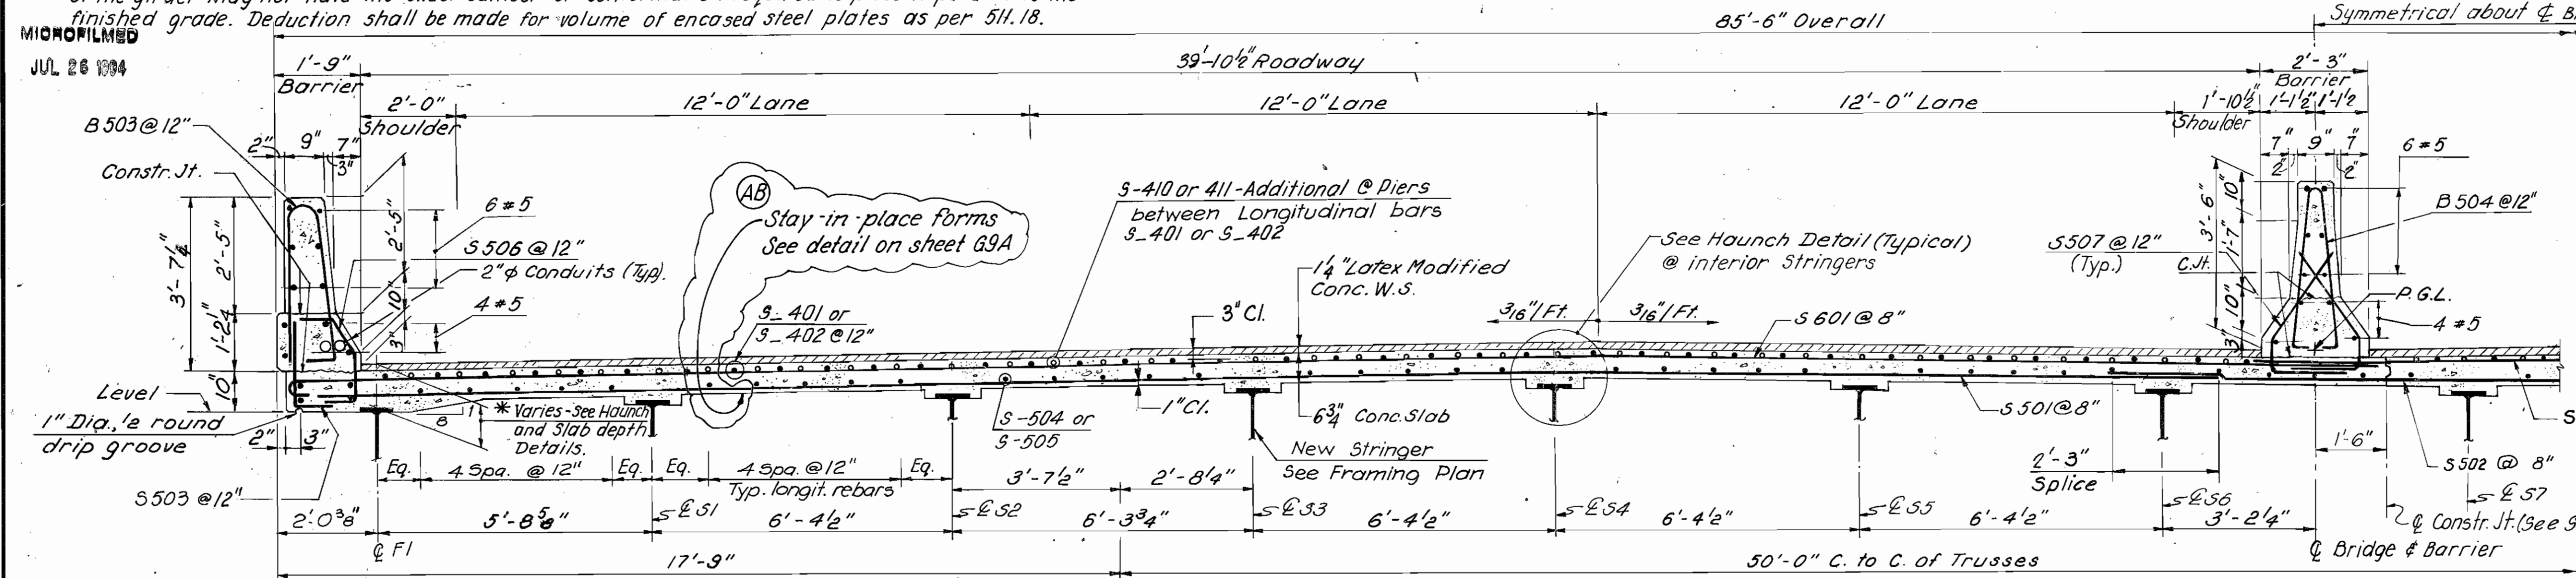

BAR SIZE	MIN. LAP
# 4	1'-10"
# 5	2'-3"
# 6	2'-8"

• Deck Slab Depth: The distance shown from top of deck slab to top of steel beam is the design dimension. The quantity of deck concrete to be paid for shall be based on this dimension, less 1/4" W.S. even though deviation from it may be necessary because the top flange of the beam may not have the exact camber or conformation required to place it parallel to the finished grade.






• A Haunch Width as shown on Haunch & Depth of Slab Details shall be used for computing quantity of concrete.

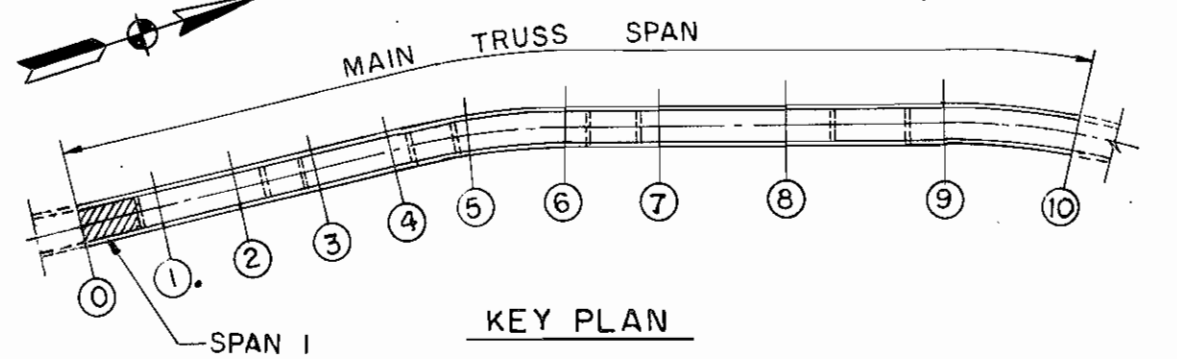

- NOTES**
- All Deck concrete shall be "Lightweight class 5"
  - Deck pouring sequences and directions are indicated in Dwg. No 275 "Deck Slab Details I"
  - Pretformed deflection joint filler in barriers shall be either 1/4" thick gray sponge rubber (AASHTO M-153) or 1/4" gray cellular polyvinyl chloride (PVC) sponge. Concrete parapets above upper construction joints shall be placed in alternate sections by the use of bulkheads. Closing sections shall be placed after removal of bulkheads and after placement of expansion joint filler.
  - Embedded Lighting conduits (size & layout), junction boxes, grounding etc. are detailed in the Dwg. No 664 to 669 "Proposed Bridge Lighting"
  - For details of Deck supporting Traffic Signs, see Dwg. No 275 & 277.
  - The contractor shall bend or field cut reinforcing steel as required at scuppers.

**REFERENCES**

REFERENCES	DWG. NO
General Notes	66 to 623
General Plan & Elevation (Existing and Proposed)	201 to 206
Typical Cross Section	207
Top of Deck Elevations and Deflections	262 to 267
End of slab sections EI-EI & E3-E3	276
Scupper Details	654 & 655
Lighting Post-Pilaster Details & Barrier Cavities for Conduit	668
Expansion Joints	278 to 282
Sign Support details	275
Bar List	283
Haunch and Slab Depth details	262
Stay-in-place forms	69A

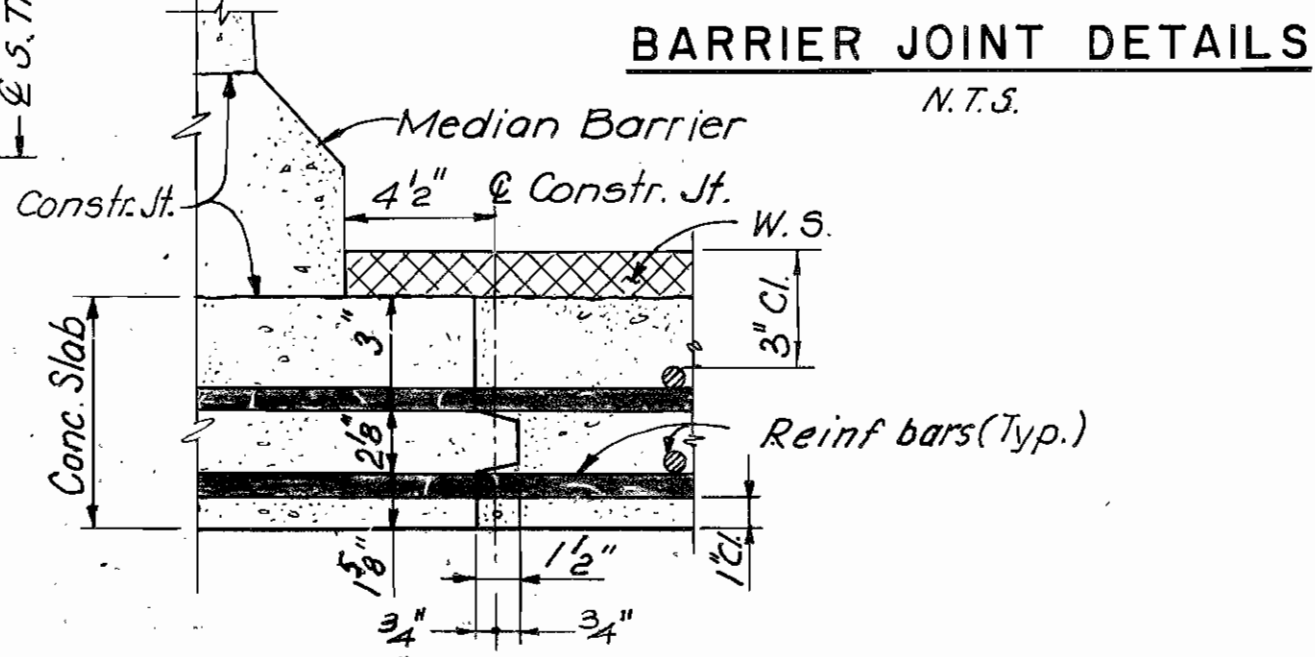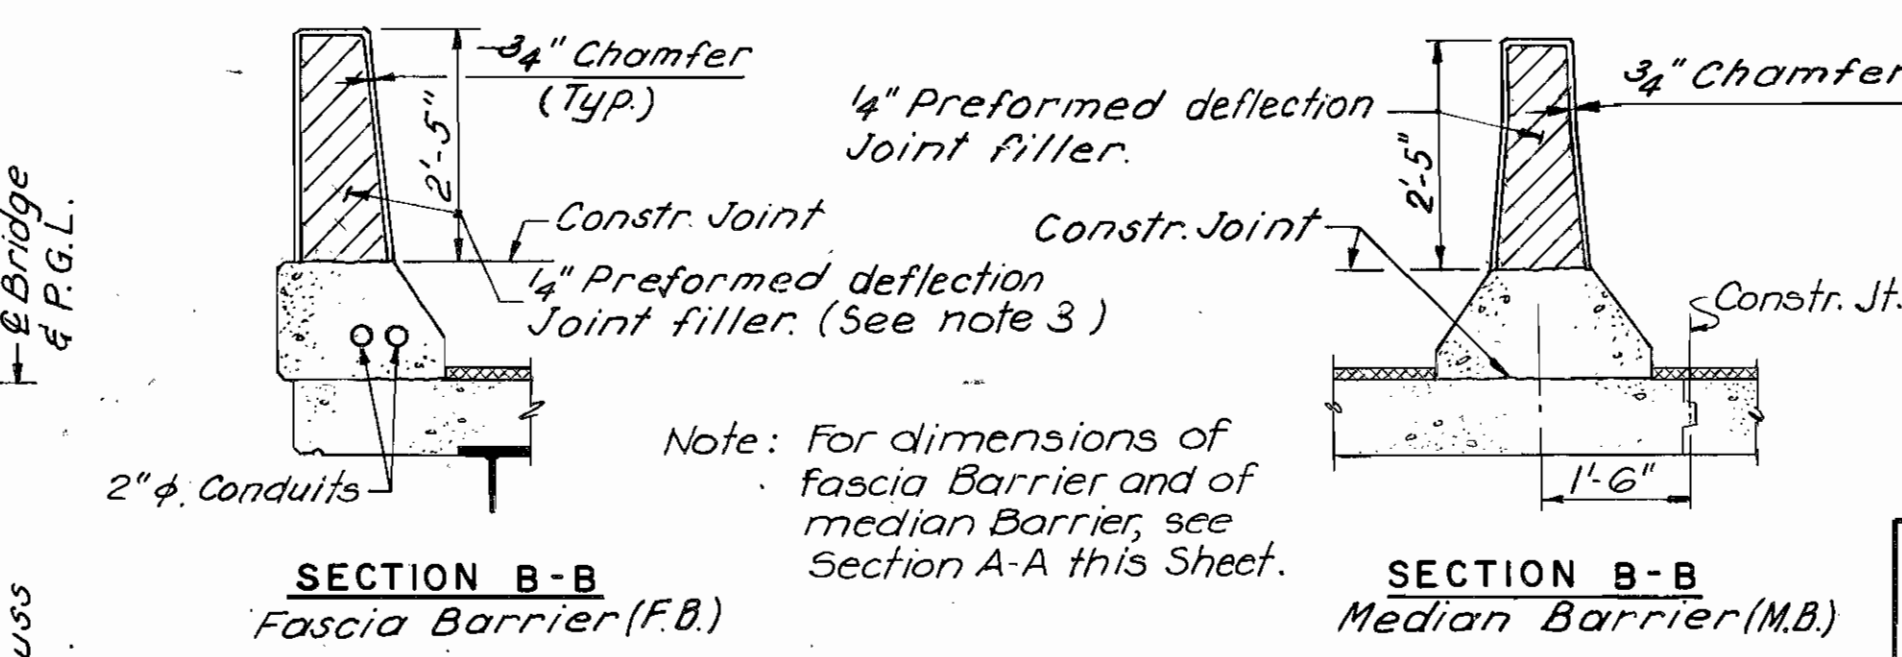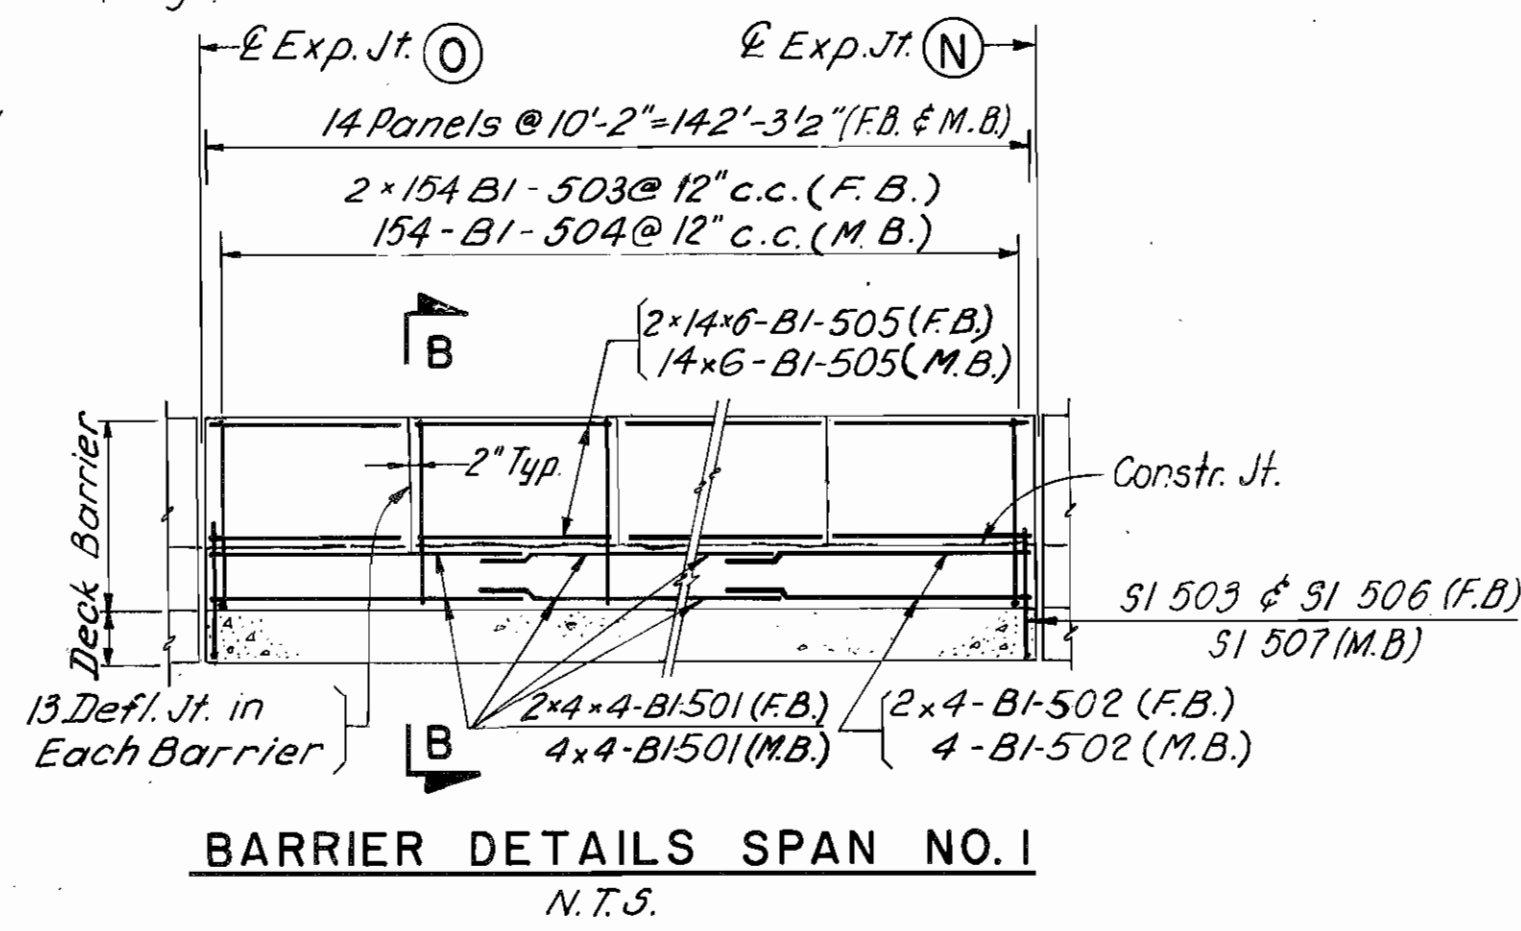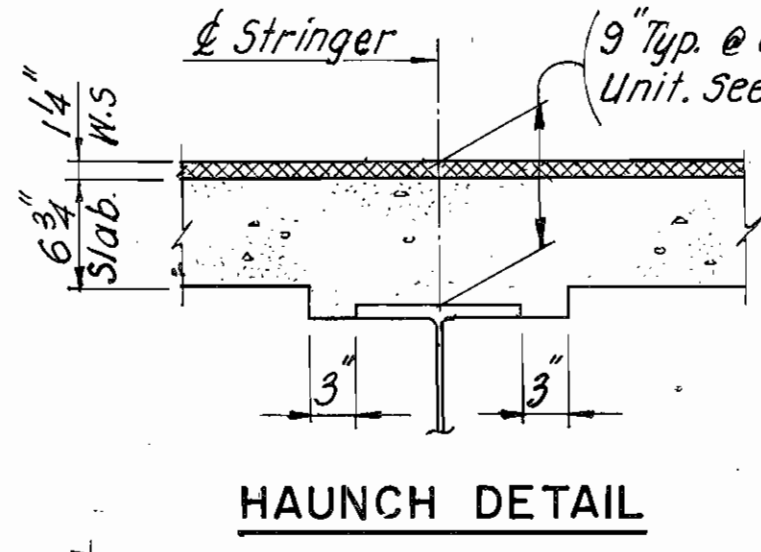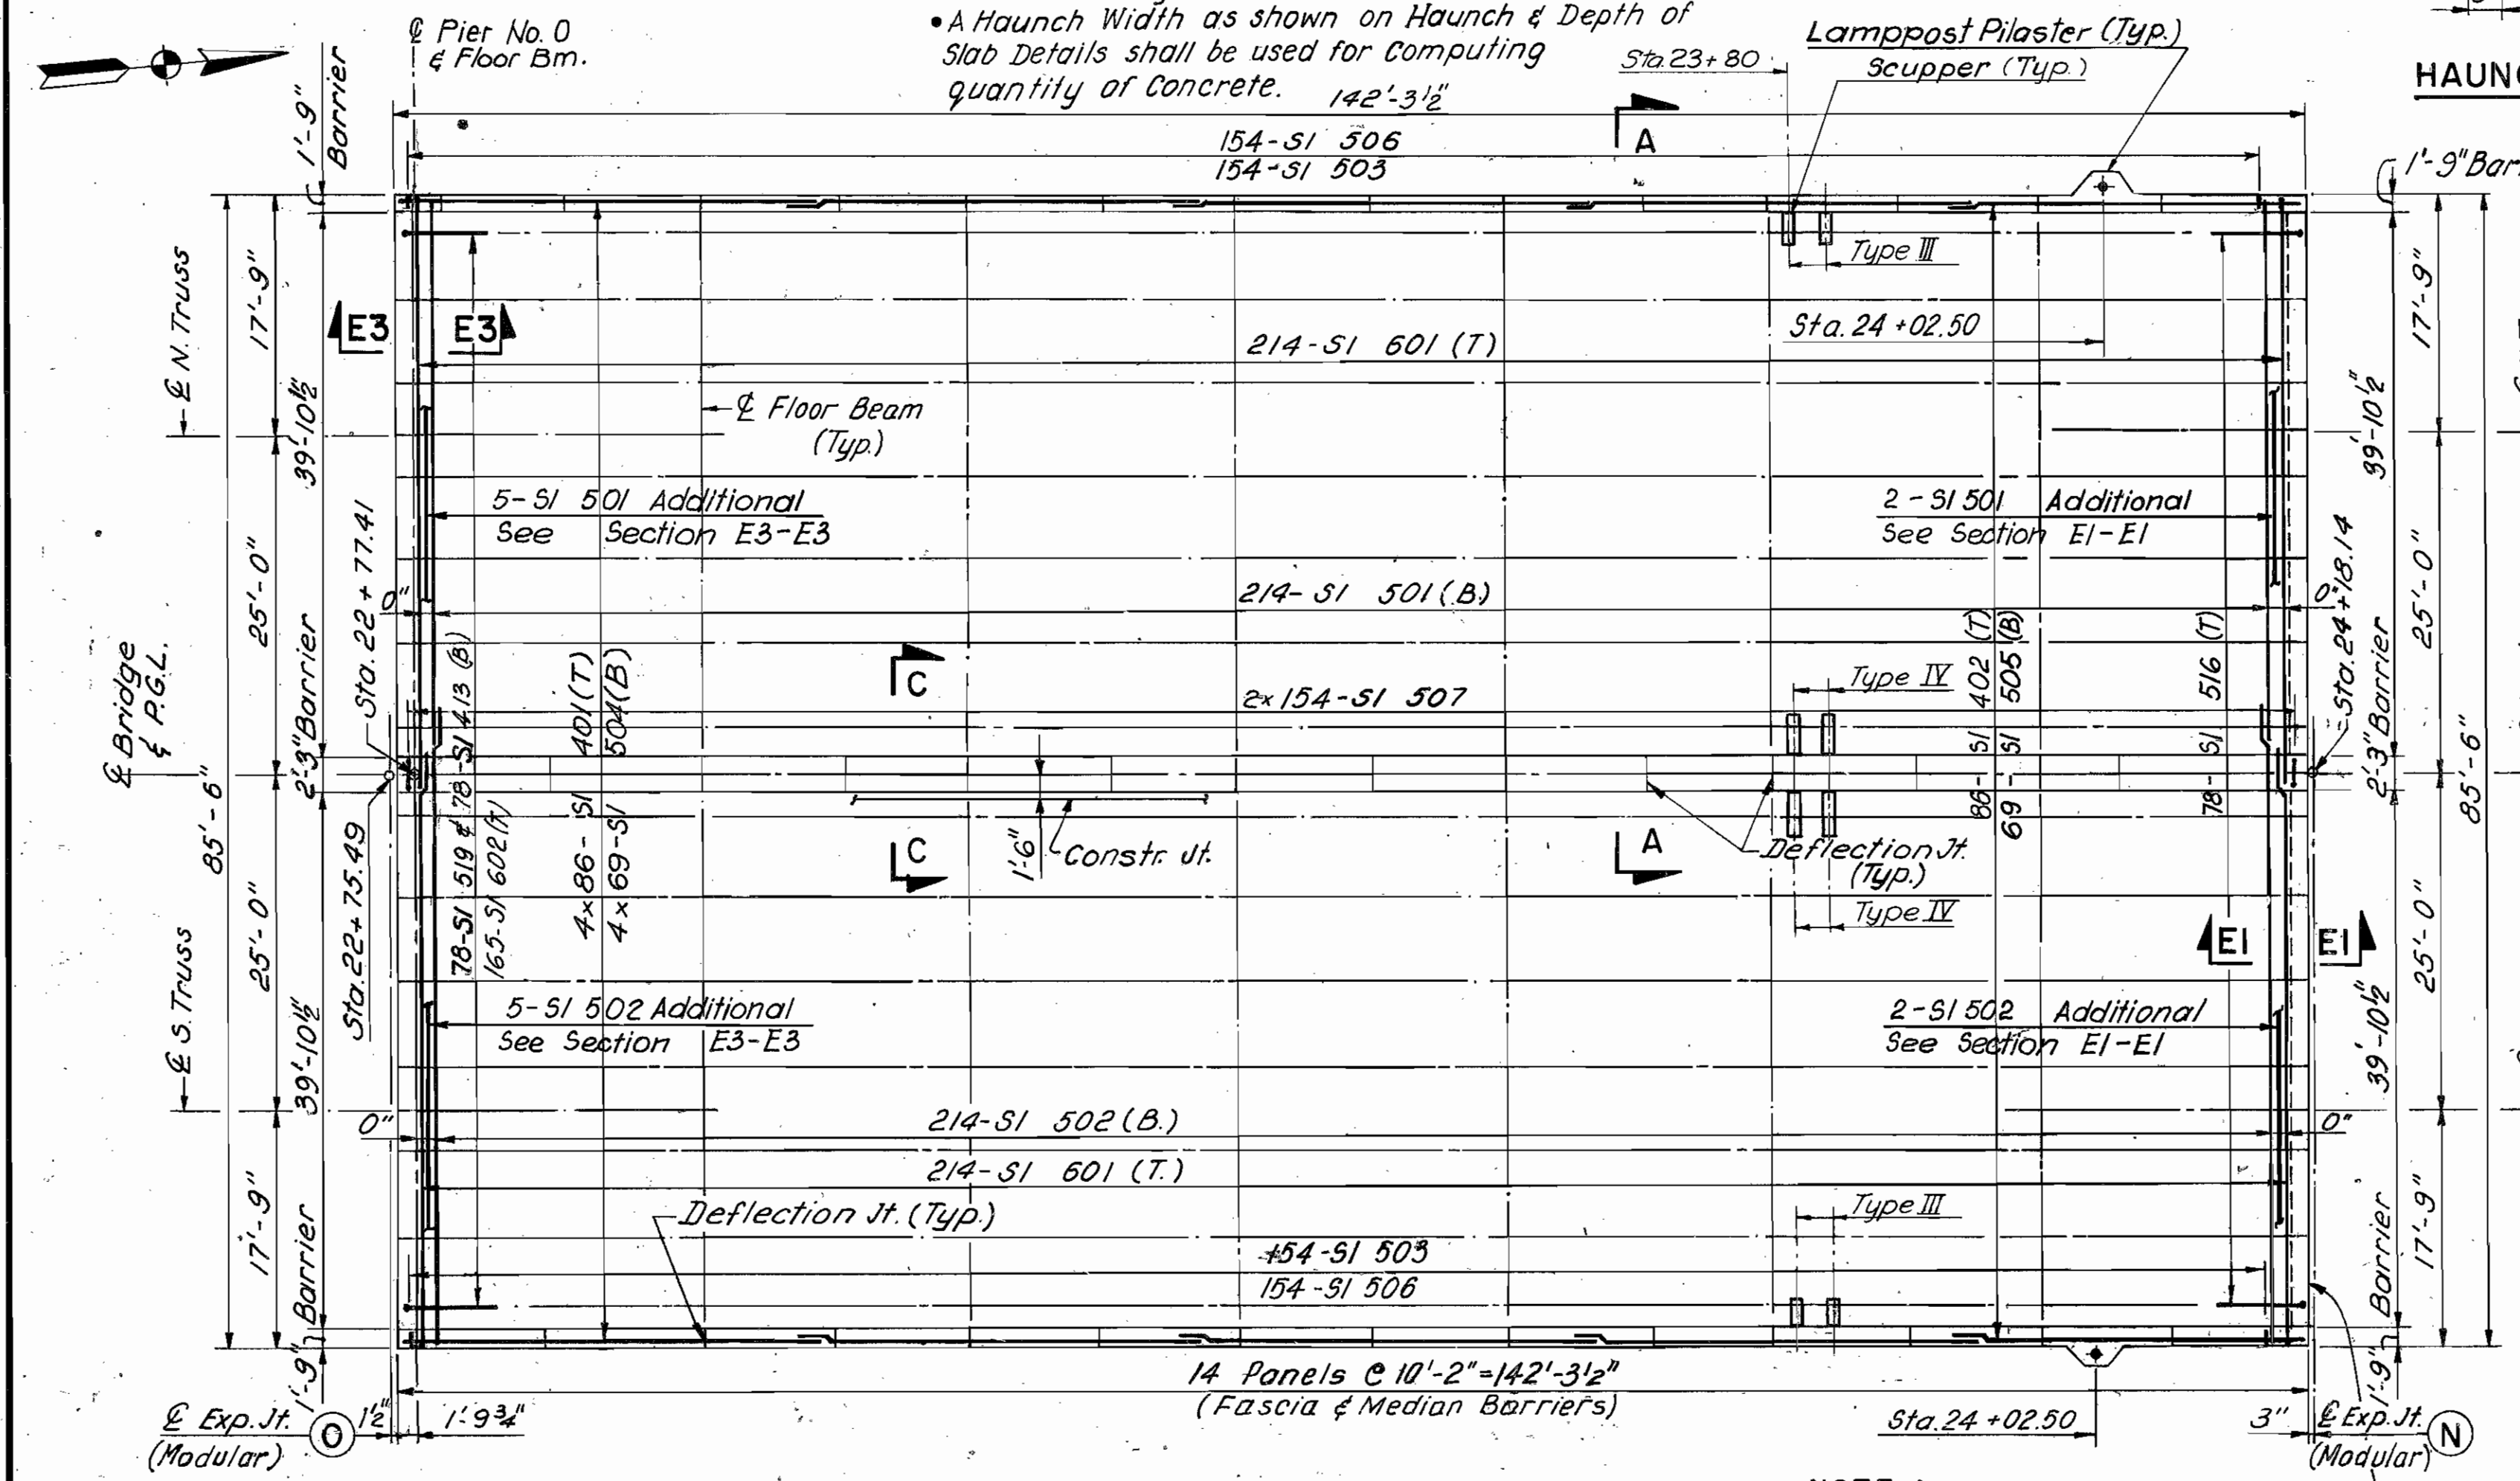

**NOTE A:**  
Field cut and bend reinf. bars to clear boxes.  
Support Boxes for Exp. Jt. Not Shown See Dwg 278 See also Note A.

TRUSS SPAN NO. I - PLAN

PAVLO ENGINEERING CO., P.C.  
NEW YORK, NEW YORK

CUYAHOGA COUNTY ENGINEER  
CLEVELAND OHIO

**MAIN AVENUE BRIDGE**  
CITY OF CLEVELAND  
BRIDGE OVER THE CUYAHOGA RIVER VALLEY

MAIN TRUSS SPAN - I  
**DECK SLAB REINFORCEMENT**



BRIDGE NO. 193 REPORT NO. 7119 DATE Oct. 25, 1983

**NO. B-136**


DESIGN	DRAWN	CHECKED	REVISED TO AS BUILT
A.S./B.P.	T.C.	E.G.	AS BUILT 2/94

MICROFILMED  
JUL 28 1984

Support Boxes  
for Exp. Jt. Not Shown. See Dwg. 278  
See also Note 1, this sheet.  
59'-0 1/4"

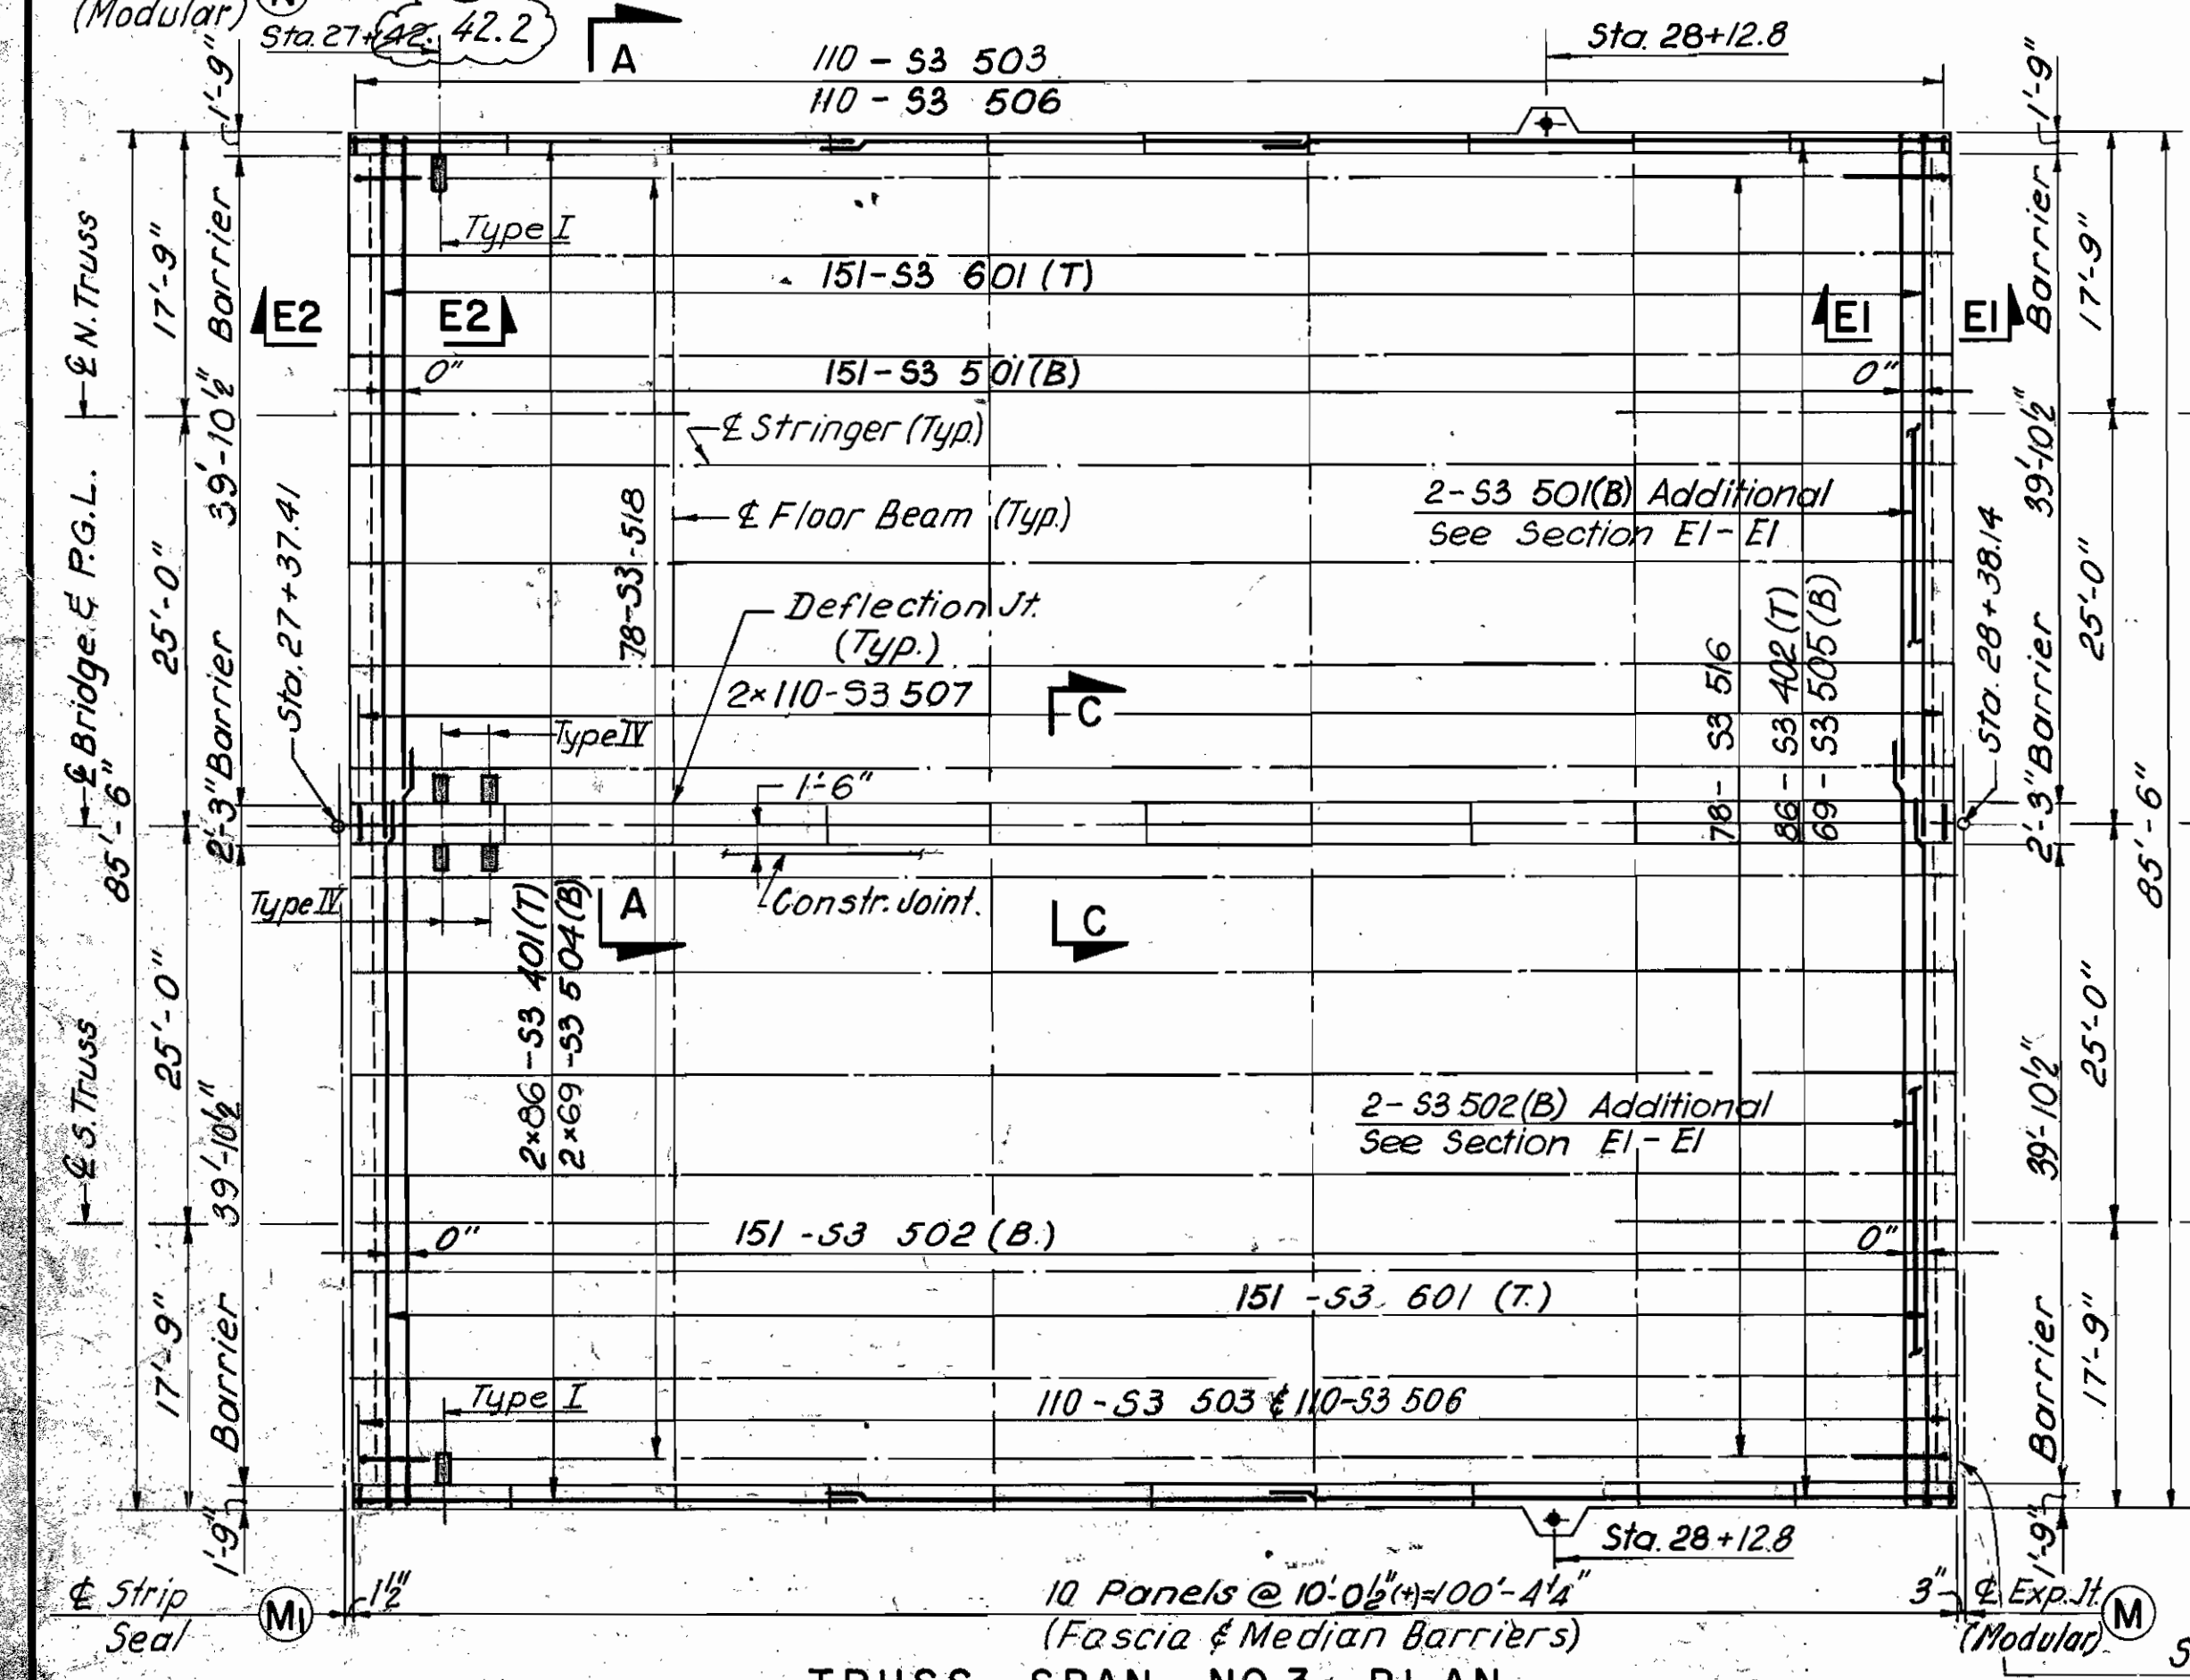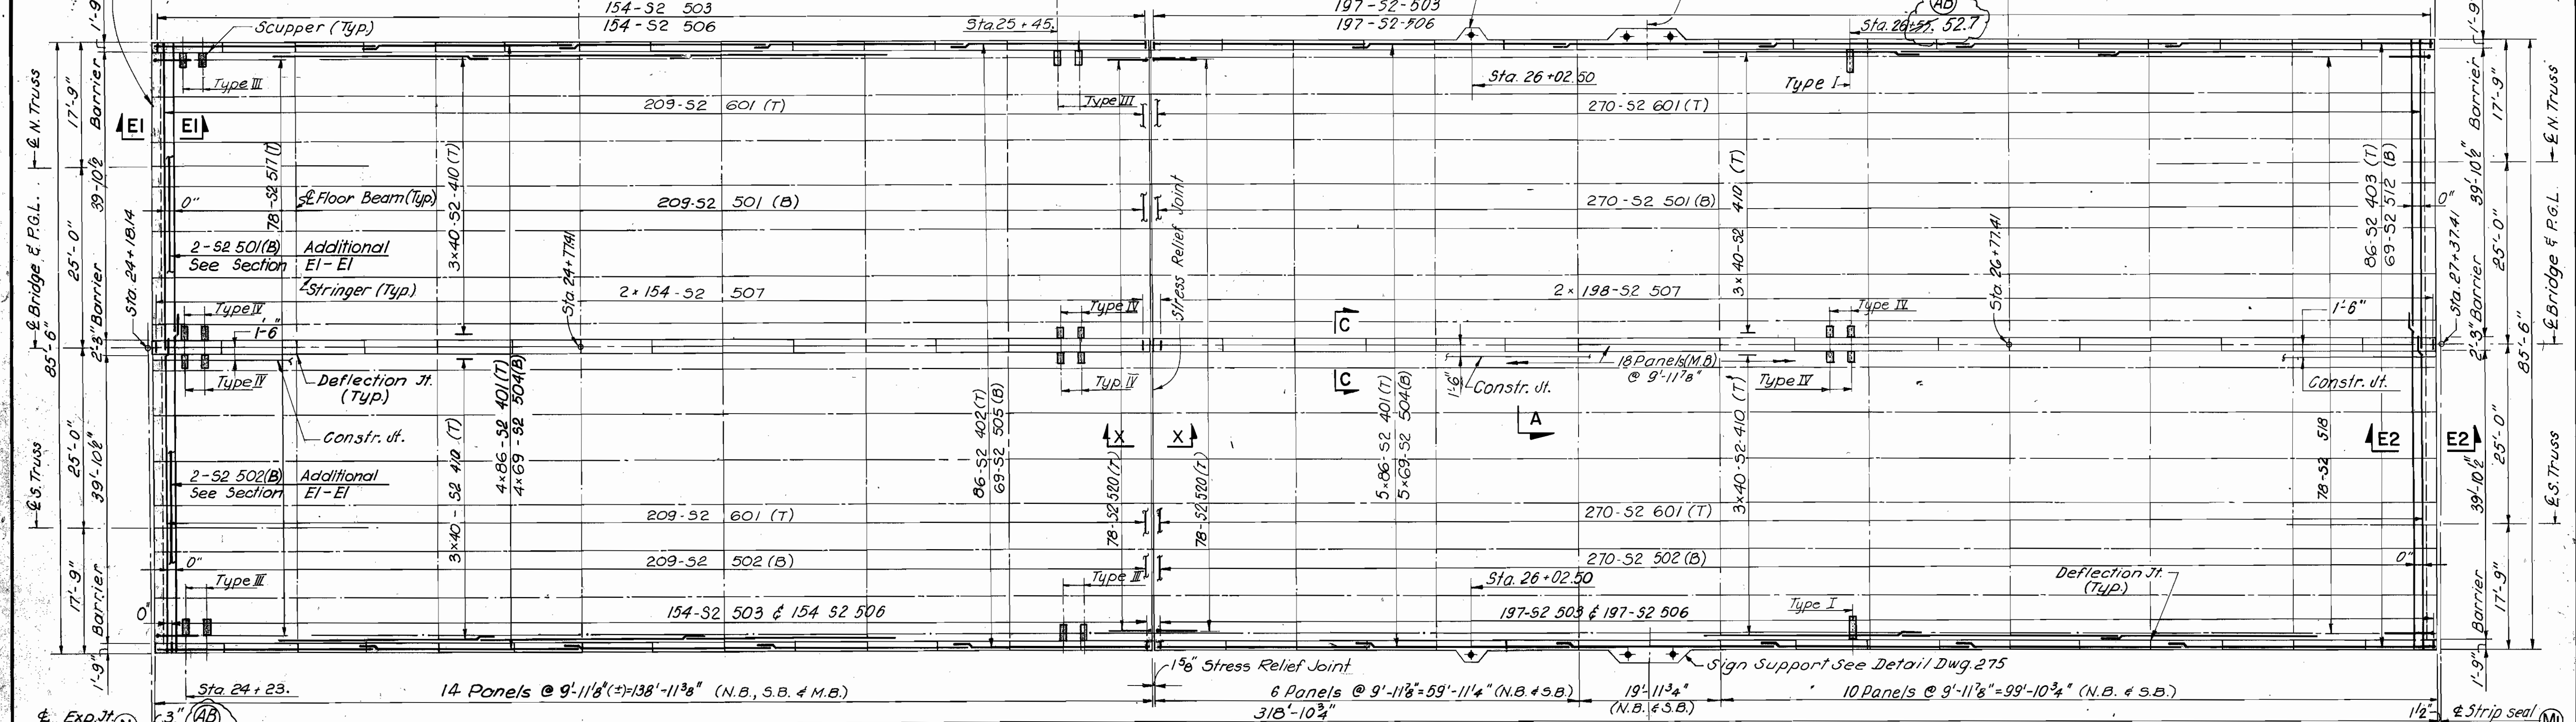


TRUSS SPAN NO. 2 - PLAN

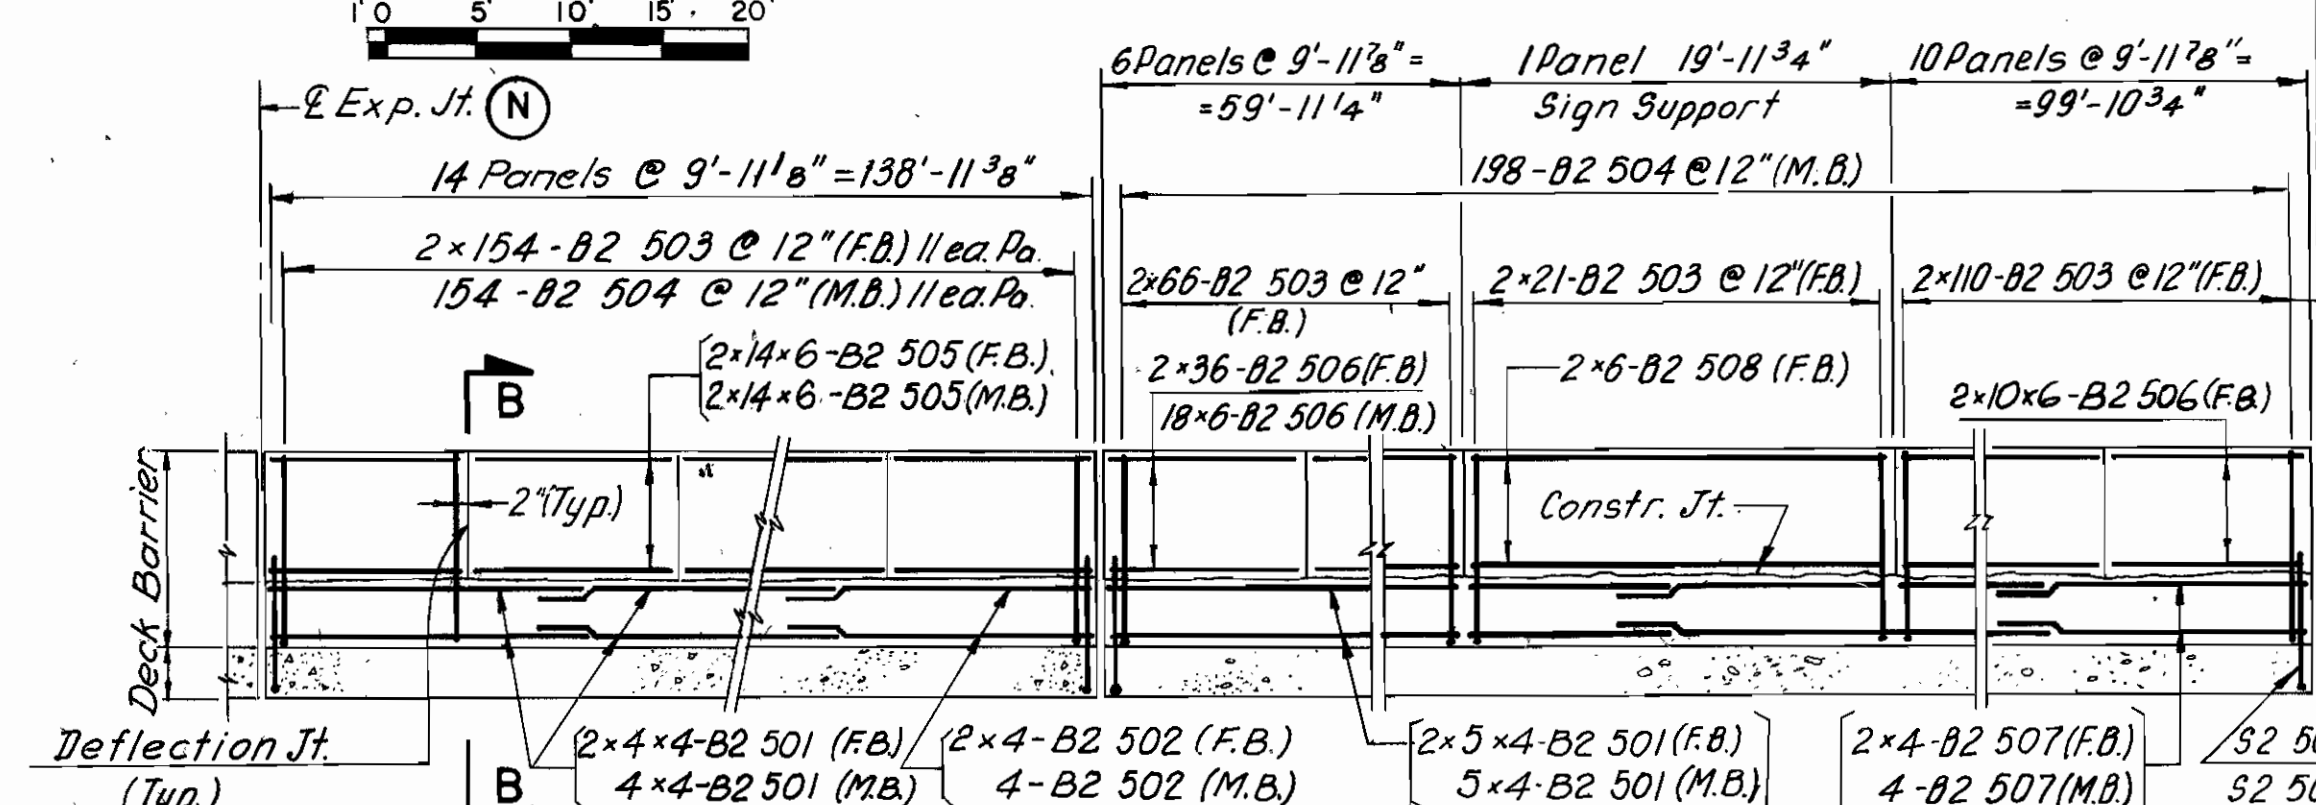


BARRIER DETAILS SPAN NO. 2

NOTE 1  
Field cut and bend  
the bars to clear boxes

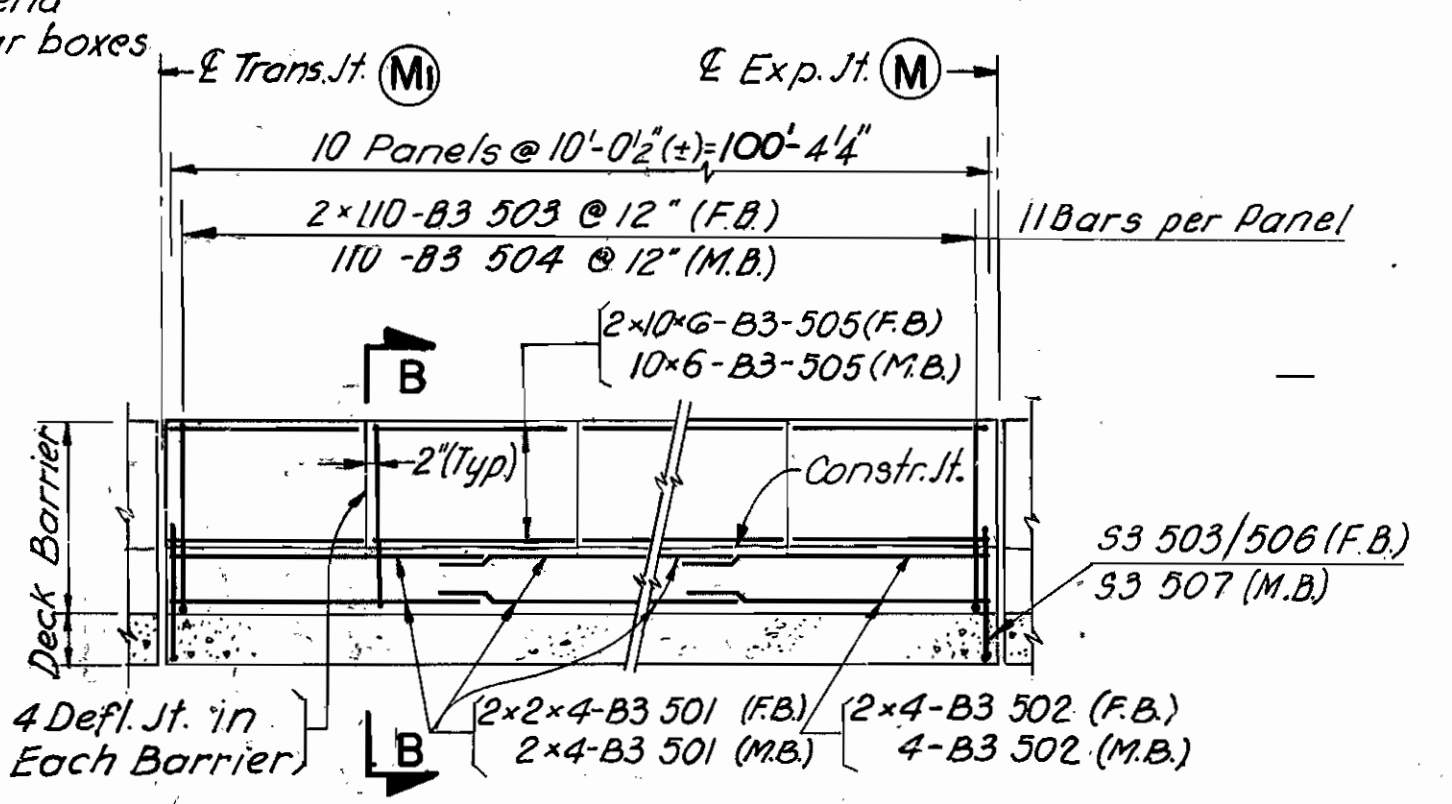

BARRIER DETAILS SPAN NO. 3

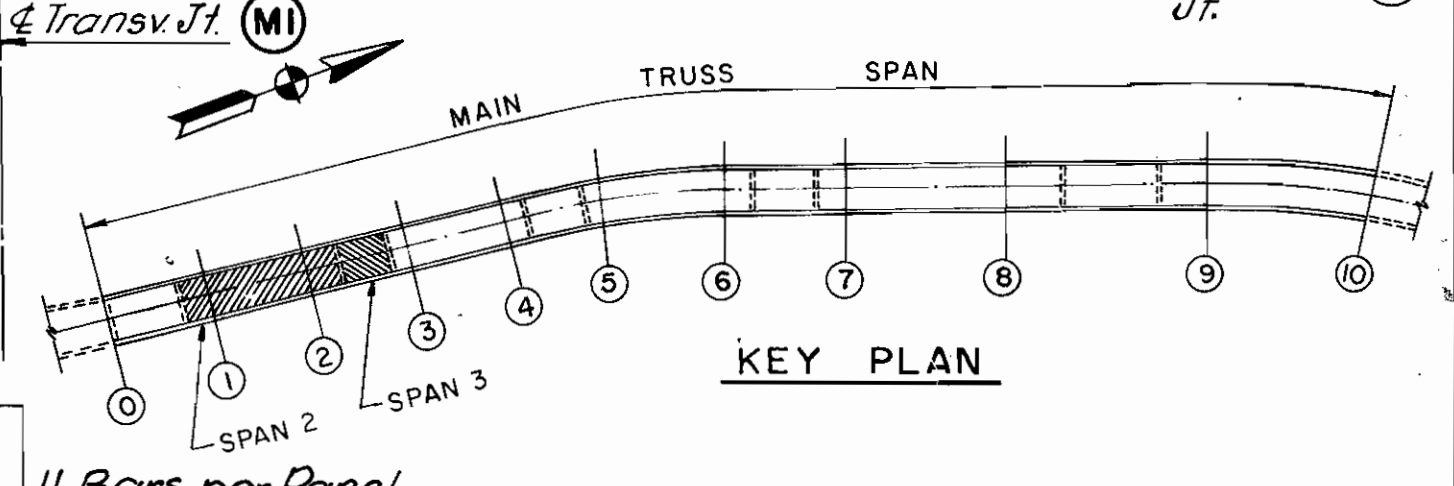

REFERENCES:

For References and Notes	268
Sections A-A, B-B, C-C	268
Sections E1-E1, E2-E2 & X-X	276
Exp. Joints	278
Bar Lists	283 & 284

DWG. NO. 283 & 284

As Built (AB)

PAVLO ENGINEERING CO., P.C.  
NEW YORK, NEW YORK

CUYAHOGA COUNTY ENGINEER  
CLEVELAND OHIO

**MAIN AVENUE BRIDGE**  
CITY OF CLEVELAND  
BRIDGE OVER THE CUYAHOGA RIVER VALLEY

MAIN TRUSS SPANS - 2 AND 3.  
DECK SLAB REINFORCEMENT

BRIDGE NO. 193 REPORT NO. 7119 DATE Oct. 25, 1983

**NO. B-136**

DESIGN	DRAWN	CHECKED	REVISED TO AS BUILT
A.S./B.P.	T.C.	E.G.	AS BUILT 2/94






TRUSS SPAN NO. 3 - PLAN



Support Boxes  
for Exp. Jt. Not Shown See Dwg.  
278 See also Note 1 above.

N.T.S.

CUYAHOGA COUNTY  
CUY-2-14.66

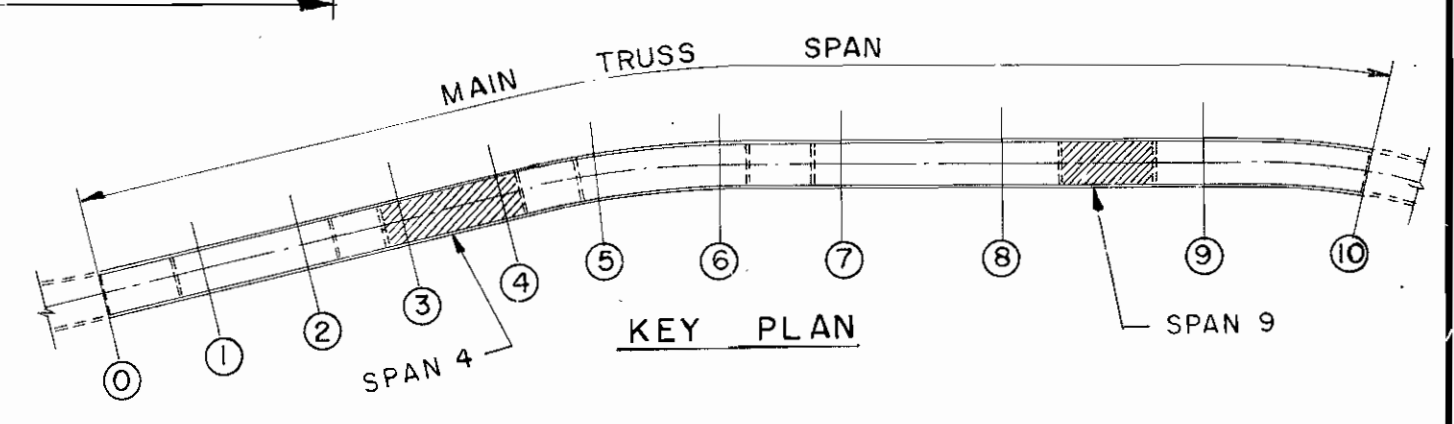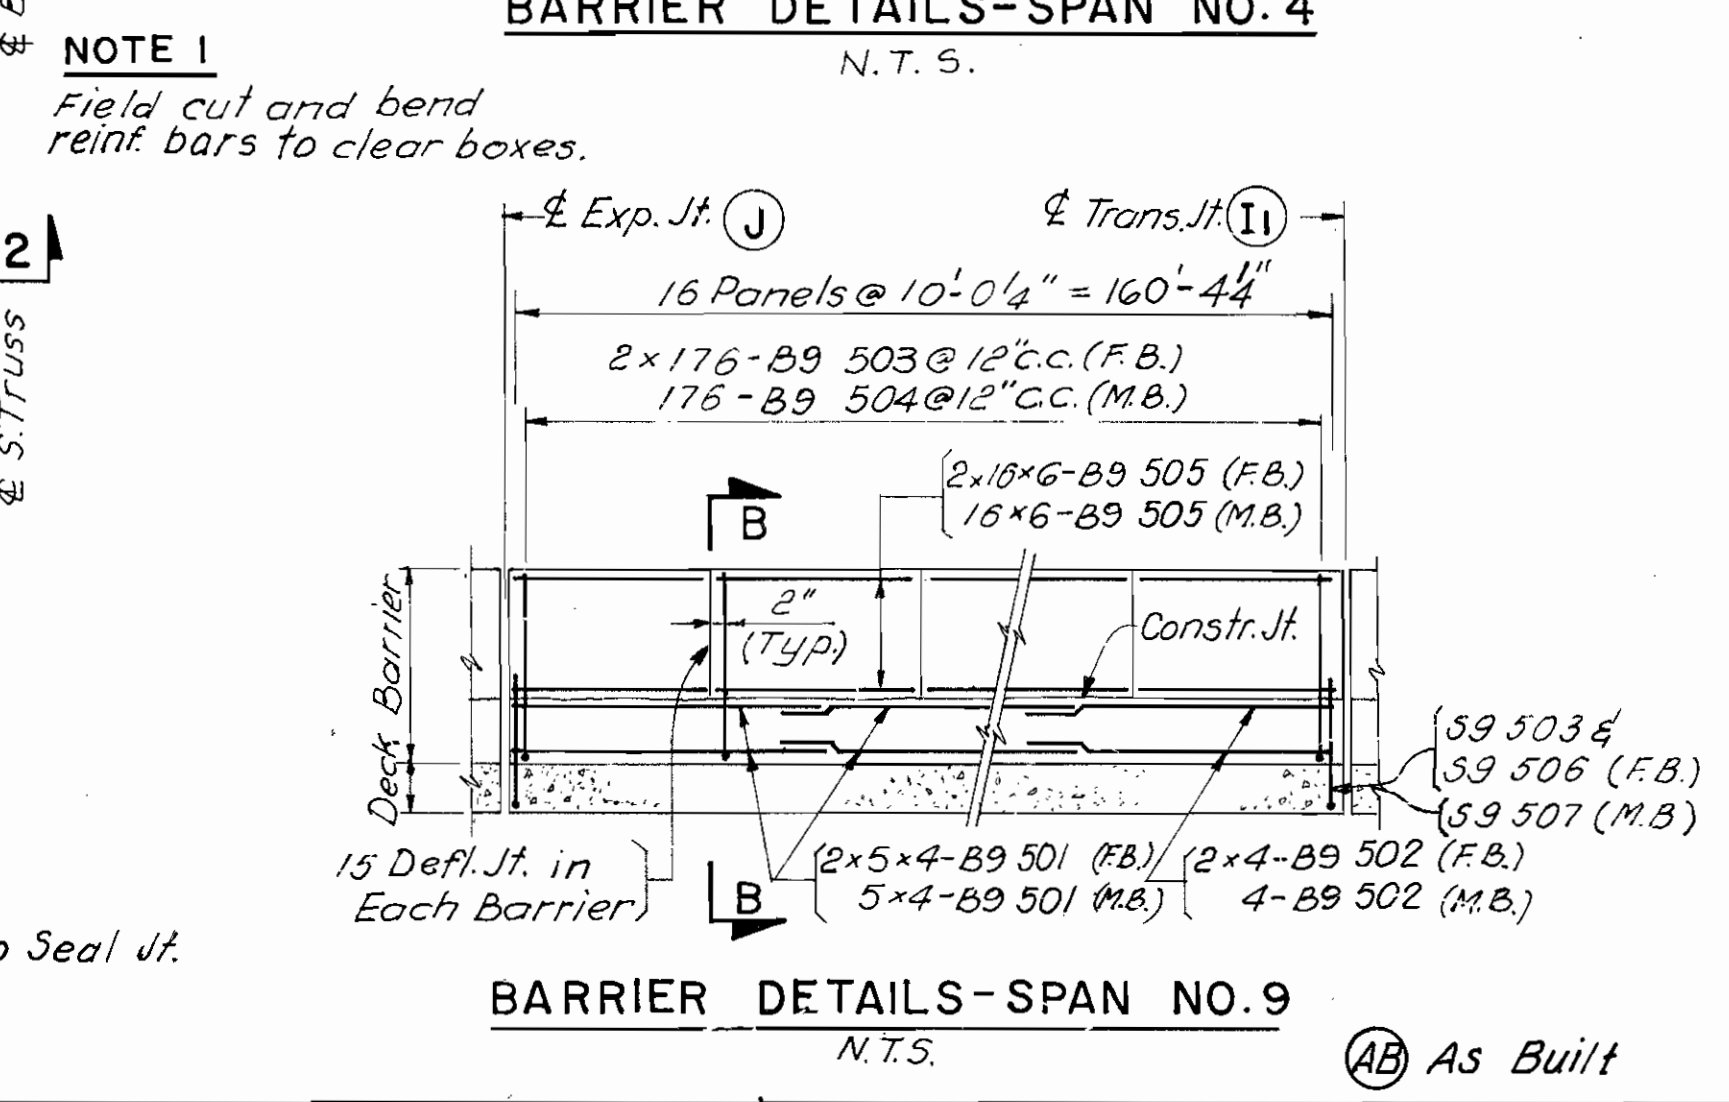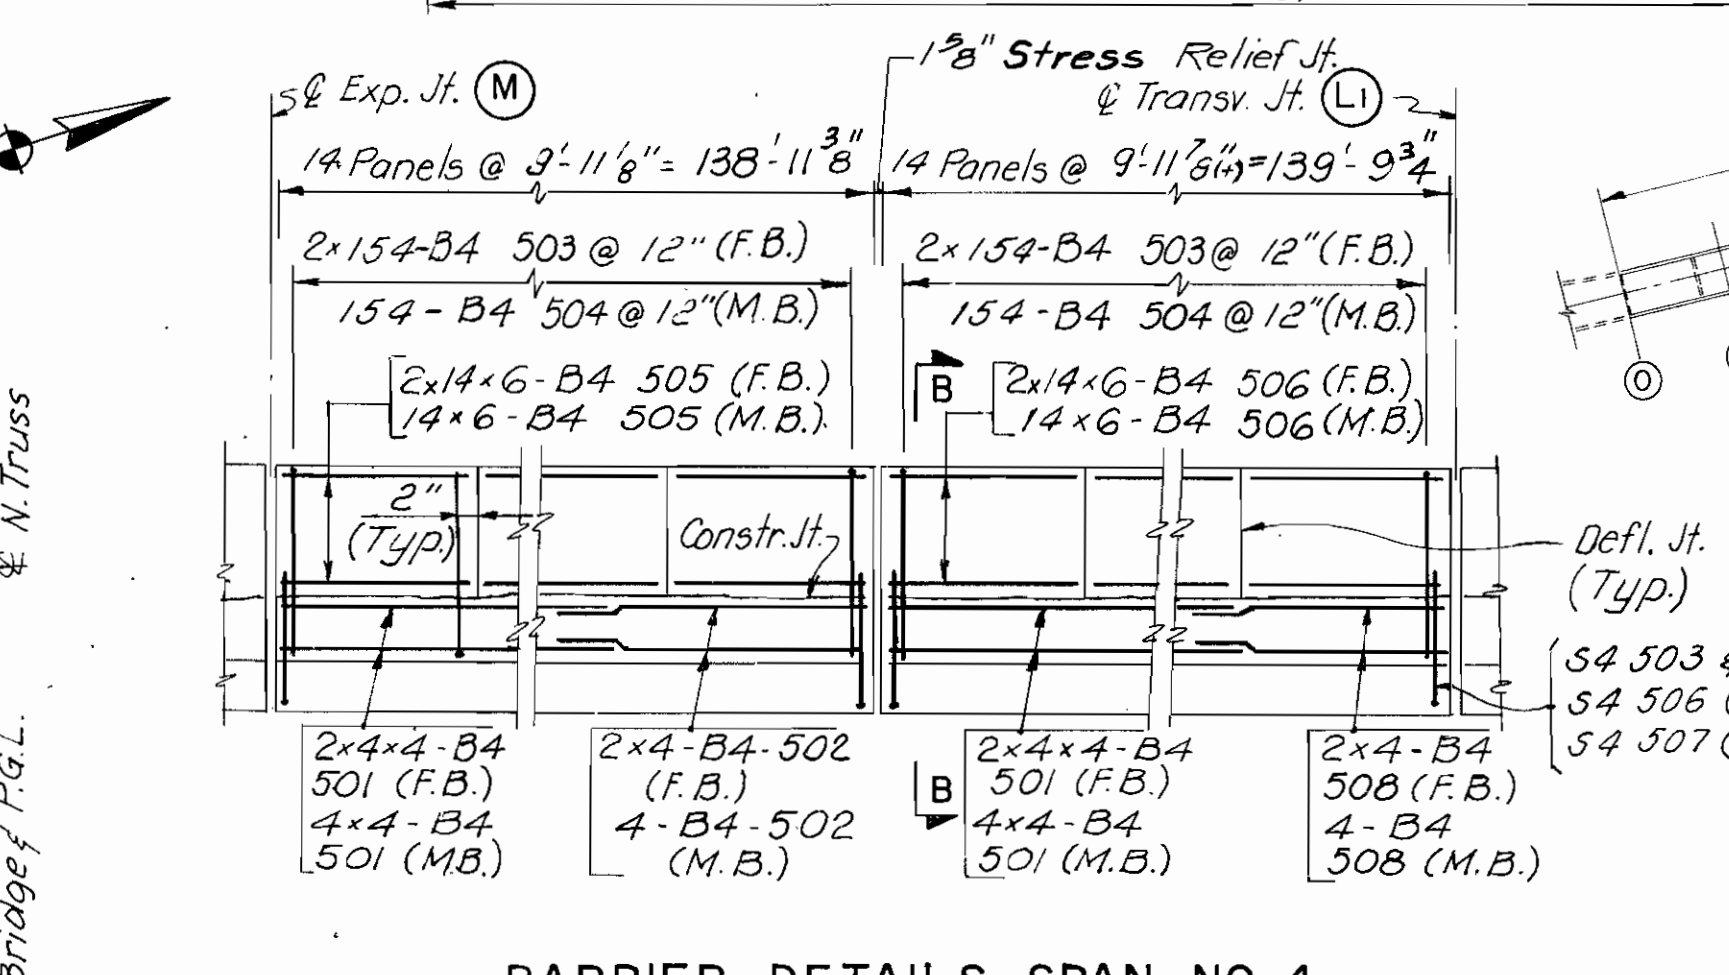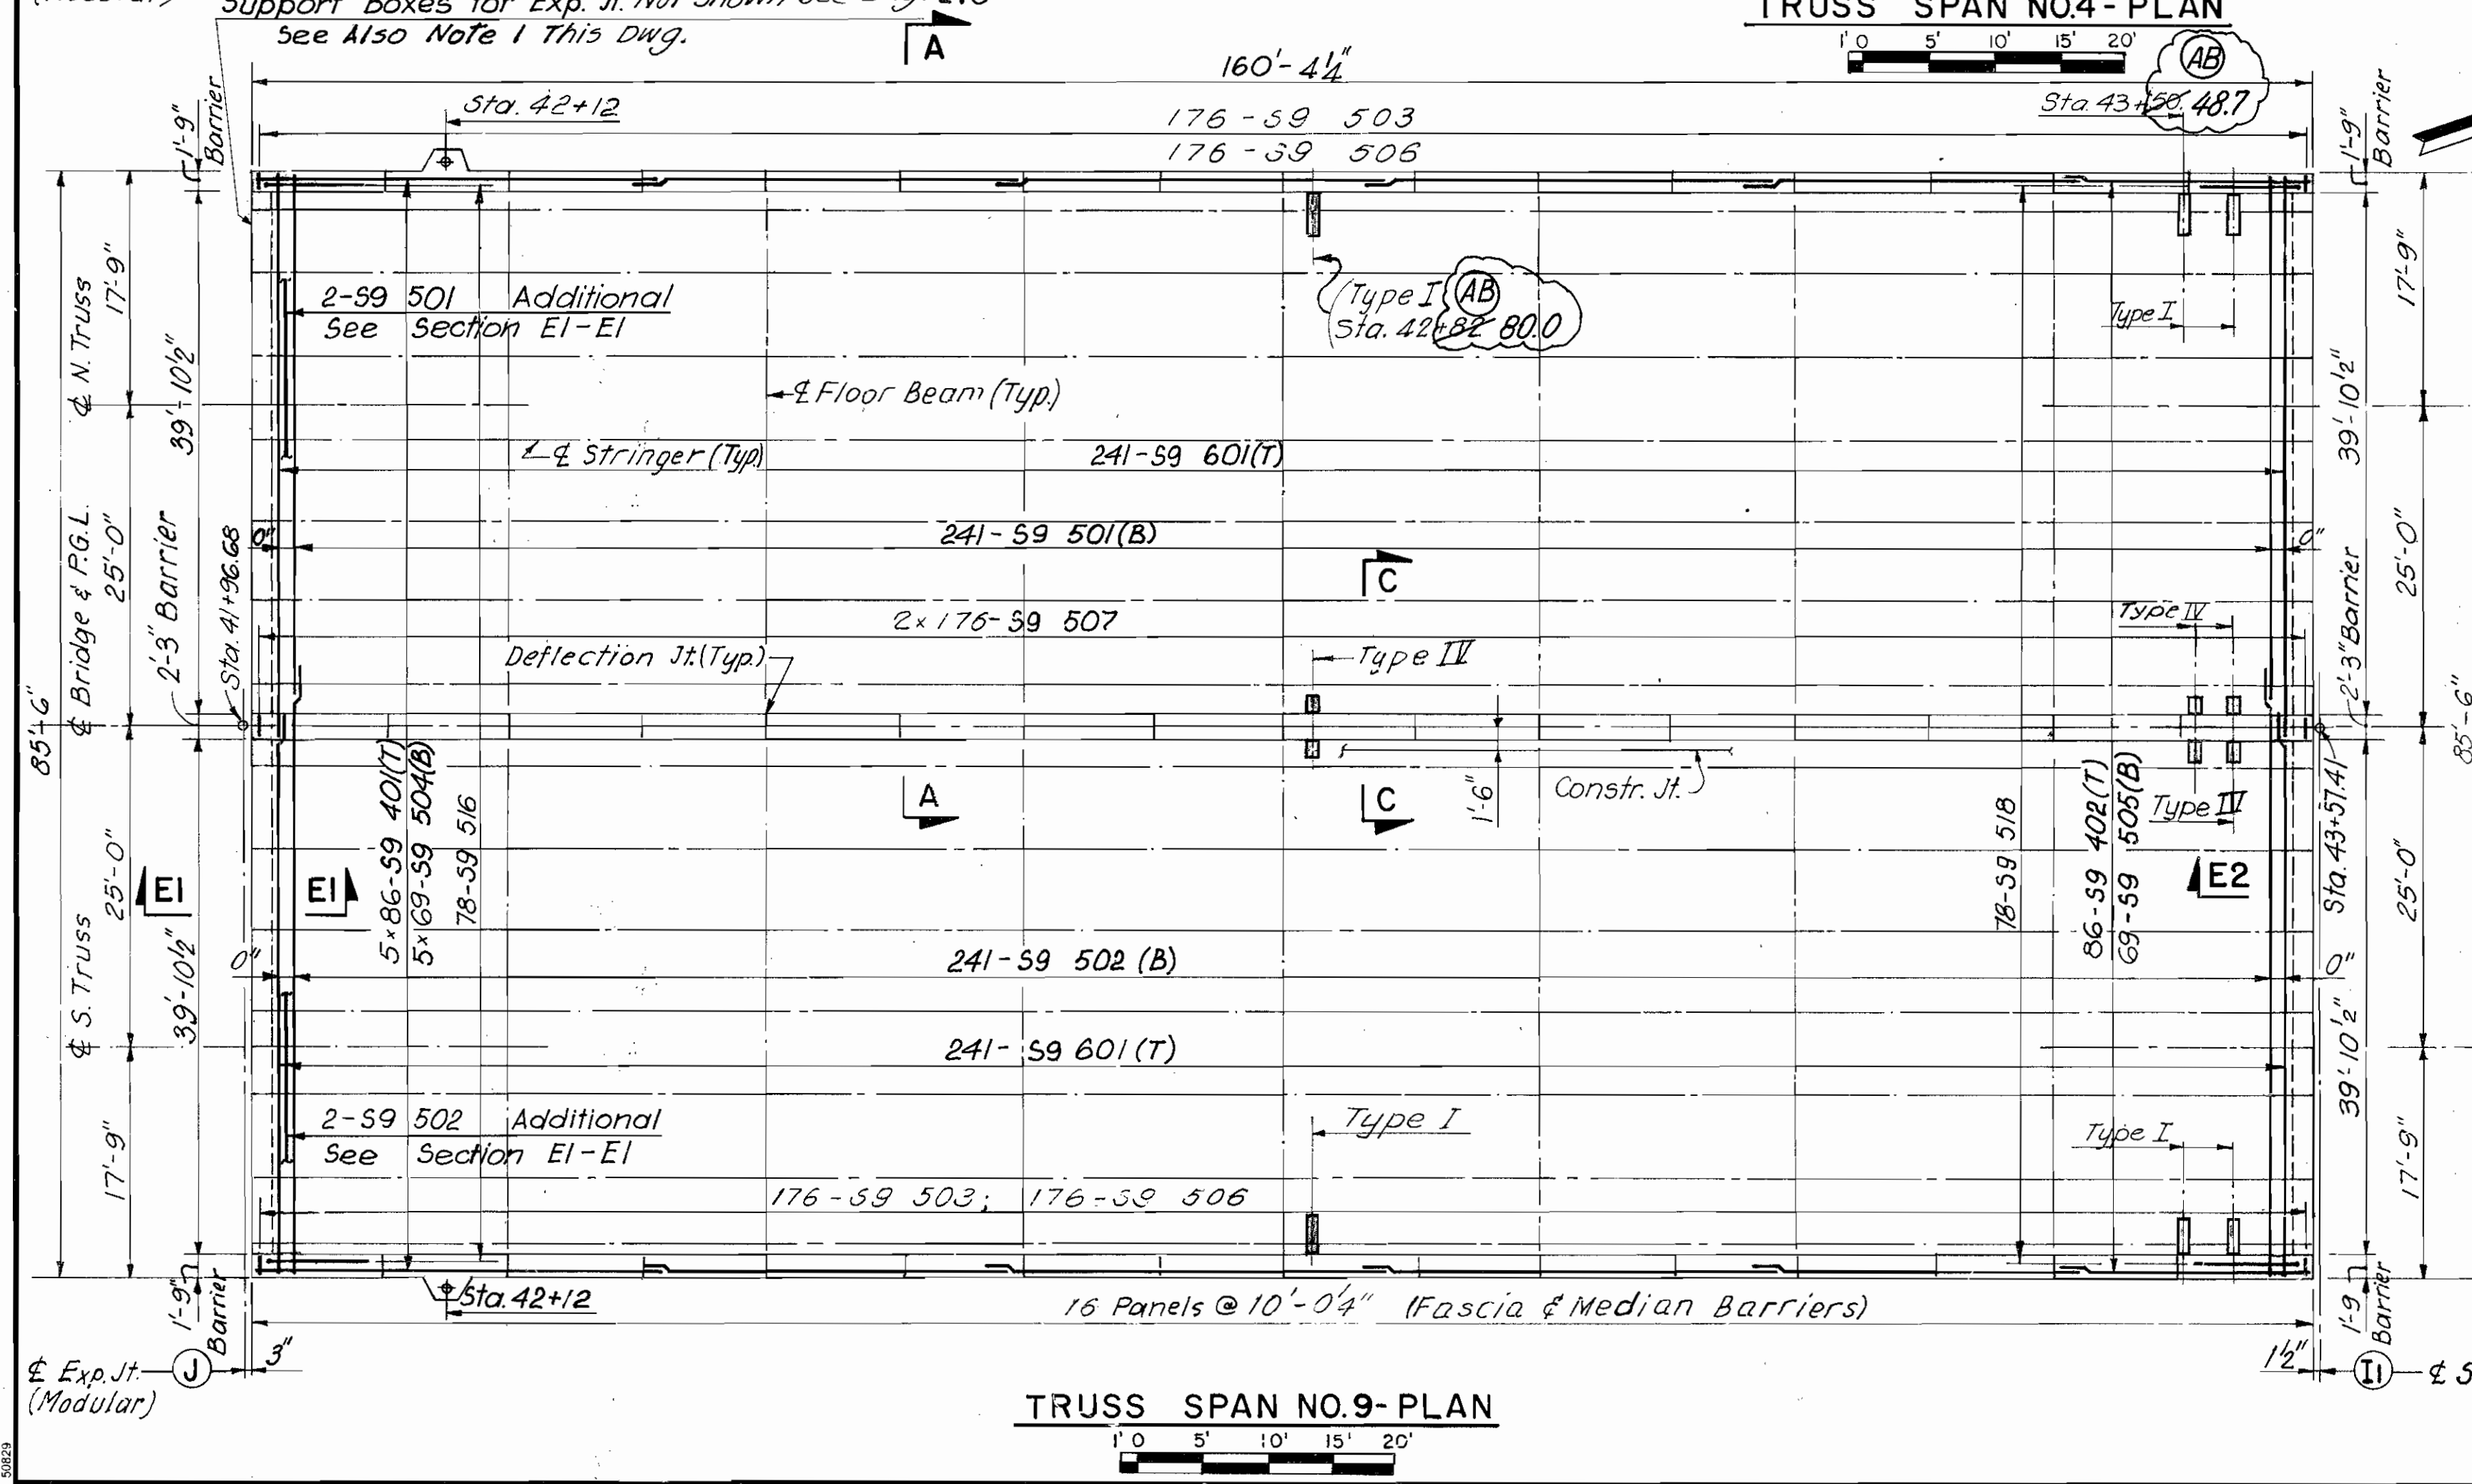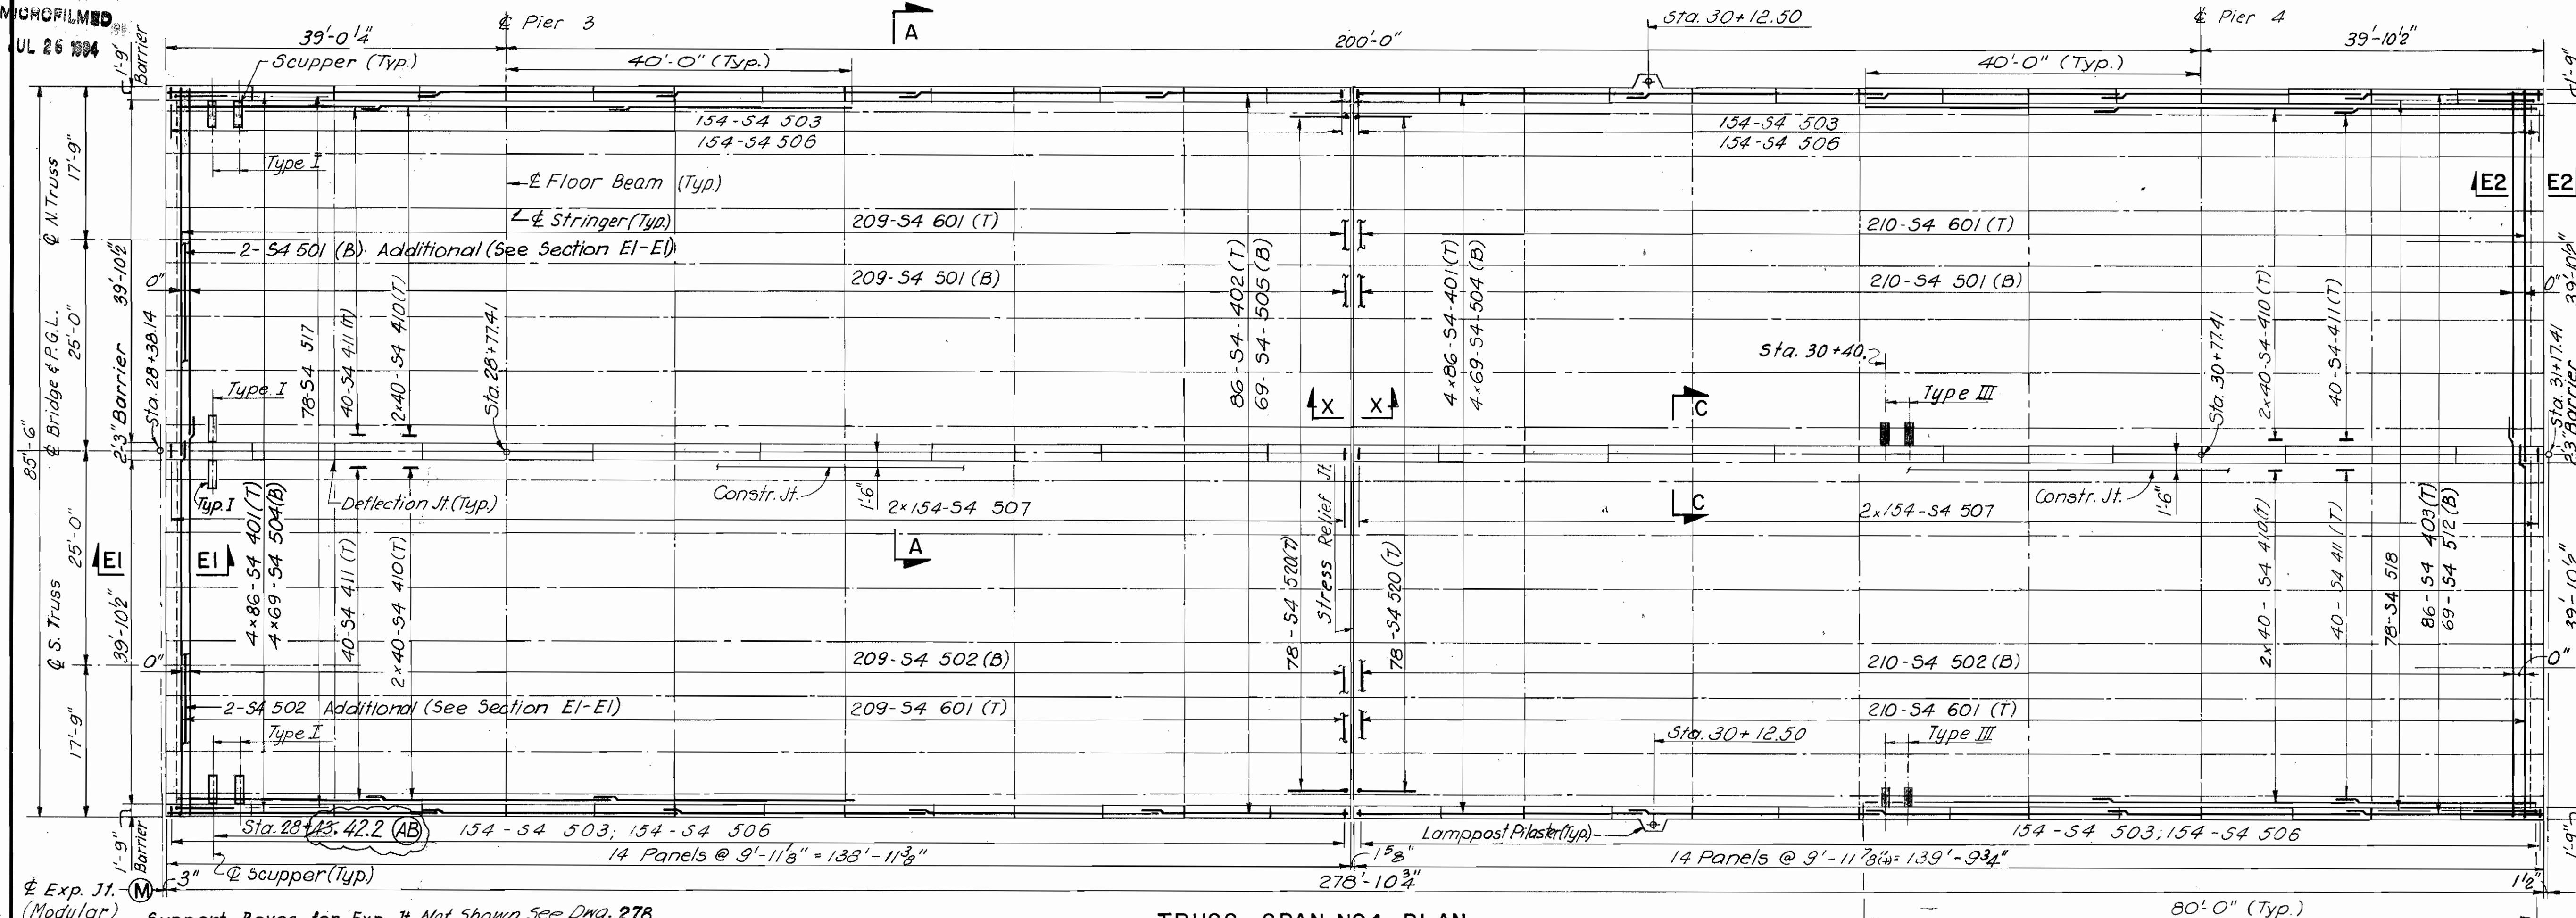

**REFERENCES:**

REFERENCE	DWG. No.
Exp. Joint	278
For References and Notes	268
Sections A-A, B-B & C-C	268
Sections EI-EI, E2-E2 & X-X	276
Bars List Span 4	284
Bars List Span 9	287

PAVLO ENGINEERING CO., P.C.  
NEW YORK, NEW YORK

**CUYAHOGA COUNTY ENGINEER**  
CLEVELAND OHIO

**MAIN AVENUE BRIDGE**  
CITY OF CLEVELAND  
BRIDGE OVER THE CUYAHOGA RIVER VALLEY

MAIN TRUSS SPANS - 4 AND 9  
**DECK SLAB REINFORCEMENT**

BRIDGE NO. 193    REPORT NO. 7119    DATE Oct. 25, 1989

**NO. B-136**

DESIGN A.S./B.P.	DRAWN T.C.	CHECKED E.G.	REVISED TO AS BUILT AS BUILT 2/94
---------------------	---------------	-----------------	--------------------------------------

270  
89

**NOTE 1**  
Field cut and bend  
reinf. bars to clear boxes.


(AB) As Built

MICROFILMED  
JUL 26 1984



CUYAHOGA COUNTY  
CUY-2-14.66

FHWA REGION	STATE	PROJECT
5	OHIO	BHF-73(51)


277  
547

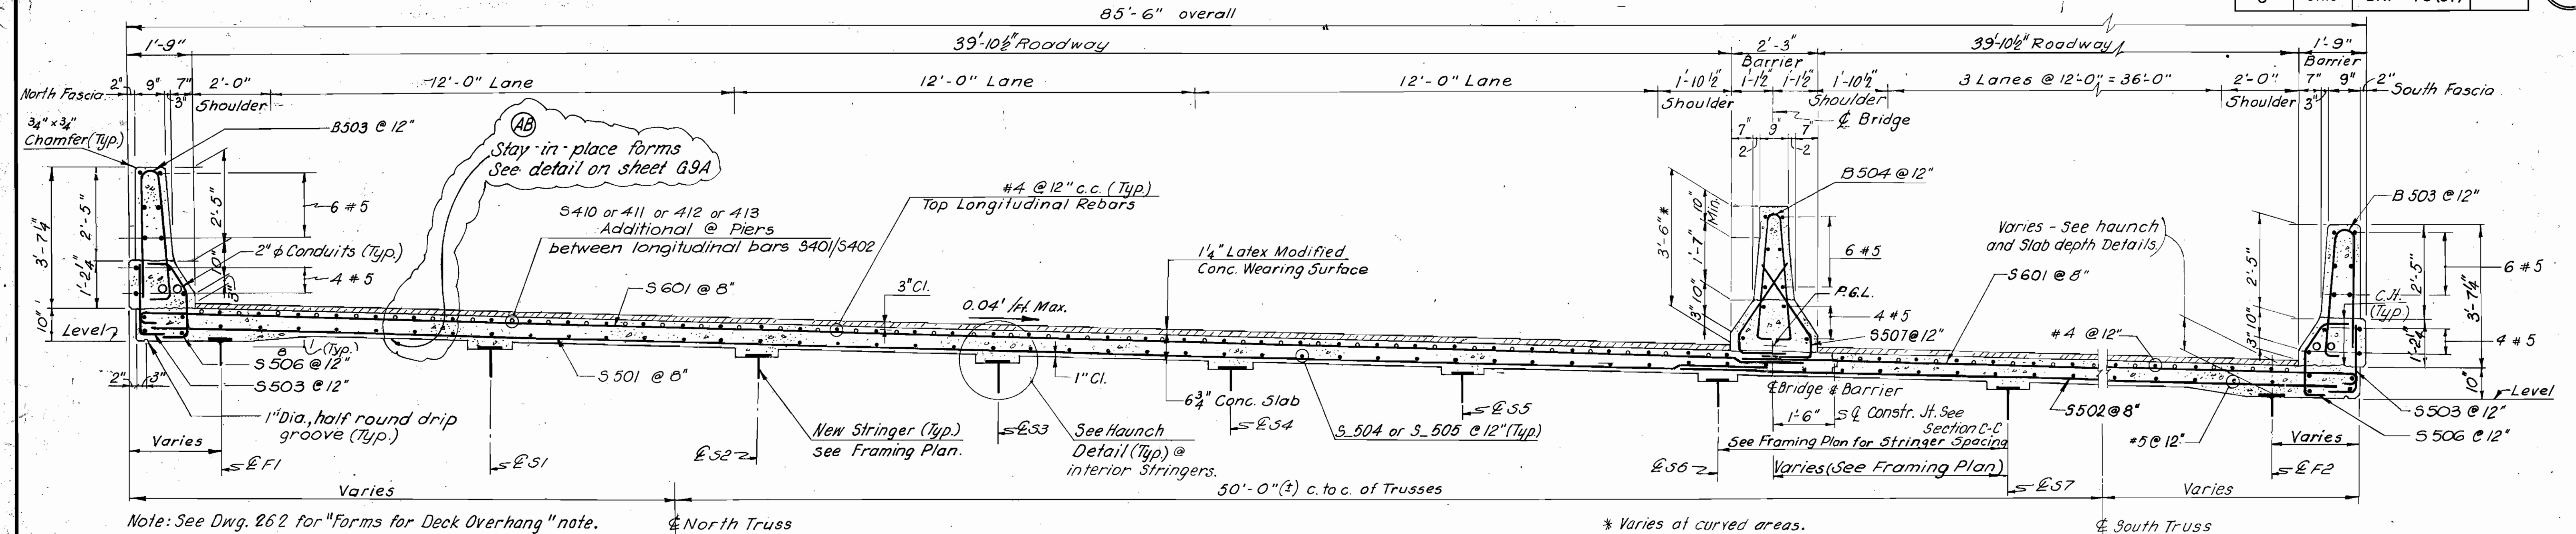


SECTION A1-A1 (Looking East)

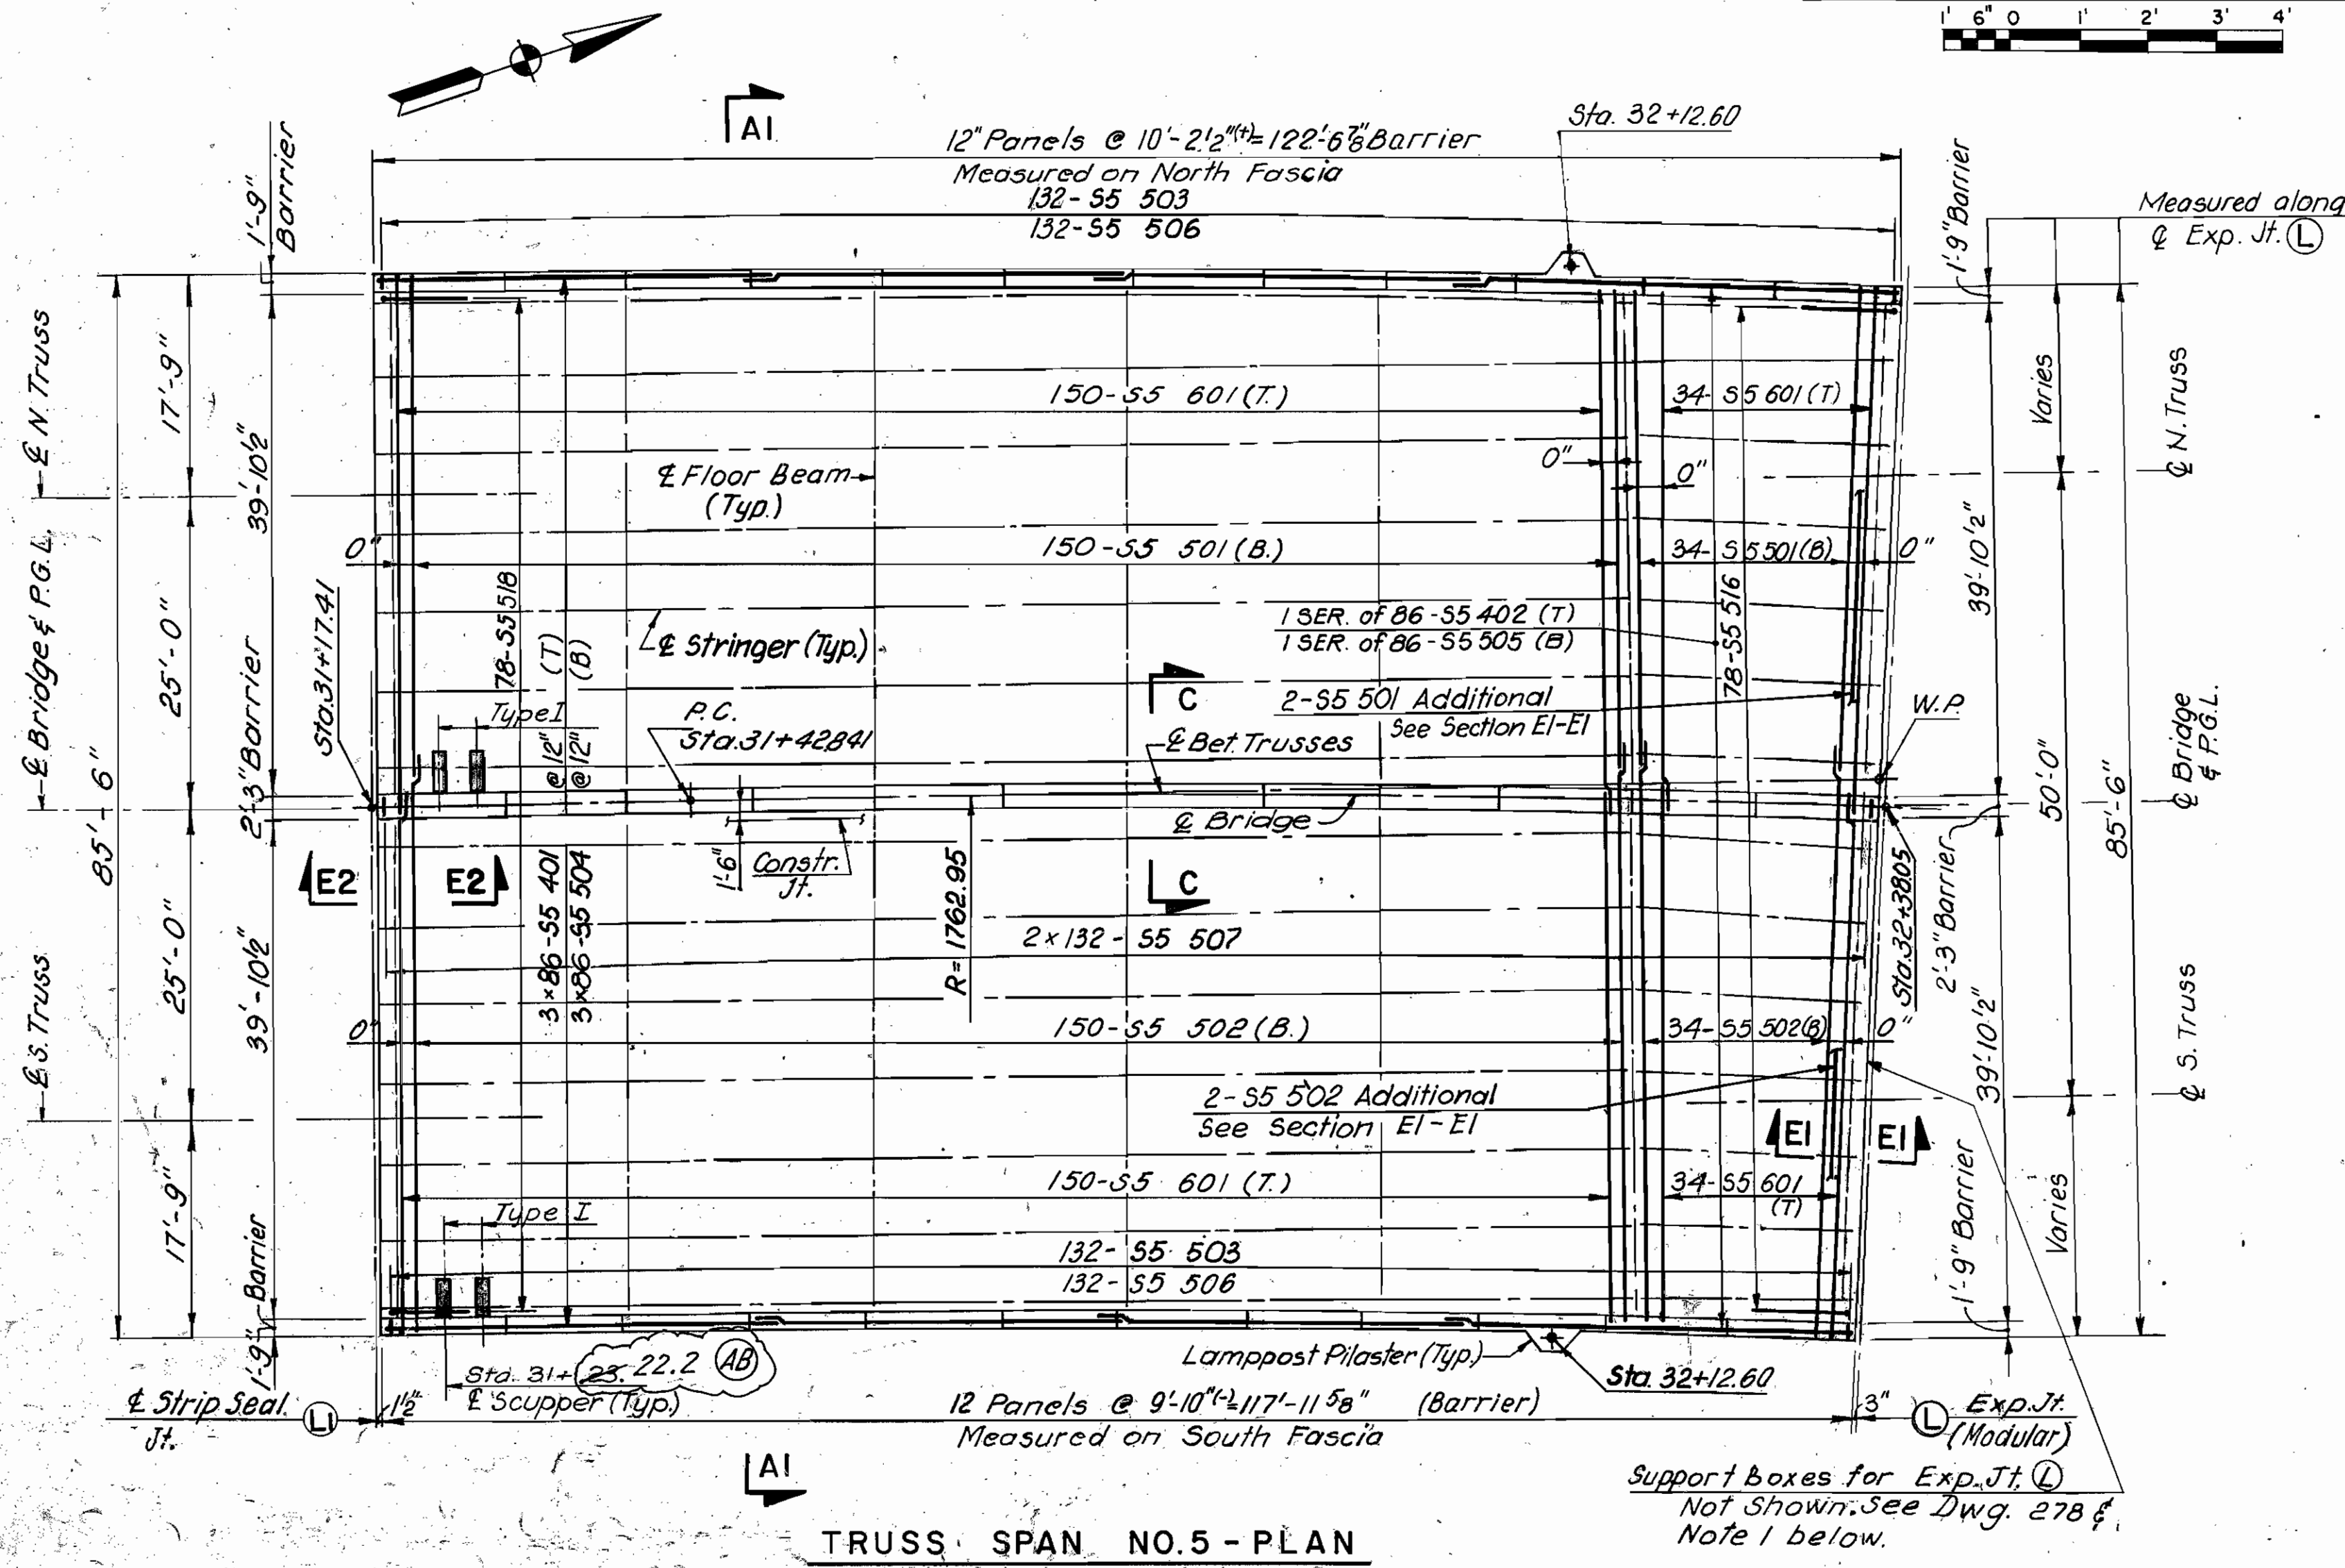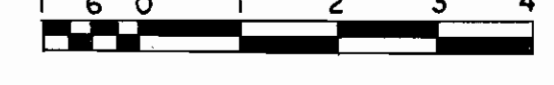

TRUSS SPAN NO. 5 - PLAN

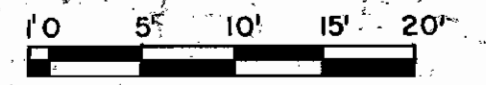


NOTE 1:  
Field cut and bend reinf. bars to clear boxes.

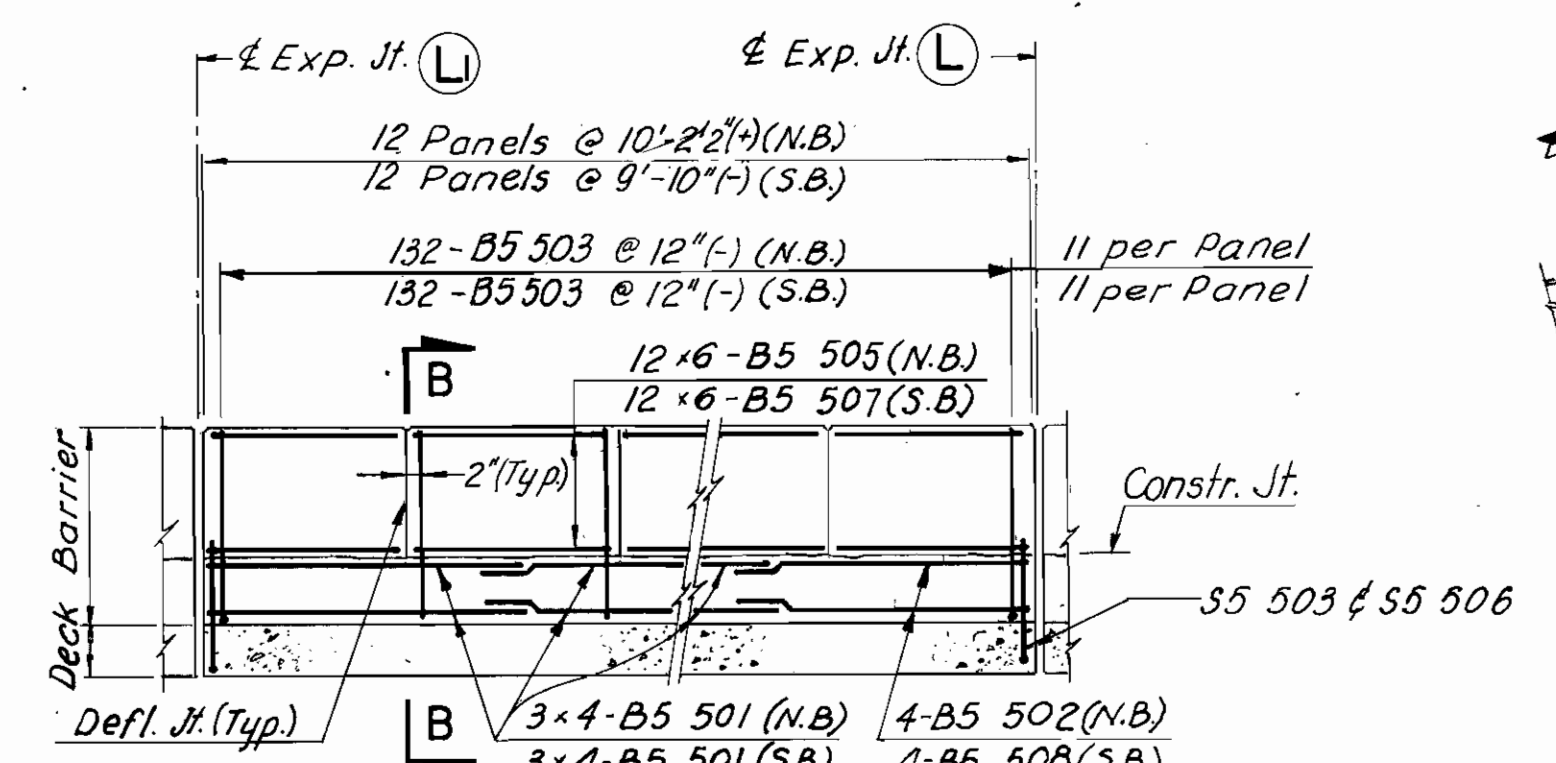


FASCIA BARRIER


BAR SIZE	MIN. LAP
# 4	1'-10"
# 5	2'-3"
# 6	2'-8"

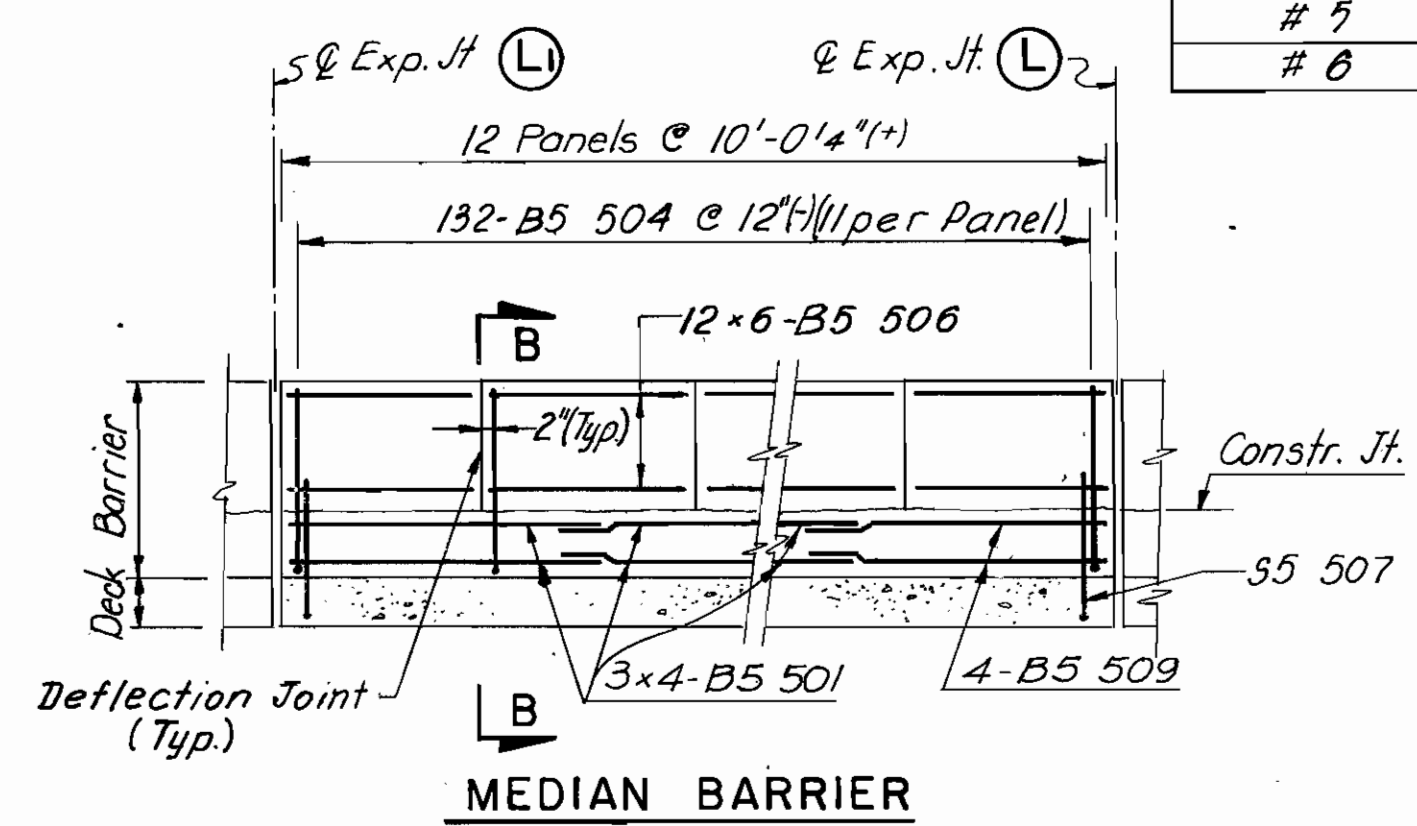

MEDIAN BARRIER

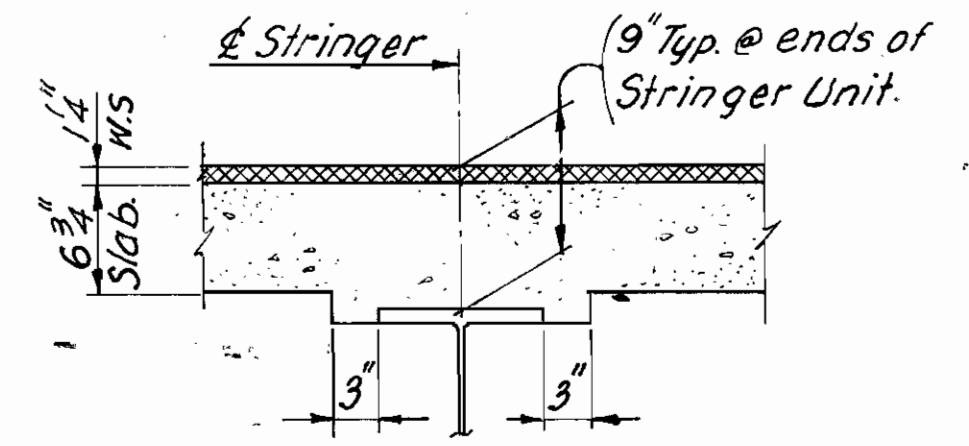

HAUNCH DETAIL

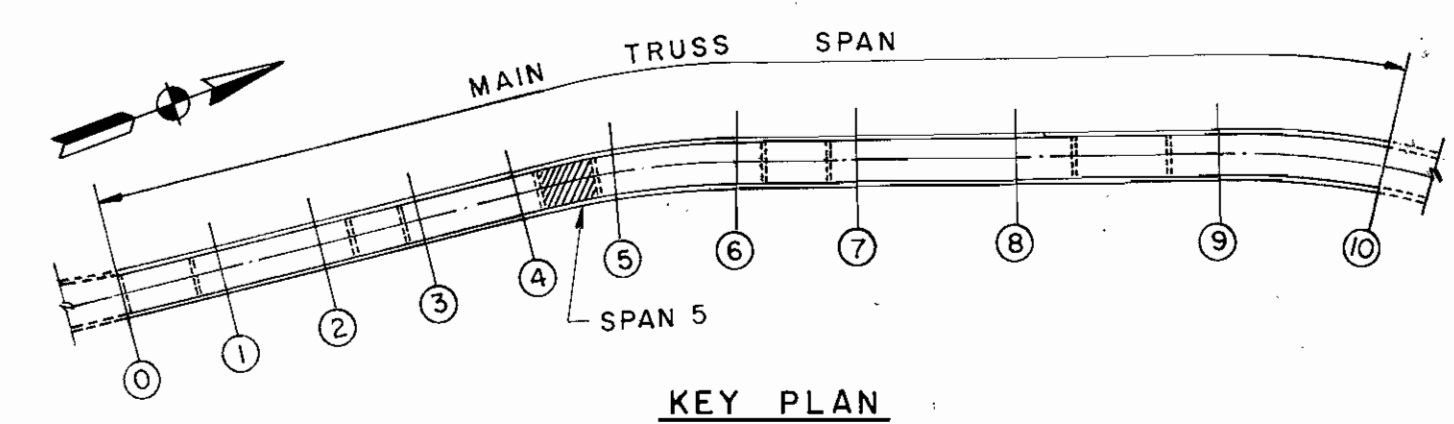

REFERENCES

REFERENCES	DWG. NO.
Notes and References	268
Sections A-A, B-B & C-C	268
Sections E1-E1 & E2-E2	276
Exp. Joint	278
Bar List Span 5	285
Haunch and Slab depth Details	262
Exist. & Proposed Framing Plan	212
Pilaster Details	668
Haunch and Slab Notes	288
Stay-in-place forms (AB)	G9A

(AB) As Built

PAVLO ENGINEERING CO., P.C.  
NEW YORK, NEW YORK

CUYAHOGA COUNTY ENGINEER  
CLEVELAND OHIO

**MAIN AVENUE BRIDGE**  
CITY OF CLEVELAND  
BRIDGE OVER THE CUYAHOGA RIVER VALLEY

MAIN TRUSS SPAN - 5  
**DECK SLAB REINFORCEMENT**

BRIDGE NO. 193 REPORT NO. 7119 DATE Oct. 25, 1989

**NO. B-136**

DESIGN A.S./B.P. DRAWN T.C. CHECKED E.G. REVISED TO AS BUILT AS BUILT 2/94


Support Boxes for Exp. Joint Not Shown See Dwg. 278 See also Note this Sheet.

MICROFILMED JUL 26 1984


FHWA REGION	STATE	PROJECT
5	OHIO	BHF-73(51)

278  
547


CUYAHOGA COUNTY  
CUY-2-14.66

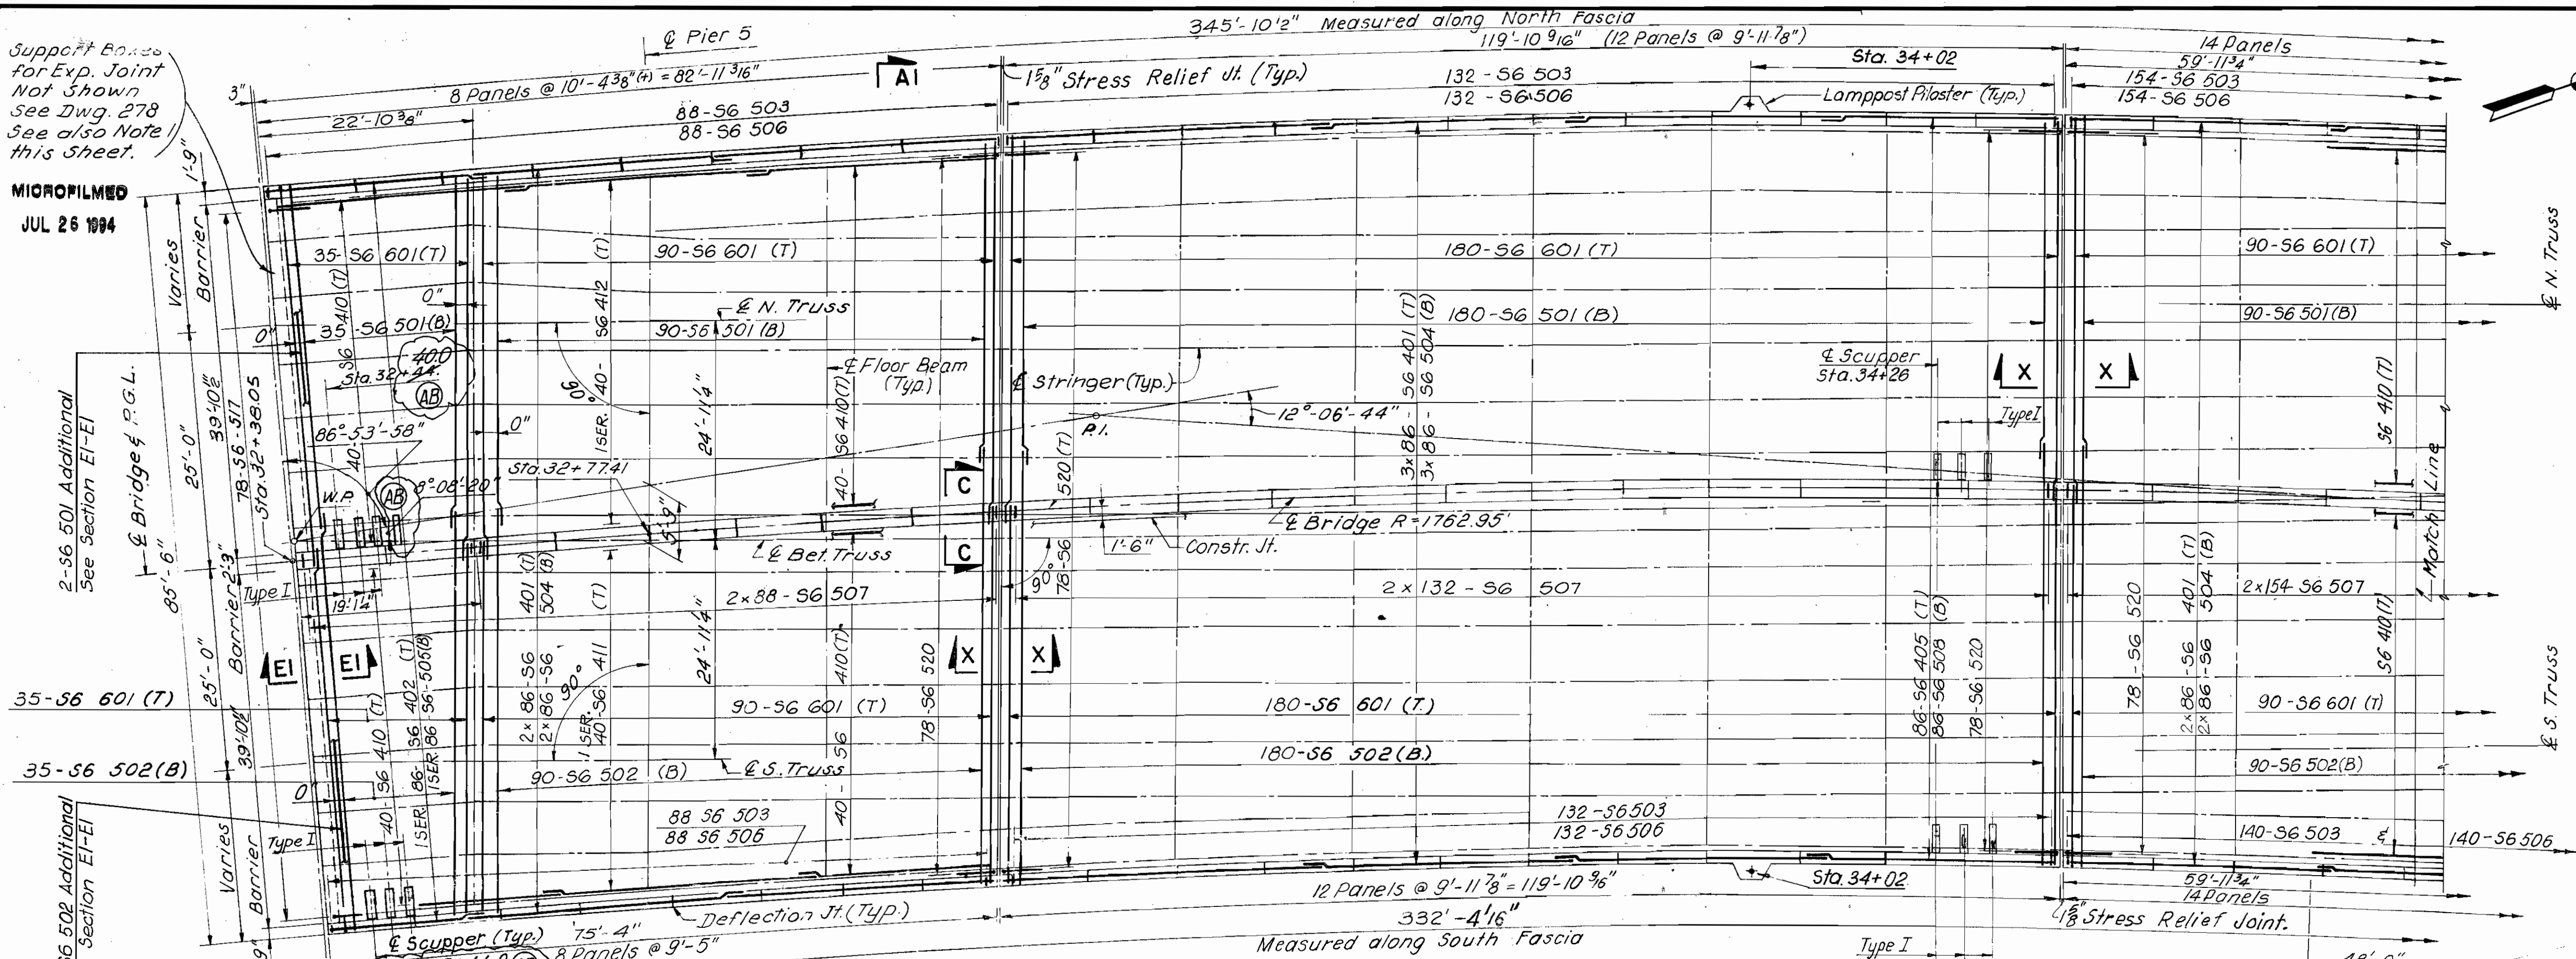


TRUSS SPAN NO. 6 - PART PLAN

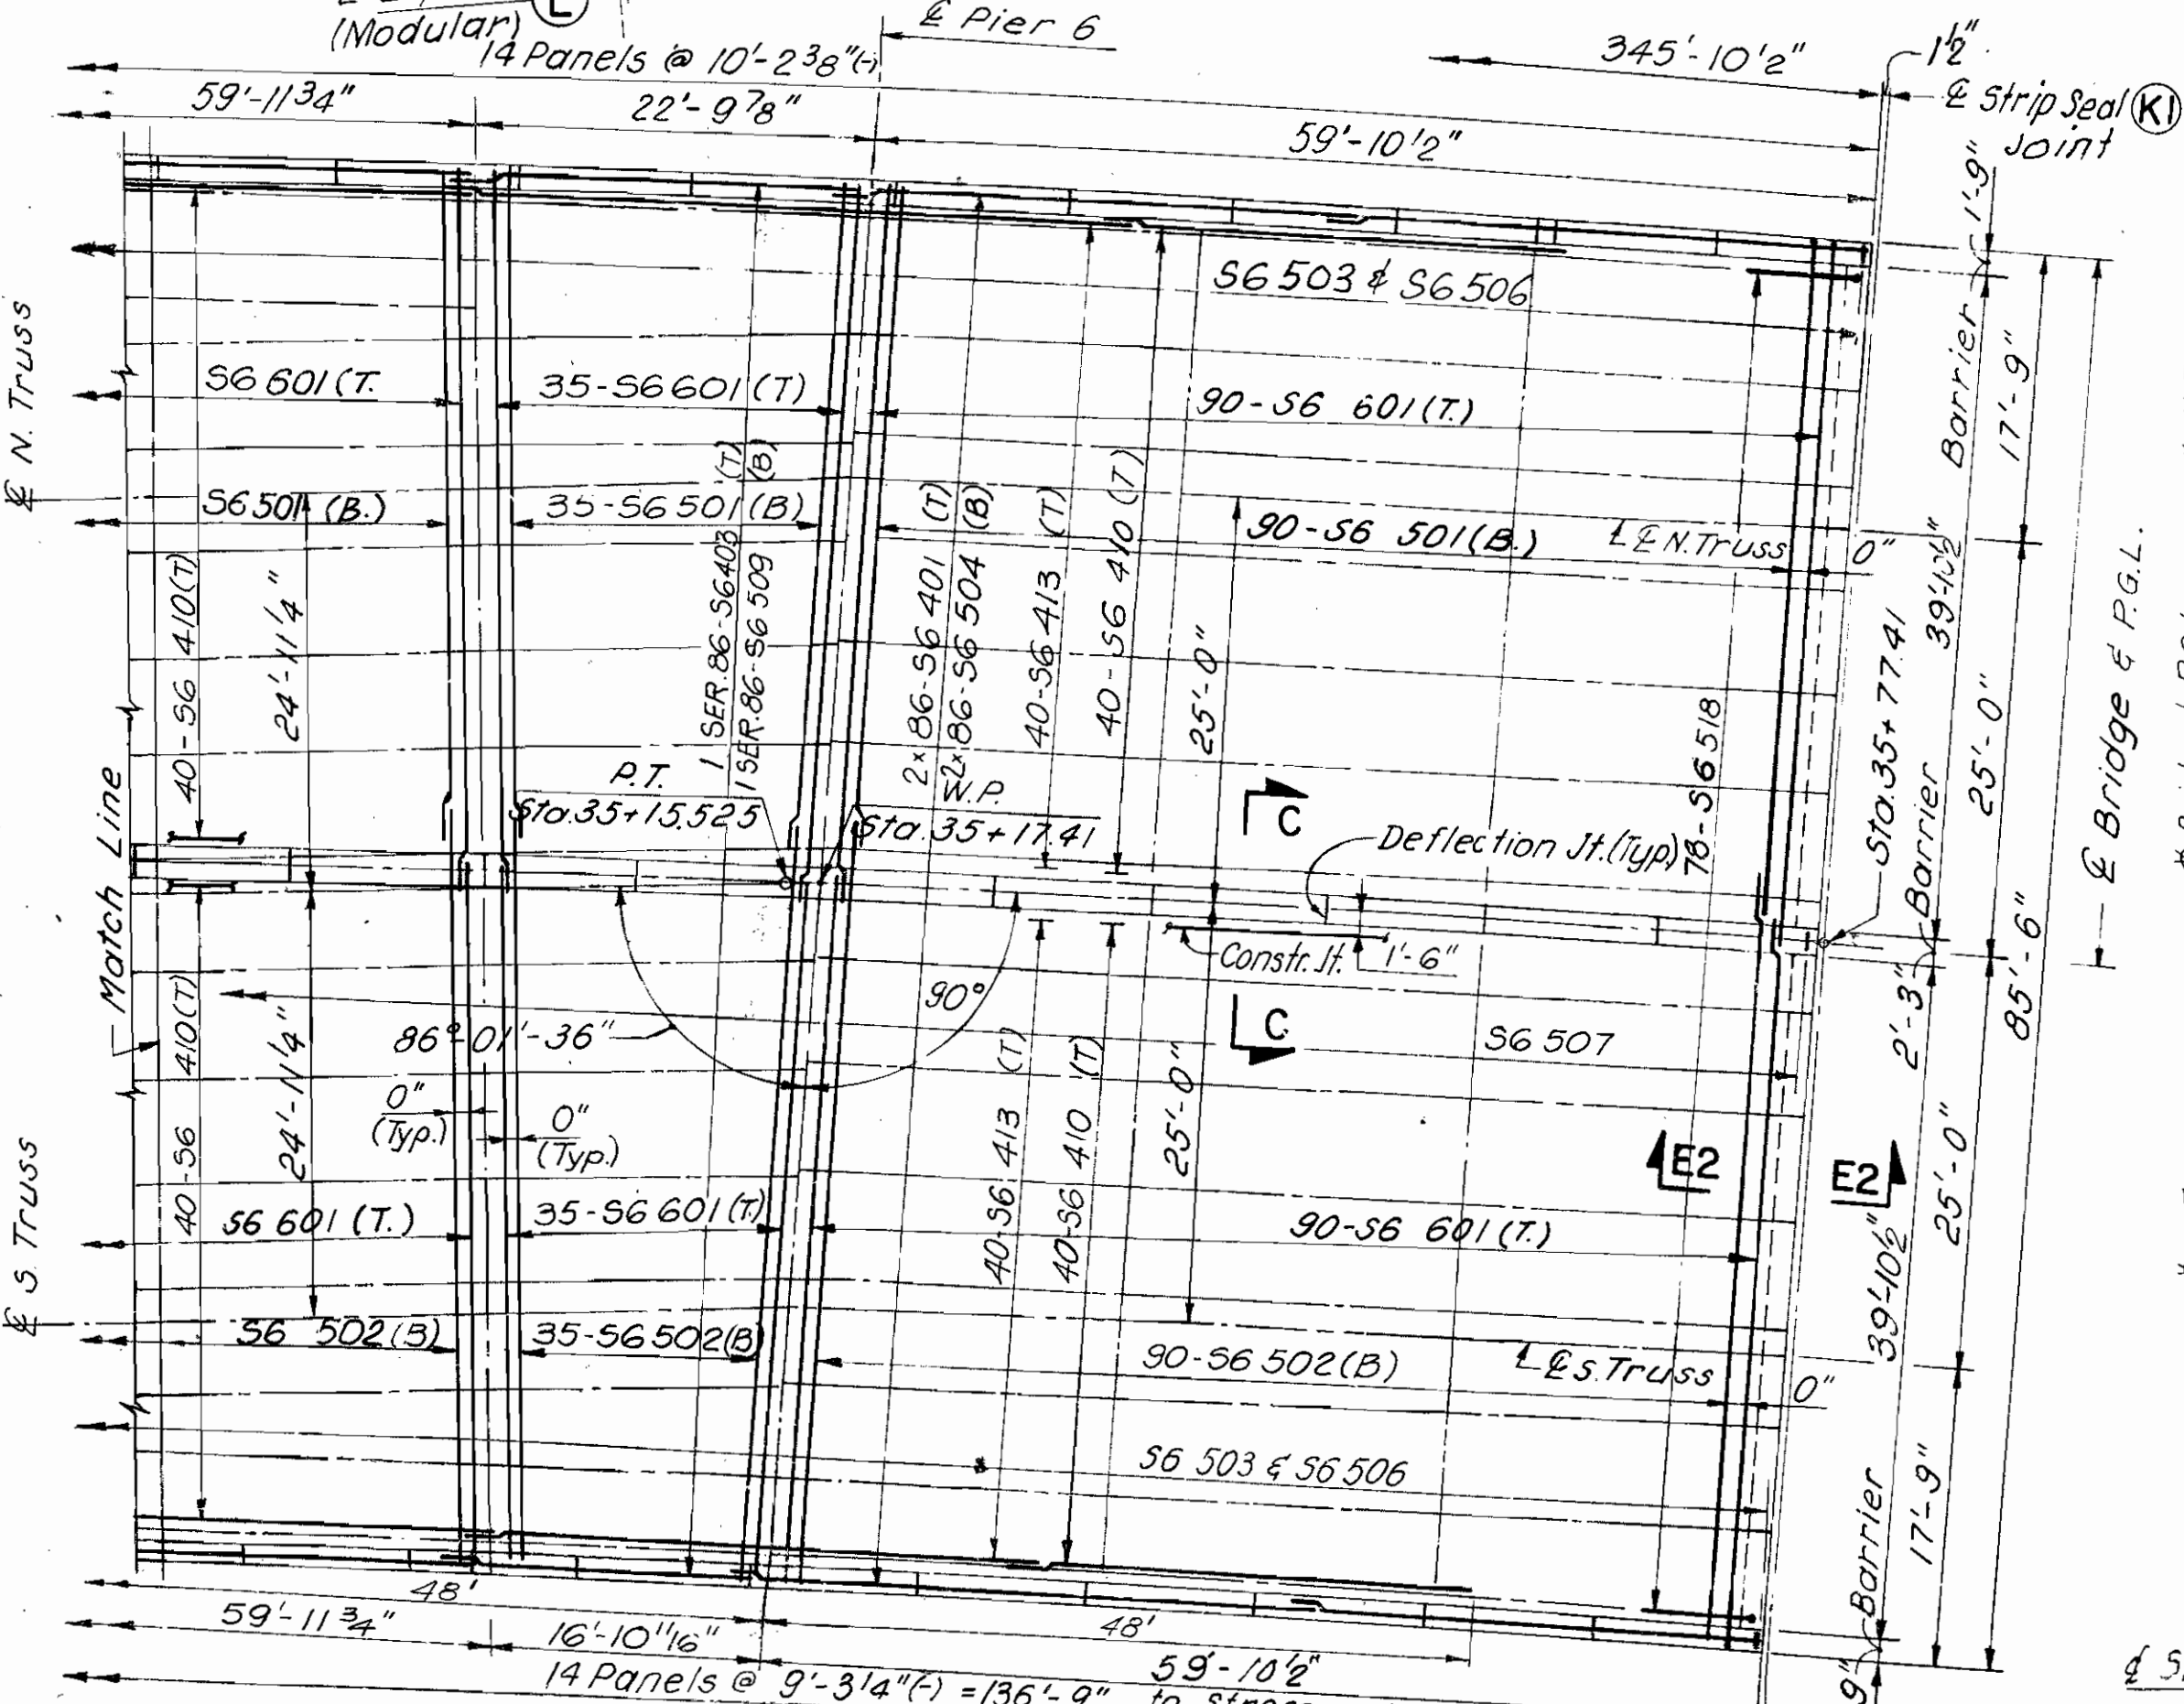

TRUSS SPAN NO. 6 - PART PLAN

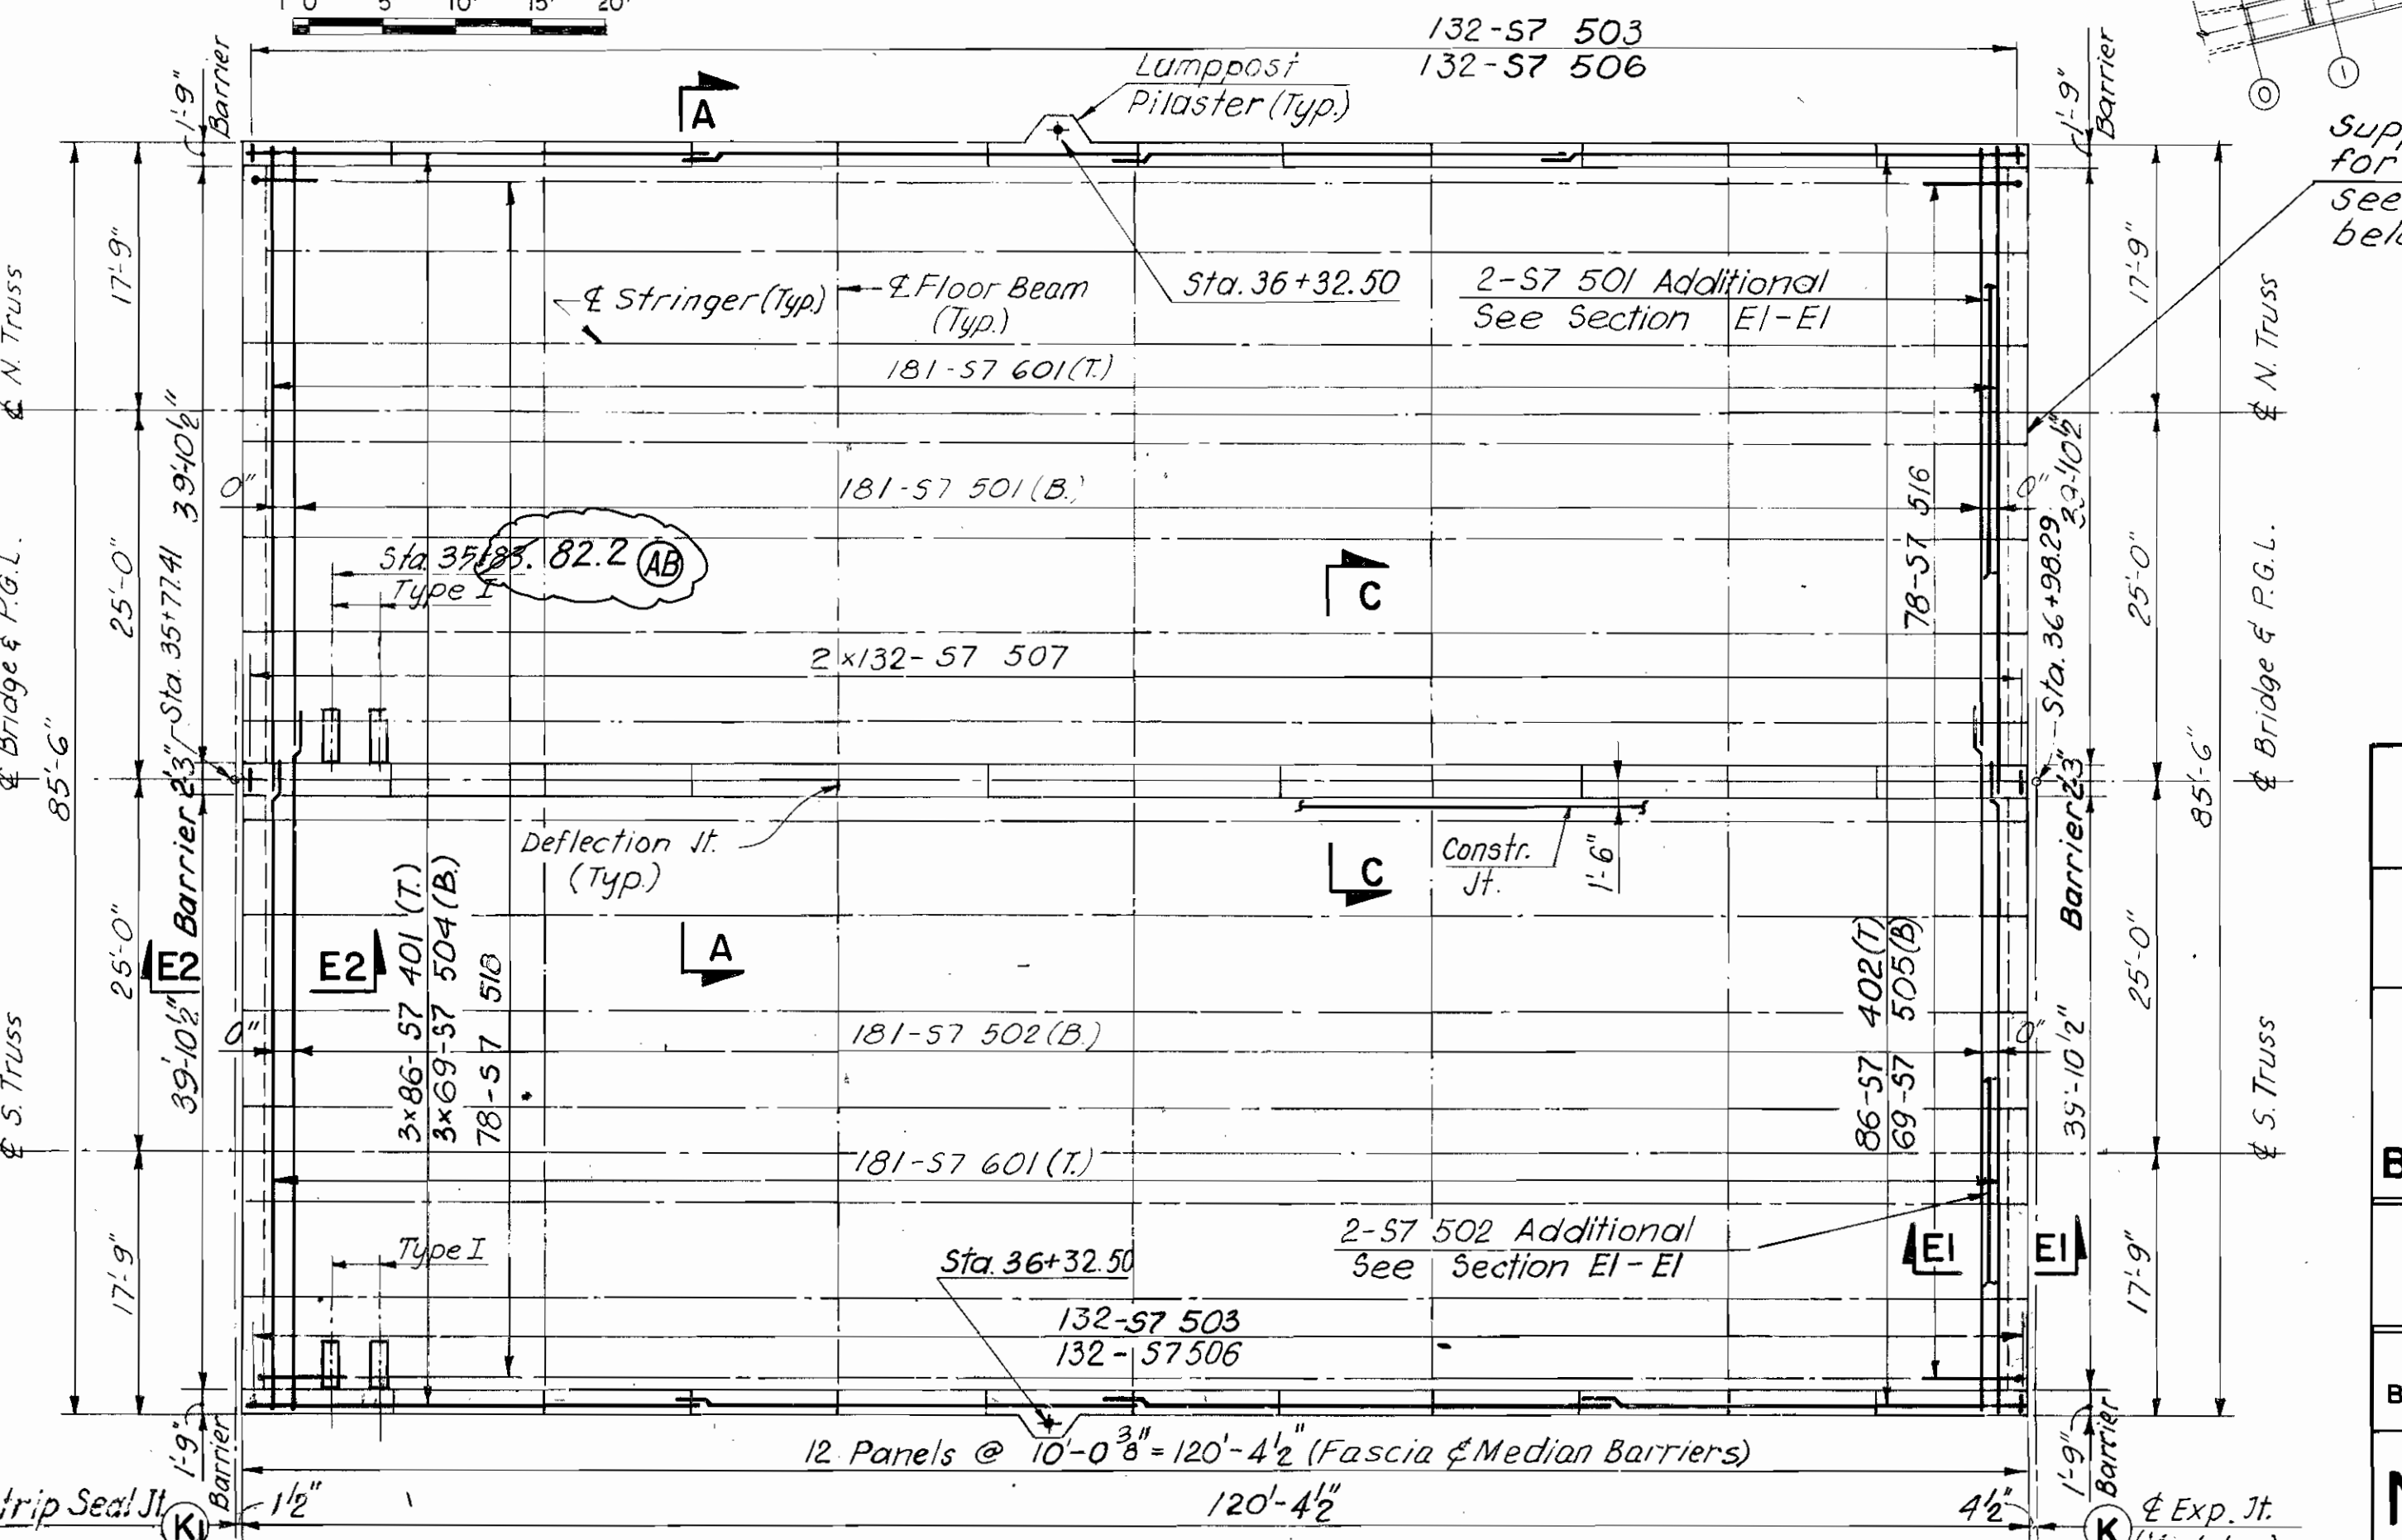

TRUSS SPAN 7 - PLAN

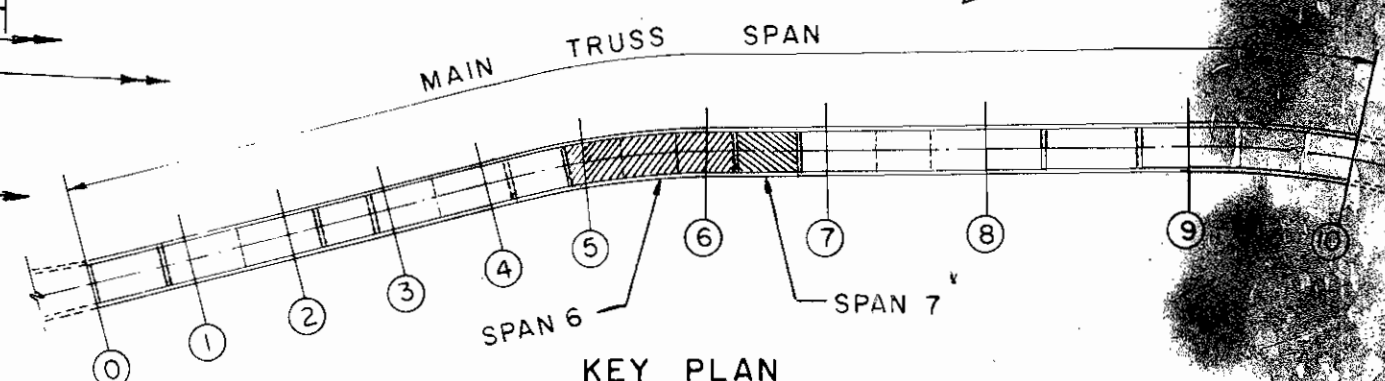

Support Boxes for Exp. Joint Not Shown See Dwg. 278 & Note 1 below.

NOTE 1  
Field cut and bend Reinf. bars to clear boxes.

(AB) As Built

REFERENCES:	DWG. NO.
Exp. Joint	278
References, Notes & Sections	268
Section A-A and C-C	268
Deck Slab Details 1 & 3	275 & 277
Section A1-A1	271
Sections E1-E1, E2-E2 & X-X	276
Bar Lists span 6 & 7	286 & 287

PAVLO ENGINEERING CO., P.C.  
NEW YORK, NEW YORK

CUYAHOGA COUNTY ENGINEER  
CLEVELAND OHIO  
**MAIN AVENUE BRIDGE**  
CITY OF CLEVELAND  
BRIDGE OVER THE CUYAHOGA RIVER VALLEY  
MAIN TRUSS SPANS - 6 AND 7  
**DECK SLAB REINFORCEMENT**

BRIDGE NO. 193 REPORT NO. 7119 DATE Oct 25 1989

NO. B-136 272/89



DESIGN A.S. / B.P.	DRAWN T.C.	CHECKED E.G.	REVISED TO AS BUILT AS BUILT 2/94
-----------------------	---------------	-----------------	--------------------------------------



MICROFILMED  
JUL 26 1994


FHWA REGION	STATE	PROJECT	279 547
5	OHIO	BHF-73 (51)	

CUYAHOGA COUNTY  
CUY - 2 - 14.66

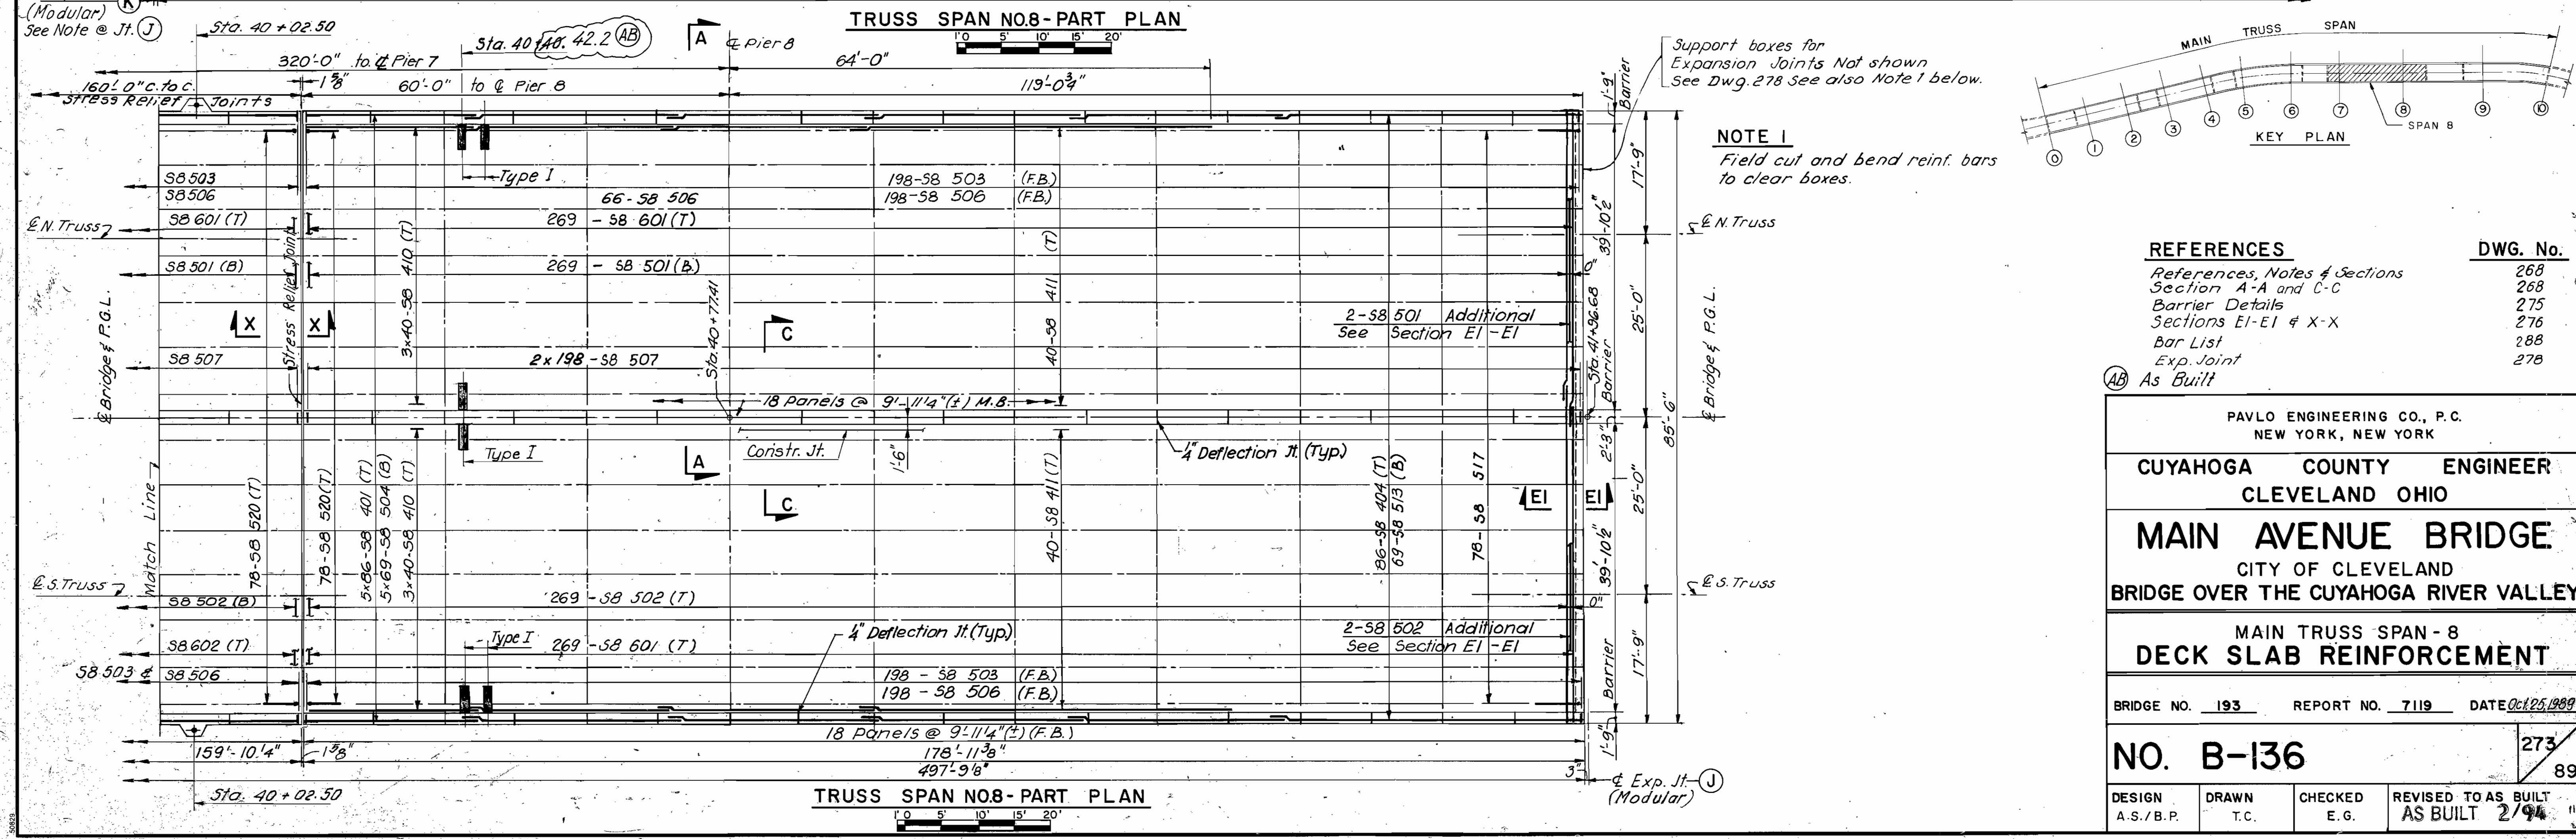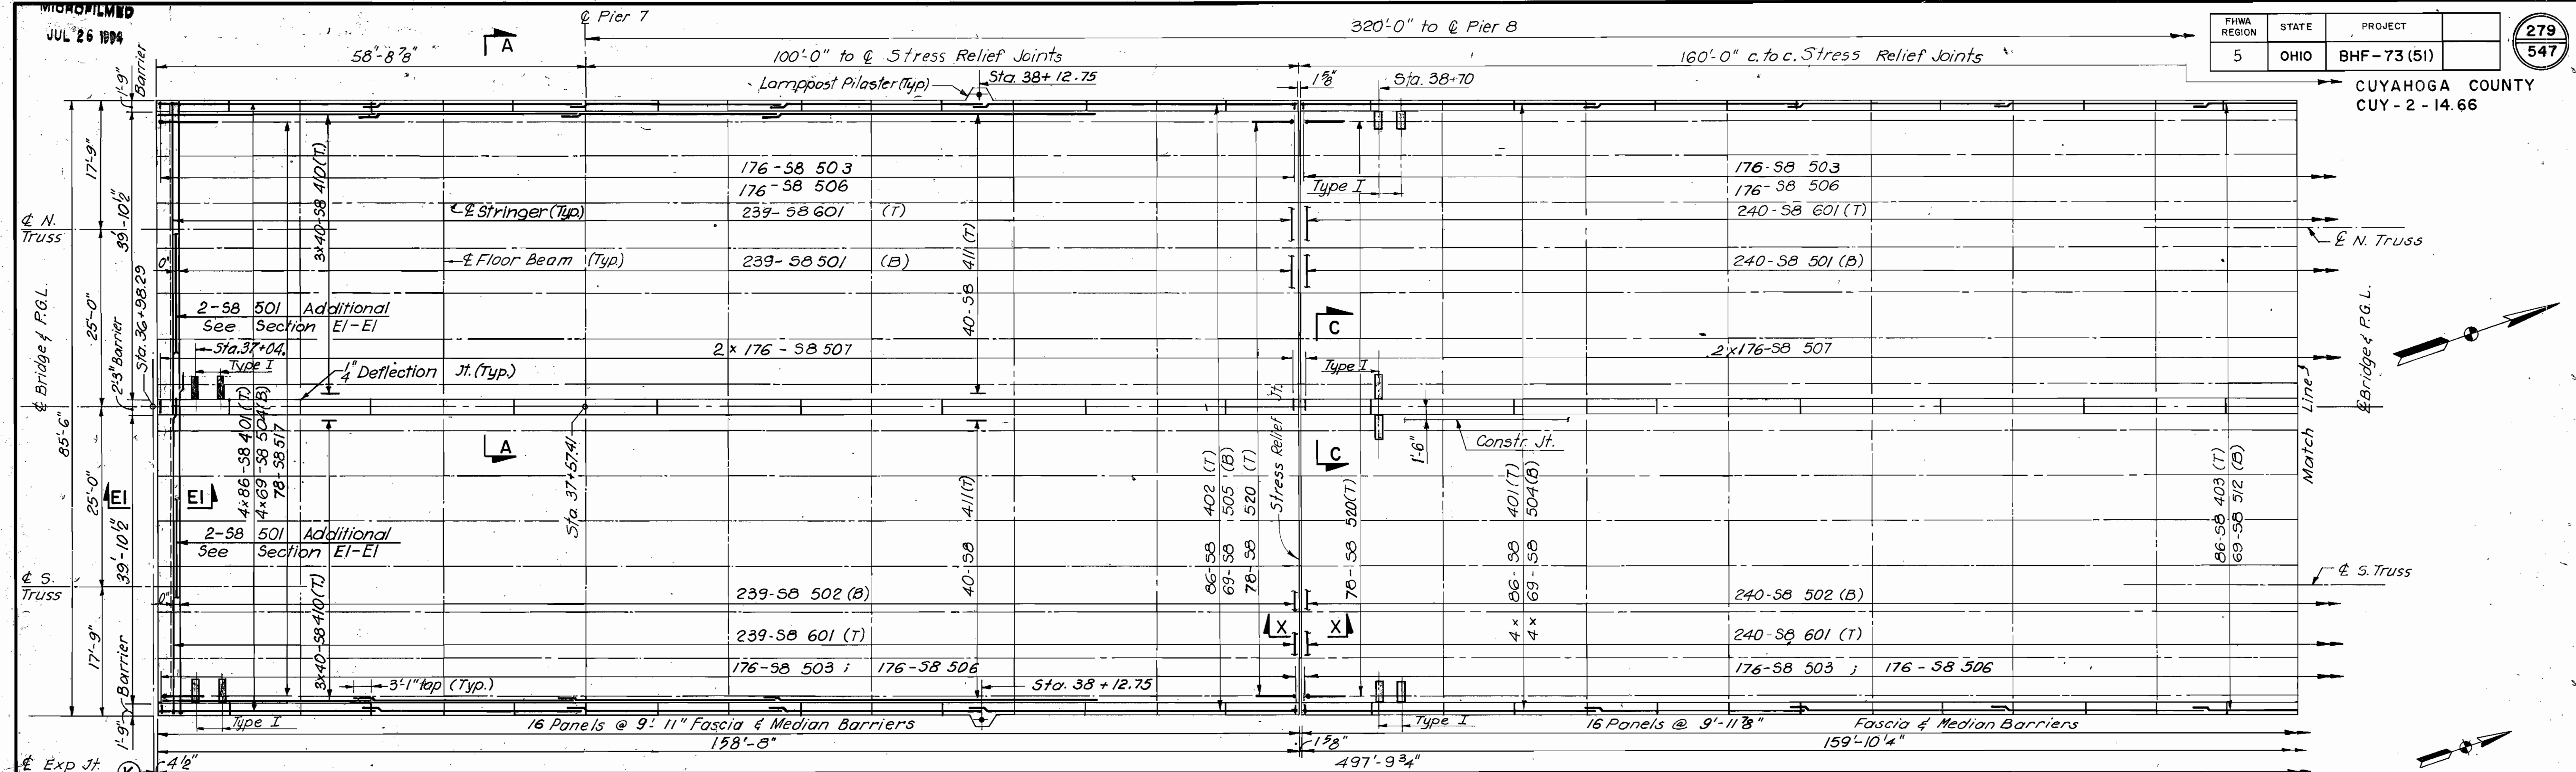

Support boxes for Expansion Joints Not shown See Dwg. 278 See also Note 1 below.

**NOTE 1**  
Field cut and bend reinf. bars to clear boxes.

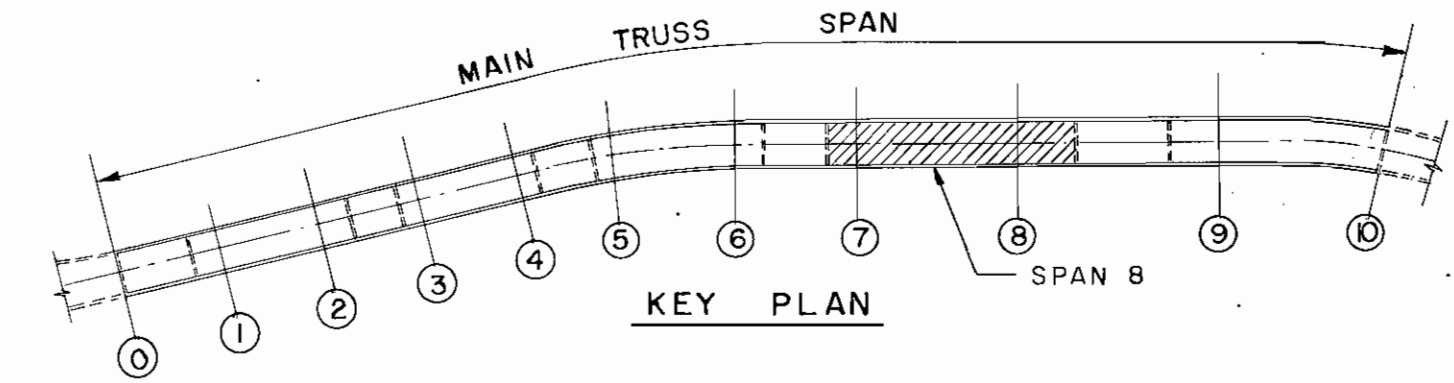

**REFERENCES**

References, Notes & Sections	DWG. No.
References, Notes & Sections	268
Section A-A and C-C	268
Barrier Details	275
Sections E1-E1 & X-X	276
Bar List	288
Exp. Joint	278

As Built

PAVLO ENGINEERING CO., P.C.  
NEW YORK, NEW YORK

**CUYAHOGA COUNTY ENGINEER**  
CLEVELAND OHIO

**MAIN AVENUE BRIDGE**  
CITY OF CLEVELAND  
BRIDGE OVER THE CUYAHOGA RIVER VALLEY




MAIN TRUSS SPAN - 8  
**DECK SLAB REINFORCEMENT**

BRIDGE NO. 193 REPORT NO. 7119 DATE Oct 25, 1989

**NO. B-136** 273  
89



DESIGN A.S./B.P.	DRAWN T.C.	CHECKED E.G.	REVISED TO AS BUILT AS BUILT 2/94
---------------------	---------------	-----------------	--------------------------------------

CUYAHOGA COUNTY  
CUI-2-14.66

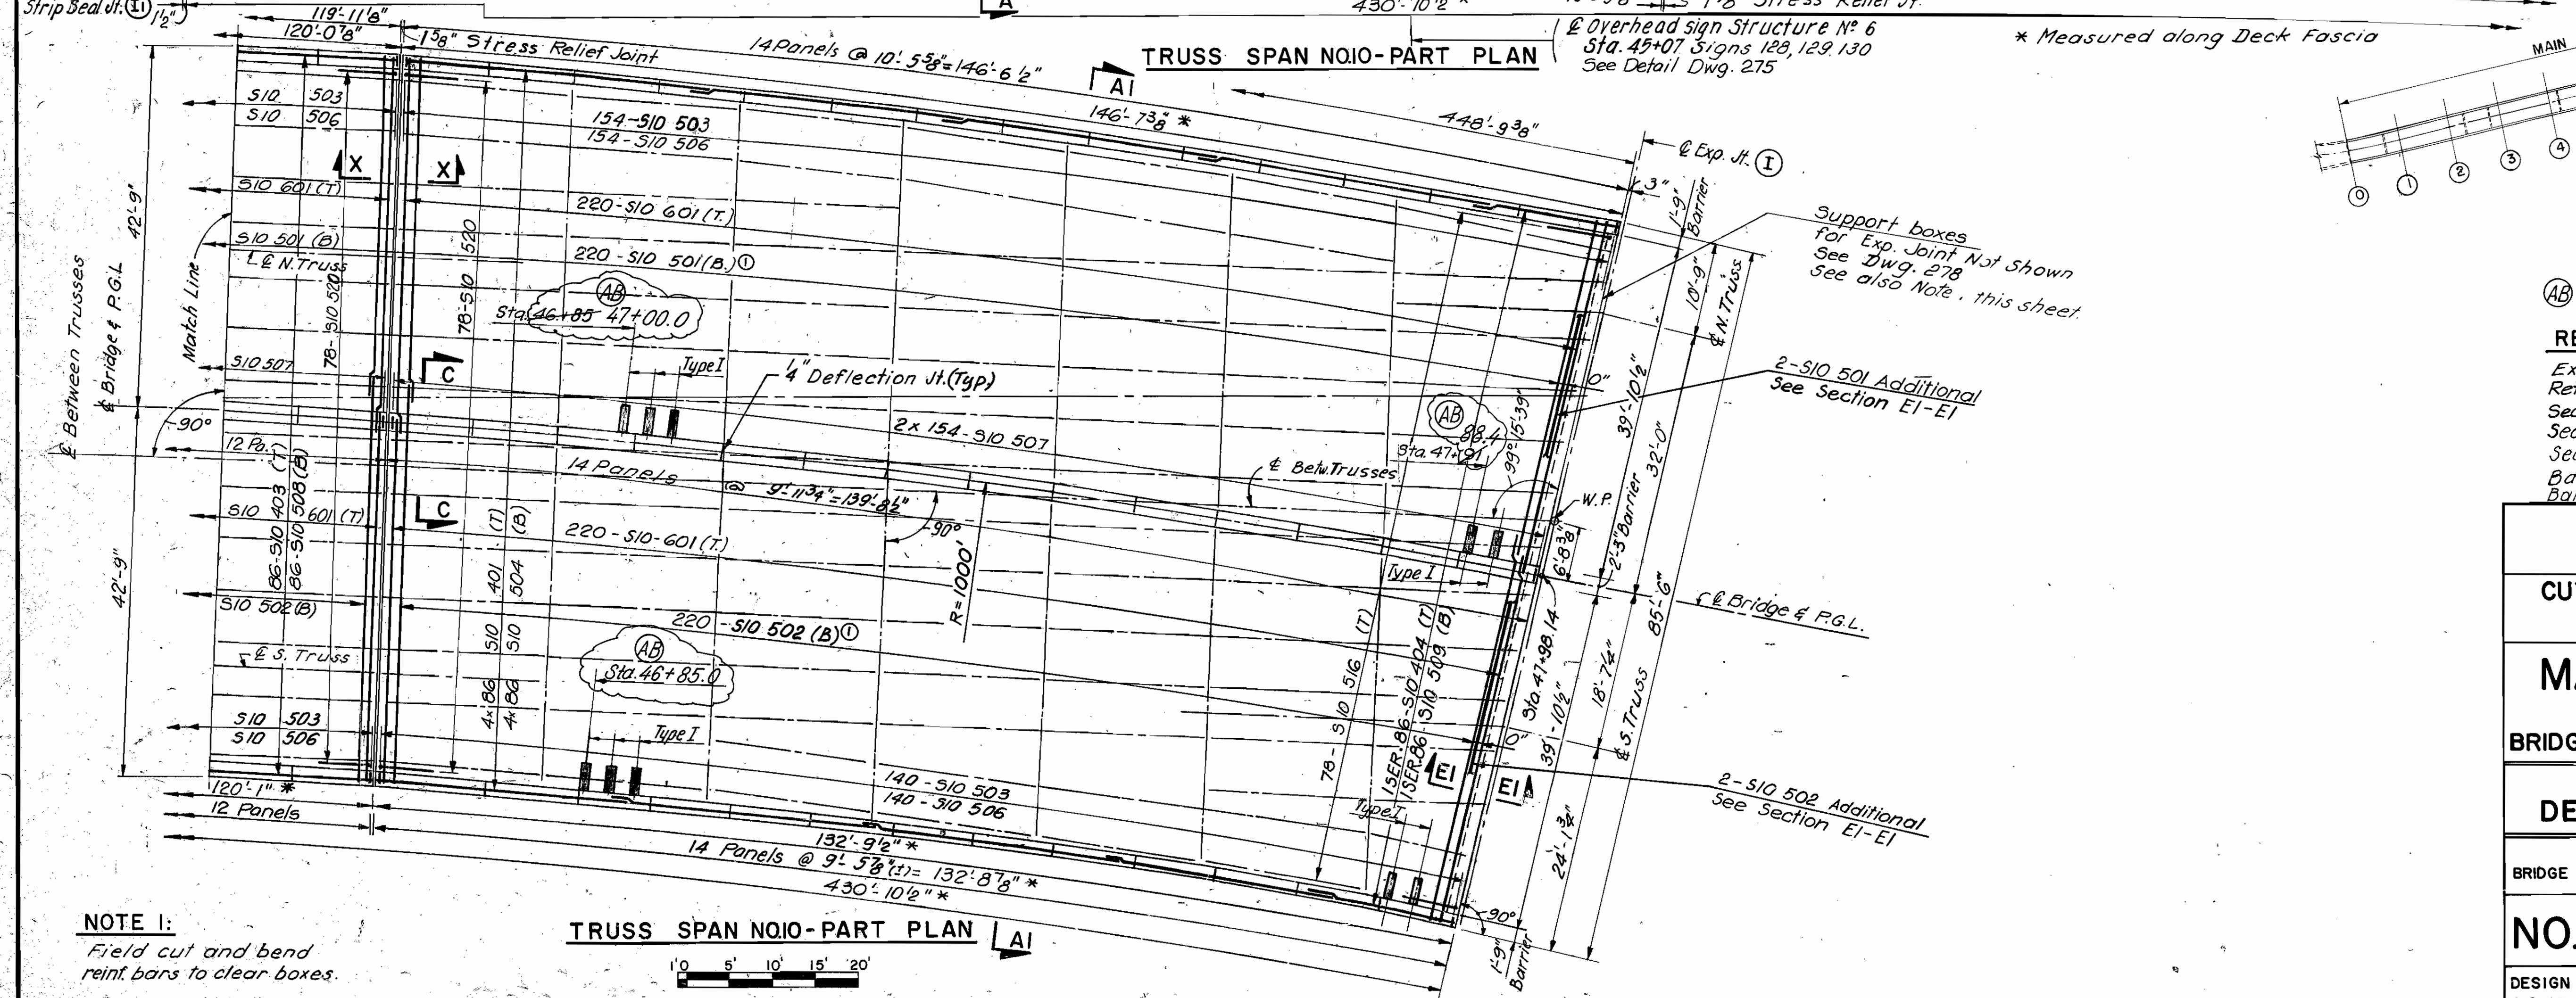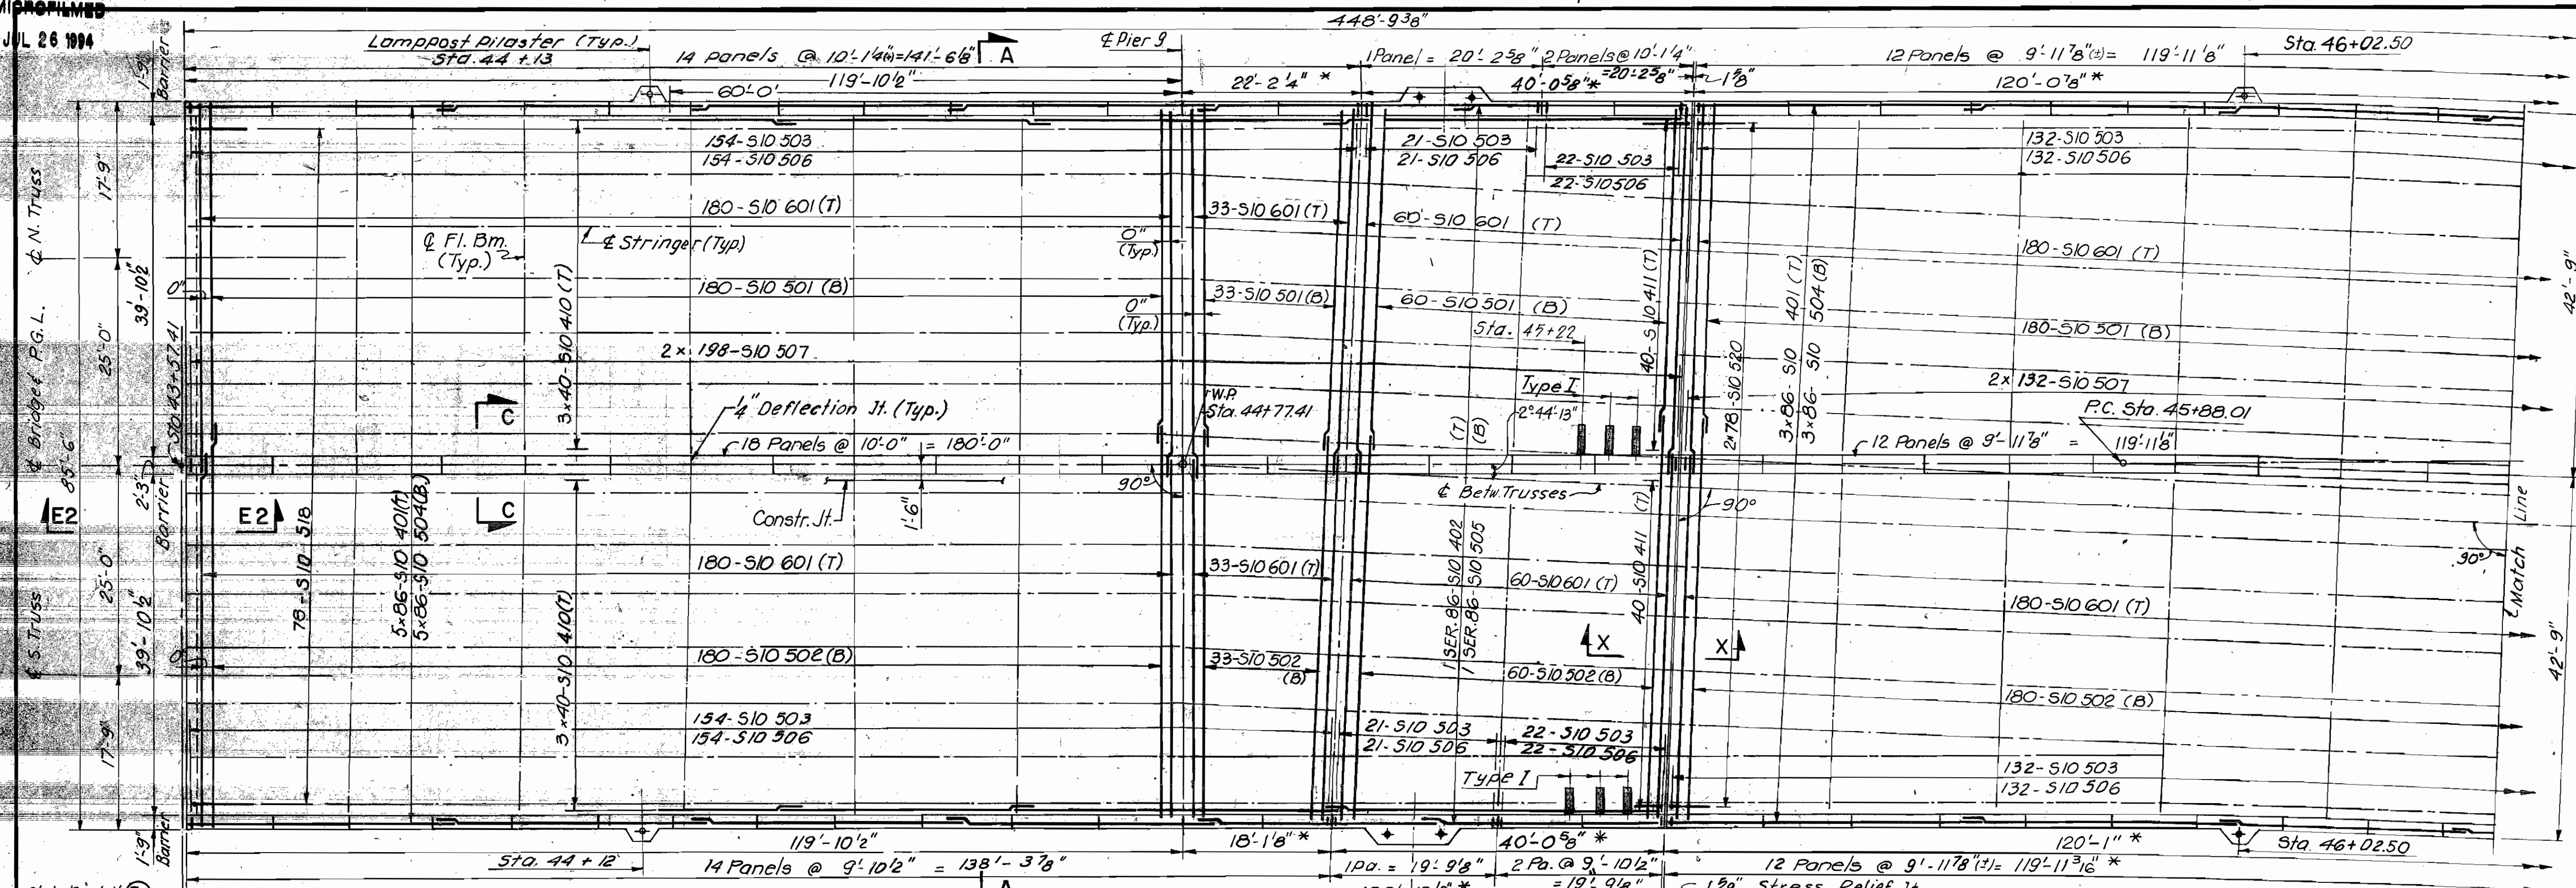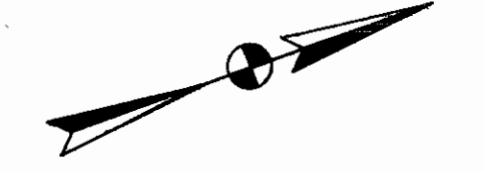

**NOTE I:**  
Field cut and bend  
reinf. bars to clear boxes.

**TRUSS SPAN NO.10 - PART PLAN** | A-I

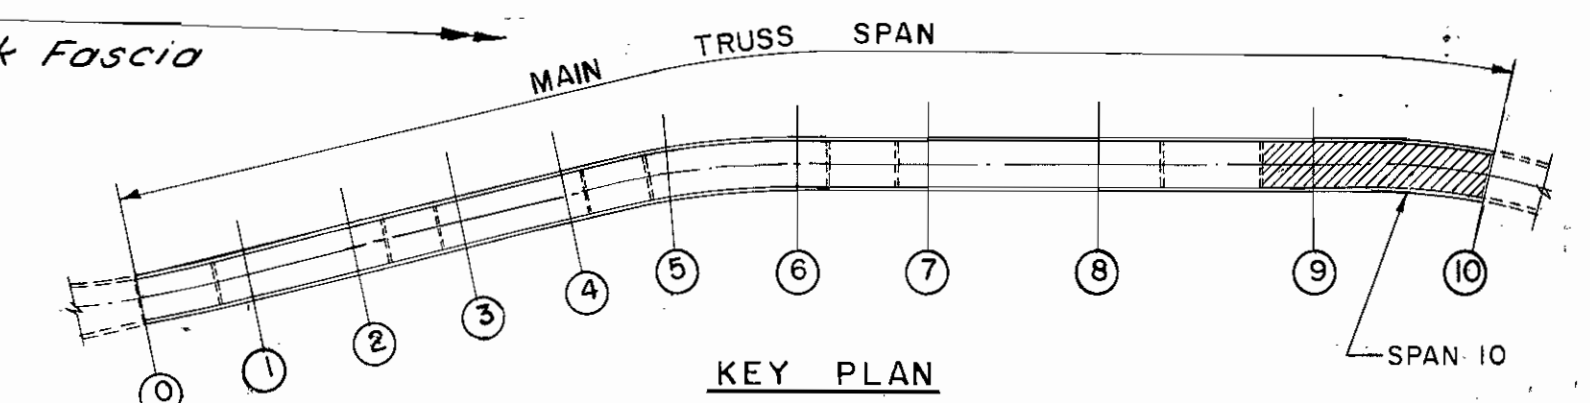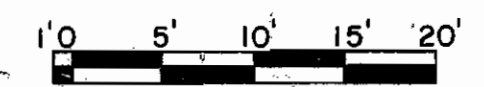

**REFERENCES**

REFERENCE	DWG. NO.
Exp. Joint	278
References, Notes and Sections	268
Section A-A and C-C	268
Section A1-A1	271
Sections E1-E1, E2-E2 & X-X	276
Barrier Details	277
Bar List	289

PAVLO ENGINEERING CO., P.C.  
NEW YORK, NEW YORK

**CUYAHOGA COUNTY ENGINEER**  
CLEVELAND OHIO

**MAIN AVENUE BRIDGE**  
CITY OF CLEVELAND  
BRIDGE OVER THE CUYAHOGA RIVER VALLEY

MAIN TRUSS SPAN - 10  
**DECK SLAB REINFORCEMENT**

BRIDGE NO. 193 REPORT NO. 7119 DATE Oct. 25, 1989

**NO. B-136** 274  
89



DESIGN A.S./B.P.	DRAWN T.C.	CHECKED E.G.	REVISED TO AS BUILT AS BUILT 2/94
---------------------	---------------	-----------------	--------------------------------------

STRUCTURE FILE NUMBER: 1800 035

**EAST APPROACH FORWARD SECTION**  
SCOPE OF REHABILITATION WORK

THE SECTION IS A 759 FOOT LONG, SIX LANE DIVIDED, STEEL VIADUCT, CONSISTING OF ONE TRUSS SPAN AND FOURTEEN FLOOR BEAM AND STRINGER SPANS. FRAMING INTO BRACED COLUMNS.

- THE WORK INCLUDES
- REMOVAL OF EXISTING I-BEAM-LOK DECK, SIDEWALKS, RAILINGS, FASCIA PLATES, STRINGERS, CATWALKS, DIAPHRAGMS, ETC.
  - REPAIR AND REINFORCEMENT OF THE FLOOR BEAMS, COLUMNS AND TRUSS MEMBERS.
  - INSTALLATION OF NEW STEEL STRINGERS, FLOORBEAMS AND FASCIA STRINGERS.
  - CONSTRUCTION OF NEW LIGHTWEIGHT CONCRETE DECK SLABS, BARRIERS, LUMINAIRE SUPPORTS, DRAINAGE DEVICES AND ARMORED JOINTS.
  - ALTERATION OF TWO EXISTING STONE PYLONS AT 9TH STREET.
  - FIELD COATING OF SOME EXISTING STRUCTURAL STEEL AND PAINTING OF NEW STRUCTURAL STEEL.
  - INSTALLATION OF NEW LIGHTING AND TRAFFIC CONTROL SYSTEMS.
  - CONCRETE REPAIRS.
  - COATING OF THE EXPOSED EXISTING AND NEW CONCRETE SURFACES.

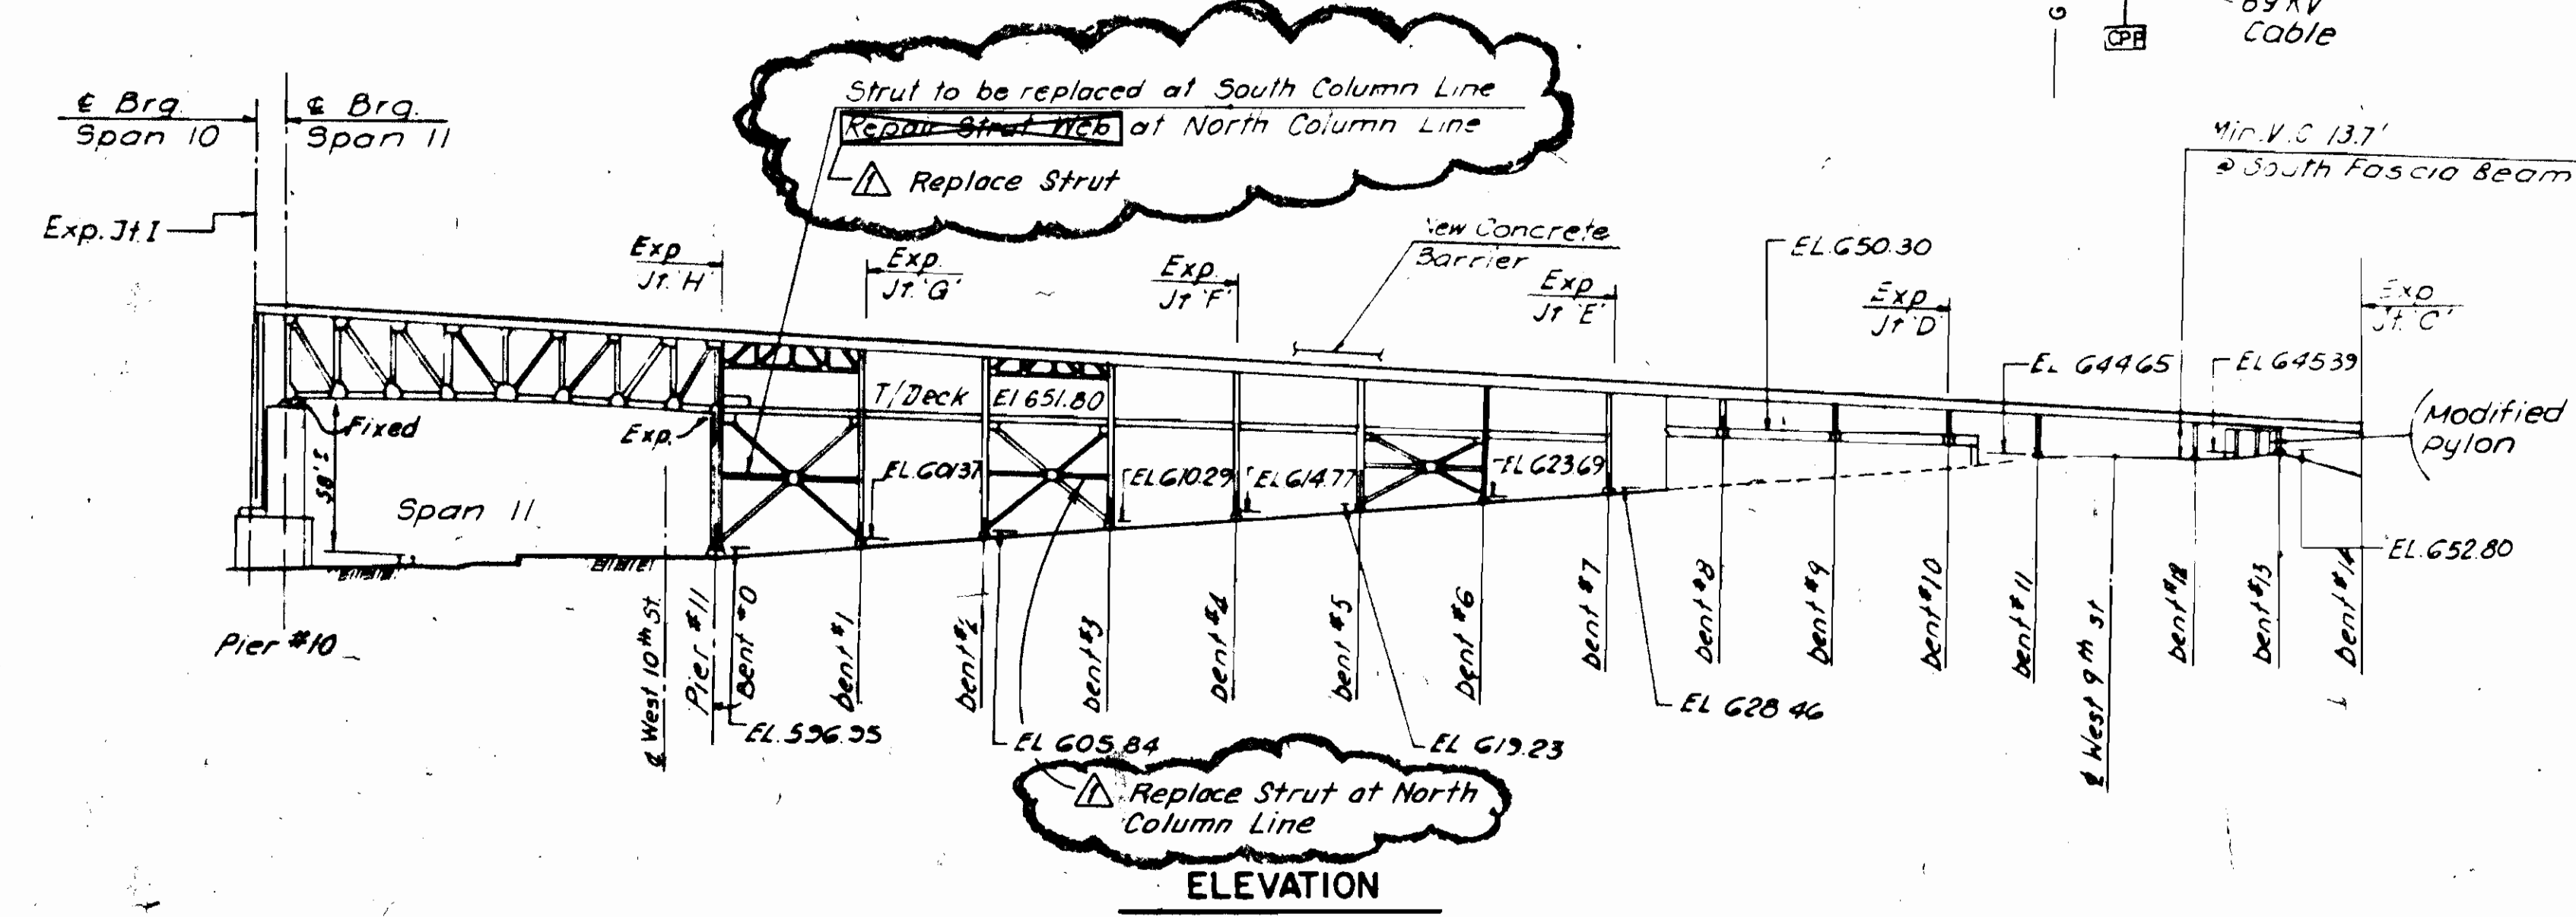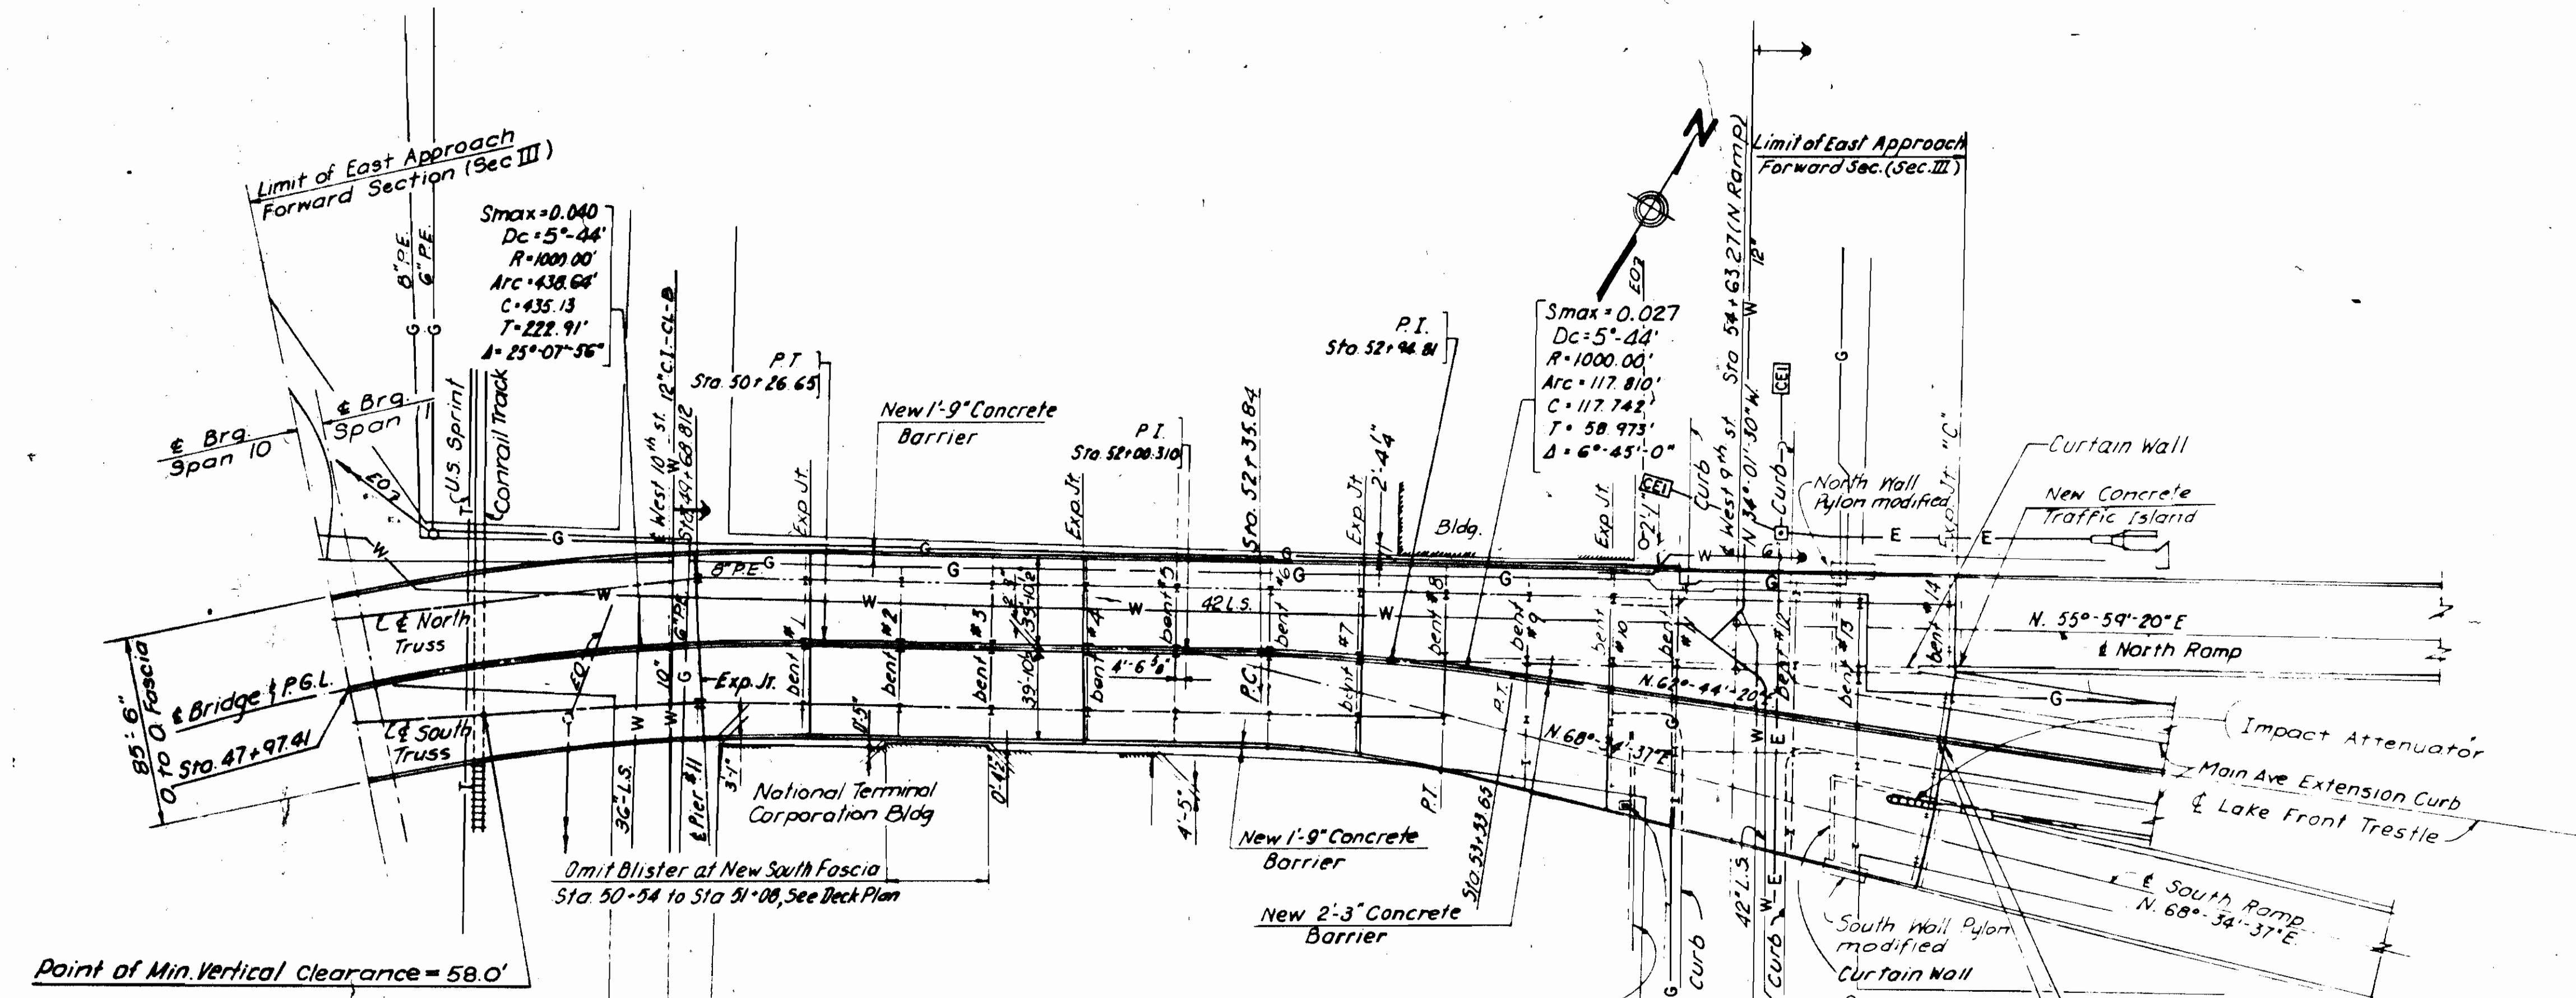

- LEGEND**
- East Ohio Gas — G — G —
  - Ohio Bell Tel. Co. — T — T —
  - Cleveland Public Power Co. — C.P.P. — E — E —
  - Water — W — W —
  - Sewers — S — S —
  - Manhole — ● —
  - Cleveland Electric Illuminating Co. — C.E.I. — E — E —
  - Cleveland Thermal Energy Co. (Steam Line) — TH — TH —
  - Overhead Electric Lines — C.E.I. — EO — EO —
  - C.E.I. Utility Poles — ○ —

**REFERENCE**

Typical Cross Sections	303
Profile and Superelevation	305
Deck Plan	341
IMPACT ATTENUATOR	345

**DWG. NO.**

303
305
341
345

The Contractor shall make provision to protect all areas under the Bridge used by Pedestrians or vehicles and over the river, from falling debris during removal of the existing superstructure and during erection

**C.V.N. NOTE**  
Structural steel for new or repaired Main Load Carrying Members subjected to tension or stress reversal, shall meet the "Longitudinal Charpy V-notch" requirements of 15 ft.-Lb. @ 40°F. Main load carrying members for this section are limited to: Stringers, Floor Beam Flanges & Web, Bracket Top Flange and Web & Tie Plates.  
See also "GENERAL NOTES" Structural Steel.



**NOTE:**  
1. For lighting, drainage and sign support structures, see deck plans.



Rev. 1	Plan Revision	3-15-91
PAVLO ENGINEERING CO., P.C. NEW YORK, NEW YORK		
CUYAHOGA COUNTY ENGINEER CLEVELAND OHIO		
<b>MAIN AVENUE BRIDGE</b> CITY OF CLEVELAND BRIDGE OVER THE CUYAHOGA RIVER VALLEY		
<b>EAST APPROACH-FORWARD SECTION PROPOSED PLAN &amp; ELEVATION</b>		
BRIDGE NO. 193	REPORT NO. 7119	DATE Oct. 20, 1994
<b>NO. B-136</b>		302 54
DESIGN S.H.	DRAWN C.P.J.	CHECKED C.K.D.
REVISED TO AS BUILT. AS BUILT 2/94		
O.D.O.T. 9-18-91 T.E.S.		



CUYAHOGA COUNTY  
CUY - 2 - 14.66

Remove exist. Riveted or Welded Connection. Grind smooth Top Flange of Floorbeam in direction of Stress taking care not to undercut or Gauge Flange.

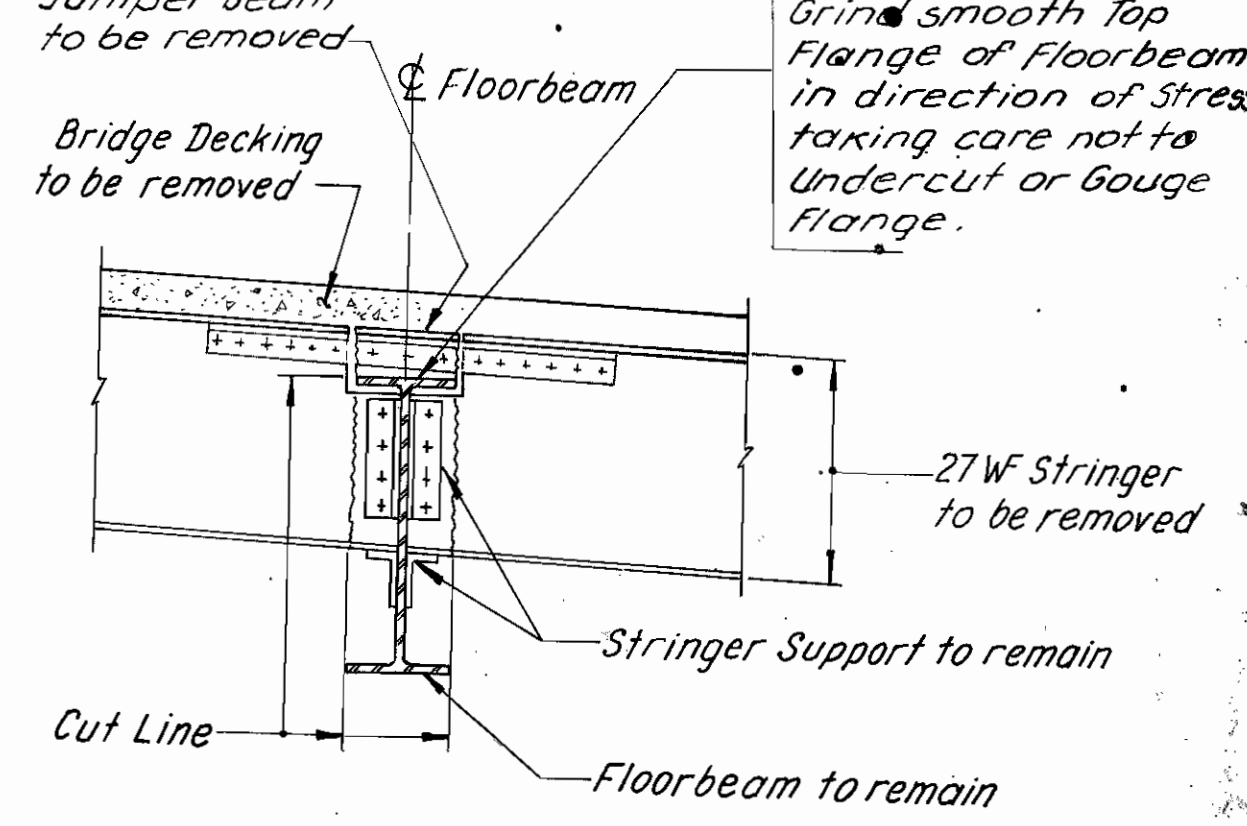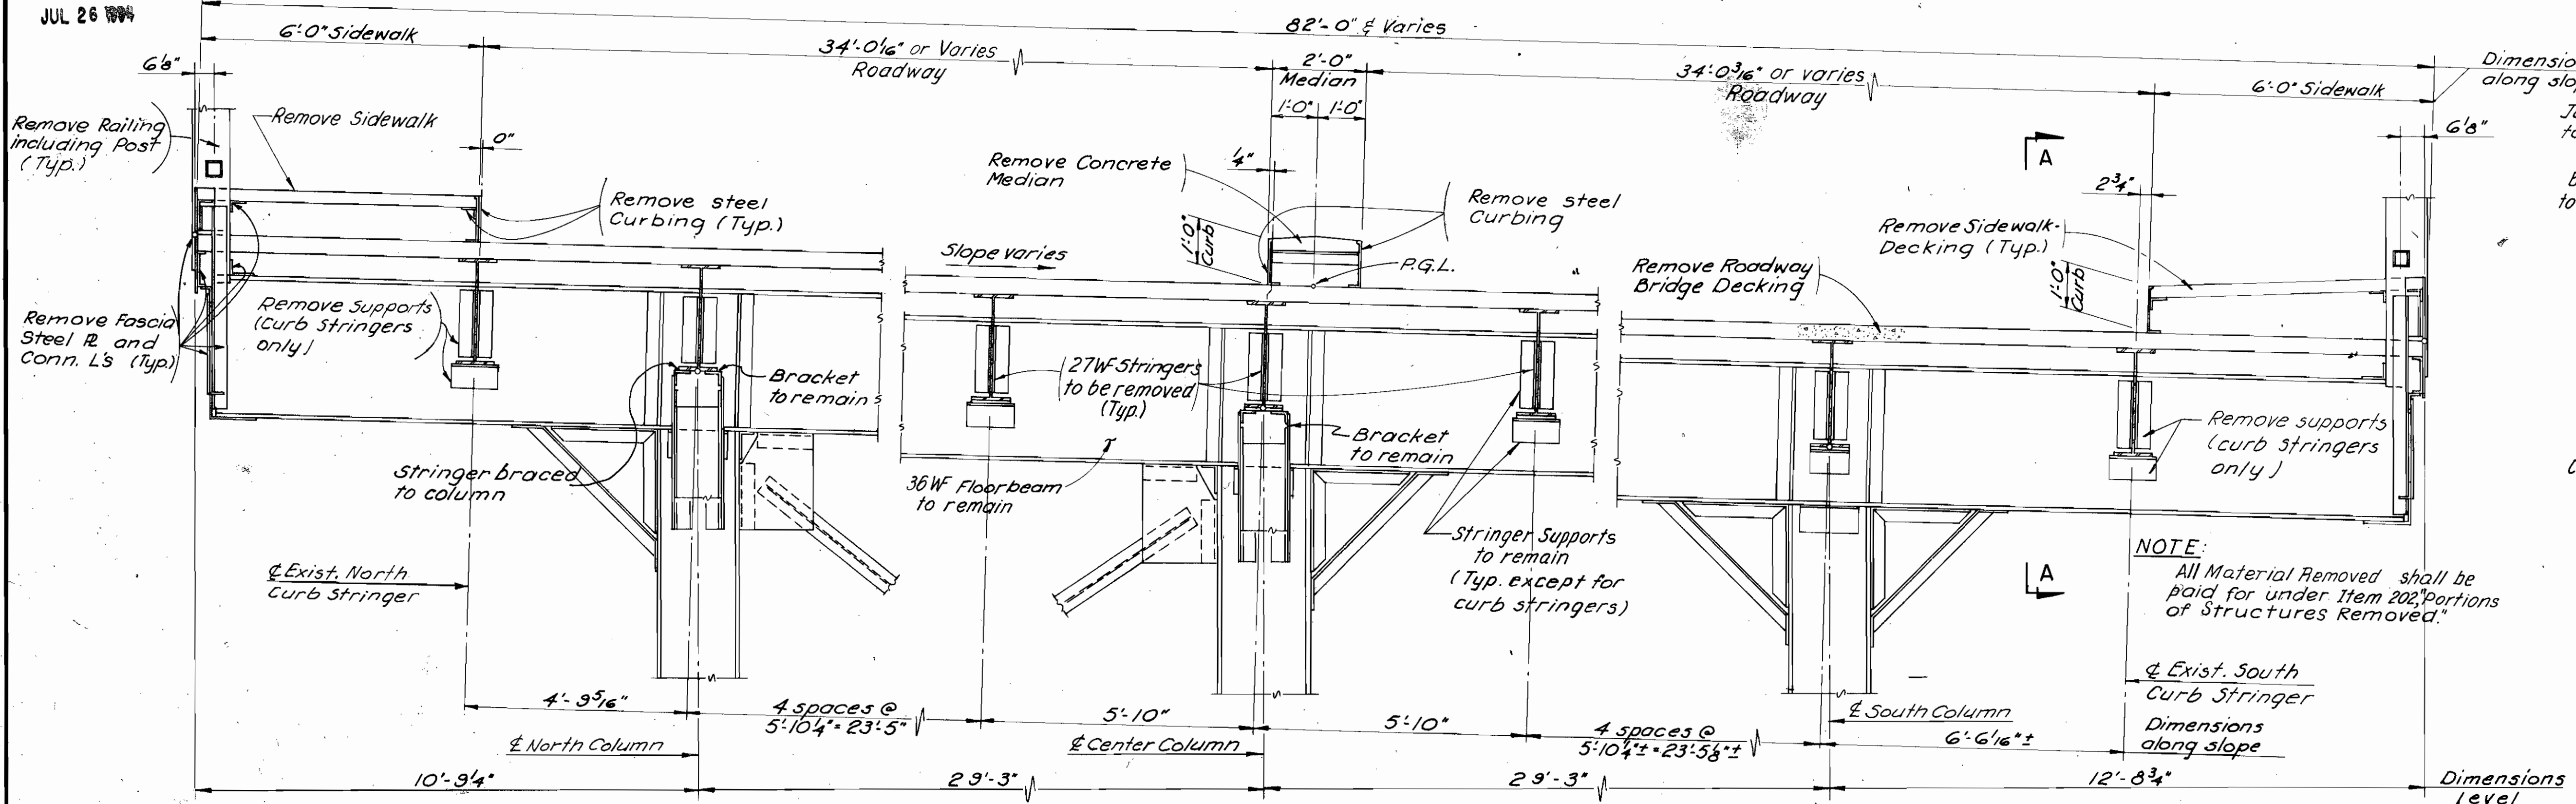

NOTE: All Material Removed shall be paid for under Item 202, Portions of Structures Removed.

Lamp Pole Support Pilaster  
For location see Deck Plan.  
& Pole.

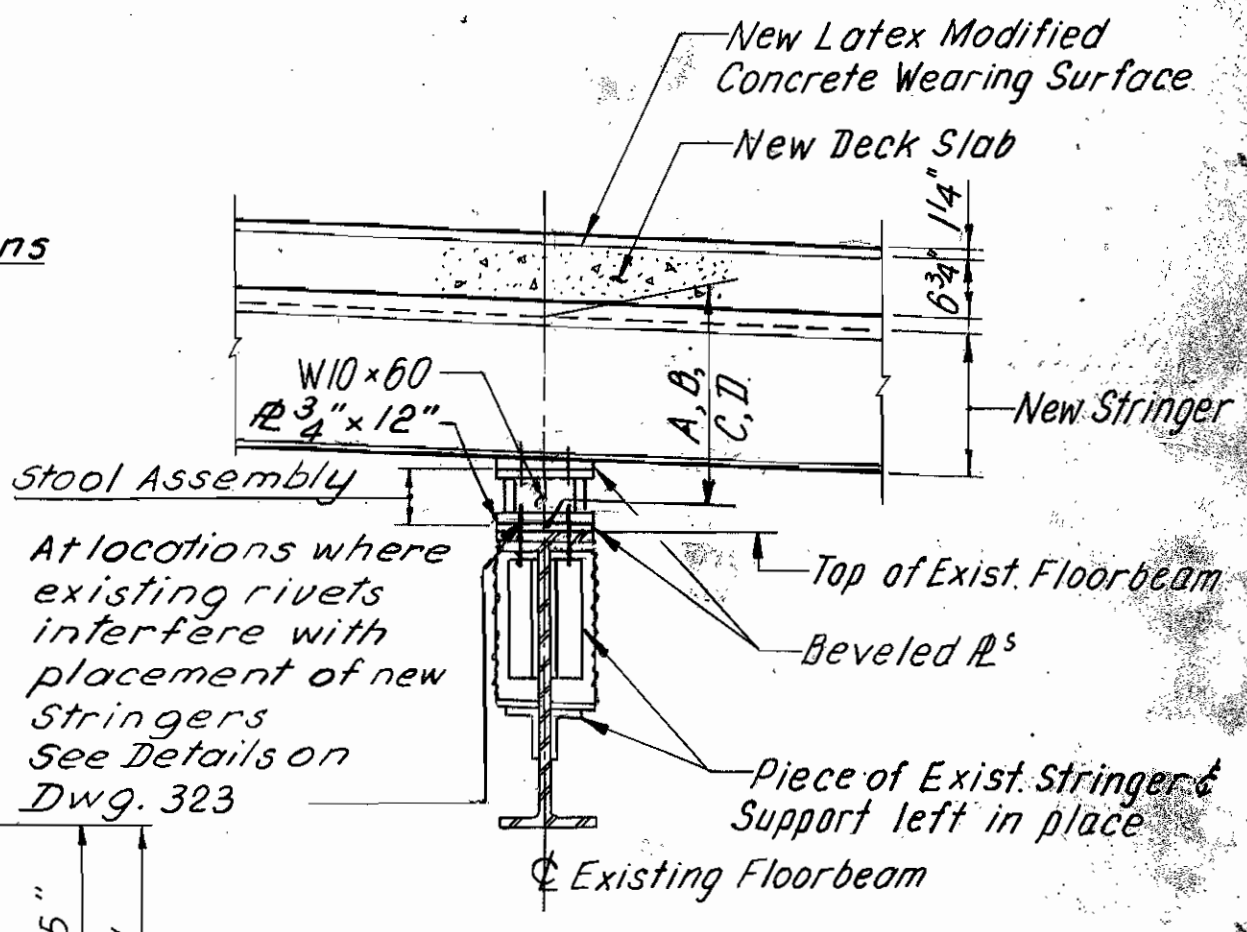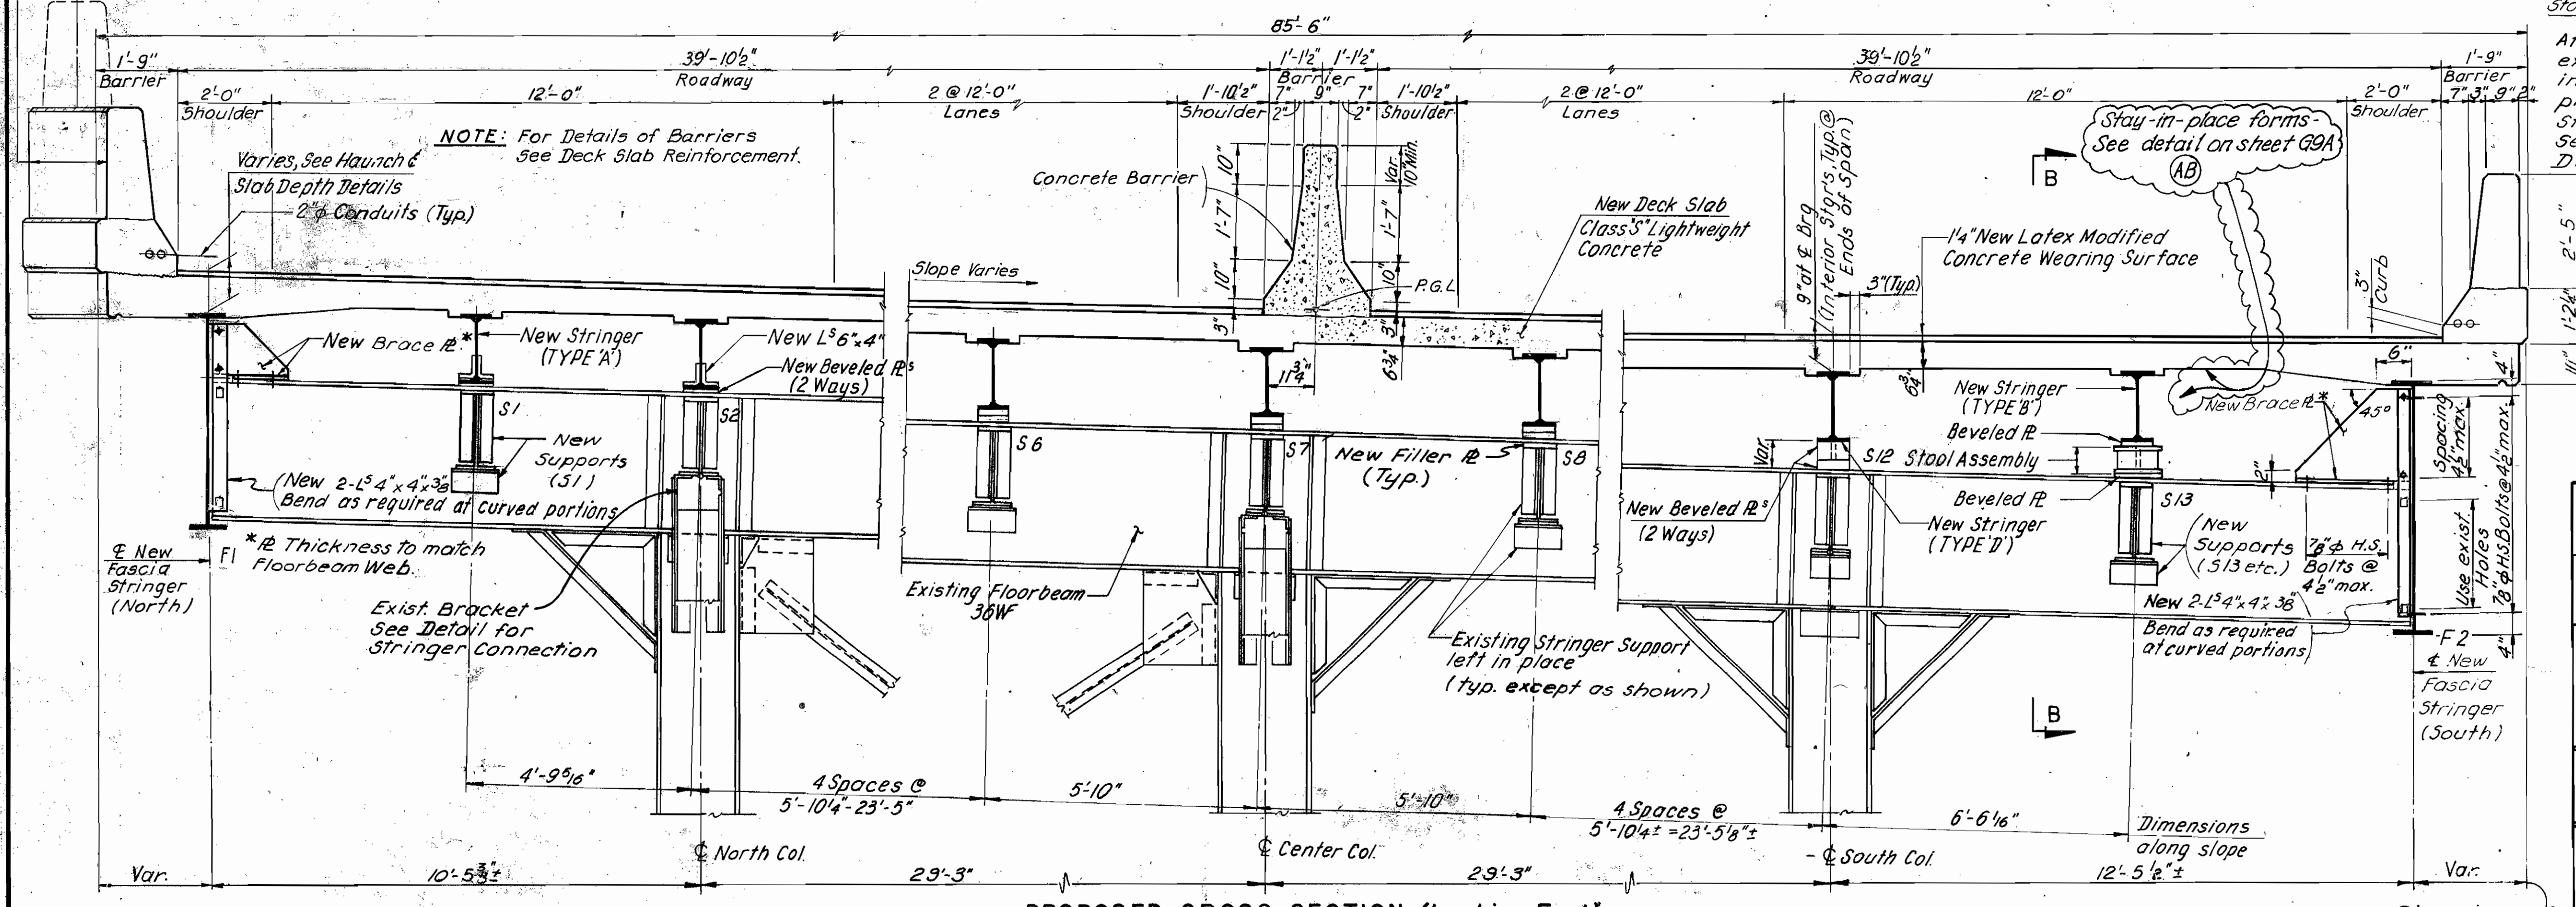

REFERENCES:

Existing Plan & Elevation	301
Proposed Plan & Elevation	302
Haunch and Slab Depth Details	338
Framing Plans	310, 311, 312
Stringer Schedules	325 to 330, Ind.
Stringer Details	324
Fascia Stringer Setting Dim.	331
Deck Slab	340-344

PAVLO ENGINEERING CO., P.C.  
NEW YORK, NEW YORK

CUYAHOGA COUNTY ENGINEER  
CLEVELAND OHIO

MAIN AVENUE BRIDGE  
CITY OF CLEVELAND  
BRIDGE OVER THE CUYAHOGA RIVER VALLEY


EAST APPROACH - FORWARD SECTION  
TYPICAL CROSS SECTIONS

BRIDGE NO. 193 REPORT NO. 7119 DATE

NO. B-136 303


DESIGN B.G./D.G.	DRAWN A.D.	CHECKED V.H./R.M.	REVISED TO AS BUILT AS BUILT 2/94
------------------	------------	-------------------	-----------------------------------

Note: Sections shown are typical at straight portions of bridge. At curved portions, total width and other dimensions vary.

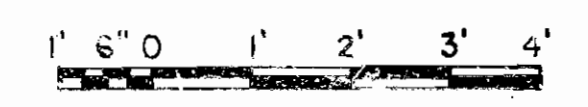

CUYAHOGA COUNTY  
CUY-2-14.66


MAIN TRUSS SPAN EAST APPROACH-FORWARD SECTION-SECT. III

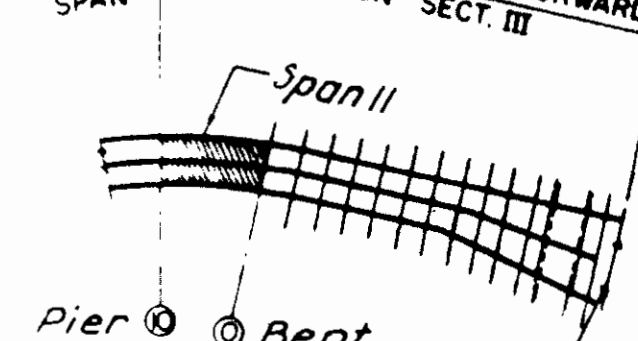


KEY PLAN

EXISTING FRAMING REMOVAL

MARK	DESIGNATION	SPAN II		REMARKS
		QUANT.		
S1	21W63	56		
S2, S5, S6, S9, S11, S13	21W59	57		
S3	21W68	3		
S4	21W73	5		
D1	14W30	49		
D2	9C134	34		
D3	10C20	8		Drain
D4	12W25	4		Lamp Post
F1 & F2	1-R262x3	18		
	2-L34x3x3/8	36		

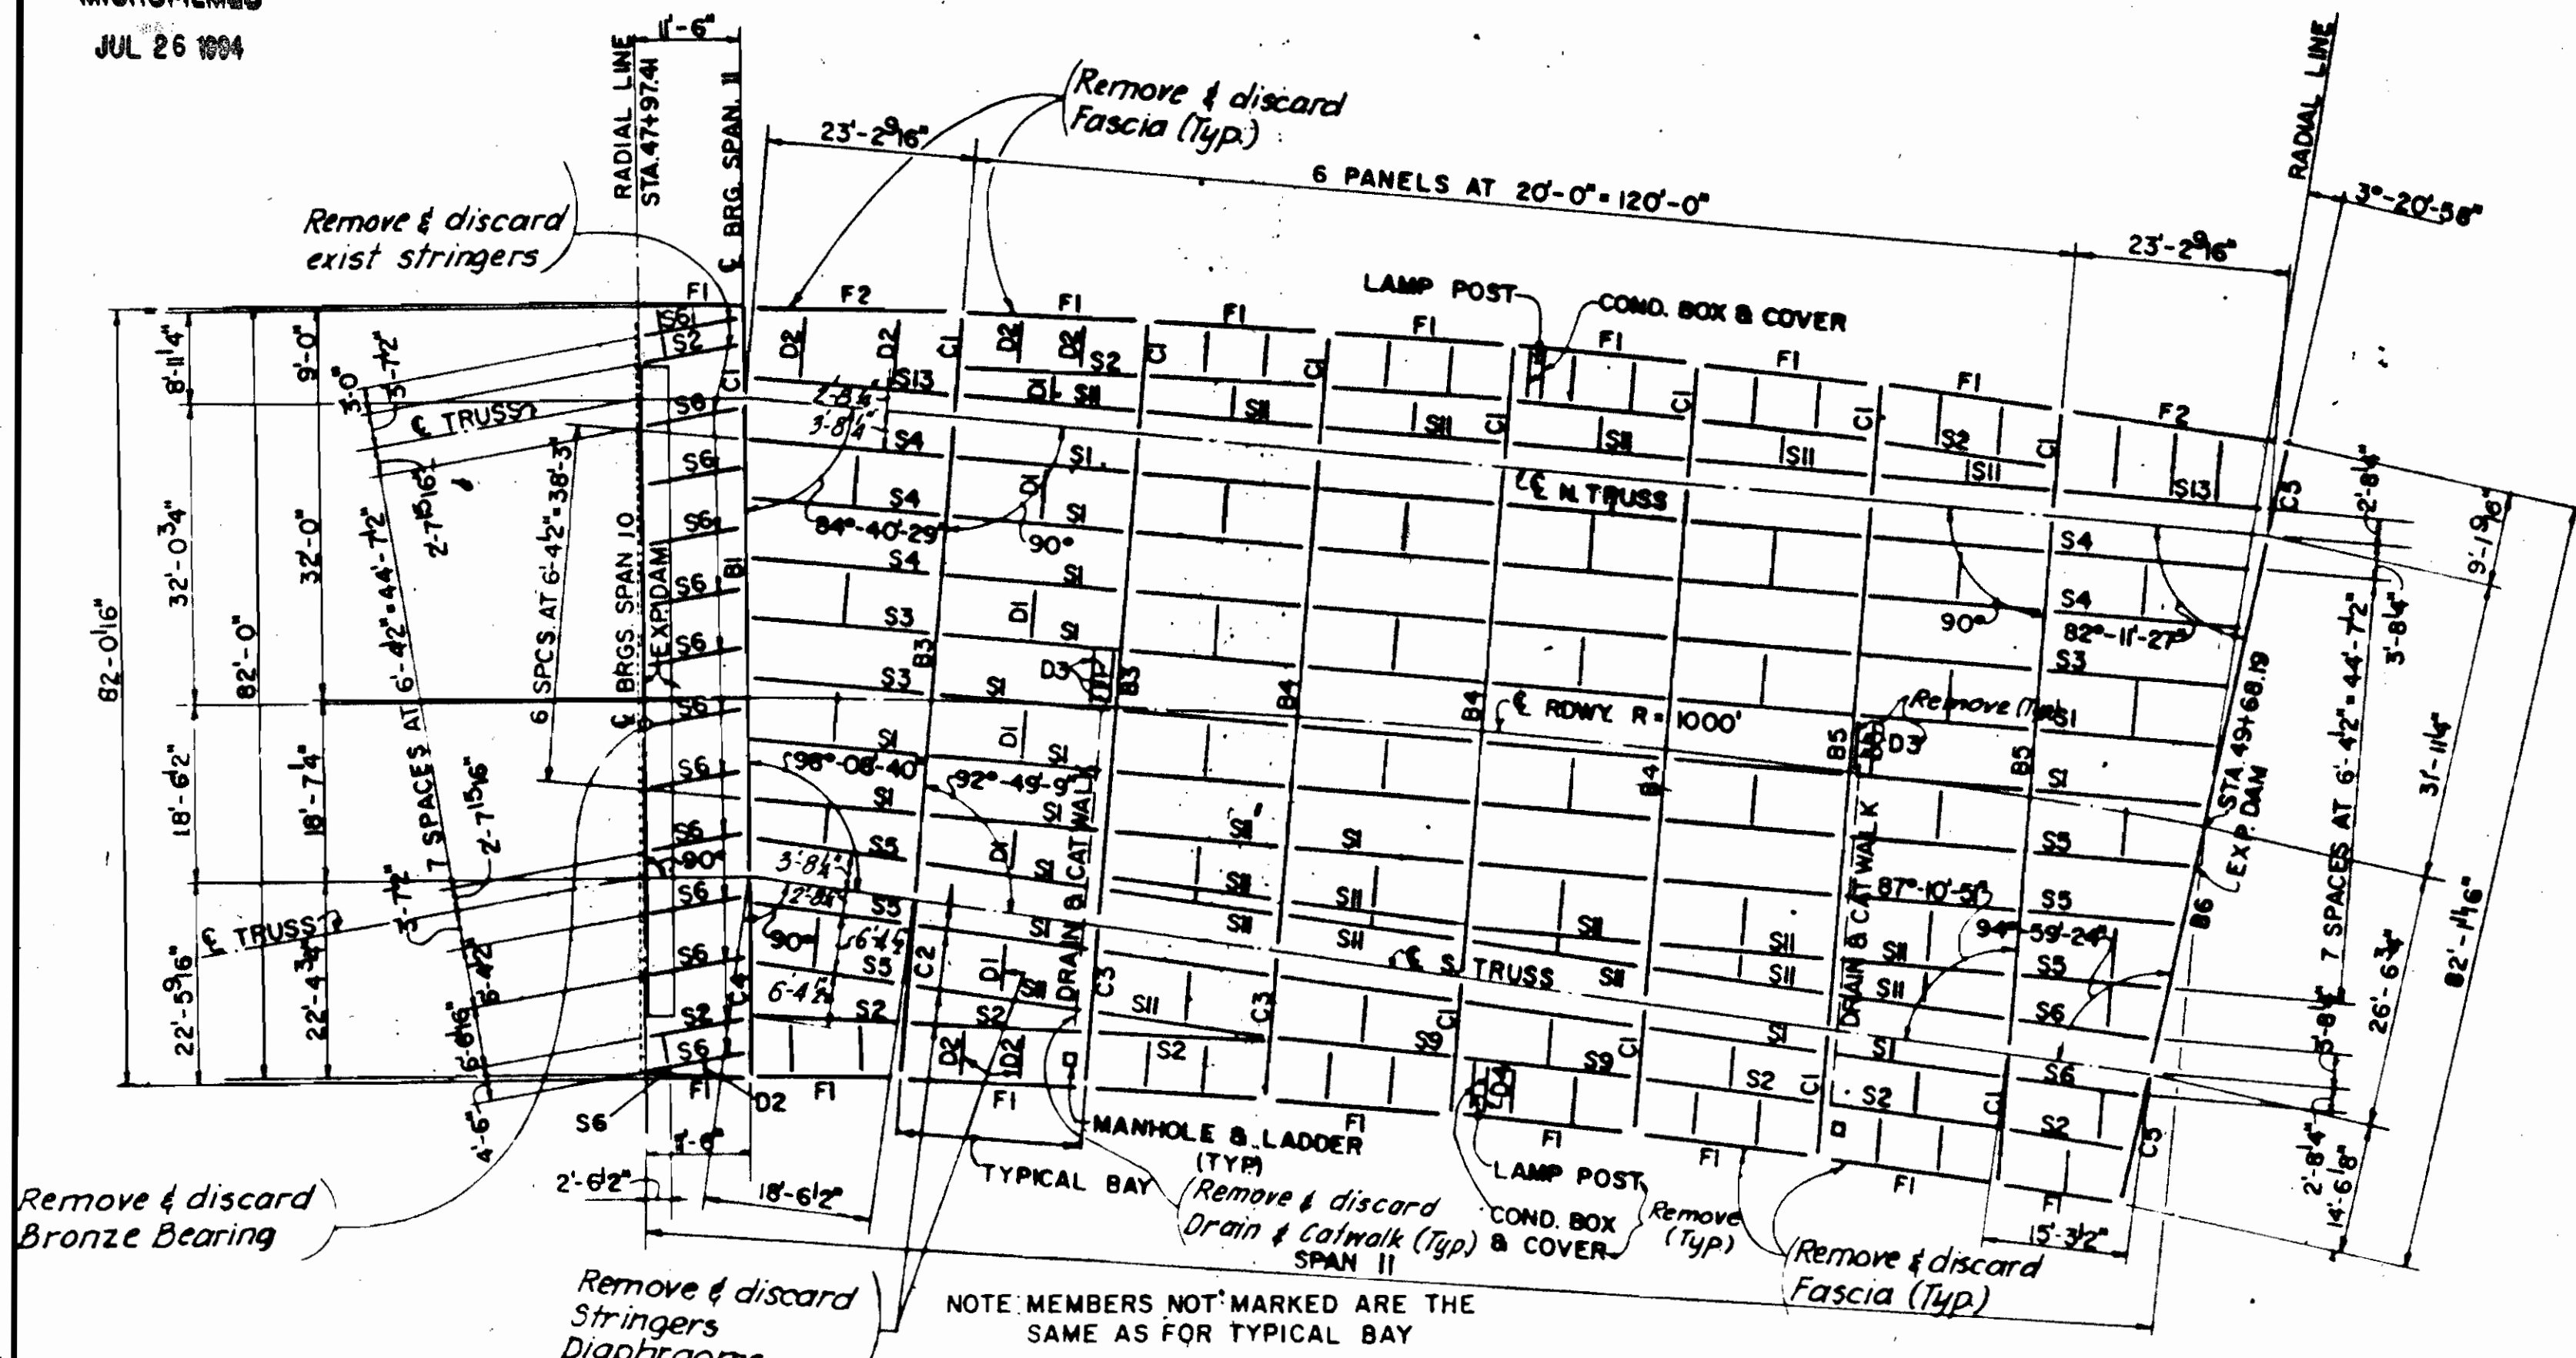


EXISTING FRAMING PLAN

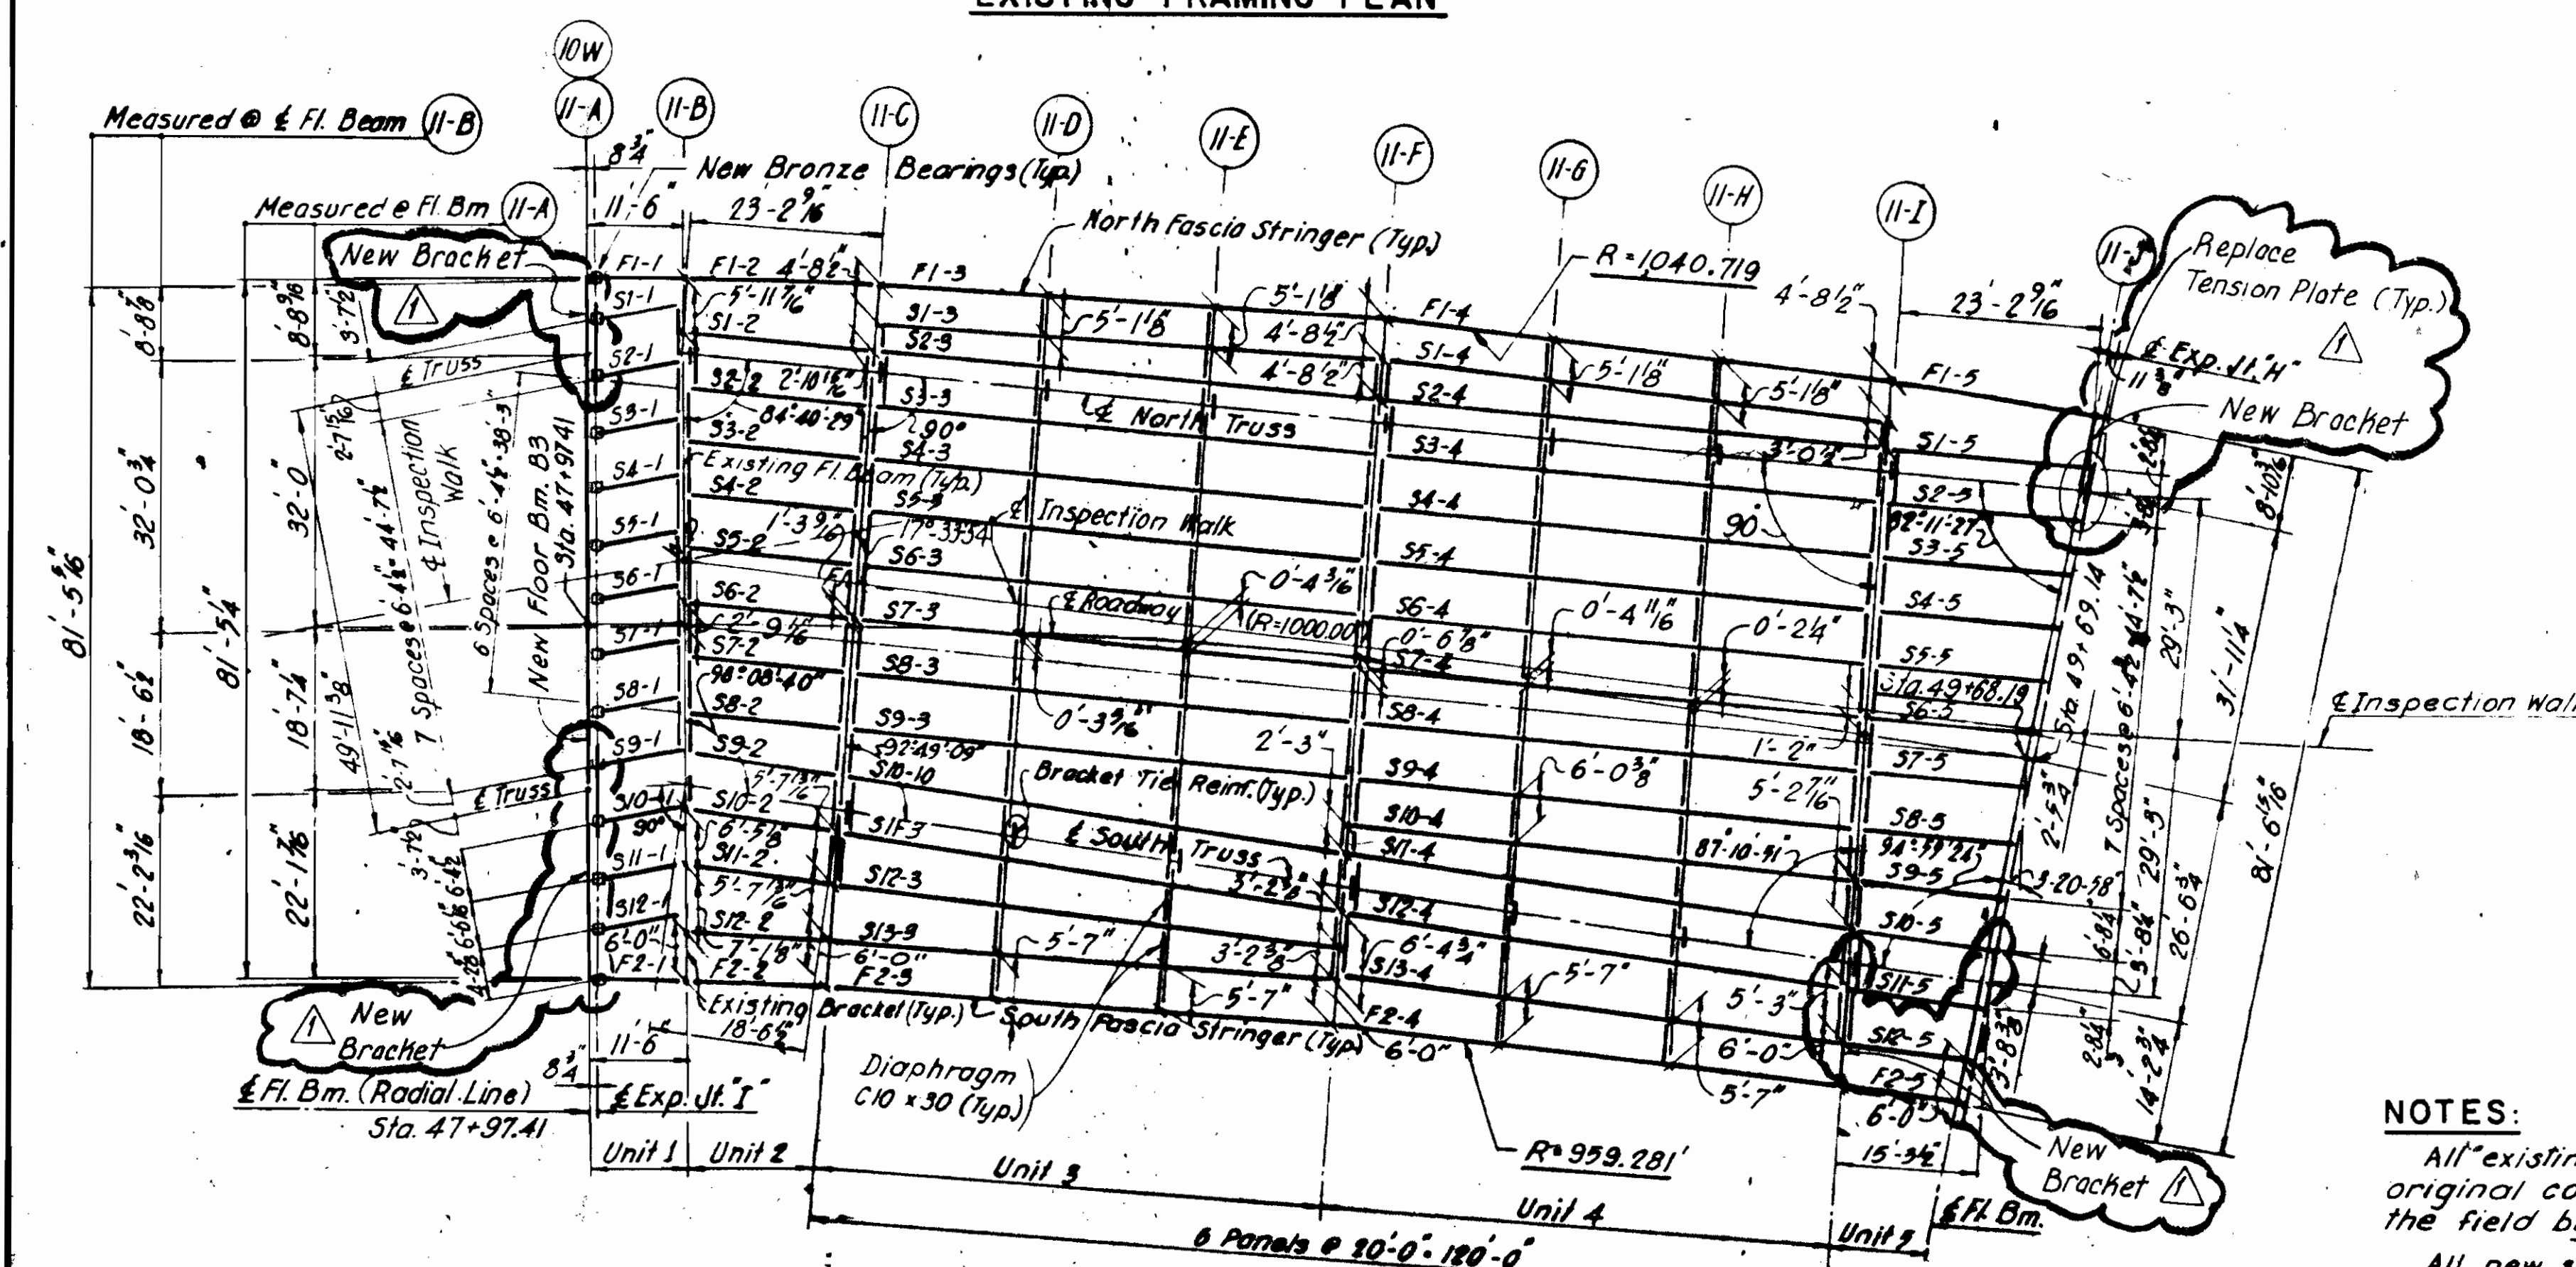


TRUSS SPAN II - PROPOSED FRAMING PLAN

Denotes existing framing member  
Denotes new framing member

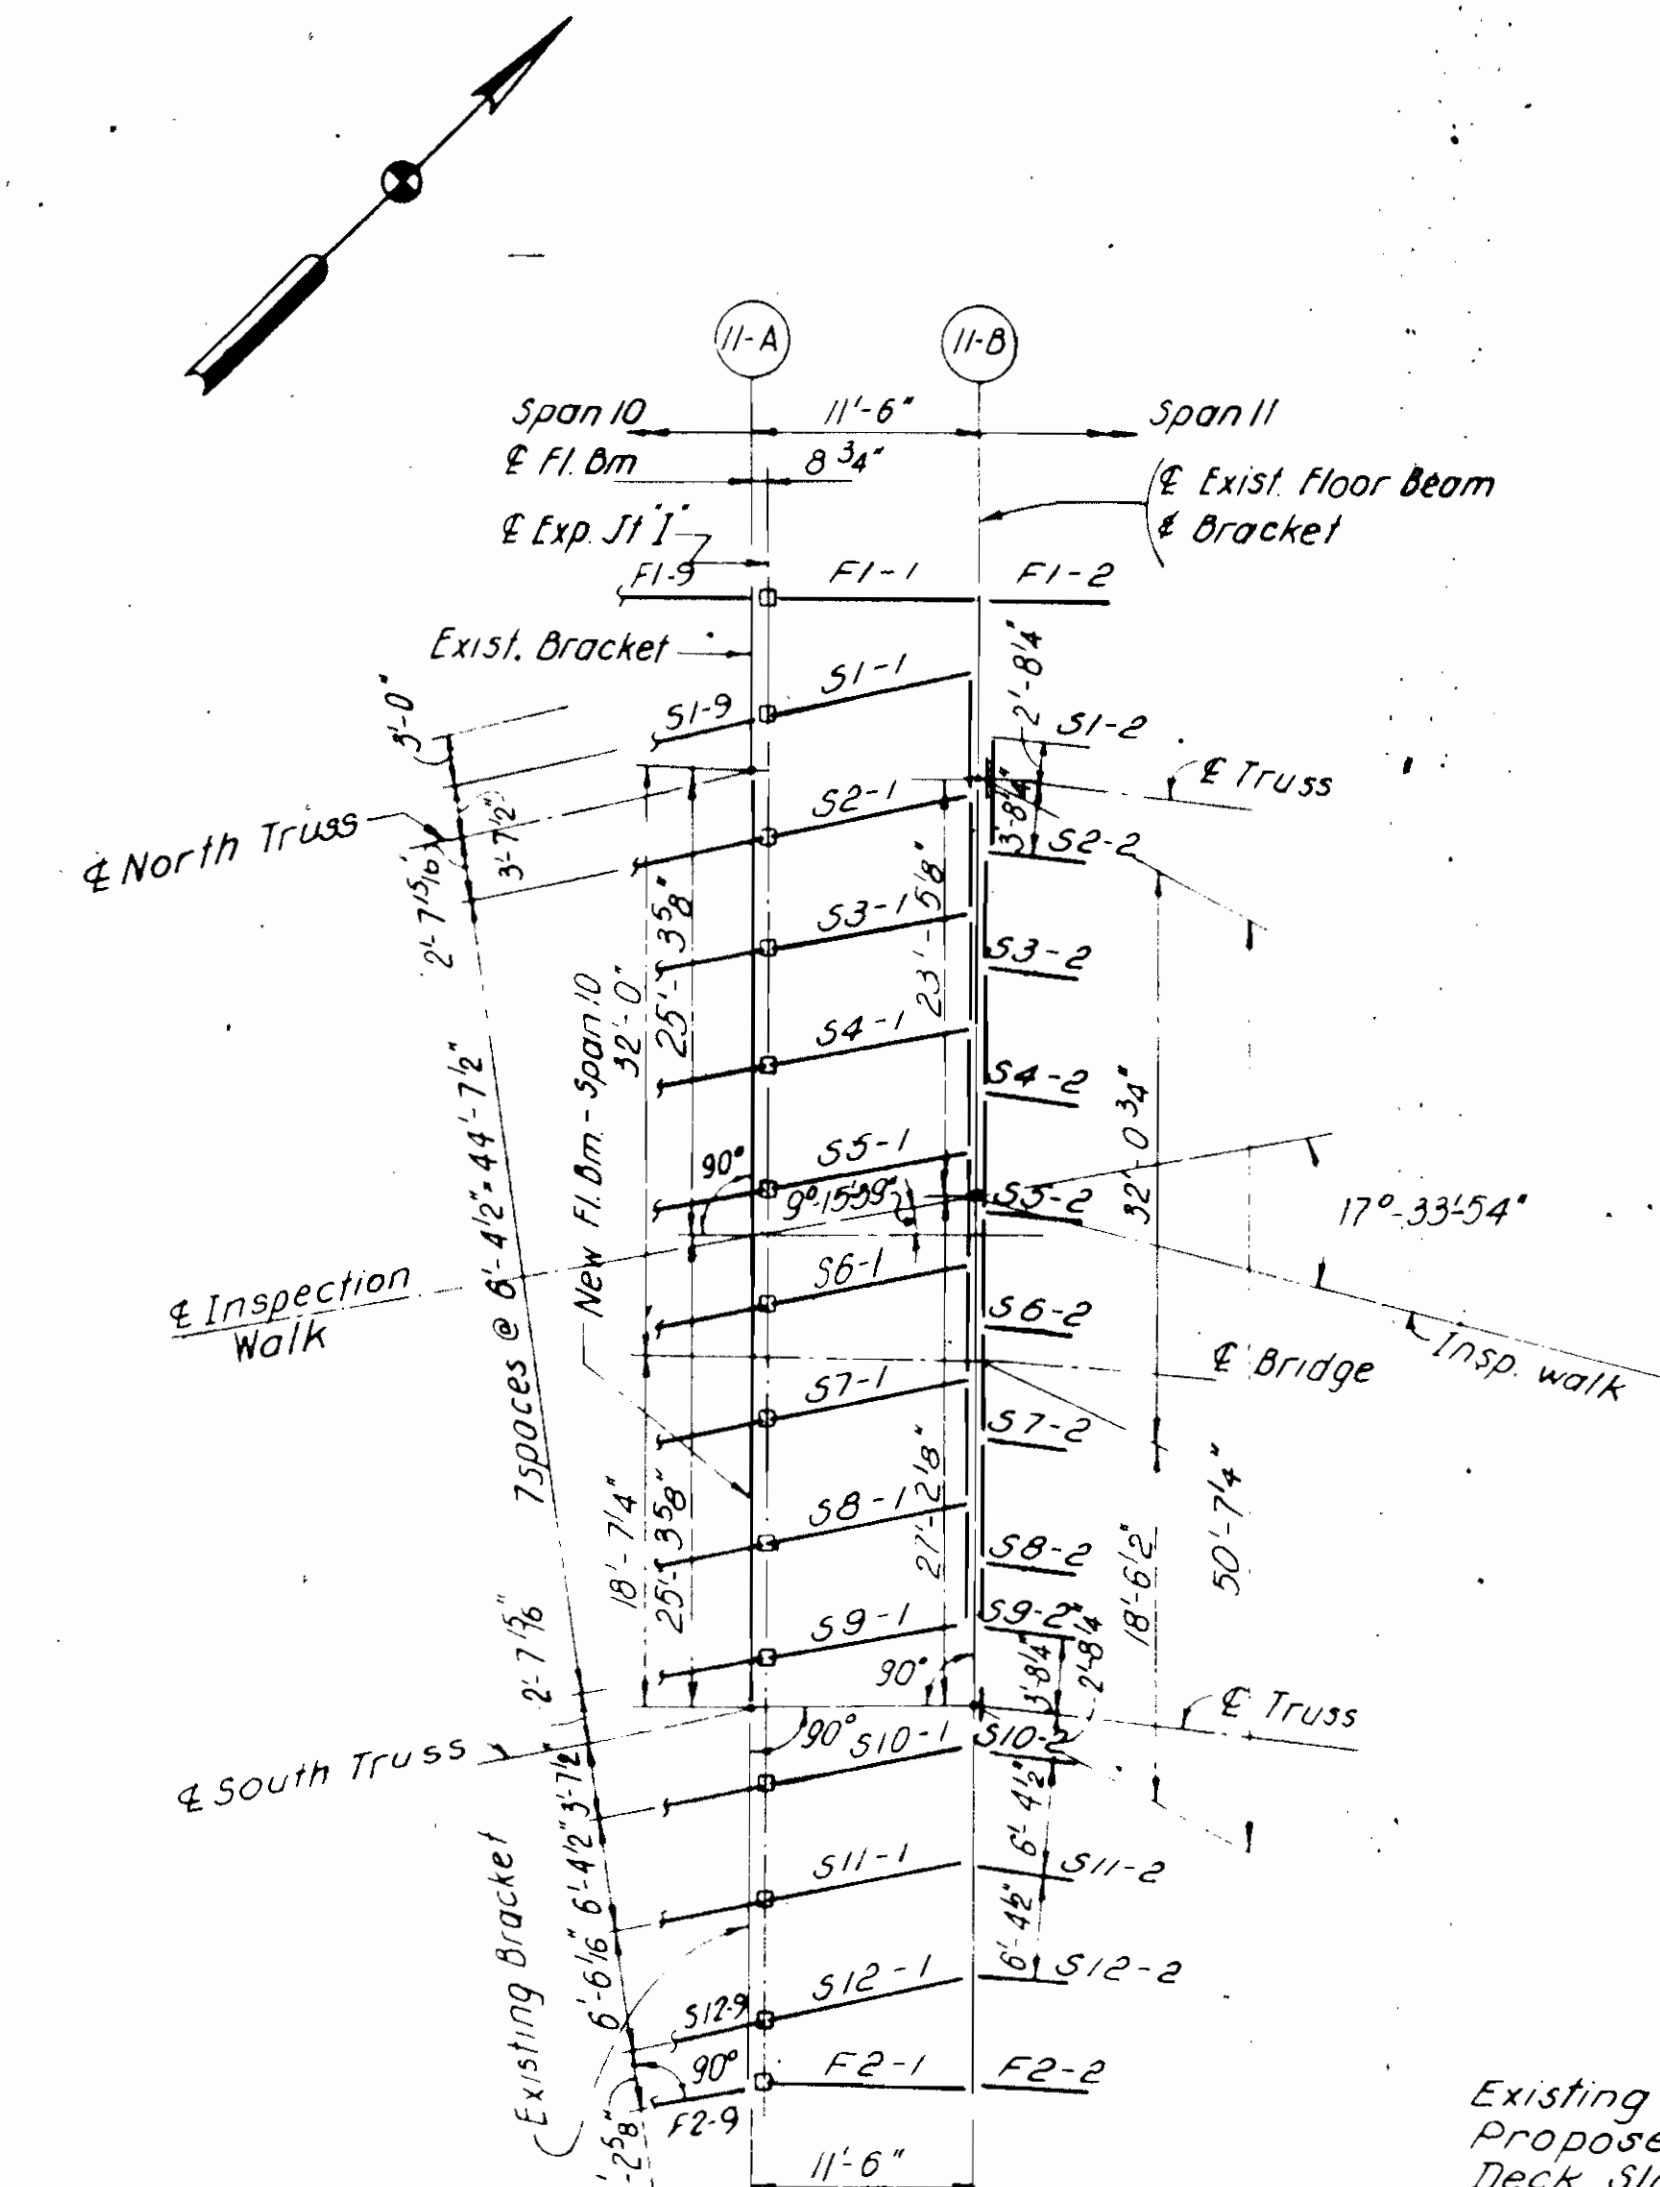

PARTIAL FRAMING PLAN

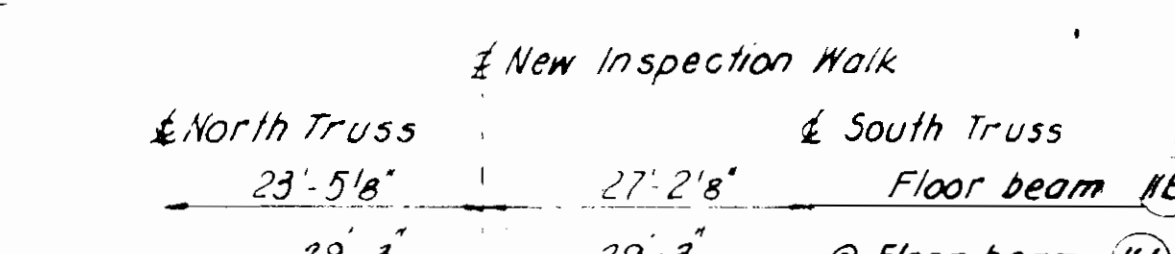

TYPICAL SECTION - INSPECTION WALK (LOOKING EAST)

REFERENCES:

- Existing Plan and Elevation 301
- Proposed Plan and Elevation 302
- Deck Slab Reinforcement 340
- Inspection Walkway 257, 258, 259
- Miscellaneous Structural Details (Span II) 336
- Stringer Schedules (Span II) 325 & 326
- Top of Deck Elevations & Deflections 337
- Fascia Stringer Setting Dimensions and Camber 331
- Typical Stringer Detail 231
- Exp Joint "H" 349
- Exp Joint "I" 278
- New Floorbeam B3 254
- New Brackets 309A

DWG. NO.

Rev. 1	Plan Revisions	2-10-91
--------	----------------	---------

PAVLO ENGINEERING CO., P.C.  
NEW YORK, NEW YORK

CUYAHOGA COUNTY ENGINEER  
CLEVELAND OHIO

**MAIN AVENUE BRIDGE**  
CITY OF CLEVELAND  
BRIDGE OVER THE CUYAHOGA RIVER VALLEY  
**EAST APPROACH-FORWARD SECTION-SPAN II**  
**EXIST. & PROP. FRAMING PLAN**


BRIDGE NO. 193 REPORT NO. 7119 DATE Oct 20 1991

**NO. B-136**

DESIGN A.S.	DRAWN J.P.W.	CHECKED A.P./R.M.	REVISED TO AS BUILT AS BUILT 2/94
----------------	-----------------	----------------------	--------------------------------------

NOTES:

- All existing dimensions, elevations and details were obtained from original contract plans and shop Dwg's and shall be verified in the field by the Contractor, prior to making structure alterations.
- All new shapes and plates shall be ASTM-A36 steel (AASHTO-M183) unless noted otherwise.
- Welding details and procedures shall conform to the A.W.S. and AASHTO latest specifications.
- All new Rolled Beams, Shapes and Plates shall be ASTM A36, AISC Category I.
- All new welded Members including Fascia Stringers, Replacement of Floor Beams and Brackets shall be ASTM A36, AISC Category III.

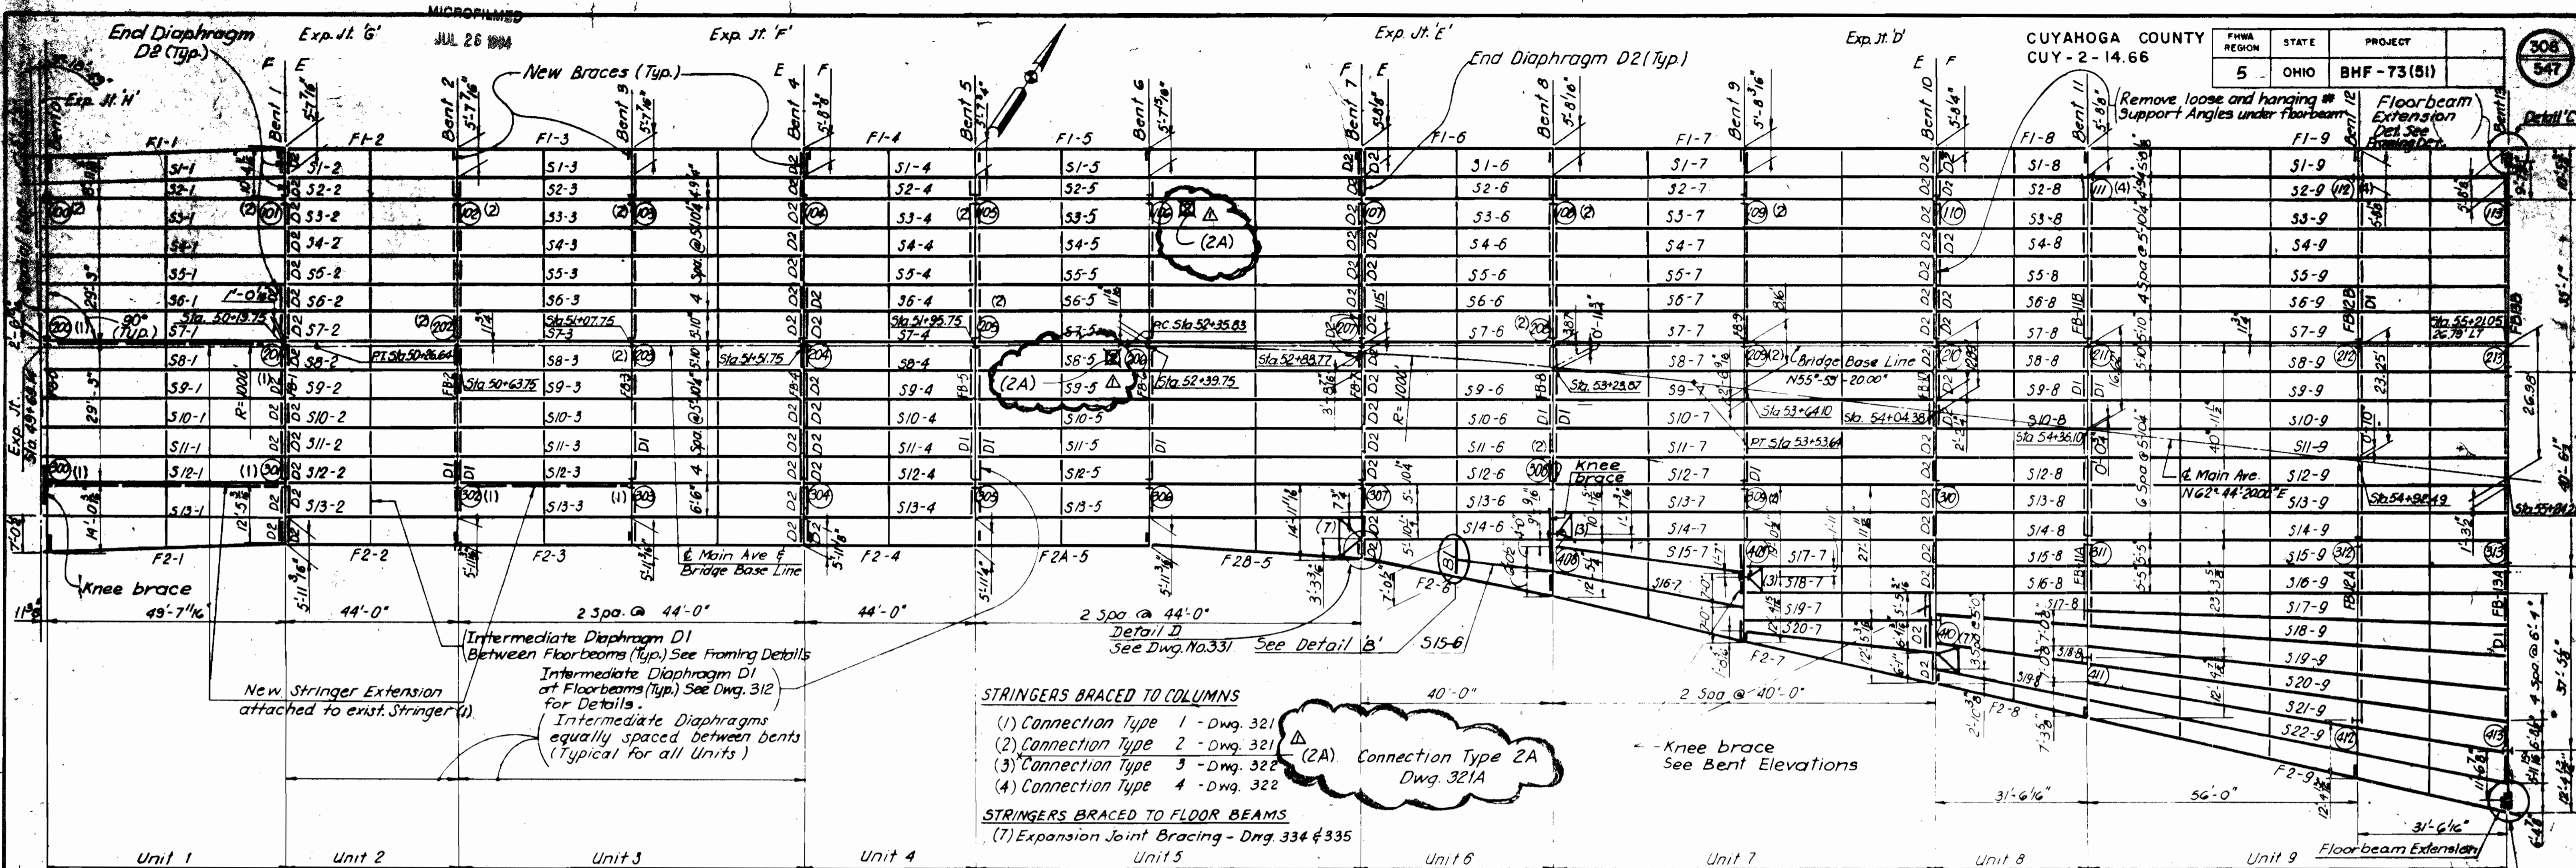

**STRINGERS BRACED TO COLUMNS**

(1) Connection Type 1 - Dwg. 321  
 (2) Connection Type 2 - Dwg. 321  
 (3) Connection Type 3 - Dwg. 322  
 (4) Connection Type 4 - Dwg. 322

**STRINGERS BRACED TO FLOOR BEAMS**

(7) Expansion Joint Bracing - Dwg. 334 & 335

(2A) Connection Type 2A  
 Dwg. 321A


**MAIN FLOOR PLAN**

All new stringers shall be installed vertical.  
 For Finishing Machine Support notes see Dwg. G8  
 Welding of attachments shall not be permitted in the tension zone of the stringers  
 For Stringers in truss spans the tension zone is 3'-0" each side of interior supports  
 For Stringers in units 1 thru 9 East of Bent 0 the tension zone is 6'-0" each side of intermediate support

NOTE: All stationing shown on plan is based on & Main Ave stations

Grind Welds smooth in direction of stress as required to install flange Reinforcement at column 40. Care shall be taken not to undercut or gouge Flange.

Replace Gusset R's on Col. 200 See Bent O Elevation

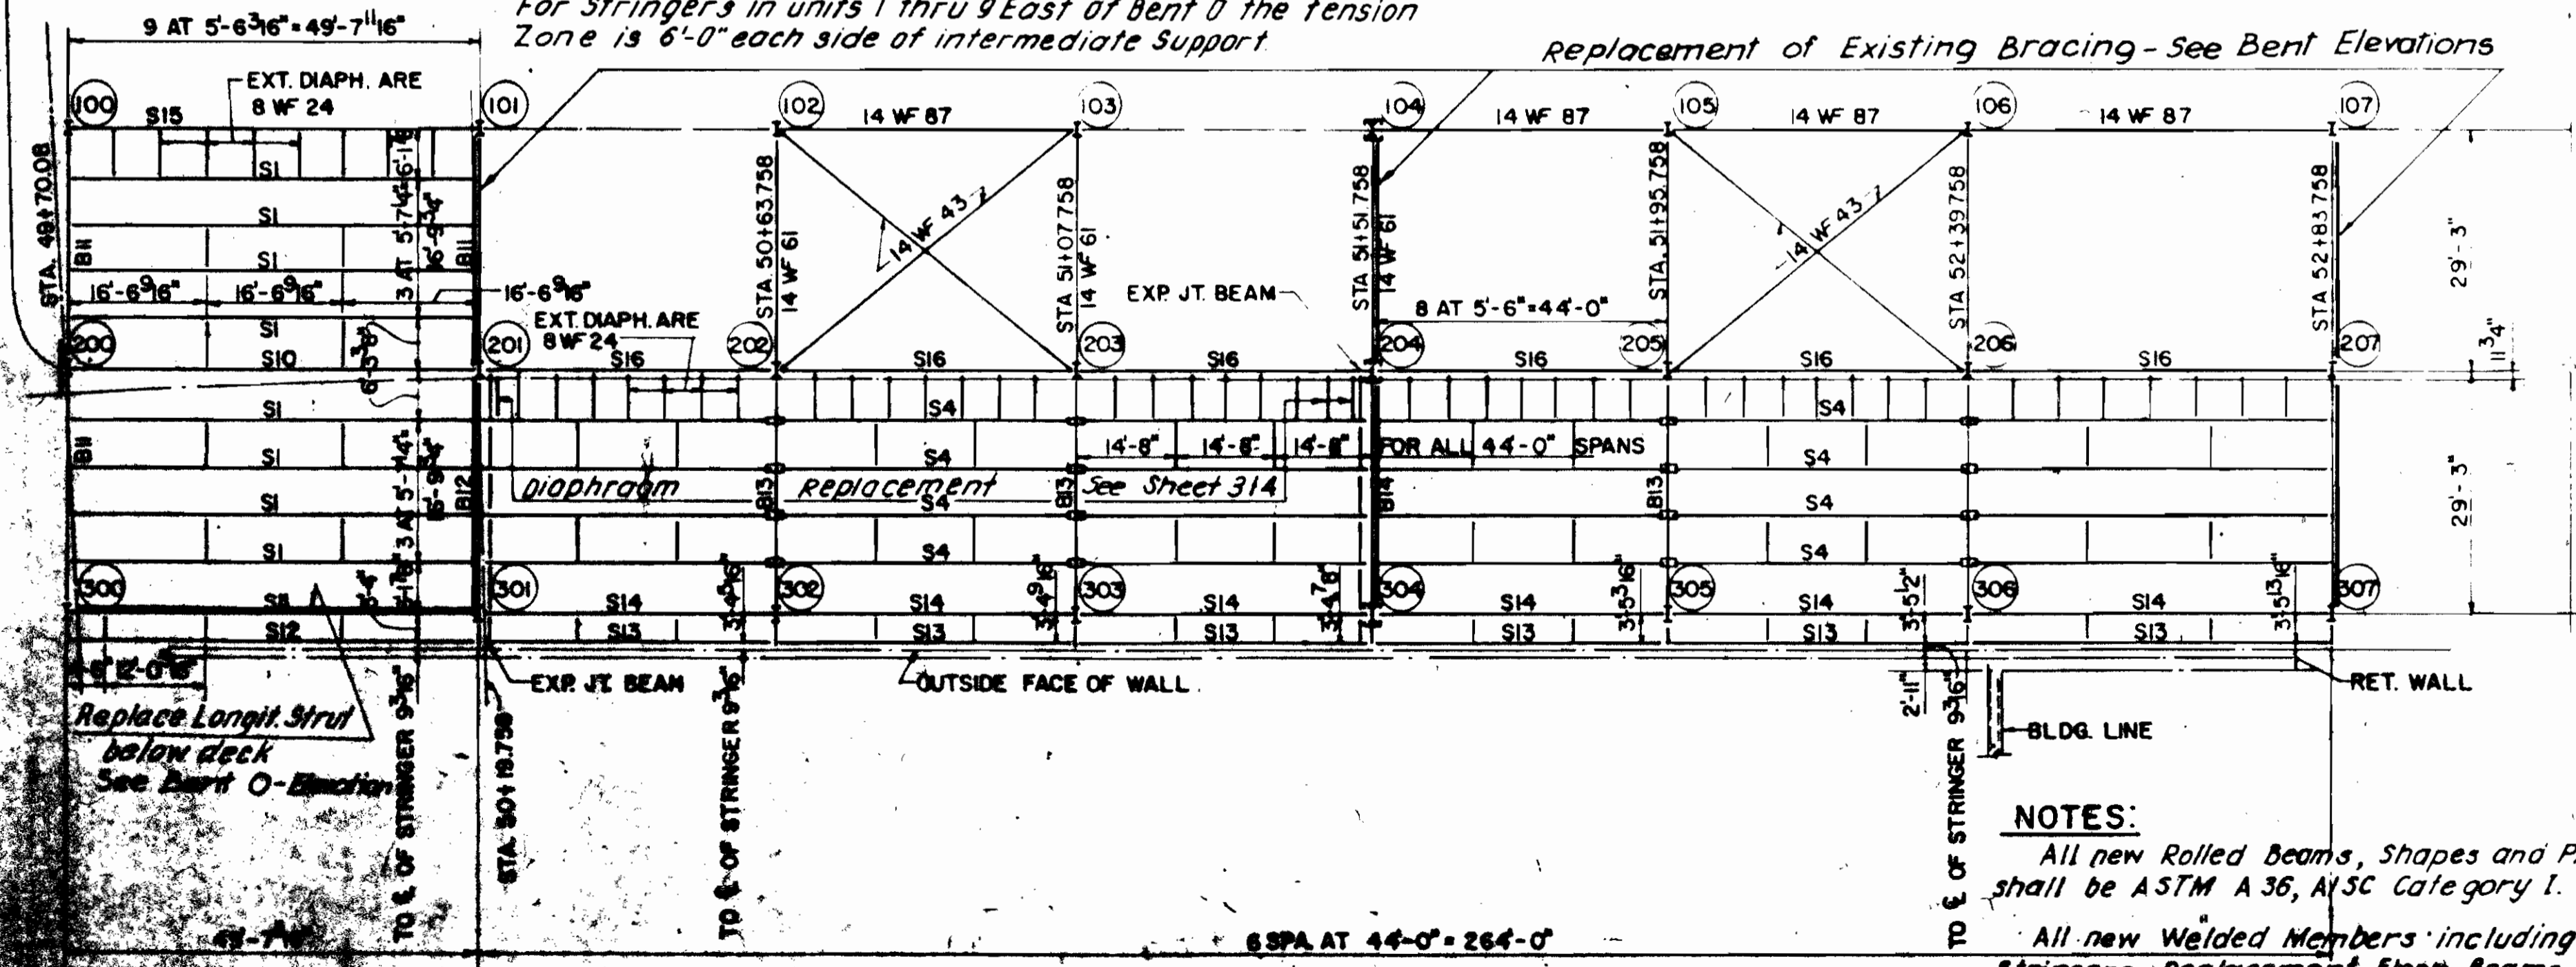

**LOWER DECK AND BRACING PLAN**

**NOTES:**

All new Rolled Beams, Shapes and Plates shall be ASTM A36, AISC Category I.

All new Welded Members including Fascia Stringers, Replacement Floor Beams and Brackets shall be ASTM A36, AISC Category II.

**PEDESTAL DETERIORATION (Requires Type M-1 repair)**

Column #	Damage
300	Exposed rebars on 3 sides
101	5" deep spalls, rebars corroded
202	Spalls & exposed rebars
302	Delaminated concrete, 6 S.F.
103	Delaminated concrete, 9 S.F.; exposed rebar
303	Cracked & delaminated concrete, 24 S.F.
104	Deteriorated rebar 4 sides, & 24 S.F. delaminated concrete, 5" deep.
304	Spalled & delaminated concrete 4 sides 24 S.F.
305	Delaminated concrete, 2 sides, 12 S.F.
106	3 S.F. delaminated & cracked concrete
306	6 S.F. delaminated concrete
307	Spalls & corroded rebars, all sides; 18 S.F. delaminated concrete, 5" deep.
108	Exposed rebars, & 5" deep delaminated conc. 3 sides
308	12 S.F. cracked + delaminated concrete, 2 sides
109	7 S.F. "
209	10 S.F. "
309	6 S.F. cracked + delaminated concrete, 3 S.F. cracked one side of Pedestal.
210	Spalls & exposed rebars, all sides, 36 S.F.
310	18 S.F. spalled & delaminated concrete, exposed bars
410	4 sides of pedestal deteriorated, 24 S.F.

**Summary:**  
 290 S.F. of concrete to be repaired

Bent floorbeams and columns may be straightened by heat if required.  
 Columns which are out of plumb shall be plumbed to within 1/4" of vertical and made straight from the base up. See General Notes.

**REFERENCES:**

REFERENCE	DWG. NO.
C.V.N. Note	302
Typical Cross Section	303
Existing Framing Plan	310
Stringer Connection Detail of Exp. Joint	333
Curb Stringer, Details at Exp. Joint	334, 335
Stringer Details	324
Stringer Schedules	327 to 330
Framing & Brg. Details, Detail 'C'	332
Fascia Stringer setting Dimension	331
Bent Elevations 0-13	313 to 317
Stringer to Col. Bracing Sh 1 & 2	321 & 322
Exp Joint Detail	346 to 350
Stringer to Col. Connect. Types 1 to 4	321 & 322
Detail 'B'	314
Concrete Repairs	674

PAVLO ENGINEERING CO., P.C.  
 NEW YORK, NEW YORK

CUYAHOGA COUNTY ENGINEER  
 CLEVELAND OHIO

**MAIN AVENUE BRIDGE**  
 CITY OF CLEVELAND  
 BRIDGE OVER THE CUYAHOGA RIVER VALLEY

EAST APPR-FORWARD SECTION-BENTS 0-13  
**PROPOSED FRAMING PLAN**

BRIDGE NO. 193 REPORT NO. 719 DATE: 5/15/91

**NO. B-136**

DESIGN B.G.	DRAWN A.D.	CHECKED AP/RN	REVIEWED BY AS/BU
----------------	---------------	------------------	----------------------

MICROFILMED  
JUL 26 1984

CUYAHOGA COUNTY  
CUY - 2 - 14.66

FHWA REGION	STATE	PROJECT
5	OHIO	BHF-73(51)

307  
547

\* See Existing Underbridge Lighting Note on Dwg. 310

REMOVE TOP OF STONE MASONRY PYLON. See Pylon Modifications

Conduit to garage under bridge  
Remove Bracing See Detail

4-Conduits attached to the bottom of all stringers

Conduit to garage under bridge

REMOVE TOP OF STONE MASONRY PYLON. See Pylon Modifications


NOTE  
Remove and discard all existing stringers, fascias and diaphragms.

EXISTING FRAMING PLAN  
1" = 8' 16' 32'


STRINGERS BRACED TO COLUMNS  
(5) Connection Type 5 - Dwg. 322  
(6) Connection Type 6 - Dwg. 321

COLUMN NOTE  
The following columns were out of proper alignment during surveys done prior to Nov. 1988: 114, 214, 314, 414, 514 & 614.



PROPOSED FRAMING PLAN  
1" = 8' 16' 32'

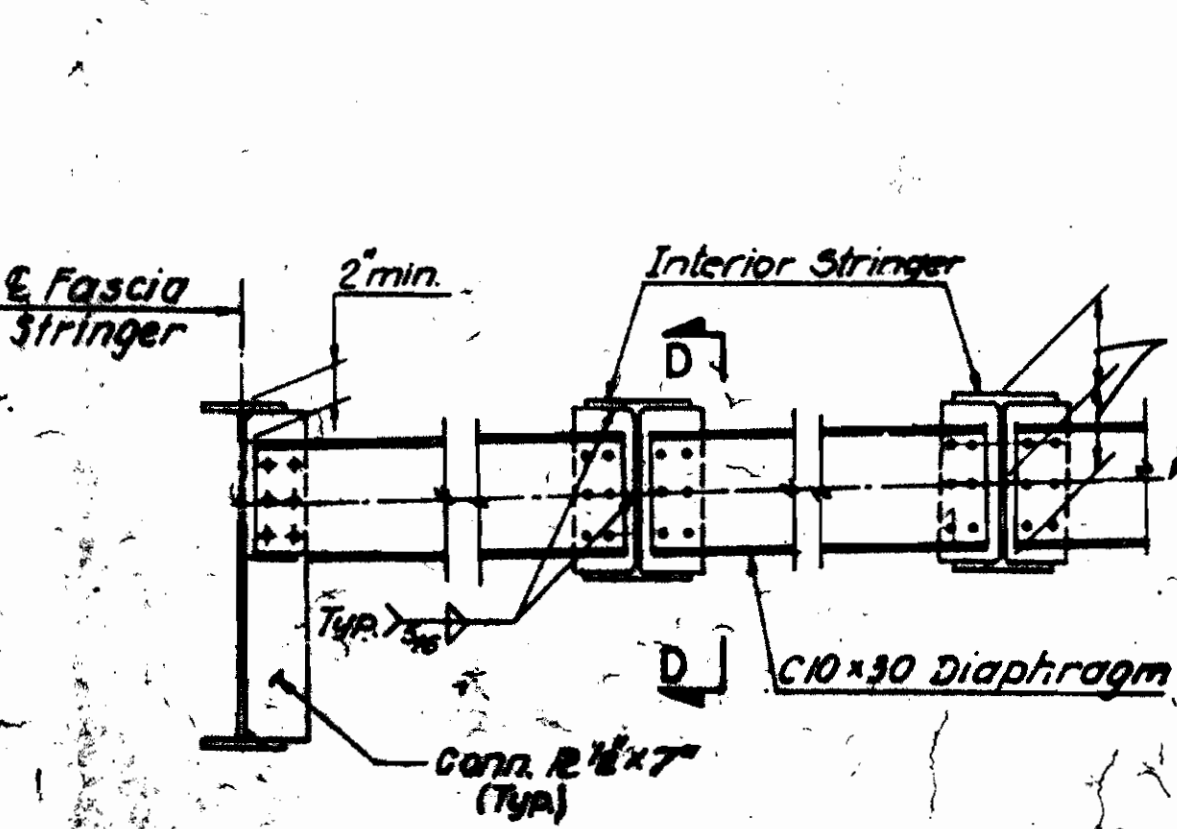


NEW INTERMEDIATE DIAPHRAGMS AT FLOORBEAM SECTION D-D

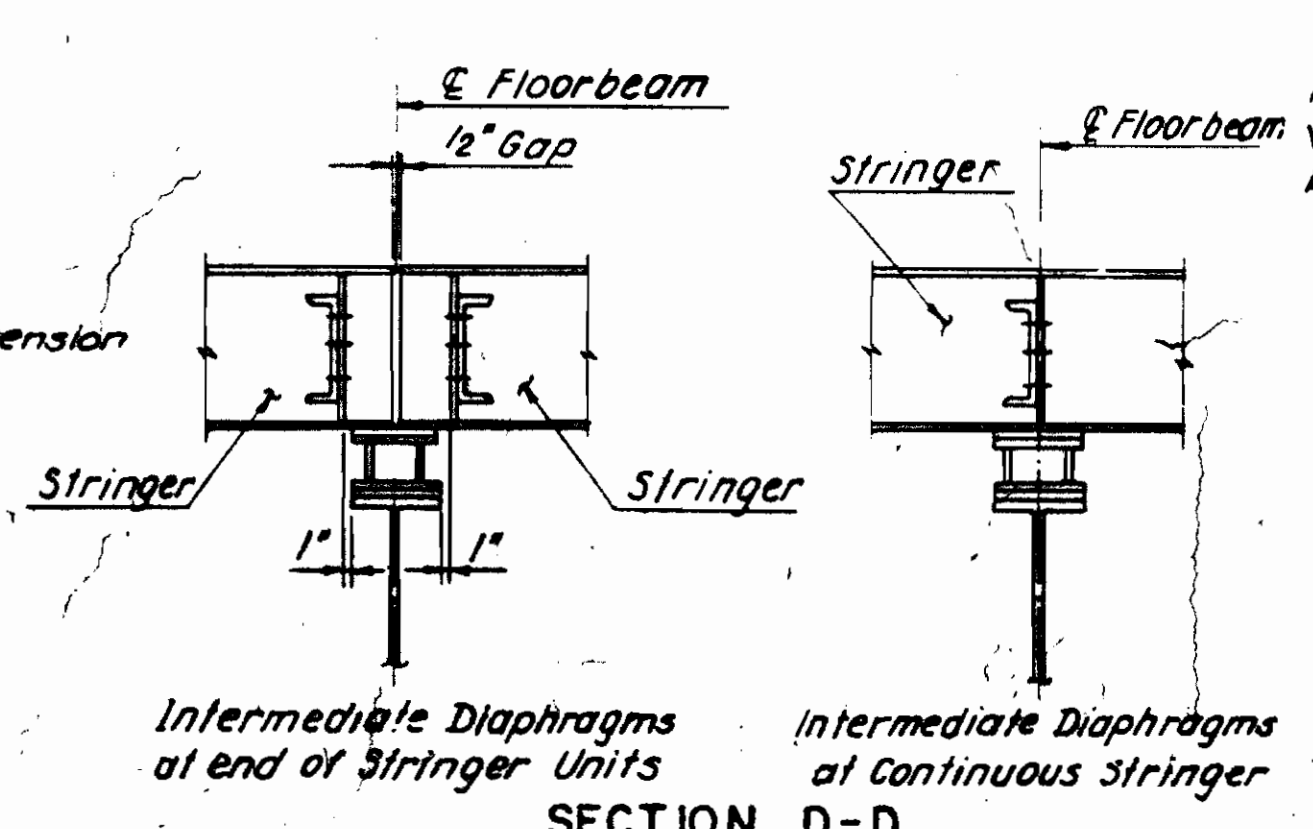

DIAPHRAGM CONNECTION TO W16x67 STRINGER WHERE DIMENSION A,B,C, OR D IS MIN. 1.13' (13 1/2")

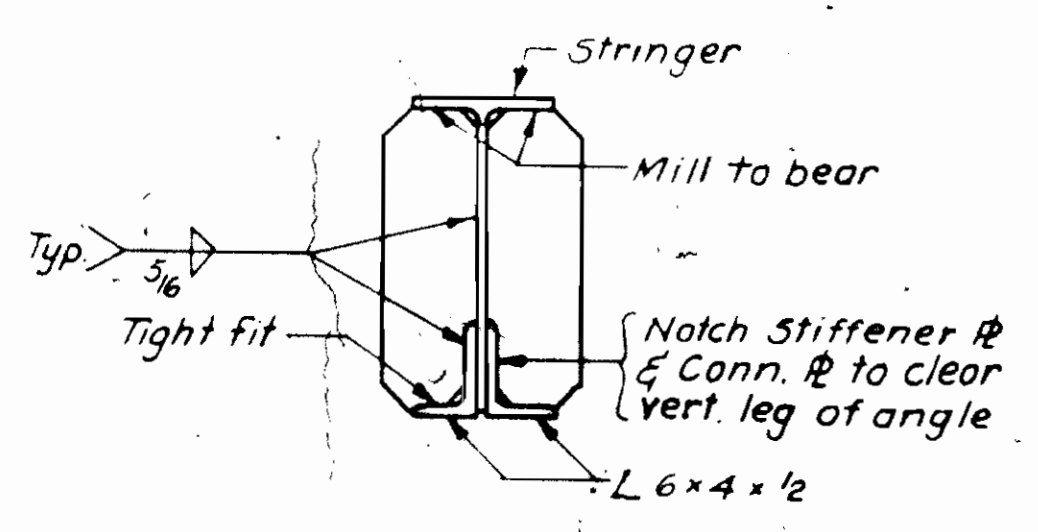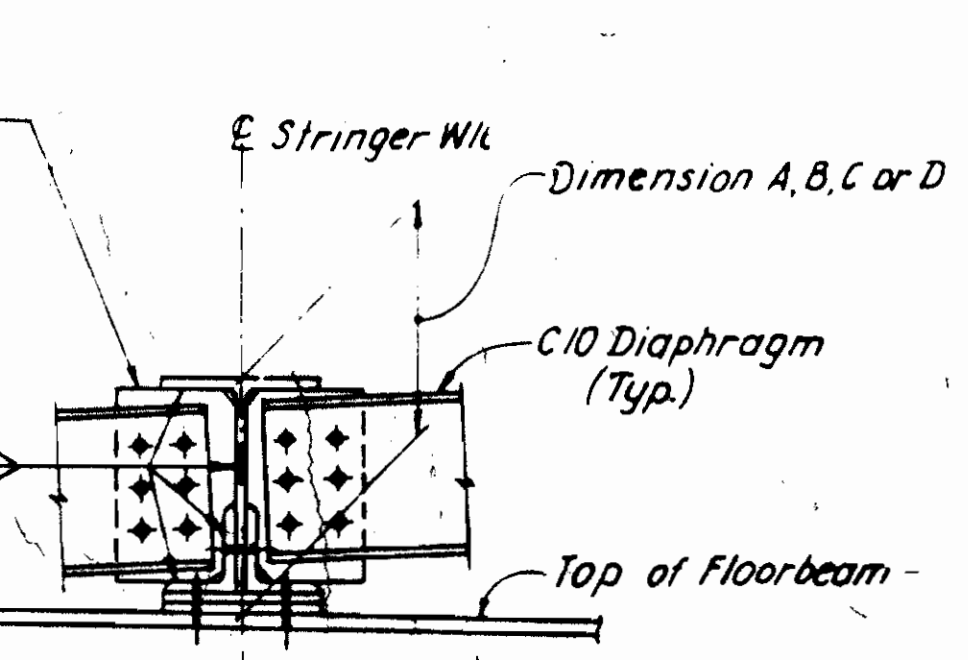


CONN. R & STIFF. R DETAIL

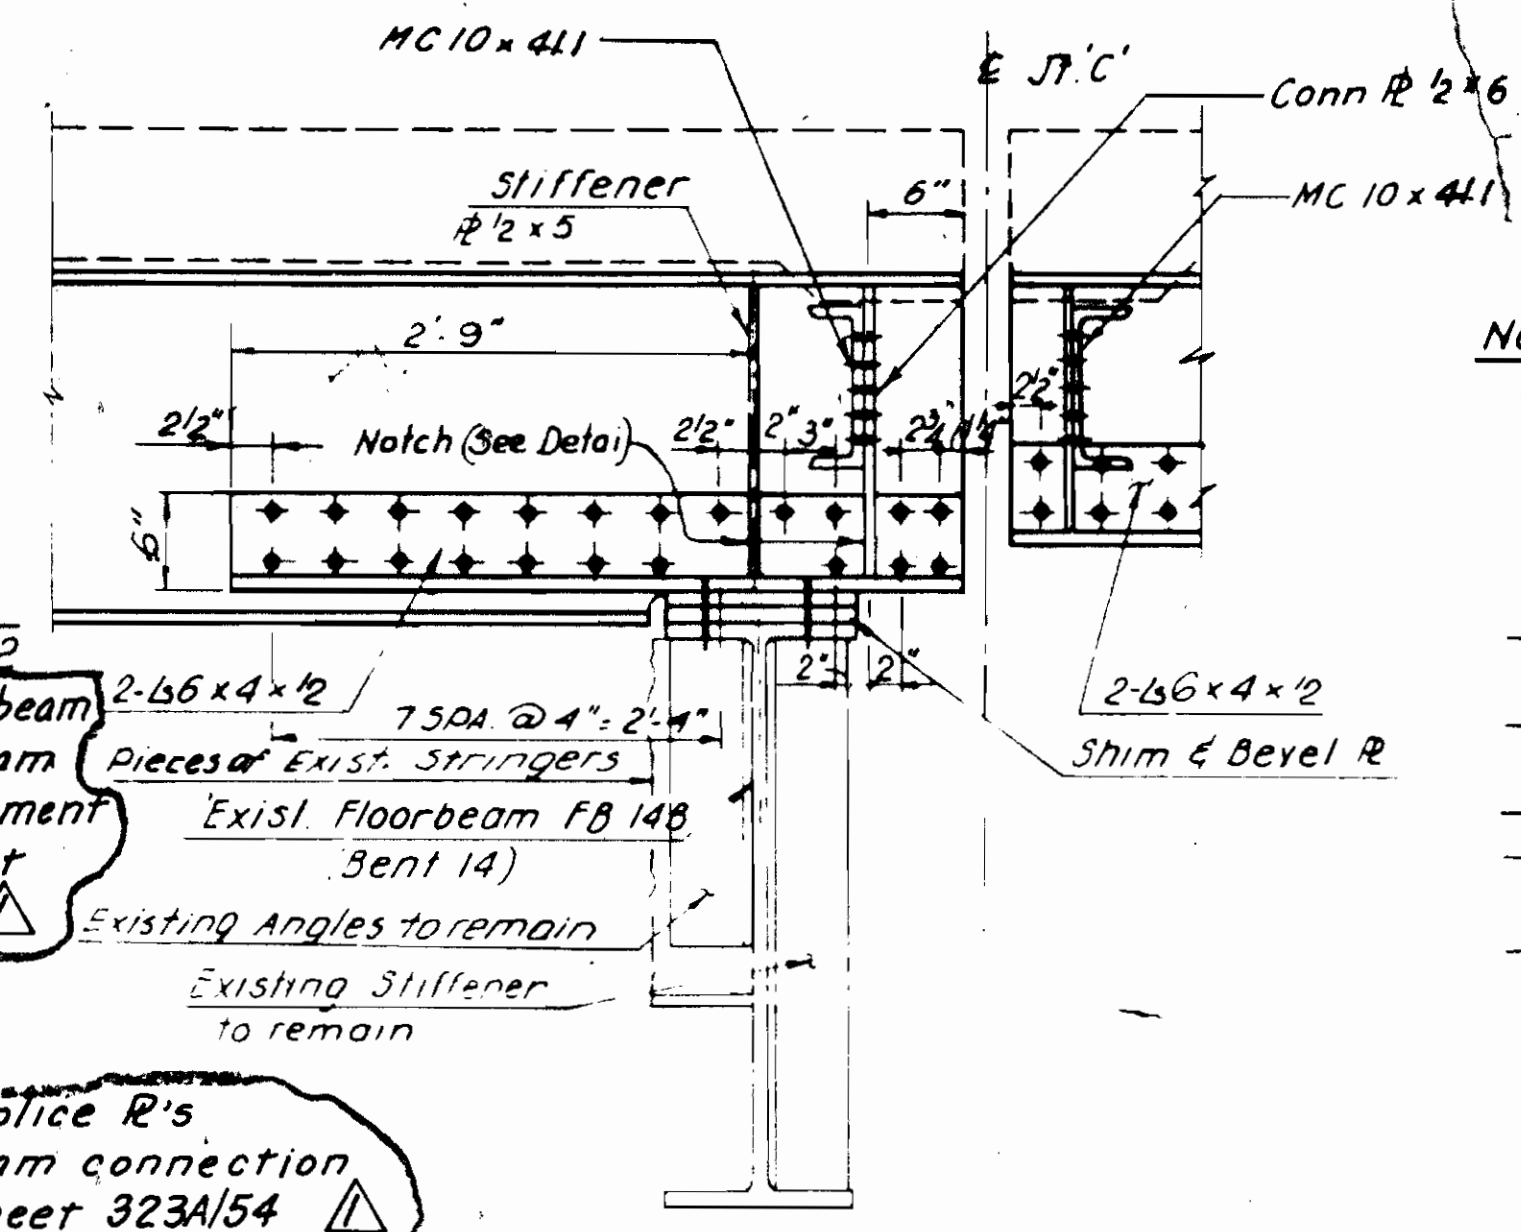

Forward Section Lakefront Trestle See Dwg No 447

DETAIL AT JOINT 'C'

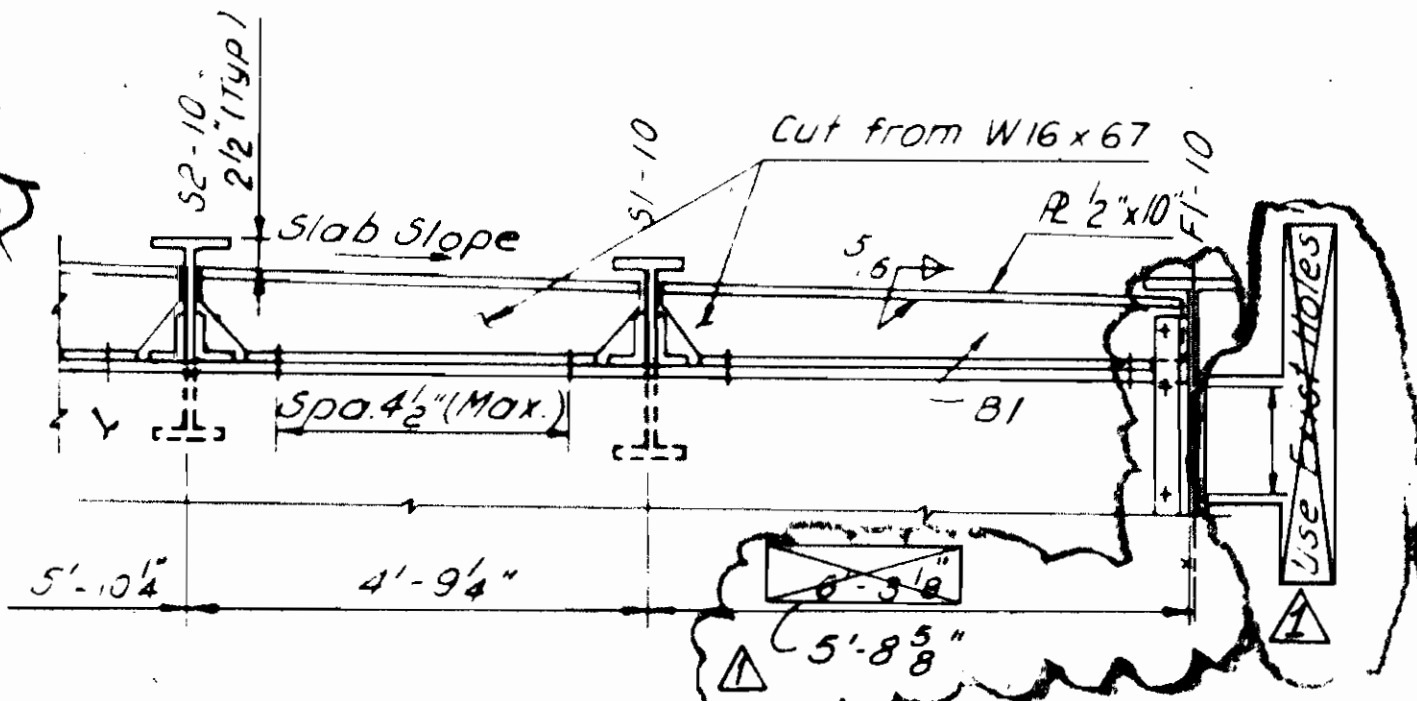

END BOLSTER SUPPORT-B1

SECTION A-A  
1" = 6' 0' 1' 2' 3' 4'

NOTES:

- All existing dimensions, elevations and details were obtained from original contract plans and shop drawings and shall be verified in the field by the contractor.
- All dimensions shown on proposed plans are measured horizontally.
- All connection plates for intermediate diaphragms shall be placed perpendicular to flanges.
- All bearing stiffeners shall be vertical under full Dead Load.
- All new Rolled Beams, Shapes and Plates shall be ASTM A36, AISC Category I.
- All new Welded Members including Fascia Stringers, Replacement Floor Beams and Brackets shall be ASTM A36, AISC Category III.

LEGEND

- ◆ Existing fastener (rivet or bolt) to remain in place.
- New bolts in all new steel, 7/8" high strength bolt, unless otherwise noted.
- ⊕ Replace existing fastener with new bolt for the attachment of new steel to existing steel, 7/8" high strength bolt unless otherwise noted.
- ⊖ New bolt for the attachment of new steel to existing steel, field drilled holes in existing steel to match shop drilled holes in new materials. 7/8" H.S. bolt unless otherwise noted.

REFERENCES:

REFERENCE	DWG. NO.
Concrete Repair Details	G74
Stringer Details	324
Stringer Schedules	327-330
Fascia Stringer setting Dimension	331
Floorbeam replacement	323
Stringers-Column bracing Sh 142	32, 322
Detail 'C'	332
Pylon Modifications	309
Floor beam 14C Replacement Detail	323A

Rev. 2	2 Plan Revisions	5/2/91
Rev. 1	1 Plan Revisions	3-1-91

PAVLO ENGINEERING CO., P.C.  
NEW YORK, NEW YORK

CUYAHOGA COUNTY ENGINEER  
CLEVELAND OHIO









MAIN AVENUE BRIDGE  
CITY OF CLEVELAND  
BRIDGE OVER THE CUYAHOGA RIVER VALLEY

E. APPR. - FORWARD SECTION - BENTS 13 & 14  
EXIST. & PROP. FRAMING PLAN

BRIDGE NO. 193 REPORT NO. 7119 DATE Oct 20, 1989

NO. B-136

DESIGN B.G.	DRAWN T.C.	CHECKED AR/RM	REVISED TO AS BUILT AS BUILT 2/94
----------------	---------------	------------------	--------------------------------------

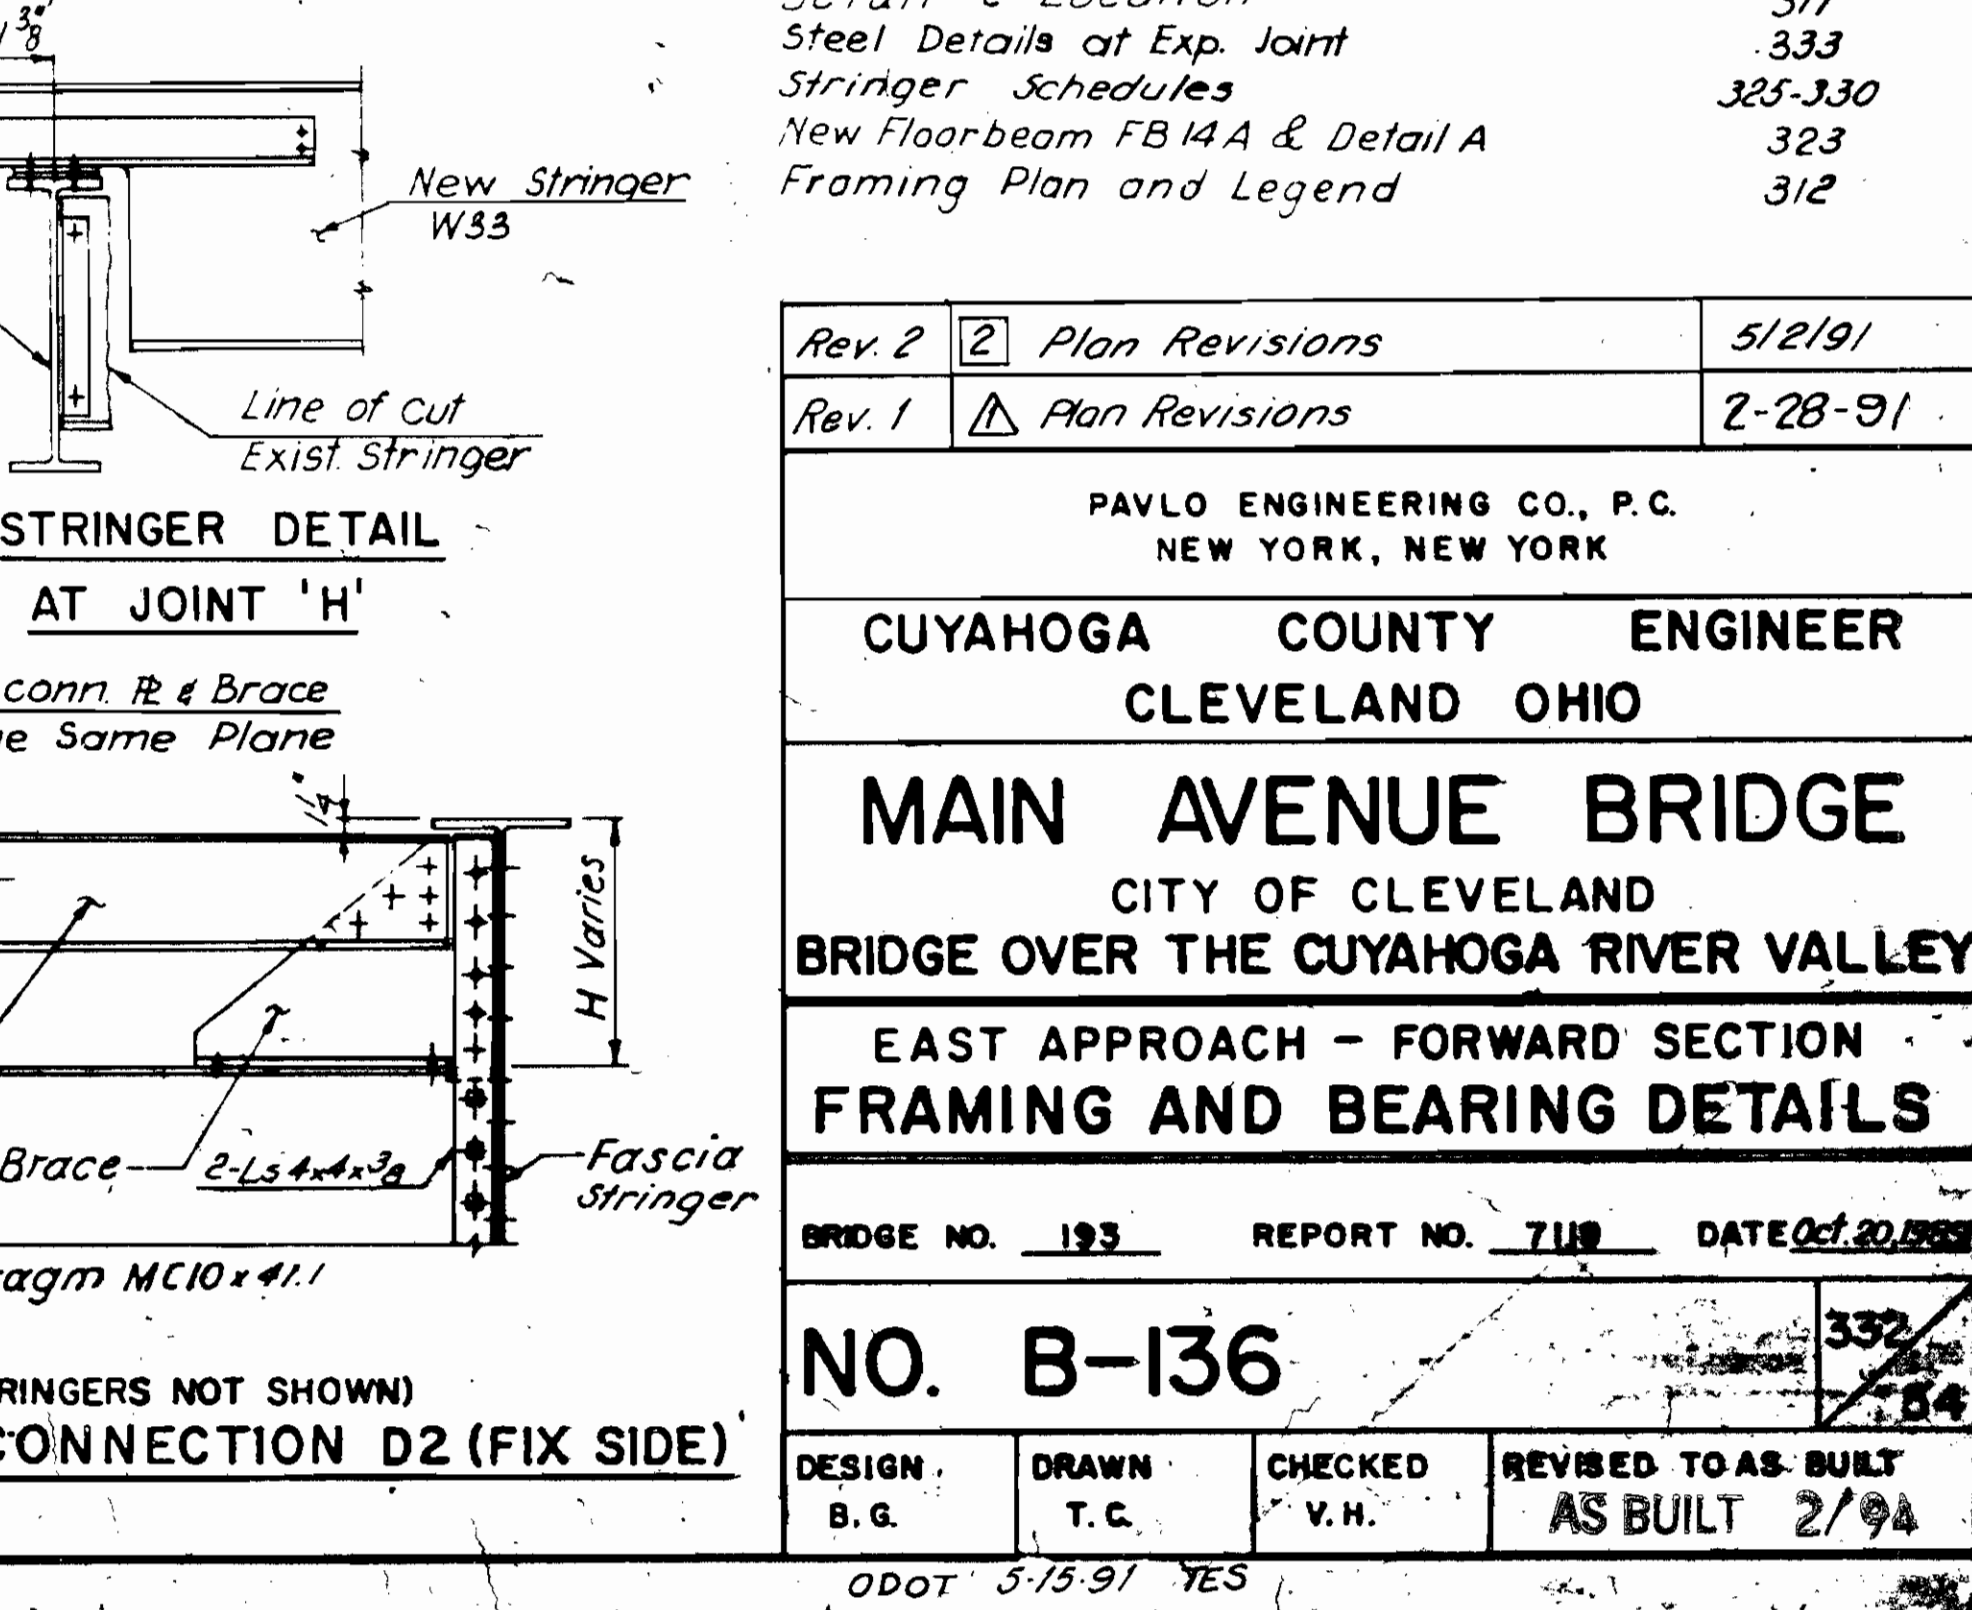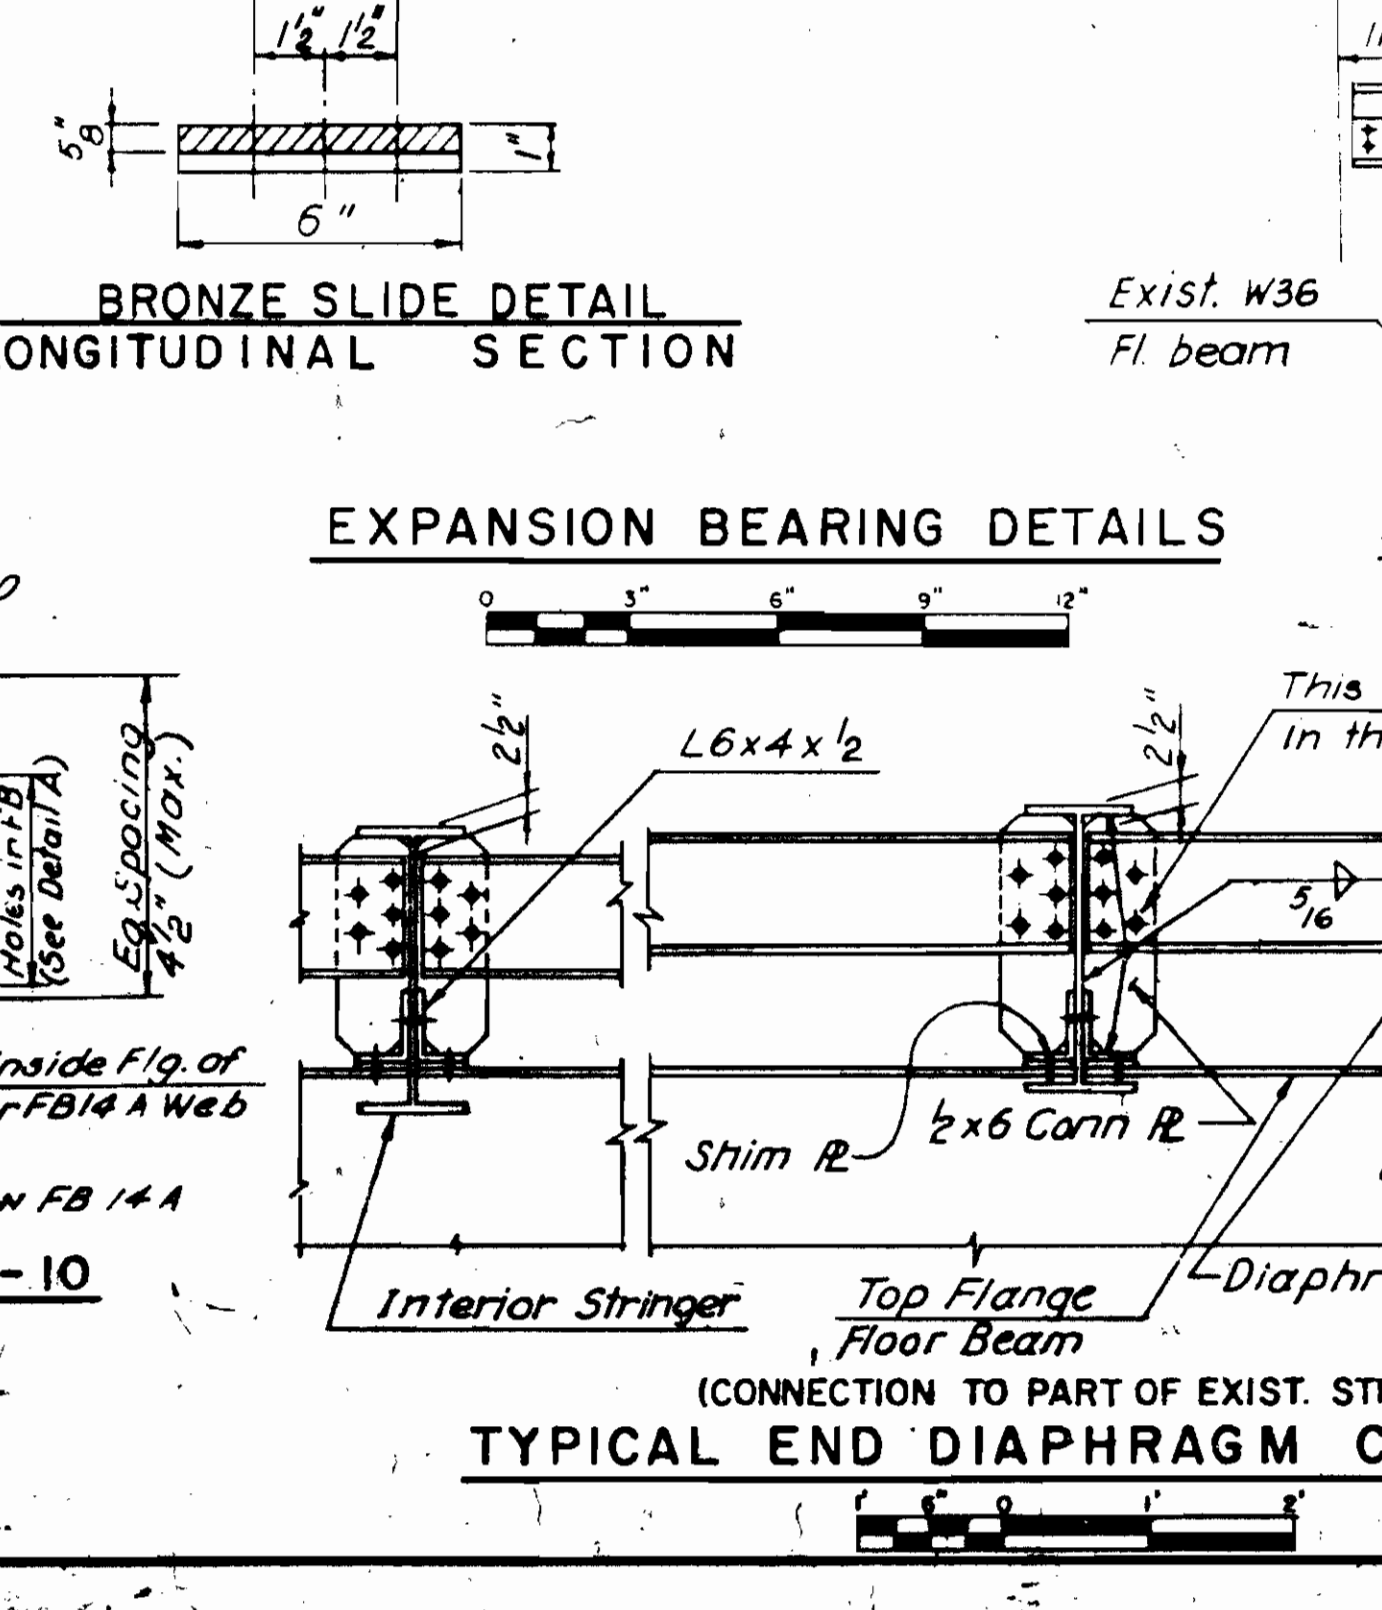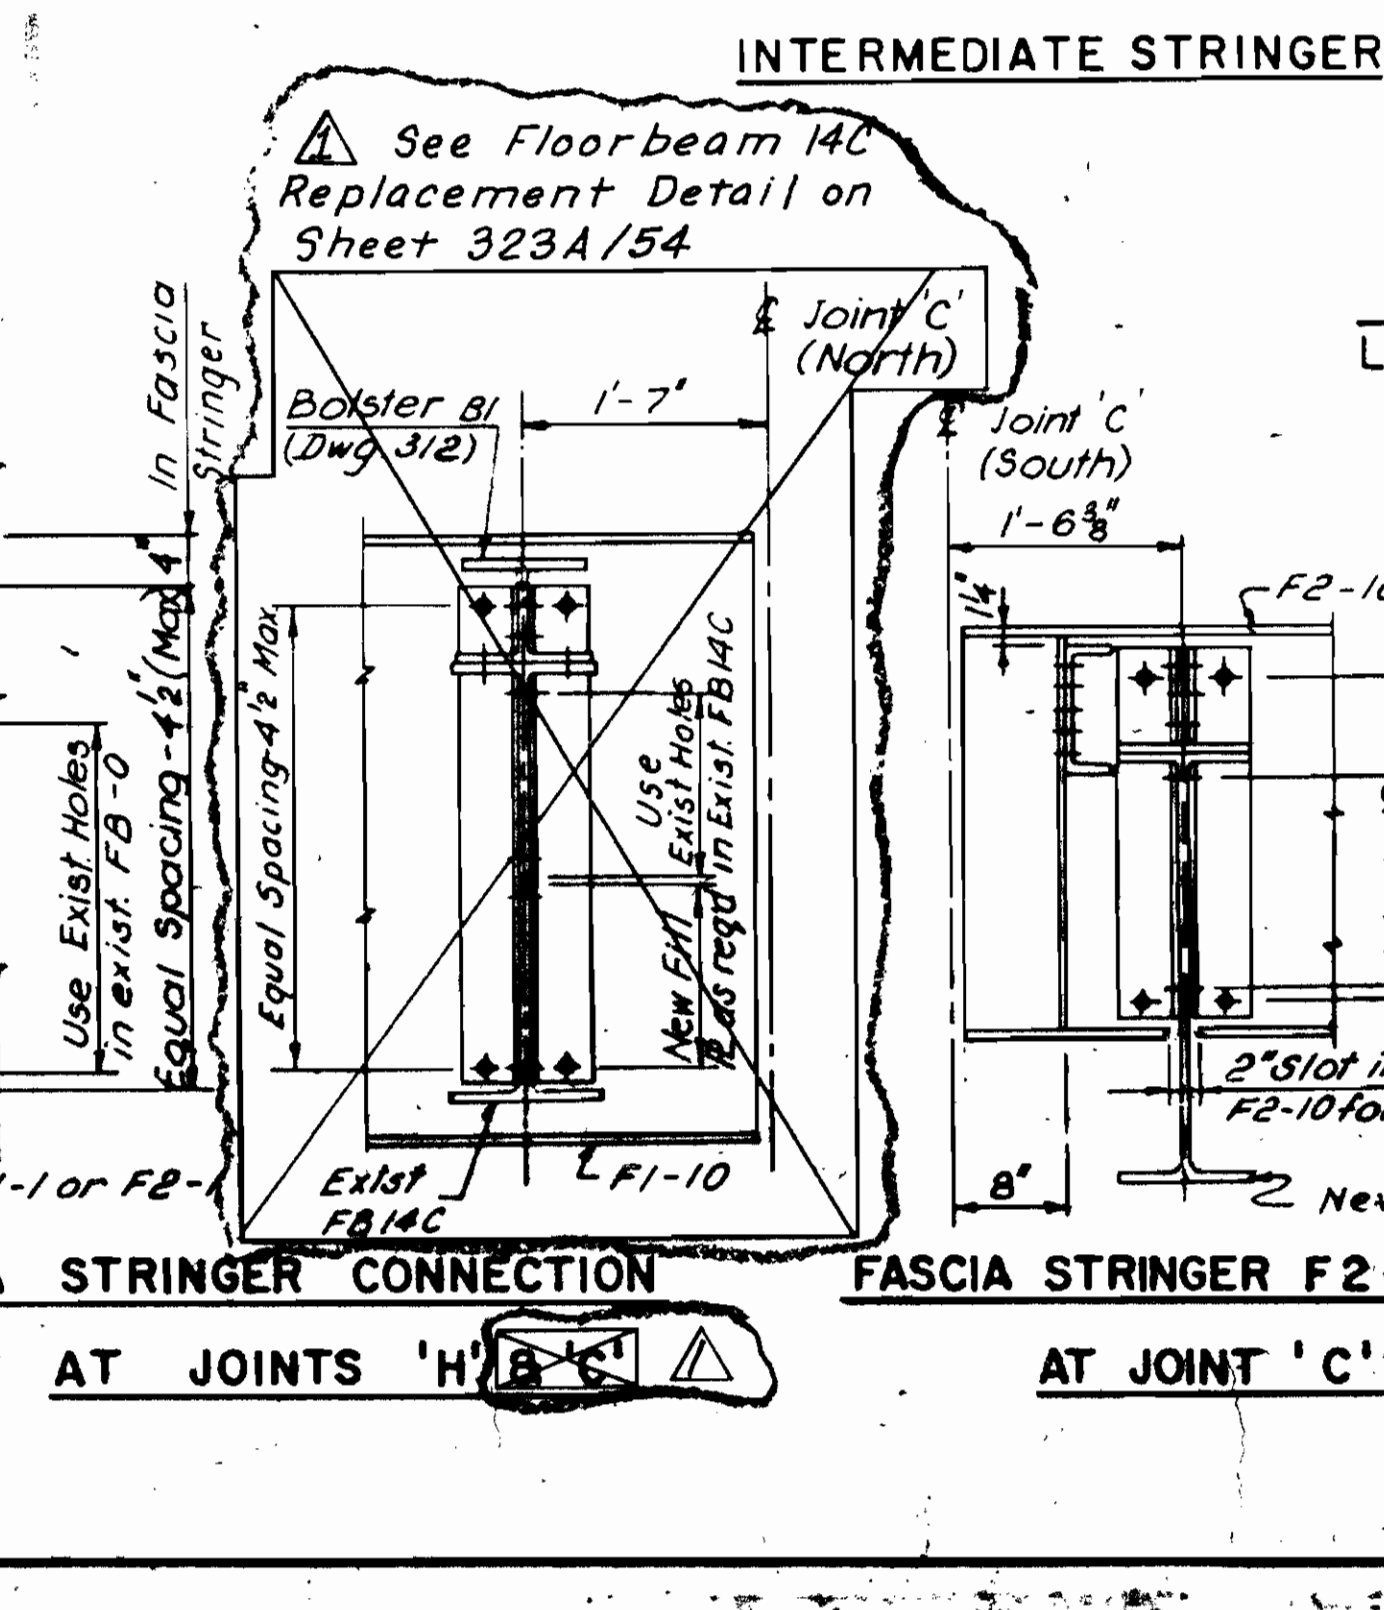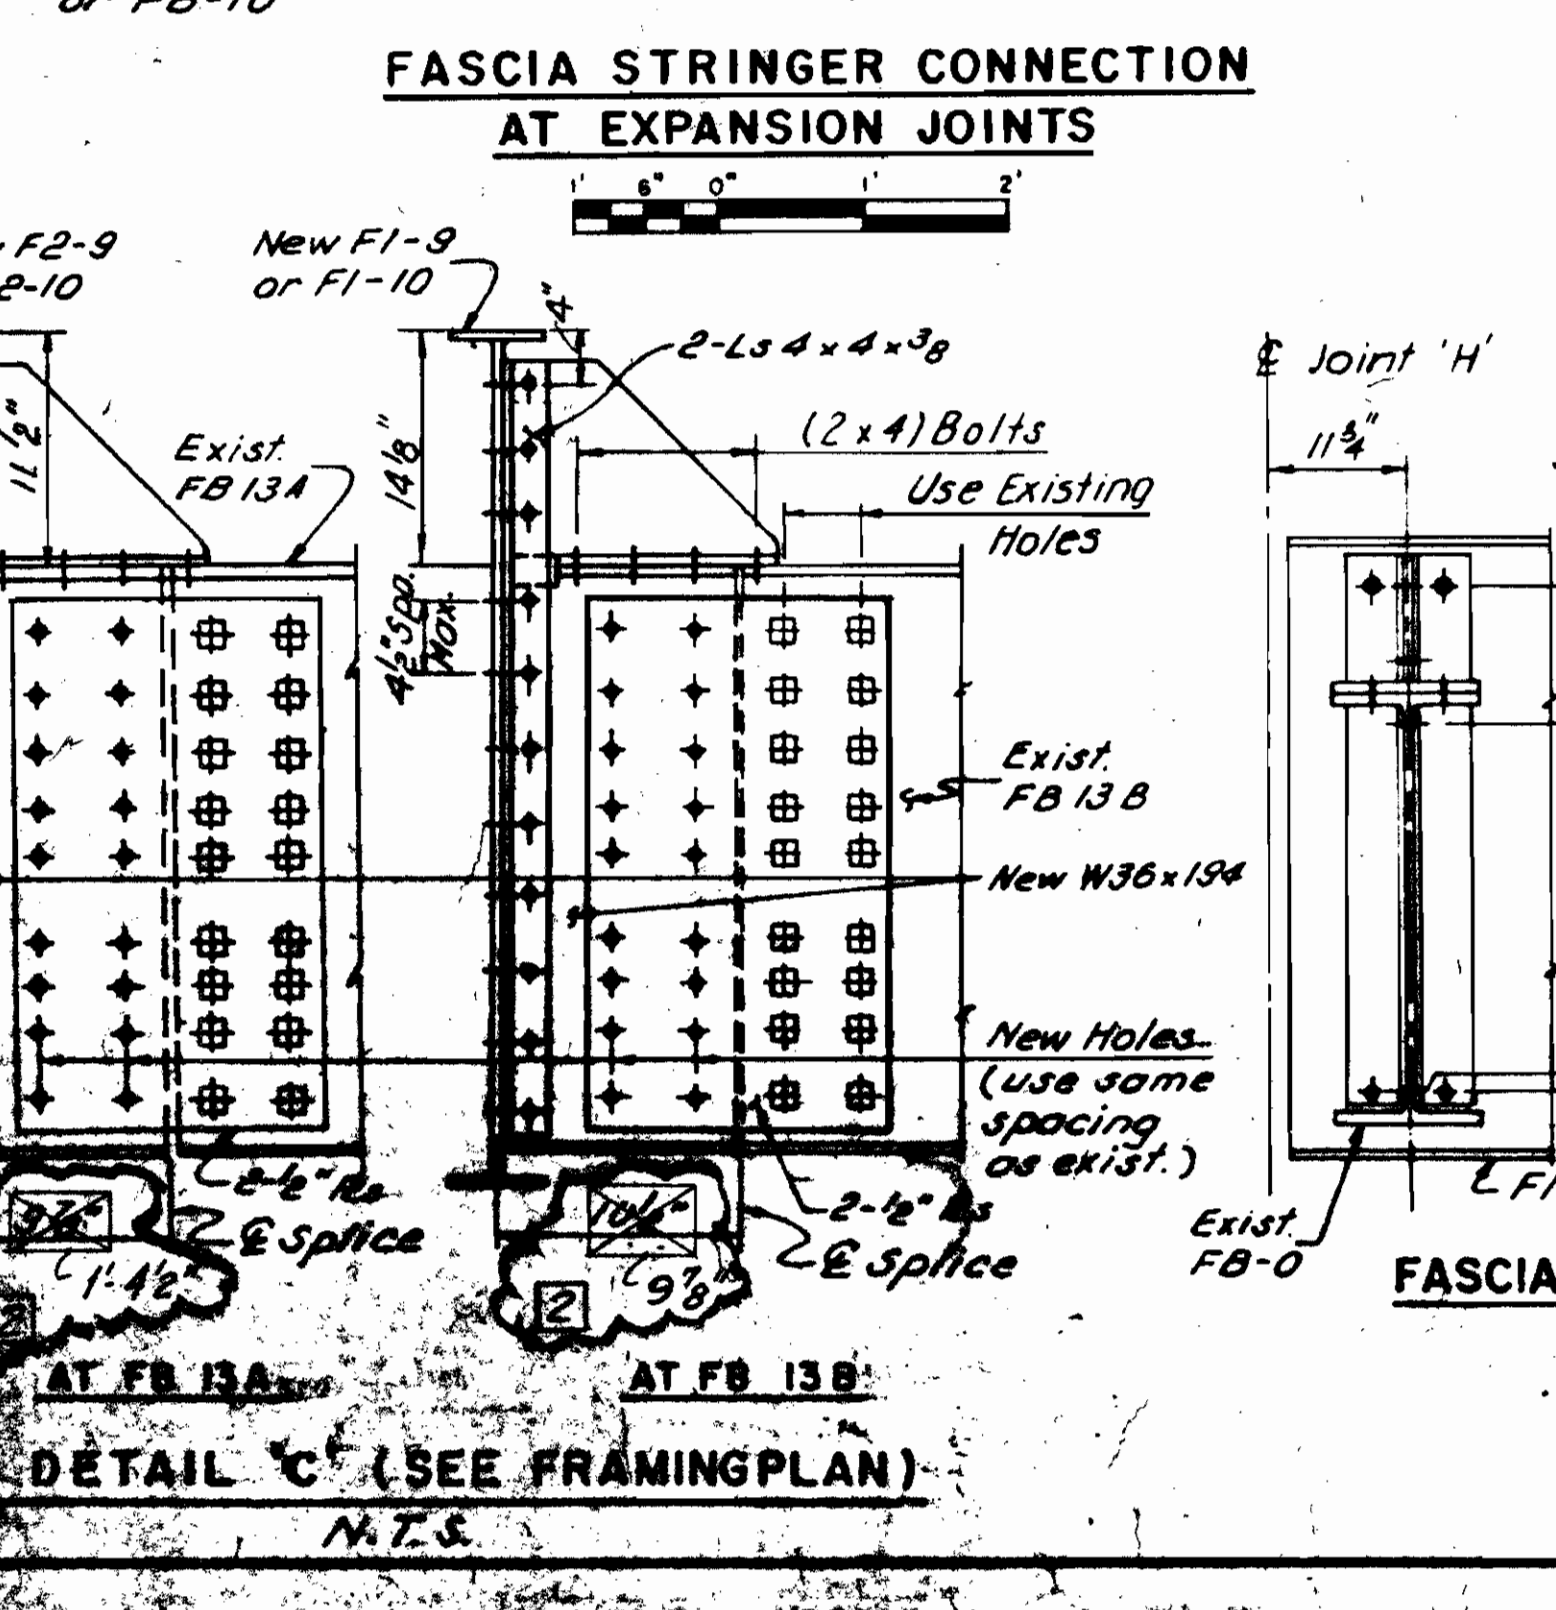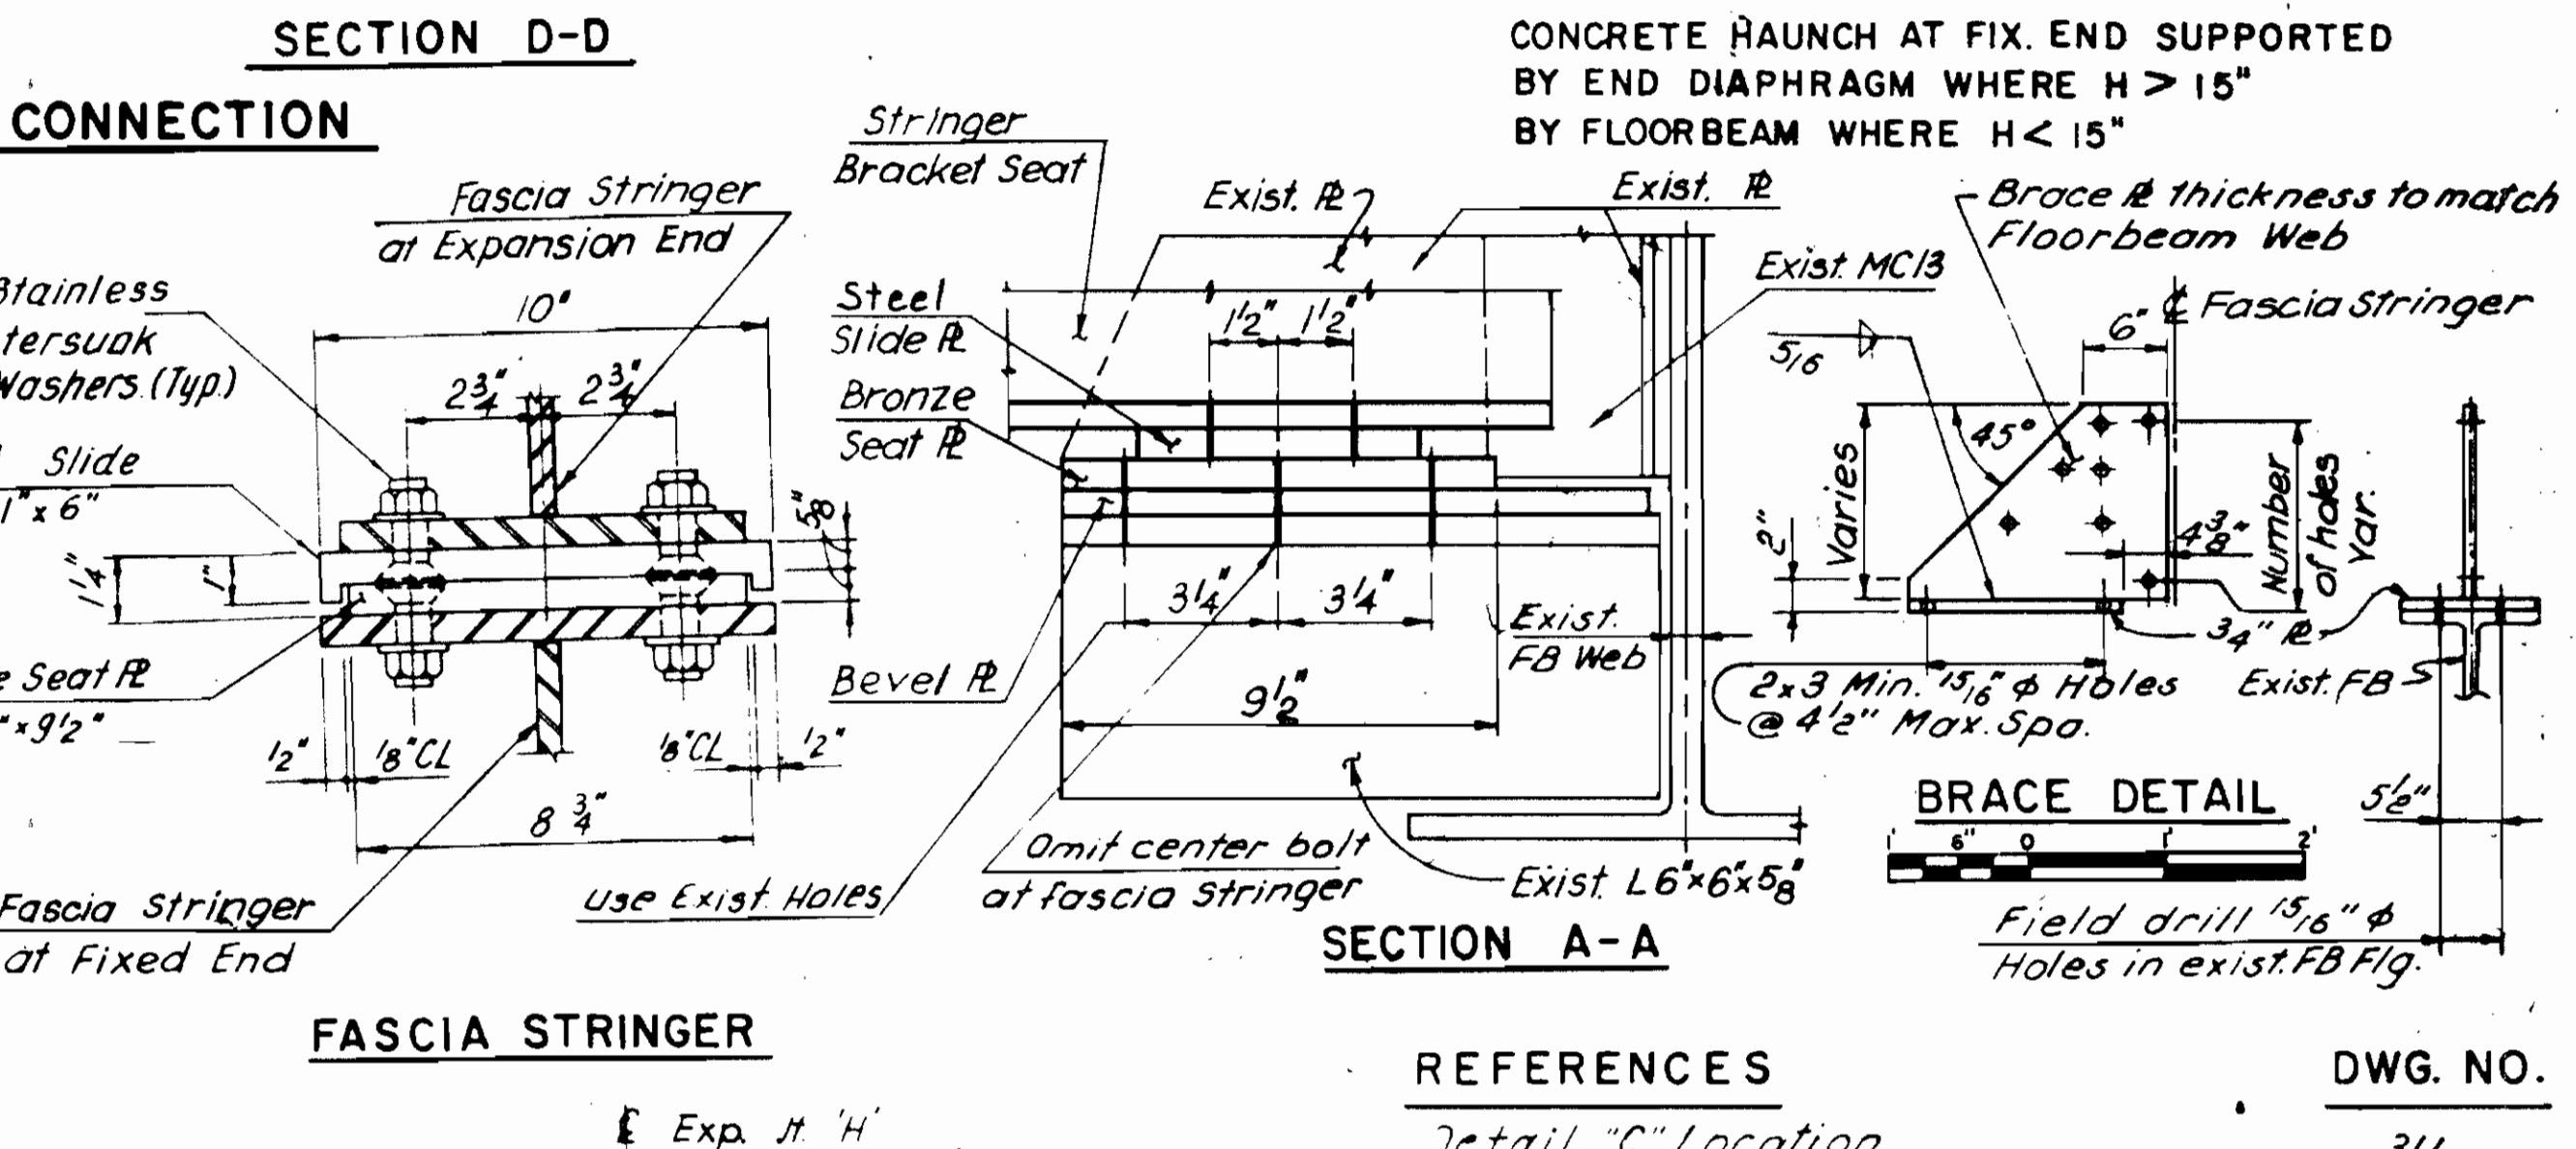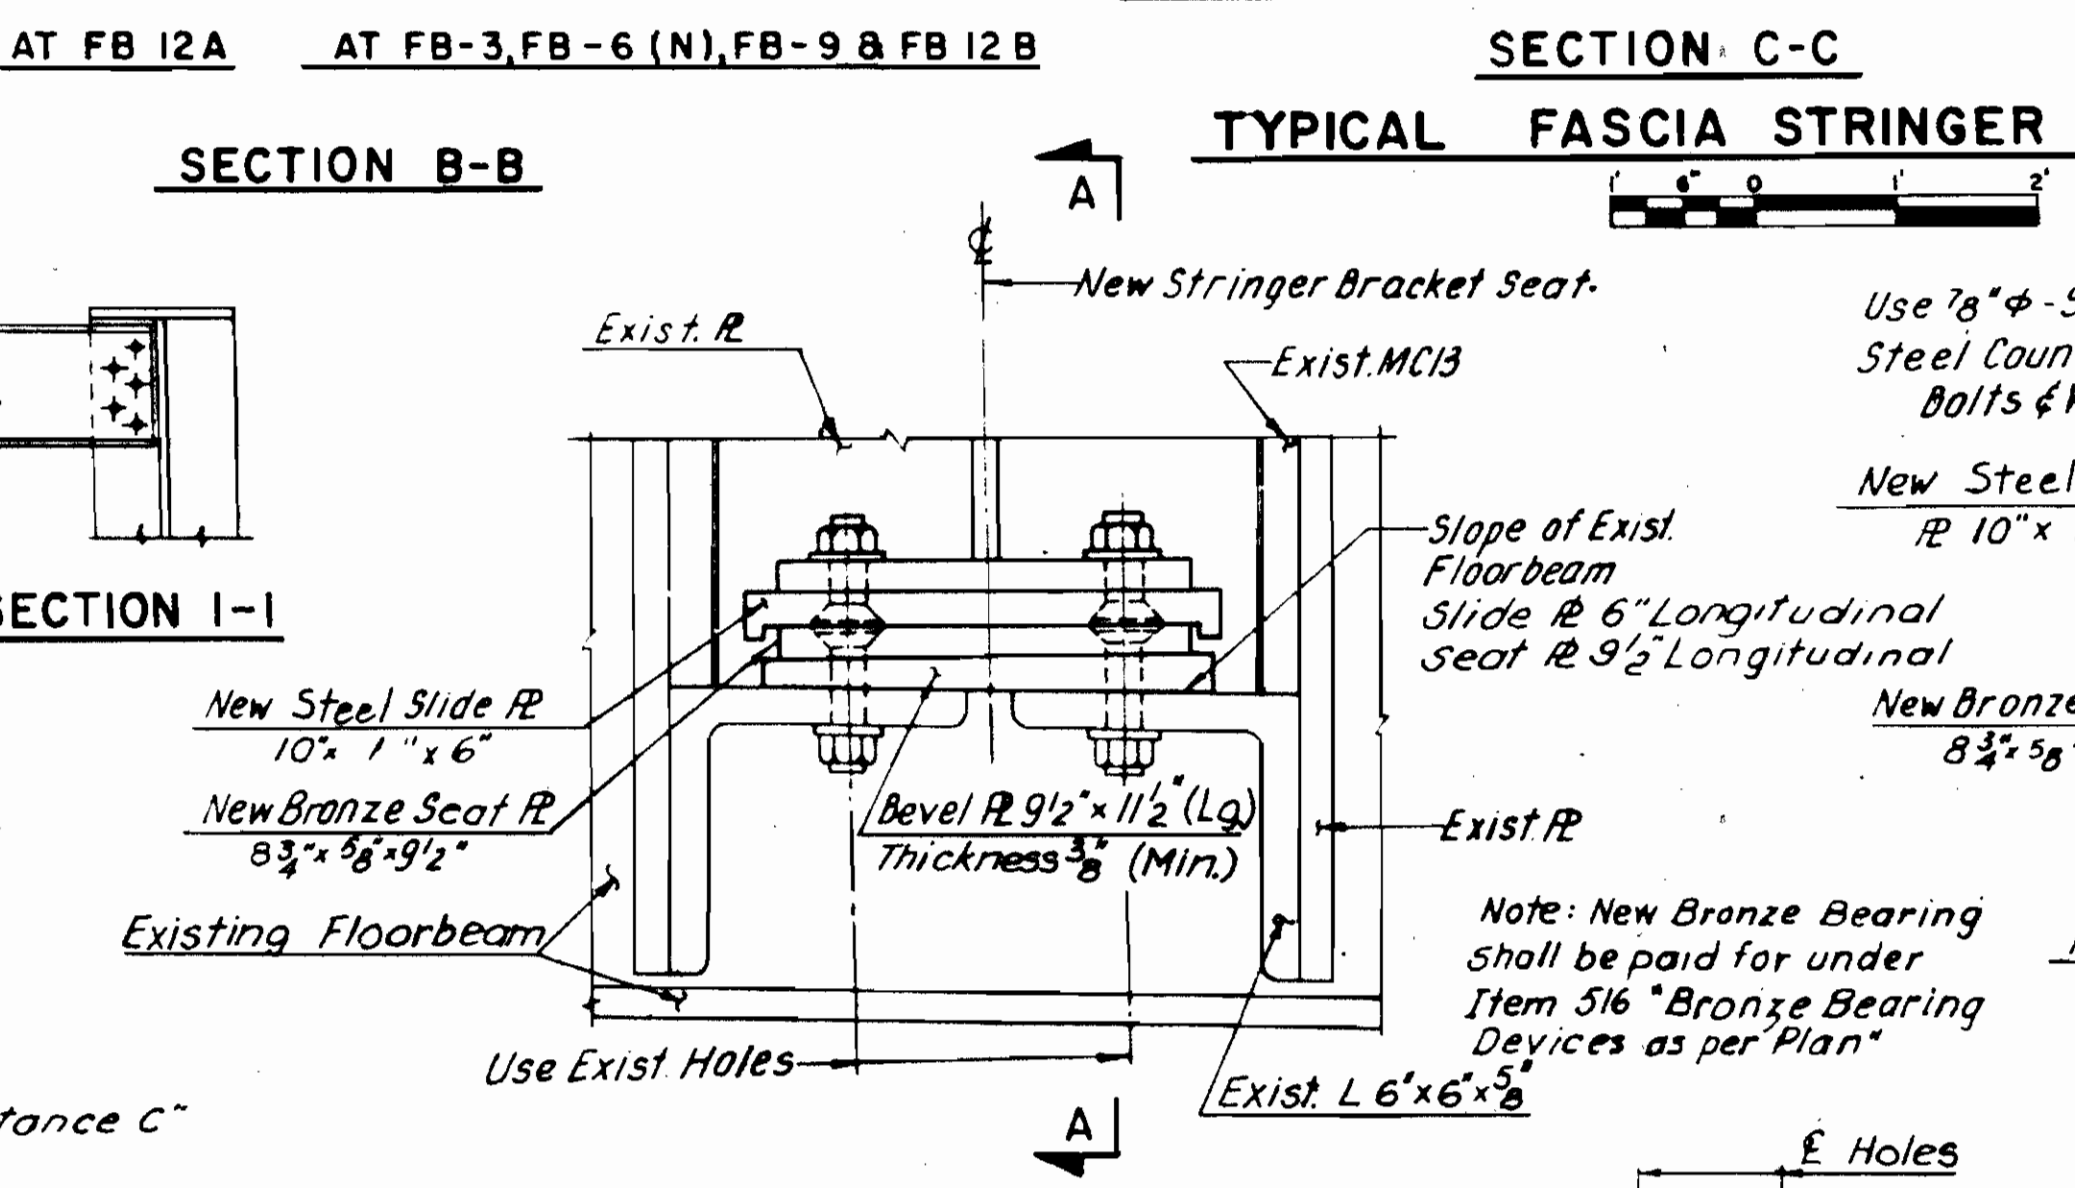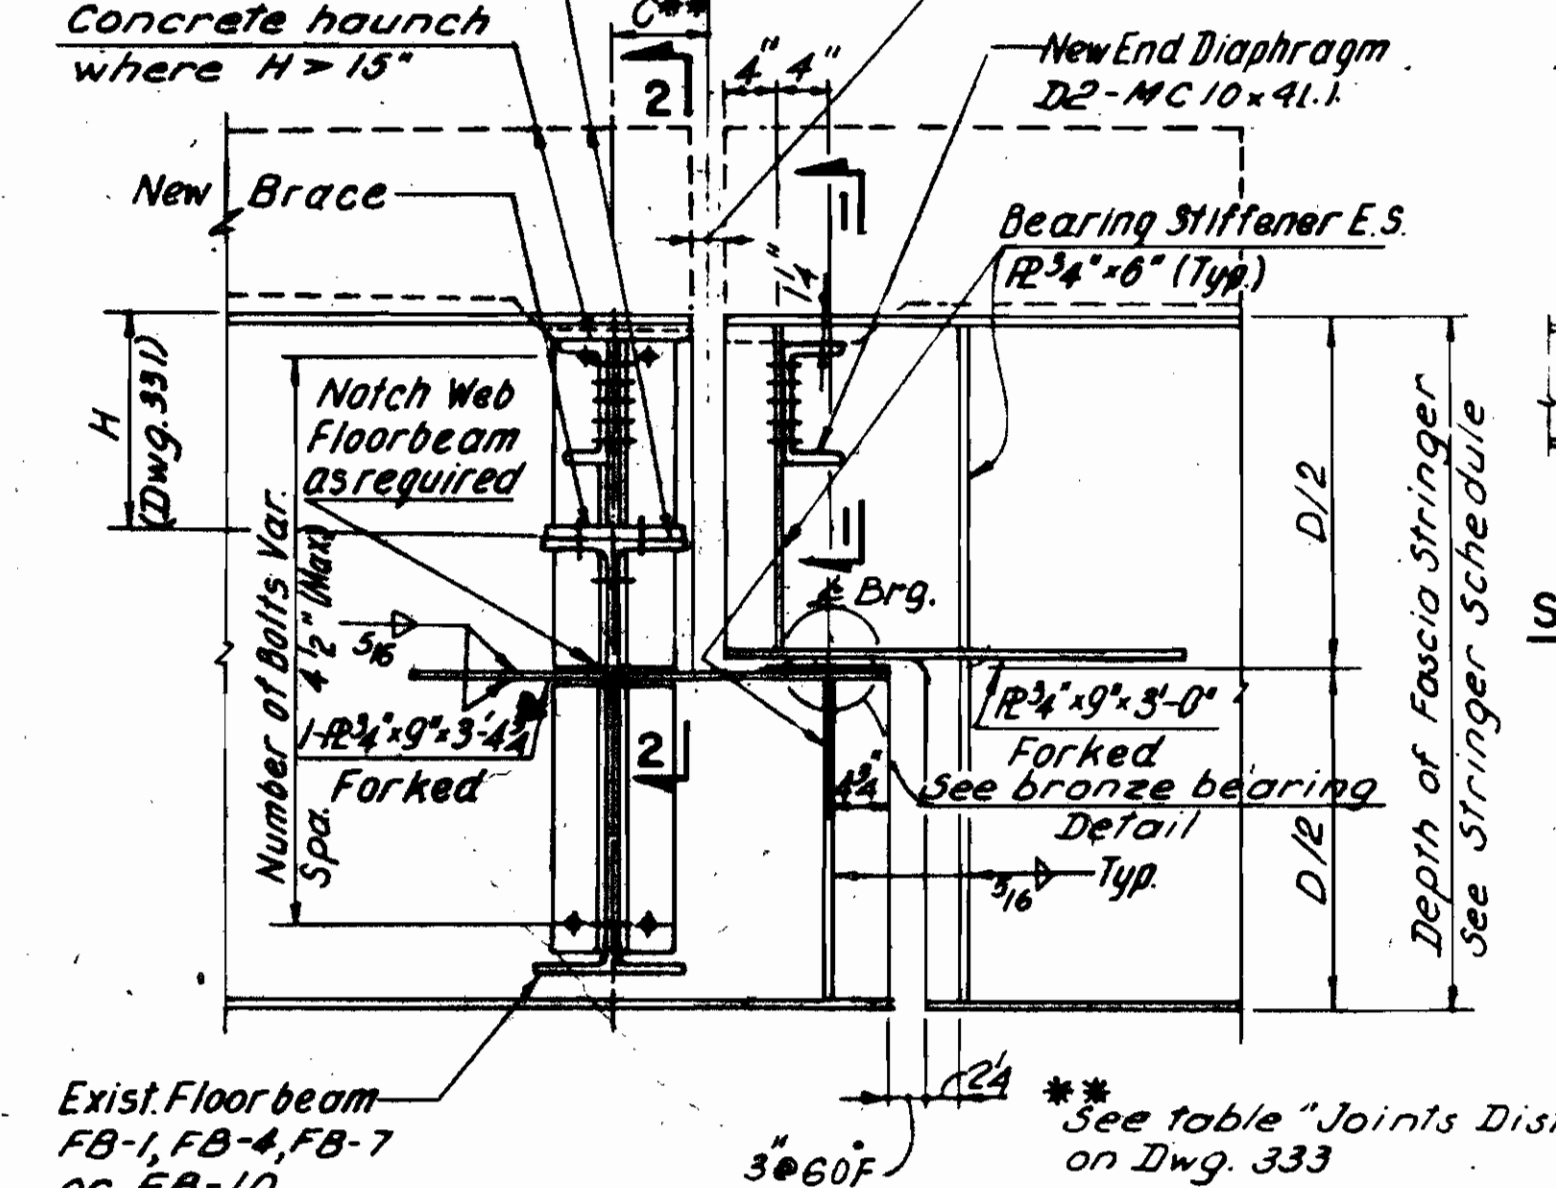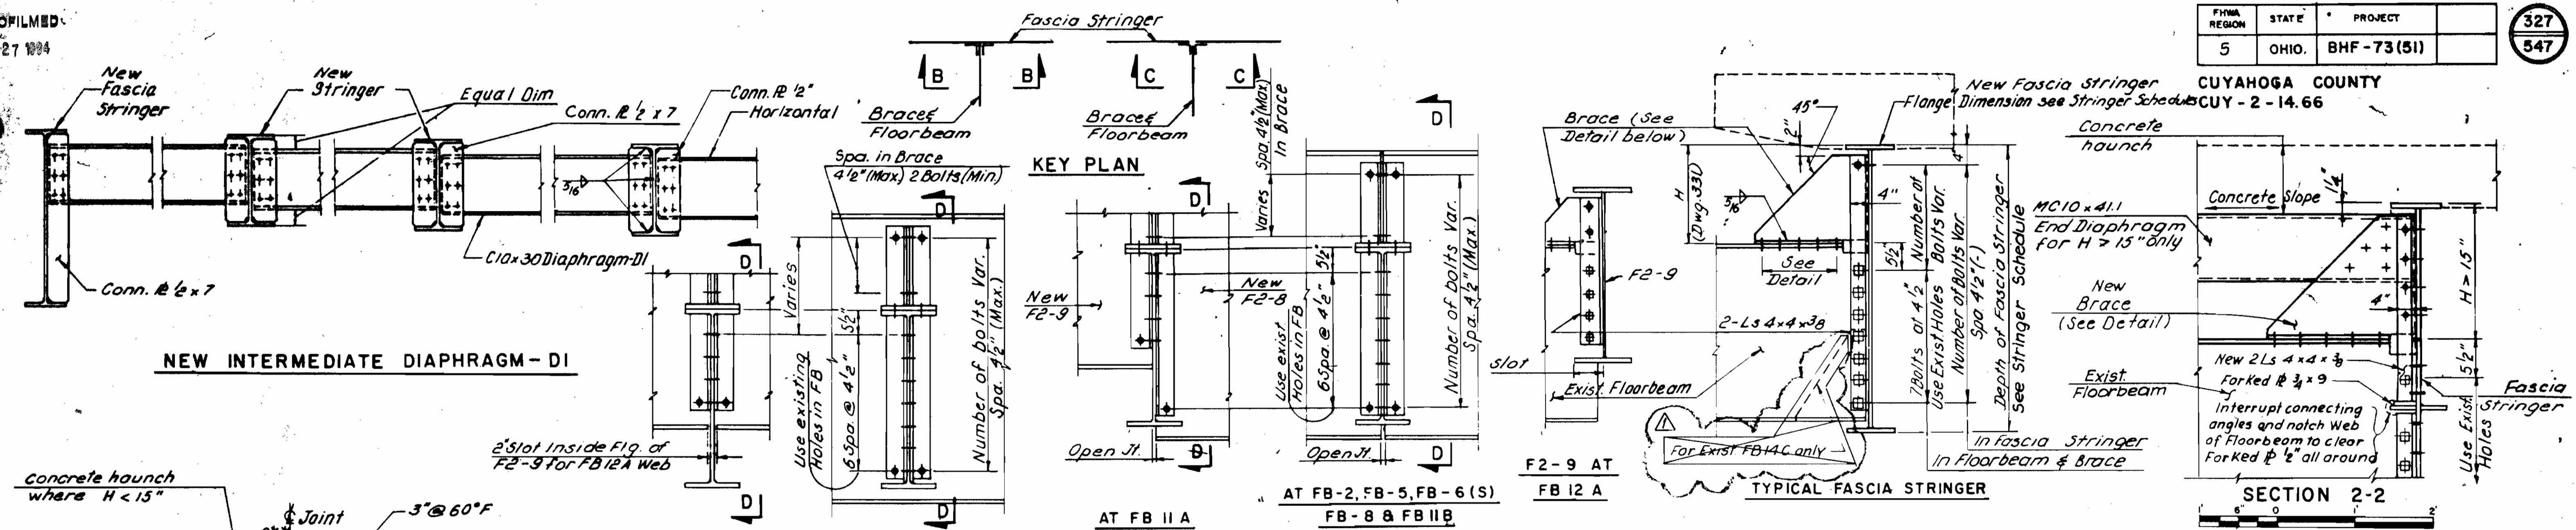

REFERENCES	DWG. NO.
Detail "C" Location	311
Steel Details at Exp. Joint	333
Stringer Schedules	325-330
New Floorbeam FB 14A & Detail A	323
Framing Plan and Legend	312

Rev.	Description	Date
Rev. 2	Plan Revisions	5/2/91
Rev. 1	Plan Revisions	2-28-91

PAVLO ENGINEERING CO., P.C.  
NEW YORK, NEW YORK

CUYAHOGA COUNTY ENGINEER  
CLEVELAND OHIO

**MAIN AVENUE BRIDGE**  
CITY OF CLEVELAND  
BRIDGE OVER THE CUYAHOGA RIVER VALLEY

EAST APPROACH - FORWARD SECTION  
**FRAMING AND BEARING DETAILS**

BRIDGE NO. 193 REPORT NO. 719 DATE Oct. 20, 1988

**NO. B-136**

DESIGN B.G.	DRAWN T.C.	CHECKED V.H.	REVISED TO AS BUILT AS BUILT 2/94
----------------	---------------	-----------------	--------------------------------------

ODOT 5-15-91 YES




Note: Bars in Span 1 are designated S1500, S1600, B1500 etc.  
Bars in Span 2 are designated S2500, S2600, B2500 etc.

NOTES: For Deck Slab Depth Note, see Dwg. Deck Slab Reinf.-3  
For Stringer Haunch Details see Dwg. Deck Slab Reinf.-4






FHWA REGION	STATE	PROJECT	335 547
5	OHIO	BHF-73(51)	

CUYAHOGA COUNTY  
CUY-2-14.66

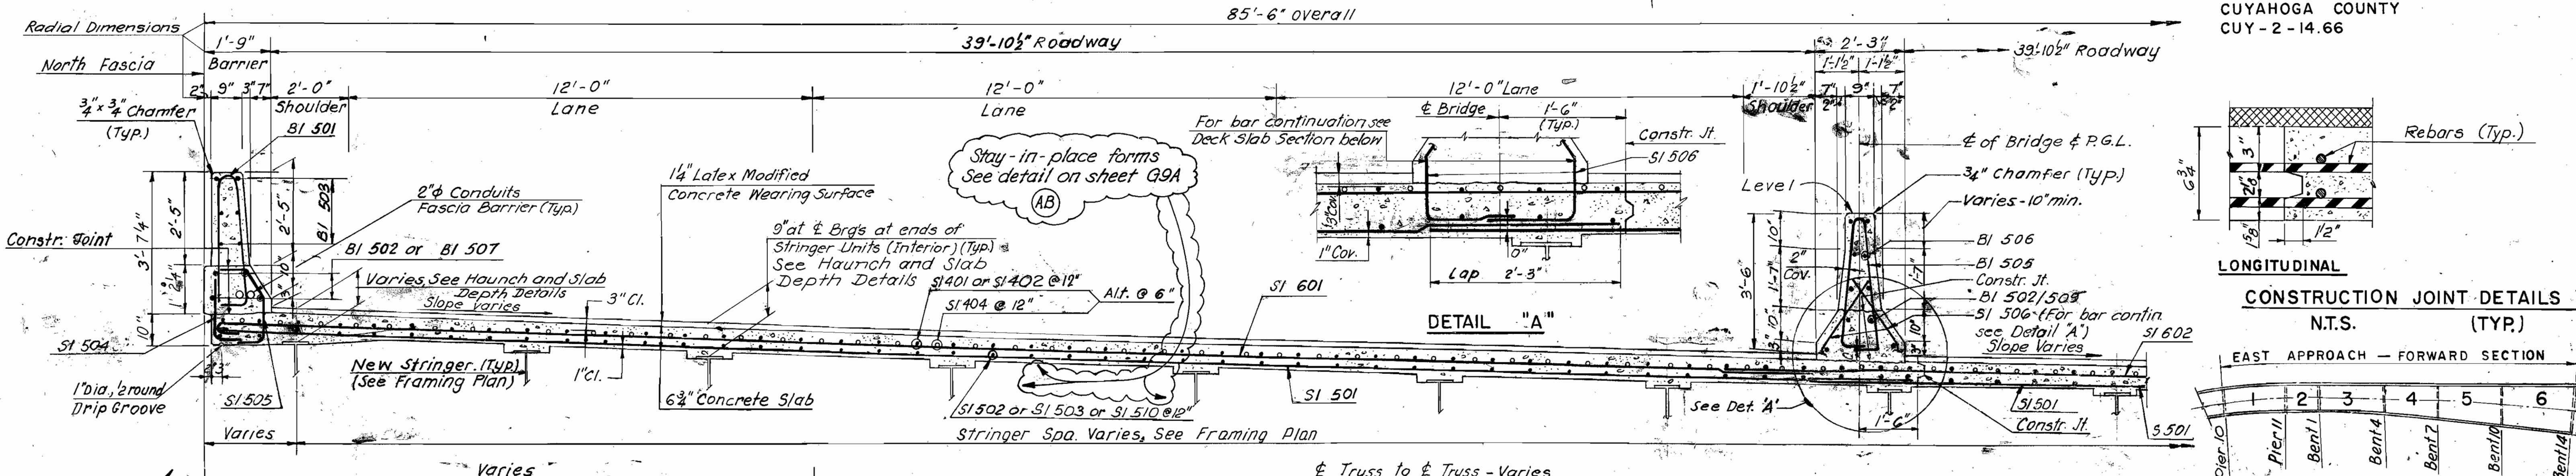

BAR SIZE	MIN. LAP
#4	1'-10"
#5	2'-3"
#6	2'-8"

SECTION A-A  
NOTE: The Contractor shall bend or field cut Reinforcing Steel, at Scuppers as required.

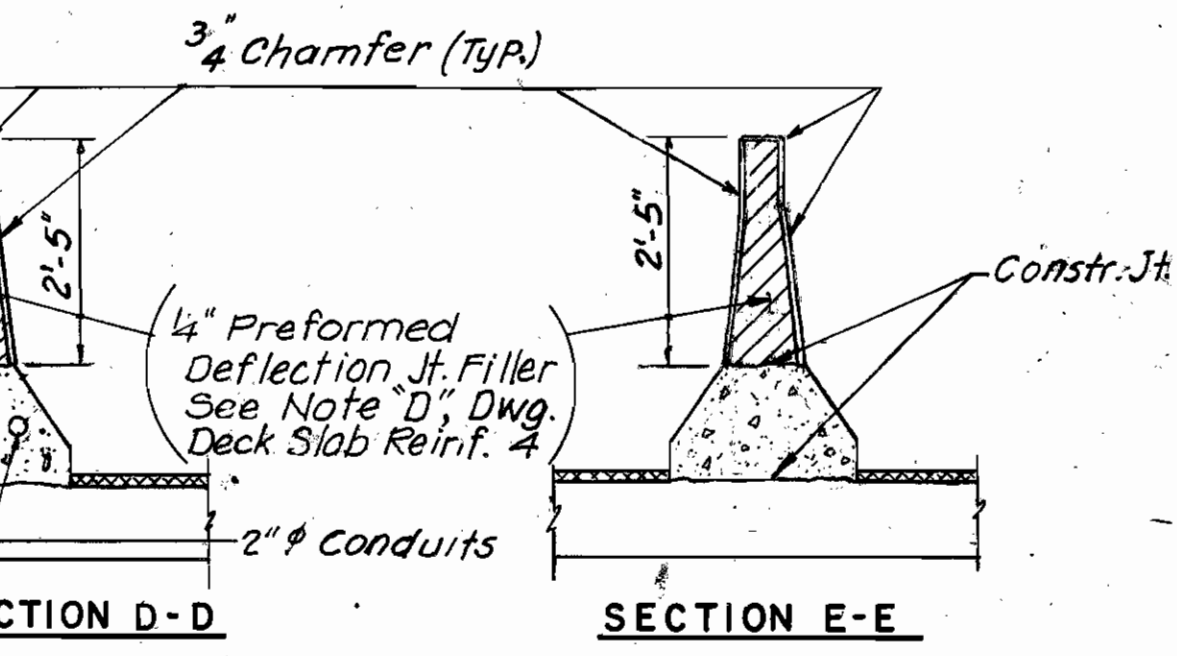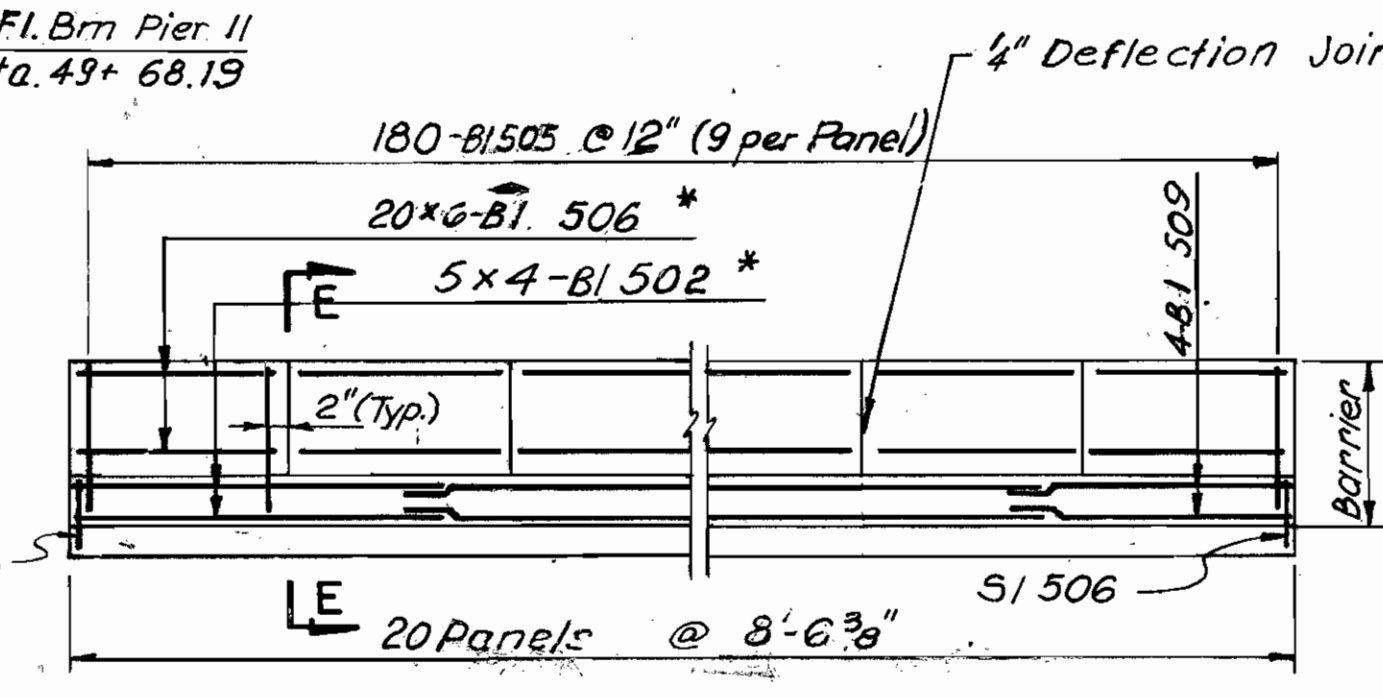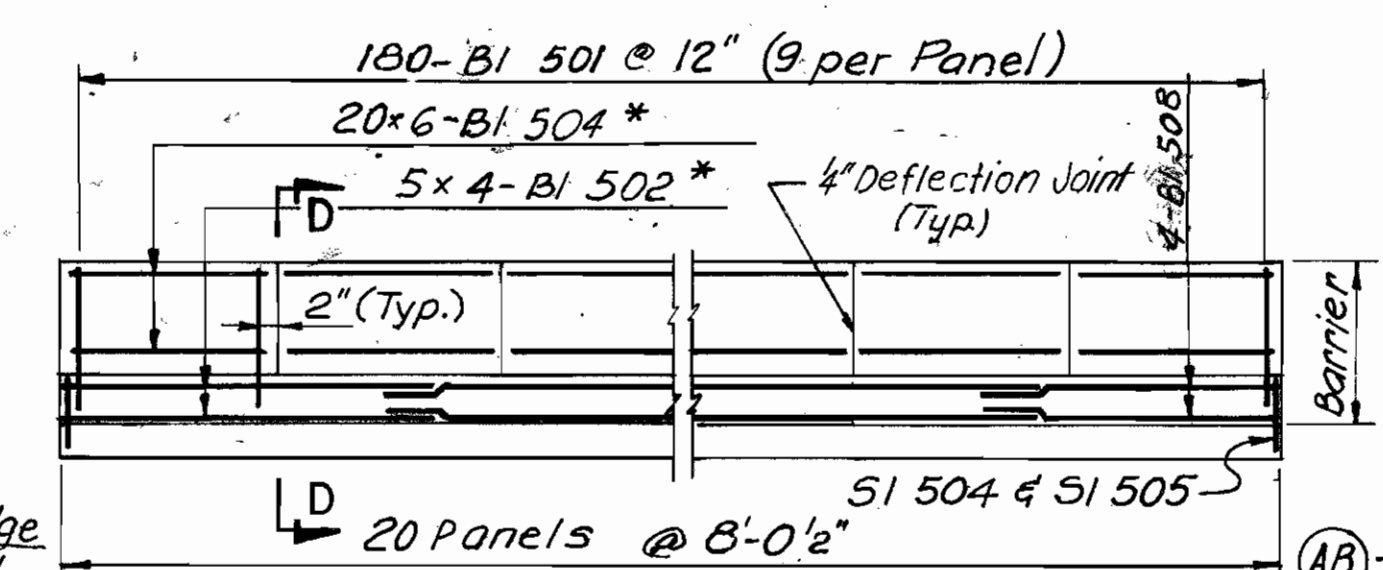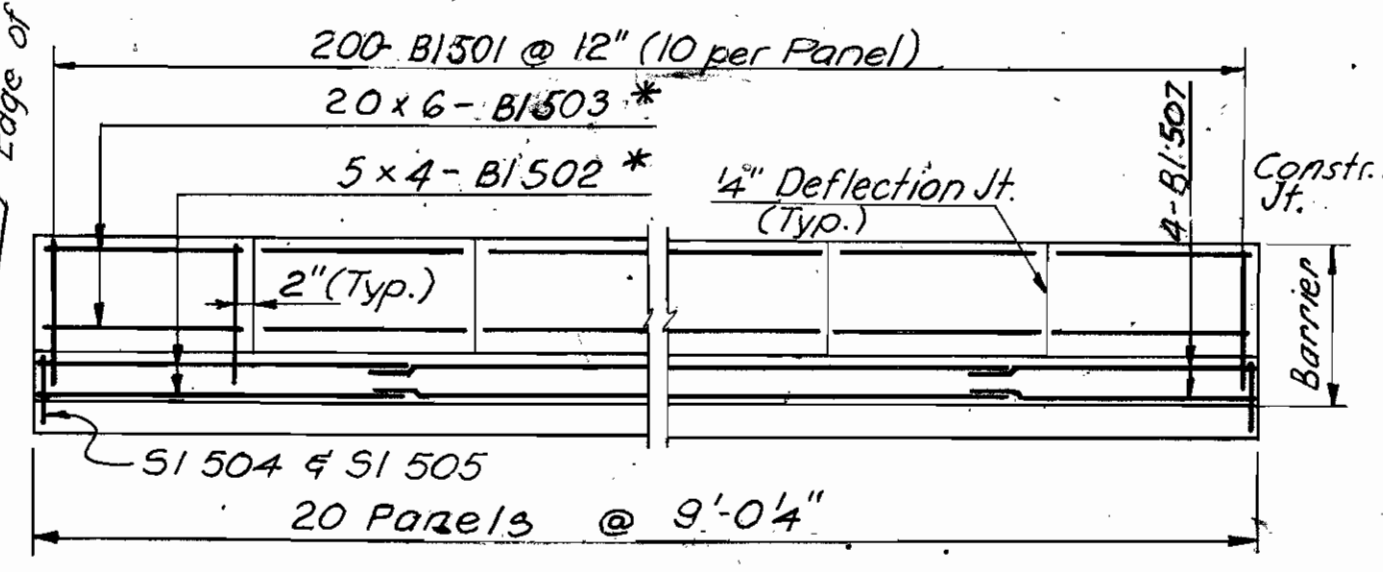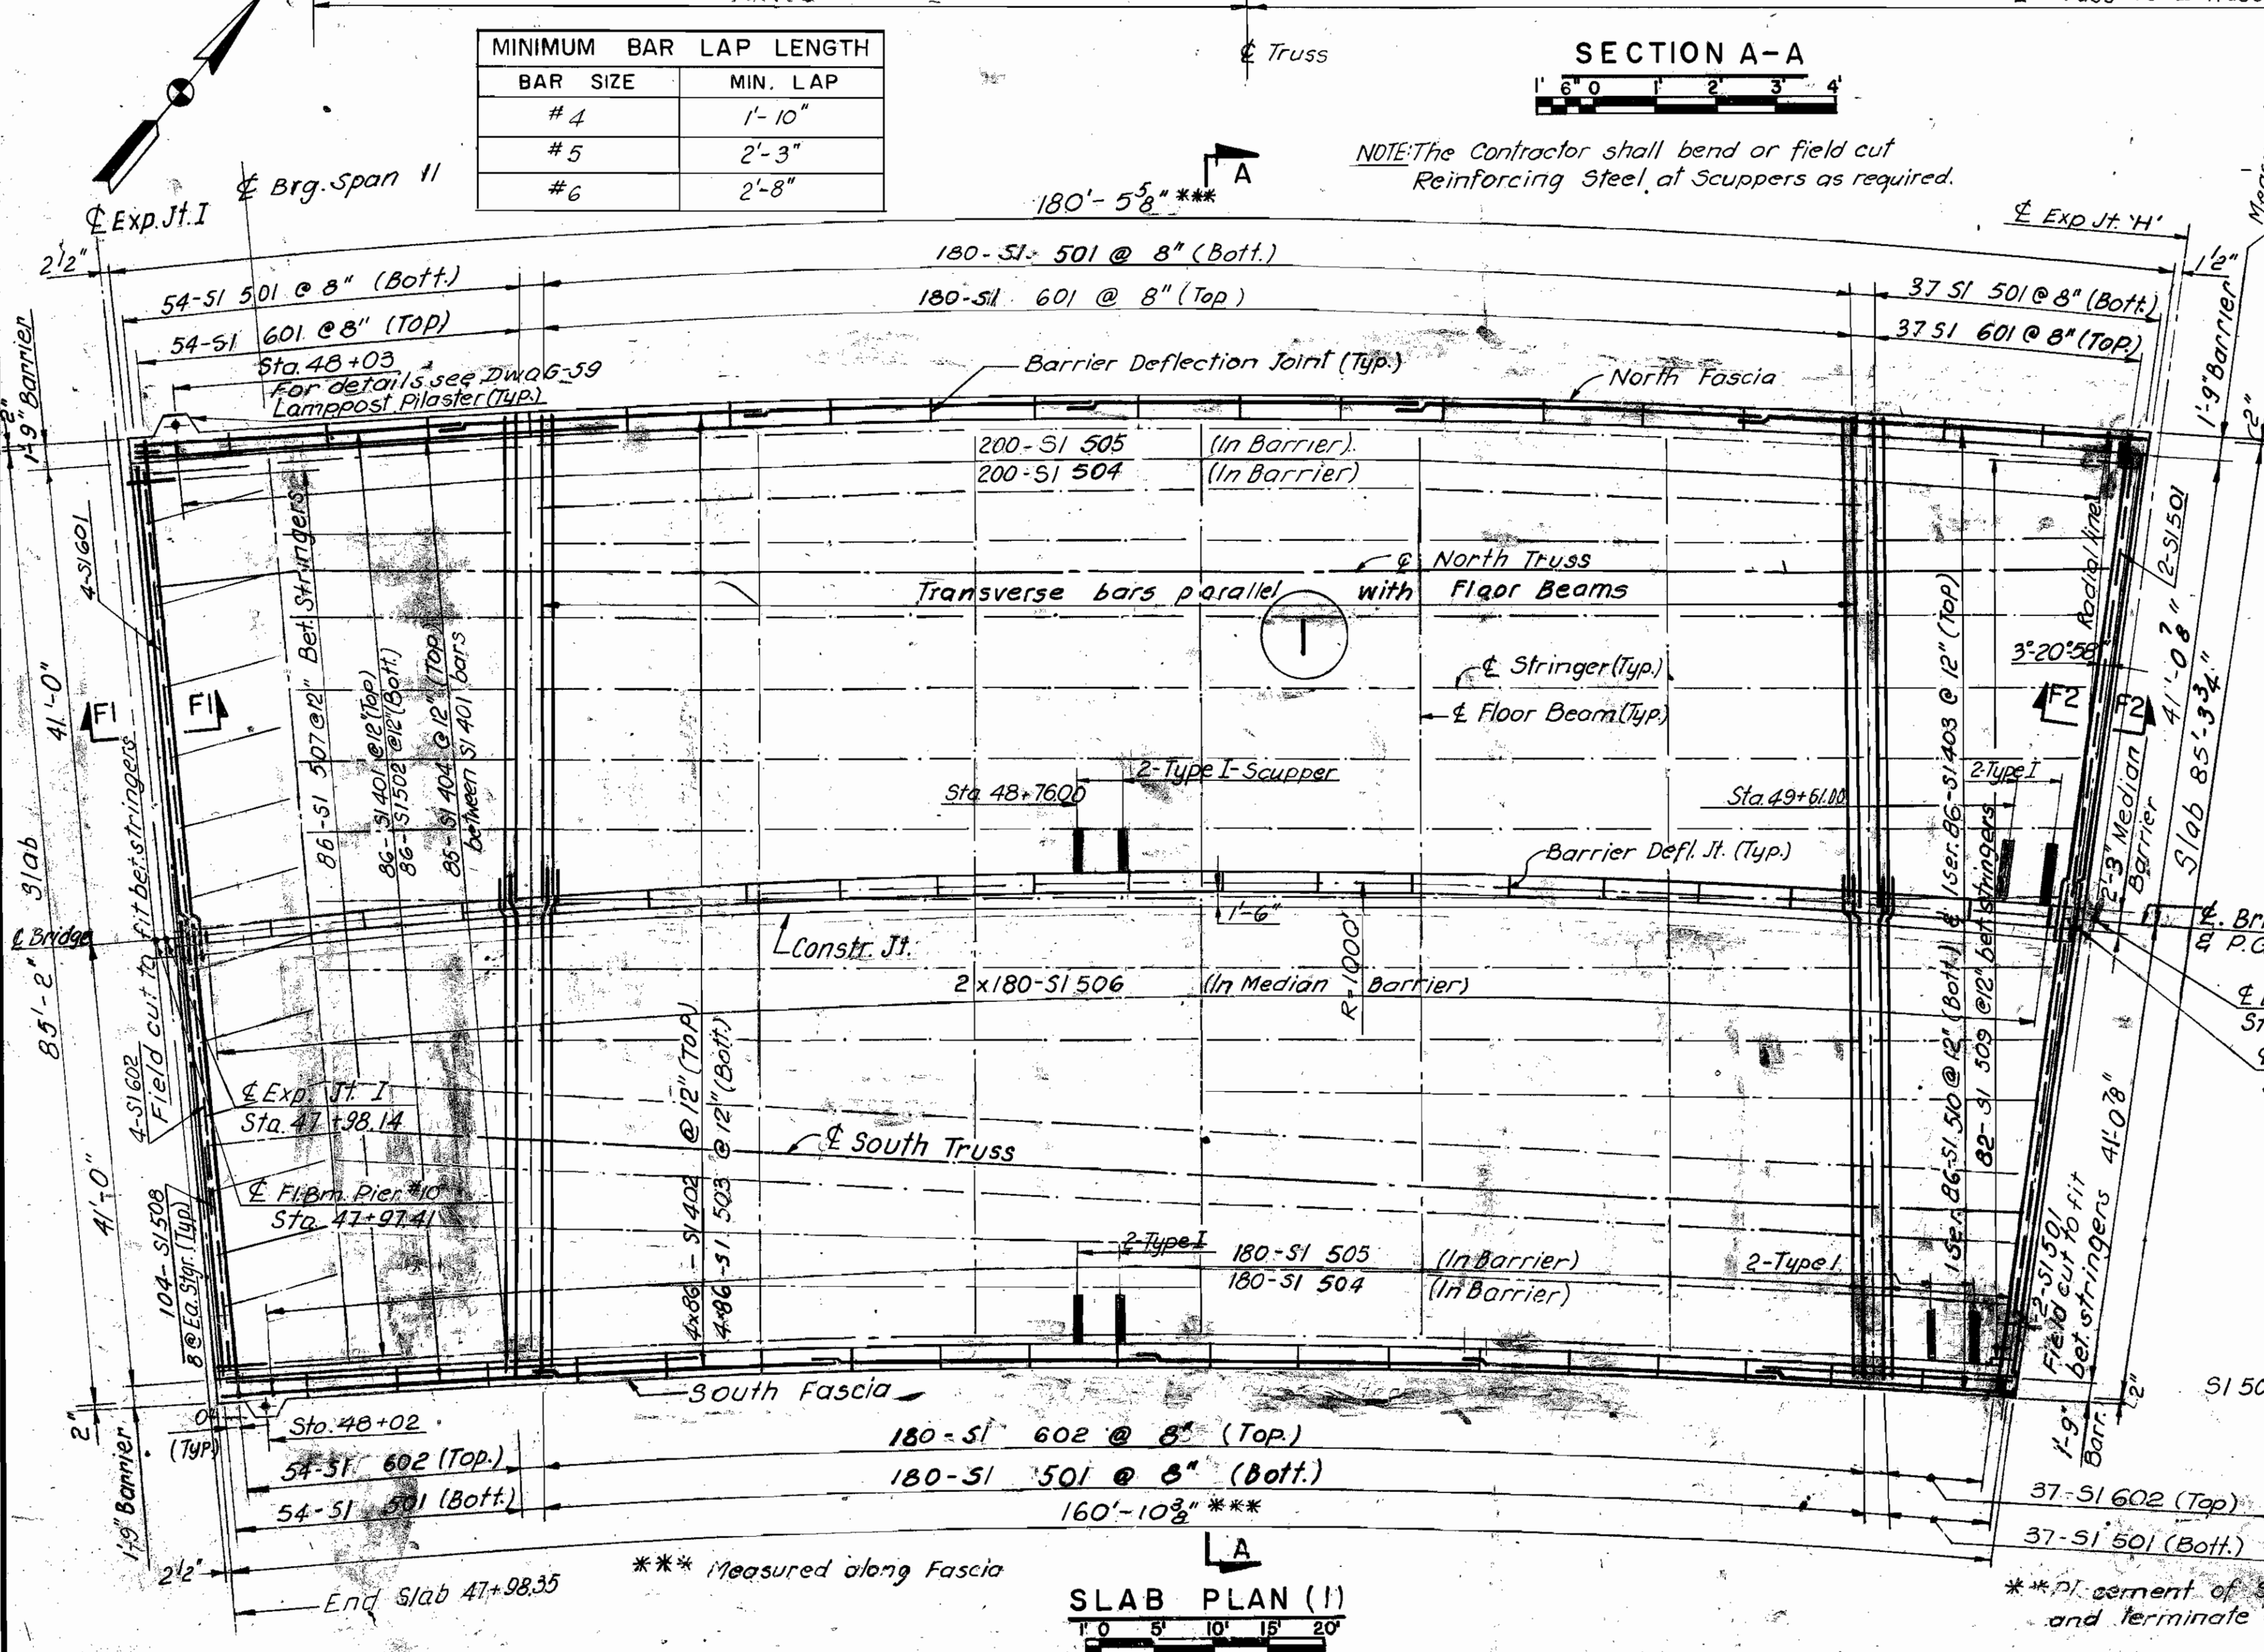

REFERENCES:

	DWG. NO.
Haunch and Slab Depth Details	338
Deck Slab Depth Note and Deck Slab Reinf.-3	342
Deck Slab Reinf.-4	343
General Notes	66 to 623
Proposed Plan and Elevation	302
Roadway Elevations	305 to 307
End Haunch Dimensions	344
Deflection Charts	337 to 339
Scupper details	654 - 655
Lighting Post - Pilaster	668
Deck Joint Details	350
Framing Plans	309 to 312
Sections F1 - F1 & F2 - F2	344
Bar List	351 - 354
Stay-in-place forms	69A

PAVLO ENGINEERING CO., P.C.  
NEW YORK, NEW YORK

CUYAHOGA COUNTY ENGINEER  
CLEVELAND OHIO

**MAIN AVENUE BRIDGE**  
CITY OF CLEVELAND  
BRIDGE OVER THE CUYAHOGA RIVER VALLEY

EAST APPROACH - FORWARD SECTION  
DECK SLAB REINFORCEMENT - I

BRIDGE NO. 193 REPORT NO. 7119 DATE Oct. 20, 1983



NO. B-136 340

DESIGN B.G.	DRAWN J.H.	CHECKED R.D.M.	REVISED TO AS BUILT AS BUILT 2/94
----------------	---------------	-------------------	---

NOTE: All Reinforcing Bars for the East Approach - Forward Section shall be prefixed FS.




FYMA REGION	STATE	PROJECT
5	OHIO	BHF - 73(51)

3-31  
 54

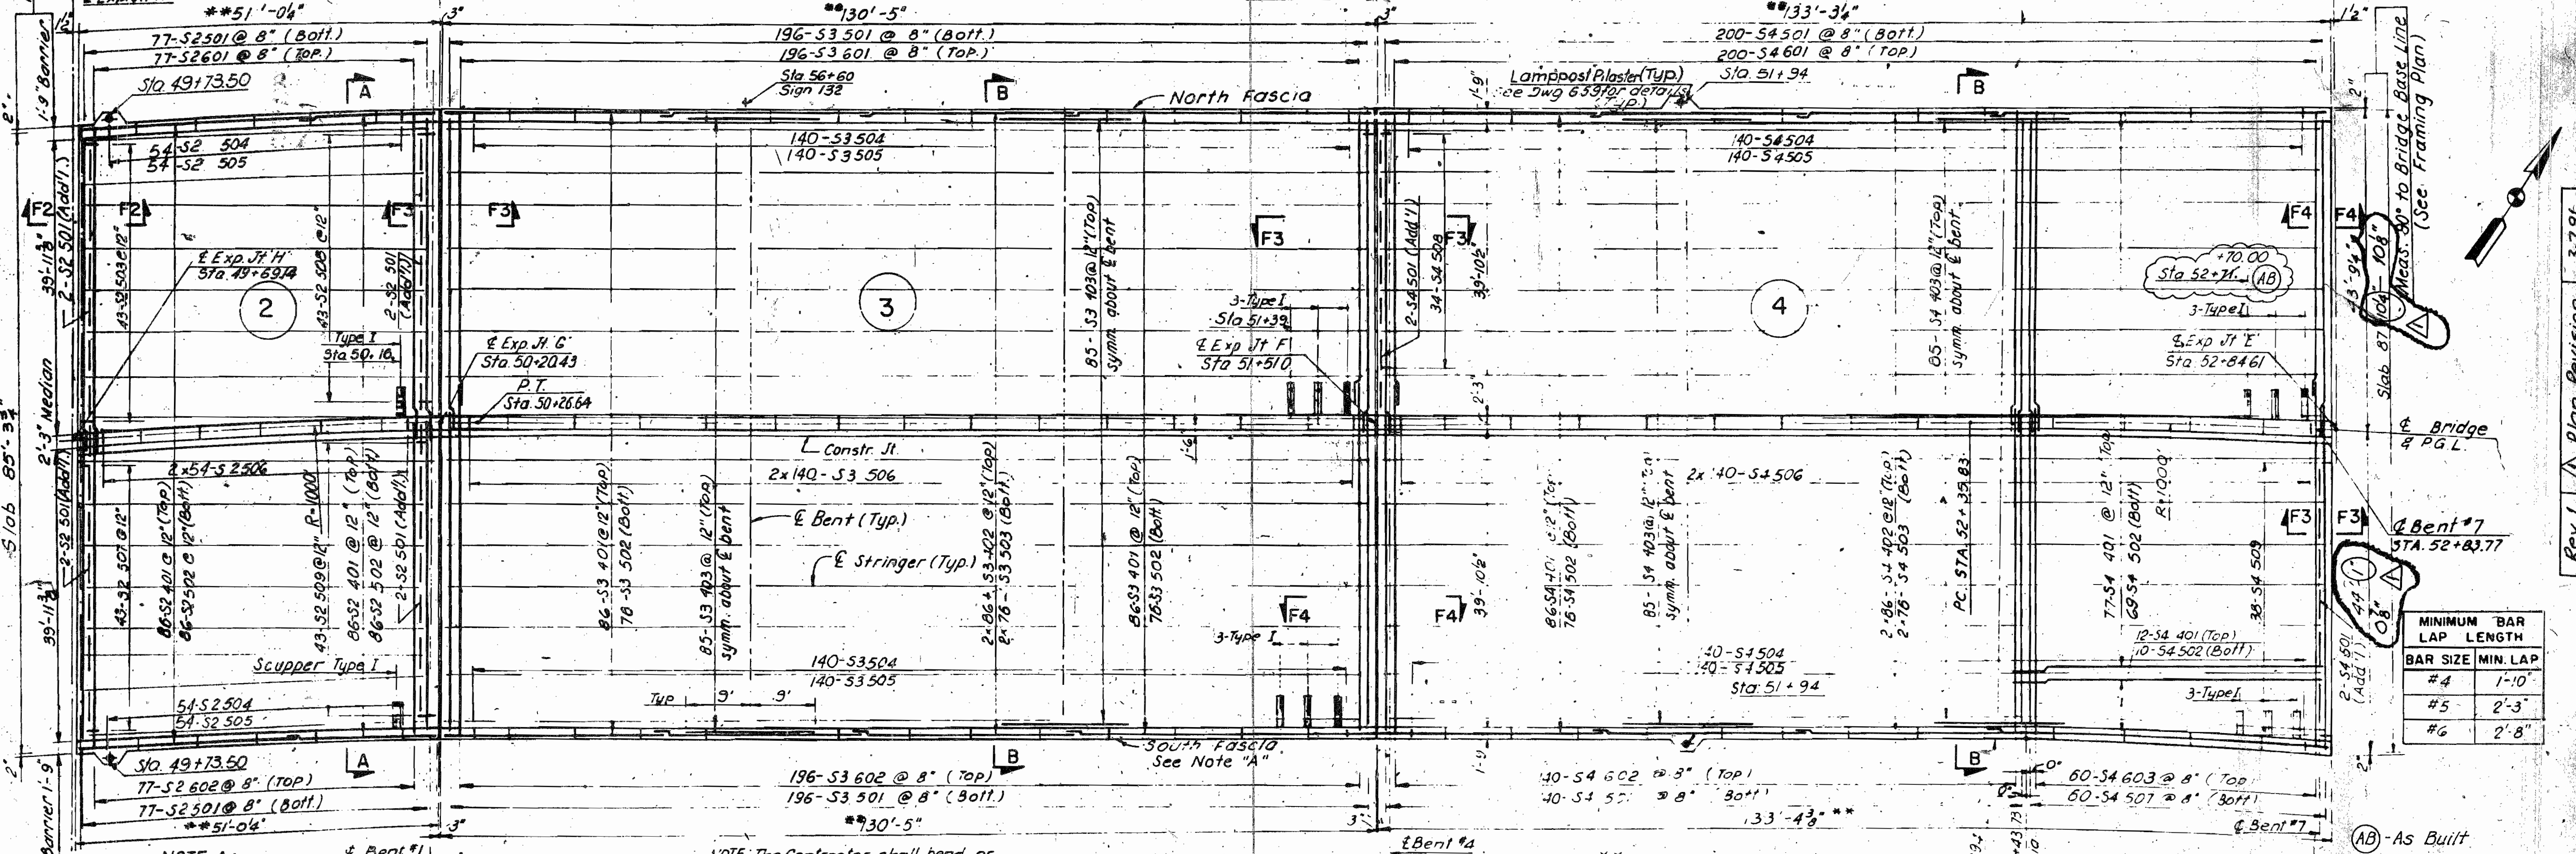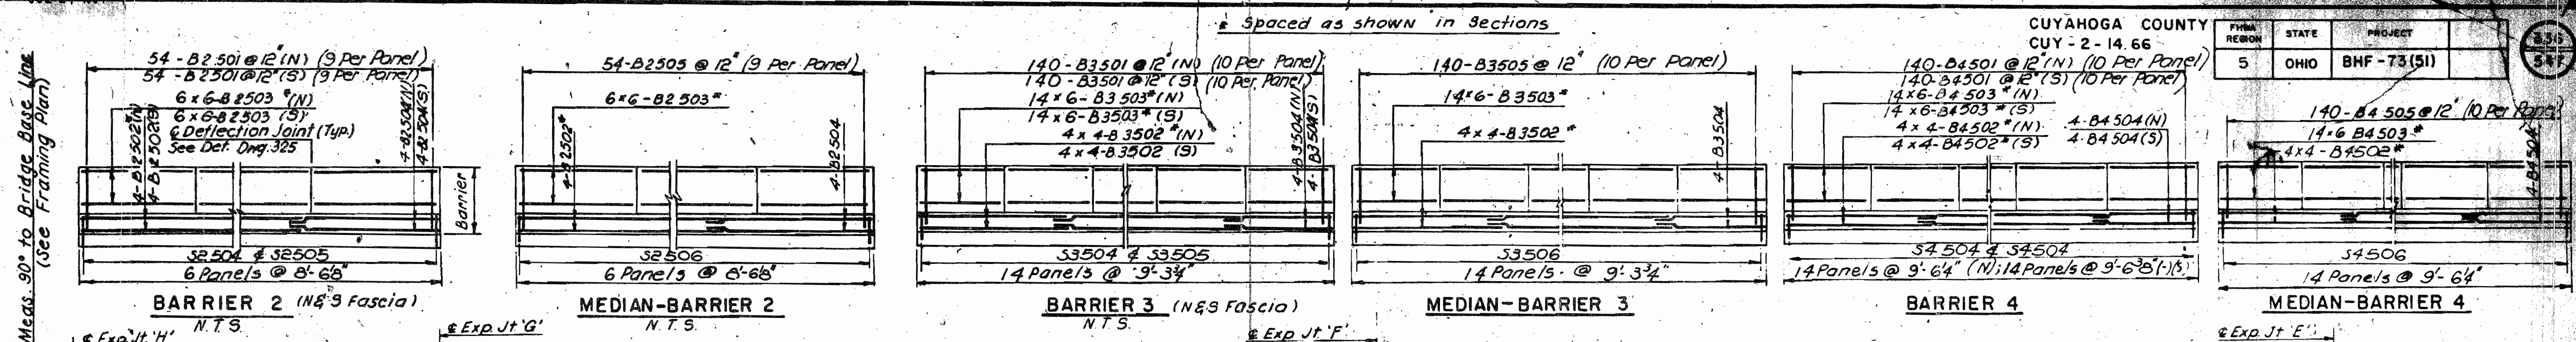

BAR SIZE	MIN. LAP
#4	1'-10"
#5	2'-3"
#6	2'-8"

SLAB PLAN (2-3-4)

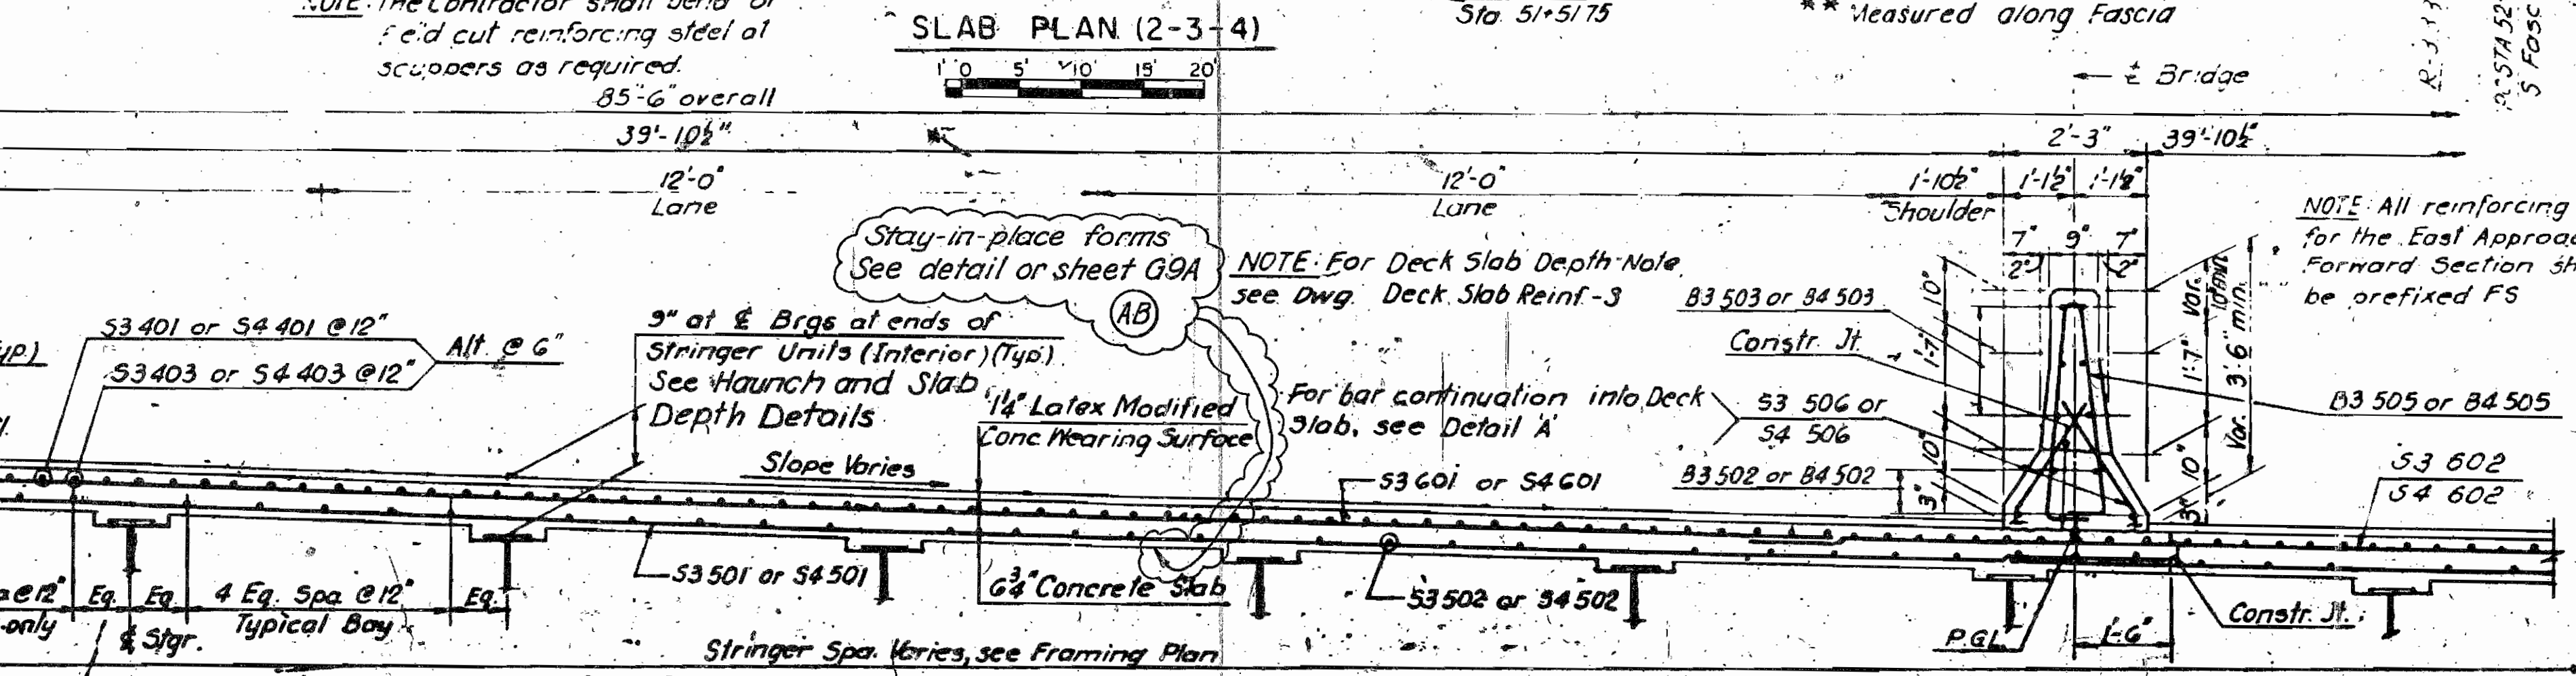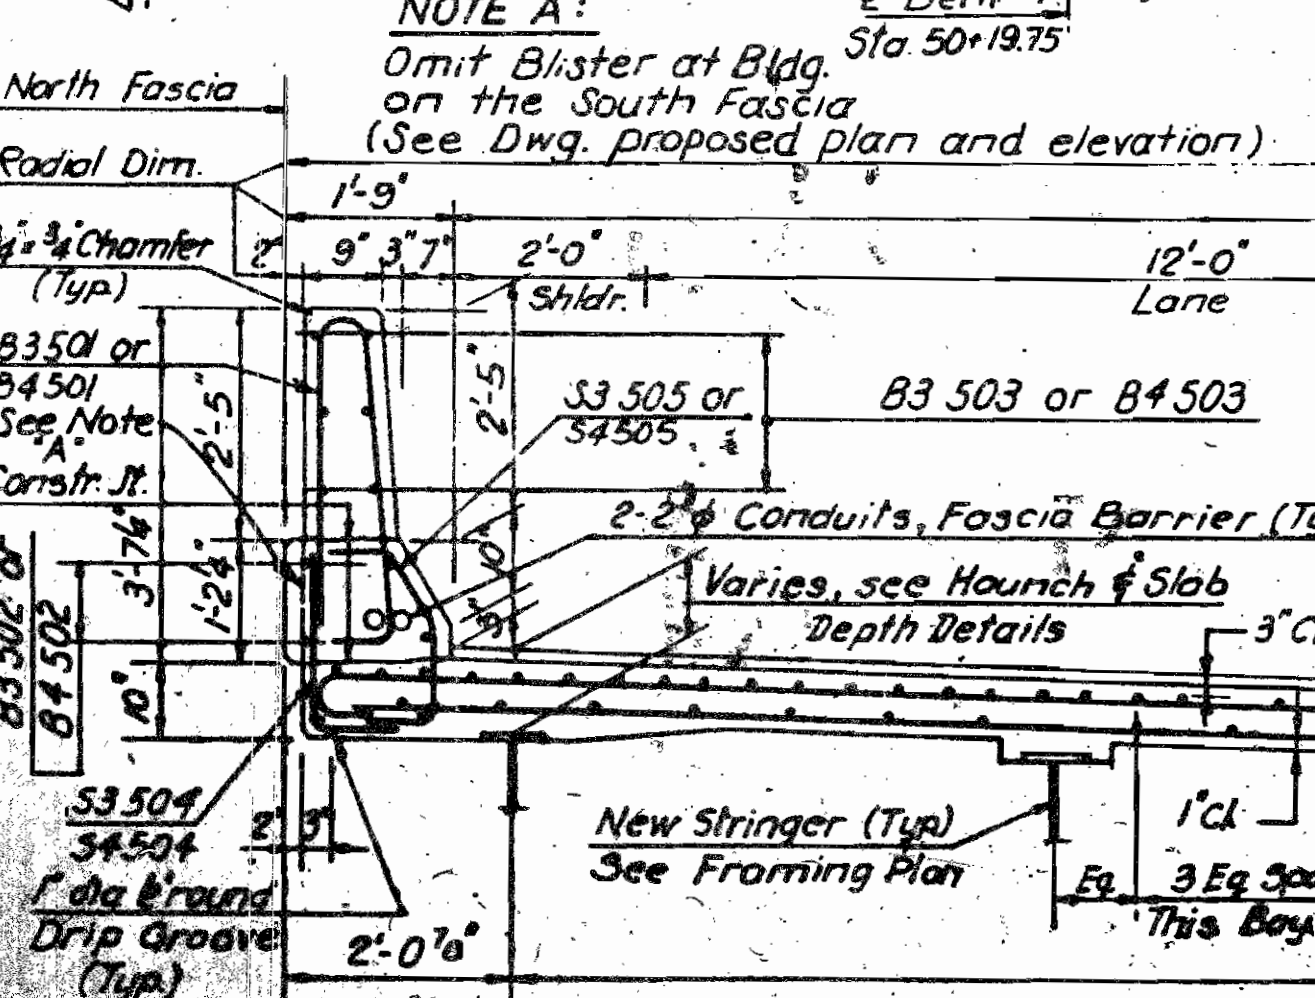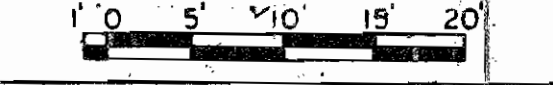

SECTION B-B

NOTE: For Stringer Haunch Details, see Dwg. 338  
 Note: See Dwg. 338 for "Forms for Deck Overhang" Note.

For Section A-A, and Detail A' see Dwg. 340  
 For References and Details, see Dwg. 340

PAVLO ENGINEERING CO., P.C.  
 NEW YORK, NEW YORK

CUYAHOGA COUNTY ENGINEER  
 CLEVELAND OHIO

**MAIN AVENUE BRIDGE**  
 CITY OF CLEVELAND  
 BRIDGE OVER THE CUYAHOGA RIVER VALLEY

EAST APPROACH - FORWARD SECTION  
**DECK SLAB REINFORCEMENT-2**


BRIDGE NO. 193 REPORT NO. 7119 DATE 01/30/89

**NO. B-136**

DESIGN	DRAWN	CHECKED	REVISED TO AS BUILT
B.G.	J.H.	R.O.M.	AS BUILT 2/2/94

ODOT 3-27-81 TES

Rev. 1 Plan Revision 3-7-91

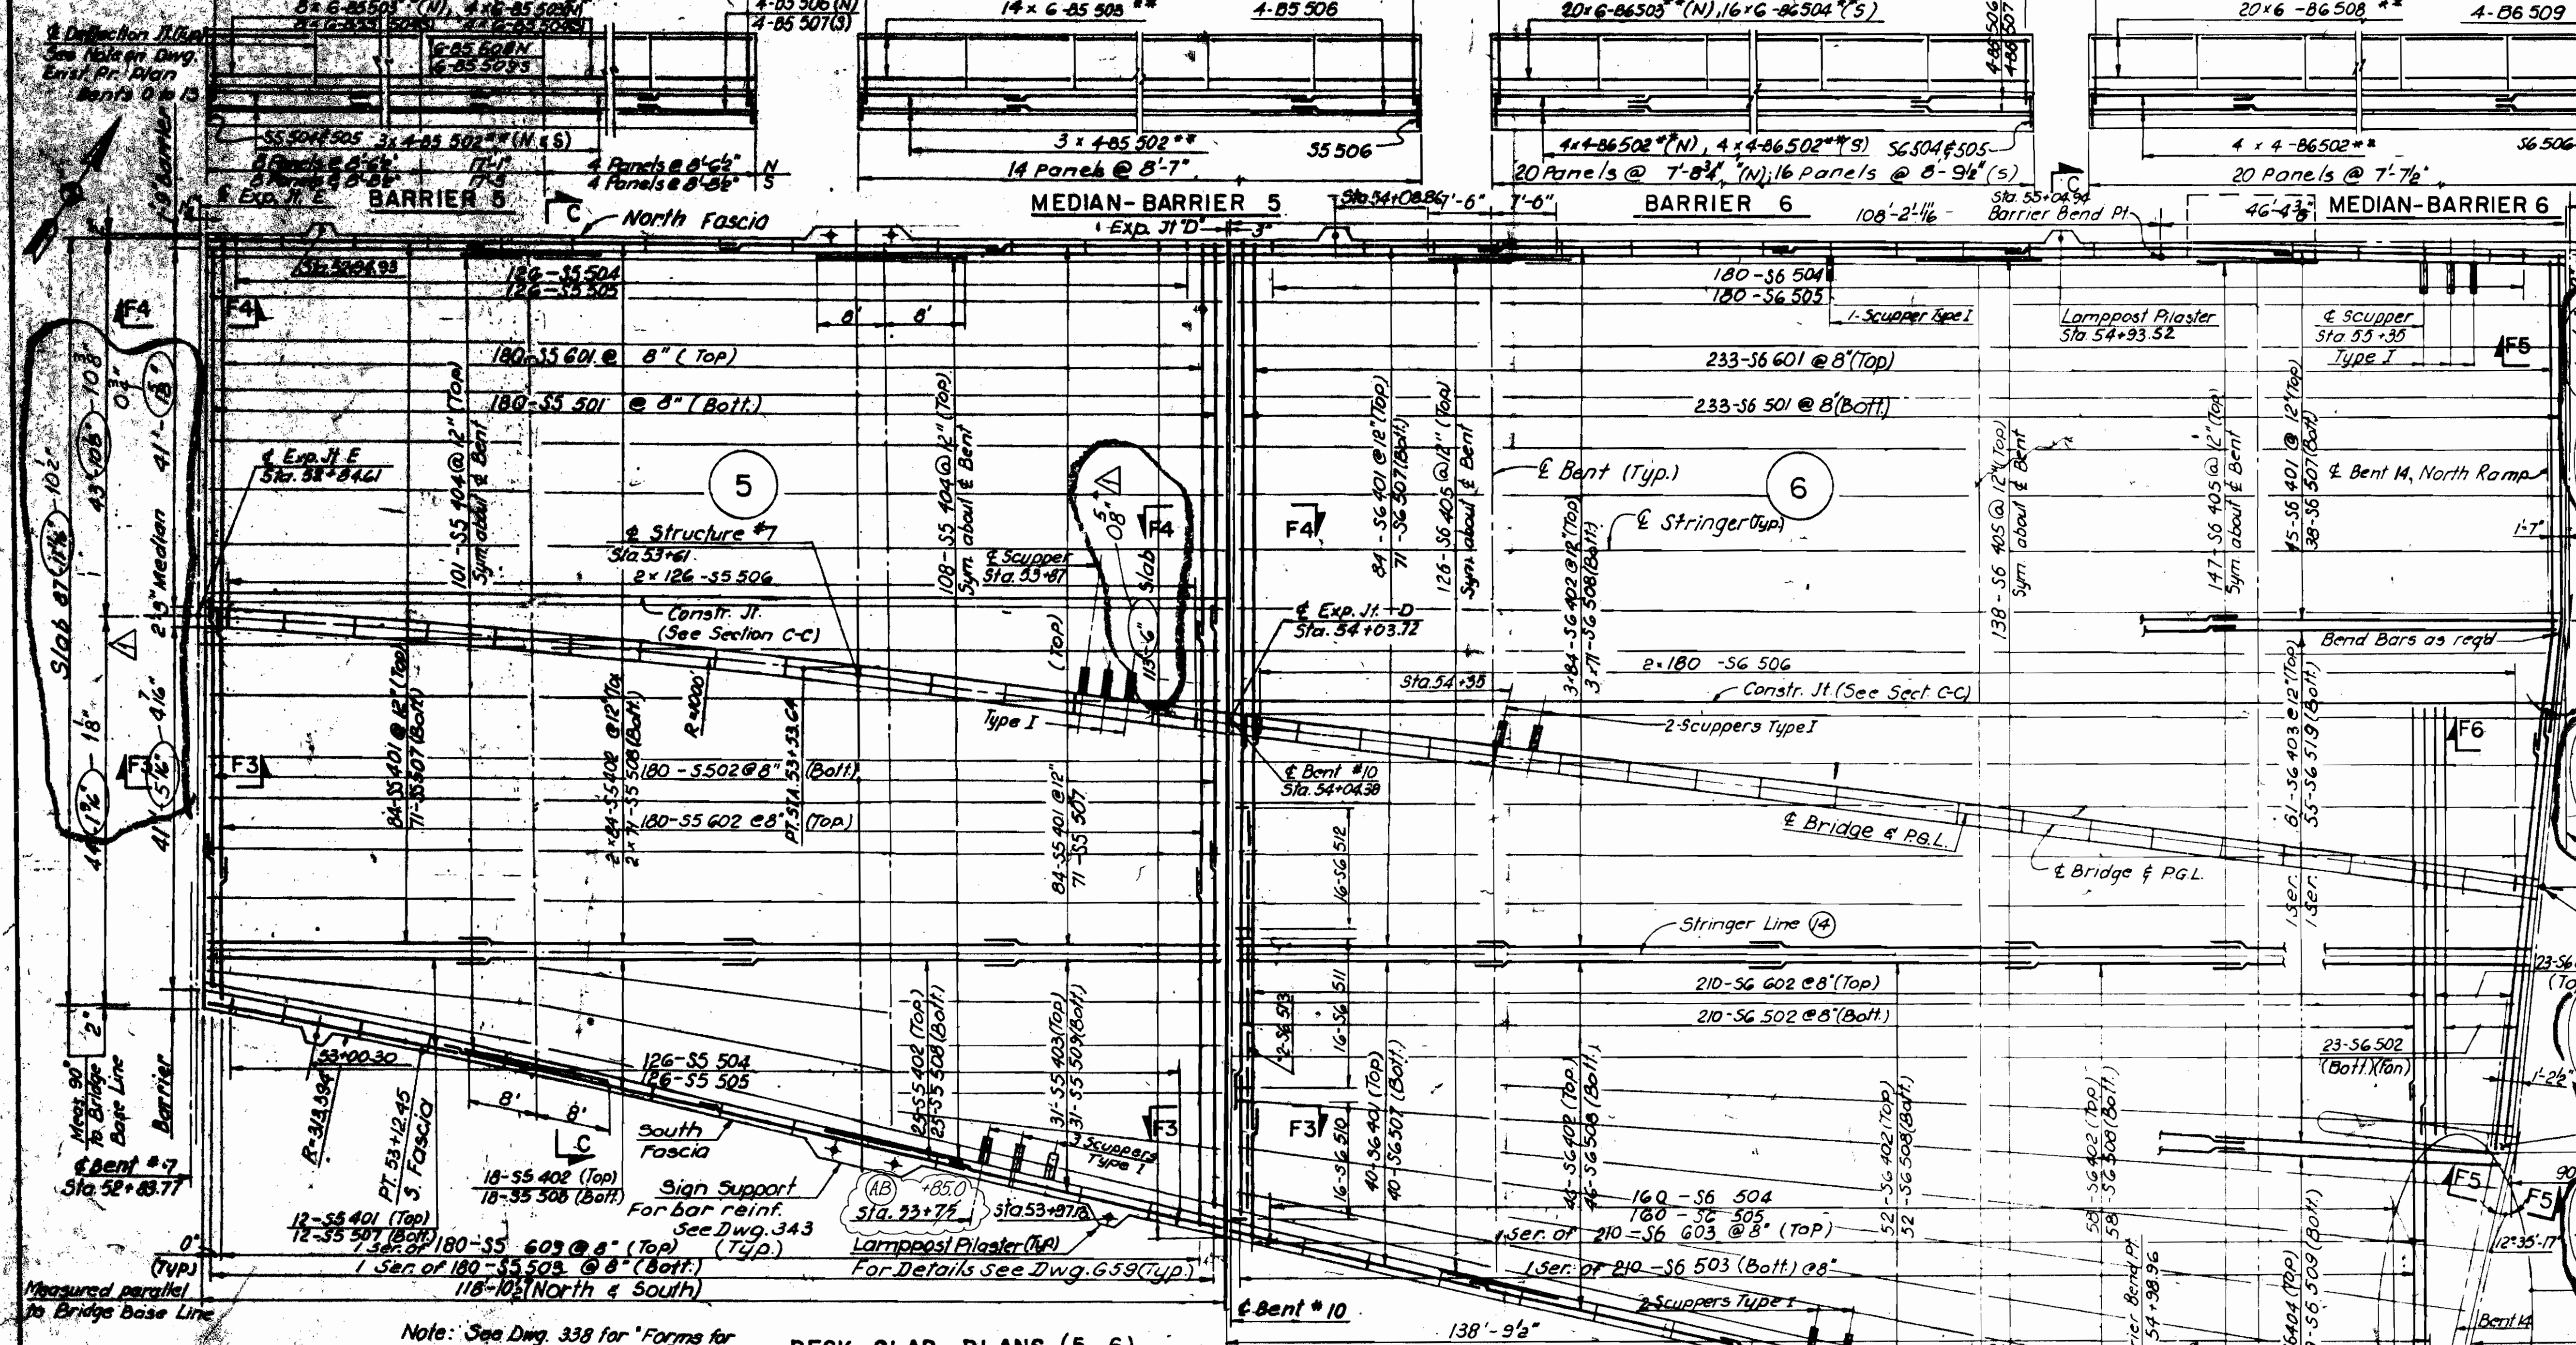

Meas 90° to Bridge Base Line (See Framing Plan)  
Exp. Jt. 'C' \*\* Spaced as shown in Sections. All Barriers N.T.S.

NOTE: The Contractor shall bend or field cut reinforcing steel at Scuppers as required.

NOTES:  
A Haunch Width as shown on Haunch and Depth of Slab Details shall be used for computing quantity of Concrete.

DECK SLAB DEPTH:  
The distance shown from top of deck to top of steel beam is the design dimension. The quantity of deck concrete to be paid for shall be based on this dimension, less 1/4" wearing surface even though deviation from it may be necessary because the top flange of the beam may not have the exact camber or conformation required to place it parallel to the finished grade.

\* This is the design dimension. The quantity of deck concrete to be paid for shall be based upon this dimension, less 1/4" even though deviation from it may be necessary because the top flange of the girder may not have the exact camber or conformation required to place it parallel to the finished grade. Deduction shall be made for volume of encased steel plates as per 511.18.

90° to Bridge Base Line  
See framing plan Dwg. 311

Exp. Jt. C  
Sta 55+56.06

For References and Details, see Dwg. 340

"G.R.E.A.T." System Impact Attenuator and backup unit. For bar Reinf. see Dwg. 345

90° to Bridge Base Line

NOTE: All reinforcing bars for the East Approach-Forward Section shall be prefixed FS.

See Det. T.Dwg. Deck Slab Reinf.

Rev. 3 Plan Revisions 11-15-91  
Rev. 2 Plan Revisions 10-1-91

PAVLO ENGINEERING CO., P.C.  
NEW YORK, NEW YORK.

CUYAHOGA COUNTY ENGINEER  
CLEVELAND OHIO.

MAIN AVENUE BRIDGE

CITY OF CLEVELAND  
BRIDGE OVER THE CUYAHOGA RIVER VALLEY

EAST APPROACH - FORWARD SECTION  
DECK SLAB REINFORCEMENT

BRIDGE NO. 193 REPORT NO. 342

NO. B-136


DESIGN: E.C. DRAWN: J.L. CHECKED: J.L. DATE: 12-9-91

AS BUILT 2/94

Note: See Dwg. 338 for Forms for Deck Overhang note.


DECK SLAB PLANS (5-6)

MINIMUM BAR LAP LENGTH	
BAR SIZE	MIN. LAP
#4	1'-10"
#5	2'-3"
#6	2'-8"

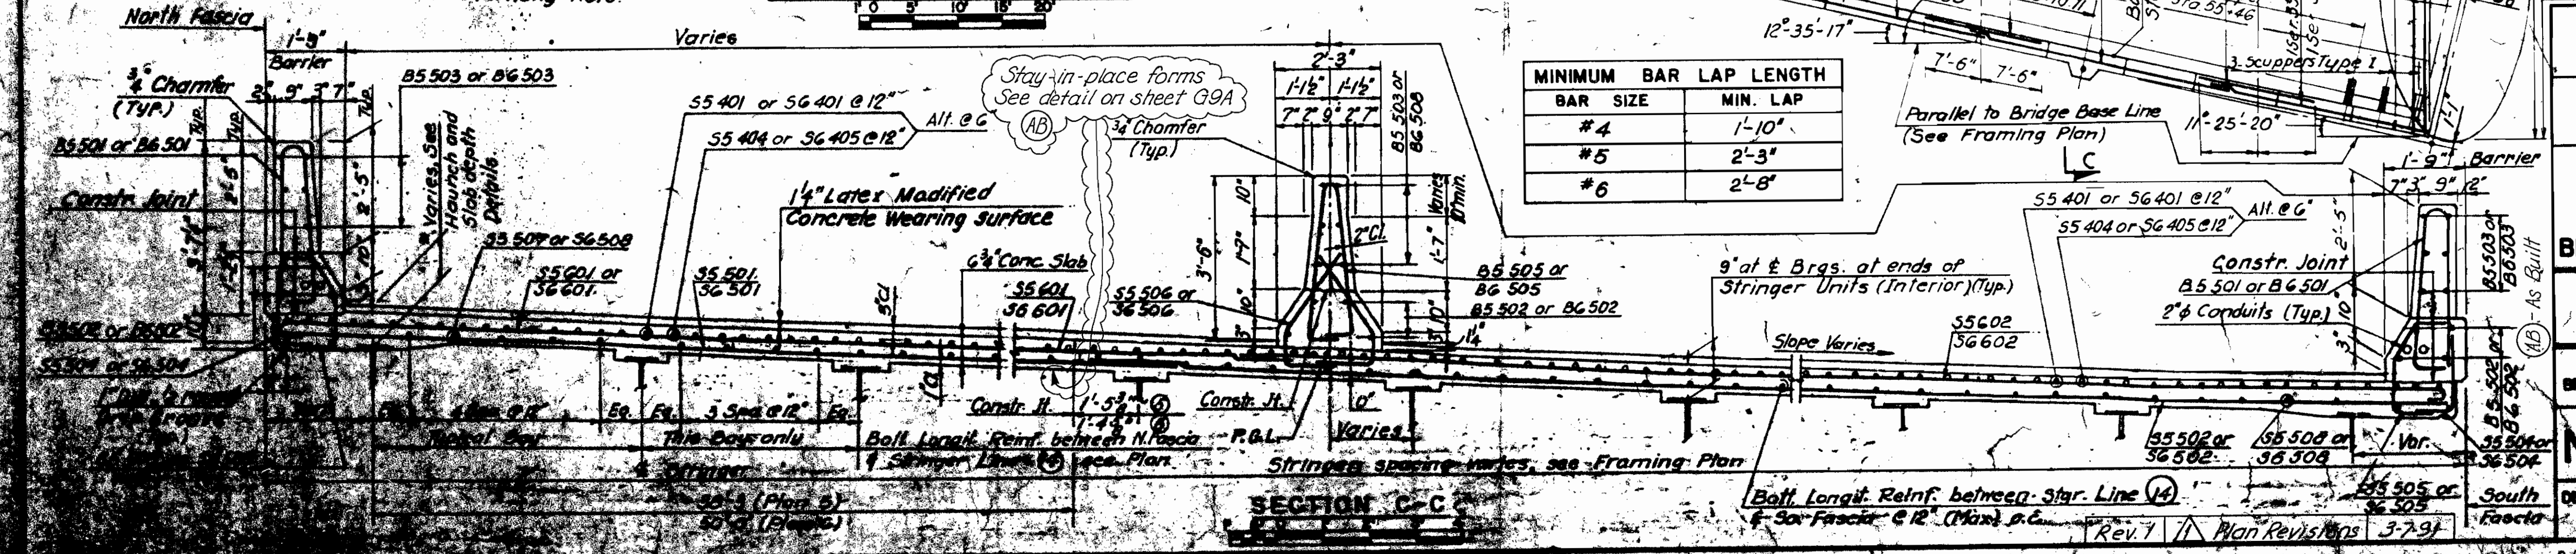


SECTION C-C

Rev. 7 Plan Revisions 3-7-93

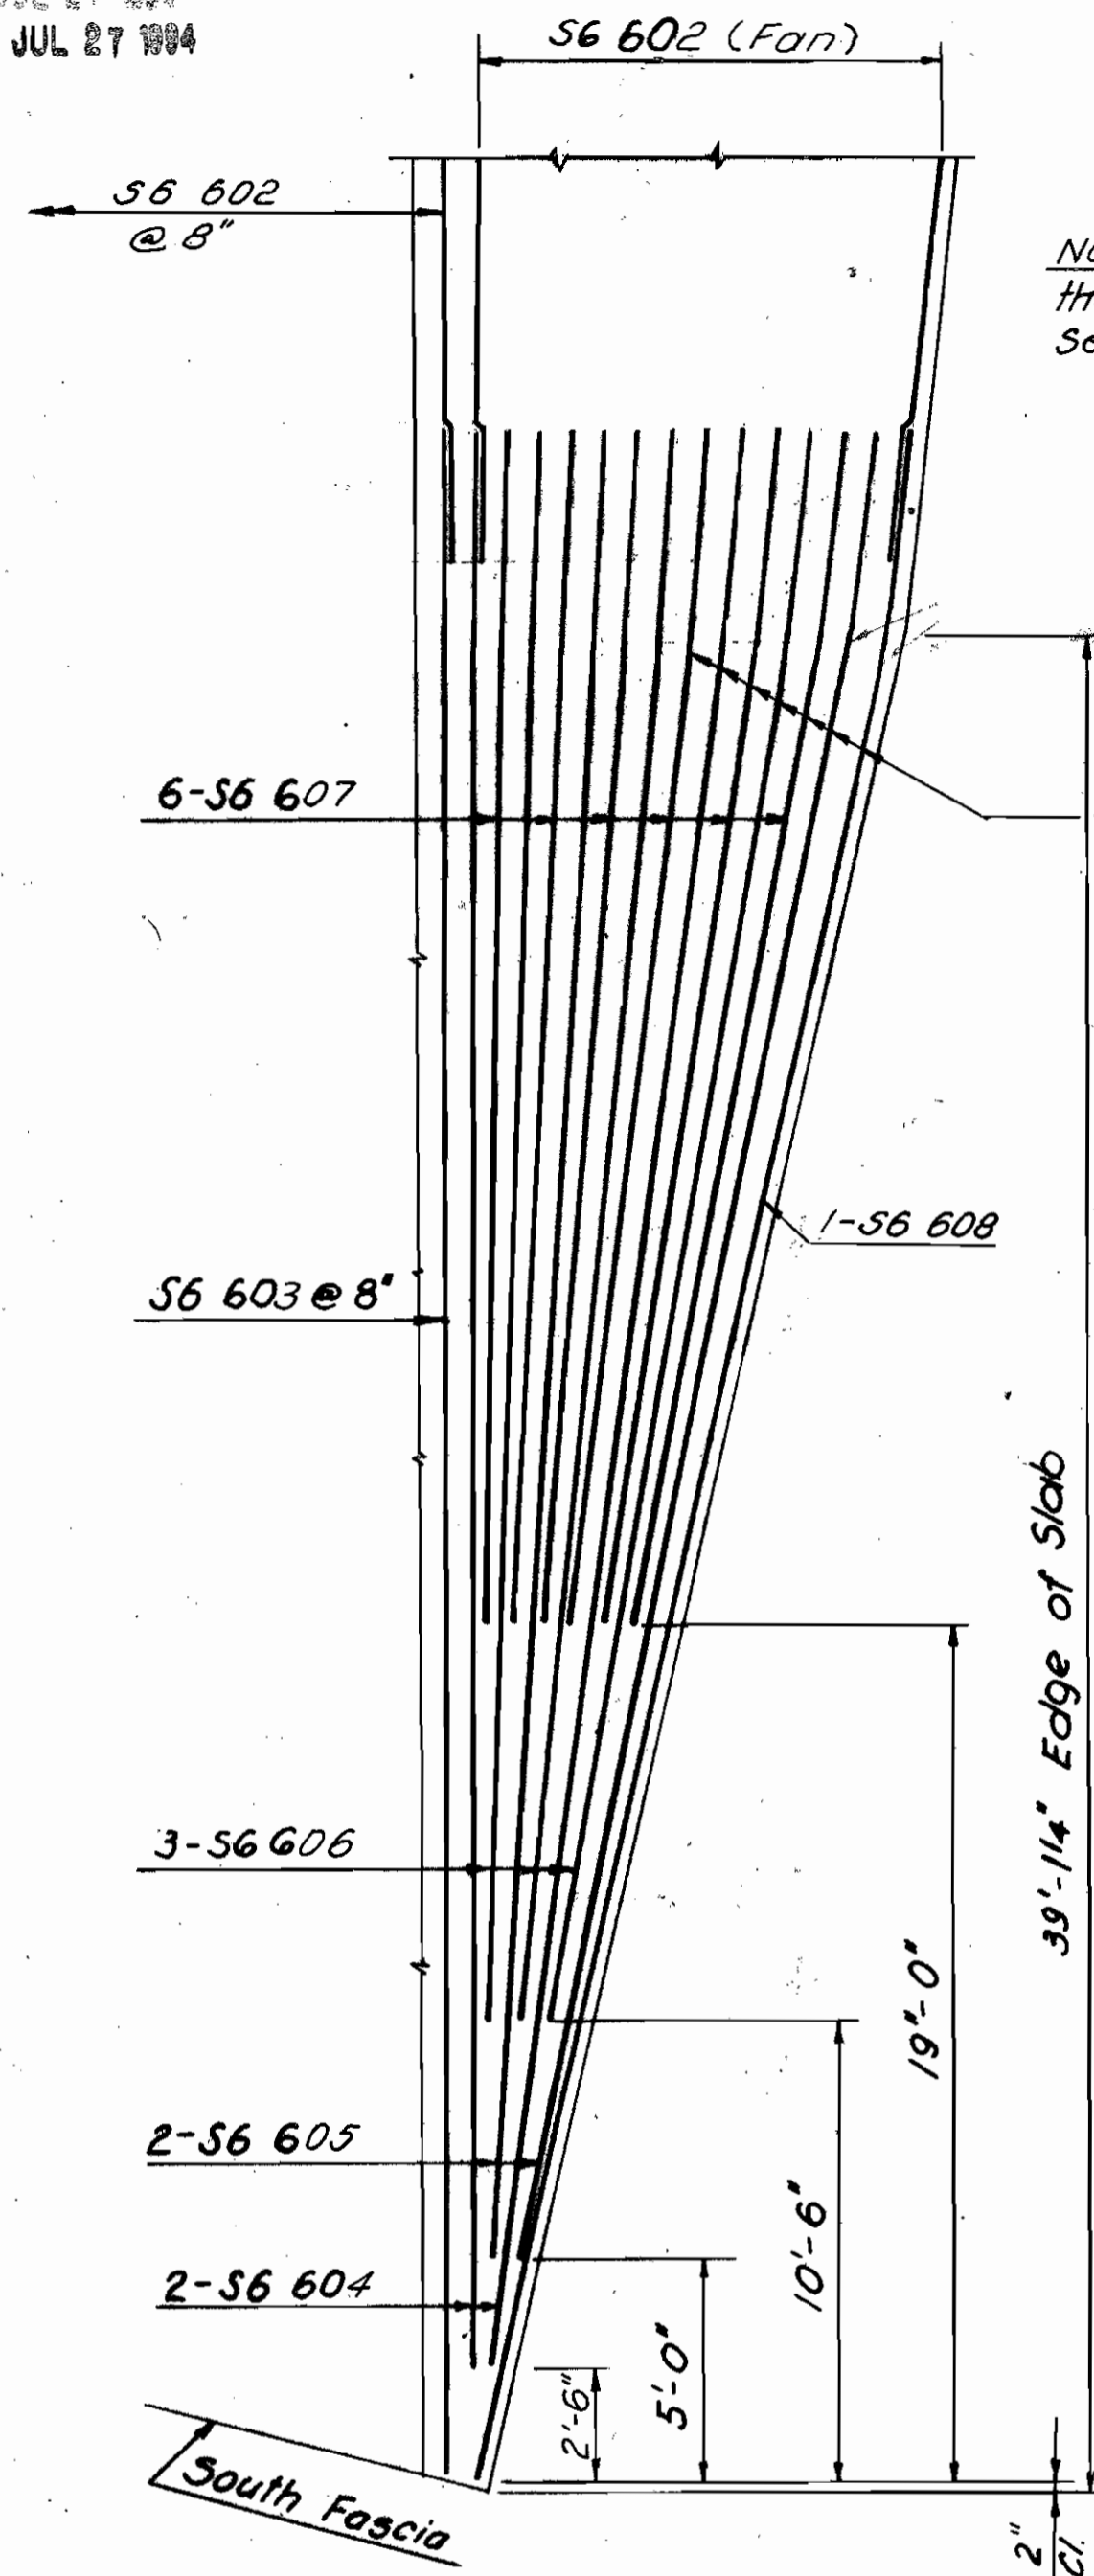


DETAIL I - Top of Slab


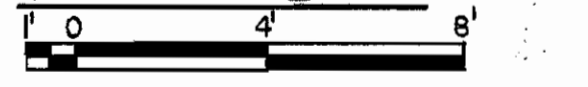


NOTE: For location of Detail I, see Dwg. Deck Slab Reinf.-3

NOTE: All reinforcing bars for the East Approach - Forward Section shall be prefixed FS

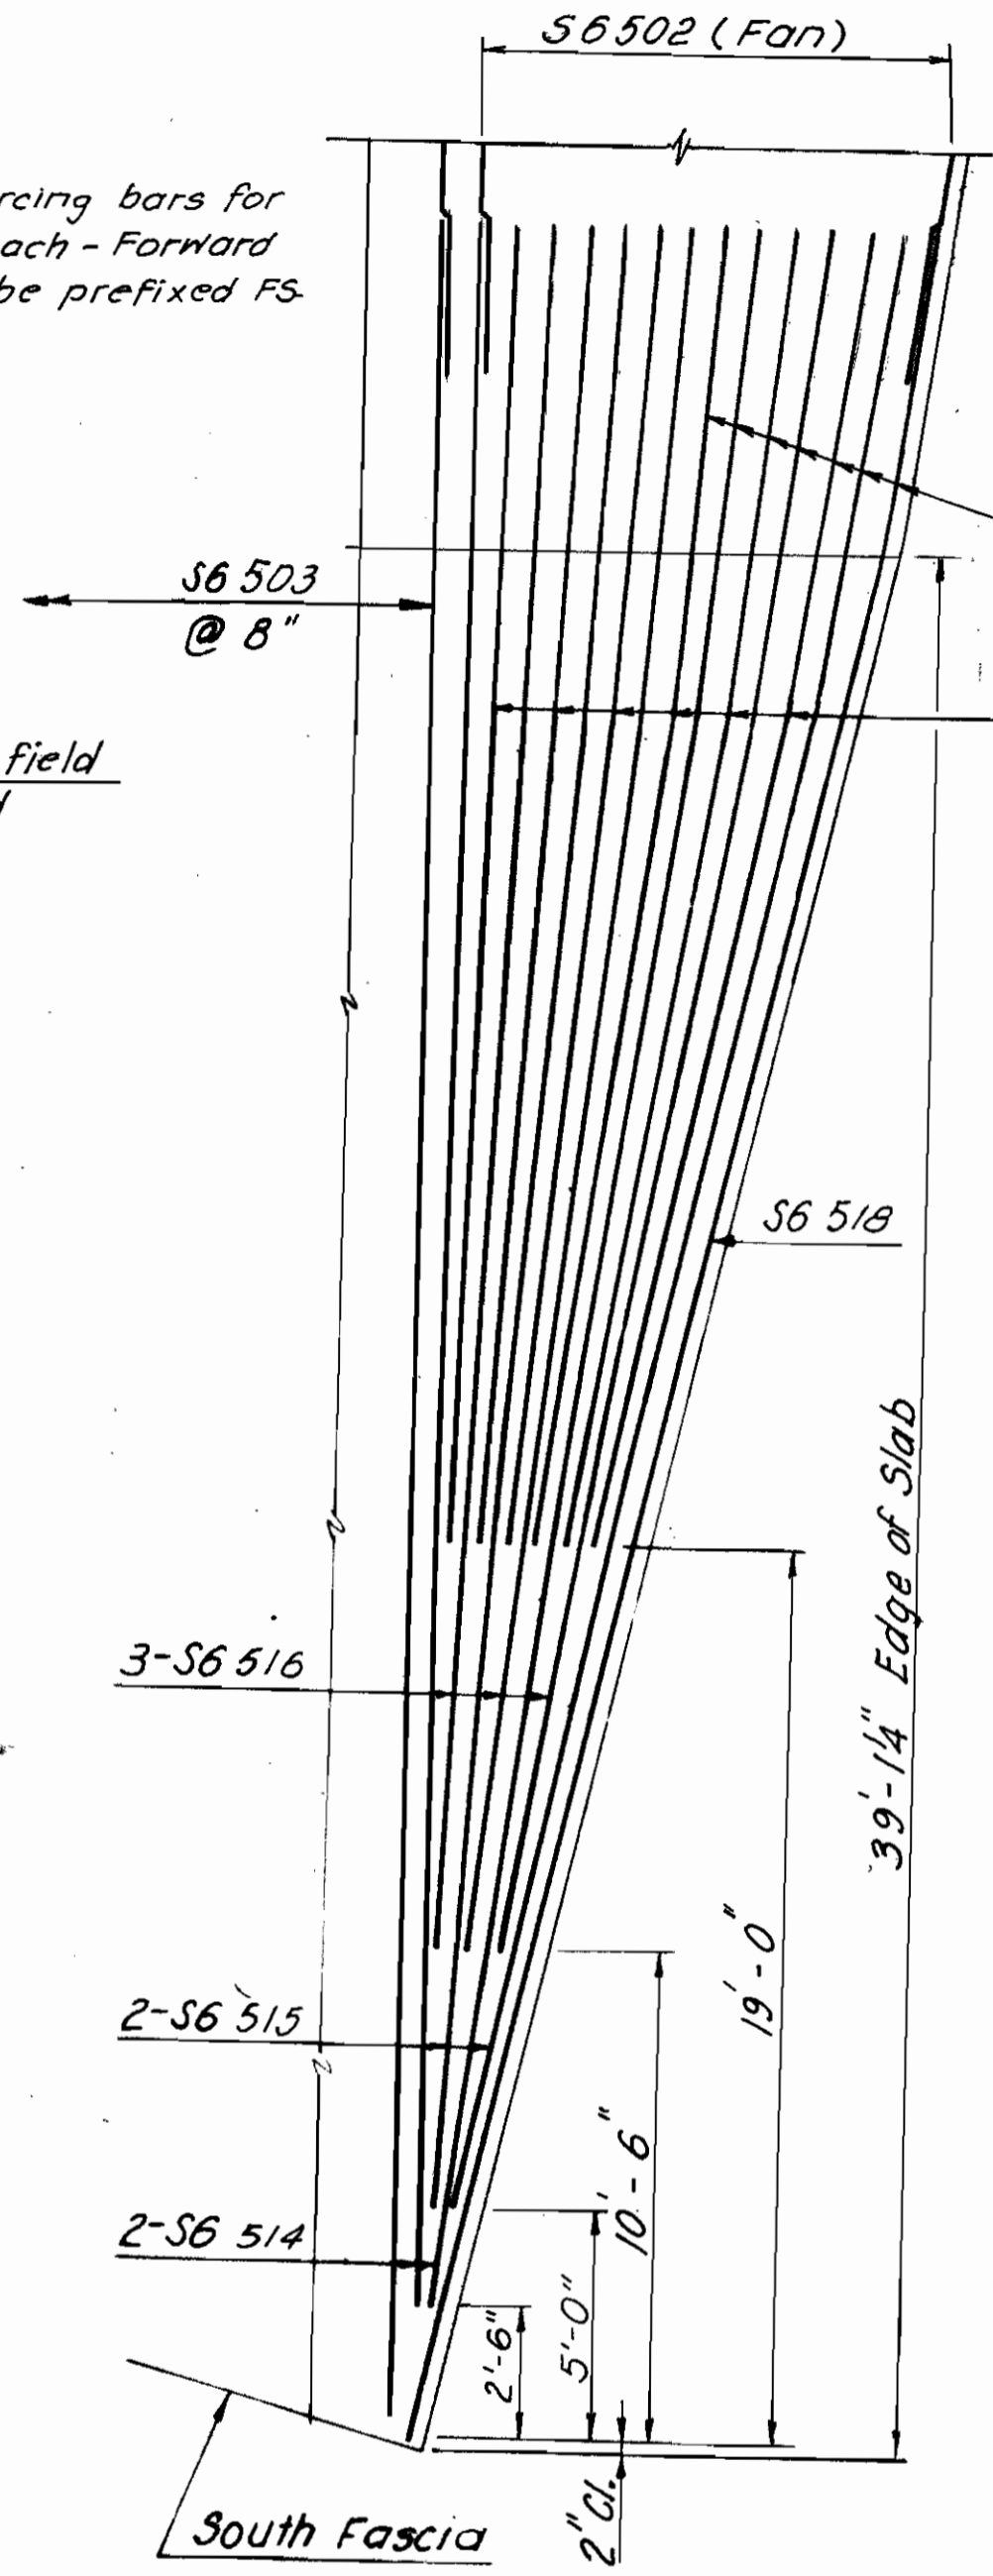


DETAIL I - Bottom of Slab

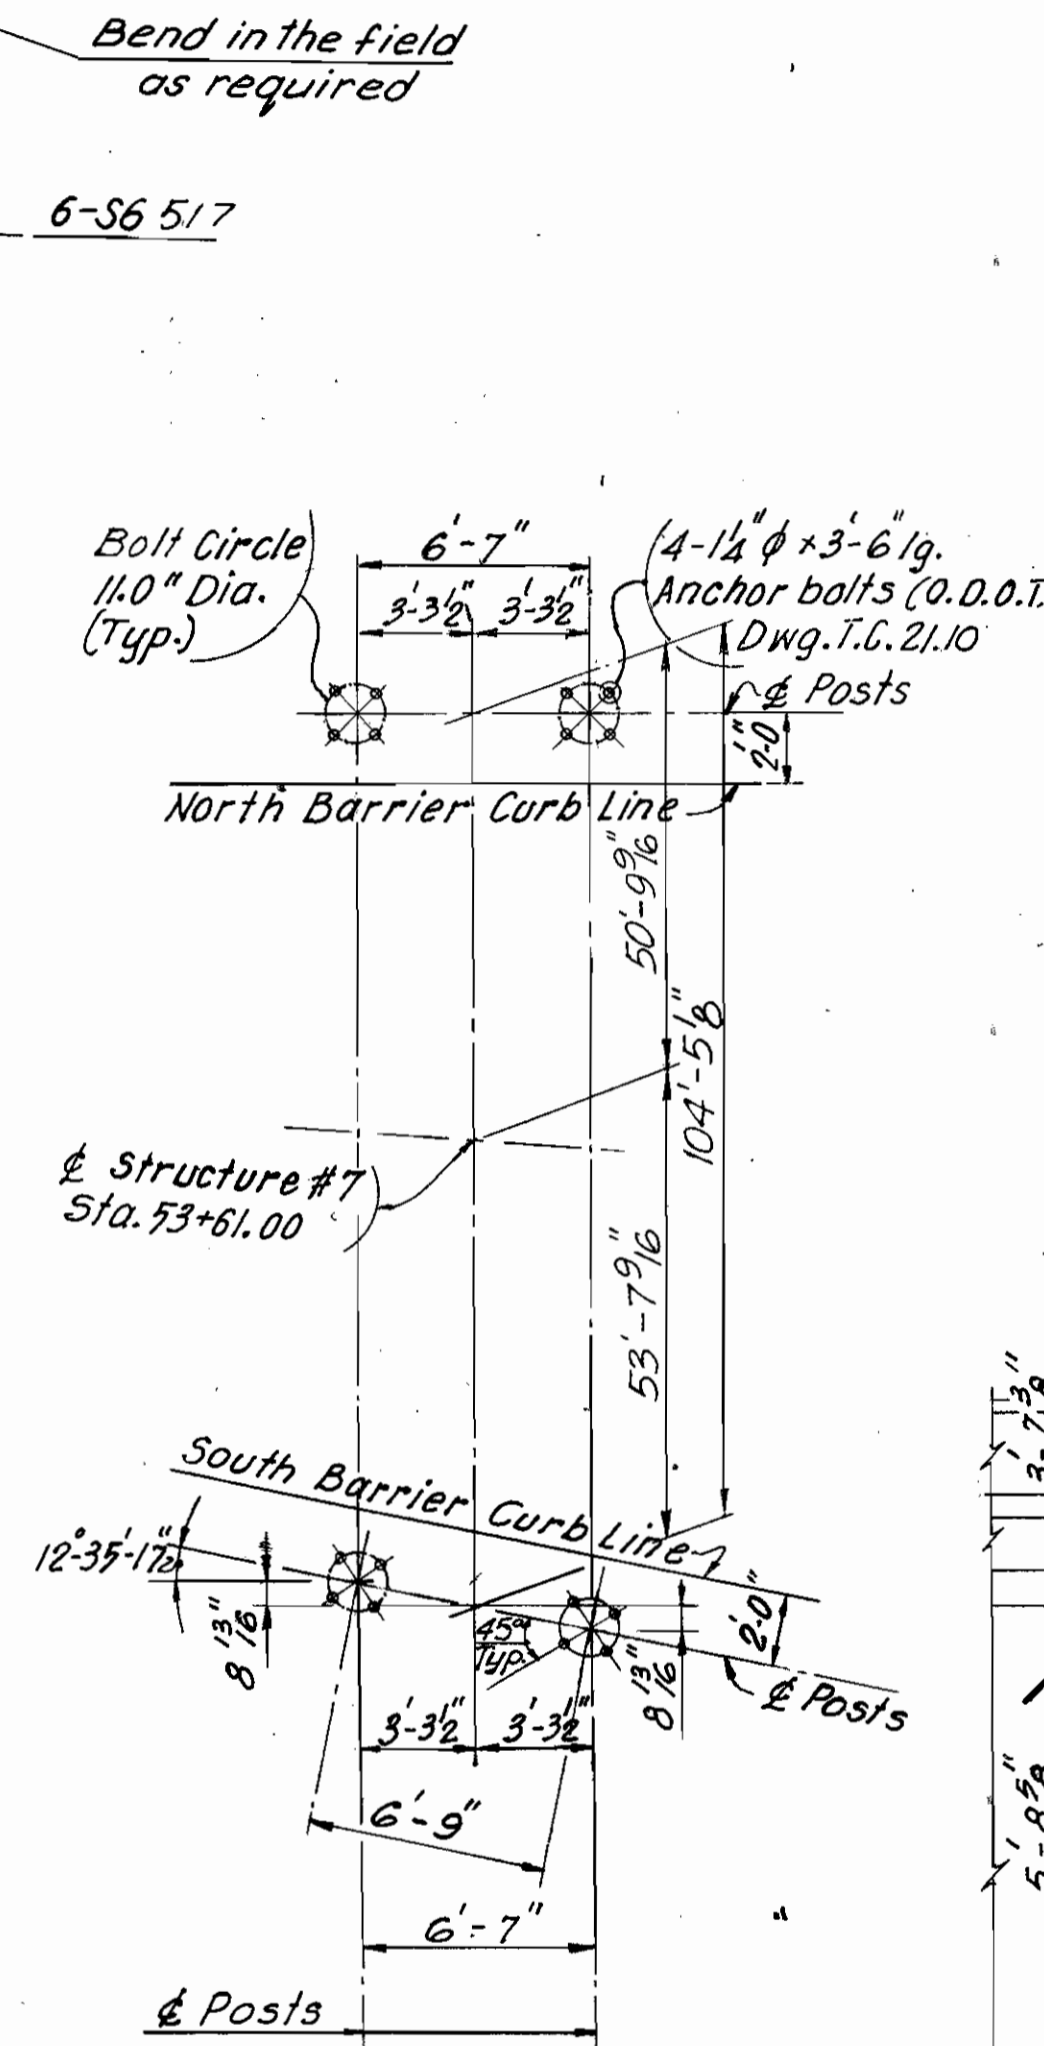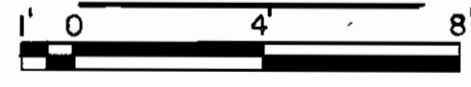

KEY PLAN

See Dwg. Deck Slab Reinforcement-3

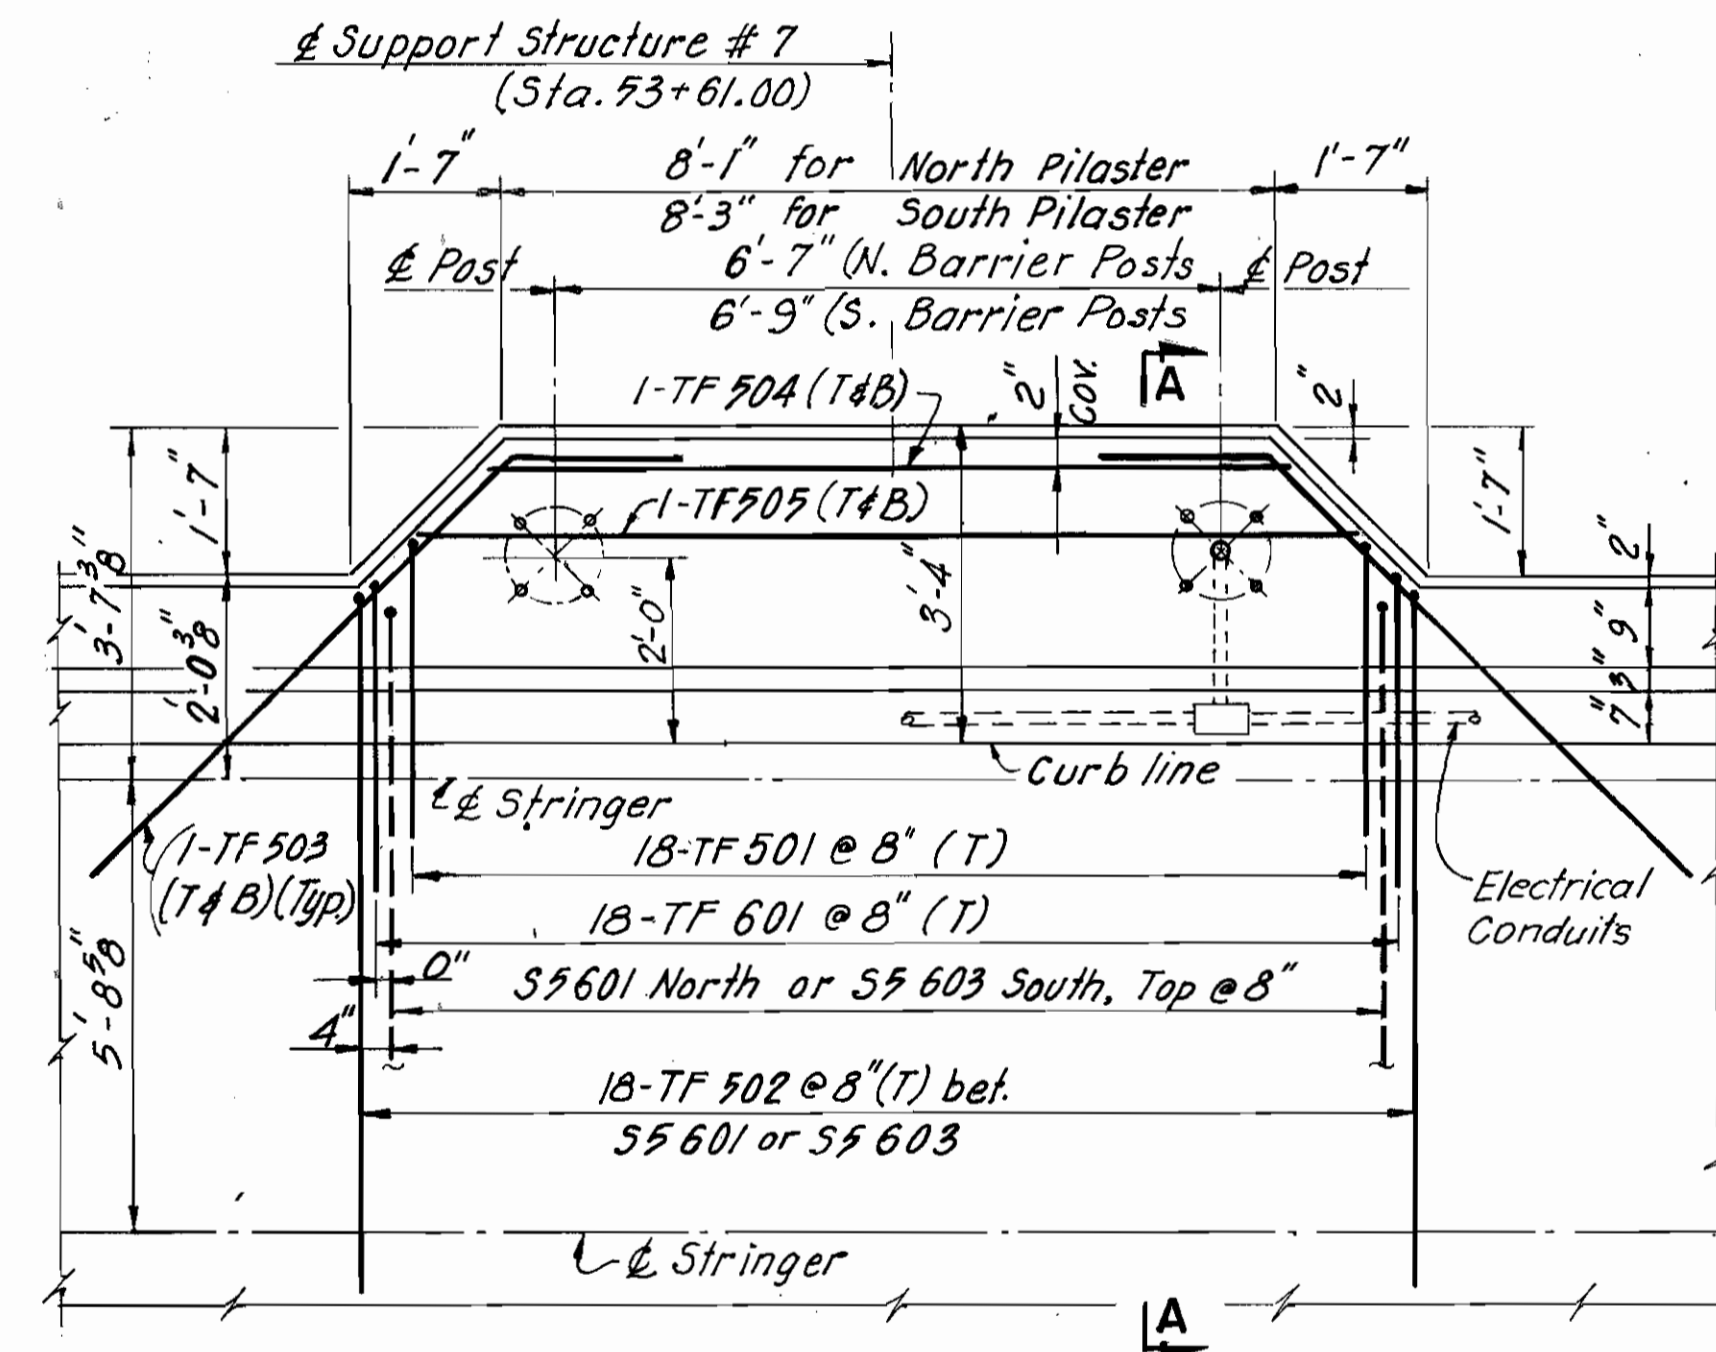


ADDITIONAL REINFORCEMENT AT SIGN SUPPORT

Note: Typical Slab & Barrier Reinforcement omitted for clarity. (See Dwg. 342)

- North Pilaster shown • South Pilaster similar.
- For location and details, see Key Plan this Dwg.

NOTE "D"  
Preformed deflection joint filler in barriers shall be either 1/4" thick gray sponge rubber (AASHTO M-153) or 1/4" gray cellular polyvinyl chloride (PVC) sponge. Concrete parapets above upper construction joints shall be placed in alternate sections by the use of bulkheads. Closing sections shall be placed after removal of bulkheads and after placement of joint filler.

MINIMUM BAR LAP LENGTH	
BAR SIZE	MIN. LAP
#4	1'-10"
#5	2'-3"
#6	2'-8"

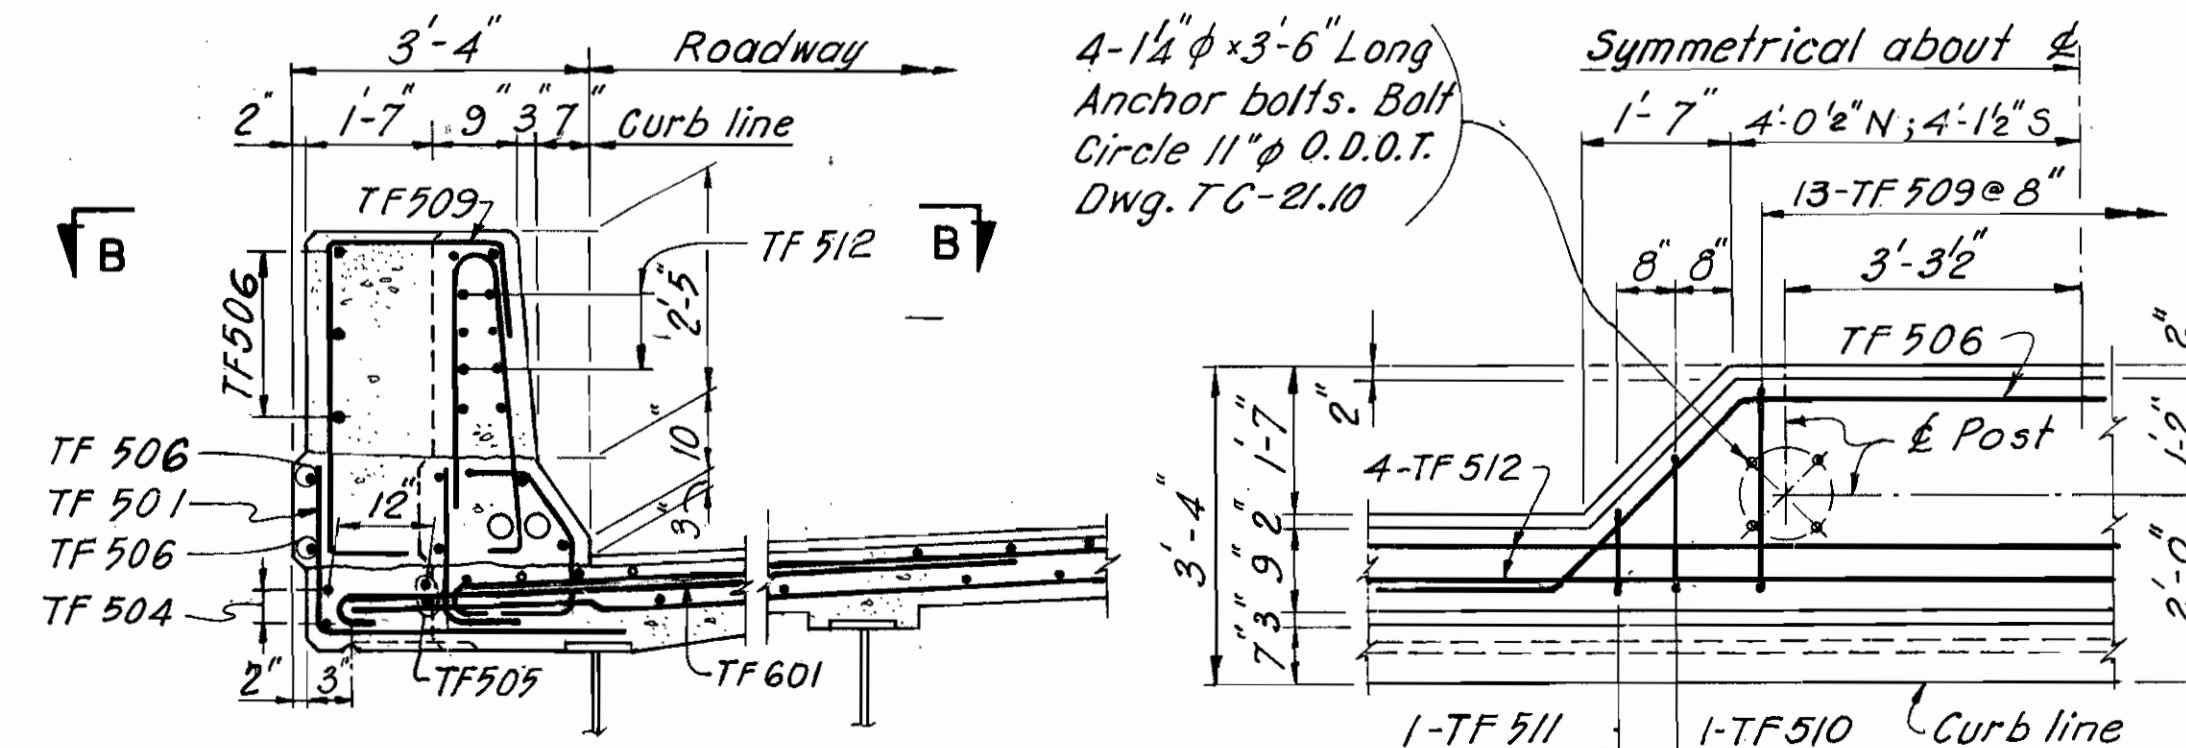

SECTION A-A




SECTION B-B


REFERENCES  
Deck Slab Reinf.-3 & Notes

DWG. NO.  
342


PAVLO ENGINEERING CO., P.C. NEW YORK, NEW YORK	
CUYAHOGA COUNTY ENGINEER CLEVELAND OHIO	
<b>MAIN AVENUE BRIDGE</b>	
CITY OF CLEVELAND BRIDGE OVER THE CUYAHOGA RIVER VALLEY	
EAST APPROACH - FORWARD SECTION <b>DECK SLAB REINFORCEMENT-4</b>	
BRIDGE NO. 193	REPORT NO. 7119 DATE Oct. 20, 1989
<b>NO. B-136</b>	
DESIGN B.G.	DRAWN J.H.
CHECKED R.D.M.	REVISED TO AS BUILT AS BUILT 2/74

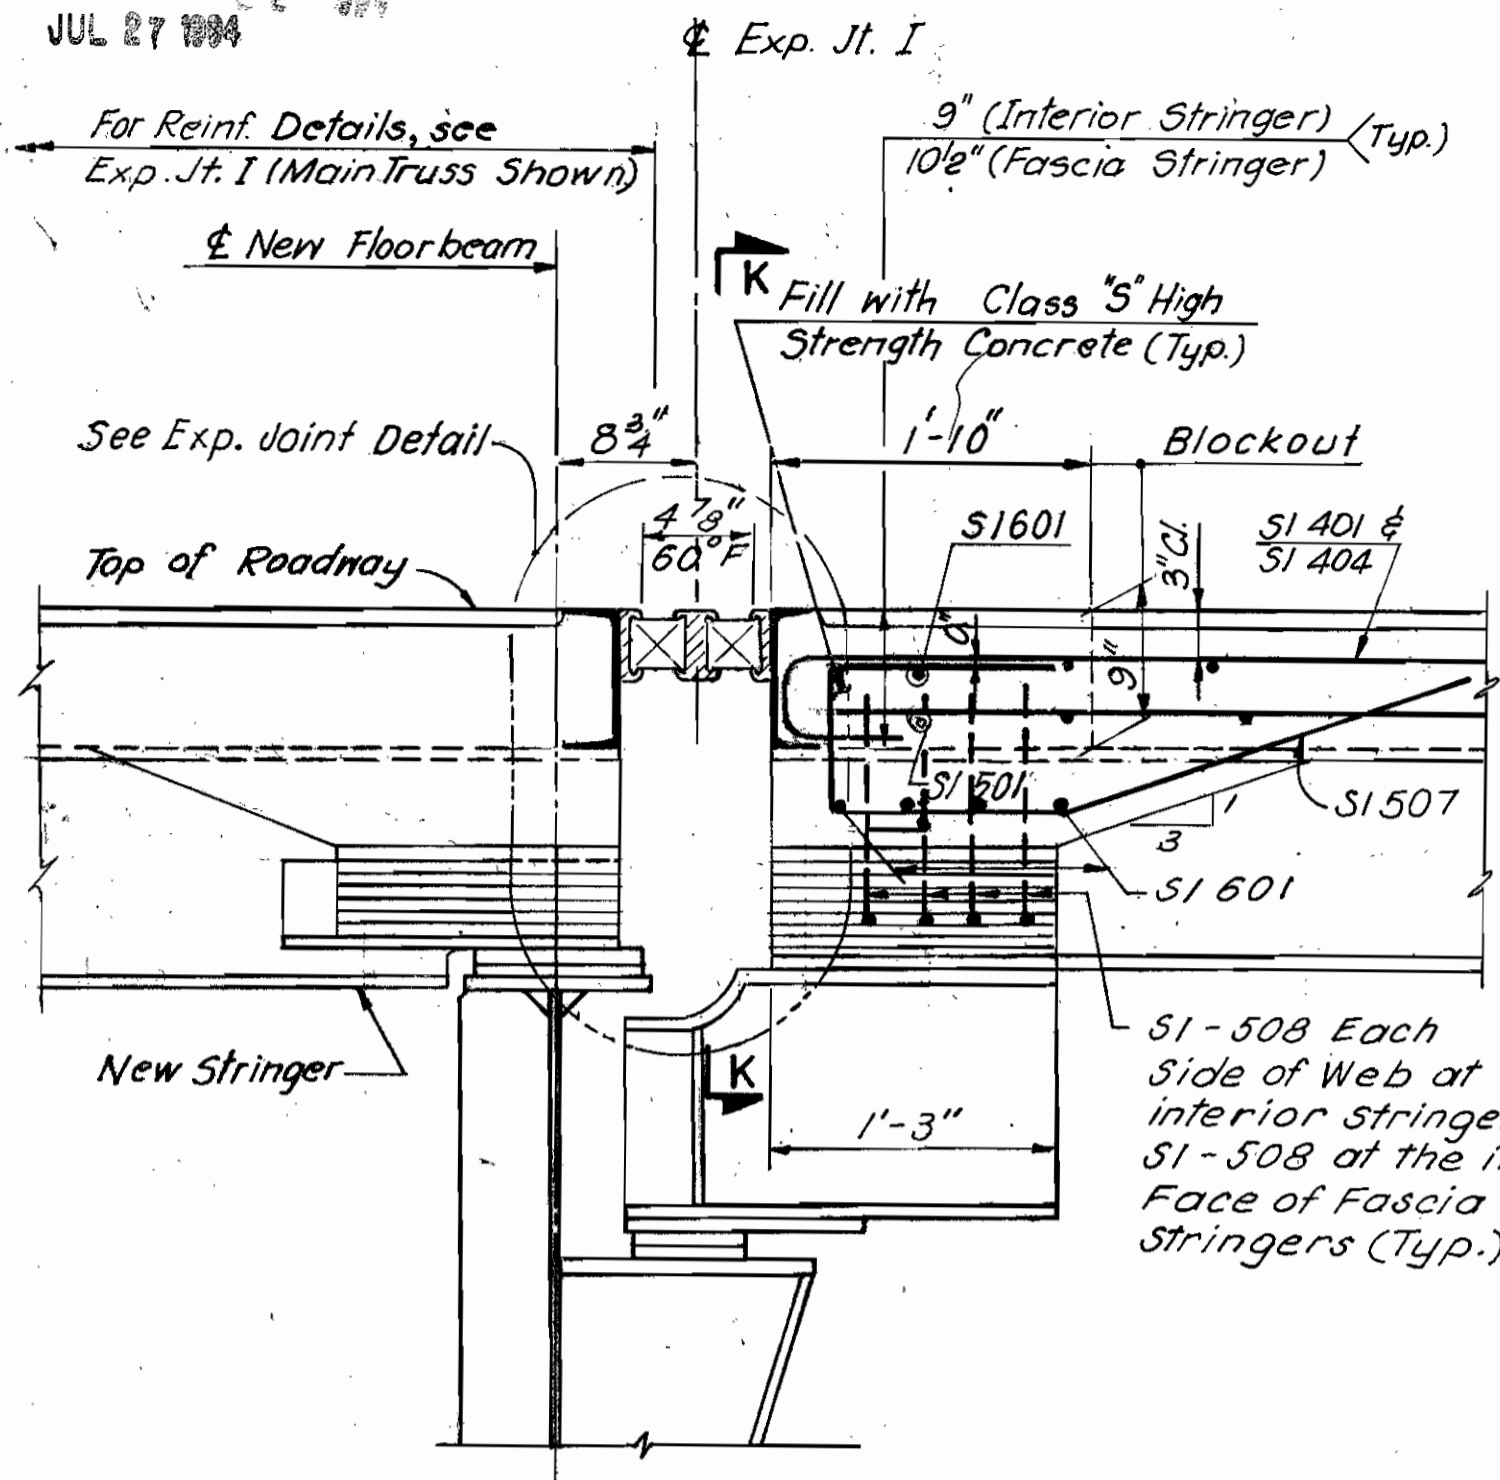


SECTION F1-F1

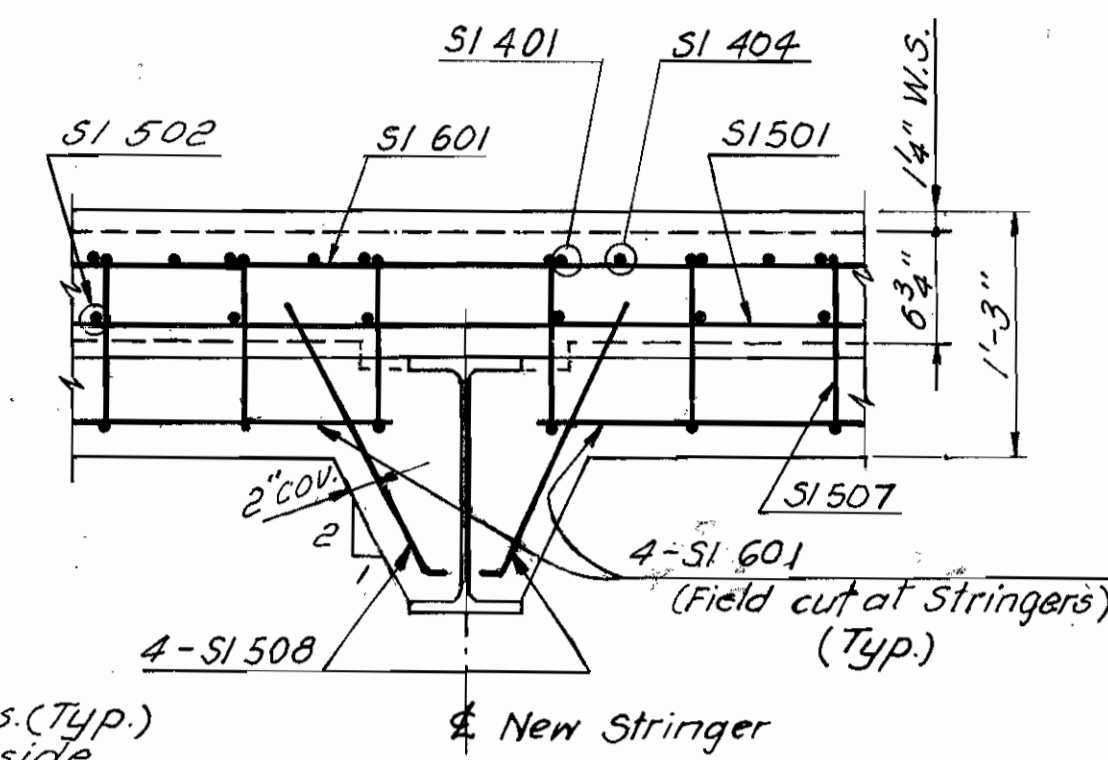


SECTION K-K

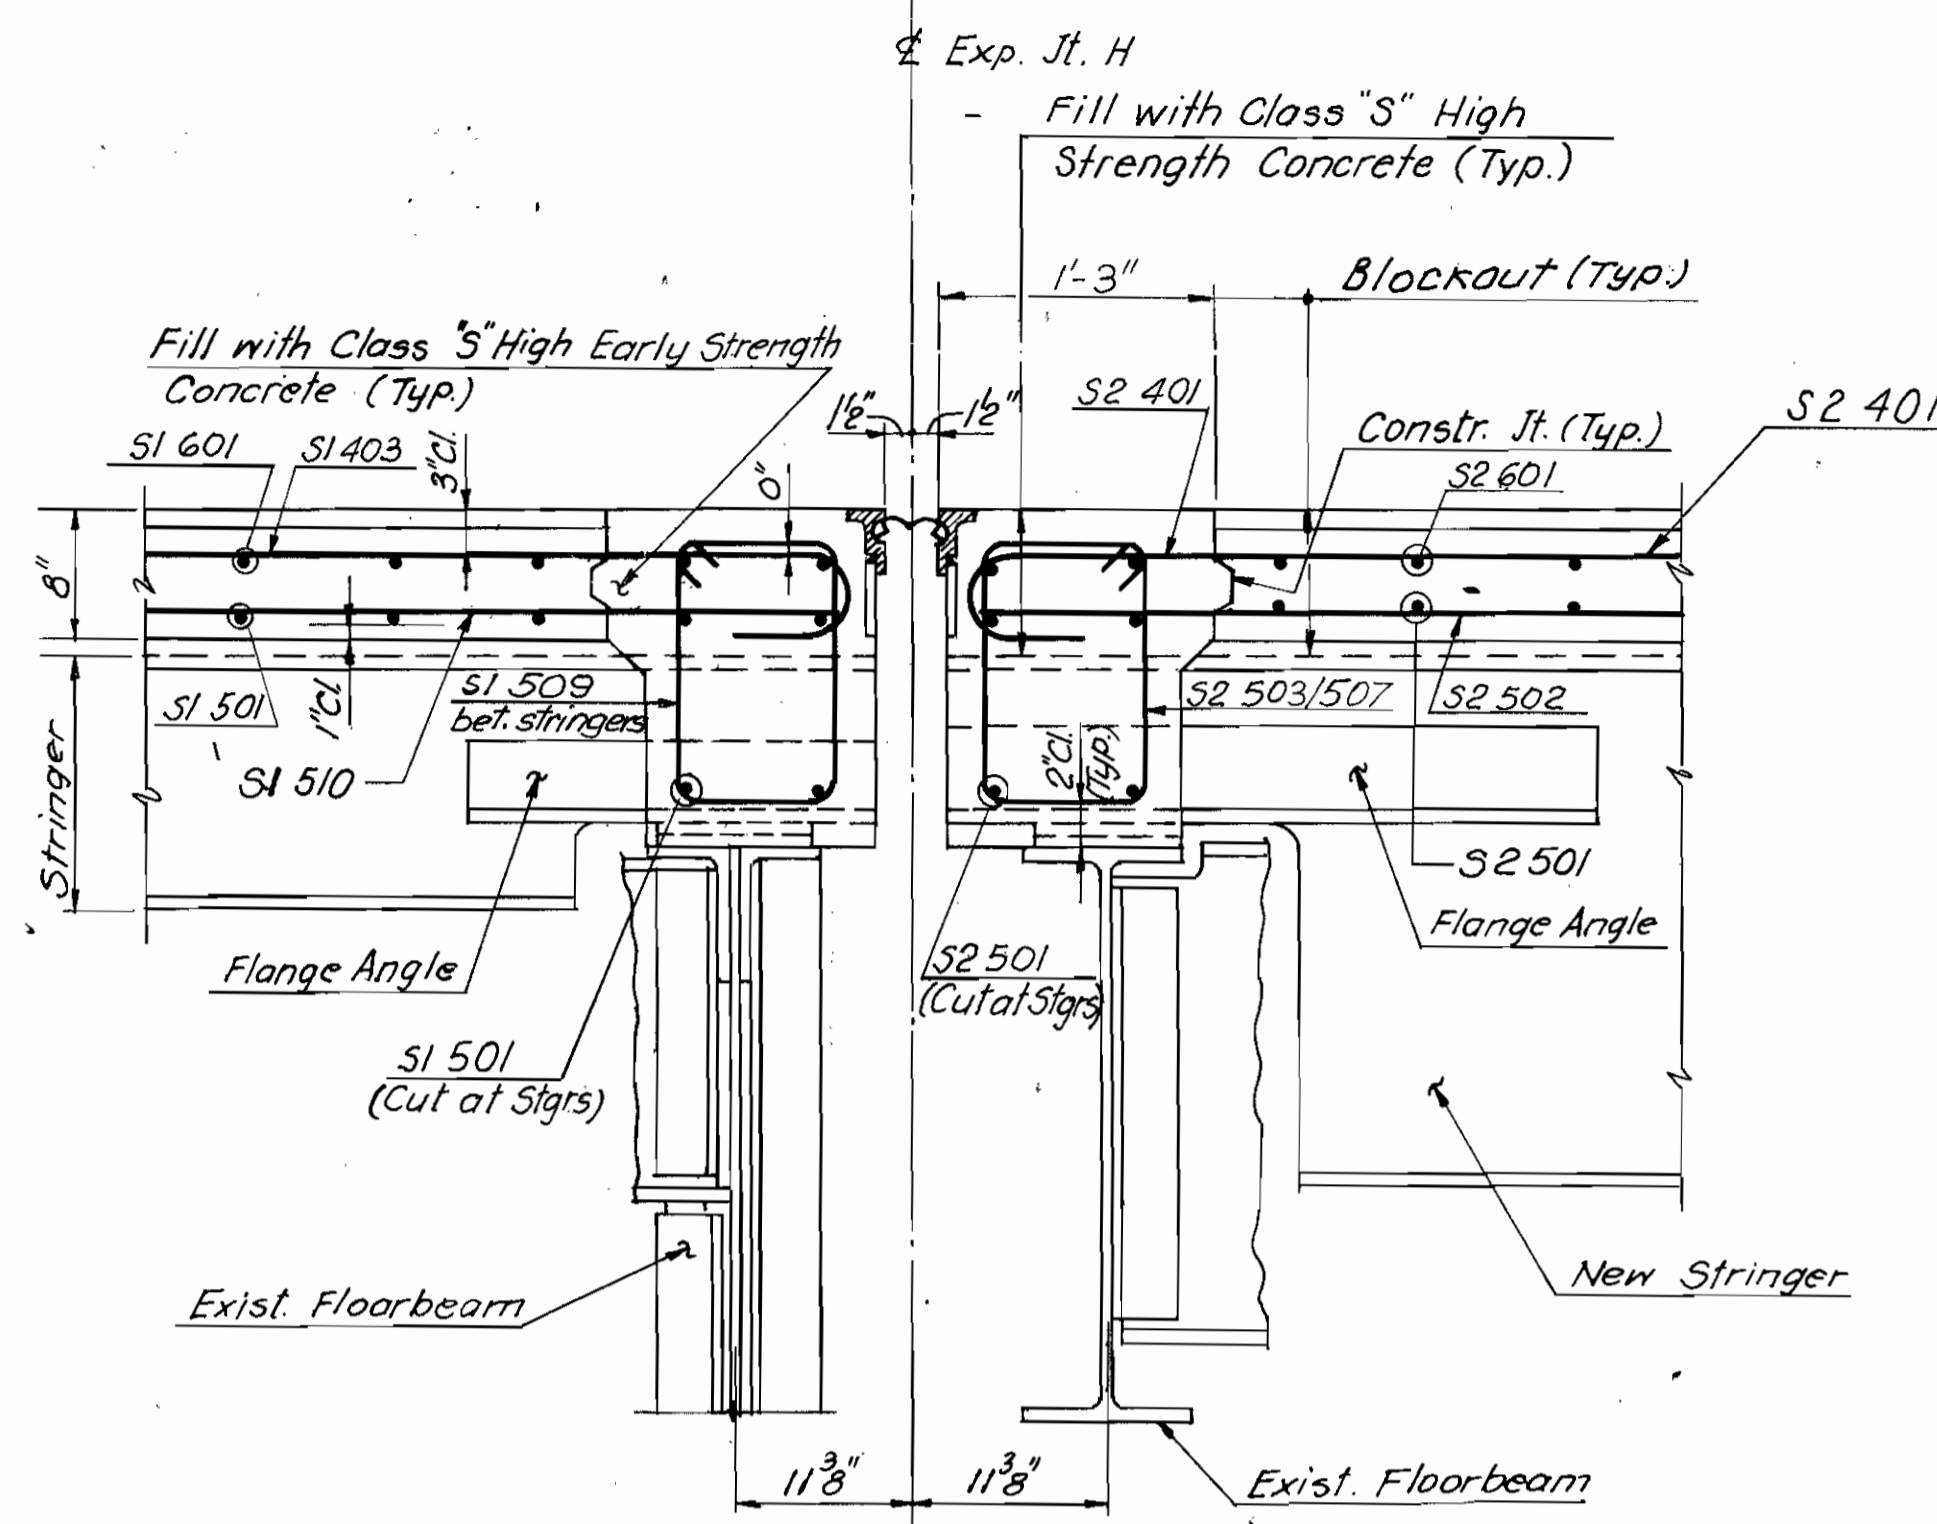


SECTION F2-F2

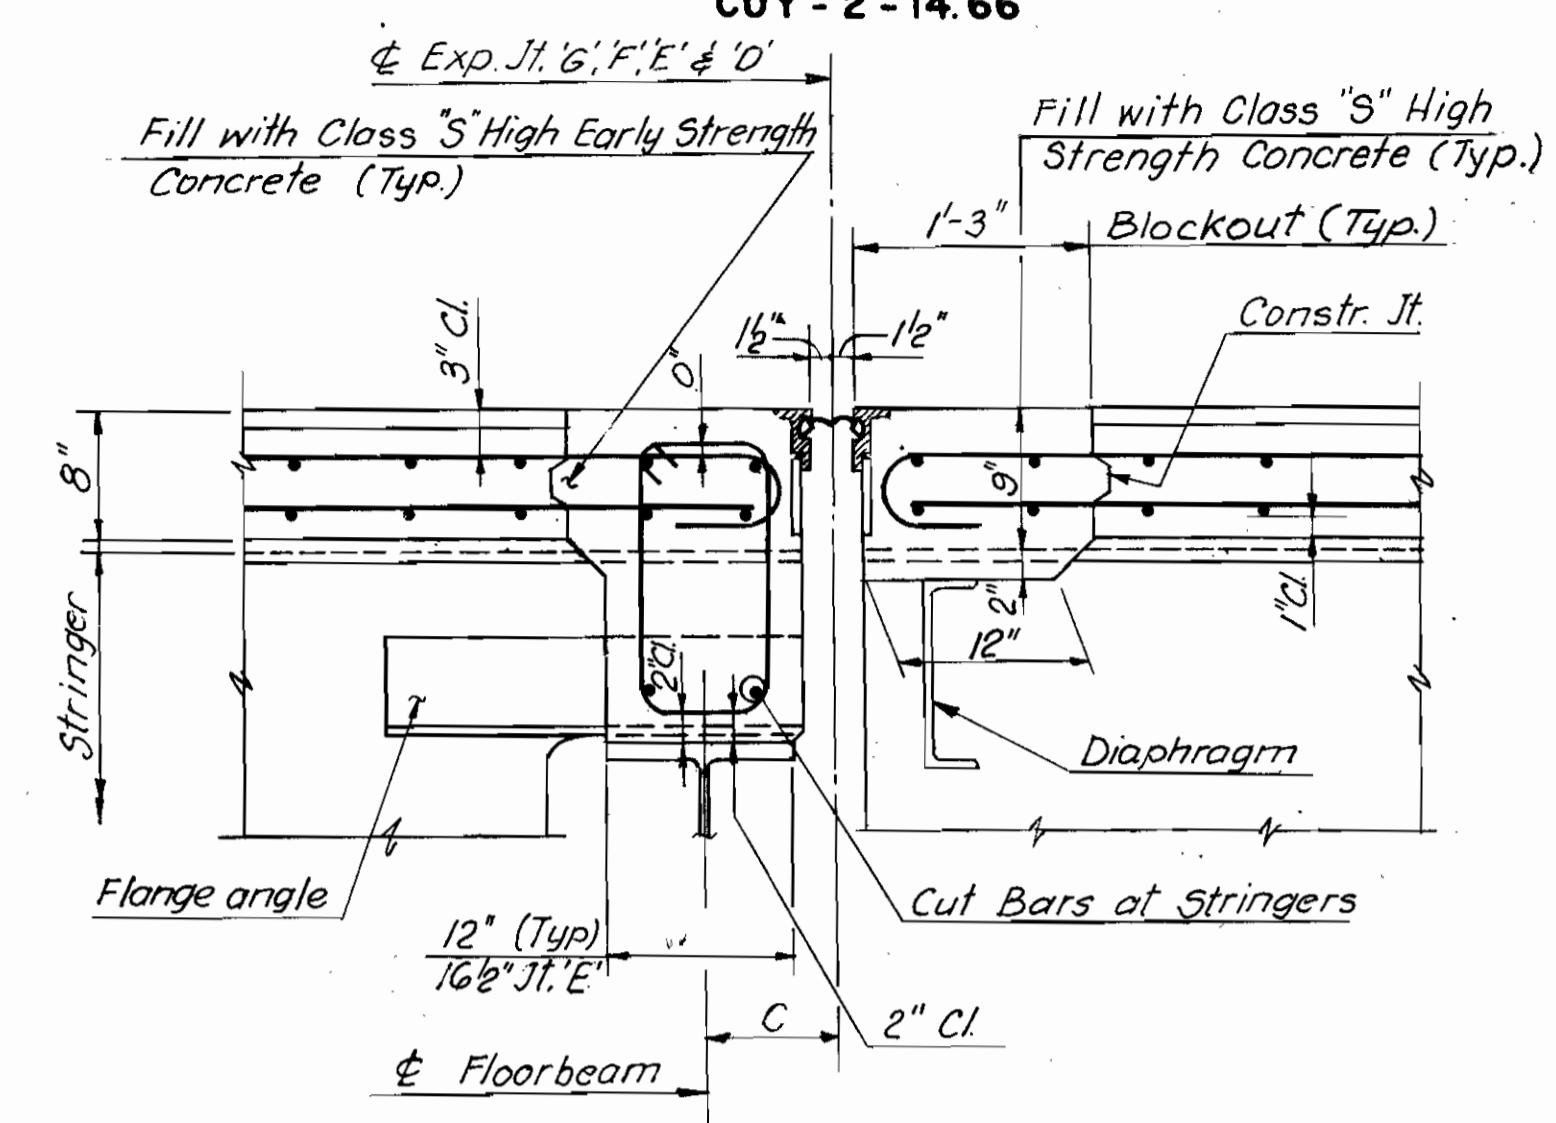


SECTION F3-F3

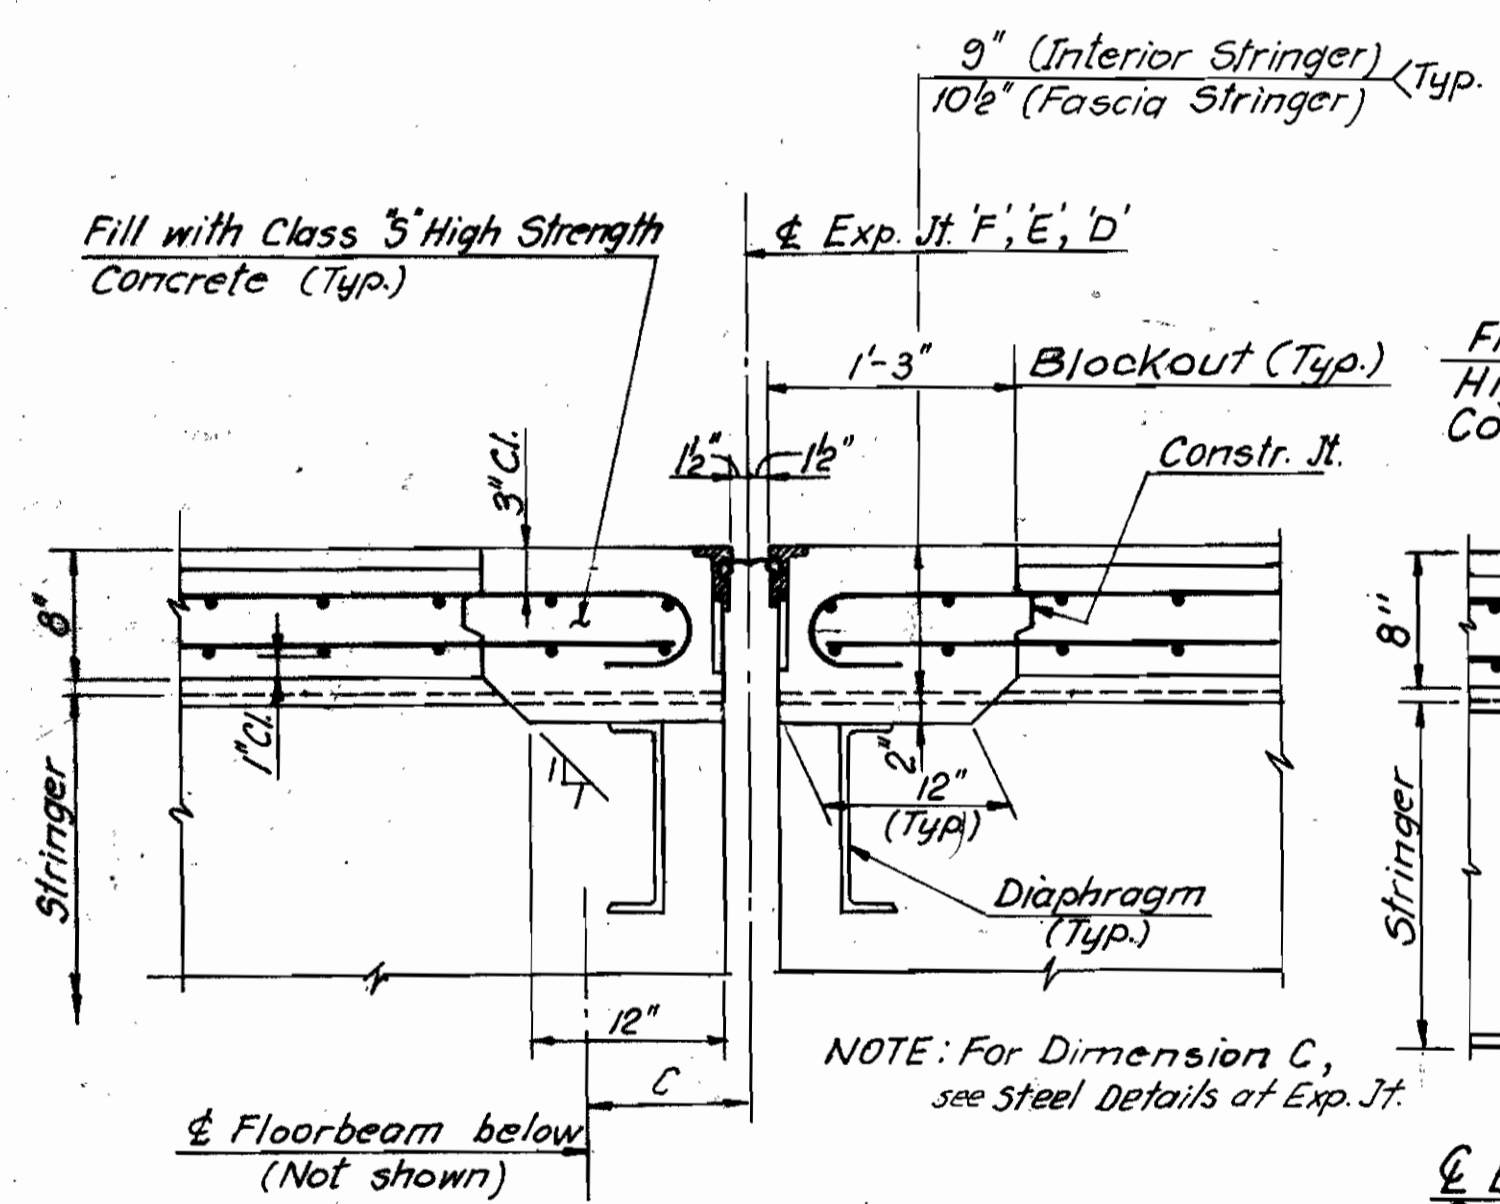

SECTION F4-F4

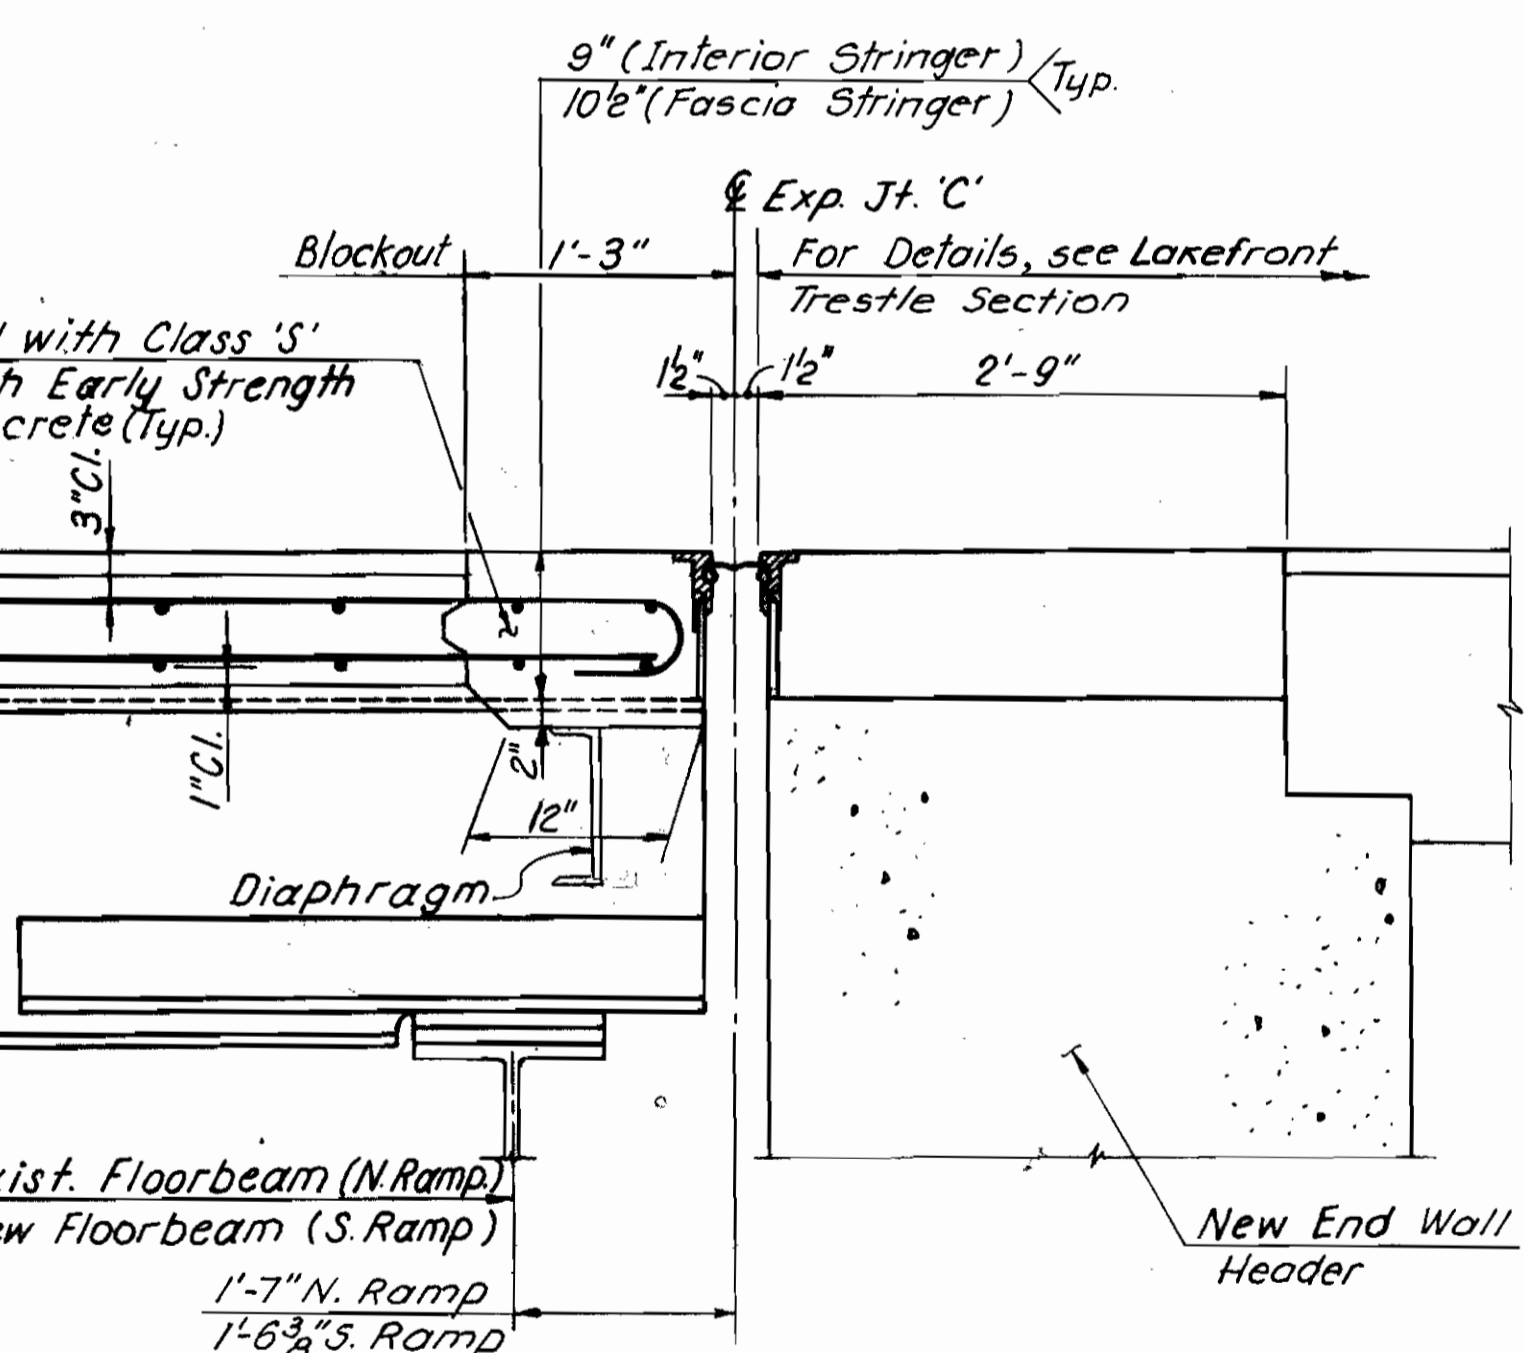

SECTION F5-F5

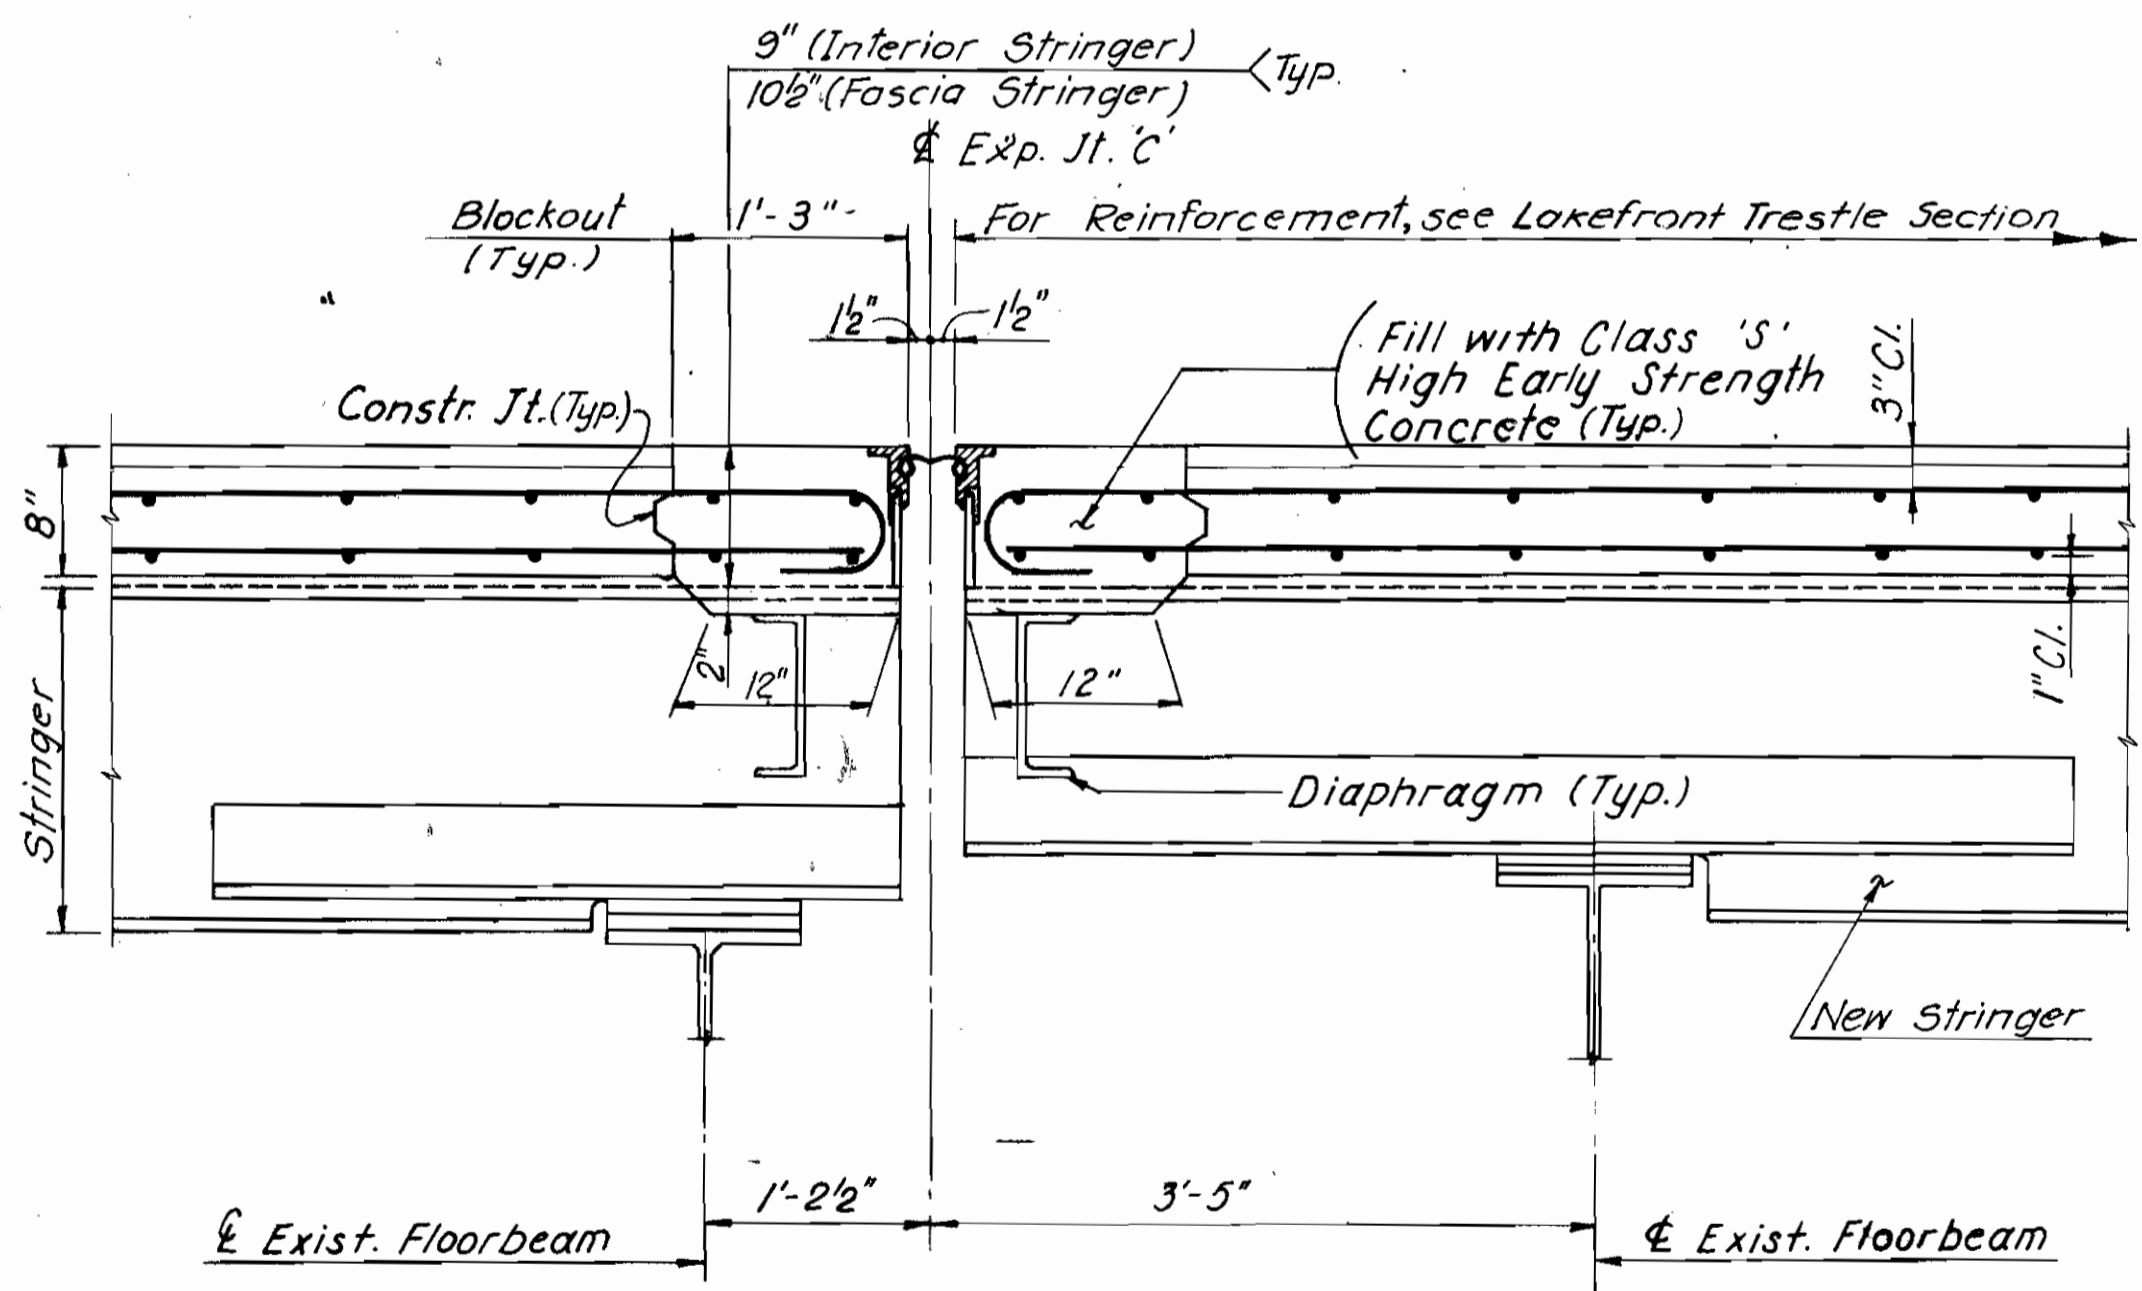

SECTION F6-F6

REFERENCES	DWG. NO.
Slab Plans	340-343
Steel Details at Exp. Jt. C	333
Steel Details at other Exp. Jts	333
Expansion Joint I - Plan & Detail	278 & 279
Expansion Joint H	349
Expansion Joints F & G	348
Expansion Joints D & E	347
Expansion Joint C	346
Location of Section F1-F1	340
Location of Sections F2-F2, F3-F3 & F4-F4	341
Location of Sections F5-F5 & F6-F6	342
Dimension C'	333
Stay-in-place forms	AB 69A

PAVLO ENGINEERING CO., P.C.  
NEW YORK, NEW YORK

**CUYAHOGA COUNTY ENGINEER**  
CLEVELAND OHIO

**MAIN AVENUE BRIDGE**  
CITY OF CLEVELAND  
BRIDGE OVER THE CUYAHOGA RIVER VALLEY

EAST APPROACH - FORWARD SECTION  
DECK SLAB REINFORCEMENT-5

BRIDGE NO. 193    REPORT NO. 7119    DATE Oct. 20, 1969

**NO. B-136**    344/54

DESIGN M.M.	DRAWN J.H.	CHECKED B.P.	REVISED TO AS BUILT AS BUILT 2/94
----------------	---------------	-----------------	--------------------------------------

MICROFILMED  
JUL 27 1994

CUYAHOGA COUNTY  
CUY-2-14.66  
STRUCTURE FILE NUMBER 1800 035

FHWA REGION	STATE	PROJECT
5	OHIO	BHF-73 (51)

351  
547

**EAST APPROACH LAKEFRONT TRESTLE**  
SCOPE OF REHABILITATION WORK

THE SECTION IS A 974 FOOT LONG, FOUR LANE, DIVIDED, STEEL VIADUCT, CONSISTING OF TWENTY TRESTLE SPANS OF CONTINUOUS LONGITUDINAL STEEL GIRDER FRAMES, CARRYING FLOOR BEAMS AND STRINGERS, AND TWO RAMPS ON FILL.

THE WORK INCLUDES:

1. REMOVAL OF EXISTING I-BEAM-LOK DECK, SIDEWALKS, RAILINGS, FASCIA PLATES, STRINGERS, ETC.
2. REINFORCEMENT OF RIGID FRAMES AND BRACKETS.
3. INSTALLATION OF NEW STEEL STRINGERS AND FASCIA BEAMS.
4. CONSTRUCTION OF NEW LIGHTWEIGHT CONCRETE DECK SLABS, BARRIERS, LUMINAIRE SUPPORTS, DRAINAGE DEVICES AND ARMORED JOINTS.
5. MODIFICATION OF ABUTMENTS AND REPLACEMENT OF PAVEMENT AT SOUTH AND NORTH RAMPS.
6. REPAIR OF DAMAGED CONCRETE WALLS AND COLUMN PEDESTALS.
7. INSTALLATION OF NEW LIGHTING AND TRAFFIC CONTROL SYSTEMS.
8. FIELD COATING OF SOME EXISTING STRUCTURAL STEEL, AND PAINTING OF NEW STRUCTURAL STEEL.
9. COATING OF THE EXPOSED EXISTING AND NEW CONCRETE SURFACES.


The Contractor shall make provisions to protect all areas under the Bridge used by Pedestrians or vehicles, from falling debris during removal of the existing superstructure and during erection.

**C.V.N. NOTE**

Structural steel for new or repaired Main Load Carrying members subjected to tension or stress reversal, shall meet the "Longitudinal Charpy V-notch" requirements of 15 Ft.-Lb. @ 40°F.  
Main load carrying members for this section are limited to: Stringers, Floor Beam Flanges & Web, Bracket Top Flange and Web & Tie Plates, Reinforcing Plates for frames and Link Plates.  
See also "GENERAL NOTES" Item 513.

**NOTES:**

For lighting, drainage and sign support structures, see roadway and deck plans.

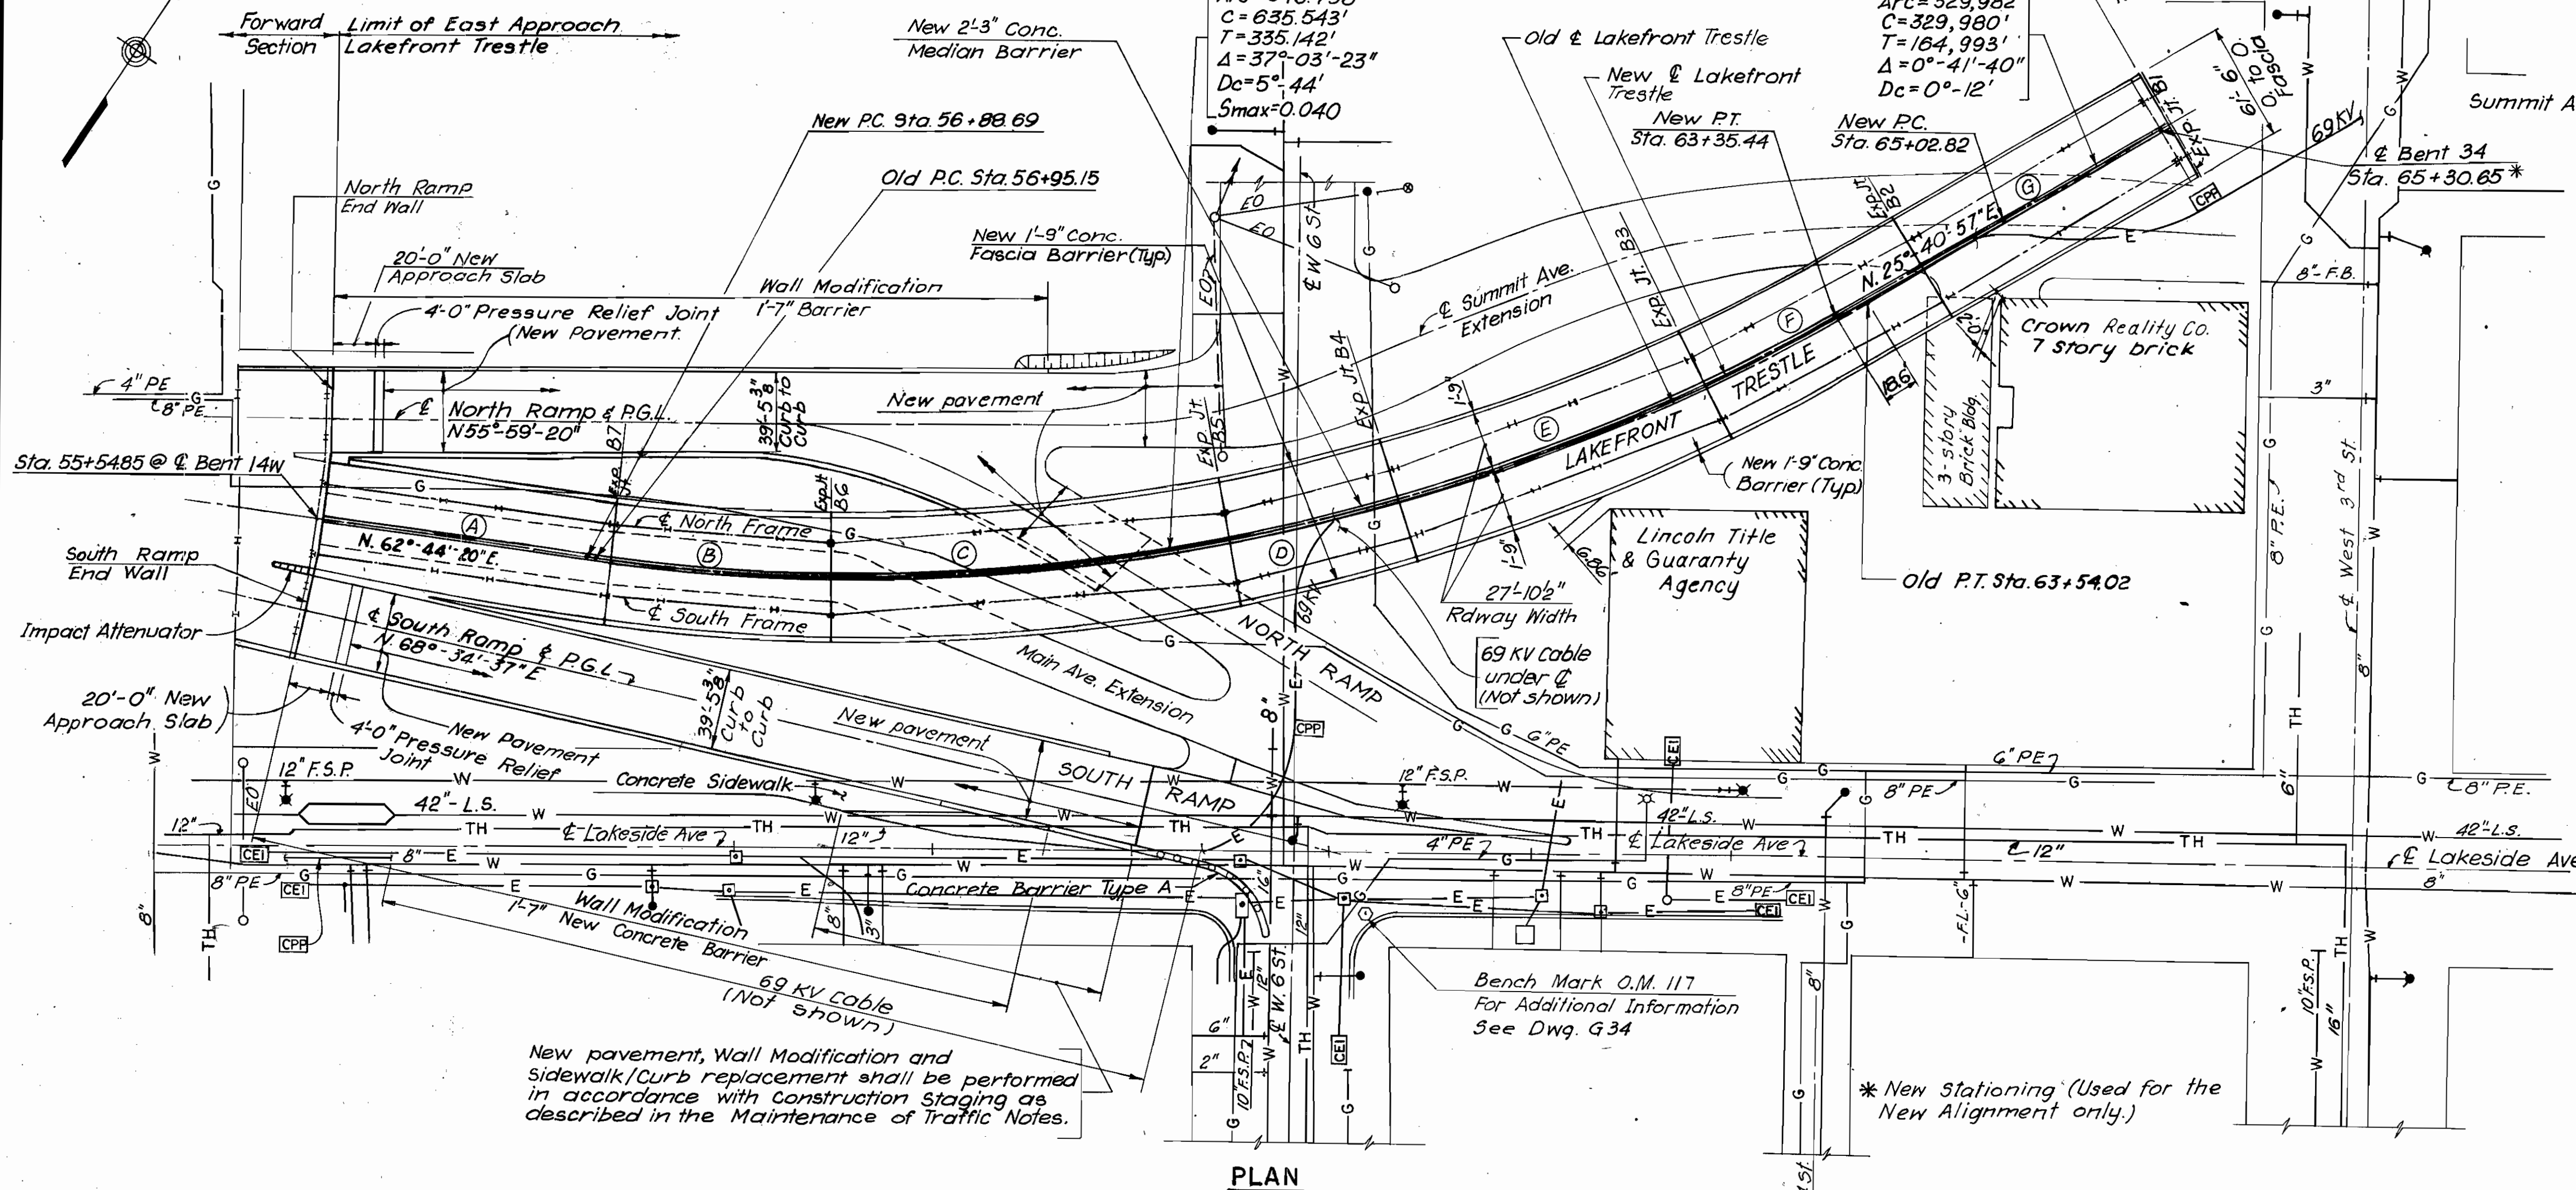


New pavement, Wall Modification and Sidewalk/Curb replacement shall be performed in accordance with Construction Staging as described in the Maintenance of Traffic Notes.

Bench Mark O.M. 117  
For Additional Information  
See Dwg. G34

\* New Stationing (Used for the New Alignment only.)

**PLAN**

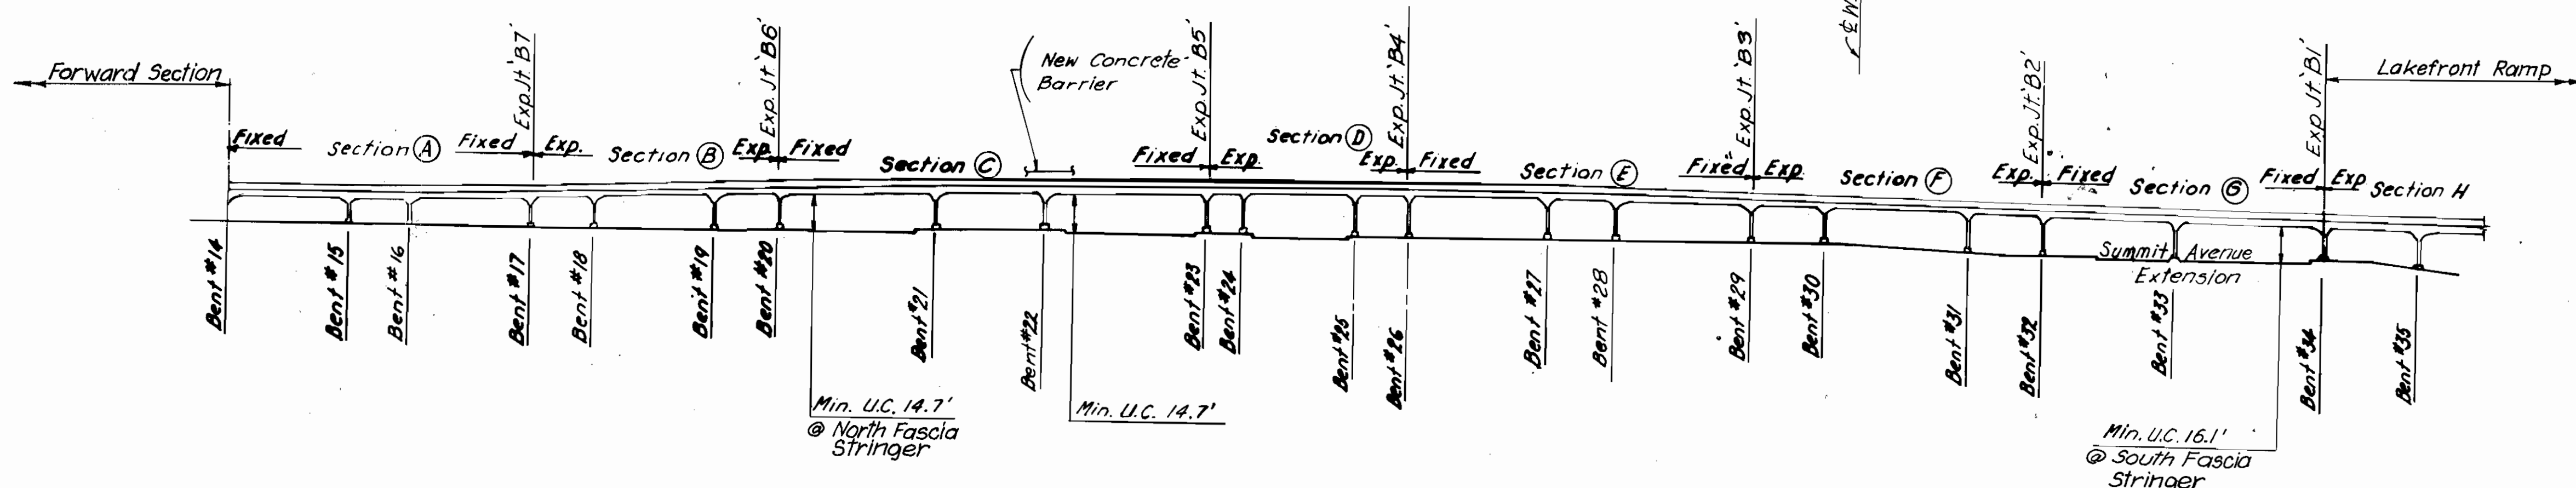

**SOUTH ELEVATION (DEVELOPED)**

**LEGEND**

Overhead Electric Lines	—CEI—	EO—EO—
C.E.I. Utility Poles	○	
Cleveland Thermal Energy Co. (Steam Line)	—TH—	TH—TH—
East Ohio Gas	—G—	G—G—
Ohio Bell Tel. Co.	—T—	T—T—
Cleveland Public Power Co.	—E—	E—E—
Water	—W—	W—W—
Sewers	—S—	S—S—
Manhole	●	
Cleveland Electric Illuminating Co.	—E—	E—E—

**REFERENCE**

Typical Cross Sections	403
Profiles & Superelevation	405 & 406
Alignment Details	634 & 639
Maintenance of Traffic Notes	627
Lakeside Ave at 6th Str.	614
Final Alignment	345
IMPACT ATTENUATOR	

**DWG. NO.**

403
405 & 406
634 & 639
627
614
345




PAVLO ENGINEERING CO., P.C. NEW YORK, NEW YORK			
CUYAHOGA COUNTY ENGINEER CLEVELAND OHIO			
<b>MAIN AVENUE BRIDGE</b>			
CITY OF CLEVELAND			
BRIDGE OVER THE CUYAHOGA RIVER VALLEY			
EAST APPROACH—LAKEFRONT TRESTLE			
<b>PROPOSED PLAN &amp; ELEVATION</b>			
BRIDGE NO. 193	REPORT NO. 7119	DATE OCT. 28, 1993	
<b>NO. B-136</b>			402 71
DESIGN S.H.	DRAWN C.P.J.	CHECKED C.K.D./D.G.	REVISED TO AS BUILT AS BUILT 2/94




\* For Floorbeams A6, C1, C9, E1, E6, G1 12" Width existing cover R. shall be reused.  
See Bracket Reinforcement Dwgs. 434 and 435 for details at new bracket connection plate

FHWA REGION	STATE	PROJECT	376
5	OHIO	BHF-73 (51)	547

CUYAHOGA COUNTY  
CUY - 2-14.66

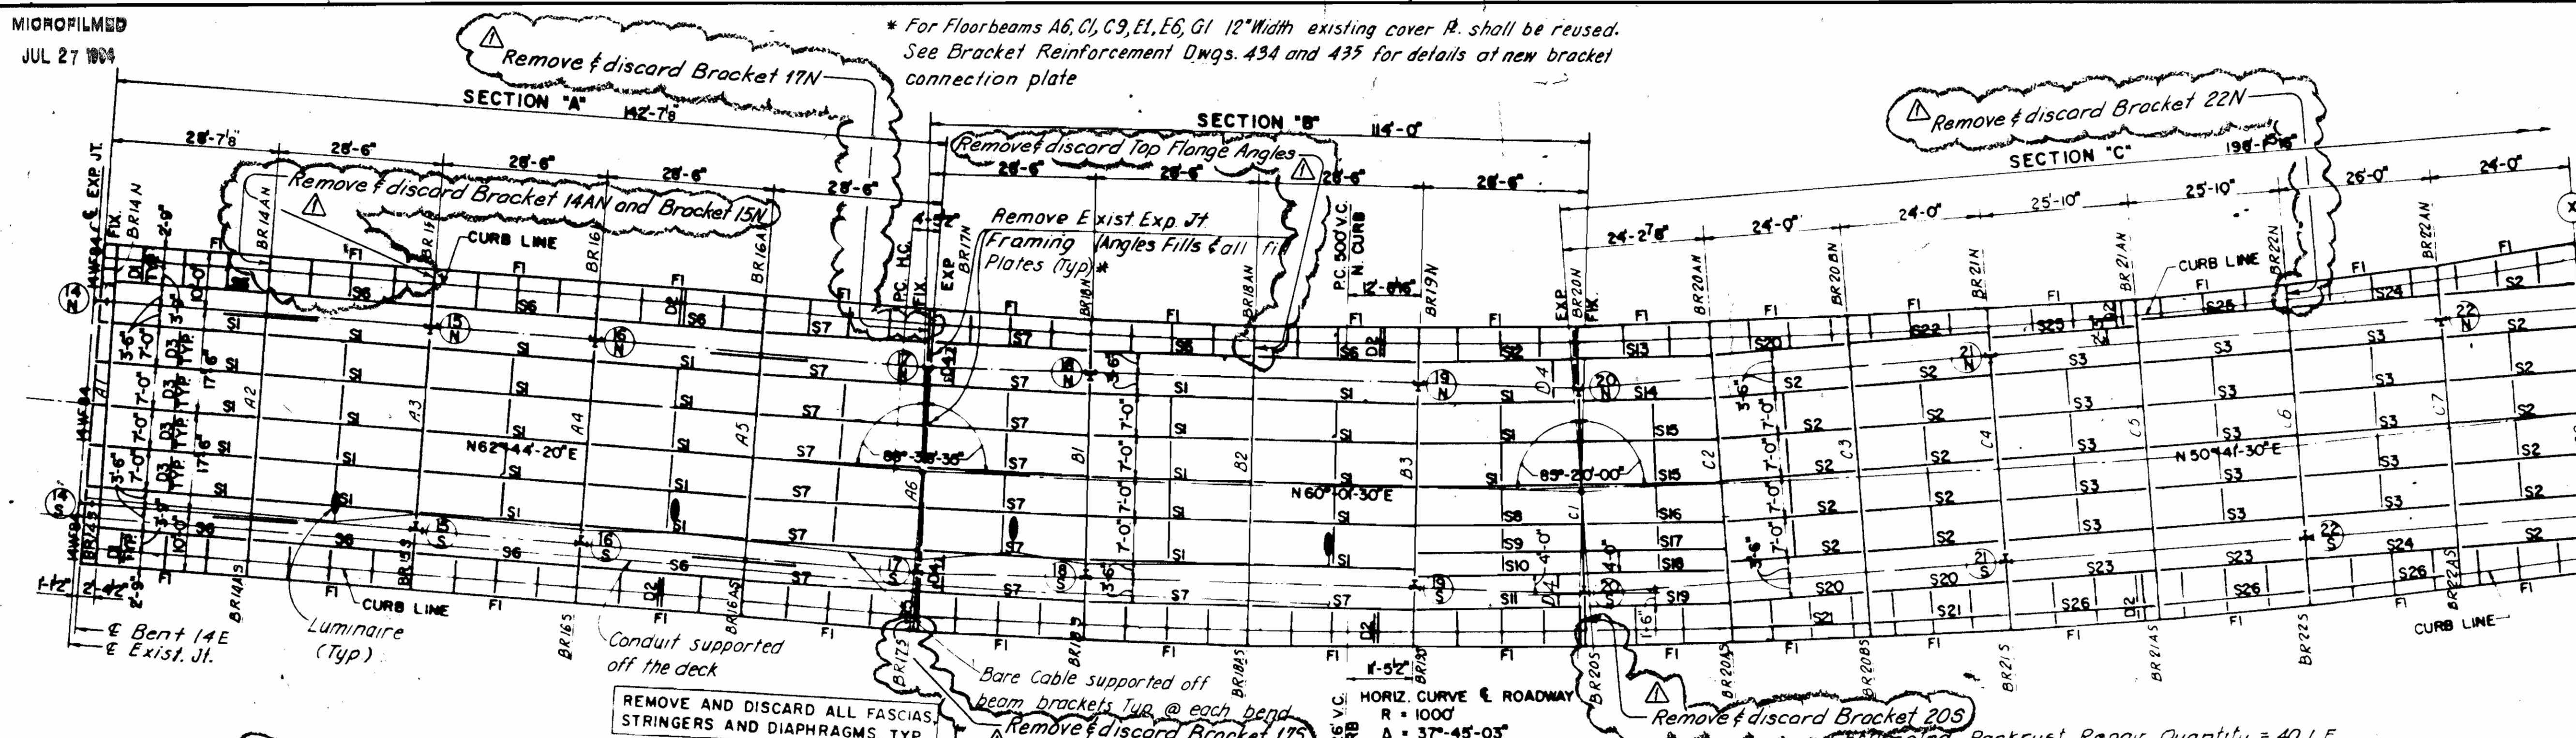

- Notes:
1. All new stringers shall be installed vertical
  2. For finishing machine support notes, see Dwg. G-7
  3. Welding of attachments shall not be permitted in the tension zone of the stringers.
  4. Tension zone is 5'-0" each side of interior supports.

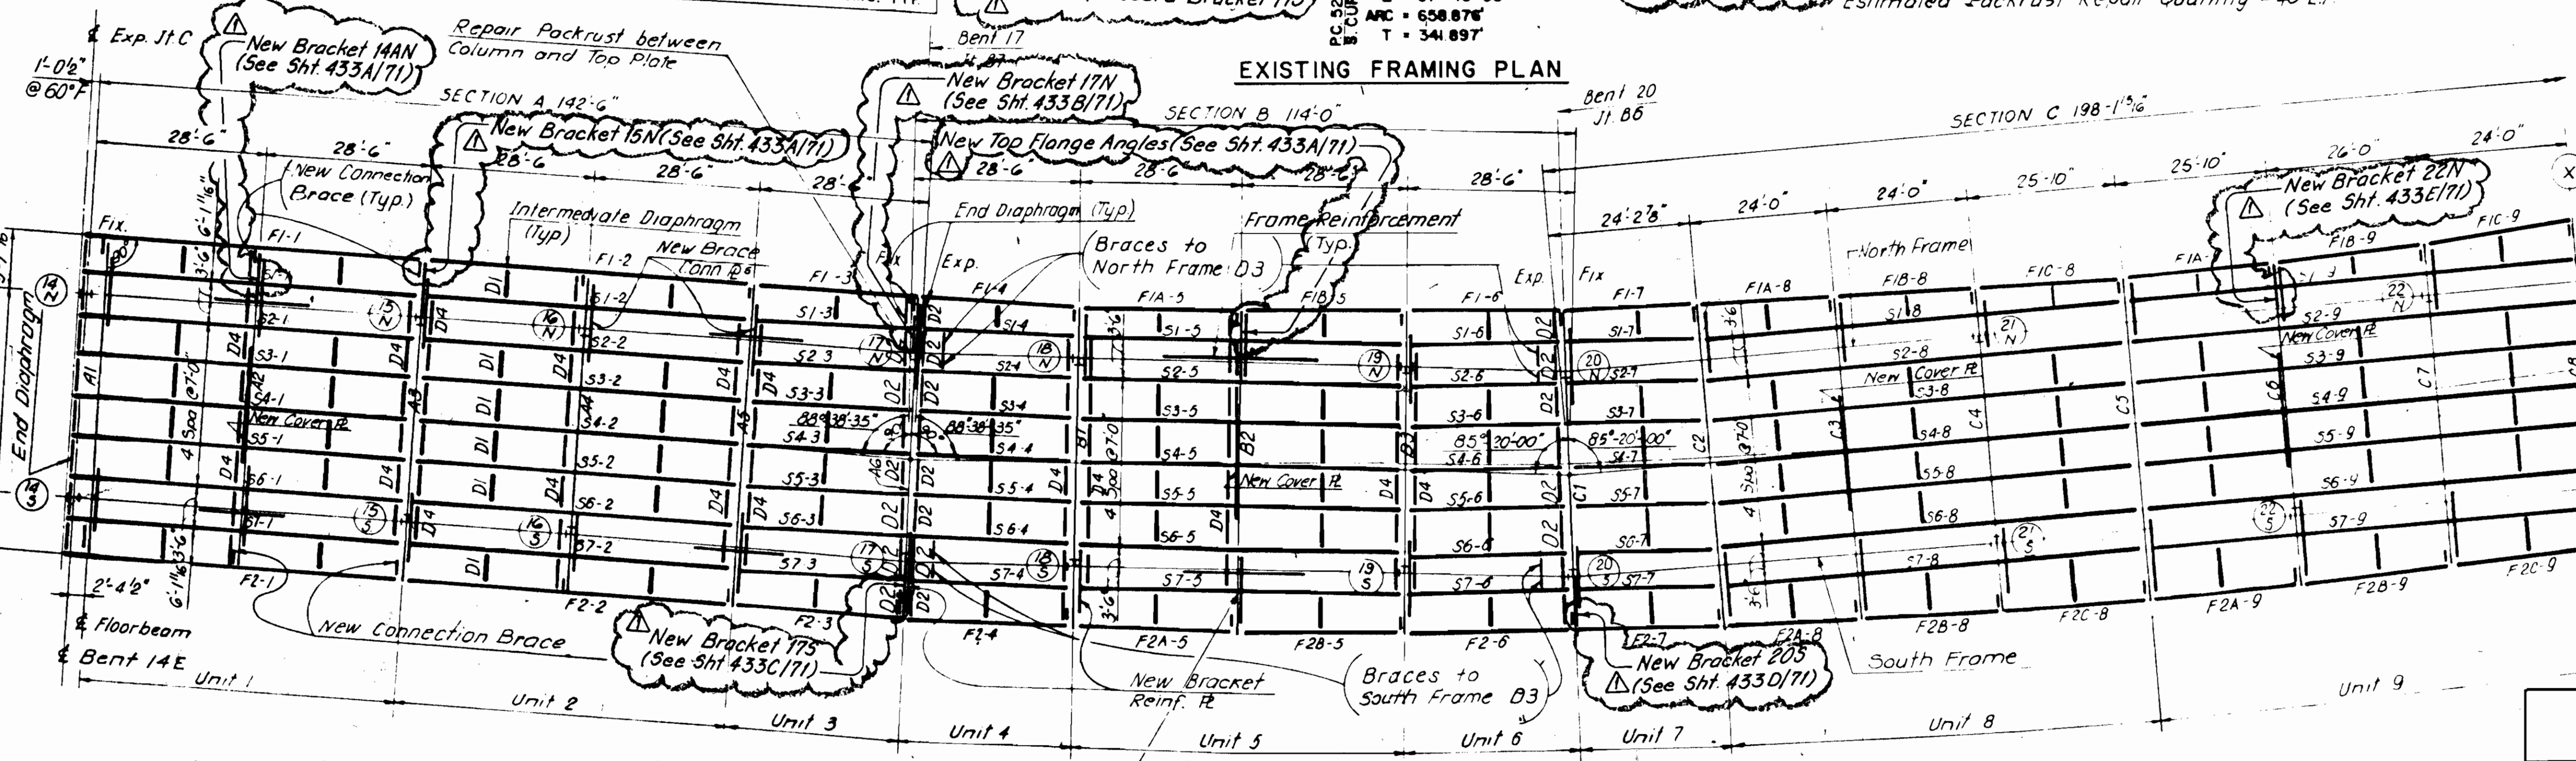

**DAMAGE TO CONCRETE OF COLUMNS**

Column	Damage
145	North face heavily spalled; exposed bars.
15N	Spalls + exposed rebars on East face
22S	Spalls on East face

Summary of concrete deterioration for dwg's 427 & 428  
100 SF require Type M-1 repairs (See "Concrete repair details")

- NOTES:
- All intermediate Diaphragms shall be located halfway between floorbeams
  - See C.V.N. Note on Dwg. 402

Rev. 1 Plan Revisions 3/15/91

PAVLO ENGINEERING CO., P.C.  
NEW YORK, NEW YORK

CUYAHOGA COUNTY ENGINEER  
CLEVELAND OHIO

MAIN AVENUE BRIDGE  
CITY OF CLEVELAND

BRIDGE OVER THE CUYAHOGA RIVER VALLEY

E. APPR.-LAKEFRONT TRESTLE, BENT 14-22  
EXIST. & PROP. FRAMING PLAN

BRIDGE NO. 193 REPORT NO. 7119 DATE: OCT. 28, 1989

NO. B-136 427/71

DESIGN	DRAWN	CHECKED	REVISED TO AS BUILT
B.G.	J.H.	W.T.	AS BUILT 2/94

- NOTES:**
- All existing dimensions, elevations and details were obtained from original contract plans and shop drawings and shall be verified in the field by the contractor.
  - All dimensions shown on proposed plans are measured horizontally.
  - All connection plates for intermediate diaphragms shall be placed perpendicular to flanges.
  - All bearing stiffeners shall be vertical under full Dead load.
  - All new Rolled Beams, Shapes and Plates shall be ASTM A36, AISC Category I
  - All new Welded Members including Fascia Stringers, Replacement Floor Beams and Brackets shall be ASTM A36, AISC Category III

**PROPOSED FRAMING PLAN**

LEGEND

- Existing member to remain
- New member or Reinf. R
- Reinforcement of Existing Bracket

Bent floor beams may be straightened by heat if required. See General Notes

Place all new Stringers at existing Stringer Locations except for Stringers S4-11 and S1-8

**REFERENCES:**

DWG. NO.	DESCRIPTION
403	Typical Cross Section
434	Bracket and Floor Beam Reinforcement Details
429, 430, 431	Frame Girder Reinforcement Details
444	Fascia Beam Setting Dimensions
445, 446	Miscellaneous Details
074	Concrete Repair Details
403	Connection Braces and Diaphragm Details
438 to 443	Stringer Schedules
447, 448	Detail at Expansion Joints
160	Deck/Framing Offset Table







MICROFILMED  
JUL 27 1994

\* For Floorbeams AG, CI, C9, EI, E6, G1 12" width existing cover R shall be reused.  
See Bracket Reinforcement Dwg. 434 and 435 for details at new bracket connection plate.


FHWA REGION	STATE	PROJECT	377
5	OHIO	BHF-73 (51)	547

CUYAHOGA COUNTY  
CUY-2-14.66

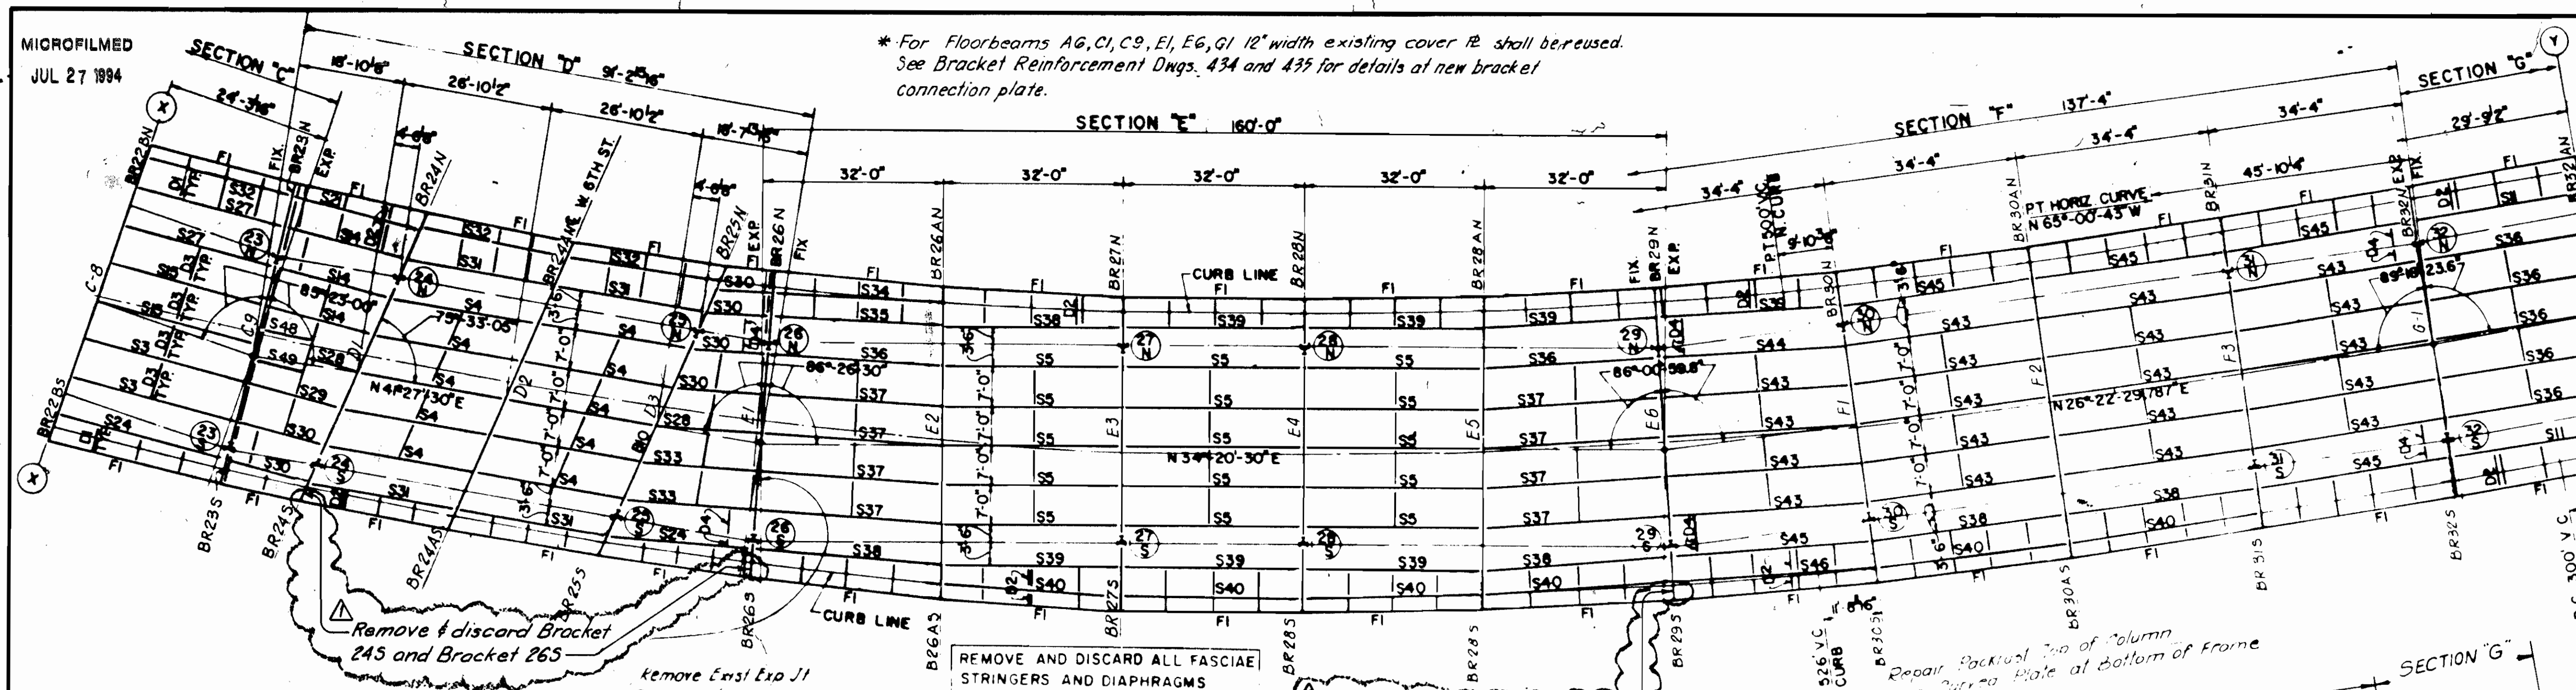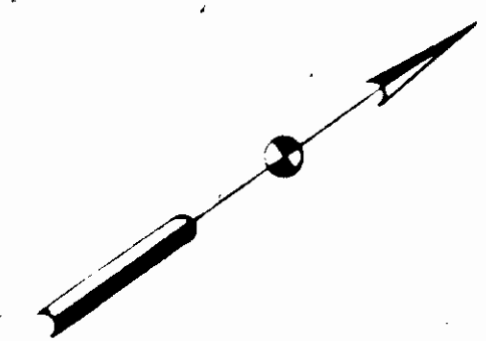

EXISTING STRINGERS

STRINGERS	SECTION
S1, S4, S7, S11, S39	27N91
S2, S15, S19, S24, S31, S35, S46	24N80
S3, S6, S8, S12, S23	24N87
S5, S37, S44, S45	27N106
S9, S10, S13, S14, S16, S20, S22, S25, S27, S40	24N74
S17, S26, S29, S34, S42	21N63
S18, S28, S41	21N68
S21, S30, S32	21N59
S36, S38	27N98
S43	27N114
S47	24N94
S48, S49	14W34
FI	

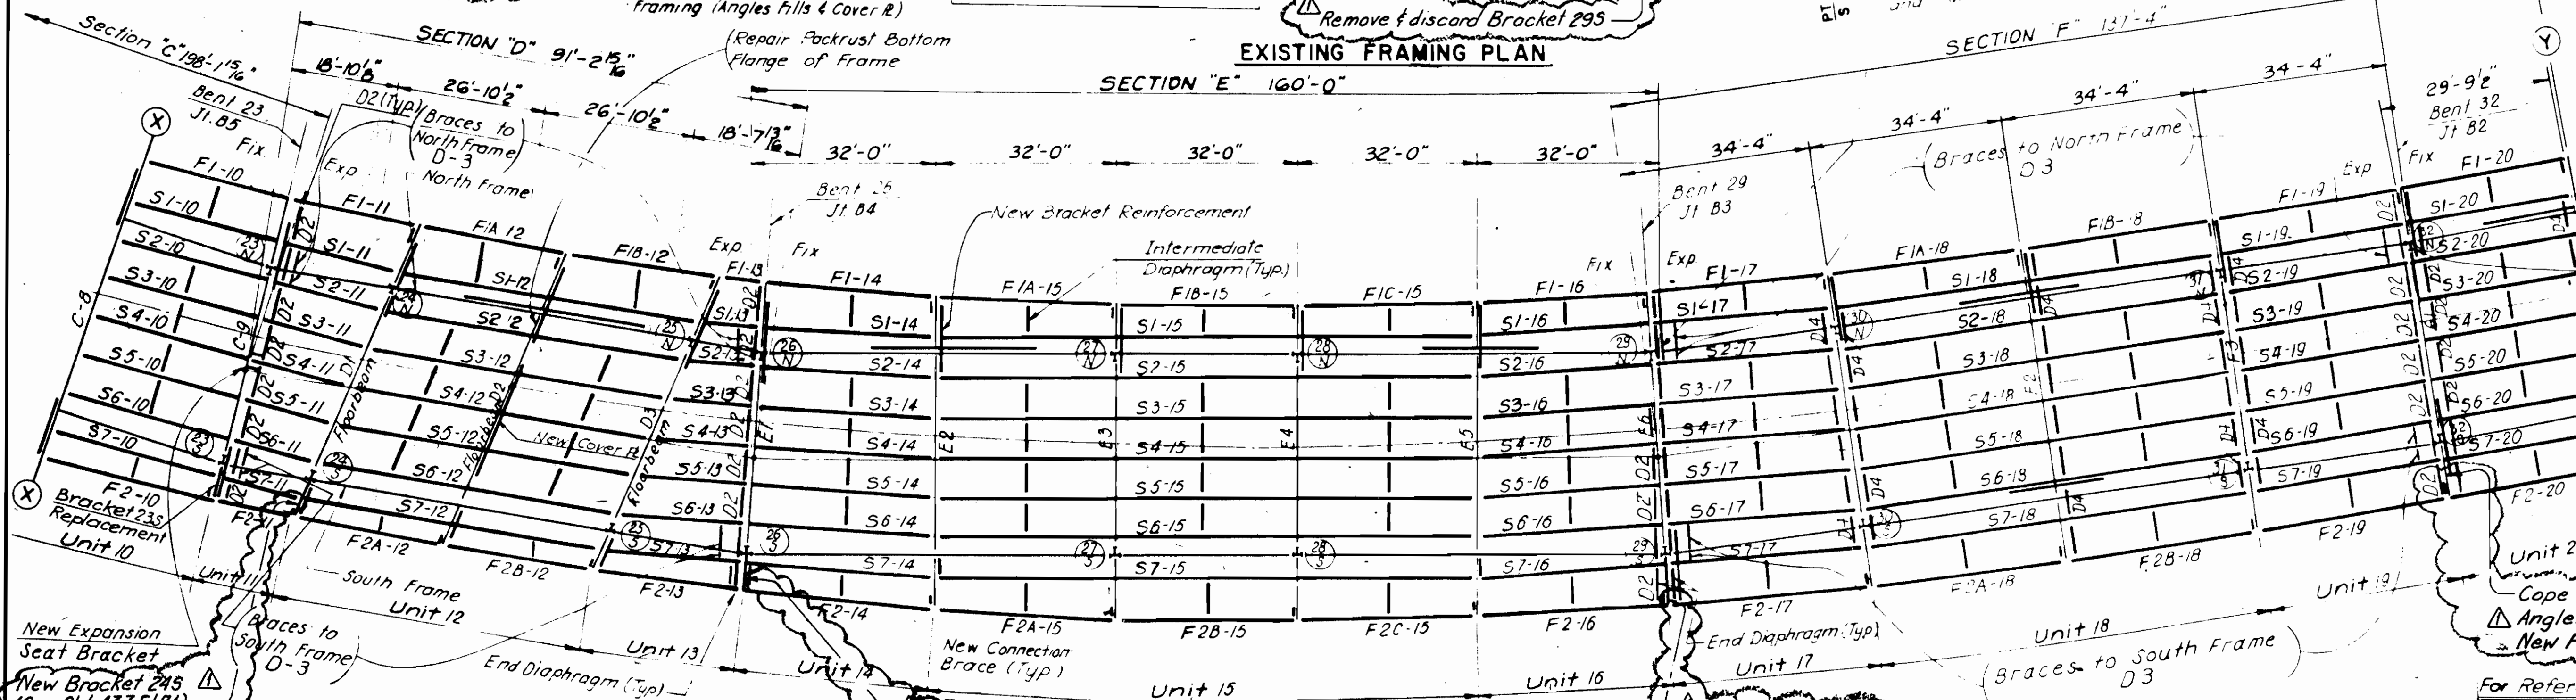

DAMAGE TO CONCRETE PEDESTALS

Column Deterioration  
23N 1/6 S.F. Spall  
29N Spalls & exposed rebars on East & South faces.  
32N 8 S.F. Spall  
34N 18 S.F. Spall  
34S Large spalls on North-East faces, 15 S.F. delamination.  
See Summary on Dwg. 427

Unit 20 - See C.V.N. Note on Dwg. 402  
Cope Existing Bracket Web and Bottom Flange  
Angles as required to clear Bottom Flange of New Fascia Girder (As approved by Engineer).

For References see Dwg. 427.

Rev. 1	Plan Revisions	3/15/91
--------	----------------	---------

PAVLO ENGINEERING CO., P.C.  
NEW YORK, NEW YORK

CUYAHOGA COUNTY ENGINEER  
CLEVELAND OHIO

**MAIN AVENUE BRIDGE**  
CITY OF CLEVELAND  
BRIDGE OVER THE CUYAHOGA RIVER VALLEY  
E. APPR.-LAKEFRONT TRESTLE, BENT 23-34  
**EXIST. & PROP. FRAMING PLAN**

BRIDGE NO. 193 REPORT NO. 7119 DATE, OCT. 28, 1989

**NO. B-136** 428


DESIGN	DRAWN	CHECKED	REVISED TO AS BUILT
B. 6	J.H.	W.T.	AS BUILT 2/94

**NOTES:**  
All new Rolled Beams, Shapes and Plates shall be ASTM A36, AISC, Category I  
All new Welded Members including Fascia Stringers, Replacement Floor Beams and Brackets shall be ASTM A36, AISC Category III  
Cope Existing Bracket Web and Bottom Flange Angles as required to clear Bottom Flange of New Fascia Girder (As approved by Engineer)


Bent floor beams may be straightened by heat if required. See General Notes.

Estimated Packrust Repair Quantity = 80 LF

FHWA REGION	STATE	PROJECT
5	OHIO	BHF - 73 (51)

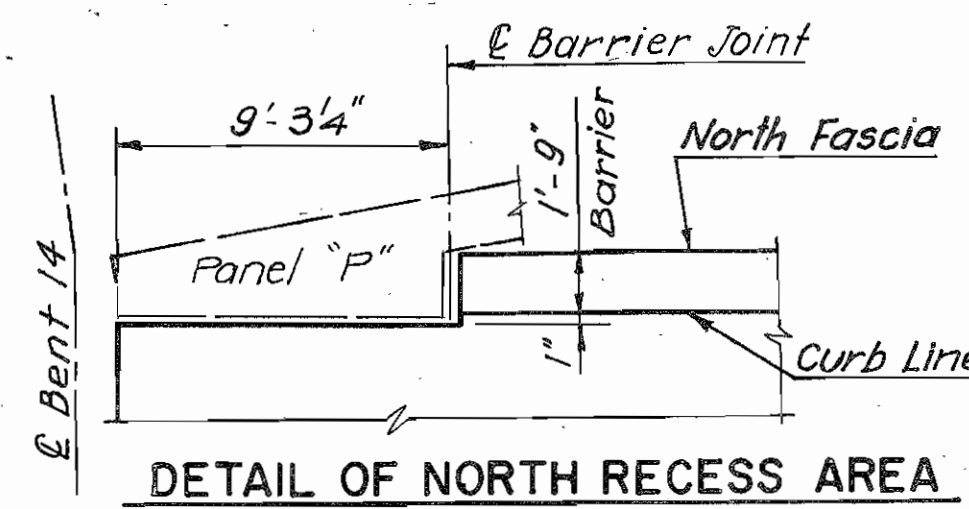


DETAIL OF NORTH RECESS AREA

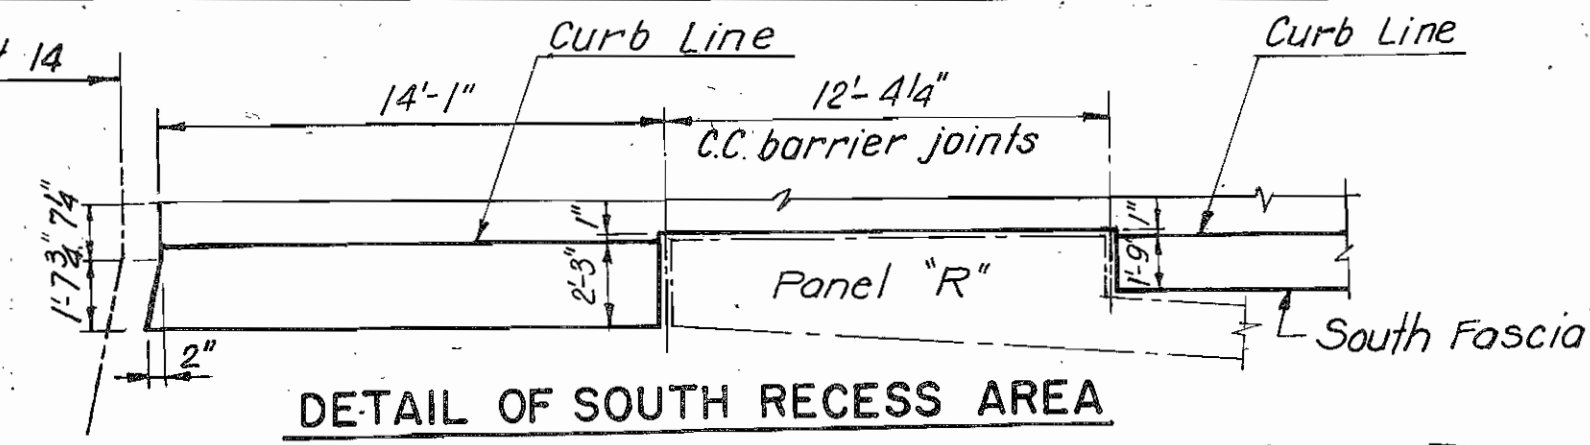

DETAIL OF SOUTH RECESS AREA

**NOTES:**  
- All Deck Concrete shall be "Lightweight Class S"  
- Embedded lighting conduits (size and layout), Junction Boxes, grounding, etc. are detailed in the "Proposed Bridge Lighting" dwgs.

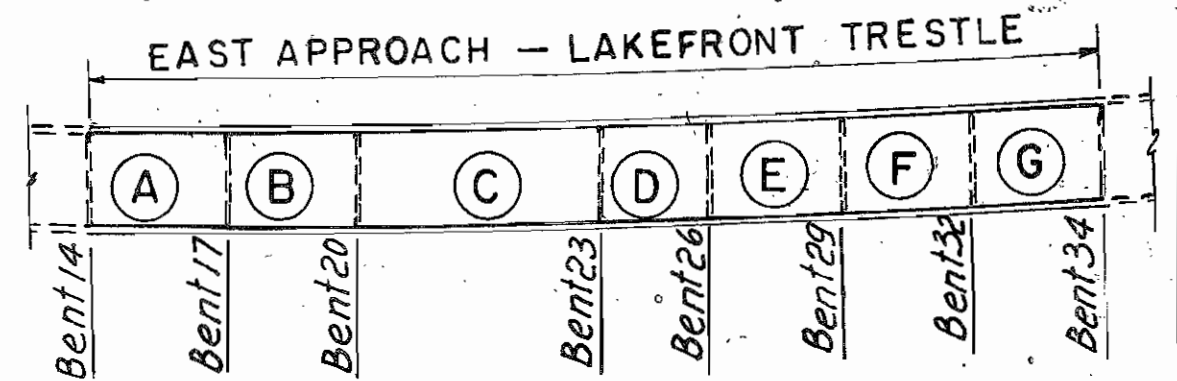


KEY PLAN  
N.T.S.


MINIMUM  
SPLICE LENGTH

Bar	Lap Length
# 4	1' - 10"
# 5	2' - 3"
# 6	2' - 8"


**Notes**  
• Expansion Joints are parallel to Bents.  
• All reinforcing bars for Lakefront Trestle deck slab and barriers shall be prefixed LT.  
• The Contractor shall bend or field cut reinforcing steel at scuppers - as required.

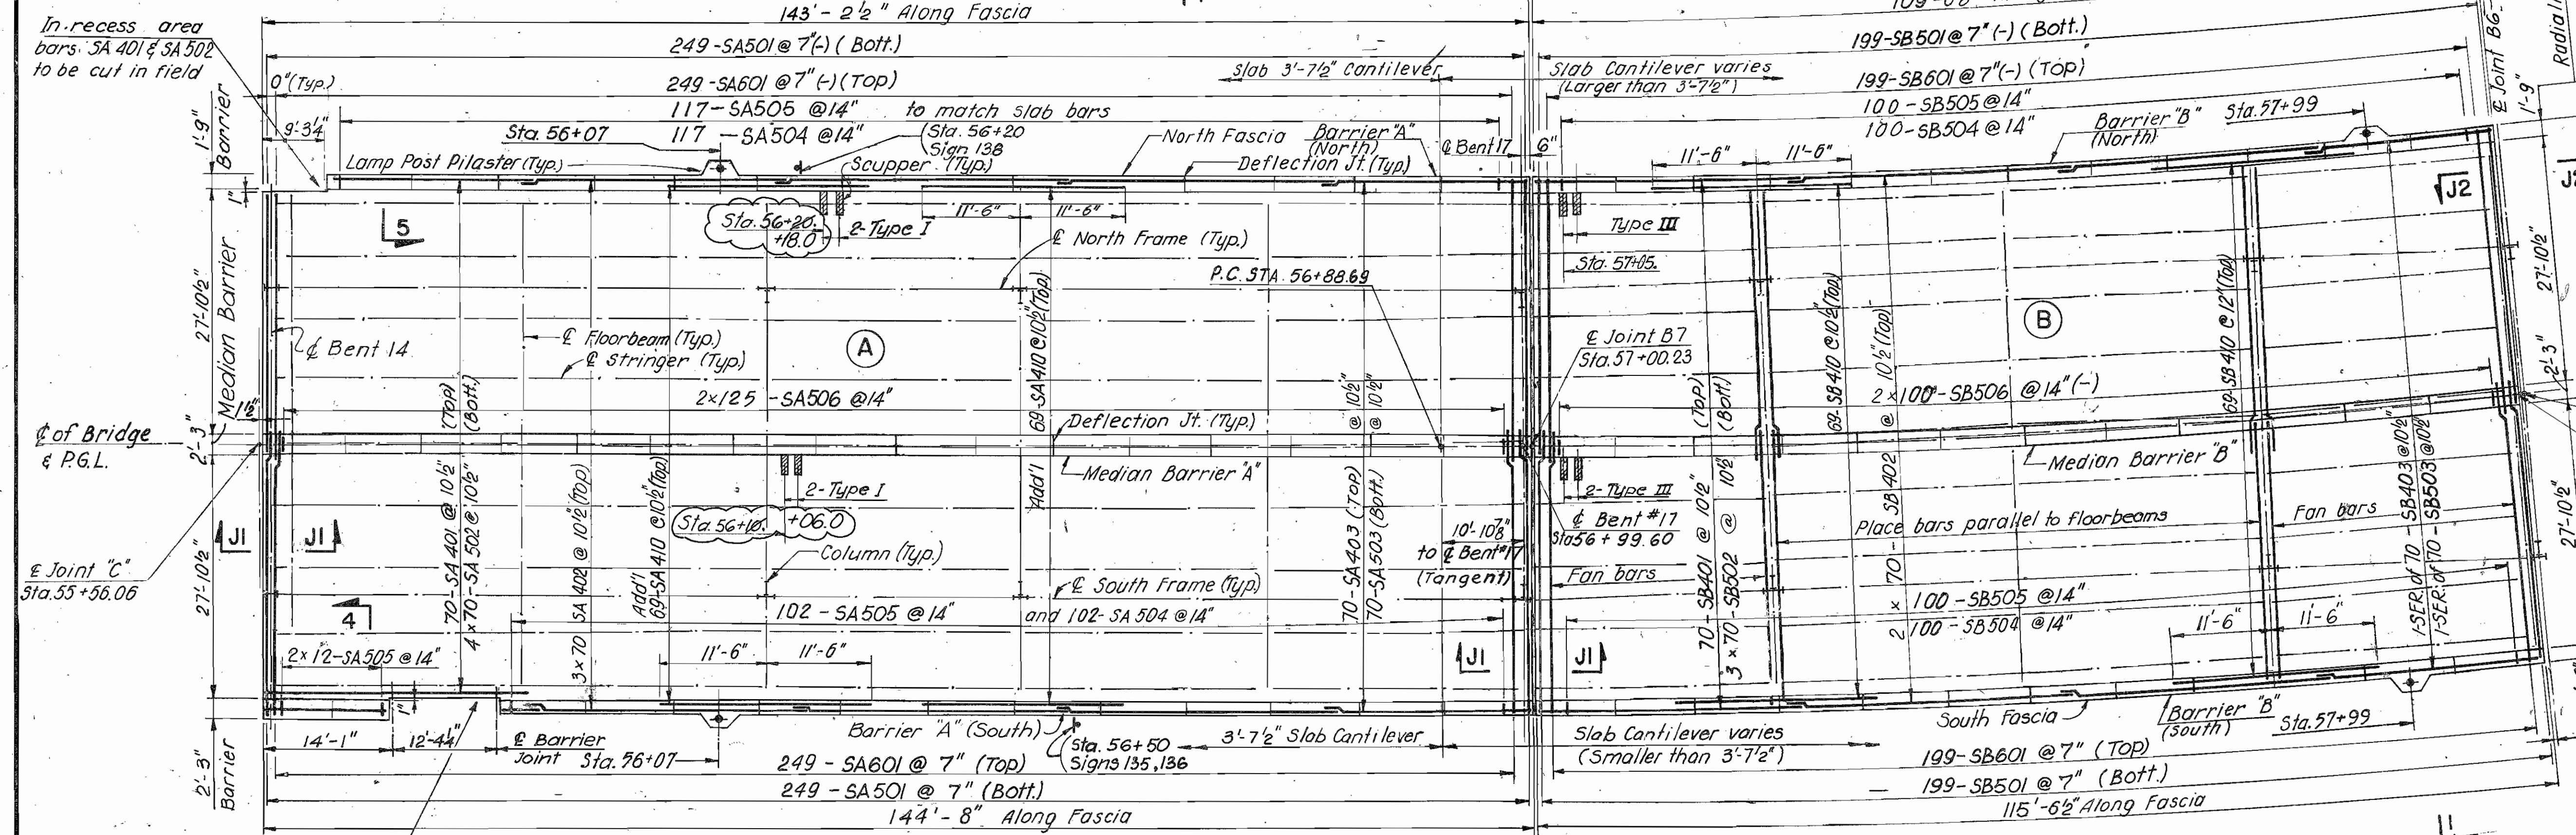


SLAB PLAN "A" & "B"

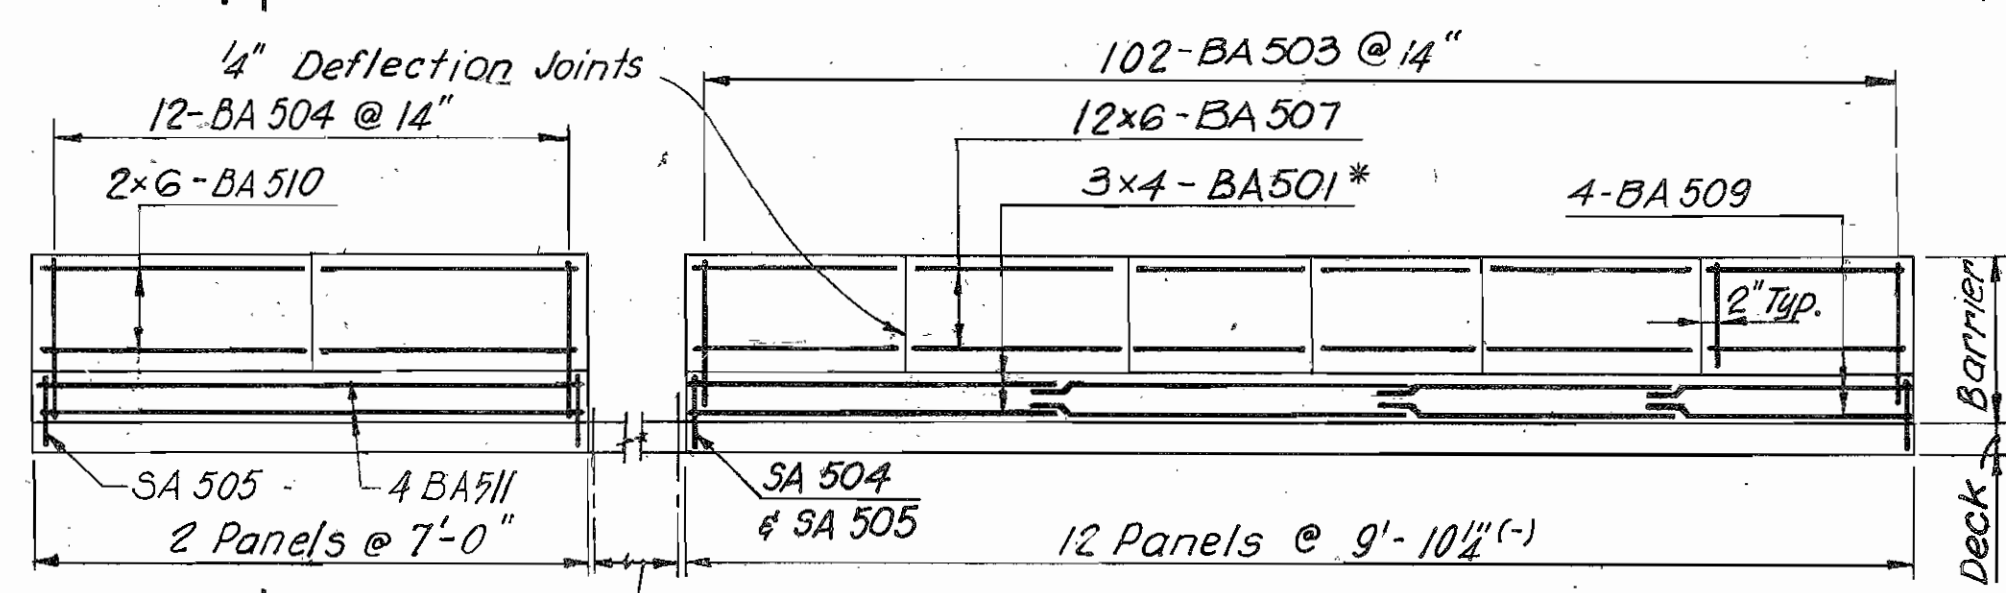


BARRIER "A" (South Fascia)  
N.T.S.

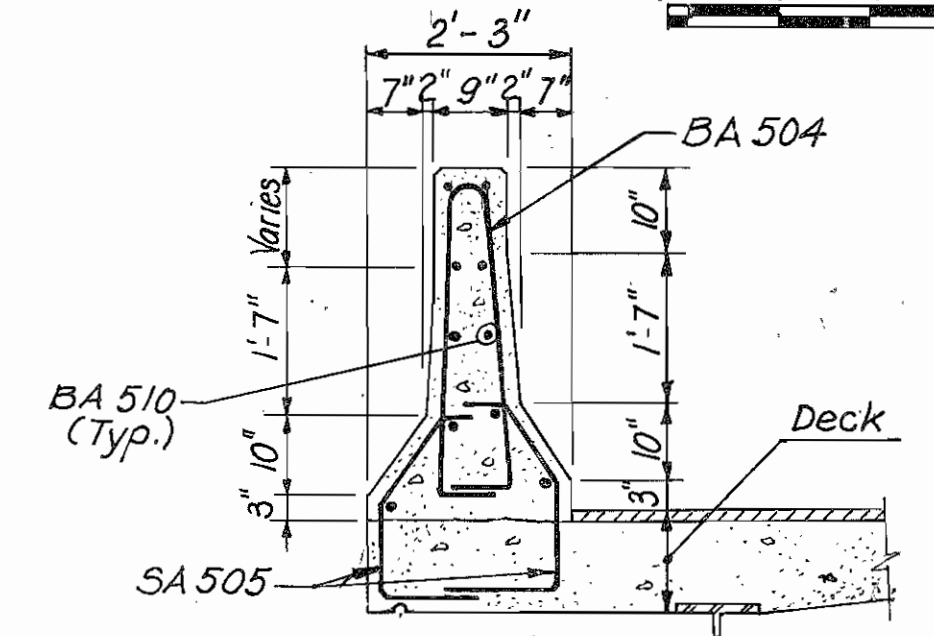


SECTION 4-4  
N.T.S.

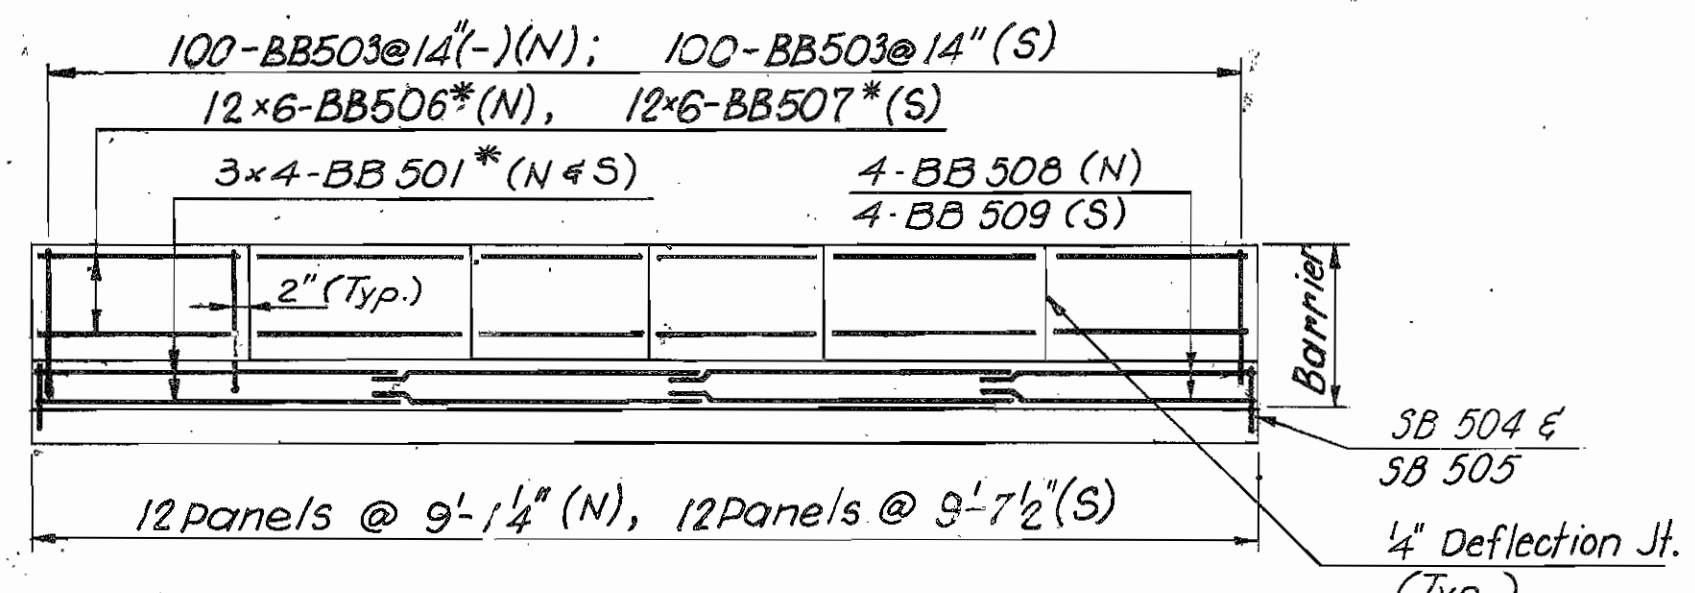


BARRIER "B" (North & South Fascia)  
N.T.S.

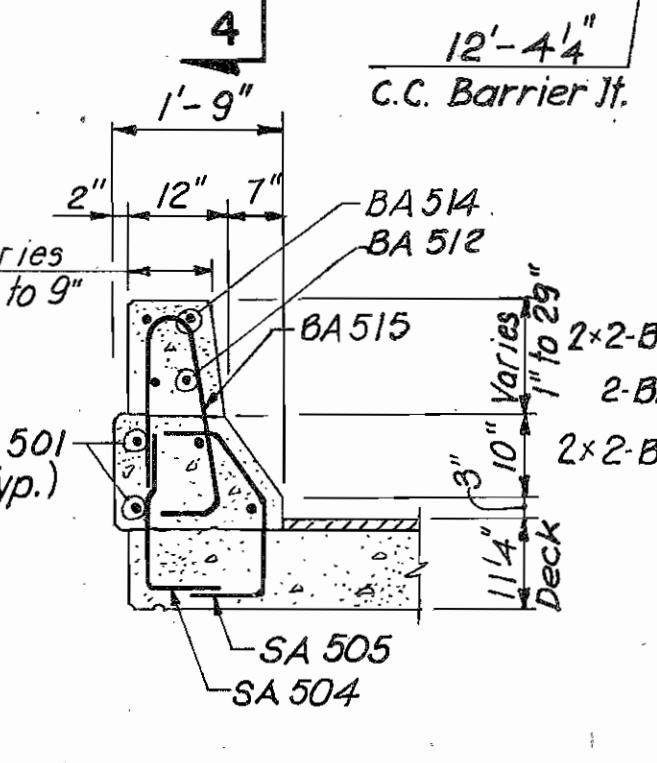


SECTION 5-5  
N.T.S.

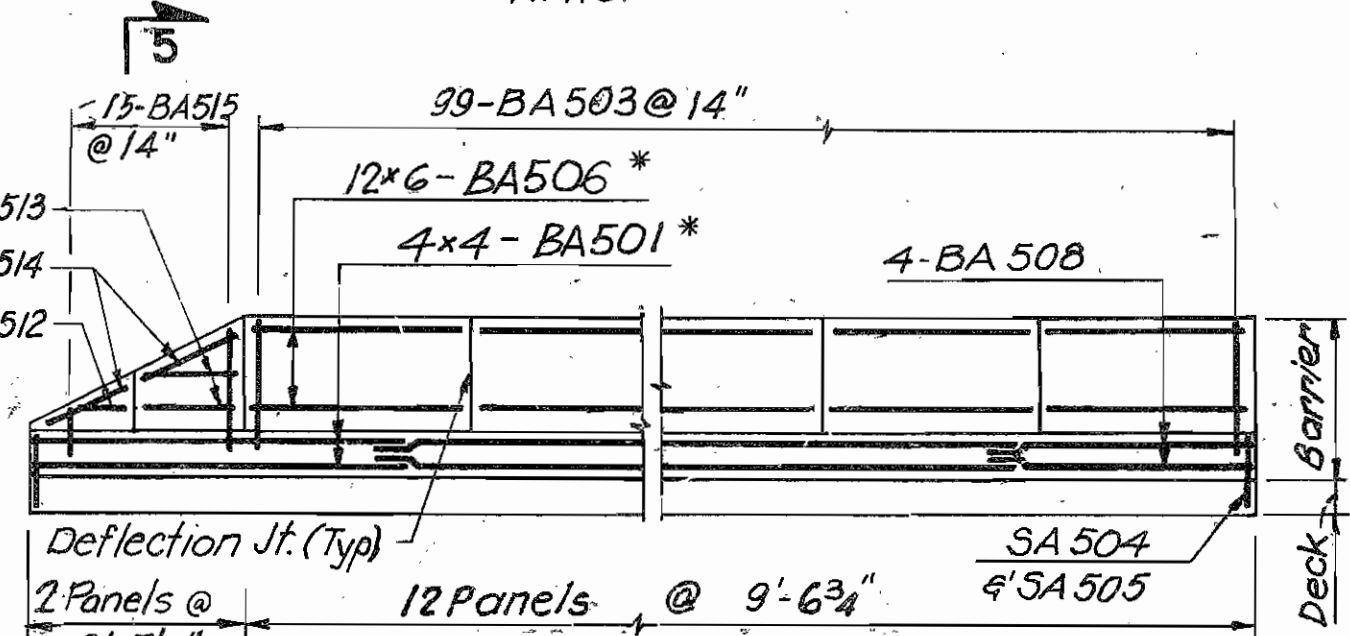

BARRIER "A" (North Fascia)  
N.T.S.

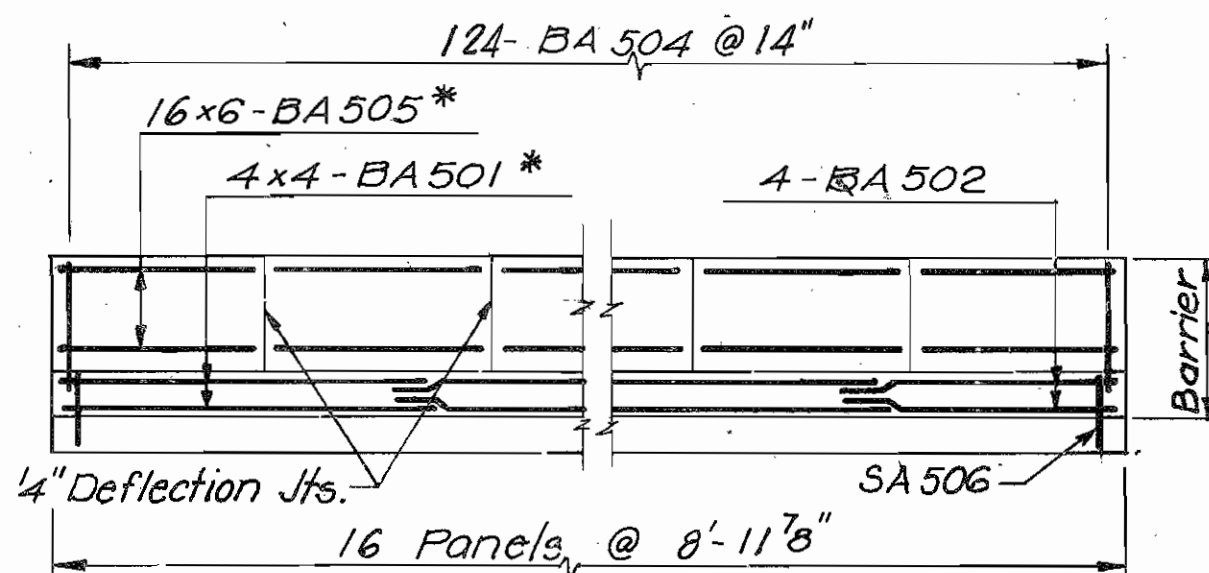

MEDIAN BARRIER "A"  
N.T.S.

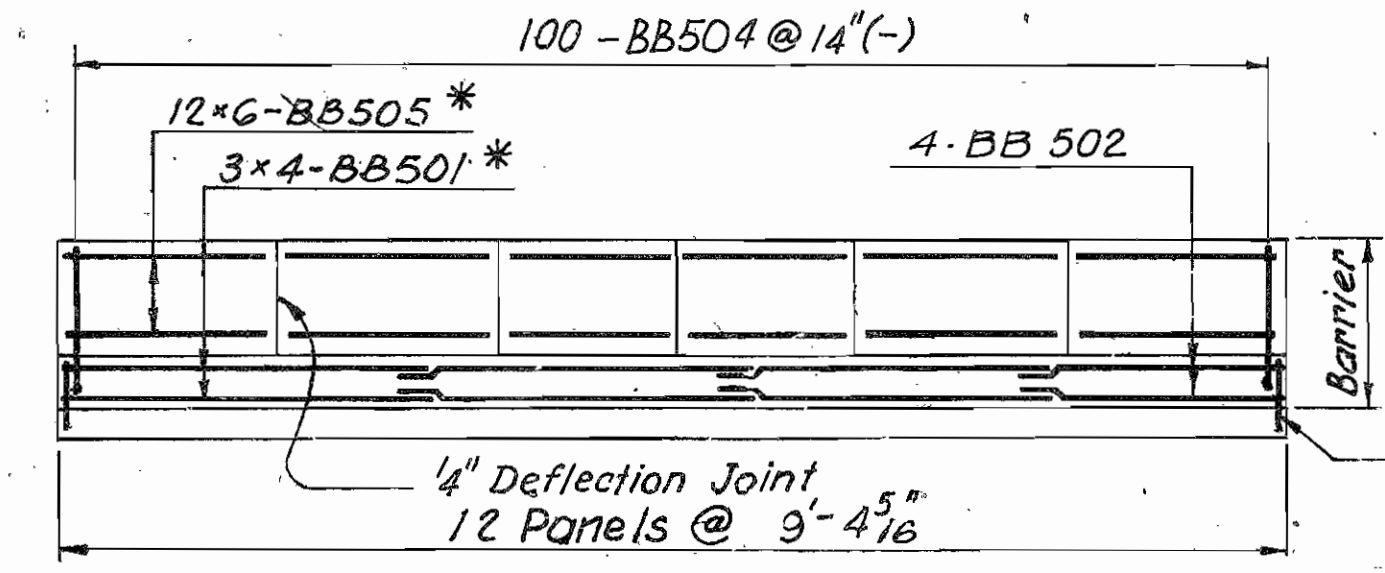

MEDIAN BARRIER "B"  
N.T.S.

\* Spaced as shown in Cross-Sections 1-1 and 2-2

REFERENCES:

General Notes	DWG. NO.
Proposed Plan and Elevation	66 & 623
Roadway Elevations	402
Reinforcing Bar List-1	407, 408 & 409
Scupper Details & Reinforcement	463
Lighting Standard/Pilaster Details	G54 & G55
Section 1-1	668
Section 2-2	456
Sections J1-J1 and J2-J2	457
Barrier details - Panel "P"	458
Barrier details - Panel "R"	420
	422

PAVLO ENGINEERING CO., P.C.  
NEW YORK, NEW YORK

CUYAHOGA COUNTY ENGINEER  
CLEVELAND OHIO


**MAIN AVENUE BRIDGE**  
CITY OF CLEVELAND  
BRIDGE OVER THE CUYAHOGA RIVER VALLEY

EAST APPROACH - LAKEFRONT TRESTLE  
DECK SLAB REINFORCEMENT - I


BRIDGE NO. 193    REPORT NO. 7119    DATE: OCT. 28, 1989

**NO. B-136**    452



DESIGN B. G.	DRAWN L. M.	CHECKED D. G. / E. G.	REVISED TO AS BUILT AS BUILT 2/94
-----------------	----------------	--------------------------	--------------------------------------

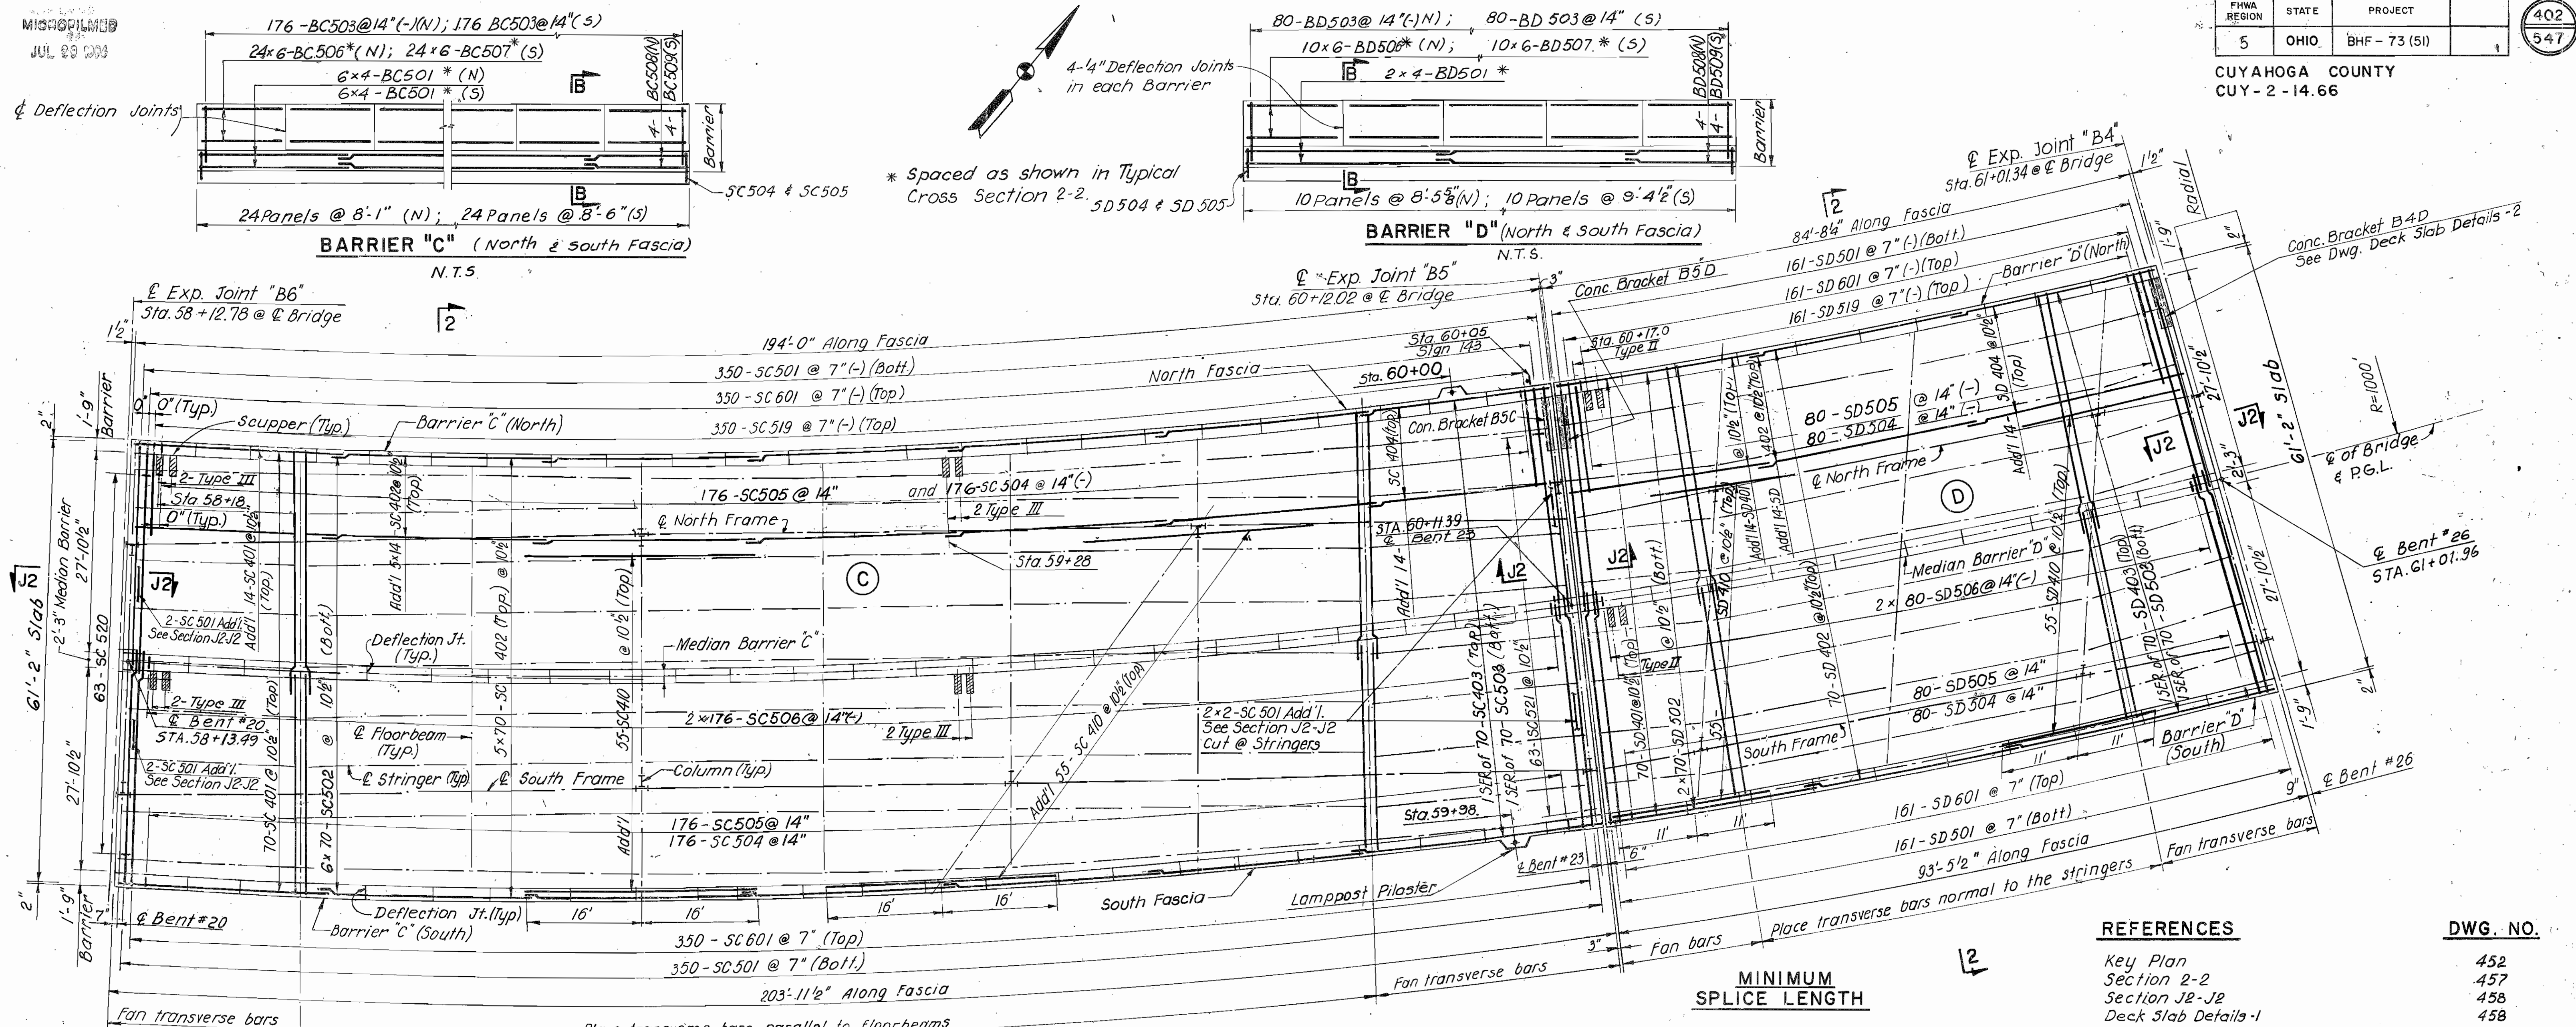

SLAB PLAN "C" & "D"

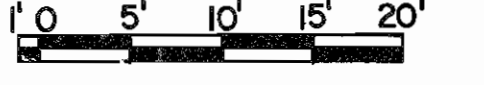

- NOTES:**
- Expansion joints are parallel to bents.
  - All reinforcing bars for Lakefront Trestle deck slab and barriers shall be prefixed LT.
  - The Contractor shall bend or field cut reinforcing steel at scuppers as required.

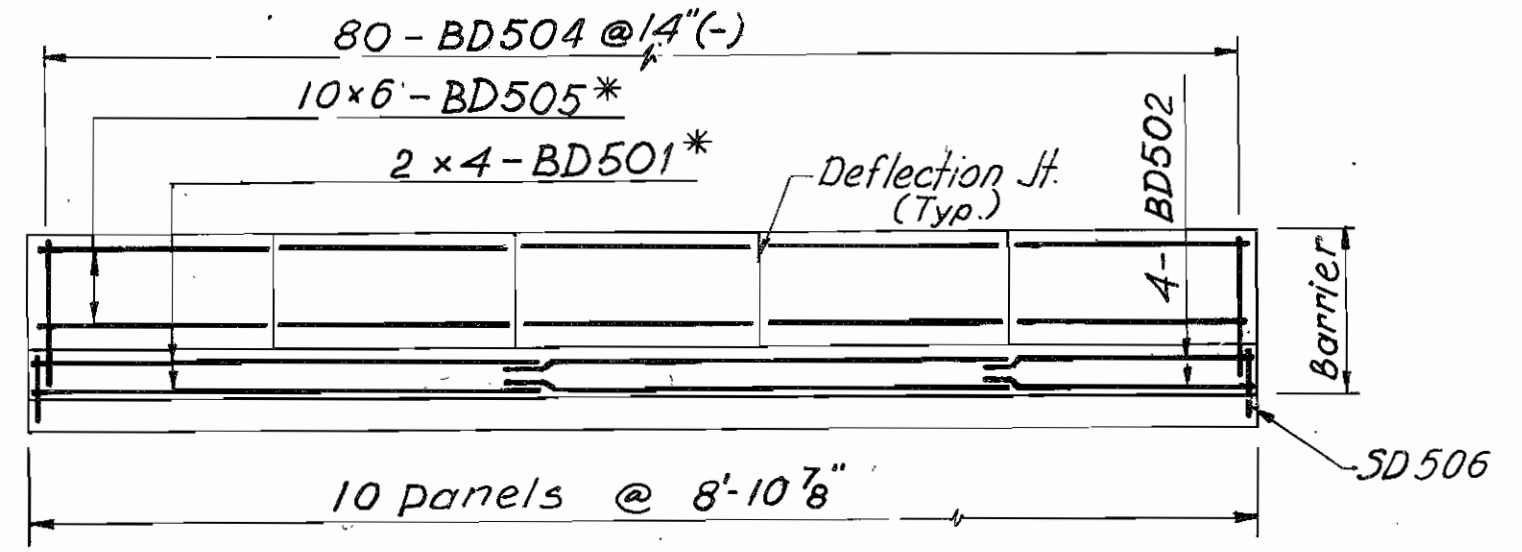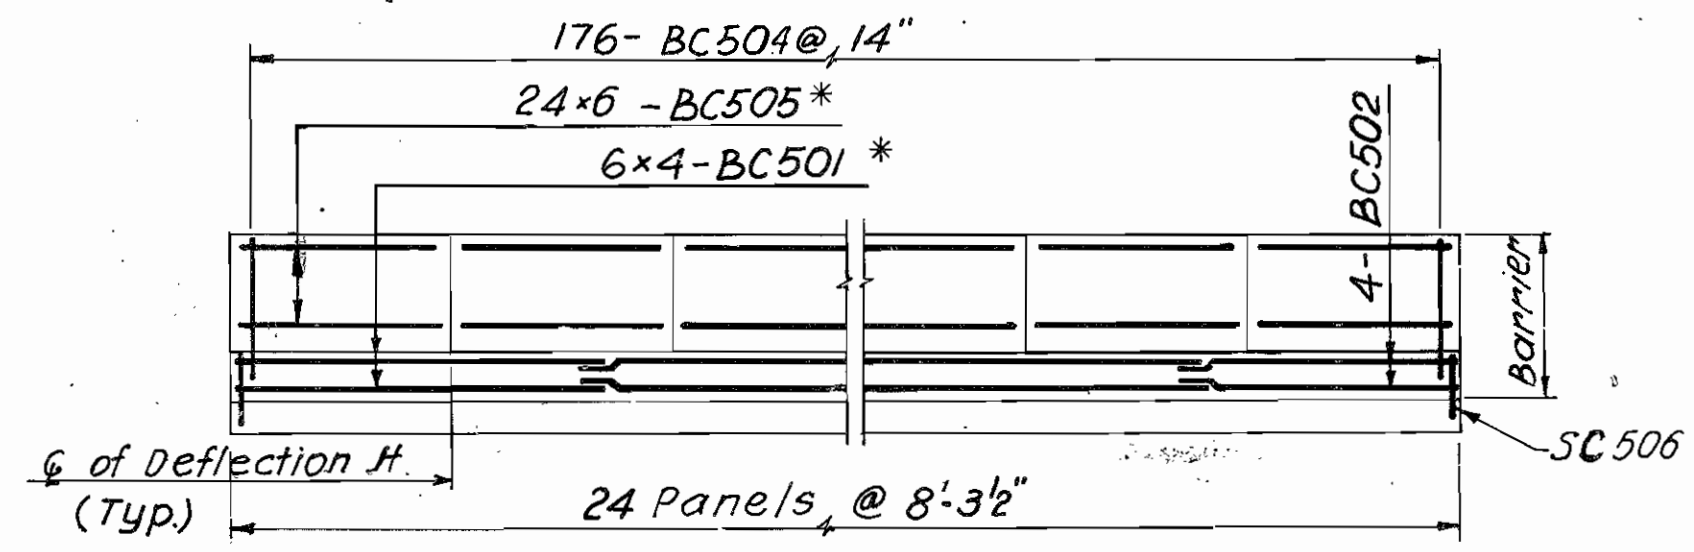

**MINIMUM SPLICE LENGTH**

Bar	Lap Length
# 4	1'-10"
# 5	2'-3"
# 6	2'-8"

**REFERENCES**

REFERENCE	DWG. NO.
Key Plan	452
Section 2-2	457
Section J2-J2	458
Deck Slab Details-1	458
Deck Slab Details-2	459
Reinforcing Bar List-2	464

For additional references, see dwg. 452

PAVLO ENGINEERING CO., P.C.  
NEW YORK, NEW YORK

**CUYAHOGA COUNTY ENGINEER**  
CLEVELAND OHIO

**MAIN AVENUE BRIDGE**  
CITY OF CLEVELAND  
BRIDGE OVER THE CUYAHOGA RIVER VALLEY  
EAST APPROACH - LAKEFRONT TRESTLE  
**DECK SLAB REINFORCEMENT-2**



BRIDGE NO. 193    REPORT NO. 7119    DATE OCT. 22, 1983

**NO. B-136**    453  
71


DESIGN B. G.	DRAWN L. M.	CHECKED DG/EG	REVISED TO AS BUILT AS BUILT 2/94
-----------------	----------------	------------------	--------------------------------------

**MINIMUM SPLICE LENGTH**





Bar	Lap Length
#4	1'-10"
#5	2'-3"
#6	2'-8"

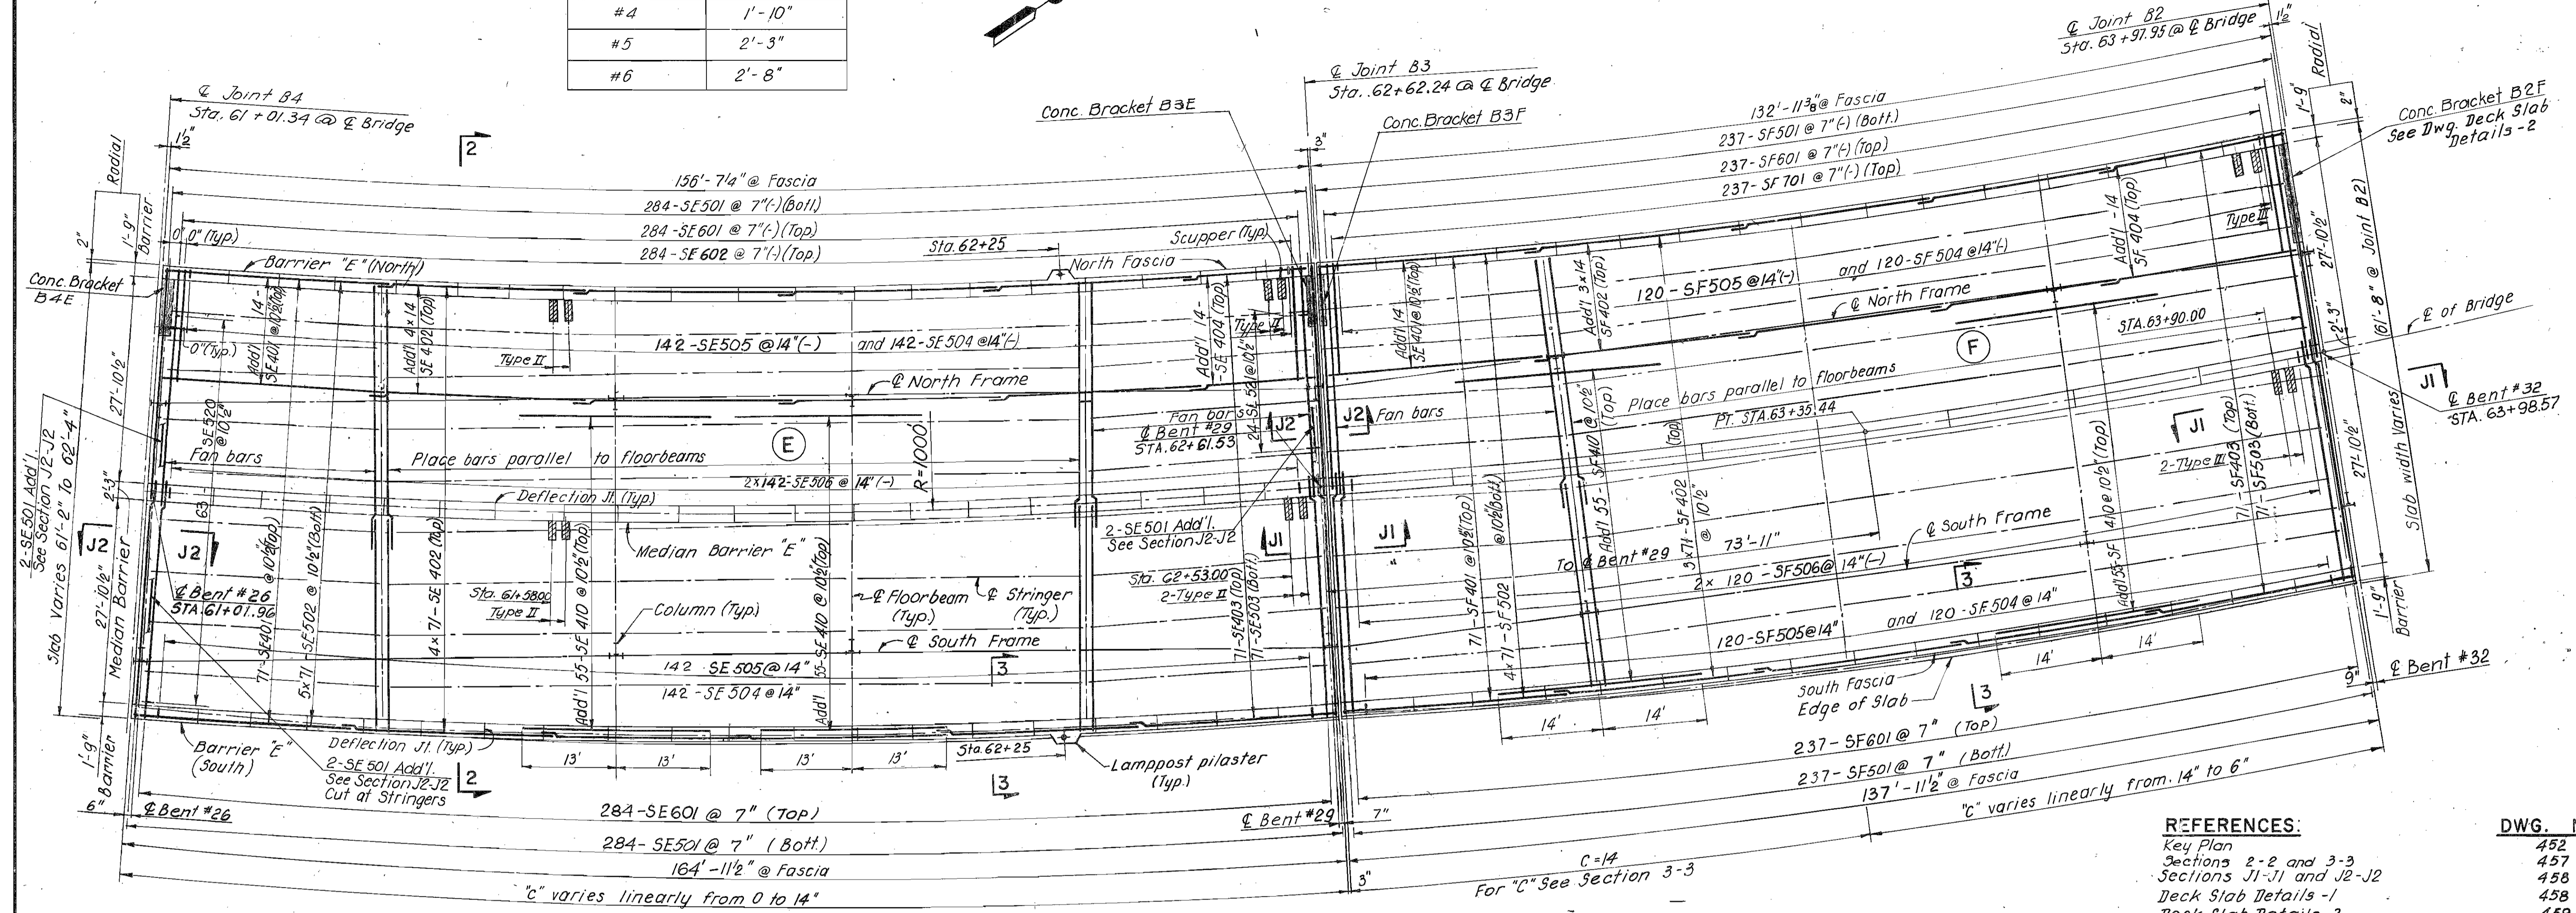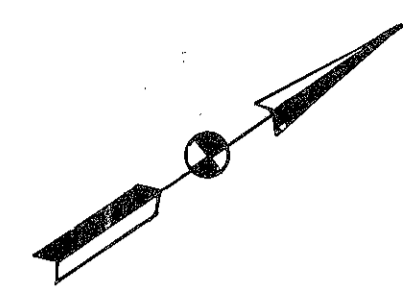

**SLAB PLAN "E" & "F"**

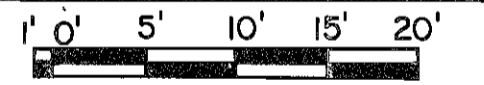

- NOTES:**
- Expansion joints are parallel to bents.
  - All reinforcing bars for Lakefront Trestle, deck slab and barriers shall be prefixed LT.
  - The Contractor shall bend or field cut reinforcing steel at Scuppers as required.

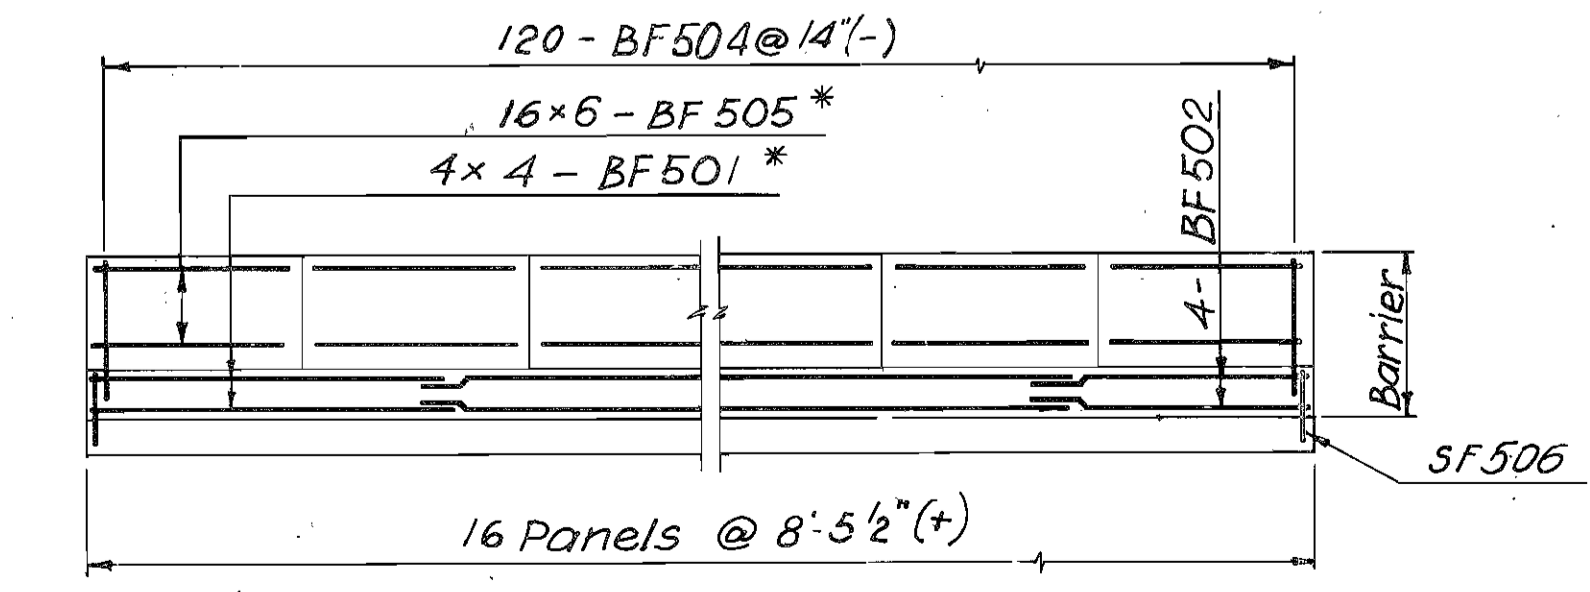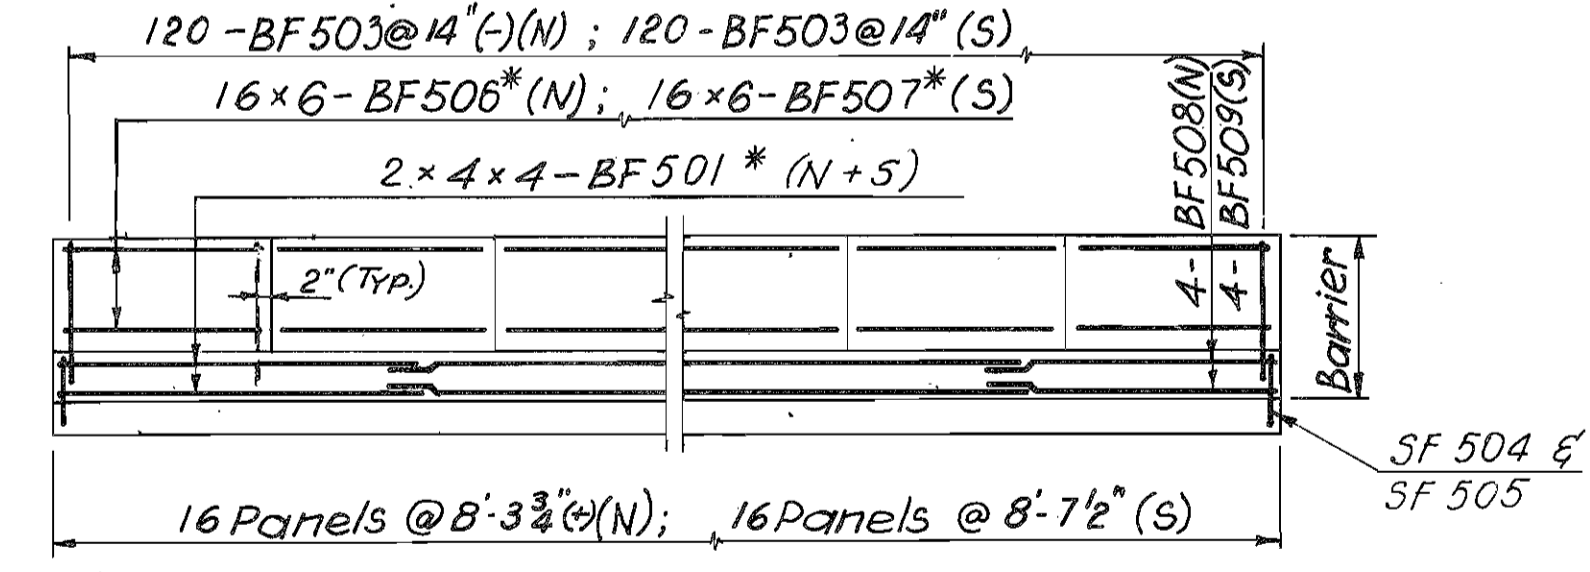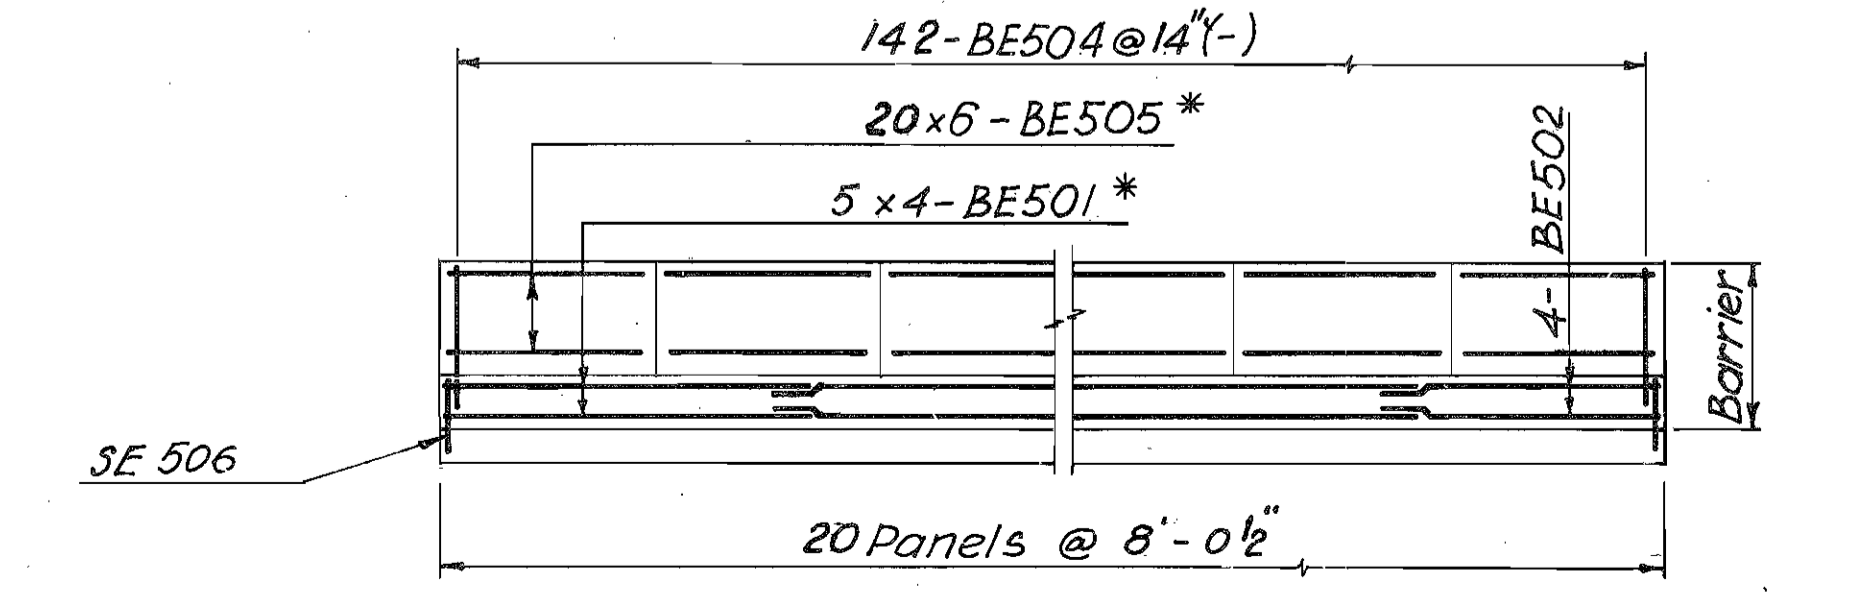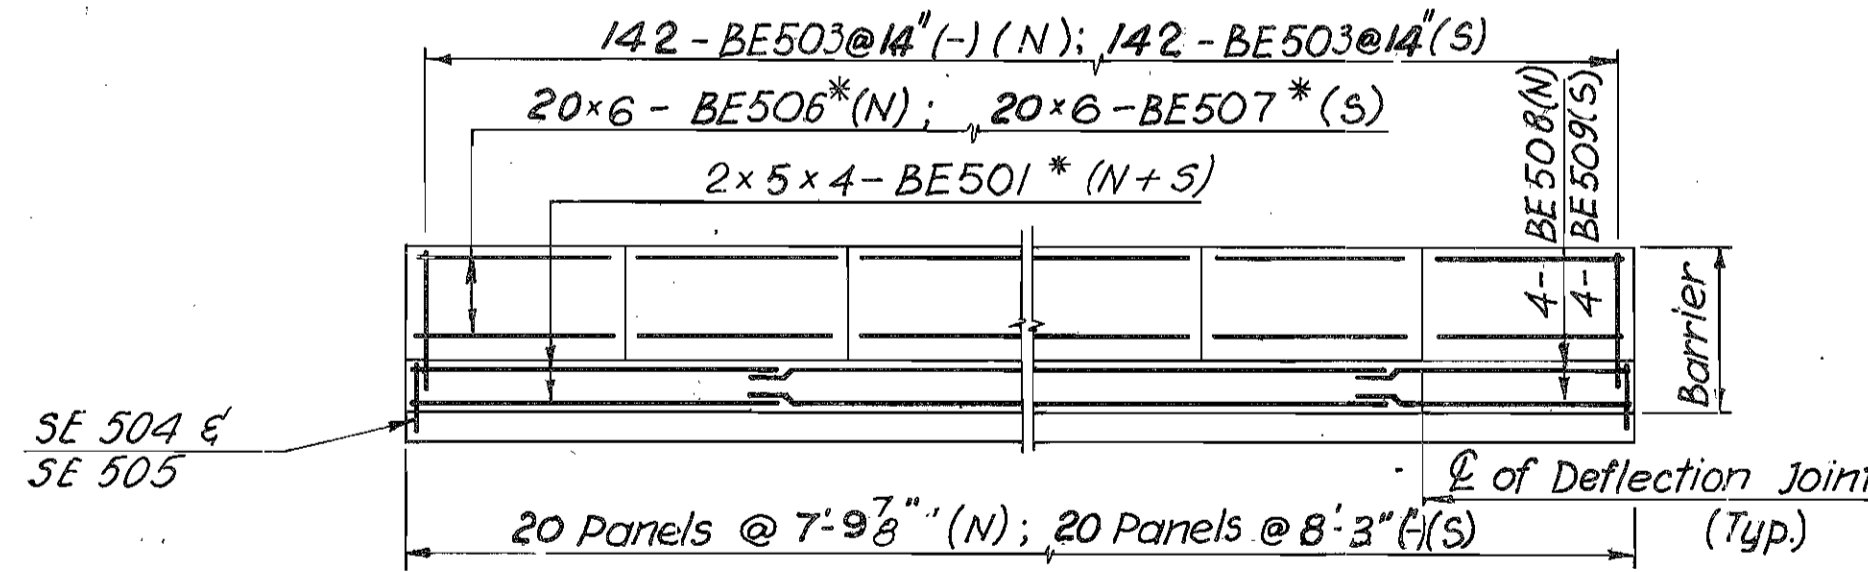

\* Spaced as shown in cross-sections 2-2 and 3-3.

**REFERENCES:**

Key Plan	452
Sections 2-2 and 3-3	457
Sections J1-J1 and J2-J2	458
Deck Slab Details-1	458
Deck Slab Details-2	459
Reinforcing Bar List-3	465

For additional references see dwg. 452

PAVLO ENGINEERING CO., P.C.  
NEW YORK, NEW YORK

**CUYAHOGA COUNTY ENGINEER**  
CLEVELAND OHIO


**MAIN AVENUE BRIDGE**  
CITY OF CLEVELAND  
BRIDGE OVER THE CUYAHOGA RIVER VALLEY

EAST APPROACH - LAKEFRONT TRESTLE  
**DECK SLAB REINFORCEMENT-3**

BRIDGE NO. 193    REPORT NO. 7119    DATE OCT. 26, 1983


**NO. B-136**    454

DESIGN B.G.	DRAWN L.M.	CHECKED D.G./E.G.	REVISED TO AS BUILT AS BUILT 2/94
----------------	---------------	----------------------	--------------------------------------

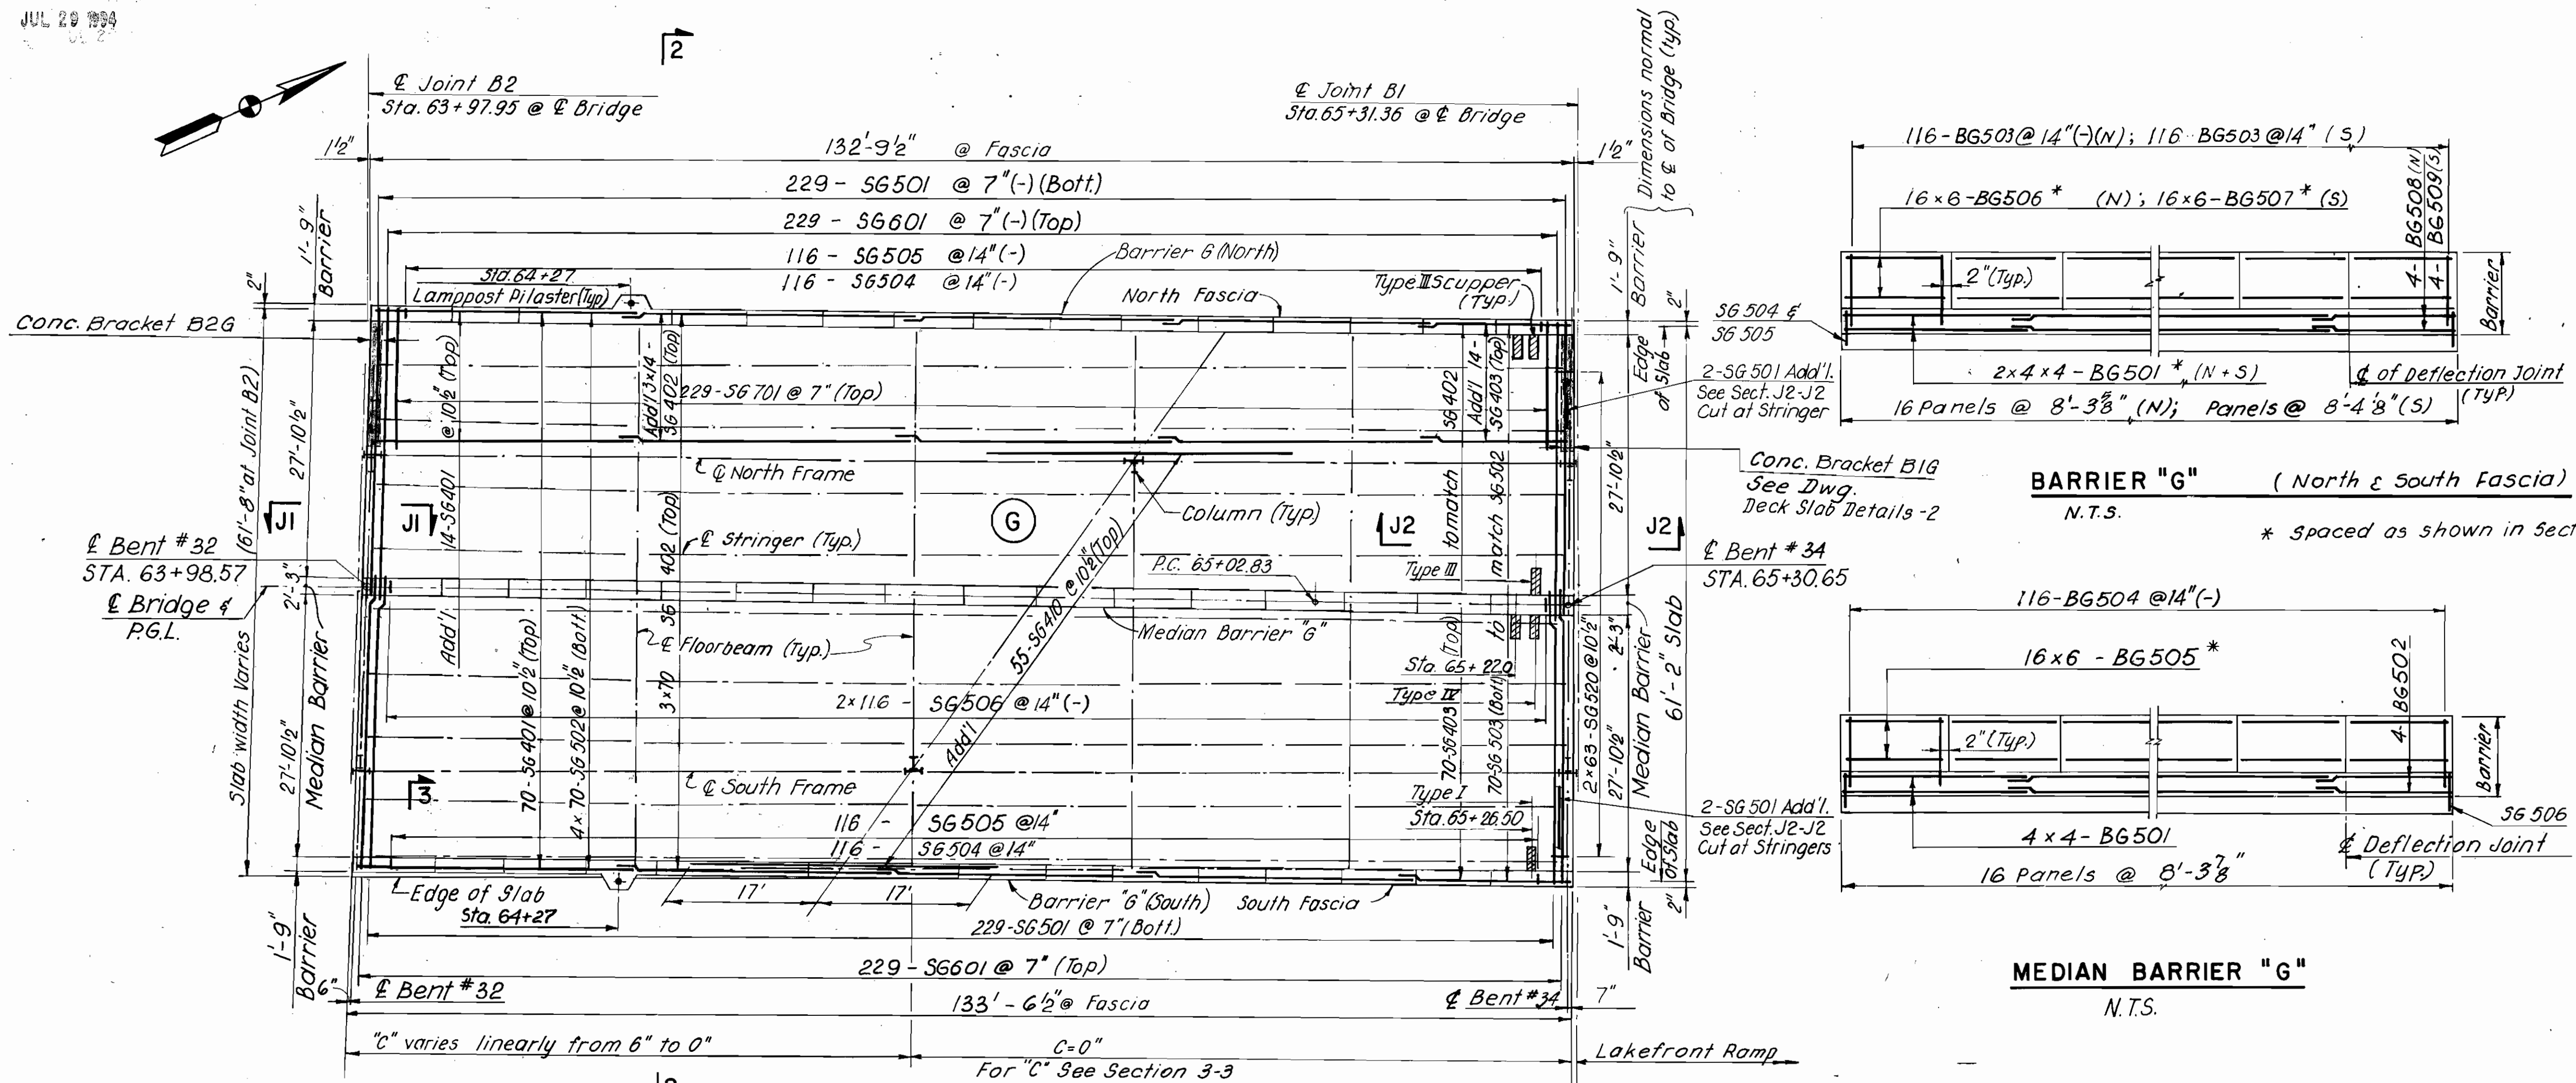

**MINIMUM SPLICE LENGTH**


BAR	LAP LENGTH
#4	1'-10"
#5	2'-3"
#6	2'-8"

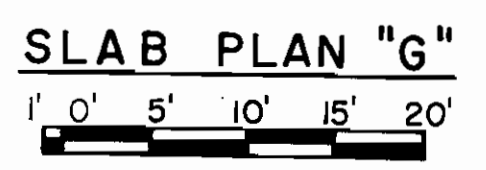


**NOTES:**

- Expansion joints are parallel to bents.
- All reinforcing bars for Lakefront Trestle deck slab and barriers shall be prefixed LT.
- The Contractor shall bend or field cut reinforcing steel at Scuppers as required.


Preformed expansion joint filler in barriers shall be either 1/4" gray sponge rubber (AASHTO M-153) or 1/4" gray cellular polyvinyl chloride (PVC) Sponge. Concrete parapets above upper construction joints shall be placed in alternate sections by the use of bulkheads. Closing sections shall be placed after removal of bulkheads and after placement of expansion joint filler.

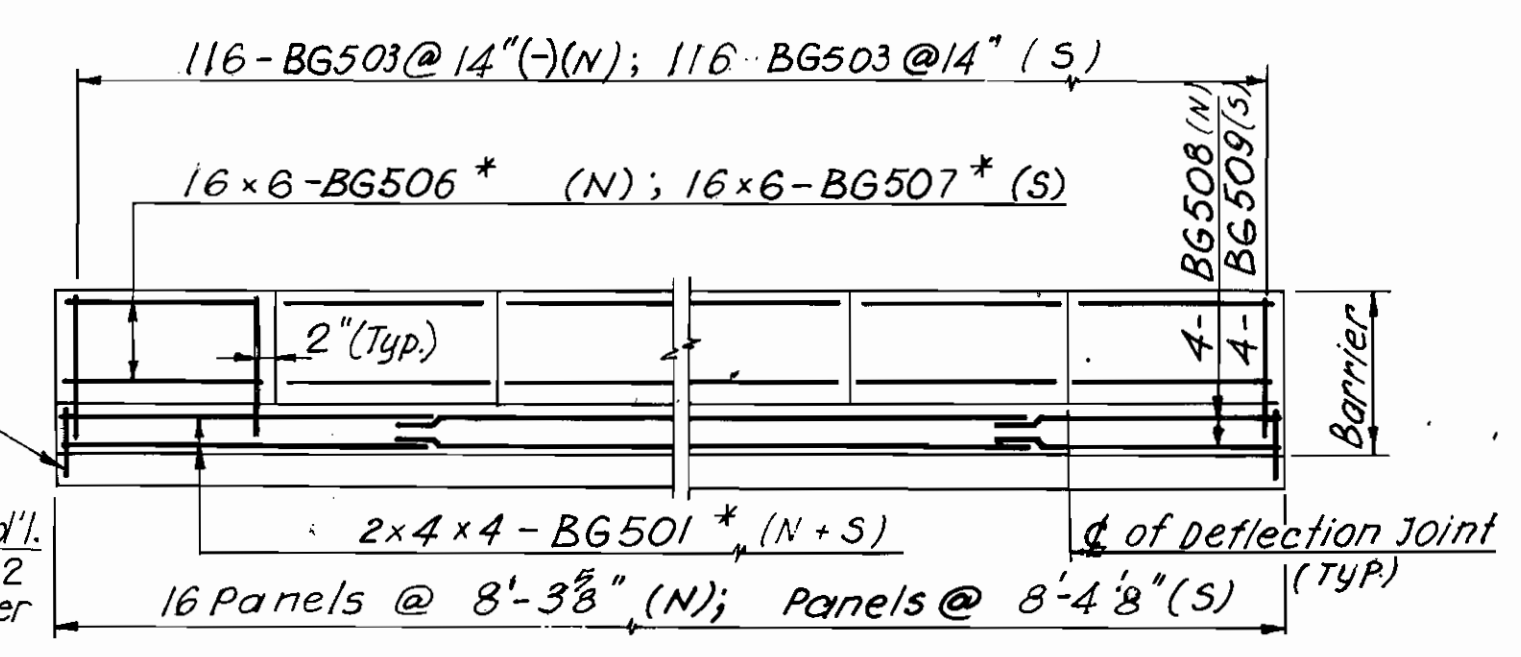


**BARRIER "G"** (North & South Fascia)  
N.T.S.  
\* spaced as shown in section.

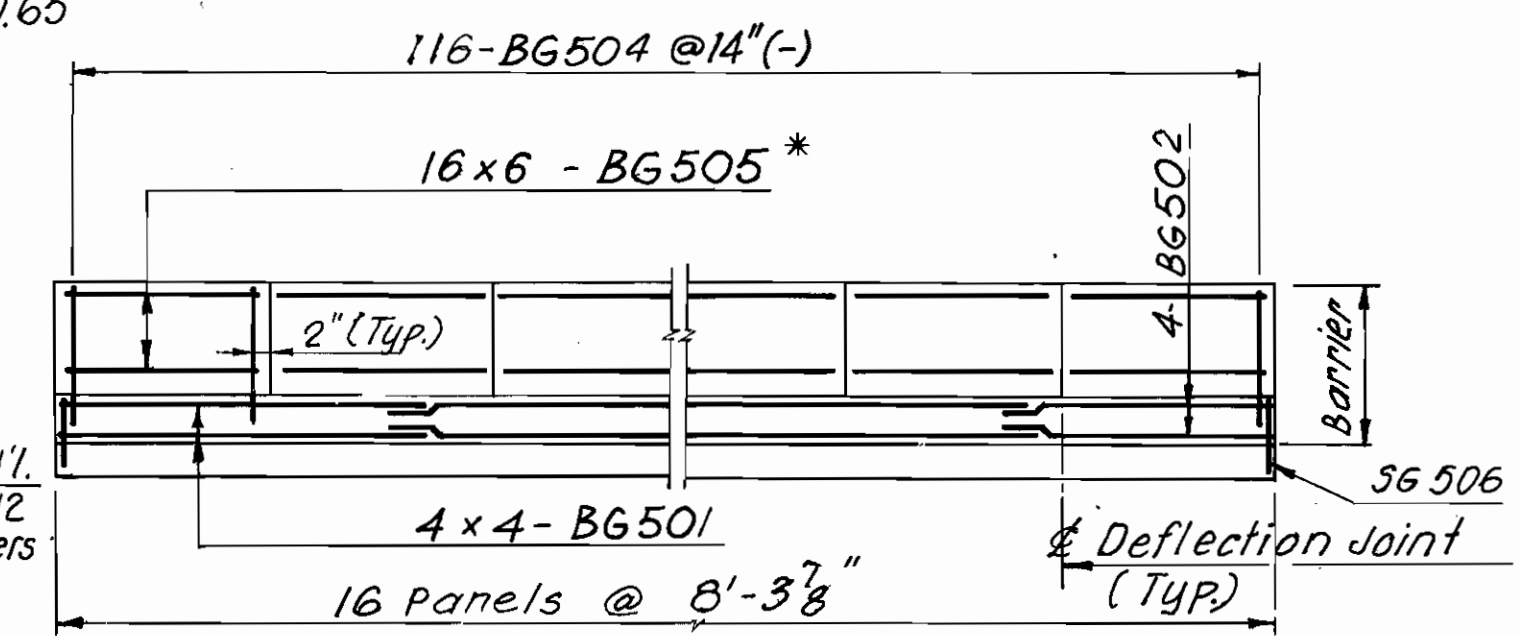

**MEDIAN BARRIER "G"**  
N.T.S.

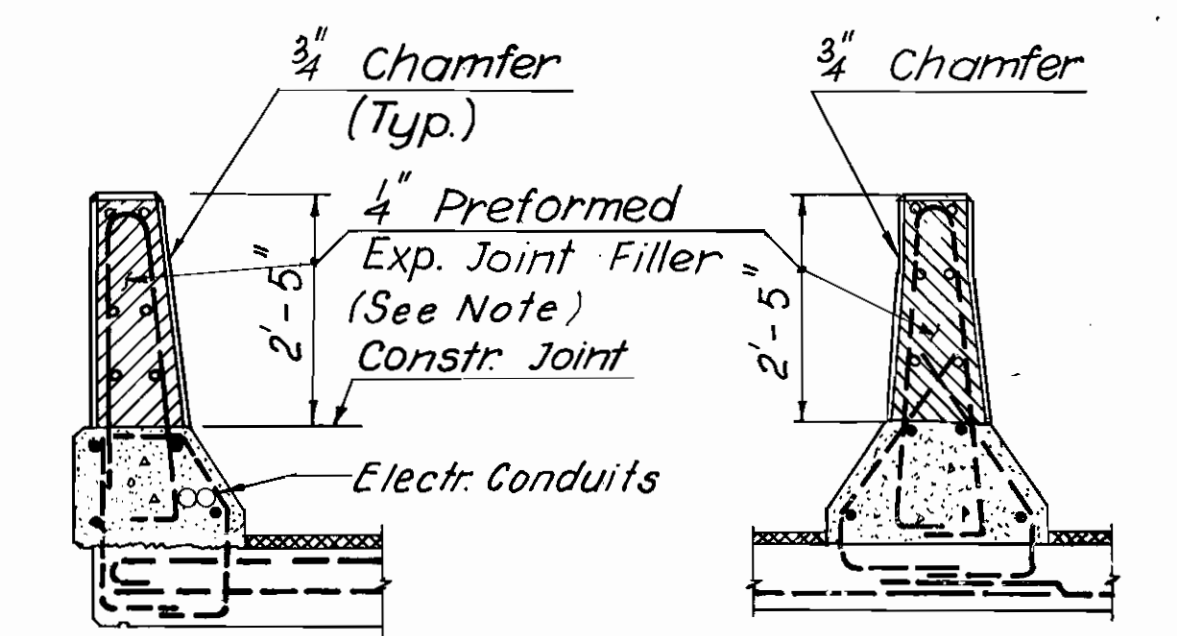

**FASCIA BARRIER**  
**MEDIAN BARRIER**  
**BARRIER JOINT DETAILS**  
N.T.S.

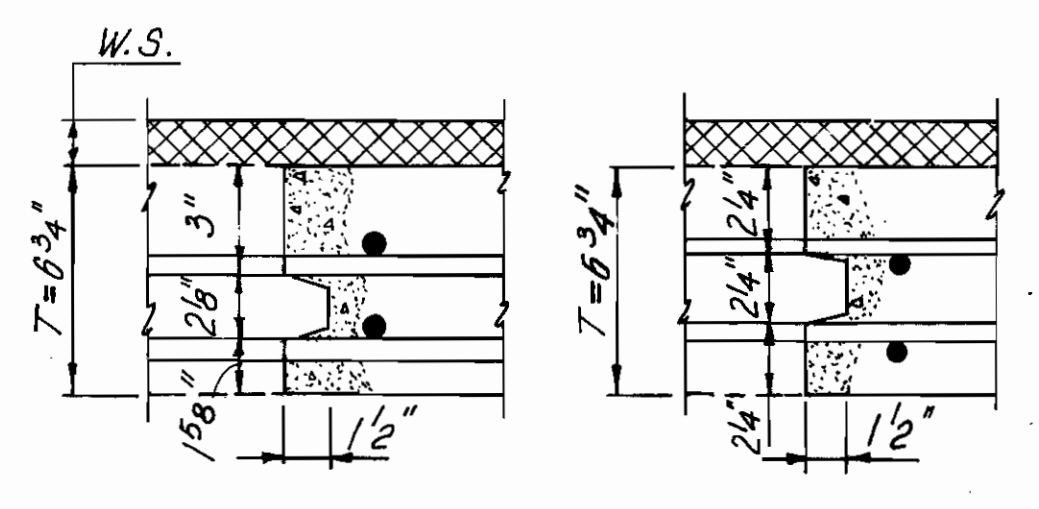

**LONGITUDINAL**  
**TRANSVERSE**  
**CONSTRUCTION JOINT DETAILS**  
N.T.S. (TYP)

**REFERENCES:**

Key Plan	452
Sections 2-2 and 3-3	457
Sections J1-J1 and J2-J2	458
Deck Slab Details-1	458
Deck Slab Details-2	459
Reinforcing Bar List-4	466

For additional references, see drawing 452


PAVLO ENGINEERING CO., P.C. NEW YORK, NEW YORK	
CUYAHOGA COUNTY ENGINEER CLEVELAND OHIO	
<b>MAIN AVENUE BRIDGE</b> CITY OF CLEVELAND BRIDGE OVER THE CUYAHOGA RIVER VALLEY	
EAST APPROACH - LAKEFRONT TRESTLE <b>DECK SLAB REINFORCEMENT-4</b>	
BRIDGE NO. 193	REPORT NO. 7119 DATE OCT. 28, 1982
<b>NO. B-136</b>	455 71
DESIGN B.G.	DRAWN L.M.
CHECKED DG/E.G.	REVISED TO AS BUILT AS BUILT 2/94

MICROFILMED  
JUL 29 1984

FHWA REGION	STATE	PROJECT	
5	OHIO	BHF - 73(51)	

405  
547

CUYAHOGA COUNTY  
CUY - 2 - 14.66

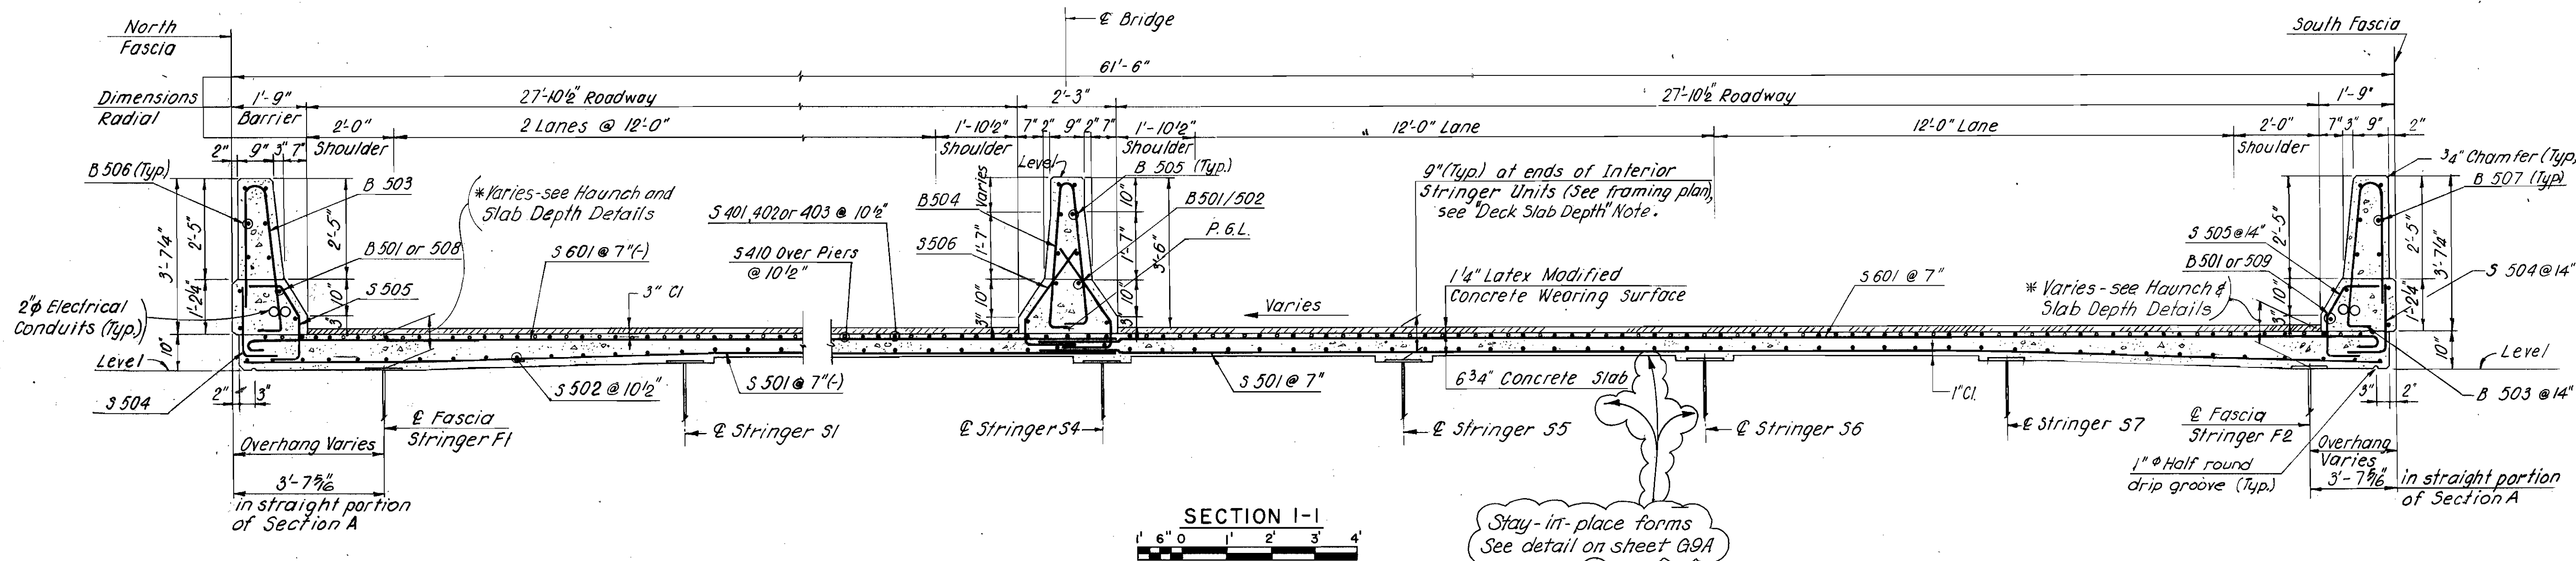

SECTION I-I  
1' 6" 0 1' 2' 3' 4'

Stay-in-place forms  
See detail on sheet G9A  
(AB)

**NOTES:**

- All reinforcing bars for Lakefront Trestle deck slab and barriers shall be prefixed LT.
- A Haunch Width as shown on Haunch & Depth of Slab Details shall be used for computing quantity of concrete
- DECK SLAB DEPTH: The distance shown from top of deck slab to top of steel beam is the design dimension. The quantity of deck concrete to be paid for shall be based on this dimension, less 1/4" wearing surface even though deviation from it may be necessary because the top flange of the beam may not have the exact camber or conformation required to place it parallel to the finished grade.
- \* This is the design dimension. The quantity of deck concrete to be paid for shall be based upon this dimension, less 1/4" wearing surface, even though deviation from it may be necessary because the top flange of the girder may not have the exact camber or conformation required to place it parallel to the finished grade. Deduction shall be made for volume of encased steel plates as per 511.18.

**REFERENCES:**


- Deck Slab Reinforcement - I 452
- Location of Section I-I 452
- Haunch and Slab Depth Details 449
- Deck-Framing Offset Table 460
- Reinforcing Bar List 463
- Forms for Deck Overhang Note 450

**DWG. NO.**

Stay-in-place forms (AB) G9A

(AB) - As Built

PAVLO ENGINEERING CO., P.C. NEW YORK, NEW YORK		
CUYAHOGA COUNTY ENGINEER CLEVELAND OHIO		
MAIN AVENUE BRIDGE CITY OF CLEVELAND BRIDGE OVER THE CUYAHOGA RIVER VALLEY		
EAST APPROACH - LAKEFRONT TRESTLE DECK SECTIONS - I		
BRIDGE NO. 193	REPORT NO. 7119	DATE: OCT. 28, 1969
NO. B-136		456 71
DESIGN B.G.	DRAWN L.M.	CHECKED D.G./E.G.
REVISED TO AS BUILT AS BUILT 2/94		

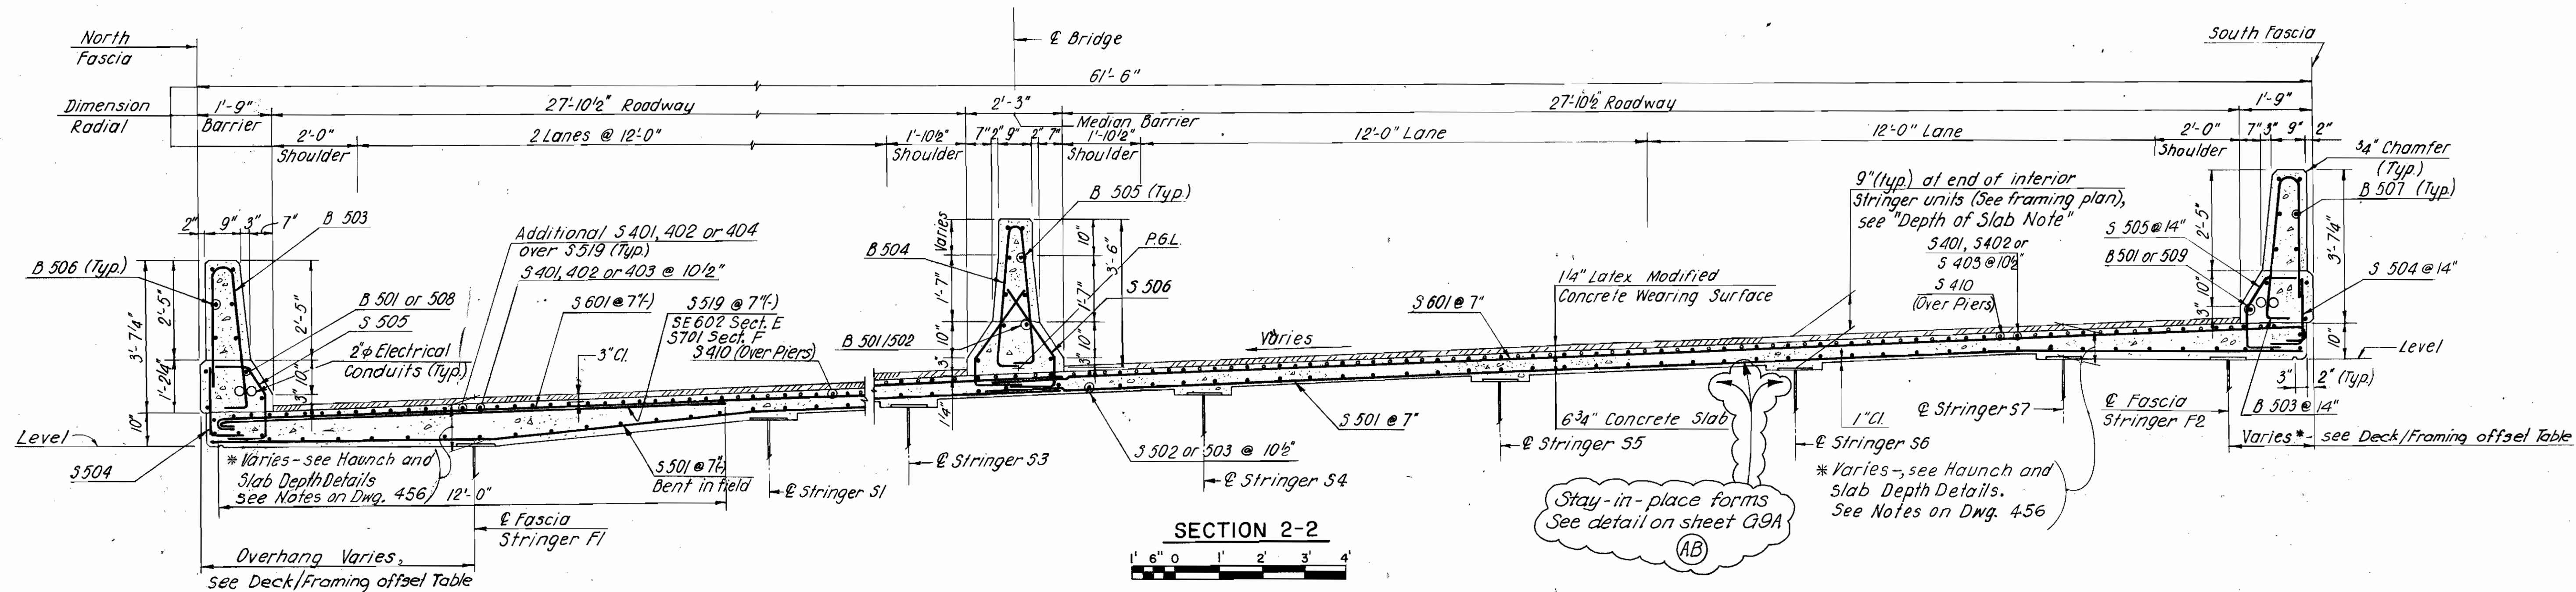

SECTION 2-2  
1" = 6"


**NOTES:**

- All reinforcing bars for Lakefront Trestle shall be prefixed LT.

**REFERENCES:**

REFERENCE	DWG. NO.
Deck slab Reinf. 2, 3 & 4	453 - 455
Location of Sections 2-2 & 3-3	453 - 455
Haunch and Slab Depth Details	449
Deck/Framing offset Table	460
Reinforcing Bar List 1, 2, 3 & 4	463 thru 466
Haunch width and Depth of Slab Note	456
Forms for Deck Overhang - Note	450
Stay-in-place forms (AB)	G9A


\* See Section 3-3 Where Overhang is less than 10"

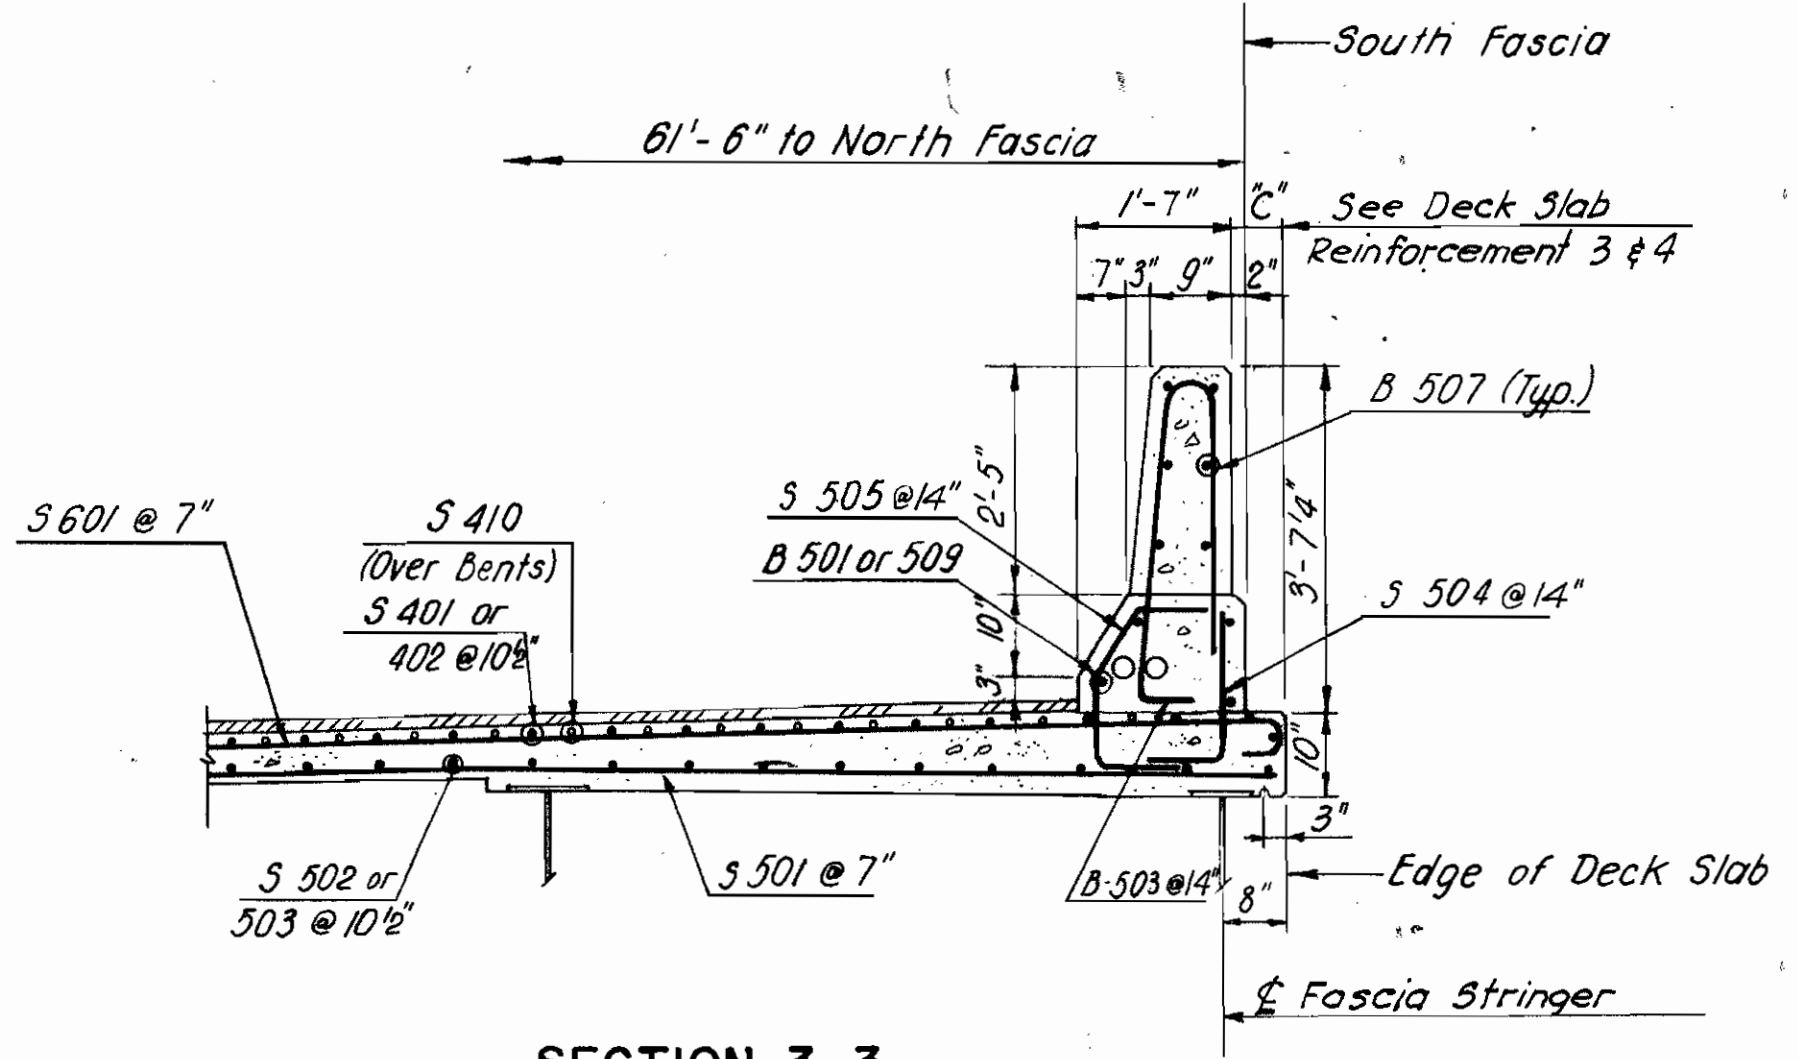


SECTION 3-3

(AB) - As Built

PAVLO ENGINEERING CO., P.C. NEW YORK, NEW YORK			
CUYAHOGA COUNTY ENGINEER CLEVELAND OHIO			
<b>MAIN AVENUE BRIDGE</b> CITY OF CLEVELAND BRIDGE OVER THE CUYAHOGA RIVER VALLEY			
EAST APPROACH - LAKEFRONT TRESTLE DECK SECTIONS - 2			
BRIDGE NO. 193	REPORT NO. 7119	DATE: OCT. 28, 1989	
<b>NO. B-136</b>			457 71
DESIGN B.G.	DRAWN L.M.	CHECKED D.G./E.G.	REVISED TO AS BUILT AS BUILT 2/94

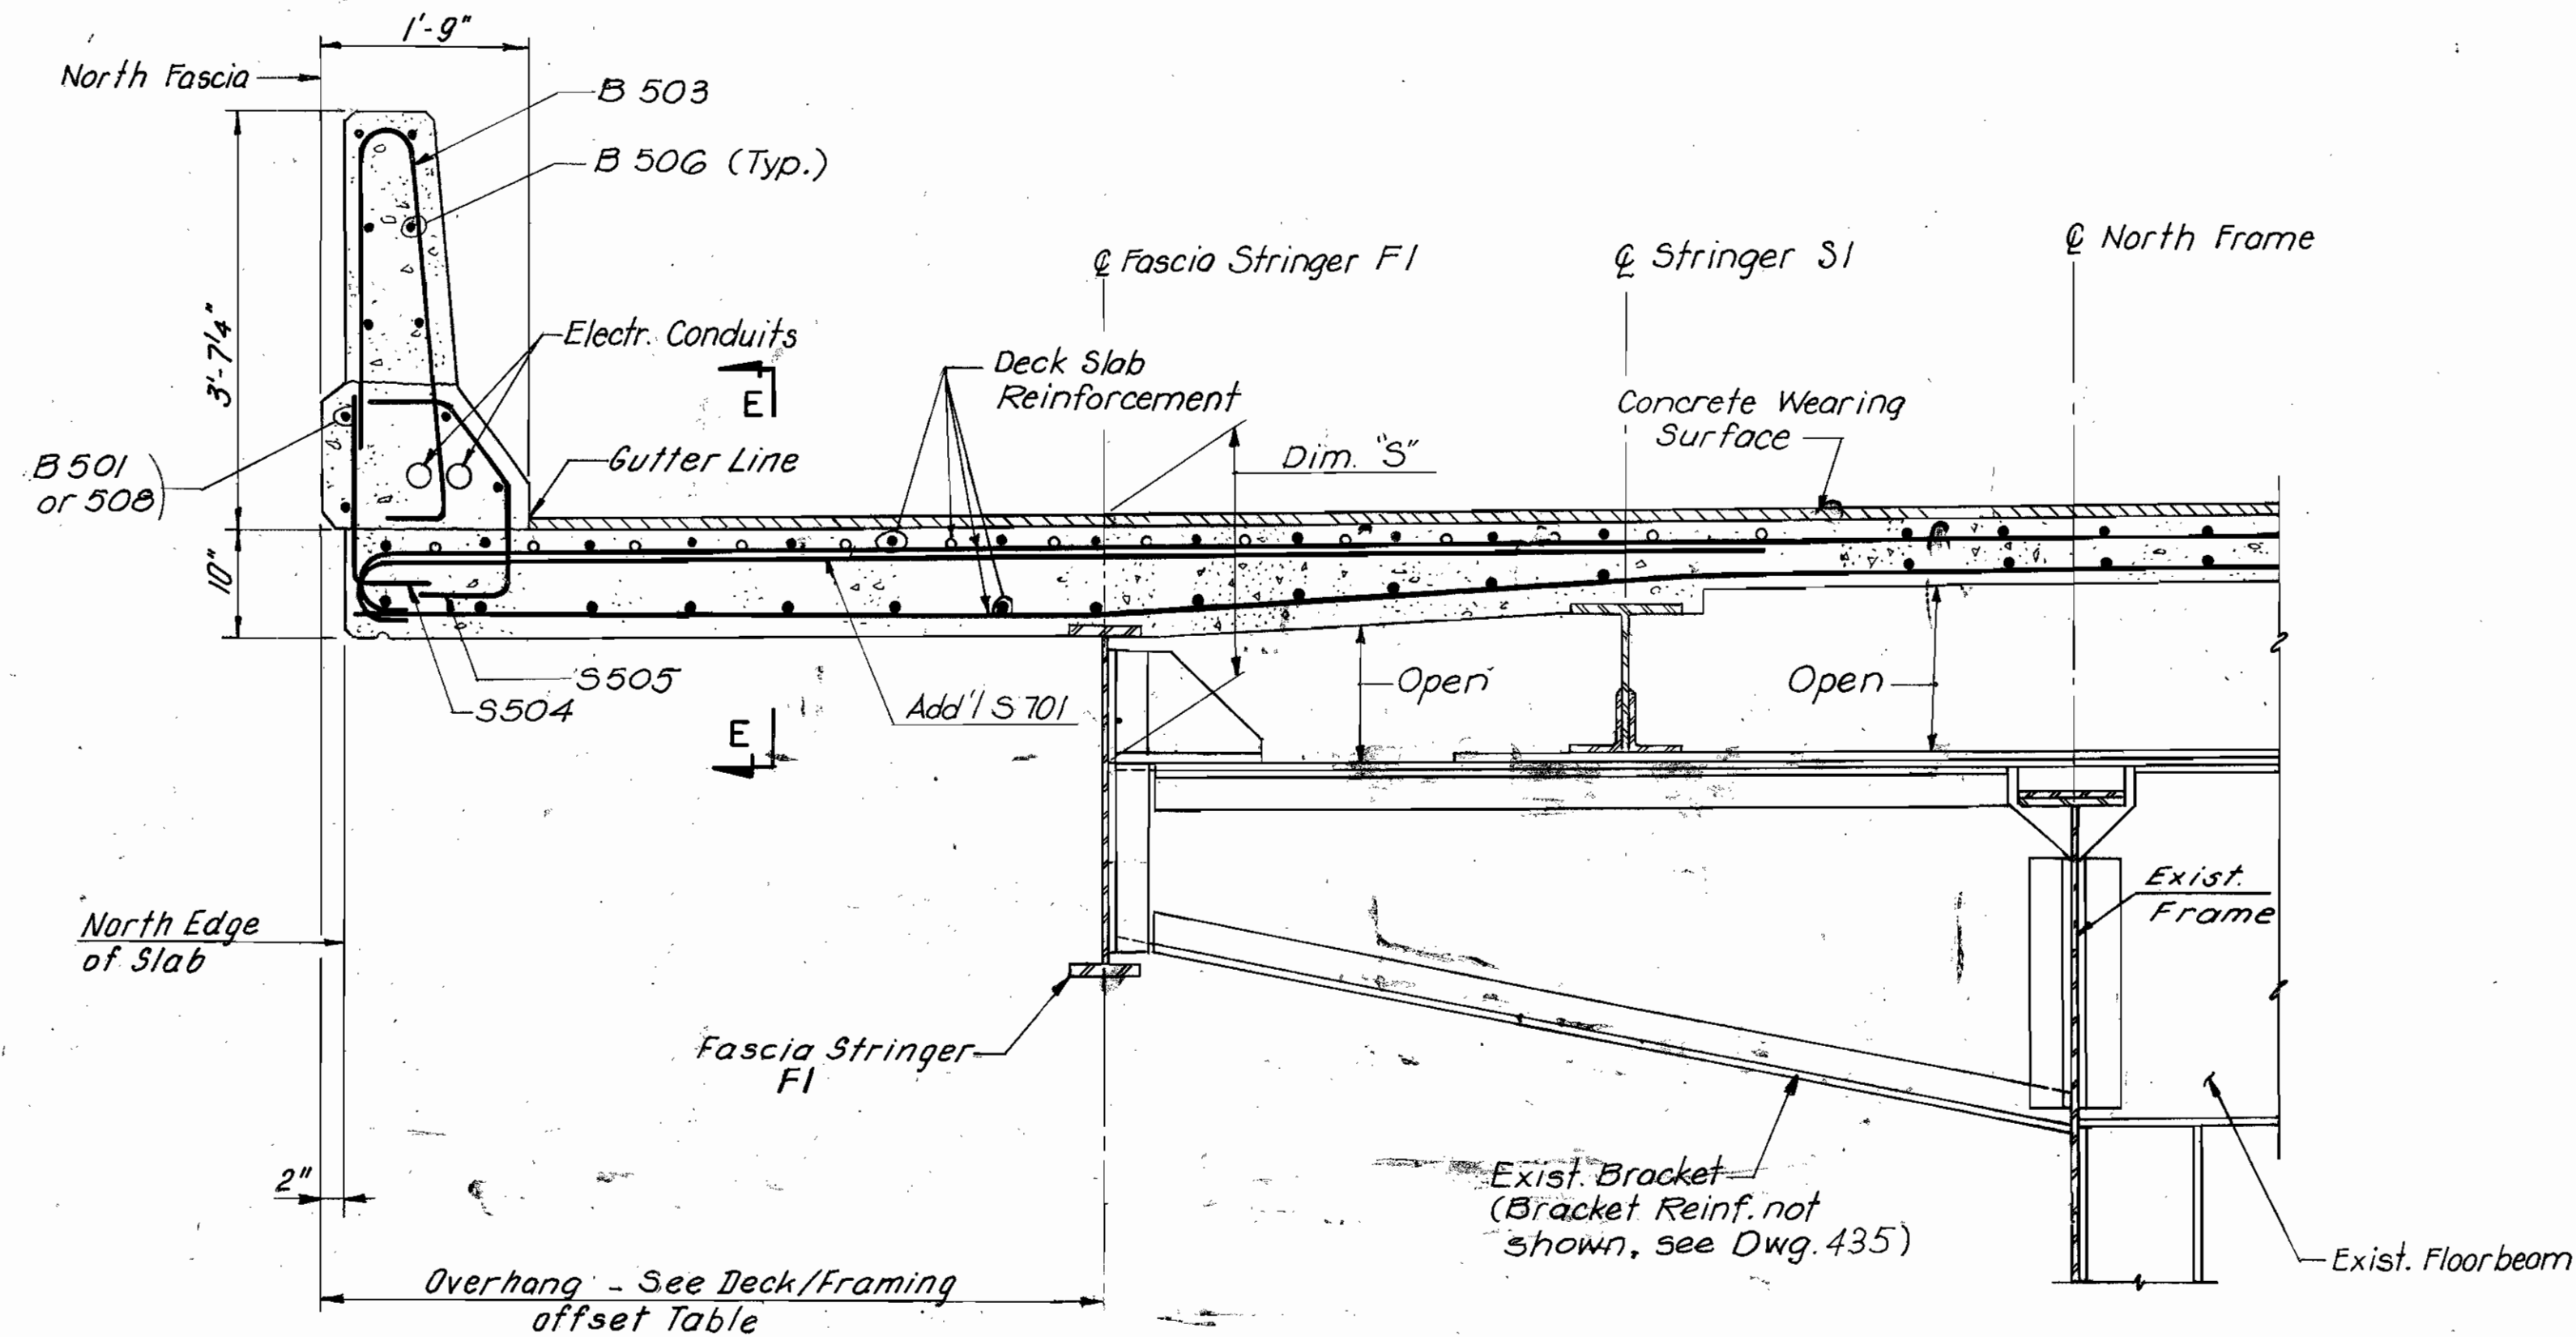


DECK SLAB DETAILS AT FASCIA

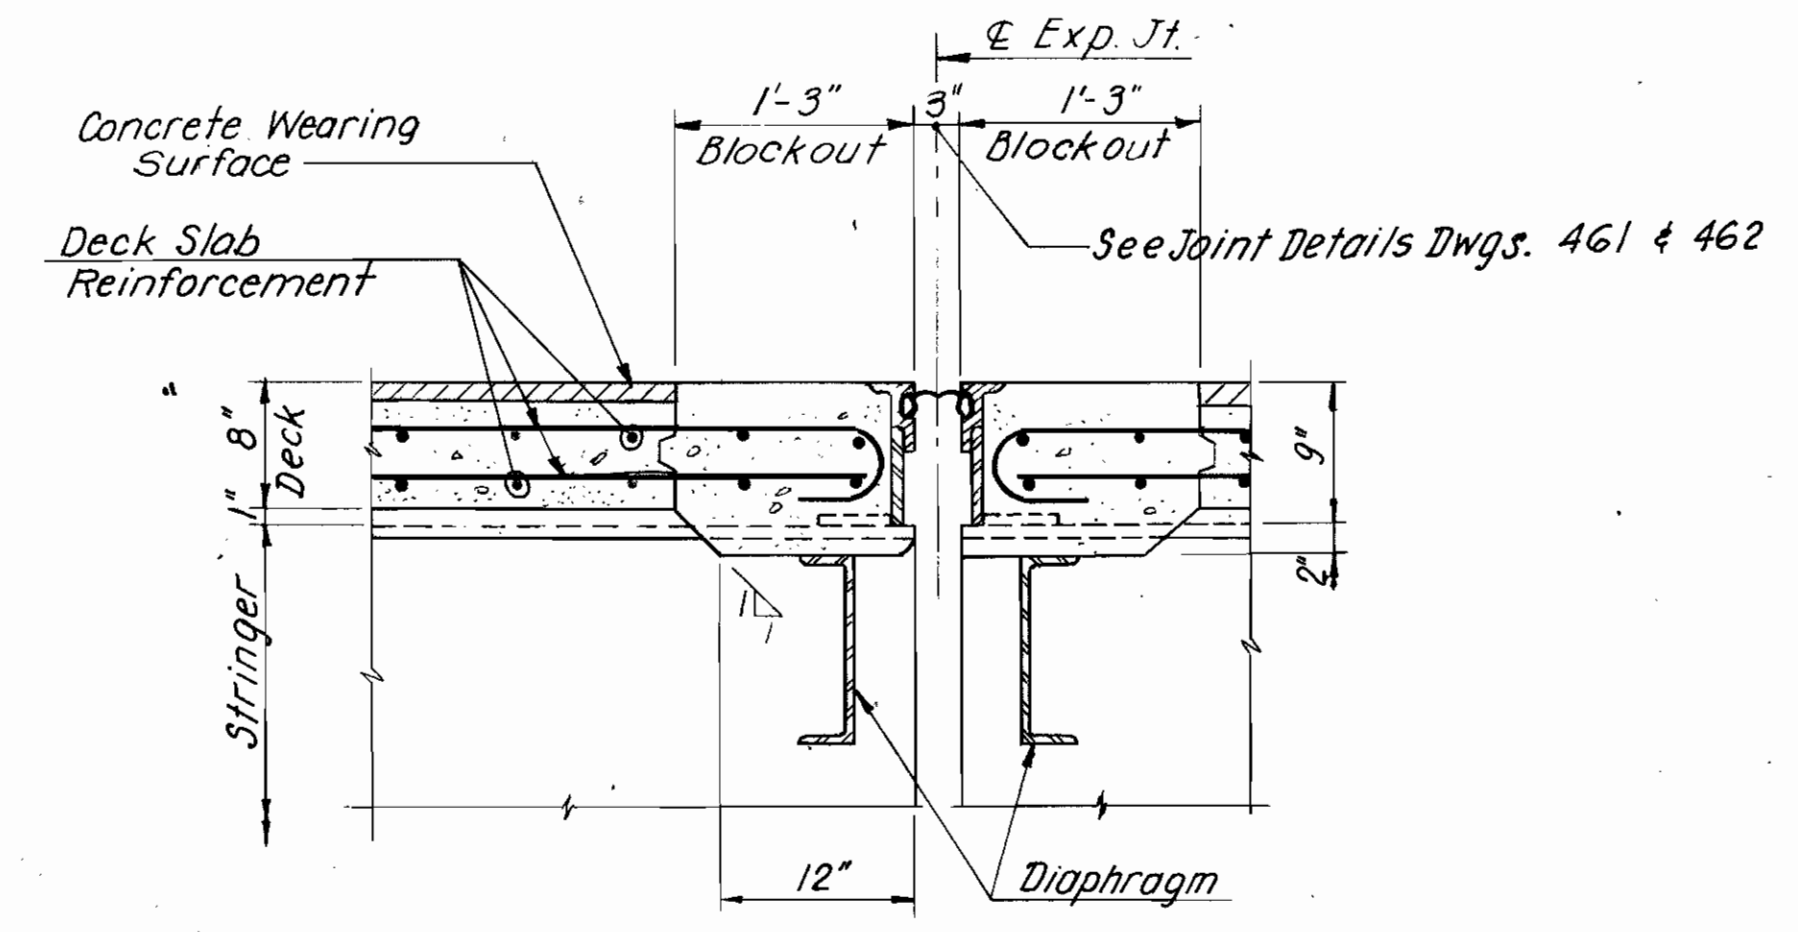


Note: Floor Beam not shown.

SECTION J1 - J1

NOTE -  
All reinforcing bars for Lakefront Trestle shall be prefixed LT.

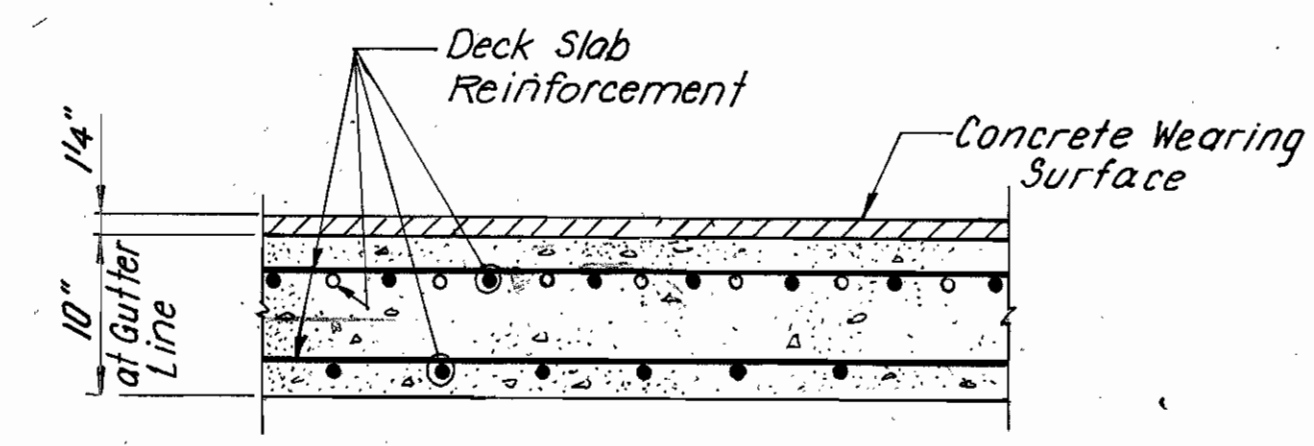

SECTION E-E

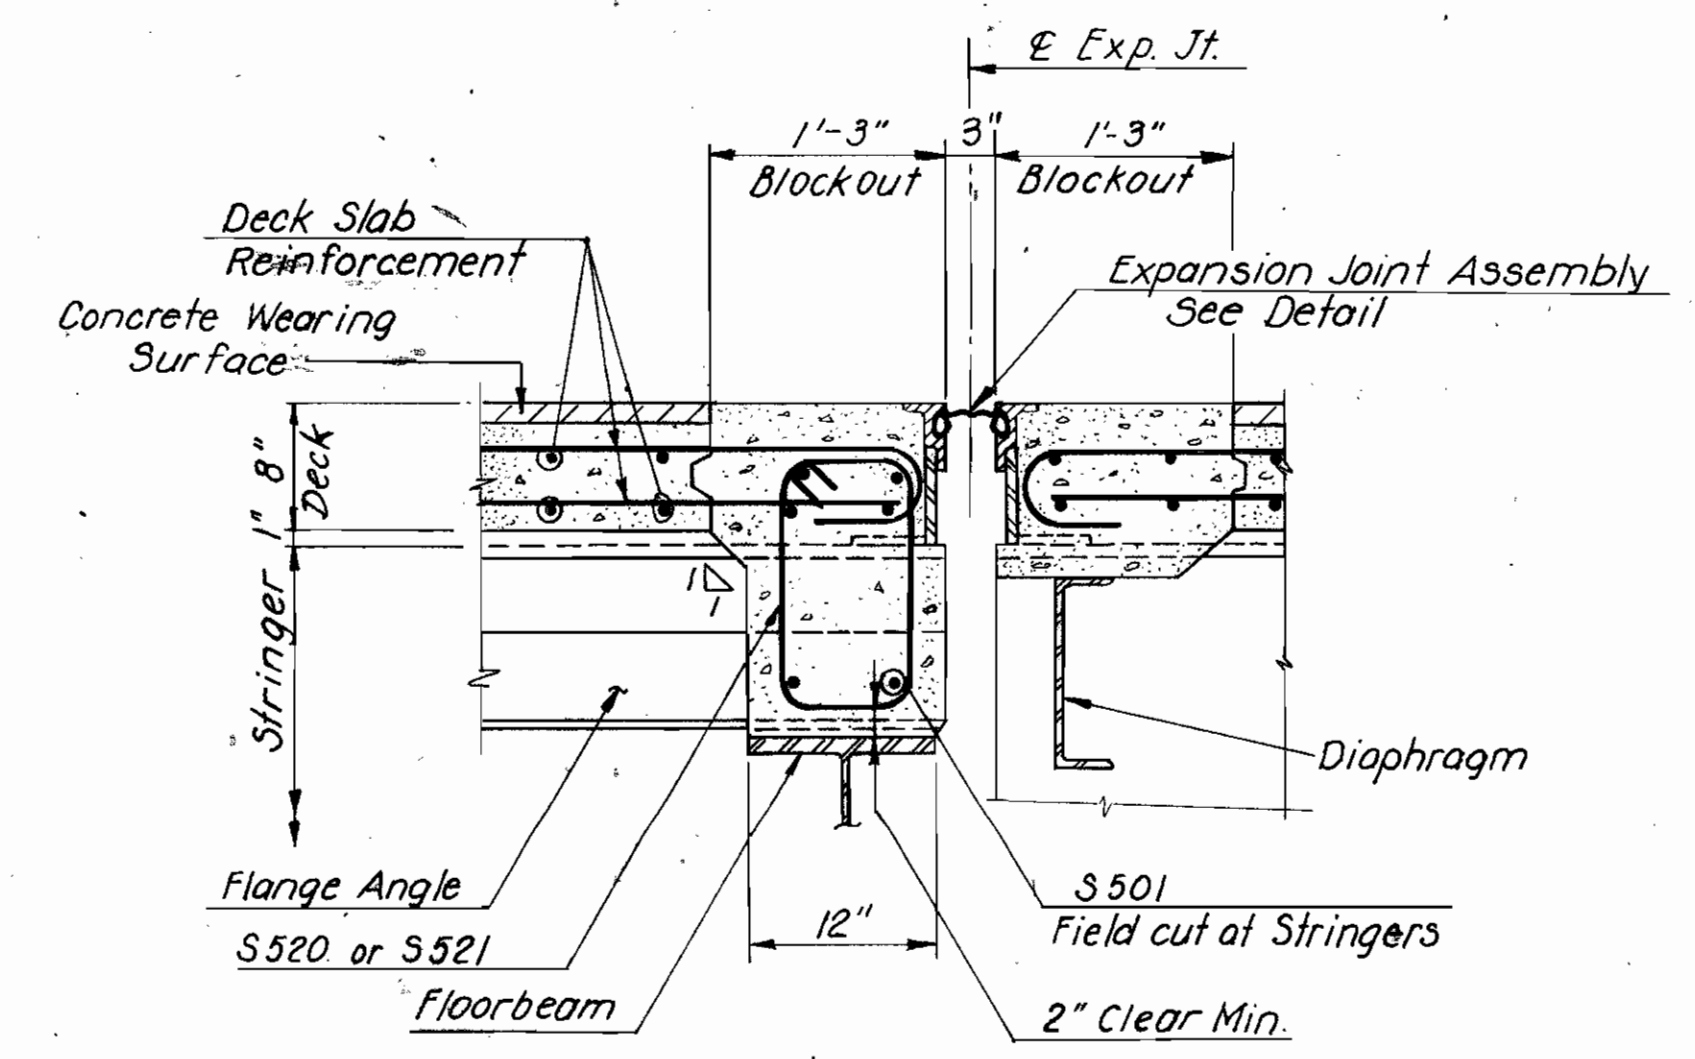

SECTION J2 - J2






REFERENCES	DWG. NO.
Deck Slab Reinforcement	452 thru 455
Deck Sections	456 & 457
Existing & Proposed Framing Plan	427 & 428
Expansion Joint	461 & 462
Location of Sections J1-J1 & J2-J2	452 thru 455
Stay-in-place forms	(AB) G9A


(AB) - As Built

PAVLO ENGINEERING CO., P.C. NEW YORK, NEW YORK			
CUYAHOGA COUNTY ENGINEER CLEVELAND OHIO			
MAIN AVENUE BRIDGE CITY OF CLEVELAND			
BRIDGE OVER THE CUYAHOGA RIVER VALLEY			
EAST APPROACH - LAKEFRONT TRESTLE			
DECK SLAB DETAILS - I			
BRIDGE NO. 193	REPORT NO. 7119	DATE: OCT. 28, 1989	
NO. B-136			458 71
DESIGN B.G.	DRAWN T.C.	CHECKED D.G./E.G.	REVISED TO AS BUILT AS BUILT 2/94



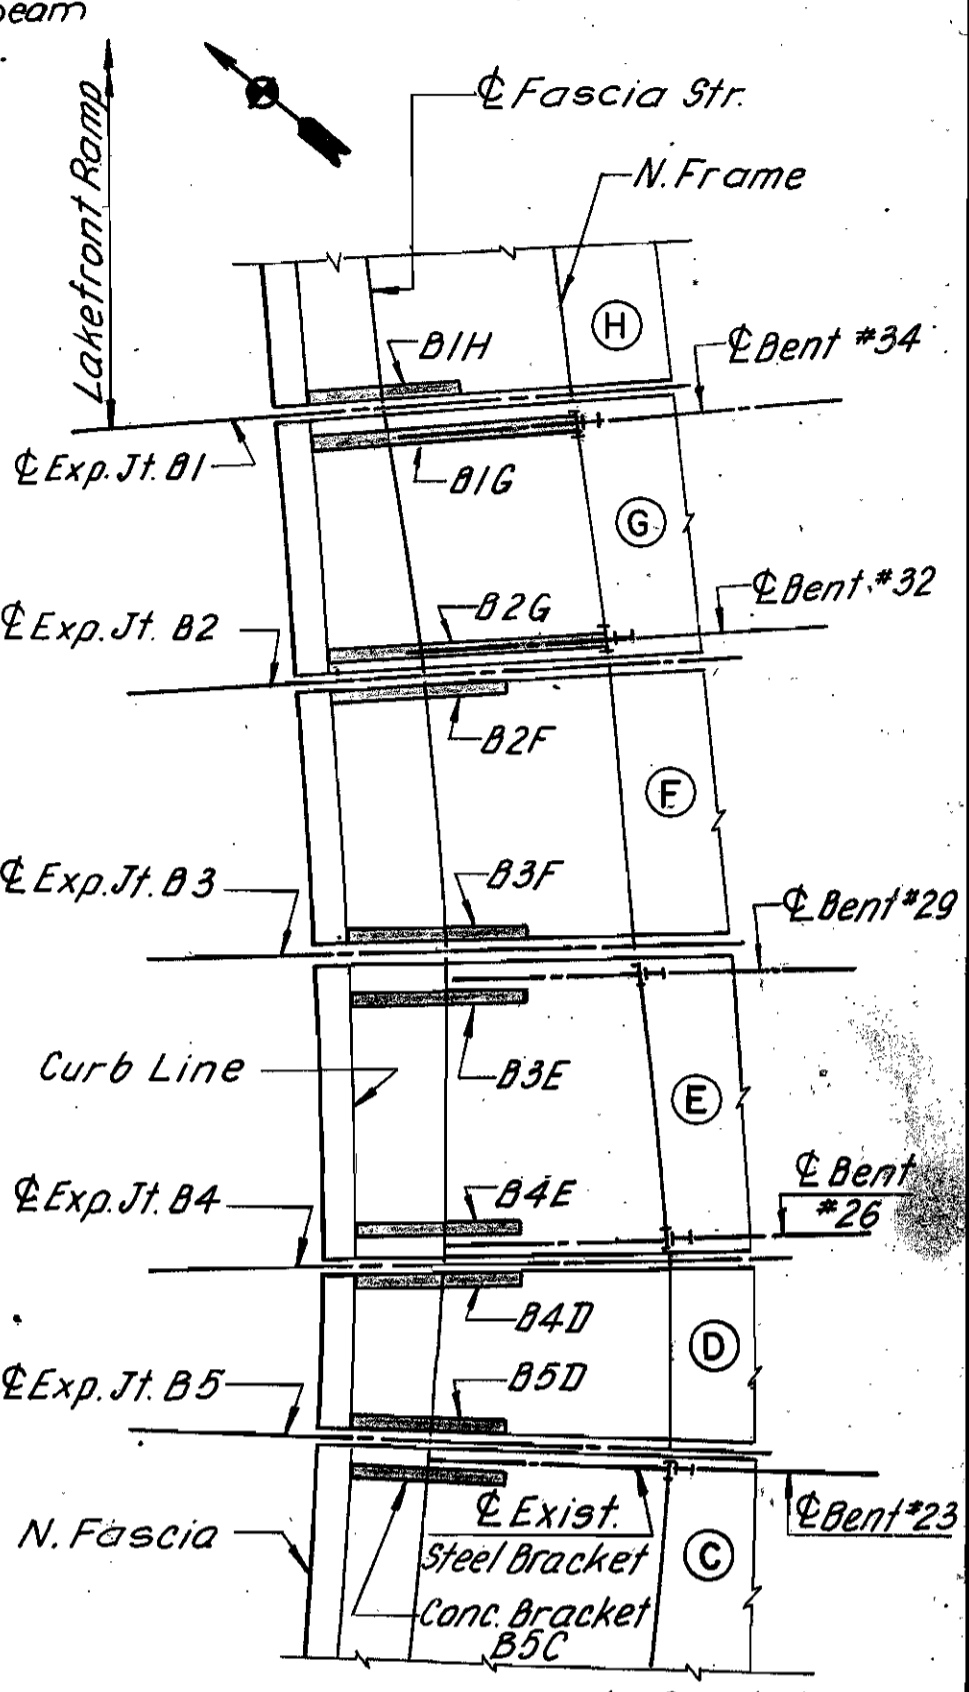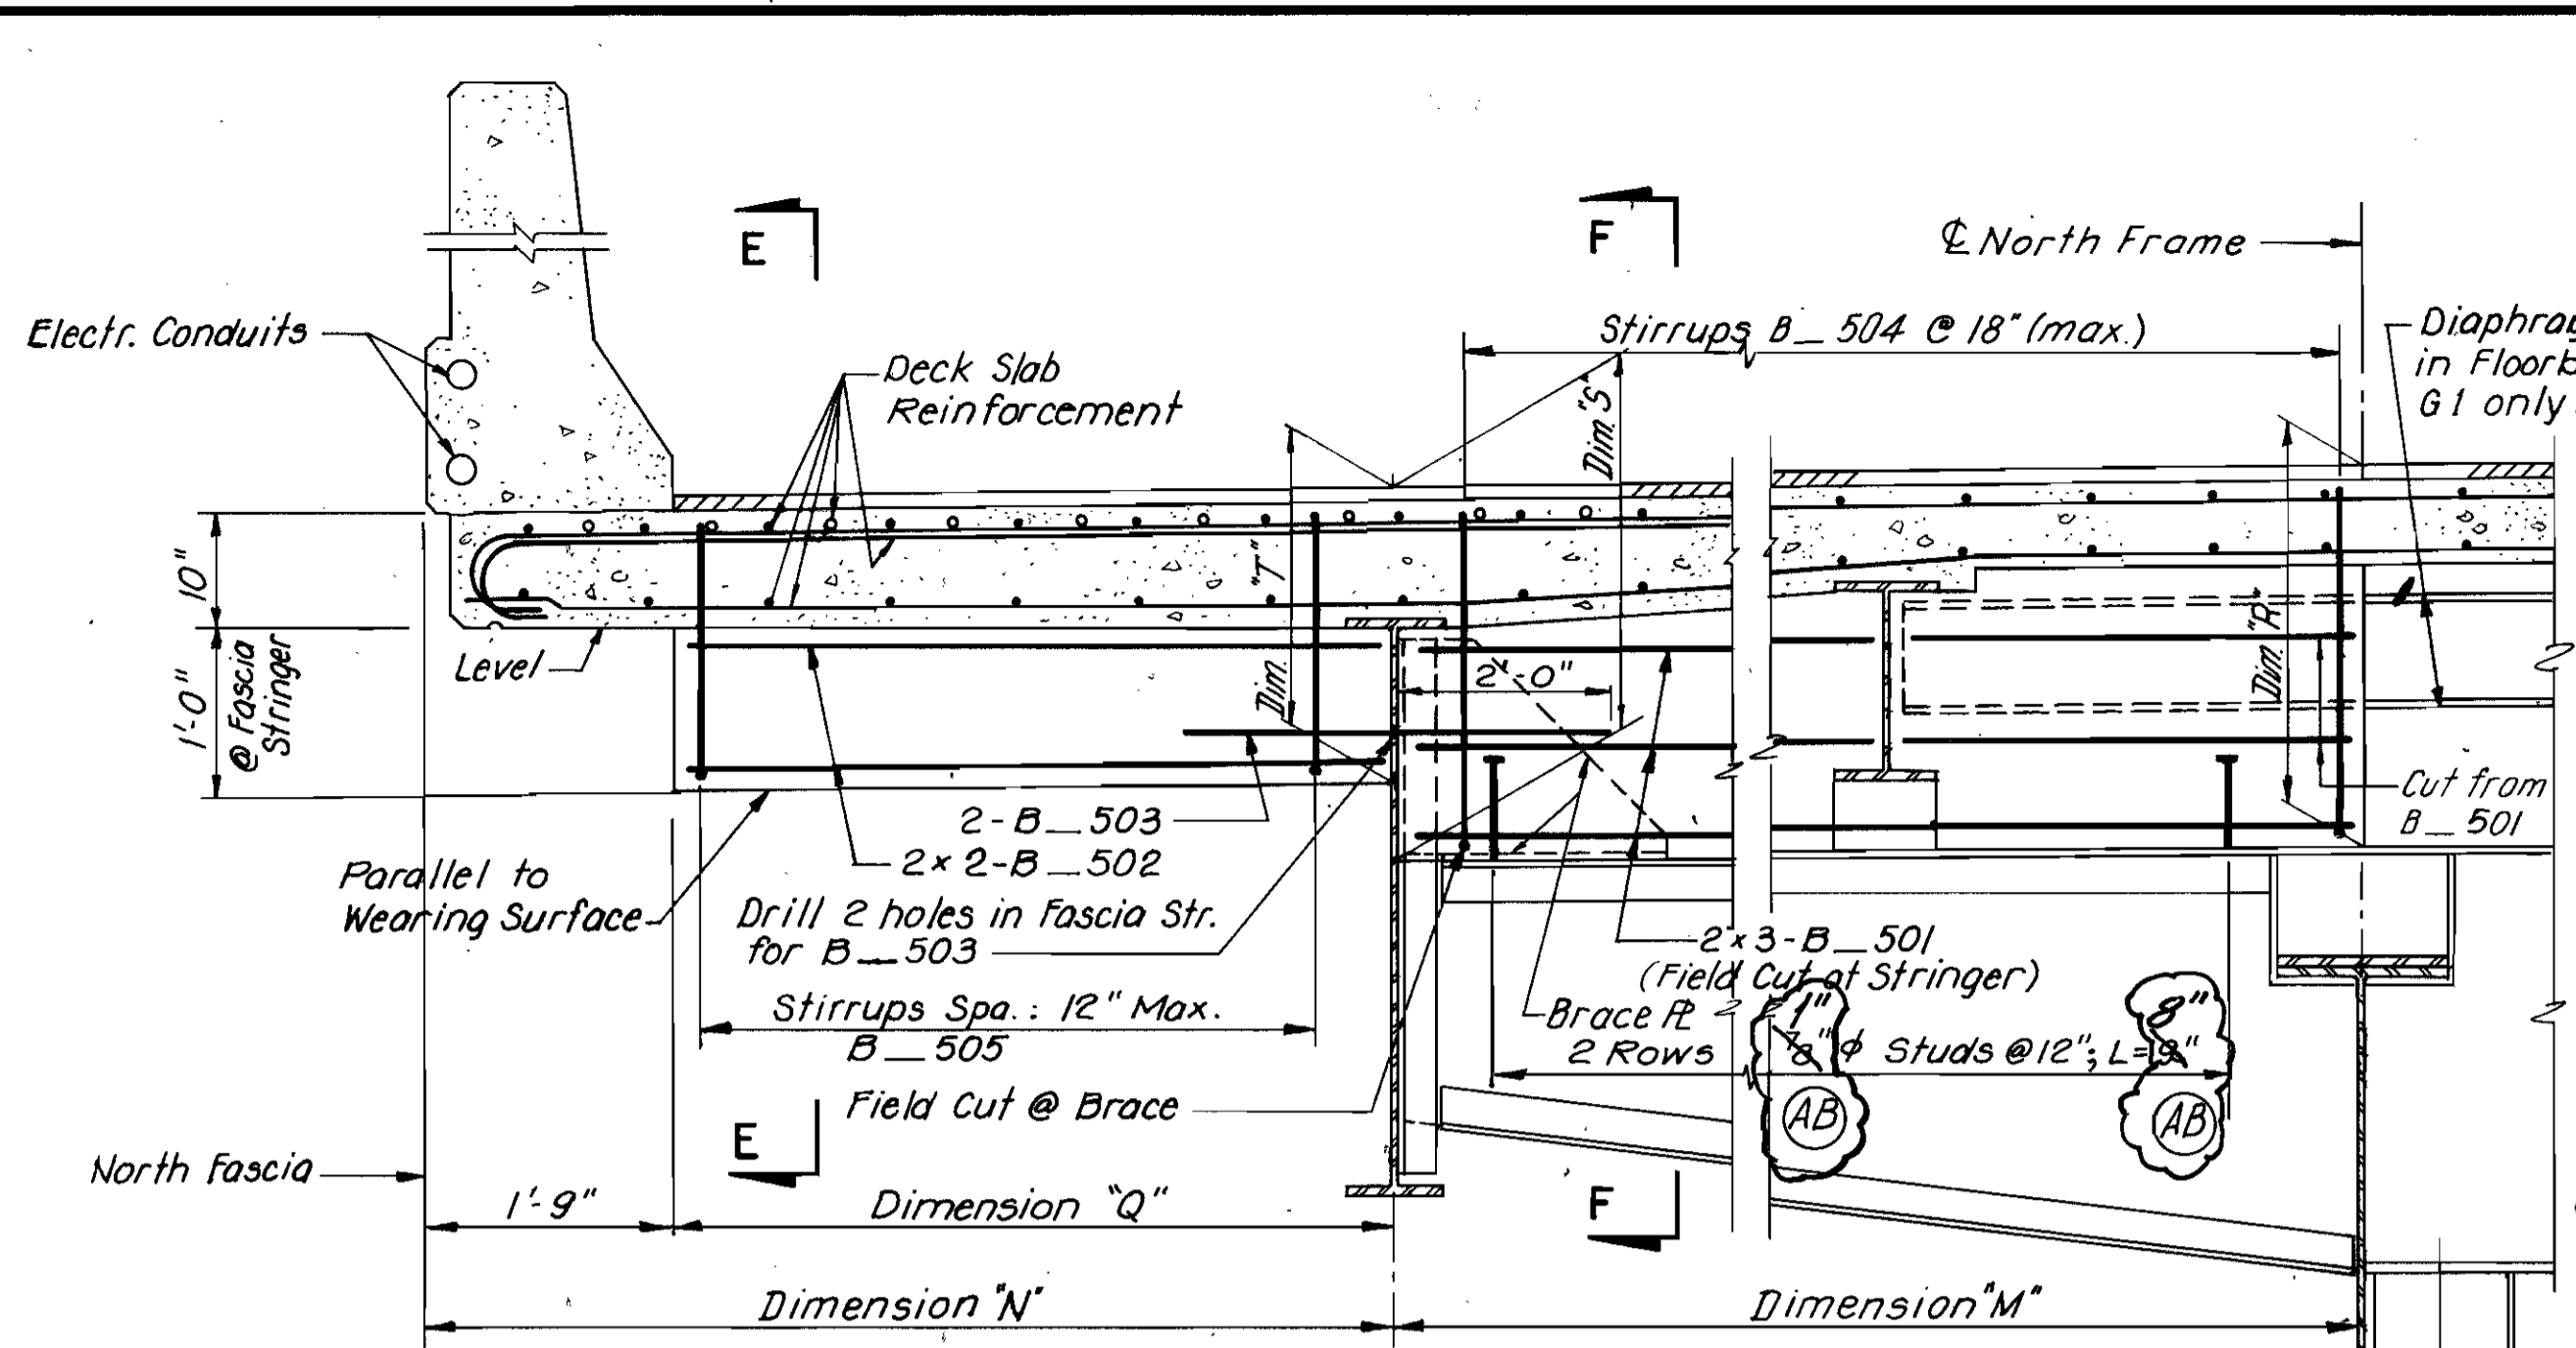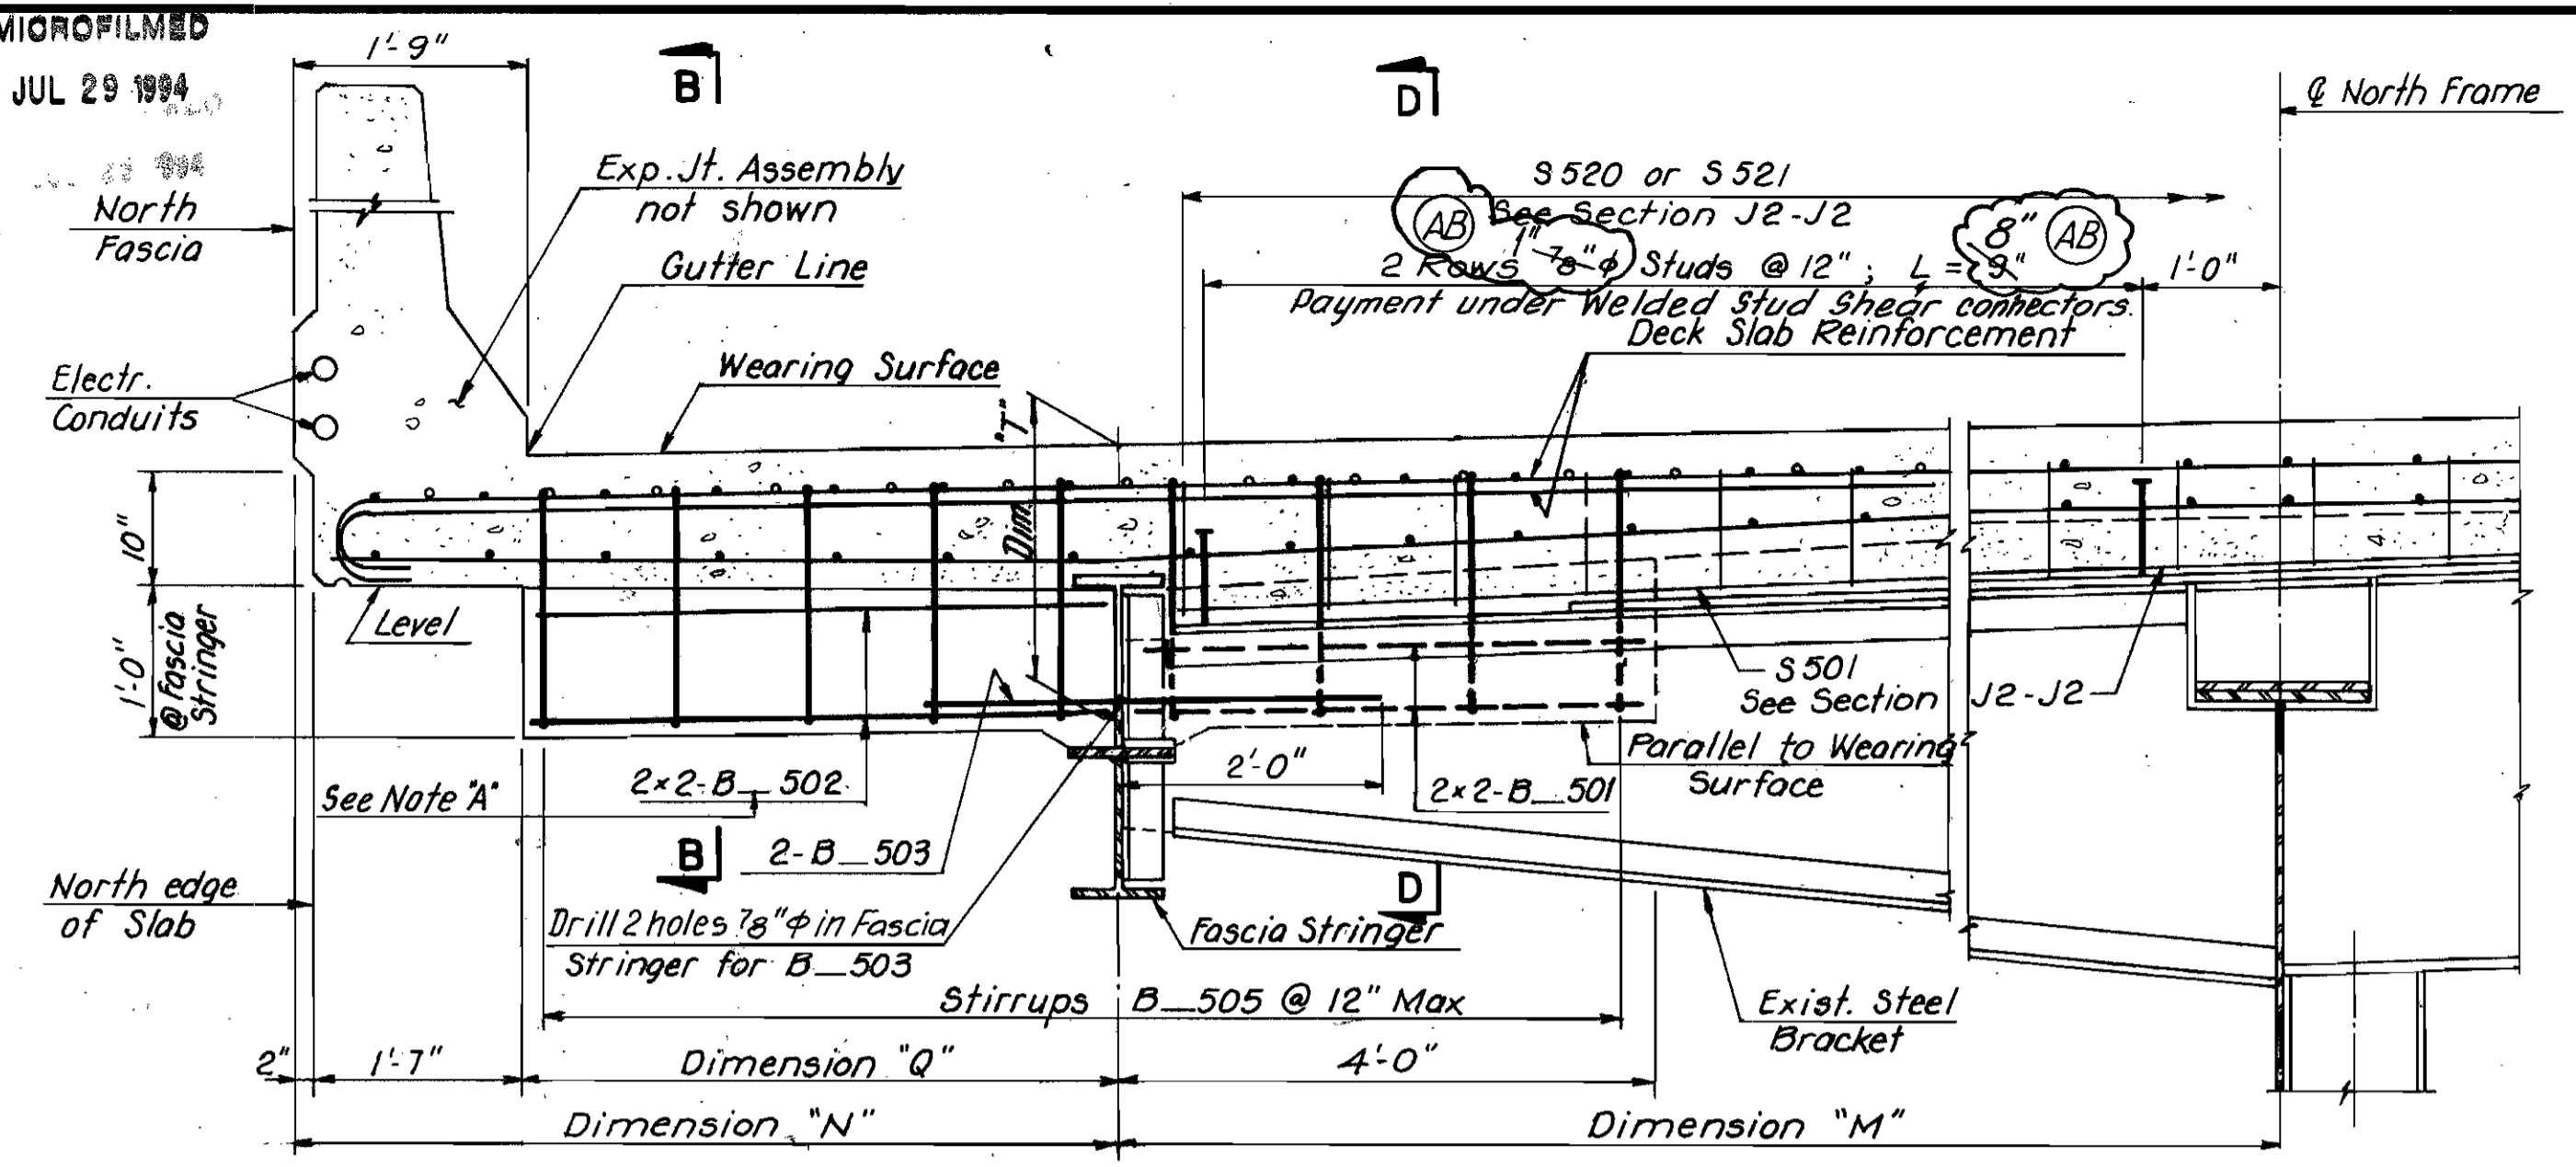


**BRACKETS B3E, B4E & B5C**  
(Fixed End)

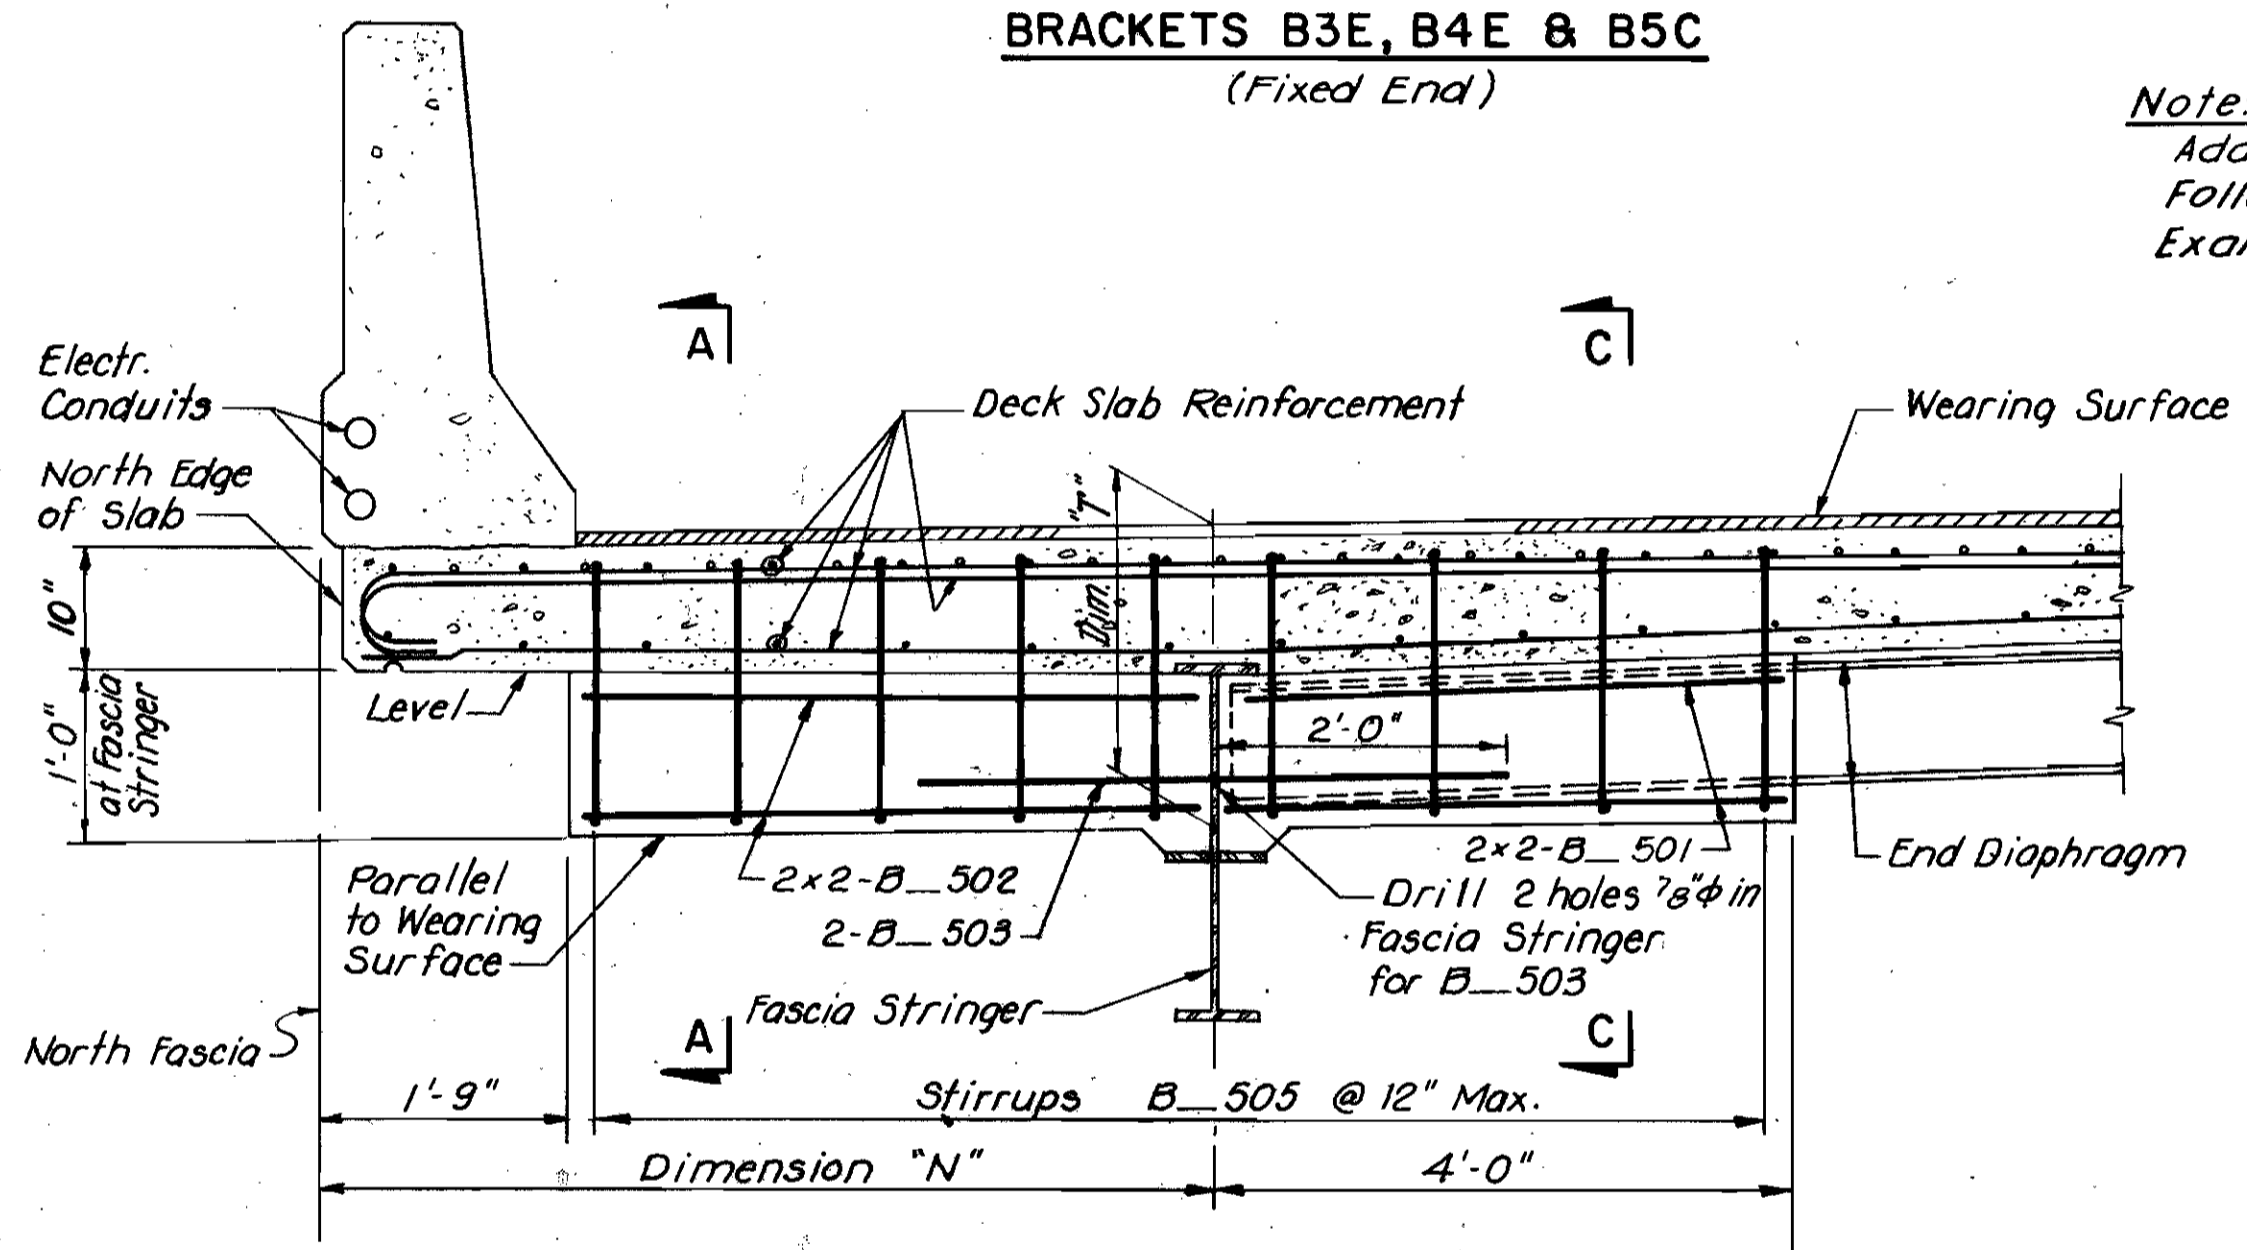

Note "A"  
Add Number of Bracket to Bar Mark Following Prefix B.  
Example: B3E 502, B5C 502; etc.



**BRACKETS B1G AND B2G**  
(Fixed End)  
Bracket B1G shown

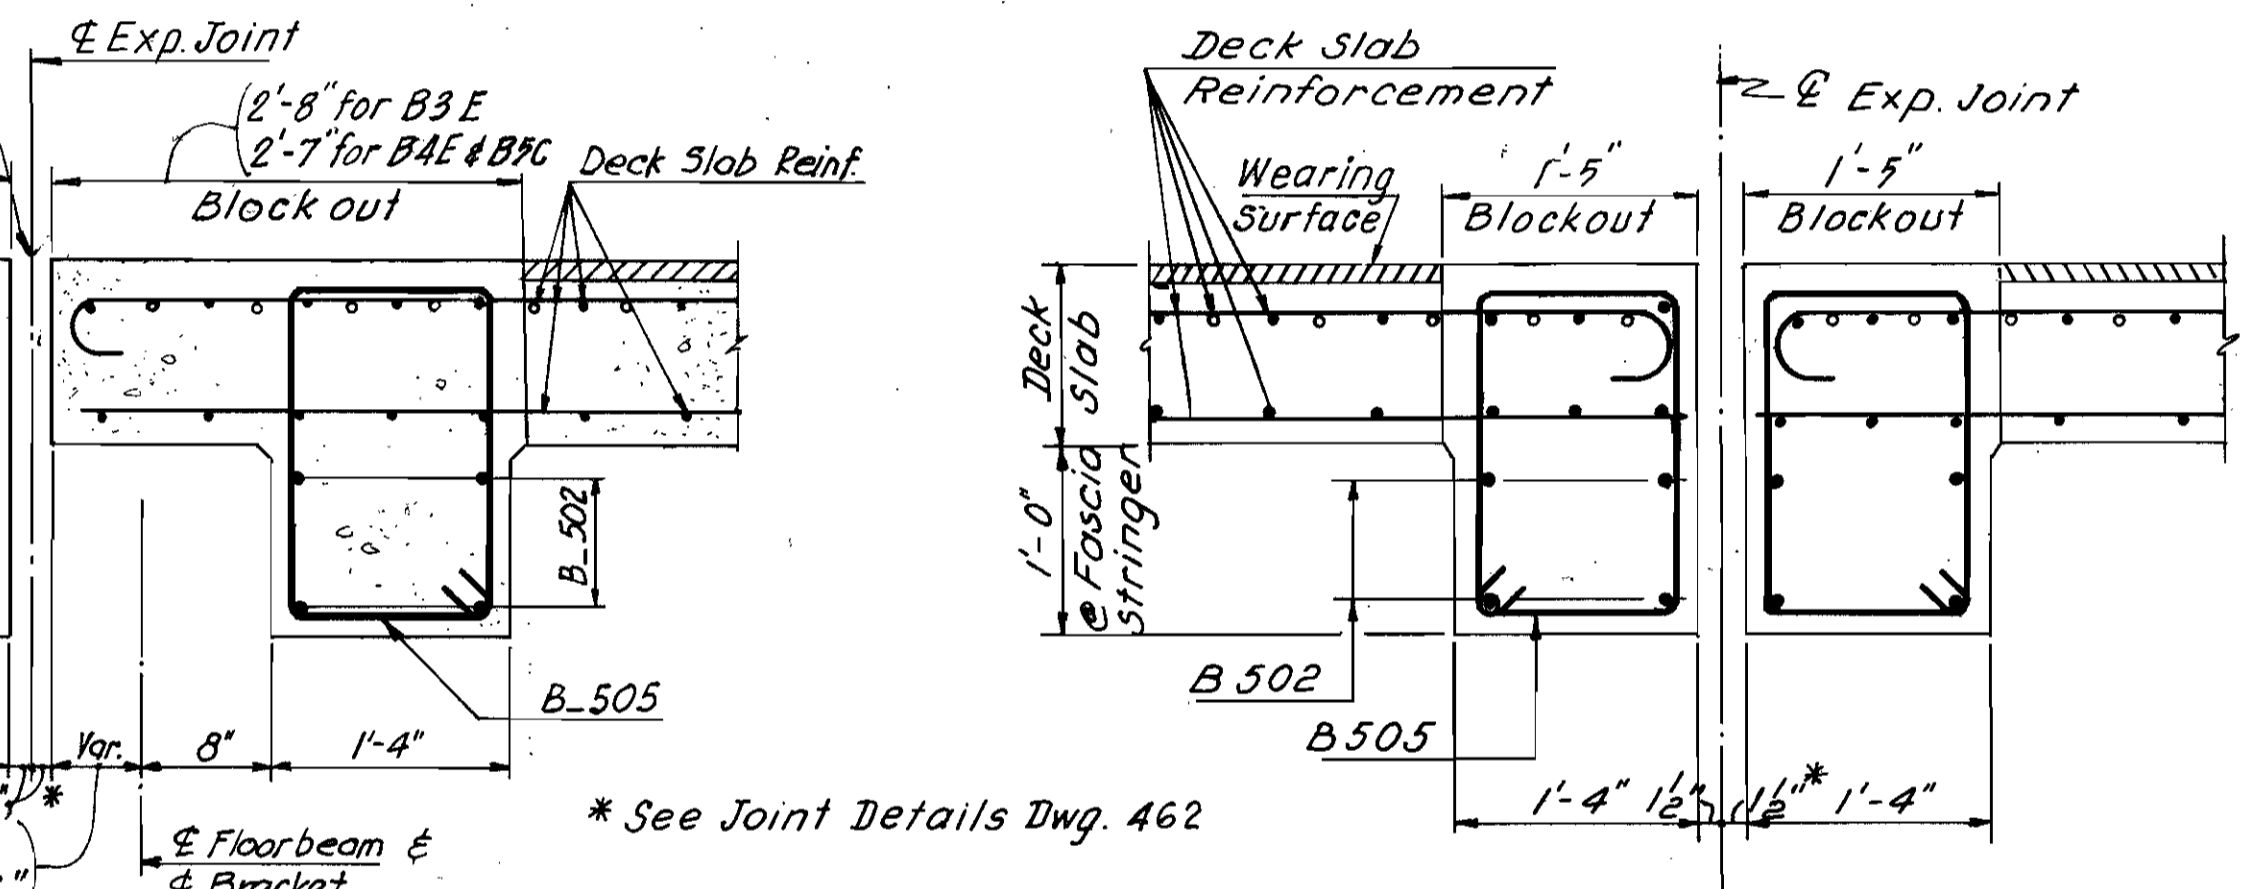

**BRACKETS B2F, B3F, B4D & B5D**  
(Expansion End)

BRACKET NUMBER	M (Ft)	N (Ft)	Q (Ft)	R (Ft)	S (Ft)	T (Ft)
B 5C	12.57	5.65	3.90	—	—	2.10
B 5D	—	—	—	—	—	2.10
B 4D	11.73	6.19	4.44	—	—	2.12
B 4E	—	—	—	—	—	2.12
B 3E	10.40	7.10	5.35	—	—	2.15
B 3F	—	—	—	—	—	2.15
B 2F	9.63	6.88	5.13	—	—	2.02
B 2G	9.63	6.88	5.13	2.83	3.08	2.02
B 1G	9.64	5.29	3.54	2.58	2.71	2.01

NOTE "B"  
Blast clean parts of steel to be embedded prior to placing concrete.

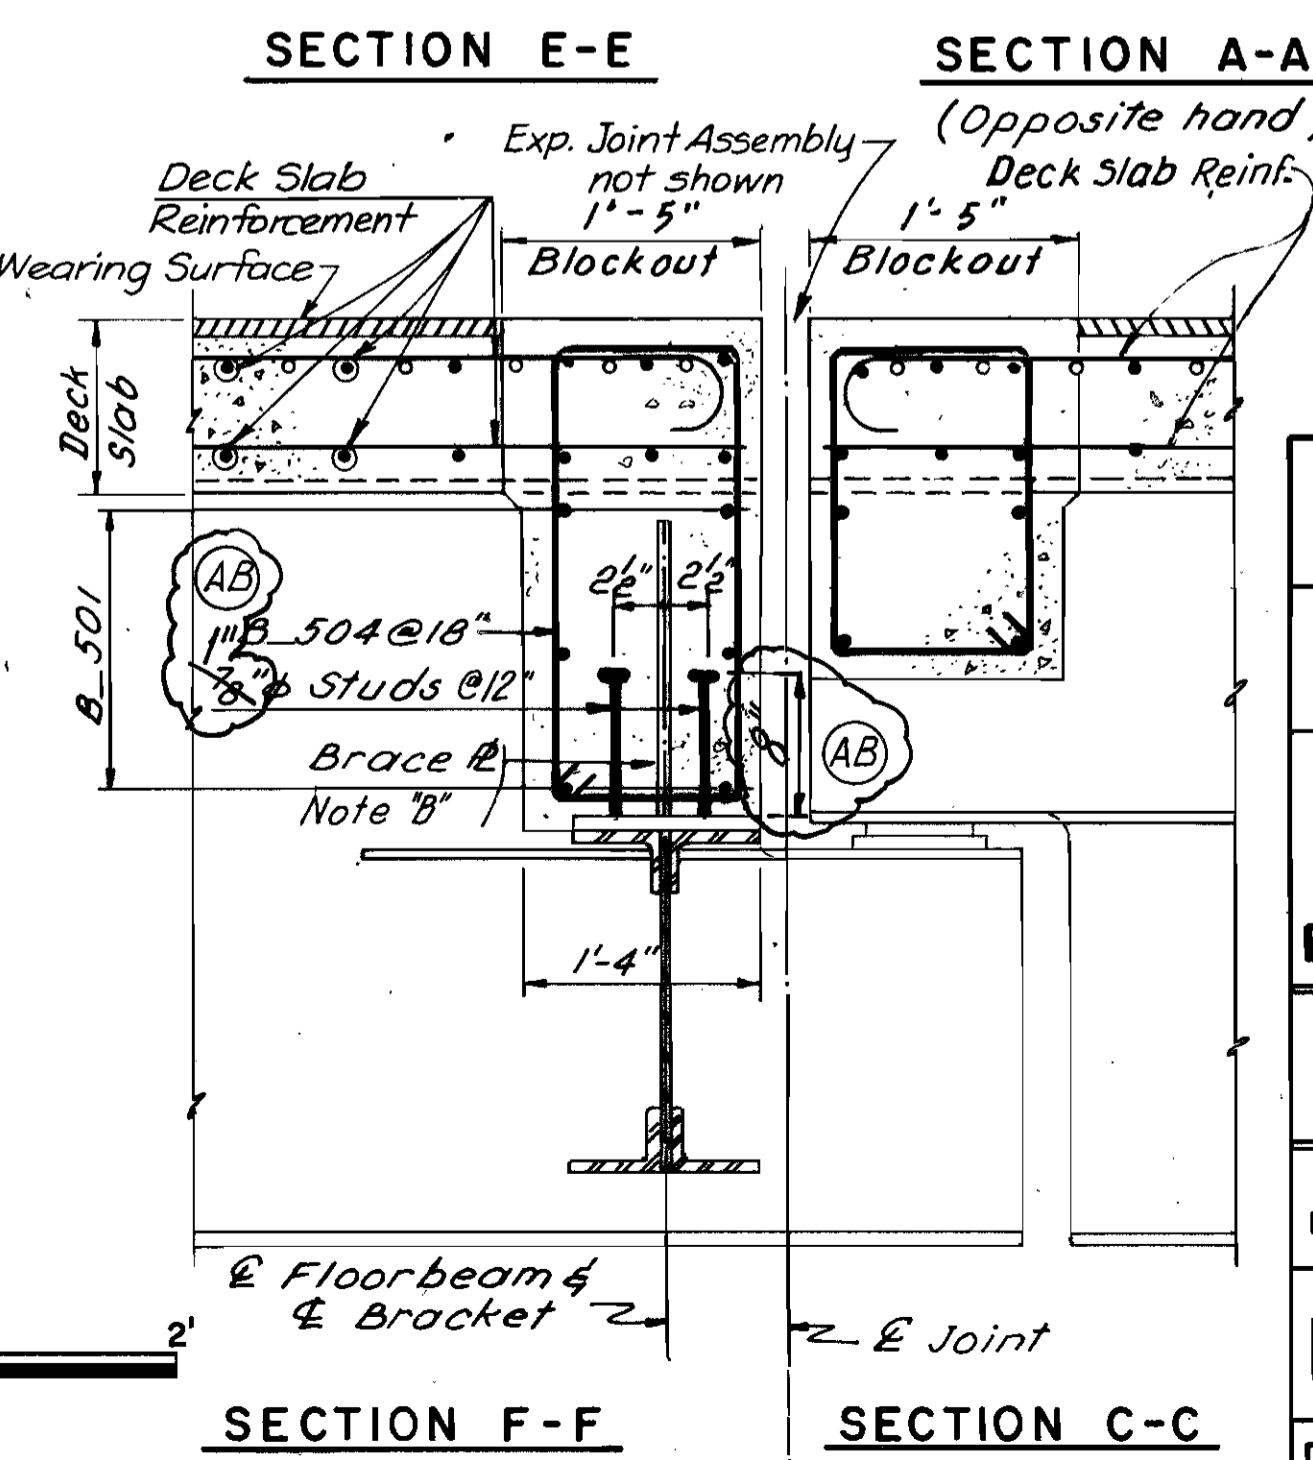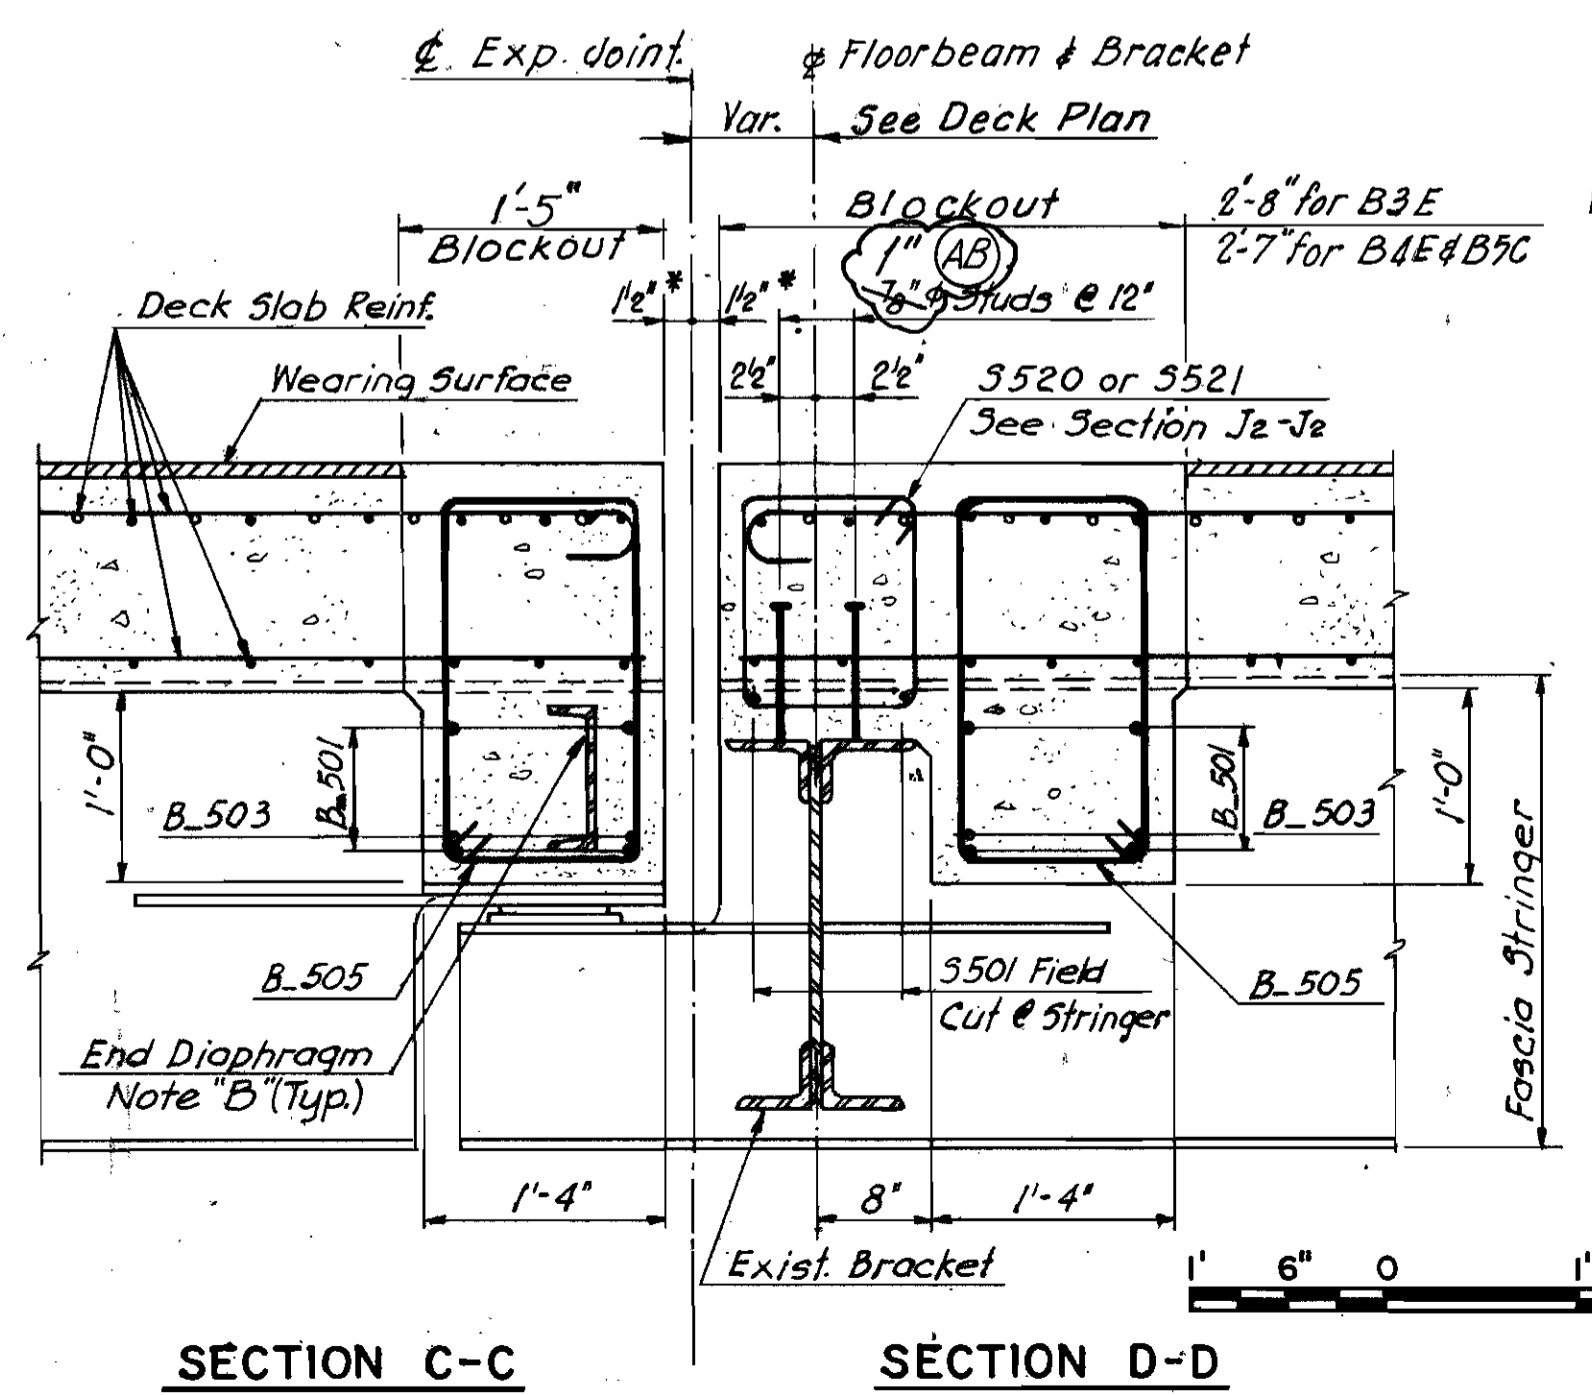

REFERENCES	DWG. NO.
Deck Slab Reinforcement	452-455
Deck Sections	456, 457
Framing Plan	427, 428
Section J2-J2	458
Joint Details	462
Stay-in-place forms	G9A

PAVLO ENGINEERING CO., P.C.  
NEW YORK, NEW YORK

**CUYAHOGA COUNTY ENGINEER**  
CLEVELAND OHIO


**MAIN AVENUE BRIDGE**  
CITY OF CLEVELAND  
BRIDGE OVER THE CUYAHOGA RIVER VALLEY

EAST APPROACH LAKEFRONT TRESTLE  
**DECK SLAB DETAILS - 2**

BRIDGE NO. 193 REPORT NO. 7119 DATE: OCT. 28, 1989

**NO. B-136** 459  
71

DESIGN	DRAWN	CHECKED	REVISED TO AS BUILT
B.G.G.	A.D./V.K.	E.G.	AS BUILT 2/94

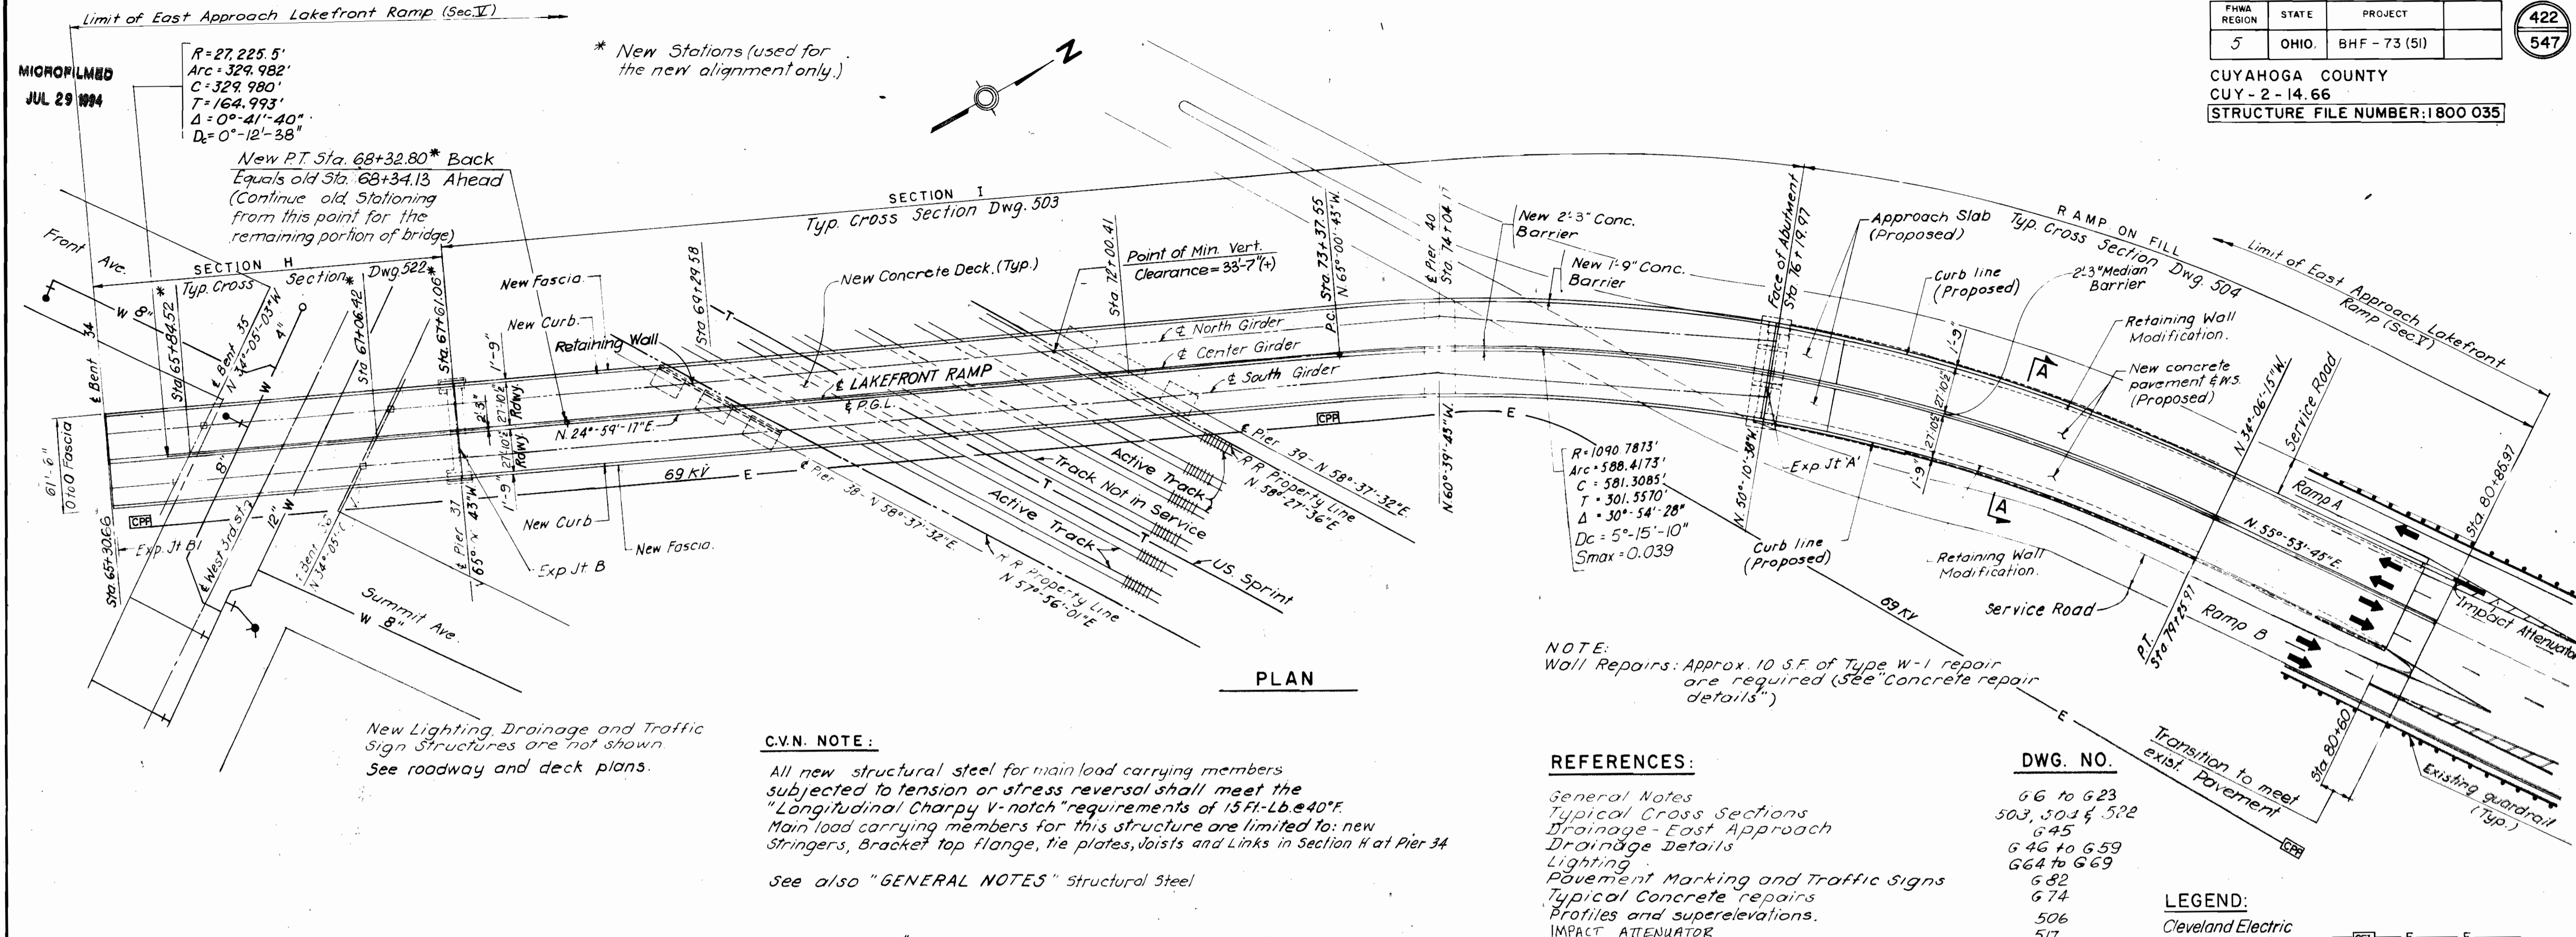

PLAN

NOTE:  
Wall Repairs: Approx. 10 S.F. of Type W-1 repair are required (See "Concrete repair details")

REFERENCES:

- General Notes
- Typical Cross Sections
- Drainage - East Approach
- Drainage Details
- Lighting
- Pavement Marking and Traffic Signs
- Typical Concrete Repairs
- Profiles and Superelevations.
- IMPACT ATTENUATOR

DWG. NO.


- G 6 to G 23
- 503, 503 & 522
- G 45
- G 46 to G 59
- G 64 to G 69
- G 82
- G 74
- 506
- 517

LEGEND:

- Cleveland Electric Illuminating Co. — E — E
- East Ohio Gas — G — G
- Ohio Bell Tel. Co. — T — T
- Cleveland Public Power Co. — C.P.P. — E — E
- Water — W — W
- Sewers — S — S
- Manhole — •
- Overhead Electric Lines — C.E.I. — EO — EO
- Utility Poles — O

C.V.N. NOTE:

All new structural steel for main load carrying members subjected to tension or stress reversal shall meet the "Longitudinal Charpy V-notch" requirements of 15 Ft.-Lb. @ 40°F. Main load carrying members for this structure are limited to: new stringers, bracket top flange, tie plates, joists and links in Section H at Pier 34. See also "GENERAL NOTES" Structural Steel.

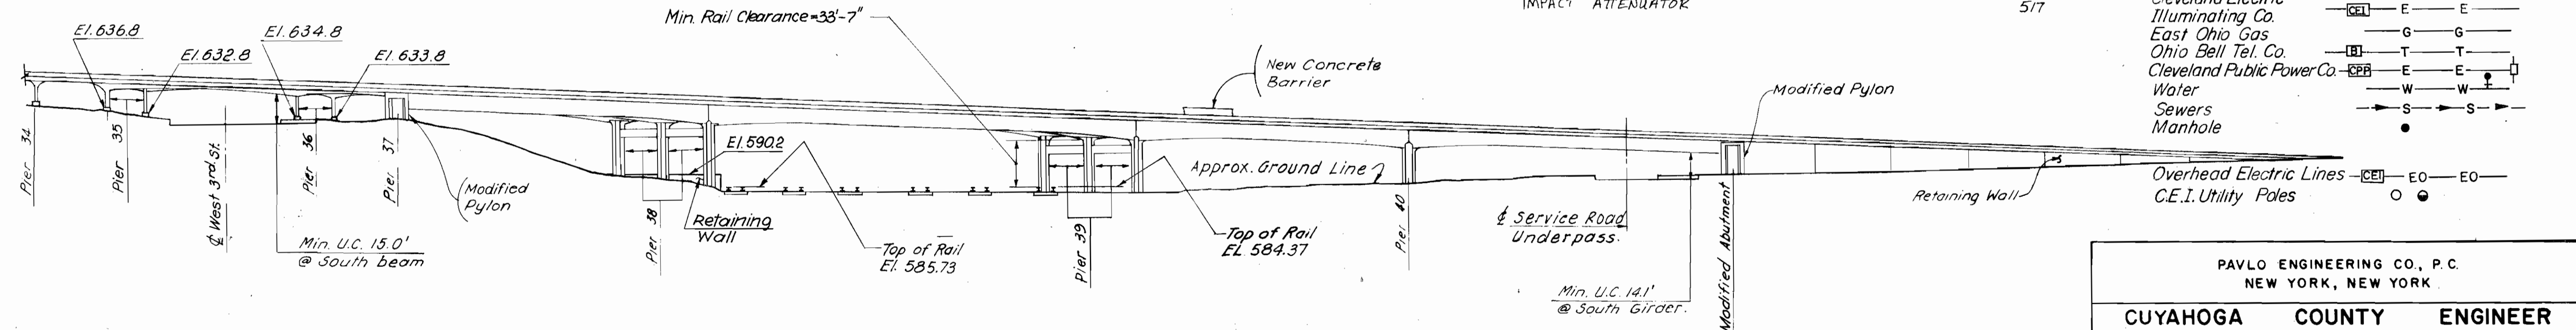

EAST APPROACH-LAKEFRONT RAMP (SECTION V)  
SCOPE OF REHABILITATION WORK:

ELEVATION

THE SECTION CONSISTS OF 1089.3 FEET OF A FOUR LANE, DIVIDED, STEEL VIADUCT MADE UP OF A THREE SPAN STEEL FRAME TRESTLE, FOUR CONTINUOUS STEEL GIRDER SPANS, AND 466 FEET OF FOUR LANE DIVIDED PAVEMENT ON FILL BETWEEN RETAINING WALLS.

THE WORK INCLUDES:

- REMOVAL OF EXISTING I-BEAM-LOK DECKING, SIDEWALKS, RAILINGS, FASCIA PLATES, STRINGERS, IN SECTION H.
- REMOVAL AND REPLACEMENT OR REPAIR OF DETERIORATED MEMBERS.
- INSTALLATION OF NEW STEEL STRINGERS AND FASCIA BEAMS.

- CONSTRUCTION OF NEW LIGHTWEIGHT CONCRETE DECK SLABS, BARRIERS, LUMINAIRE SUPPORTS, DRAINAGE DEVICES AND ARMORED JOINTS.
- CONSTRUCTION OF NEW PAVEMENT, MEDIAN AND ALTERATION OF RETAINING WALLS.
- ALTERATION OF THE EAST ABUTMENT AND STONE PYLON.
- FIELD COATING OF SOME EXISTING STRUCTURAL STEEL, AND PAINTING OF NEW STRUCTURAL STEEL.
- INSTALLATION OF NEW LIGHTING SYSTEM AND TRAFFIC SIGNS.
- COATING OF THE EXPOSED EXISTING AND NEW CONCRETE SURFACES.

The Contractor shall make provisions to protect all areas under the bridge used by Pedestrians, vehicles and railroad, from falling debris during removal of the existing superstructure and during erection.





PAVLO ENGINEERING CO., P.C. NEW YORK, NEW YORK			
CUYAHOGA COUNTY ENGINEER CLEVELAND OHIO			
MAIN AVENUE BRIDGE CITY OF CLEVELAND BRIDGE OVER THE CUYAHOGA RIVER VALLEY			
EAST APPROACH-LAKEFRONT RAMP PROPOSED PLAN & ELEVATION			
BRIDGE NO. 193	REPORT NO. 7119	DATE Oct. 23, 1988	
NO B-136			502 46
DESIGN S.H.	DRAWN C.P.J.	CHECKED C.K.D.	REVISED TO AS BUILT AS BUILT 2/94

MICROFILMED  
JUL 29 1994


$R = 27,225.5'$   
 $Arc = 329,982'$   
 $C = 329,980'$   
 $T = 164,993'$   
 $\Delta = 0^\circ - 41' - 40''$   
 $D_c = 0^\circ - 12' - 38''$

\* New Stations (used for the new alignment only.)

New PT Sta. 68+32.80\* Back Equals old Sta. 68+34.13 Ahead (Continue old Stationing from this point for the remaining portion of bridge)

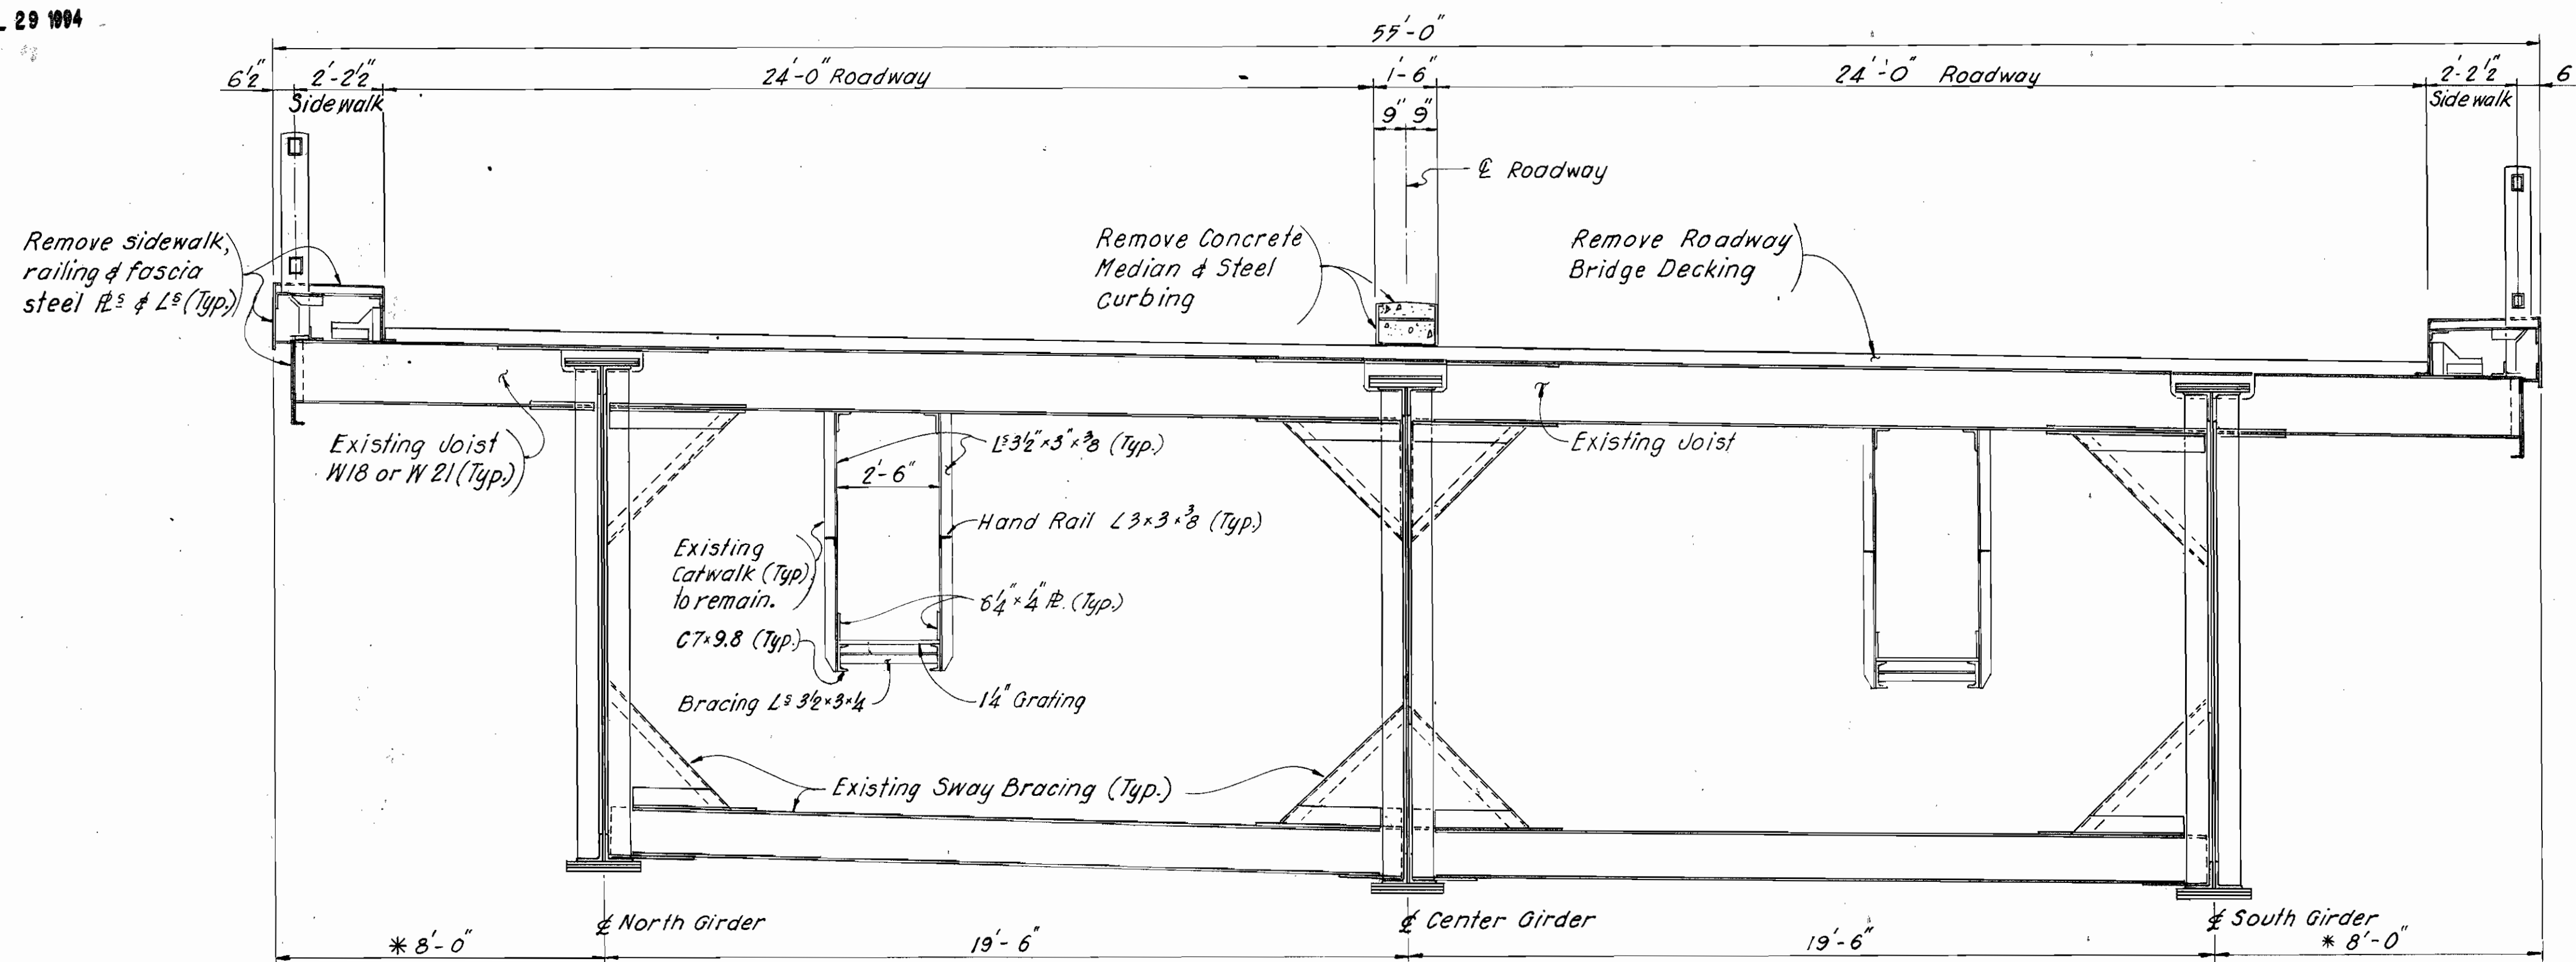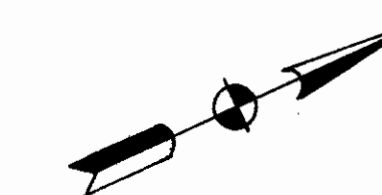


**EXISTING CROSS SECTION (Looking East)**  
(Sway Braced Section shown: see Framing Plan Dwg. 5244 325)  
Bridge Section I - From Sta. 67+61.05 to Sta. 76+19.97

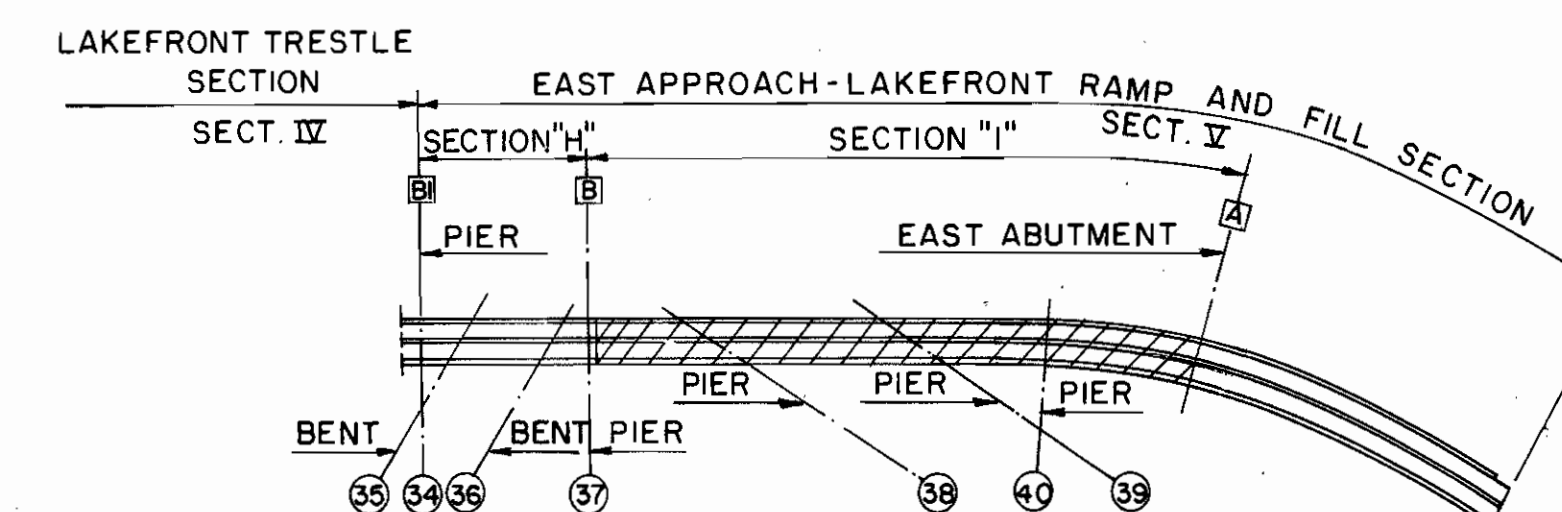

**KEY PLAN**

Note: -For Proposed Bridge Section "H" Typical Cross Section See Dwg. 522.  
-For Ramp on fill Typical Cross Section See Dwg. 504.  
For Existing Section "H" Typical Cross Section See Dwg. 403.

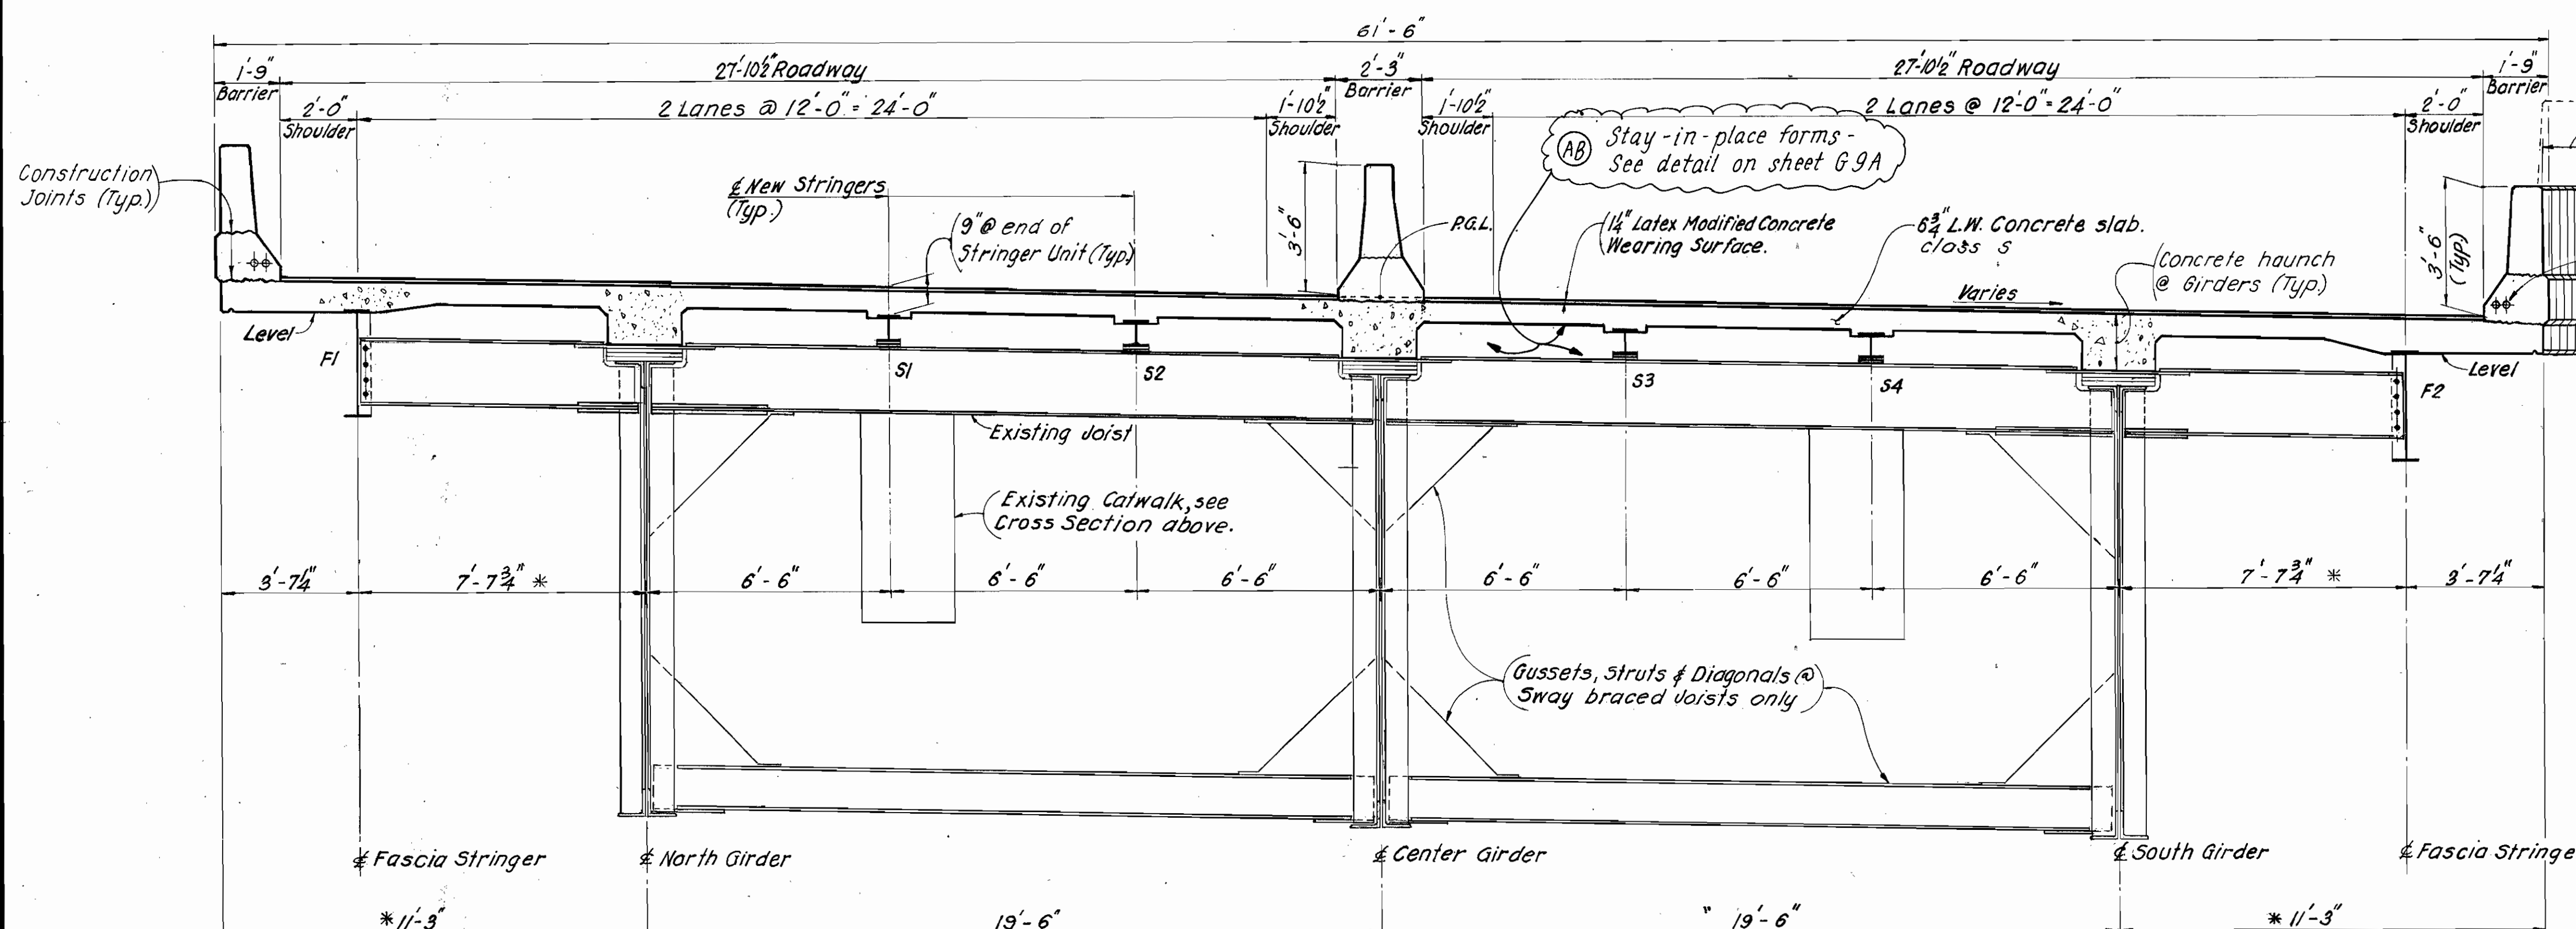


**PROPOSED CROSS SECTION (Looking East)**

\* Dimensions vary at curve.


REFERENCES:	DWG. NO.
Existing Plan & Elevation	501
Proposed Plan & Elevation	502
Section H - Typical Cross-Section	522
Notes	502

(AB) As built

PAVLO ENGINEERING CO., P.C. NEW YORK, NEW YORK	
CUYAHOGA COUNTY ENGINEER CLEVELAND OHIO	
<b>MAIN AVENUE BRIDGE</b> CITY OF CLEVELAND BRIDGE OVER THE CUYAHOGA RIVER VALLEY	
EAST APPROACH-LAKEFRONT RAMP SECTION I TYPICAL CROSS SECTION - I	
BRIDGE NO. 193	REPORT NO. 7119 DATE Oct. 23, 1994
<b>NO. B-136</b>	503 46
DESIGN A.S.	DRAWN J.P.W.
CHECKED R.D.M.	REVISED TO AS BUILT AS BUILT 2/94

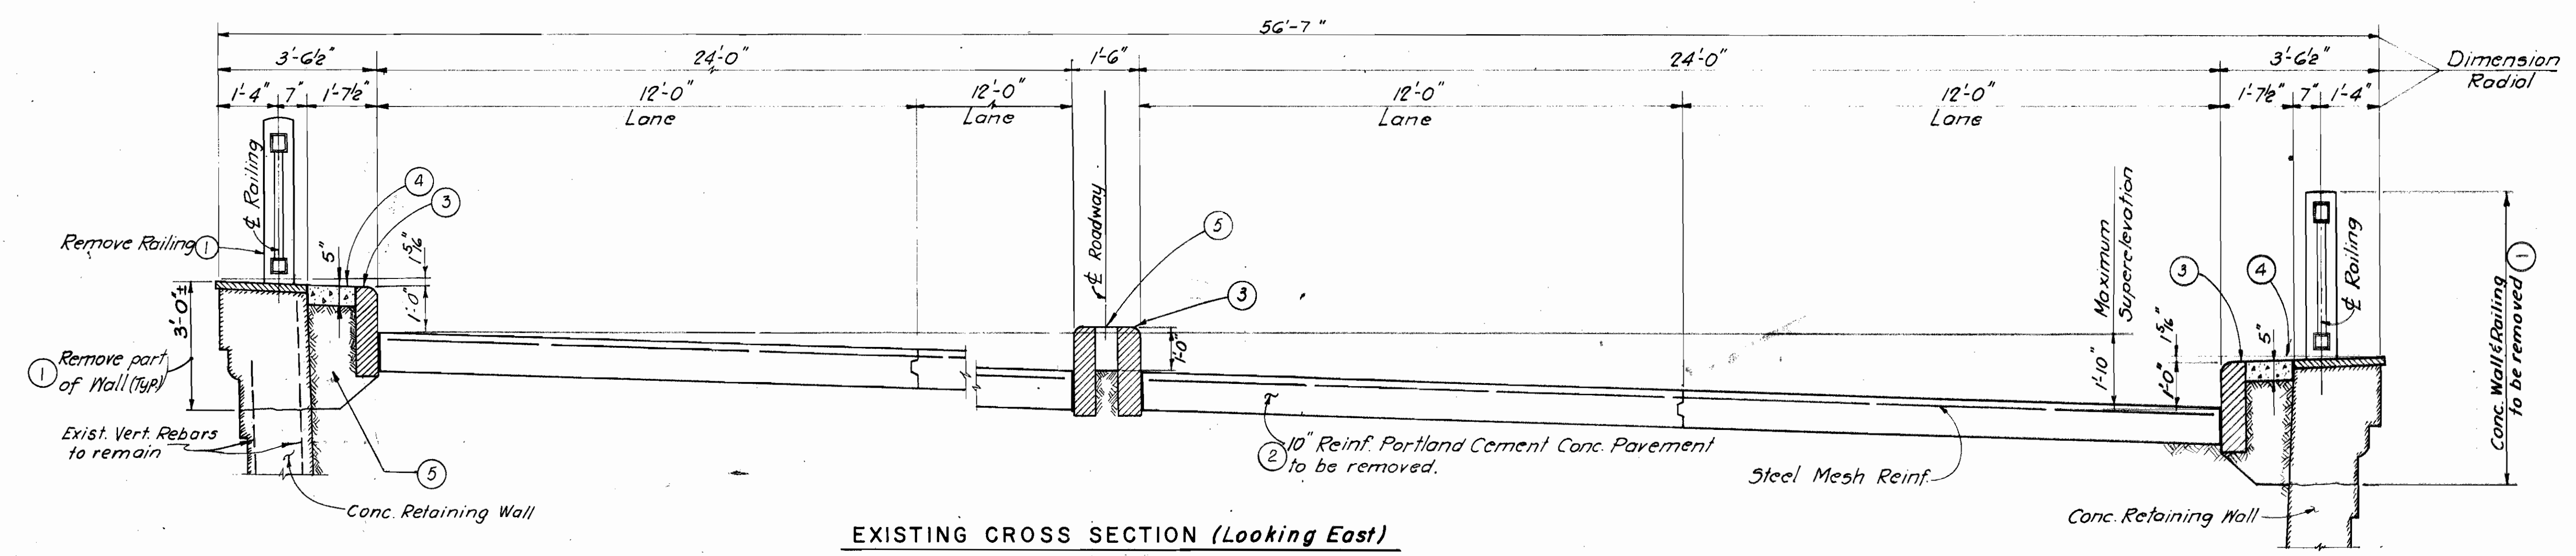

**EXISTING CROSS SECTION (Looking East)**  
Sta. 76+20 to Sta. 80+60

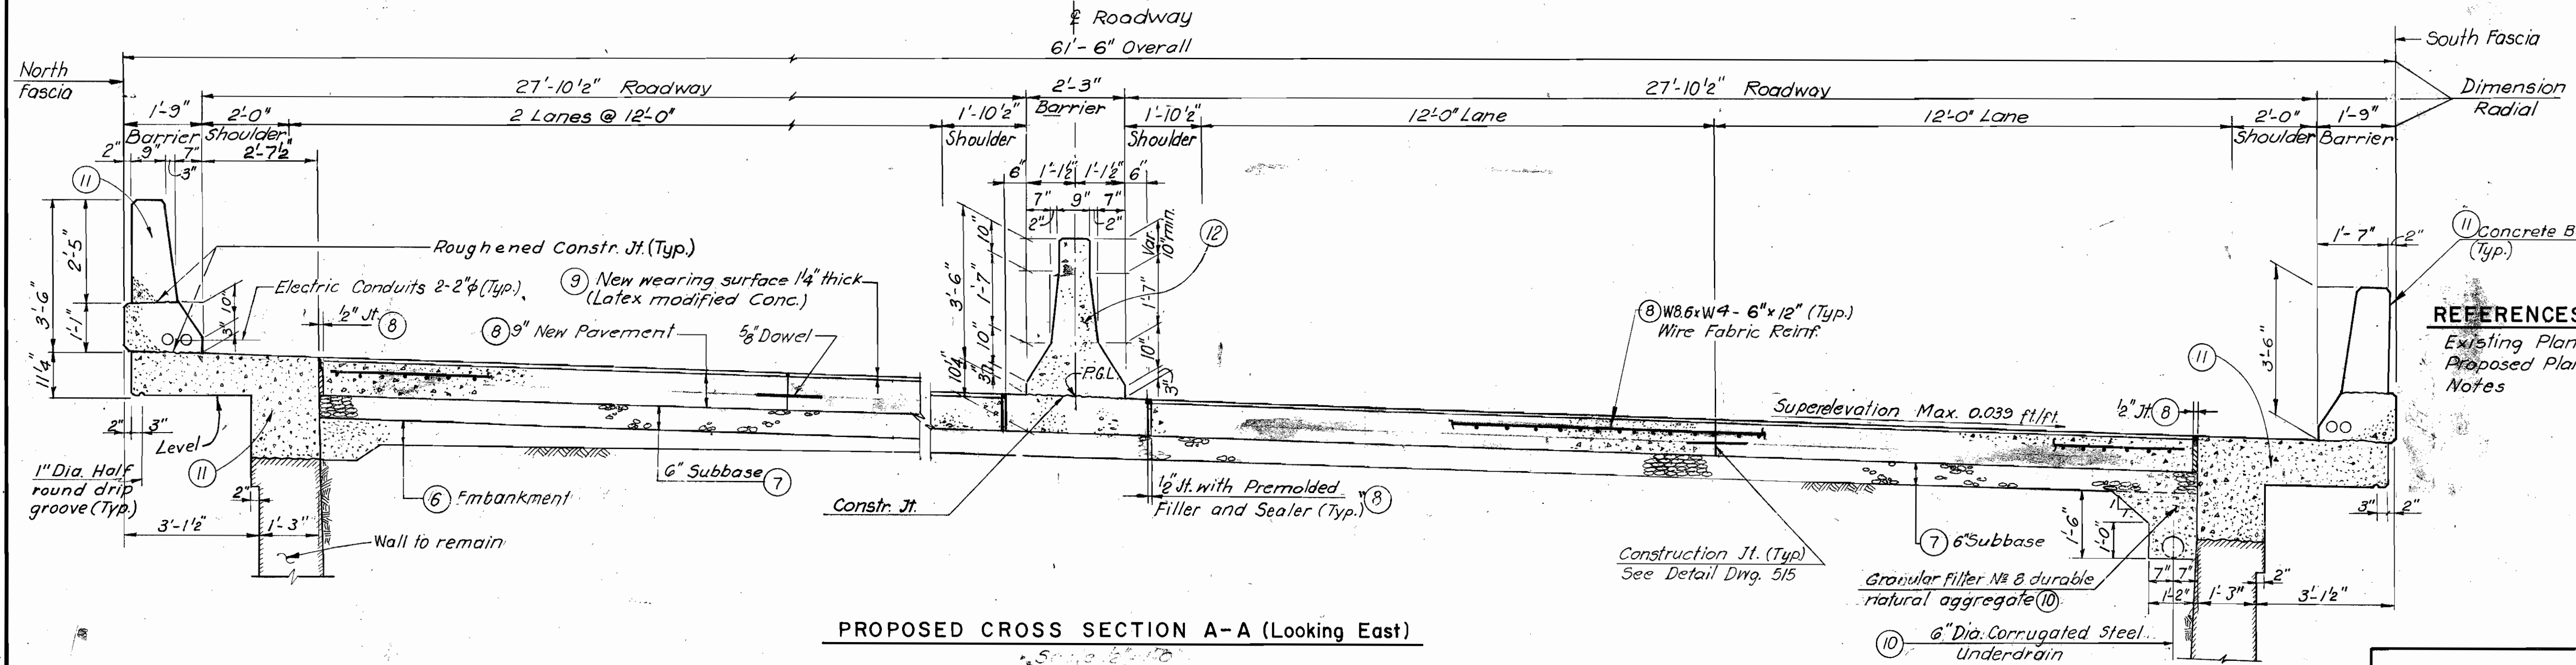

**PROPOSED CROSS SECTION A-A (Looking East)**

**REFERENCES:**  
Existing Plan & Elevation  
Proposed Plan & Elevation  
Notes

**DWG. NO.**  
501  
502  
502

**PAY ITEMS**

①	Item 202	Portions of structures removed
②	Item 202	Pavement removed
③	Item 202	Curb removed
④	Item 202	Walk removed
⑤	Item 203	Excavation, not including embankment construction
⑥	Item 203	Embankment
⑦	Item 310	6" subbase
⑧	Item 451	9" reinforced concrete pavement
⑨	Item 845	1/4" latex-modified concrete overlay
⑩	Item 605	Shallow pipe underdrain
⑪	Item 511	Class "C" concrete, Retaining Walls (above footings)
⑫	Item 622	Concrete barrier, type B, as per plan "A" *

Note: \* For Reinforcing Details See Section D-D on Dwg. 514.

PAVLO ENGINEERING CO., P.C.  
NEW YORK, NEW YORK

**CUYAHOGA COUNTY ENGINEER**  
CLEVELAND OHIO

**MAIN AVENUE BRIDGE**  
CITY OF CLEVELAND  
BRIDGE OVER THE CUYAHOGA RIVER VALLEY

EAST APPROACH - LAKEFRONT RAMP  
**TYPICAL CROSS SECTION - II**

BRIDGE NO. 193    REPORT NO. 7119    DATE Oct 23 1989

**NO. B-136**    504  
46

DESIGN	DRAWN	CHECKED	REVISED TO AS BUILT
A.S.	R.S.	R.D.M.	AS BUILT 2/94



MICROFILMED  
JUL 29 1994


CUYAHOGA COUNTY  
CUY-2-14.66

FHWA REGION	STATE	PROJECT
5	OHIO	BHF-73(51)

439  
547

EXISTING FRAMING REMOVAL

MARK	DESIGNATION	SECTION "H"		REMARKS
		QUANT.		
S1 & S2	24W74	77		
S3	21W59	2		
D1	10W29	40		
D2	10C25	4		
D3	14W30	44		
D4	10W33	2		
F1	1-L4x3x <sup>3</sup> / <sub>8</sub>	22		
	1-R18x <sup>5</sup> / <sub>8</sub>	22		
	1-Z 4 <sup>1</sup> / <sub>2</sub> x3 <sup>1</sup> / <sub>2</sub> x <sup>3</sup> / <sub>8</sub>	22		
	1-R24x <sup>3</sup> / <sub>8</sub>	22		
	1-L4x3 <sup>1</sup> / <sub>2</sub> x <sup>3</sup> / <sub>8</sub>	22		

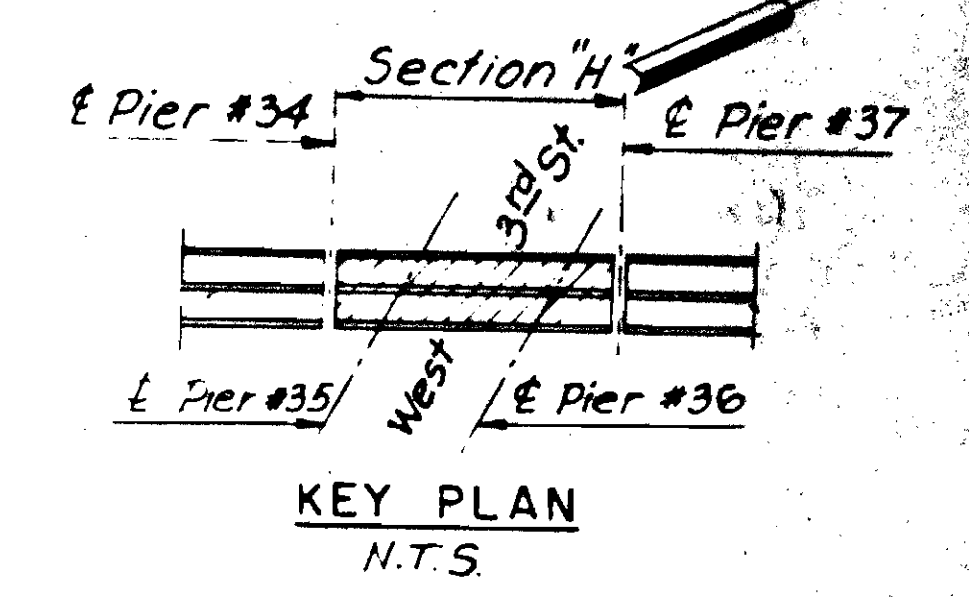

NOTES:

- All existing dimensions, elevations and details were obtained from original contract plans and shop drawings and shall be verified in the field by the Contractor, prior to making structure alterations.
- All dimensions shown on proposed plans are measured horizontally.
- All new shapes and plates shall be ASTM A36 steel (A.A.S.H.T.O - M183) unless noted otherwise.
- All High strength bolted Connections shall be of the Friction type unless noted otherwise.
- Welding details and procedures shall conform to the AWS and A.A.S.H.T.O latest specifications.
- All new Rolled Beams, Shaped and Plates shall be ASTM A36, AISC Category I.
- All new welded Members including Fascia Stringers, replacement Floor Beams and Brackets shall be ASTM A36, AISC Category III.

DECK OVERHANG TABLE


FLOORBEAM	OVERHANG *	
	NORTH	SOUTH
H - 1	5' - 3 1/2"	1' - 11 1/4"
H - 2	5' - 0 5/8"	2' - 1 7/8"
H - 3	4' - 10 1/8"	2' - 4 3/8"
H - 4	4' - 7 3/4"	2' - 6 3/4"
H - 5	4' - 5 3/4"	2' - 8 3/4"
H - 6	4' - 4"	2' - 10 5/8"
H - 7	4' - 2 1/8"	3' - 0 3/8"
H - 8	4' - 0 3/4"	3' - 1 3/4"
H - 9	3' - 11 3/8"	3' - 3 1/8"
H - 10	3' - 10 1/4"	3' - 4 3/8"
H - 11	3' - 9 1/4"	3' - 5 1/4"
H - 12	3' - 8 3/8"	3' - 6 1/8"

\* Measured radially at point of intersection of the floorbeam and the Fascia Stringers.


- For Finishing Machine Support notes See Dwg. 6B Welding of attachments shall not be permitted in the tension zone of the Stringers. For the Stringers in Section H, tension zone is 3'-3" each side of Interior Supports.

REFERENCES

Notes	DWG. NO.
Existing Plan and Elevation	524
Proposed Plan and Elevation	501
Typical Cross Section	522
Stringers Schedule and Fascia Stringers Data	521
Typical Stringer Details	520
Stringer Details I	522
Miscellaneous struct. Details	532
Charpy V Notch requirements	508


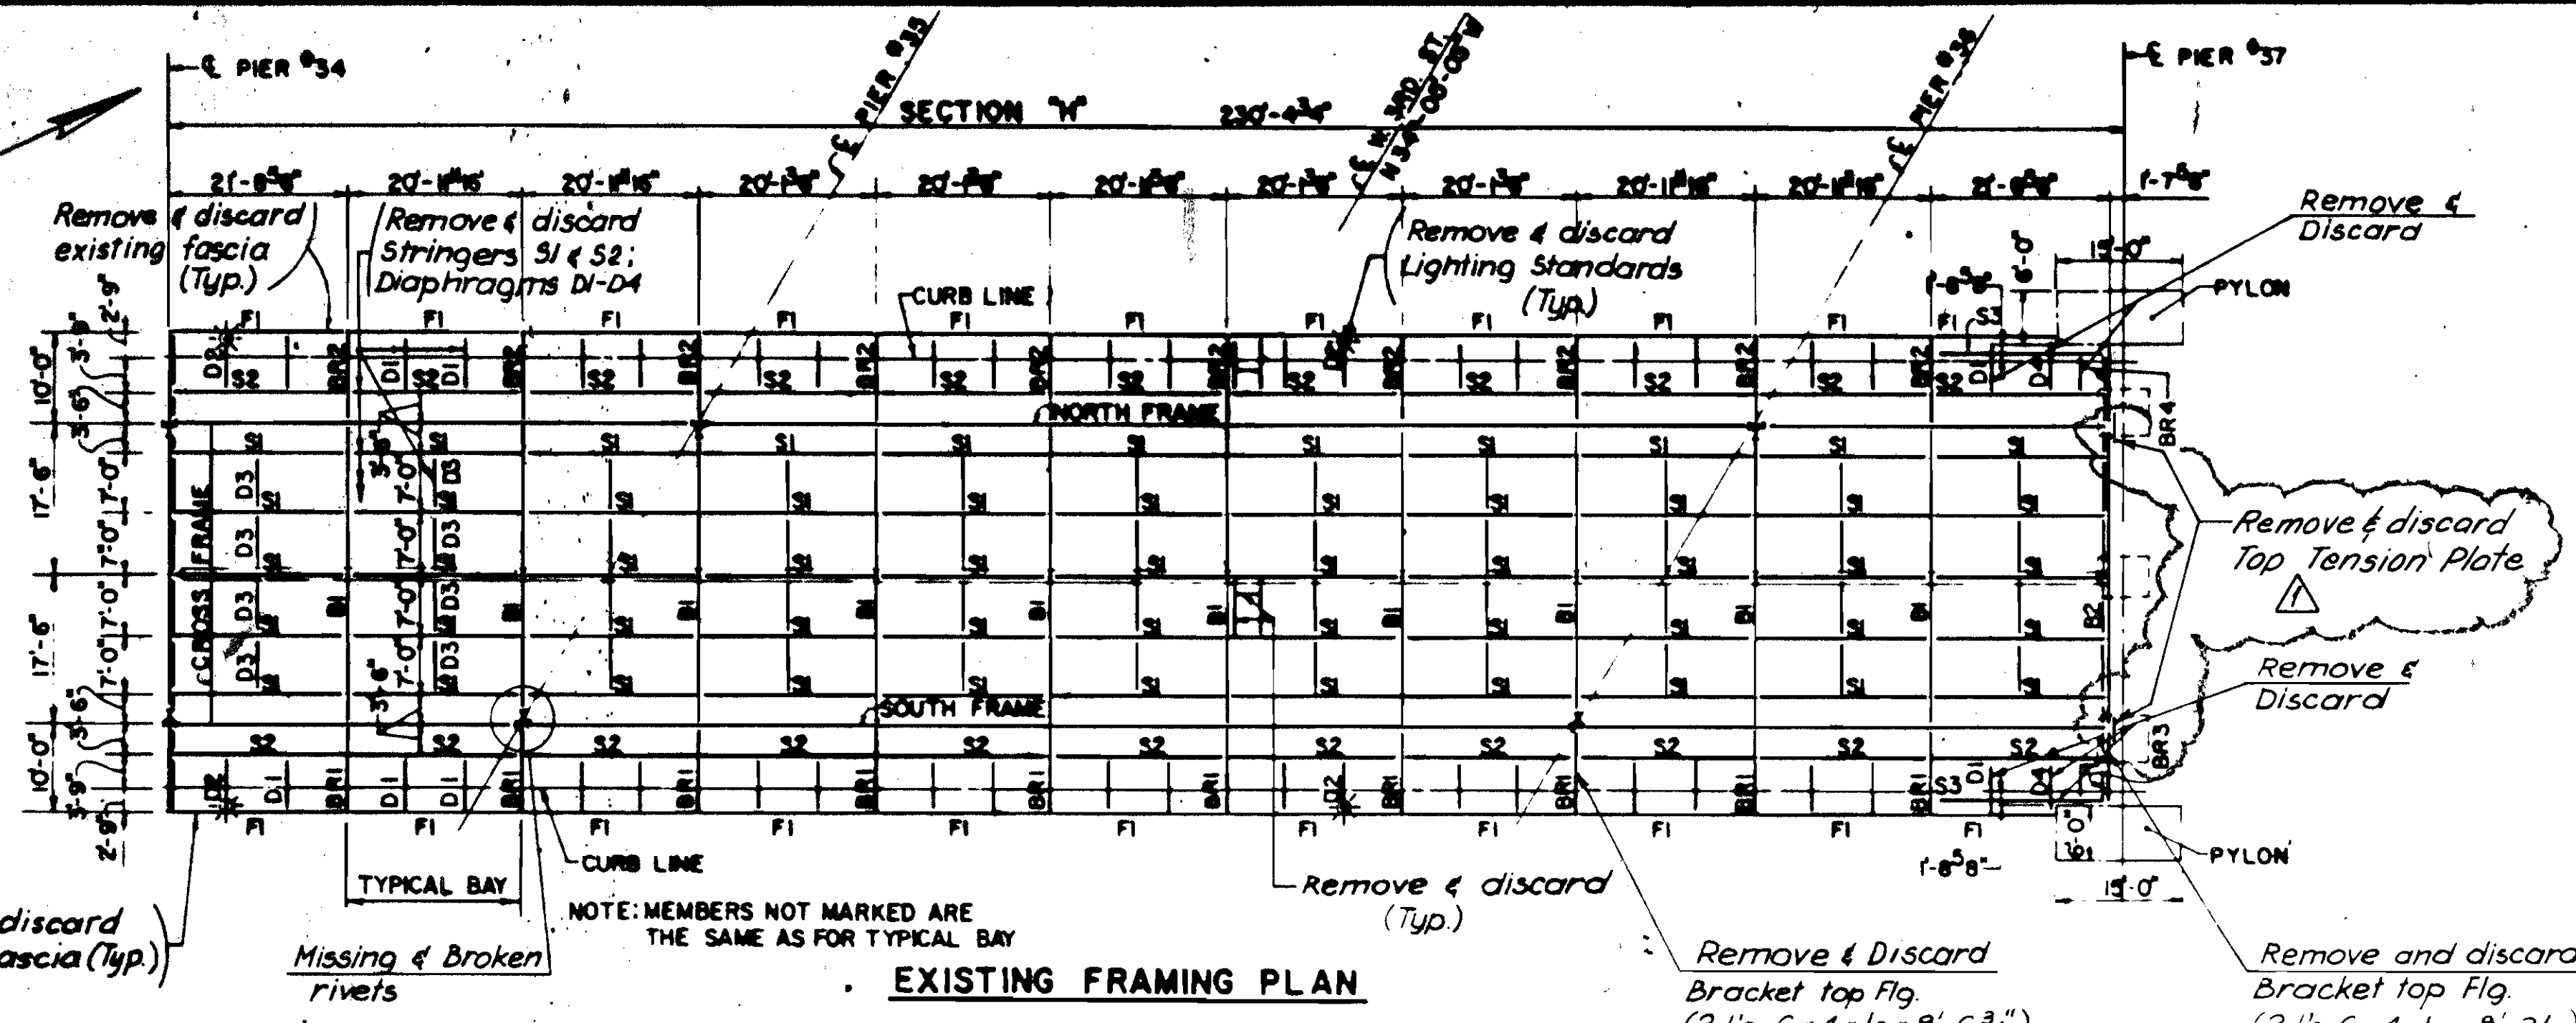


EXISTING FRAMING PLAN

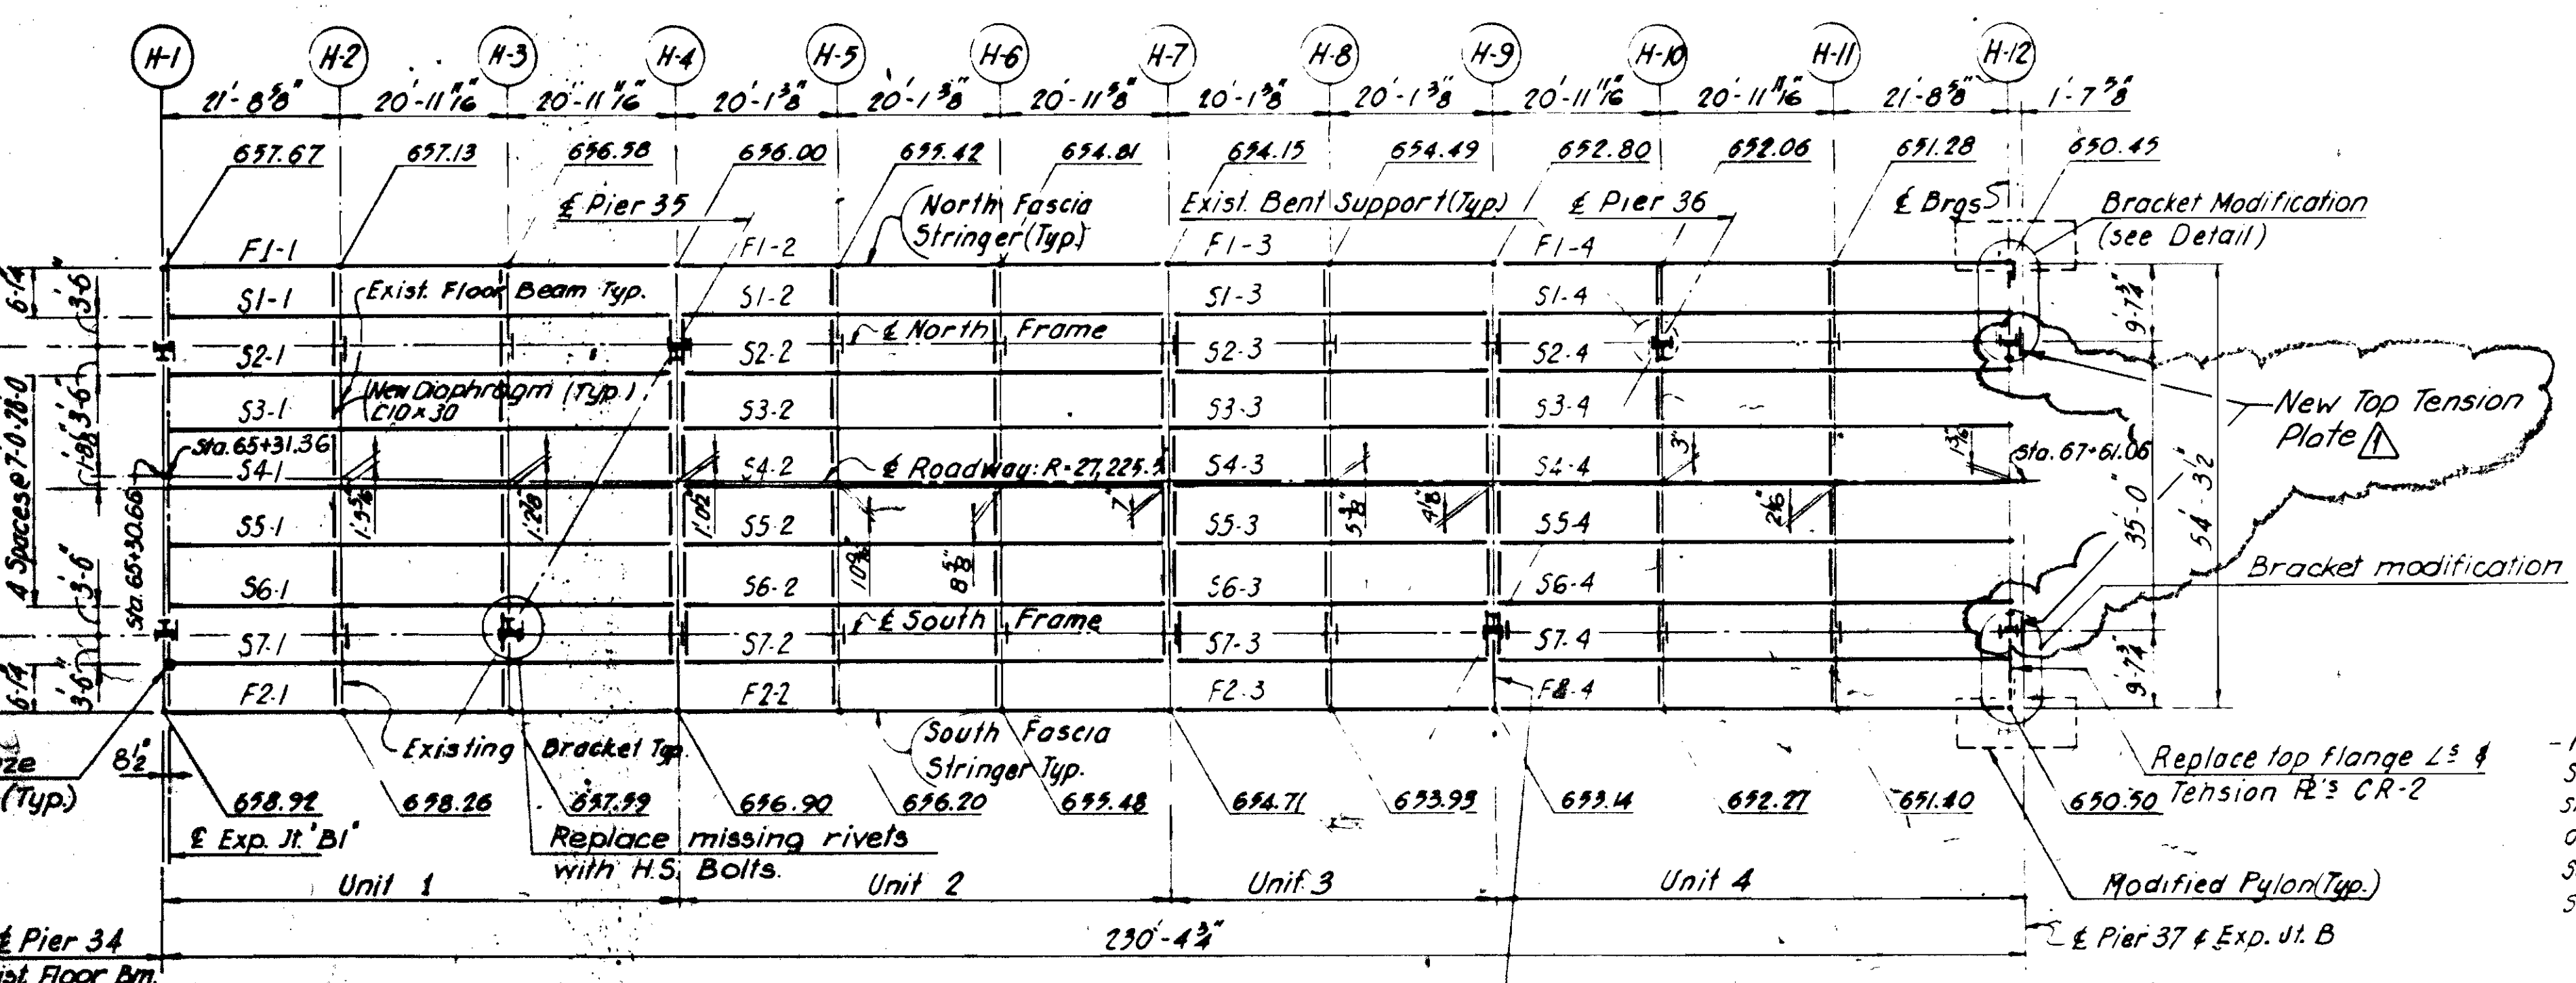


SECTION "H" - PROPOSED FRAMING PLAN

Denotes existing framing member  
Denotes new or repaired framing member  
Indicates elevation at top of exist. floor beam.

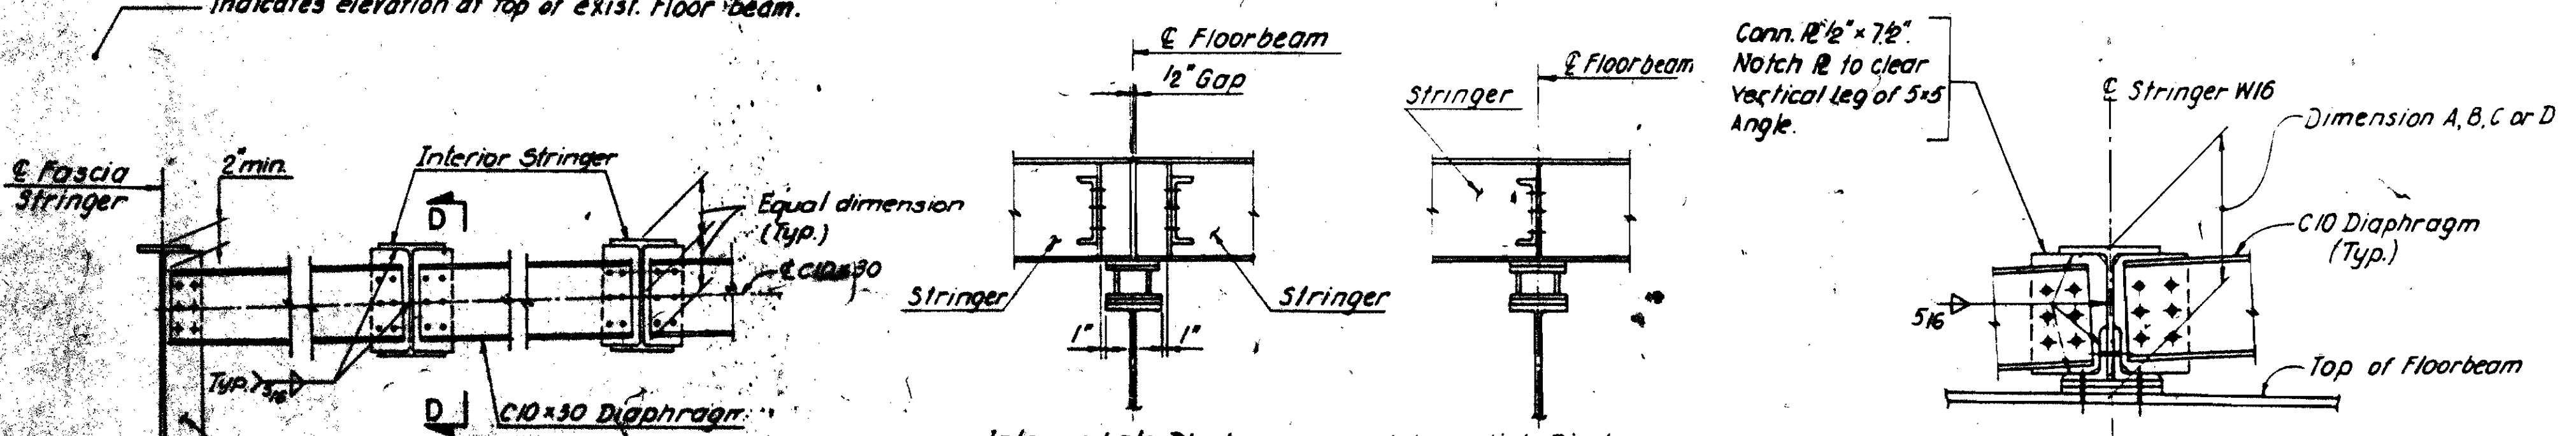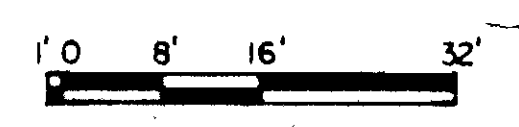

NEW INTERMEDIATE DIAPHRAGMS AT FLOORBEAMS

Rev. 1	Plan Revisions	8/5/91
PAVLO ENGINEERING CO., P.C. NEW YORK, NEW YORK		
CUYAHOGA COUNTY ENGINEER CLEVELAND OHIO		
MAIN AVENUE BRIDGE CITY OF CLEVELAND BRIDGE OVER THE CUYAHOGA RIVER VALLEY		
EAST APPROACH - LAKEFRONT RAMP - SEC. H EXIST. & PROPOSED FRAMING PLAN		
BRIDGE NO. 193	REPORT NO. 7119	DATE Oct 22, 1991
NO. B-136		519
DESIGN A.S.	DRAWN J.R.W.	CHECKED R.D.M.
REVISED TO AS BUILT AS BUILT 2/91		

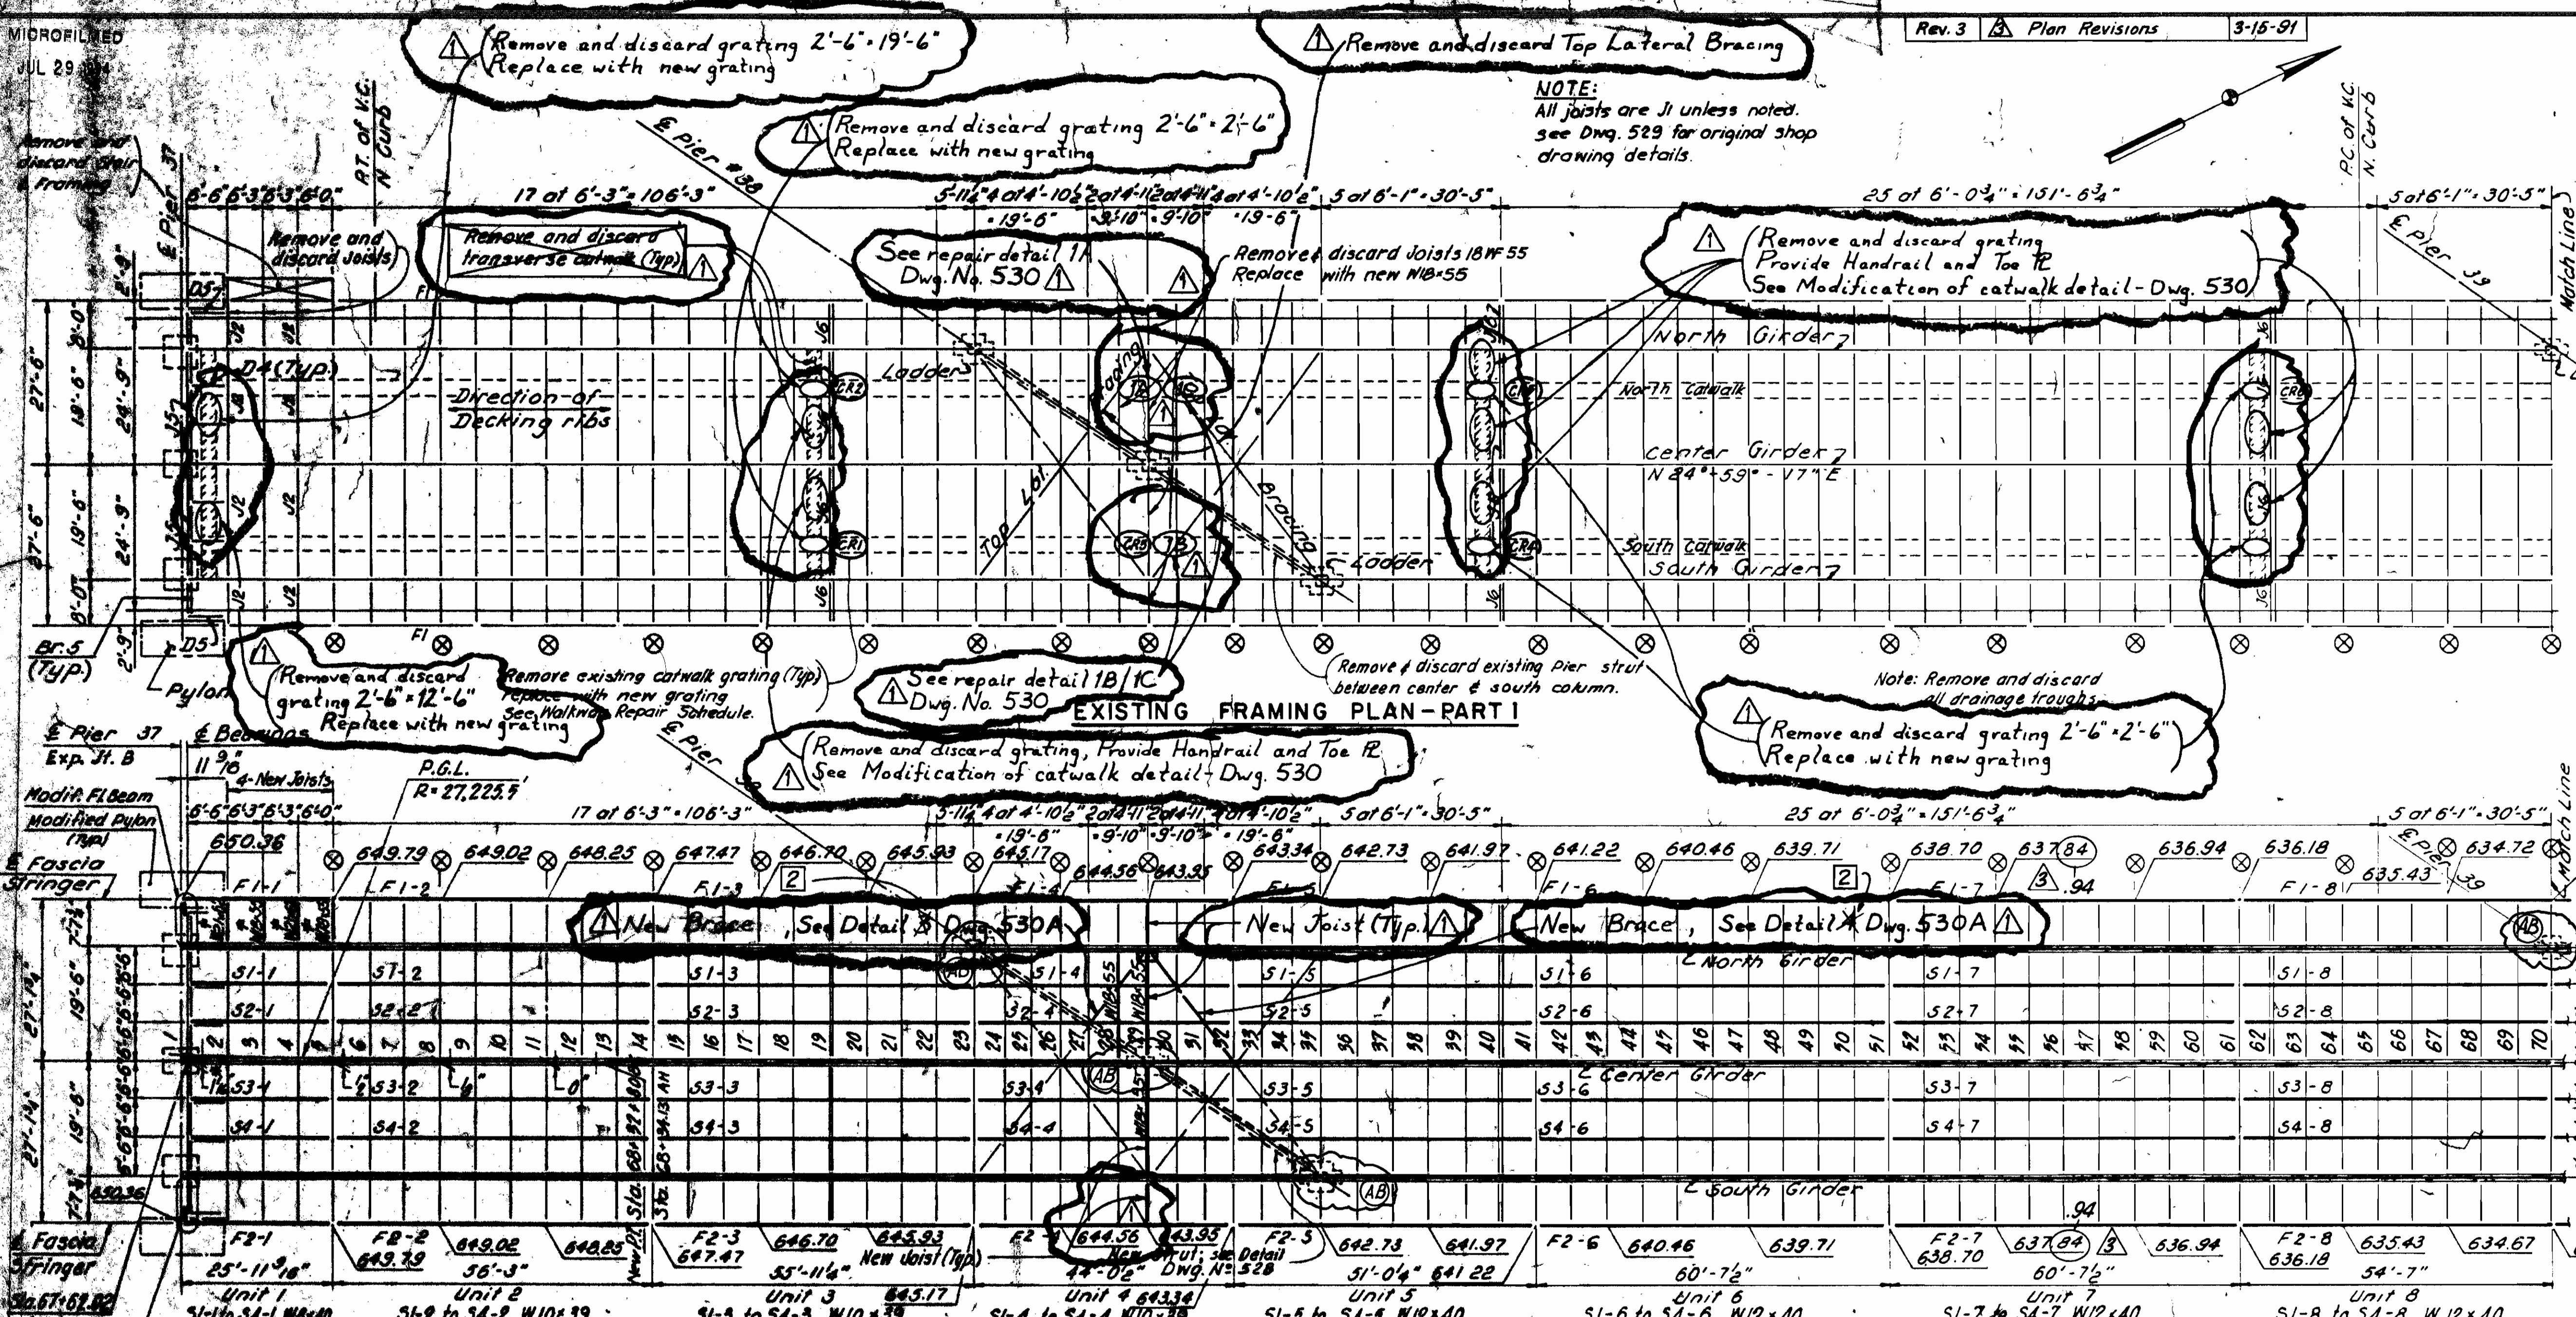

REPAIR	LOCATION UNIT/WALK	REPAIR - REMOVE AND DISCARD - REPLACE WITH NEW
1A	4 North	Grating 2'-6" x 9'-0" long Channels 2-C7 x 9.8 x 9'-0" Bracing 2-L3 1/2 x 3/4 x 4'-0"
1B	4 South	Grating 2'-6" x 6'-0" long Channels 2-C7 x 9.8 x 6'-0" Bracing 2-L3 1/2 x 3/4 x 4'-0"
1C	4 North	Same as for 1B

**NOTES:**  
All new Rolled Beams, Shapes and Plates shall be ASTM A36, AISC Category I  
All new Welded Members including fascia Stringers, Replacement Floor Beams and Brackets shall be ASTM A36, AISC Category III

All existing dimensions and details were obtained from original Contract Plans and Shop Dwg's, and shall be verified in field by the Contractor prior to making alterations. All longitudinal dimensions are sloping dimensions. See C.V.N. Requirements Dwg 502.  
New steel (shapes and plates) shall conform to ASTM-A36 (AASHTO-M183) unless otherwise noted.

All High Strength bolted connections shall be of the "Friction Type" unless noted otherwise.  
Welding details and procedures shall conform to the A.W.S. and A.A.S.H.T.O. latest Specifications.

All new stringers shall be installed vertical.  
Welds on top flange of new stringers are not permitted.

**REFERENCES:**

Proposed Plan and Elevation	DWG. NO. 502
Typical Cross Section	503
Depth of Support Table	526
Deck Framing Details	527, 531
Structural Replacement and repairs	528, 529, 530, 531
Catwalk Details	530
Attachment of New Catwalk grating	258

PAVLO ENGINEERING CO., P.C.  
NEW YORK, NEW YORK

CUYAHOGA COUNTY ENGINEER  
CLEVELAND OHIO

MAIN AVENUE BRIDGE  
CITY OF CLEVELAND

BRIDGE OVER THE CUYAHOGA RIVER VALLEY





EAST APPROACH-LAKEFRONT RAMP SECTION I  
EXIST. & PROPOSED FRAMING PLAN - I

BRIDGE NO. 193 REPORT NO. 718 DATE 2/94

NO. B-136 524

DESIGN	DRAWN	CHECKED	REVISED TO
A.S.	J.P.M.	R.Q.M.	AS BUILT 2/94

**PROPOSED FRAMING PLAN - PART I**  
(CATWALK NOT SHOWN)

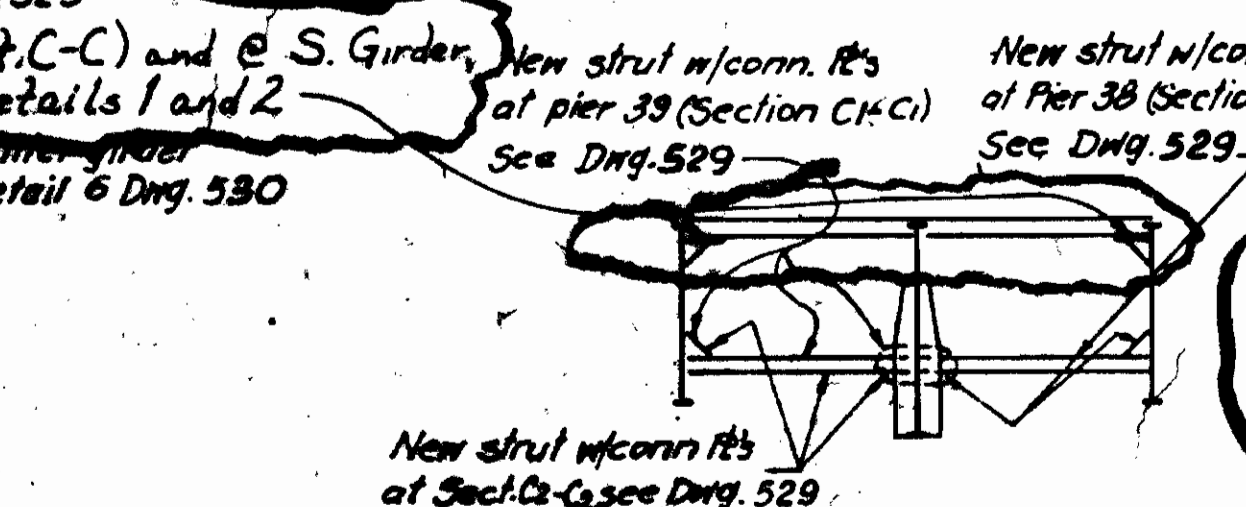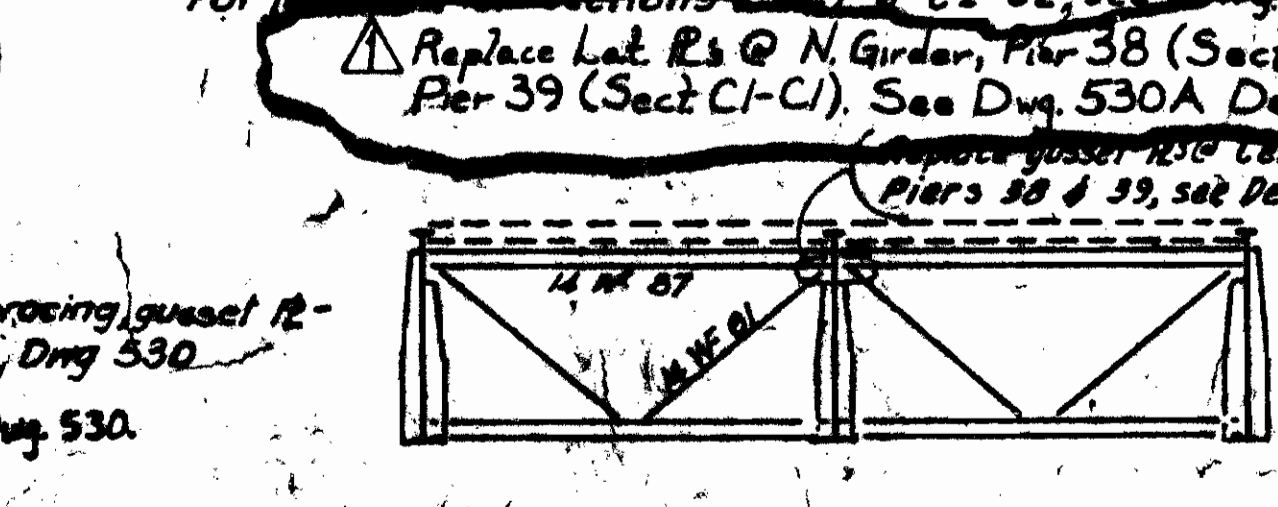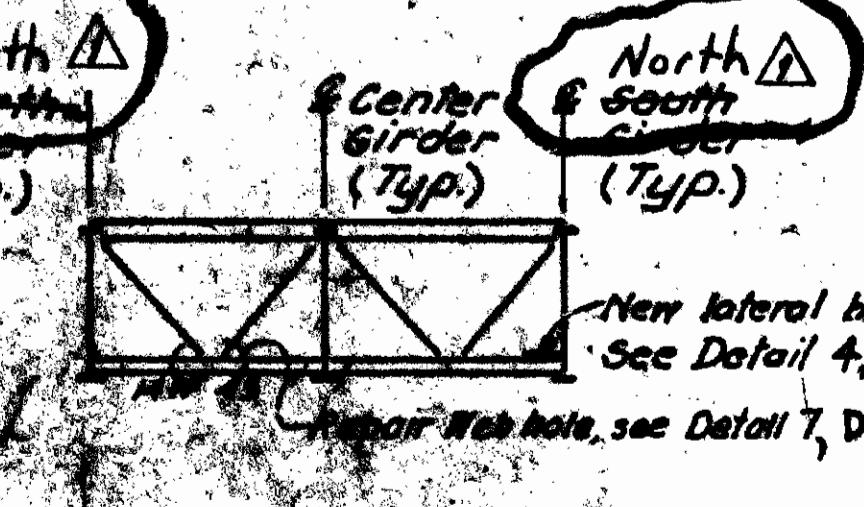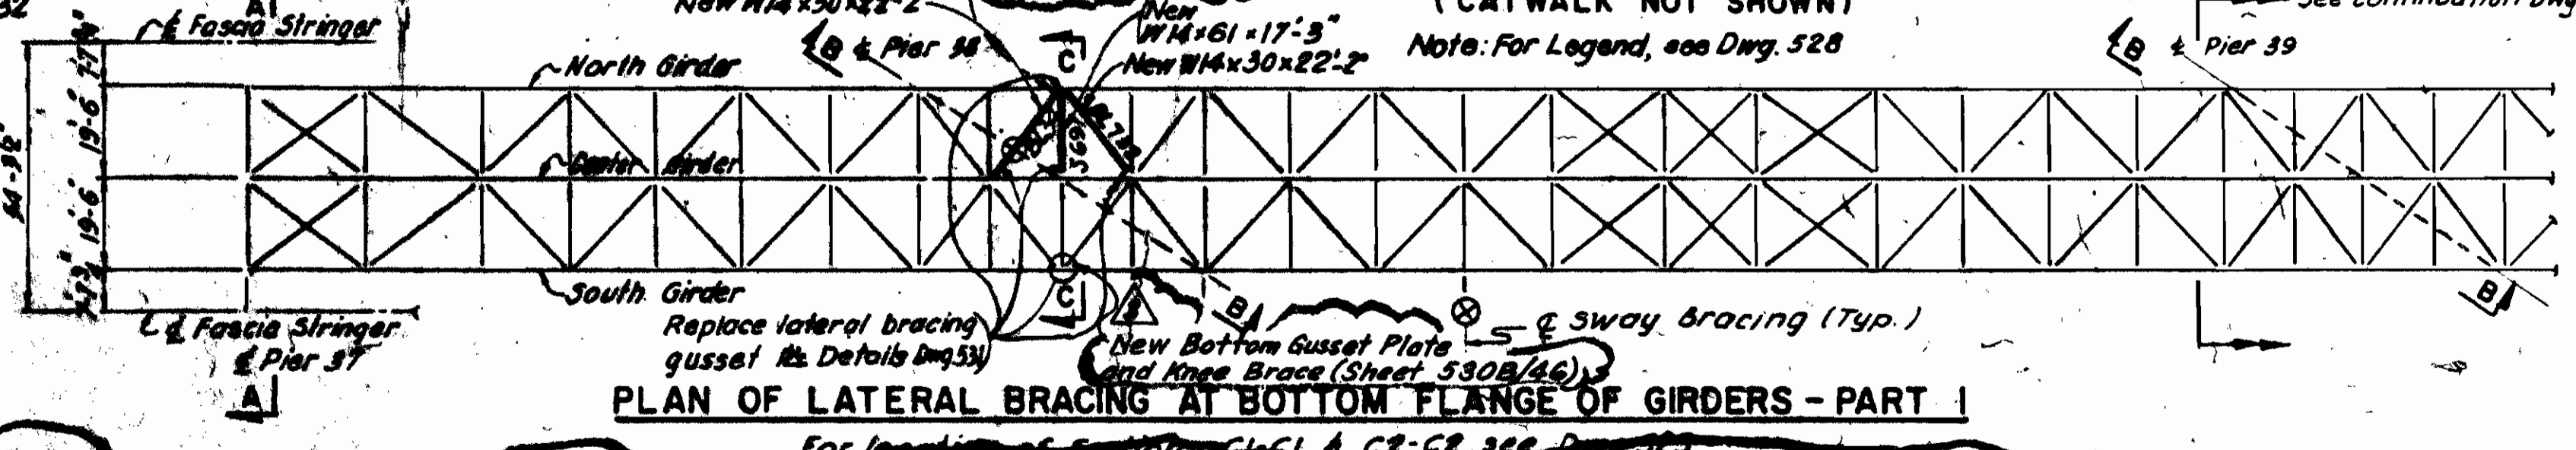

**CATWALK REPAIR SCHEDULE \***

REPAIR	LOCATION UNIT/WALK	REPAIR - REMOVE AND DISCARD - REPLACE WITH NEW
CR1	3 South	Grating 2'-6" x 6'-0" long
CR2	3 North	Grating 2'-6" x 6'-0" long Bracing 2-L3 1/2 x 3/4 x 4'-0"
CR3	4 South	Grating 2'-6" x 12'-0" long Channels 2-C7 x 9.8 x Full length Bracing 4-L3 1/2 x 3/4 x 4'-0"
CR4	5 South	Grating 2'-6" x 8'-0" long Channels 2-C7 x 9.8 x Full length Bracing 3-L3 1/2 x 3/4 x 4'-0"
CR5	6 North	Same as for CR3
CR6	8 North	Same as for CR4
CR7	9 South	Same as for CR3
CR8	9 North	Same as for CR3
CR9	13 North	Grating 2'-6" x 10'-0" long Channels 2-C7 x 9.8 x Full length Bracing 4-L3 1/2 x 3/4 x 4'-0"
CR10	16 South	Grating 2'-6" x 3'-0" long
CR11	16 North	Same as for CR10

\* New gratings, bracing, and Channels to be paid under Item Special, "Steel Grating".  
Note: New gratings shall be press-locked rectangular design, galvanized steel. Main bars shall be 1/2" x 3/8" spaced 1 1/2" on centers. Cross bars shall be 3/4" x 1/2" spaced 4" on centers.

MICROFILMED  
JUL 29 1994

**Existing Joists Schedule**

Mark	Section
J-1	WF 18 x 53
J-2	WF 21 x 59
J-3	WF 21 x 63
J-4	WF 21 x 68
J-5	WF 27 x 98
J-6	2-C18 x 42
F-1	2-L4 x 3 1/2 x 3/8
	2-Bard 1/2 x 3 1/2 x 3/8


**Existing Framing Schedule**

Mark	Section
Br.5	27 WF 98
D4	12 WF 25
D5	12 WF 40


FHWA REGION	STATE	PROJECT
5	OHIO	BHF-73(51)

445  
54


CUYAHOGA COUNTY  
CUY-2-14.66

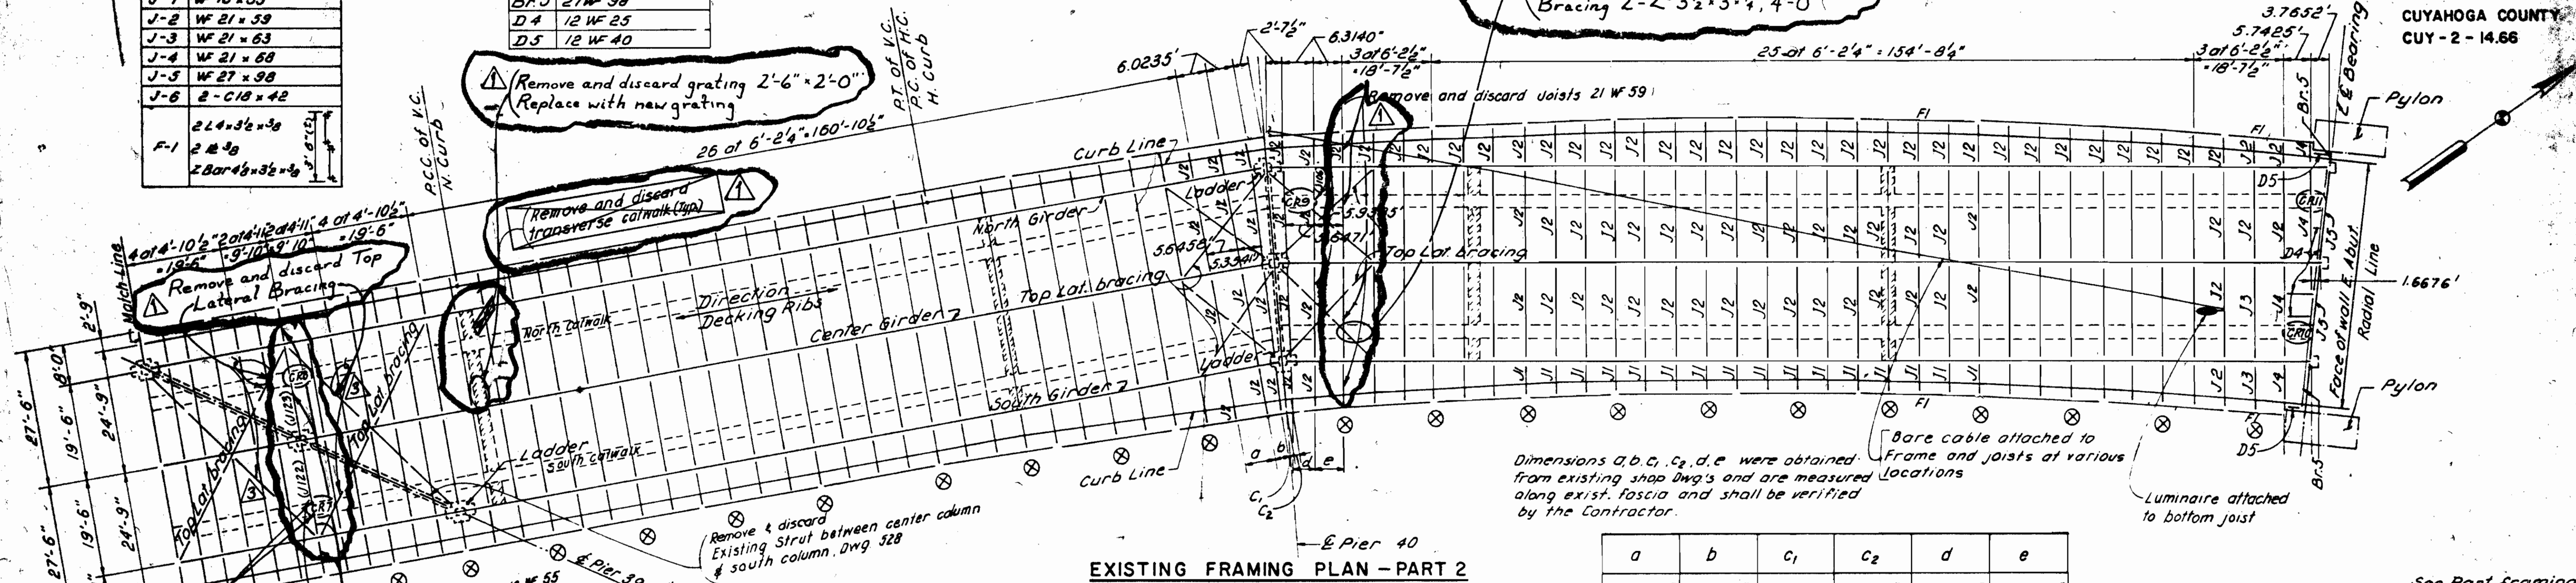


EXISTING FRAMING PLAN - PART 2

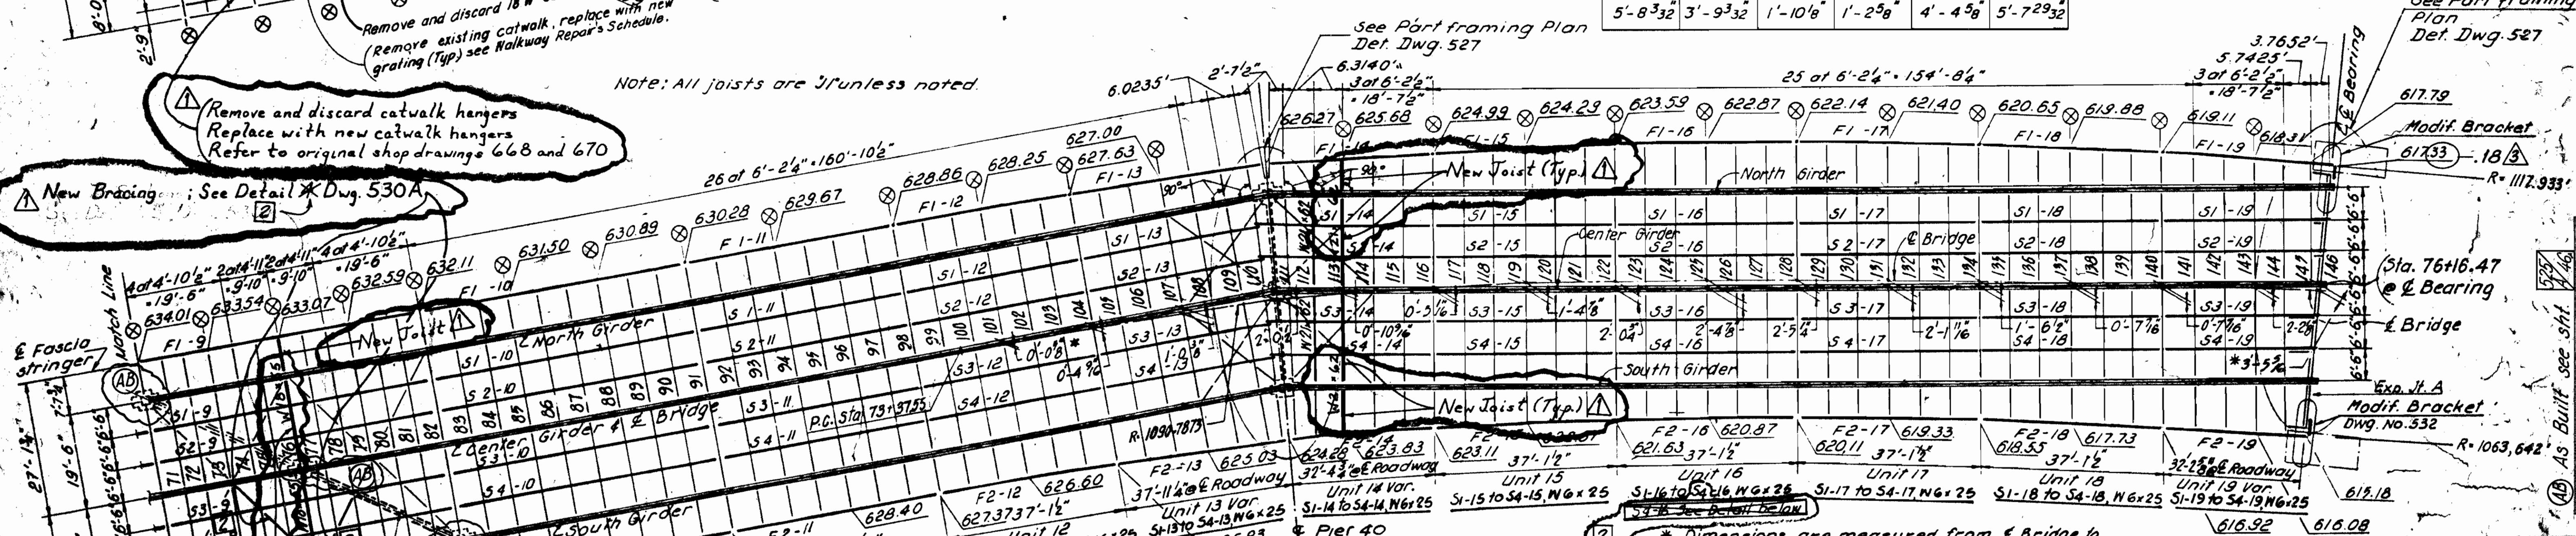

PROPOSED FRAMING PLAN - PART 2  
(CATWALK NOT SHOWN)

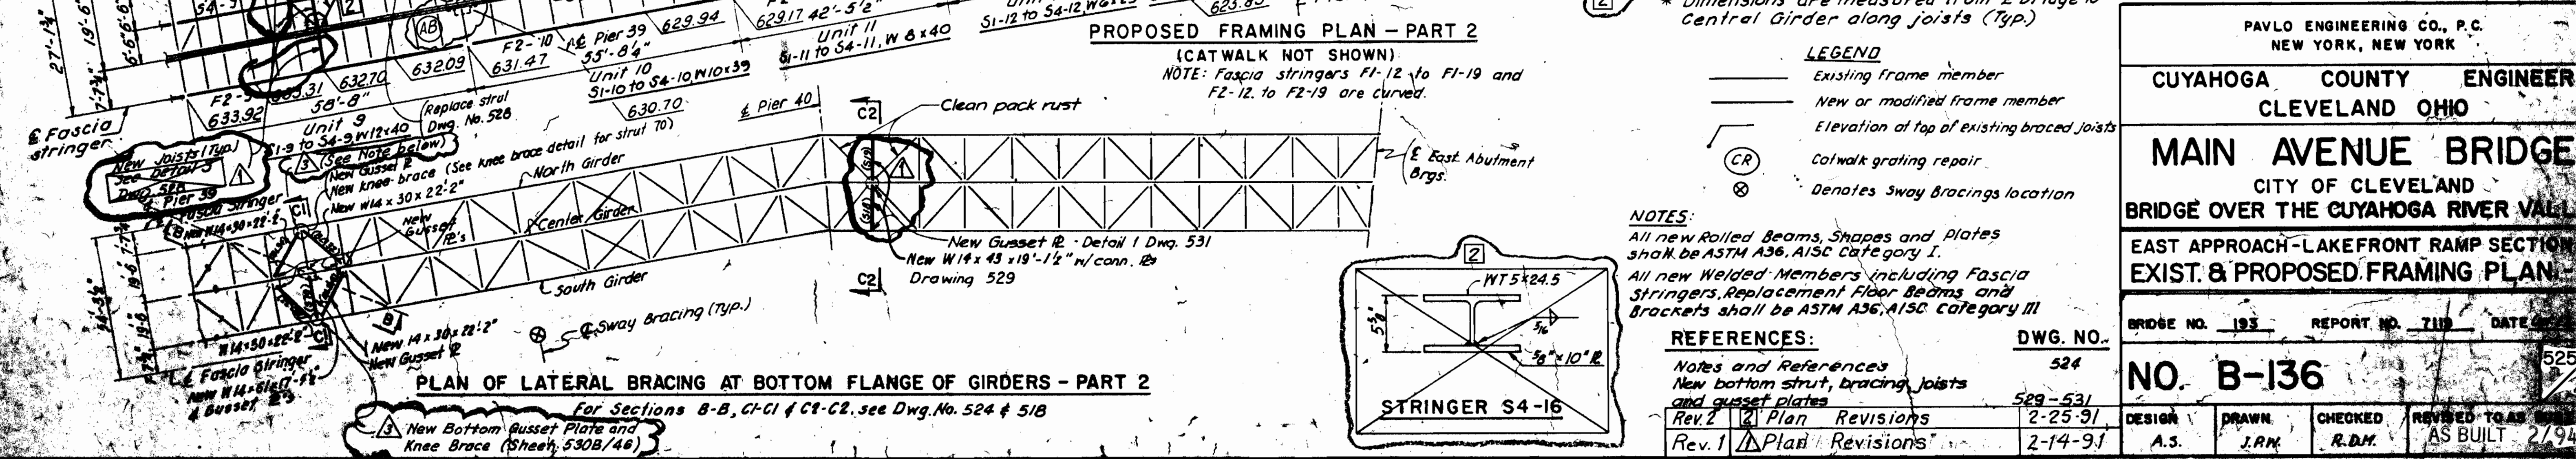


PLAN OF LATERAL BRACING AT BOTTOM FLANGE OF GIRDERS - PART 2

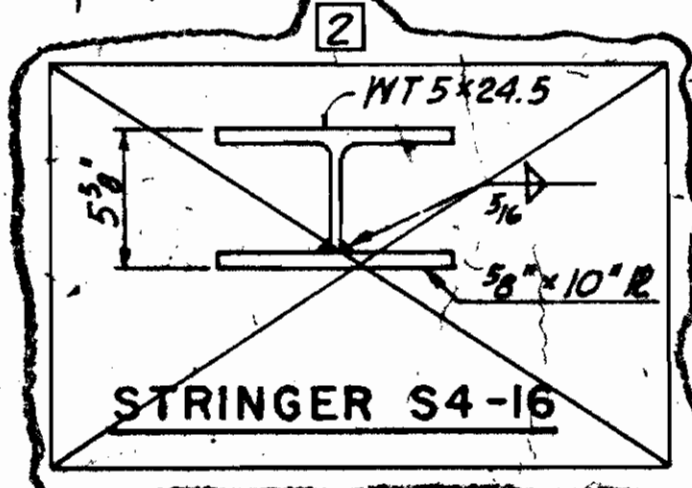

As Built see sht. 525-46  
 Plan Revisions 7-16-91

Note:  
A Haunch width as shown on Haunch and  
Depth of Slab details on Dwg. 533 shall  
be used for computing quantities of concrete.

FHWA REGION	STATE	PROJECT
5	OHIO	BHF-73(51)

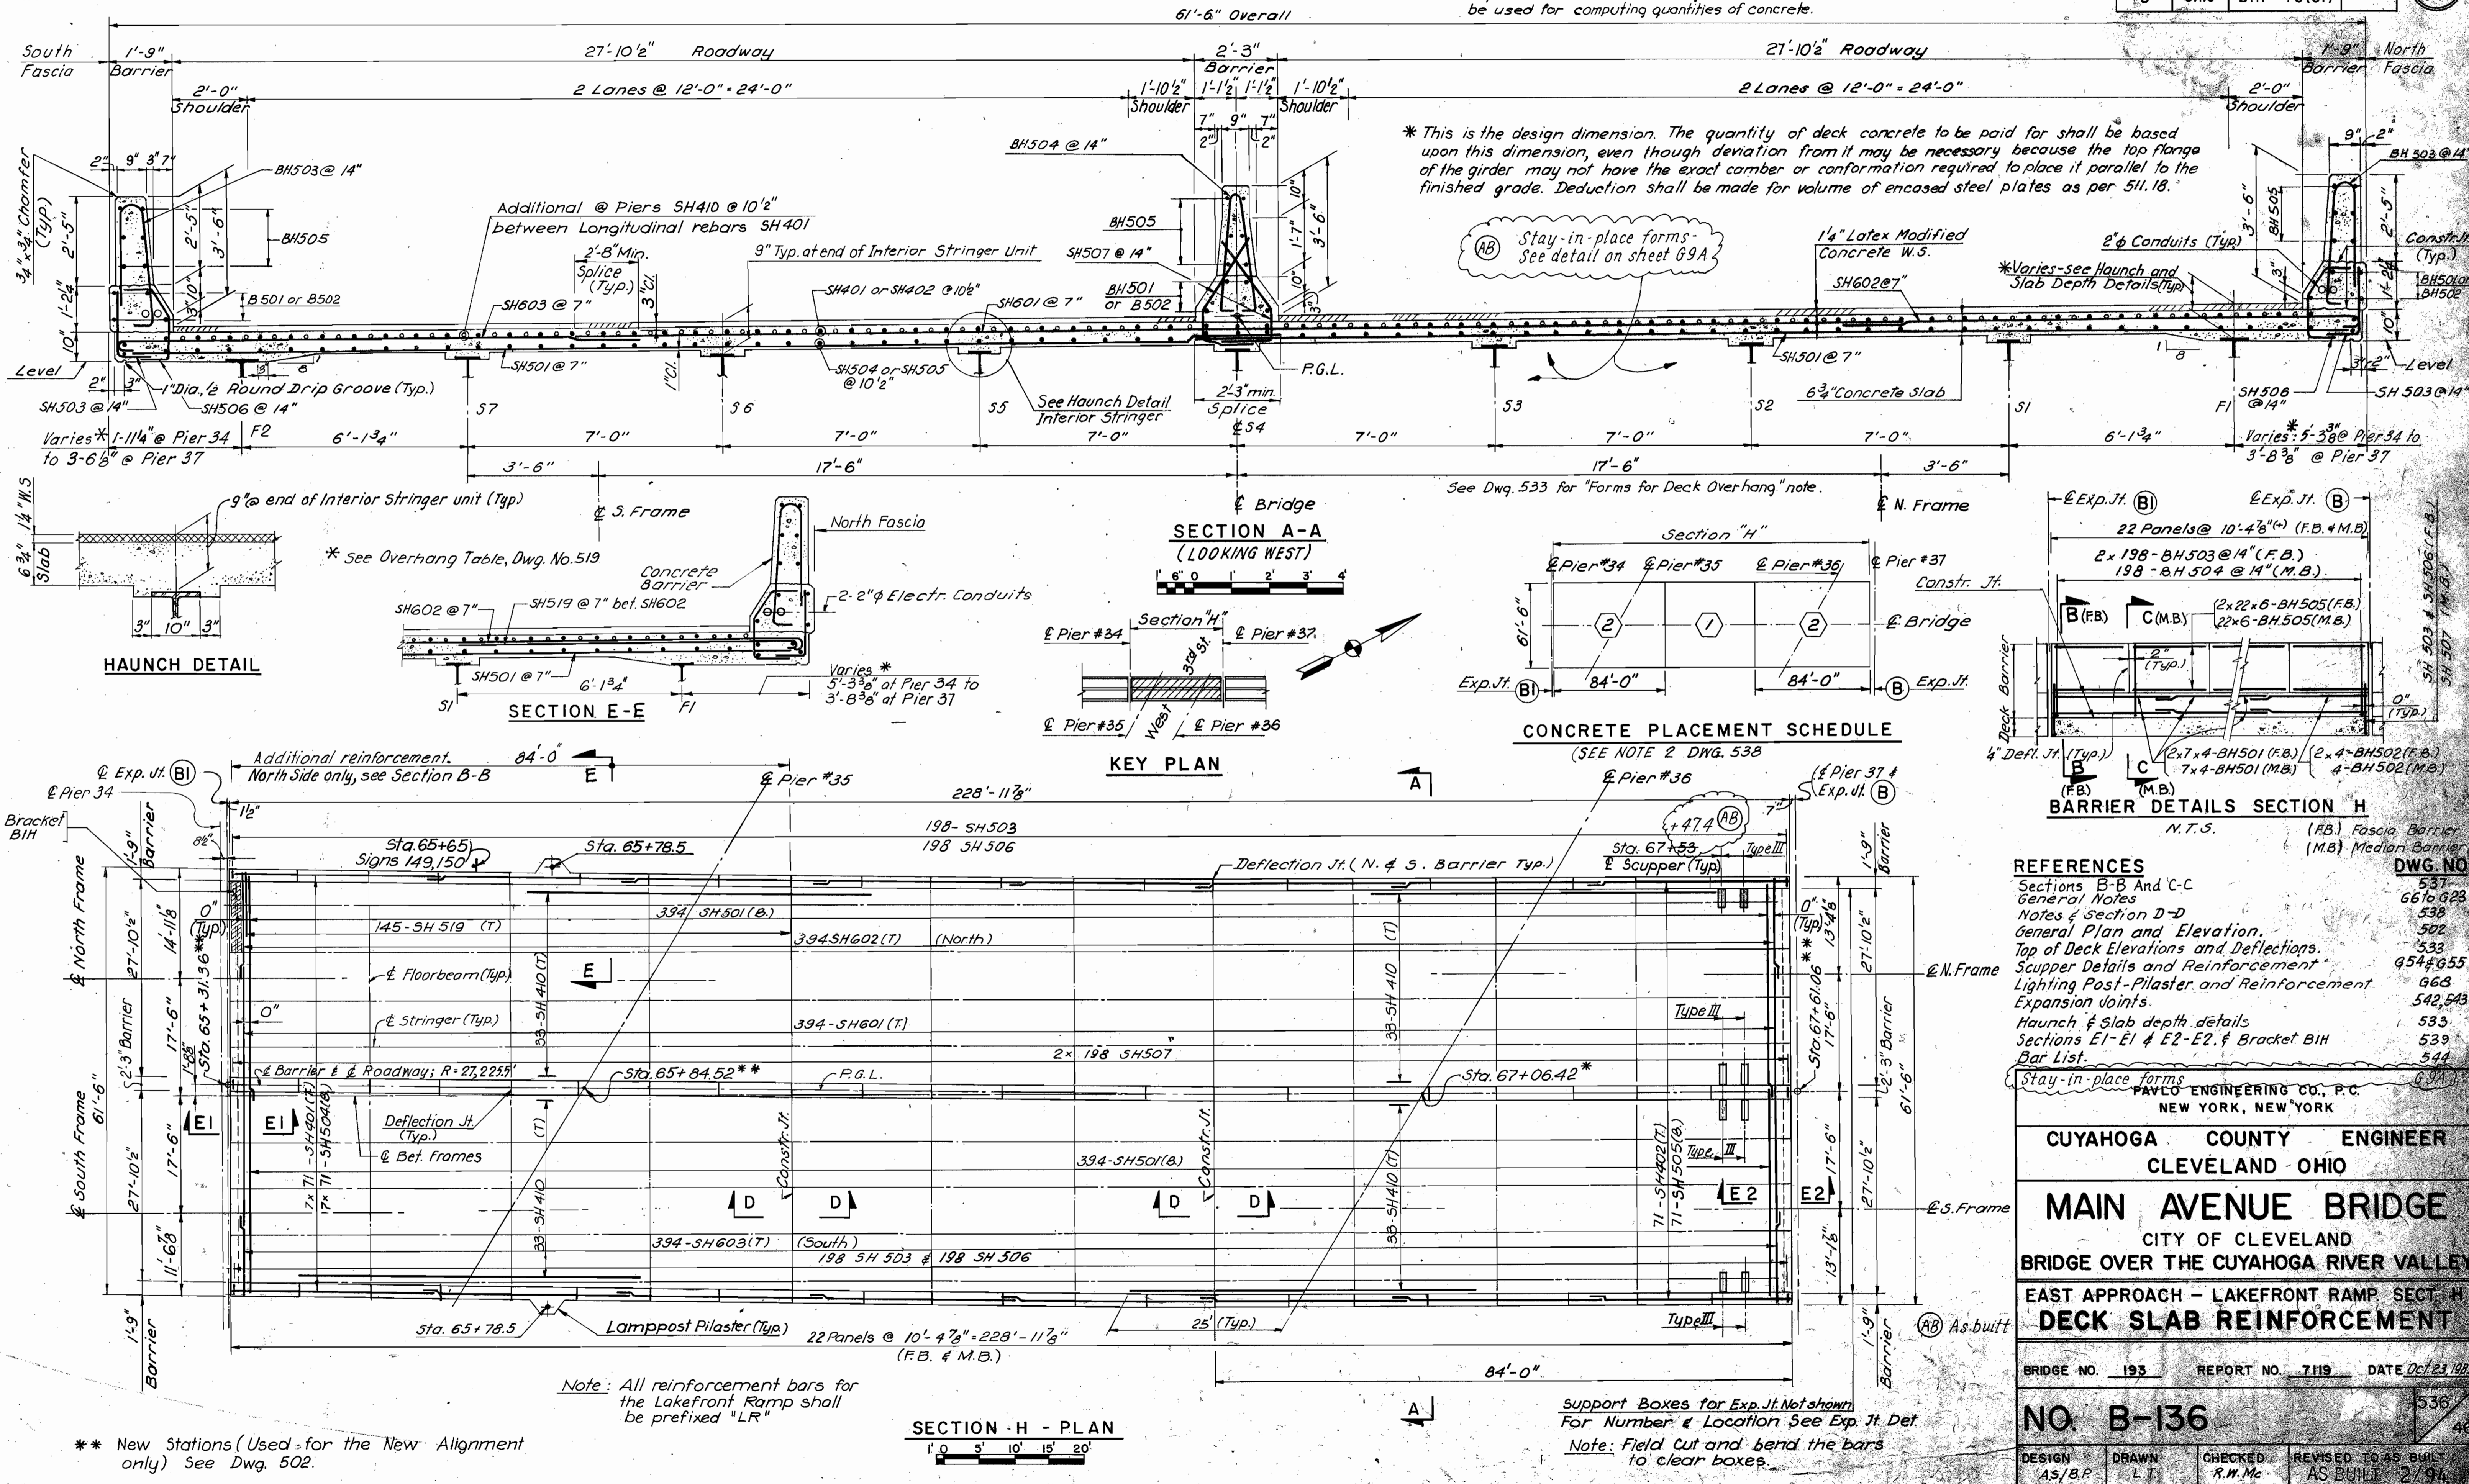


\*\* New Stations (Used for the New Alignment only) See Dwg. 502.

Note: All reinforcement bars for the Lakefront Ramp shall be prefixed "LR"

Support Boxes for Exp. Jt. Not shown  
For Number & Location See Exp. Jt. Det.  
Note: Field Cut and bend the bars to clear boxes.




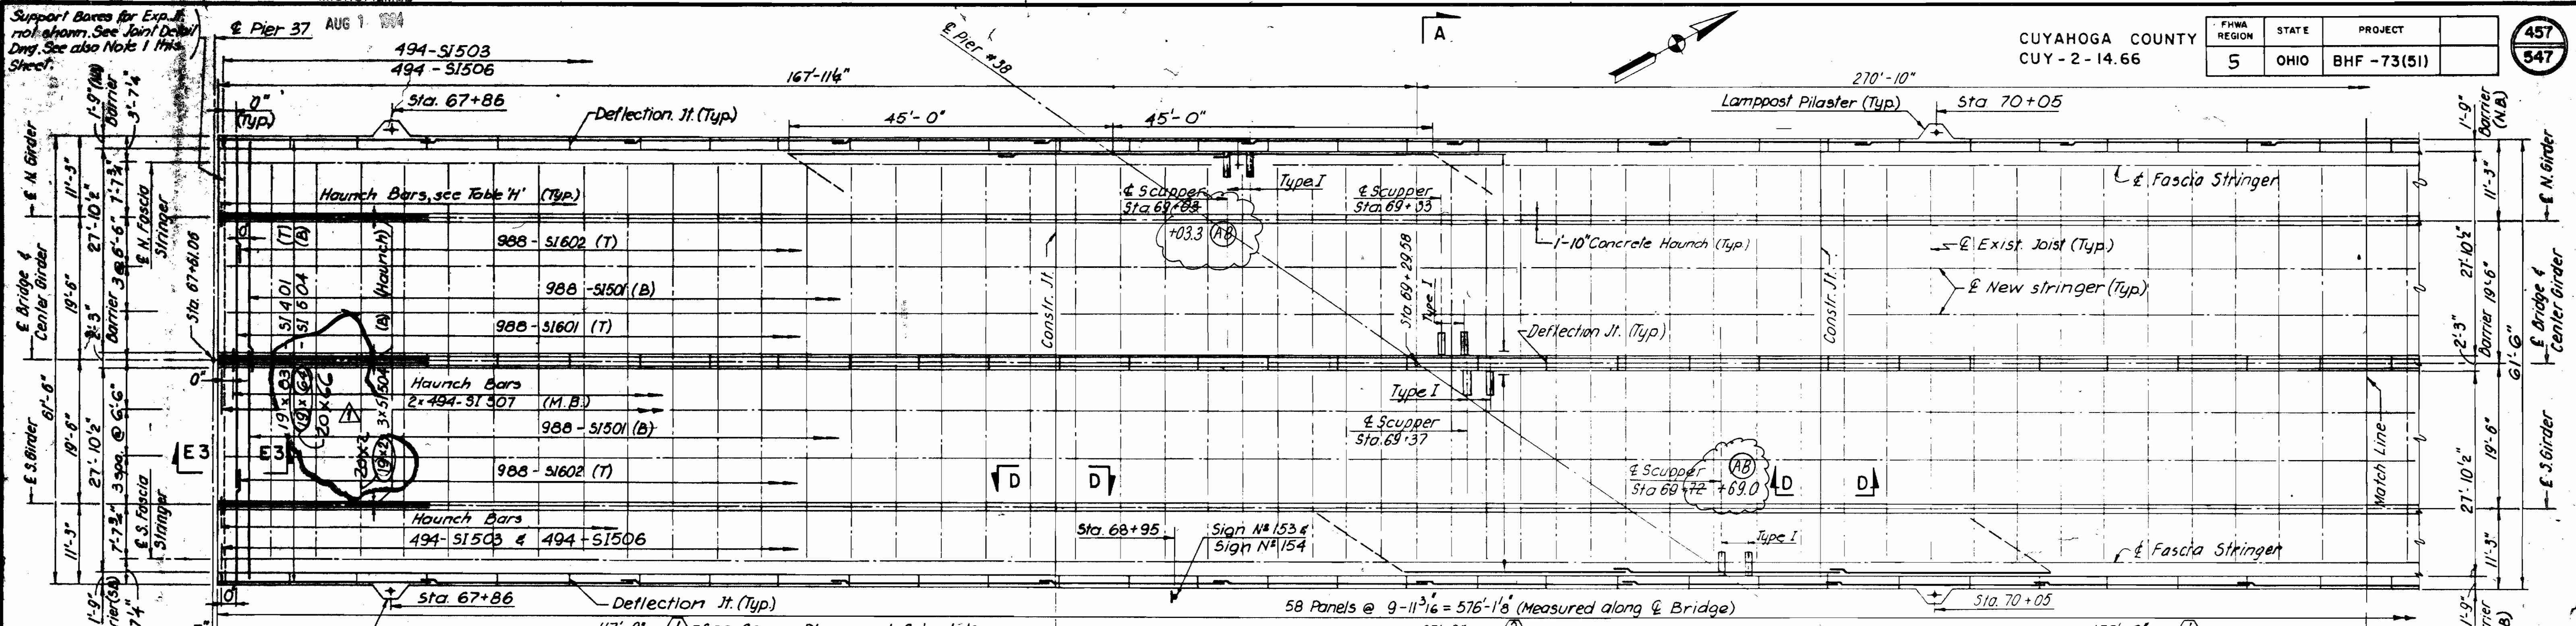


SECTION I - DECK - PART PLAN I

Note 1: Field cut and bend the bars to clear boxes.


Note 2: This is the design dimension. The quantity of deck concrete to be paid shall be based upon this dimension, even though deviation from it may be necessary because the top flange of the girder may not have the exact camber or conformation required to place it parallel to the finished grade. Deduction shall be made for volume of encased steel plates as per 511.18.

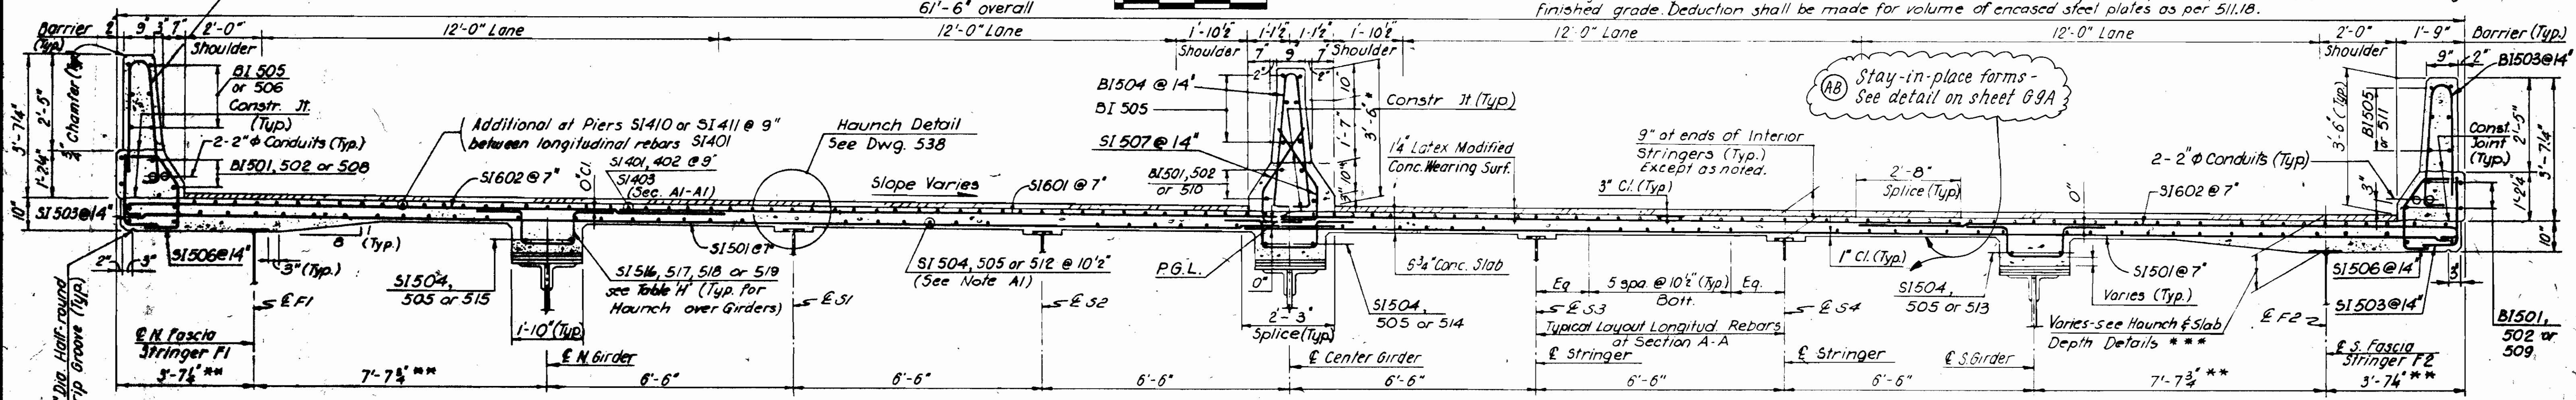


SECTION A-A (SECTION A1-A1 SIMILAR EXCEPT AS SHOWN)

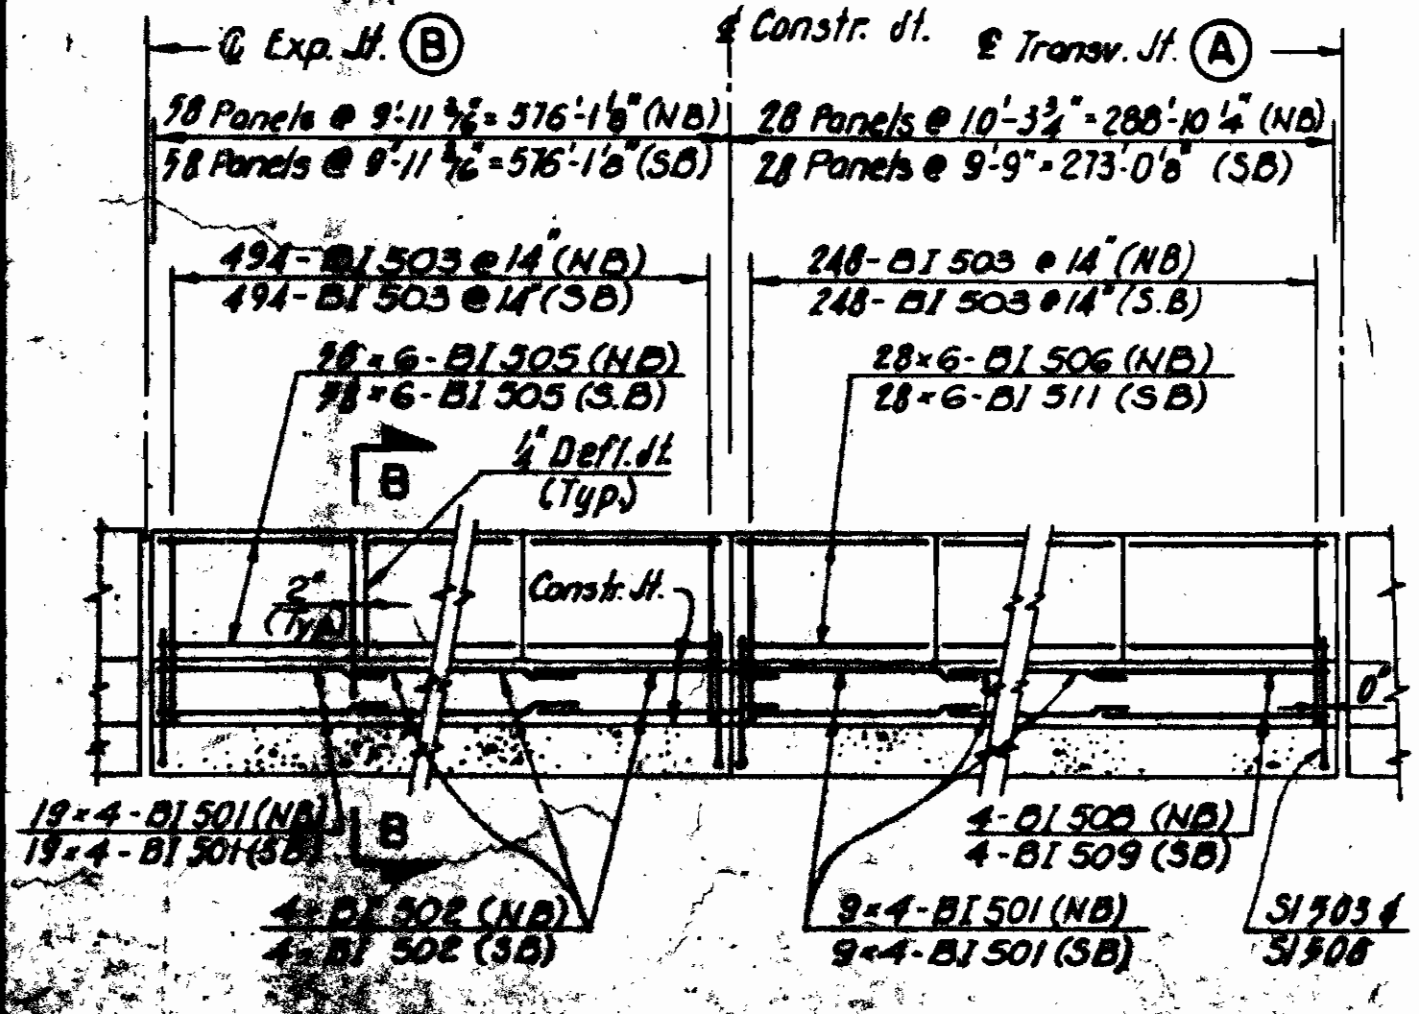


FASCIA BARRIER DETAILS

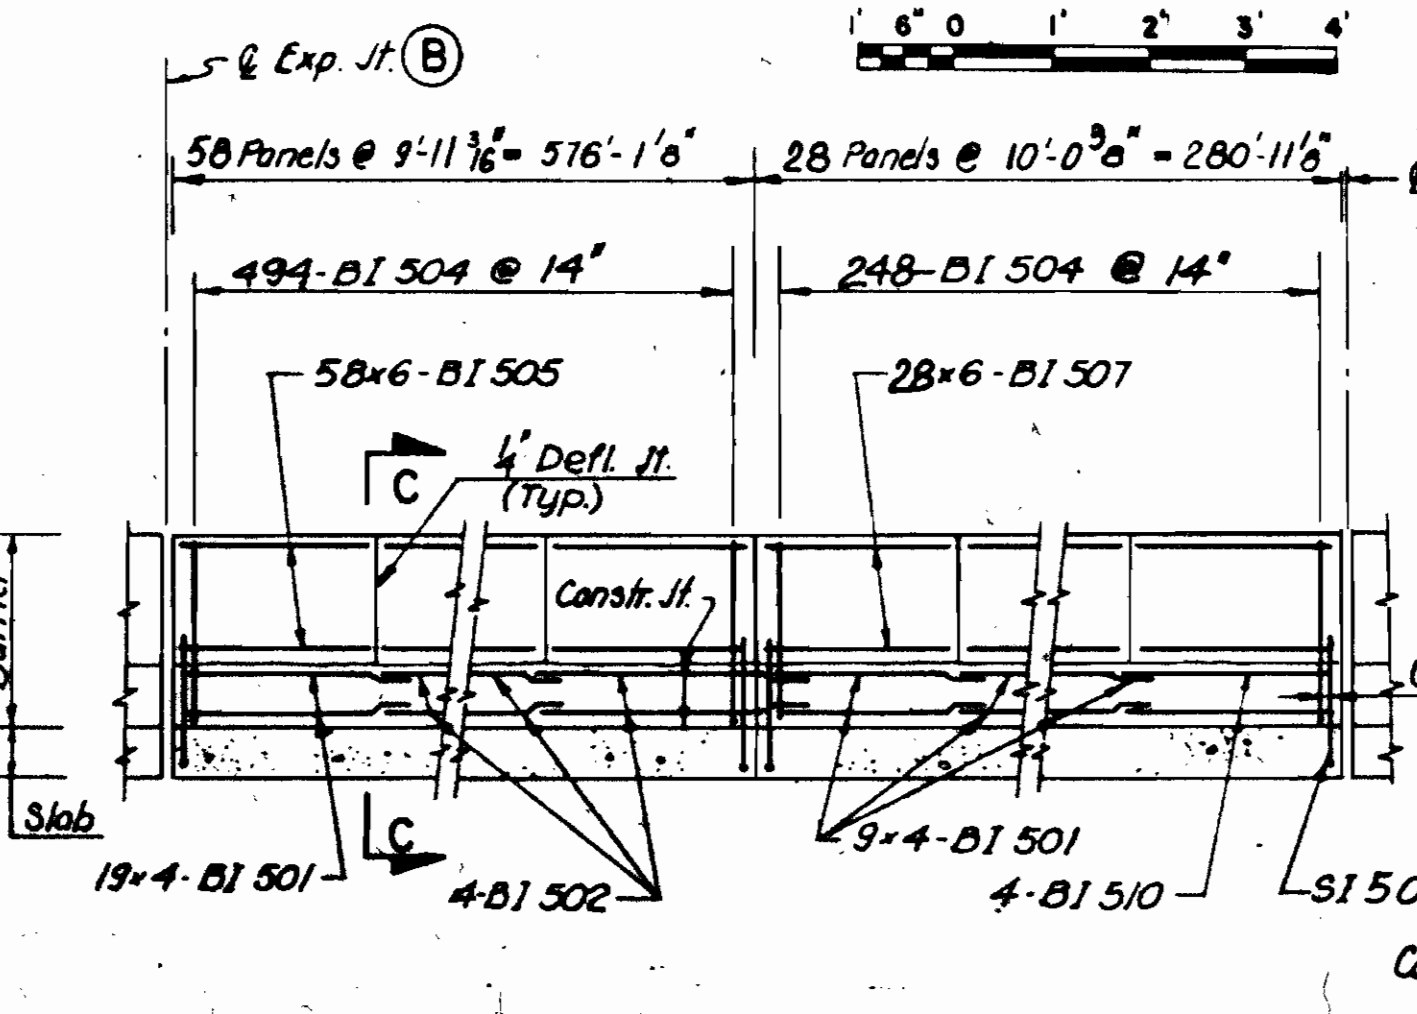

MEDIAN BARRIER DETAILS

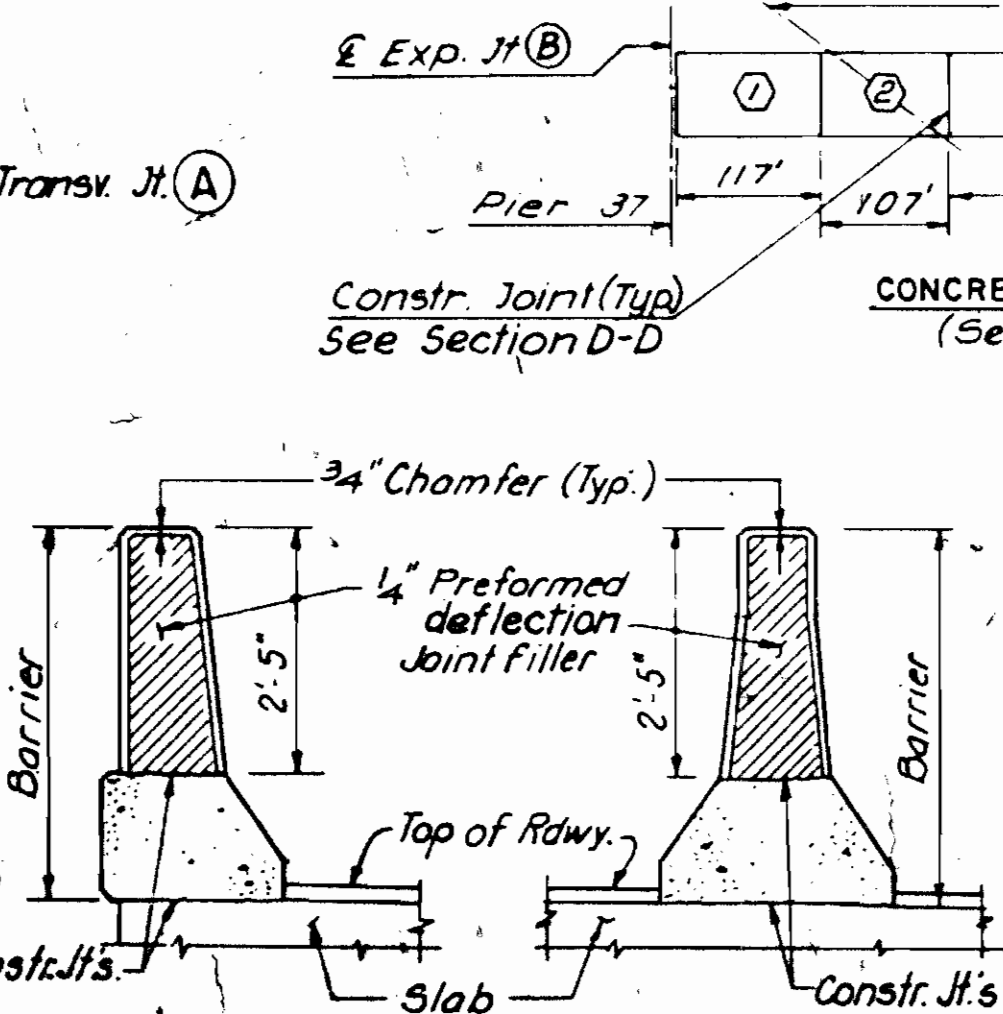

SECTION B-B (FASCIA BARRIER) SECTION C-C (MEDIAN BARRIER)

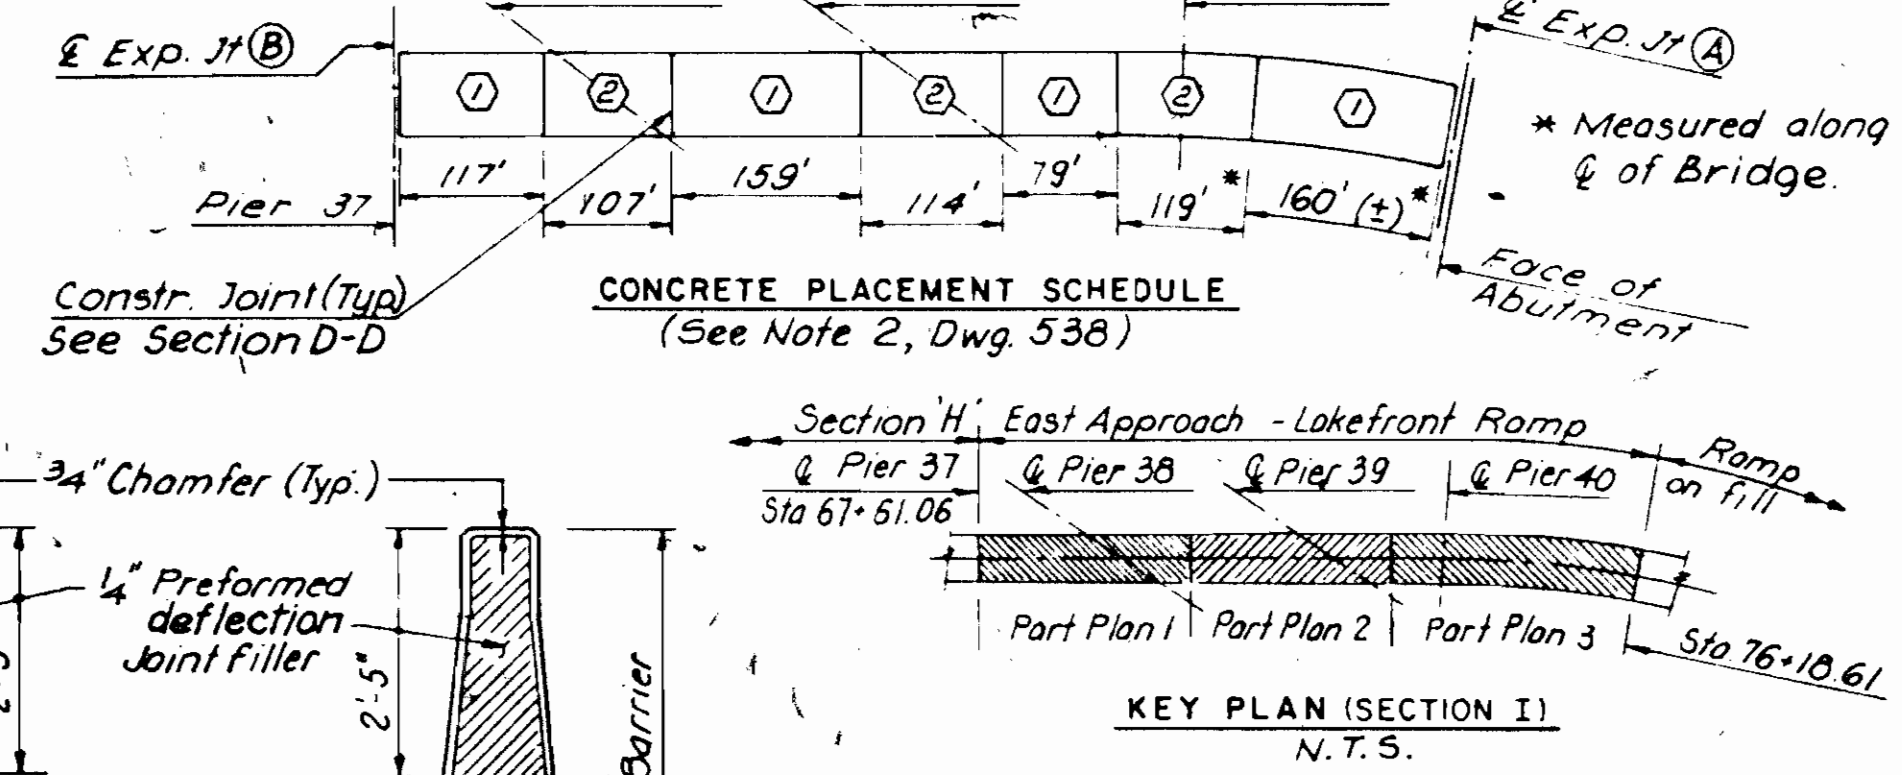

REFERENCES:

- General Notes  
Notes & Section D-D  
Top of Deck Elevation and Deflection  
Scupper Details and Reinforcement  
Lighting Post Pilaster and Reinforcement  
Exp. Joints A & B  
Sections E3 & E4, Haunch & Slab Depth Details  
Bar List  
Table H (Girders Haunch Reinforcement)
- DWG. NO.  
GG10 G23  
538  
534 & 535  
654-655  
663  
540, 541, 542, 543  
539  
545  
538, 539

Note A1: Bottom longitudinal bars in curved section of Bridge (Section A1-A1) are spaced uniformly at 10" o.c.

Note A2: As built

\*\* Dimension varies of curve

PAVLO ENGINEERING CO., P.C.  
NEW YORK, NEW YORK

CUYAHOGA COUNTY ENGINEER  
CLEVELAND OHIO


**MAIN AVENUE BRIDGE**  
CITY OF CLEVELAND  
BRIDGE OVER THE CUYAHOGA RIVER VALLEY

EAST APPROACH-LAKEFRONT RAMP-SECTION I  
DECK SLAB REINFORCEMENT - I

BRIDGE NO. 193 REPORT NO. 7119 DATE Oct 23, 1966

**NO. B-136**


DESIGN A.S/B.P. DRAWN L.T. CHECKED R.W.Mc REVISOR T.O.A.S. BUILT AS BUILT 2/94

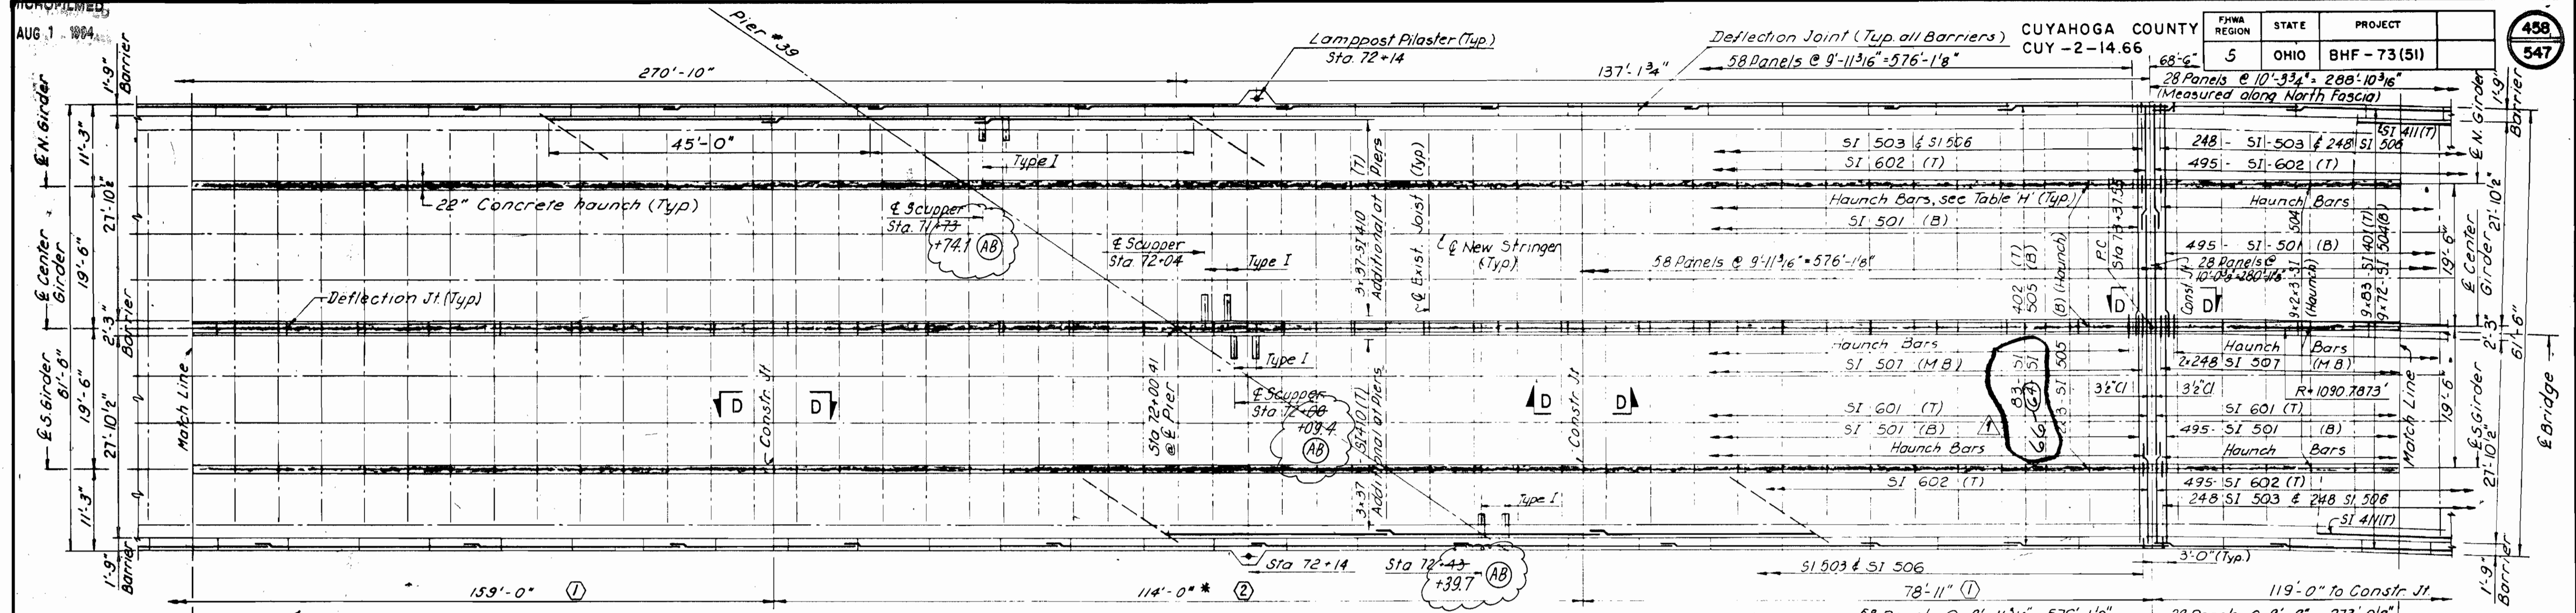

MINIMUM BAR LAP LENGTH	
BAR SIZE	MIN. LAP
# 4	1'-10"
# 5	2'-3"
# 6	2'-8"

• DECK SLAB DEPTH: The distance shown from top of deck slab to top of steel beam is the design dimension. The quantity of deck concrete to be paid for shall be based on this dimension less 1/4" W.S. even though deviation from it may be necessary because the top flange of the beam may not have the exact camber or conformation required to place it parallel to the finished grade.


• A Haunch width as shown on Haunch & Depth of Slab Details on Dwg's 534 and 526 shall be used for computing quantities of concrete.

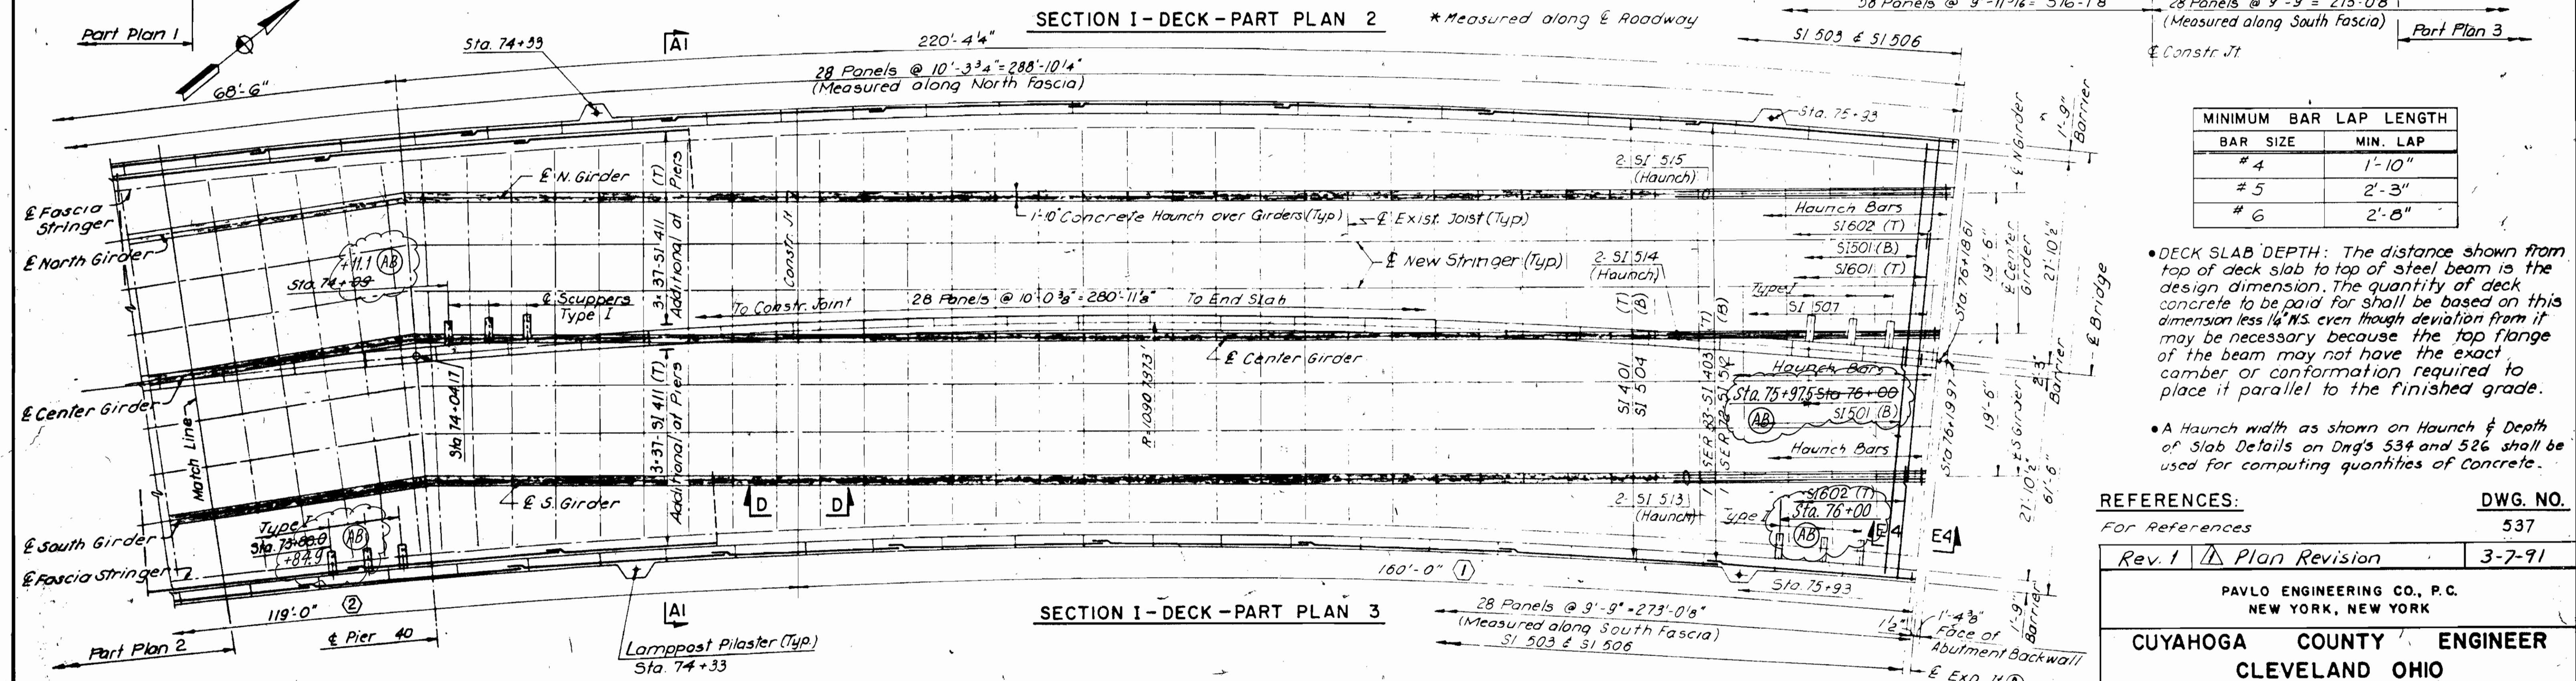

**NOTES:**

- All Deck concrete shall be "Lightweight Class 5"
- Alternate pouring schemes may be considered, which the Contractor shall submit to the Engineer for approval.
- The Contractor shall bend or field cut reinforcing steel as required.
- Preformed deflection joint filler in barriers shall be either 1/2" thick gray sponge rubber (AASHTO M-153) or 1/2" gray cellular polyvinyl chloride (PVC) sponge. Concrete in Barriers above upper construction joints shall be placed in alternate sections by the use of bulkheads. Closing sections shall be placed after removal of bulkheads & after placement of expansion joint filler.

STA. BEGINS	STA. ENDS	N. & S. GIRDER		CENTER GIRDER	
		BAR MARK	NO. OF BARS	BAR MARK	NO. OF BARS
67+60.66	69+44.58	SI 518	316	SI 517	158
69+44.58	72+25.40	SI 519	402	SI 518	241
72+25.40	72+79.77	SI 518	92	SI 518	46
72+79.77	73+37.55	SI 517	90	SI 517	49
73+37.55	74+02.07	SI 517	114	SI 517	57
74+02.07	75+78.90	SI 516	370	SI 516	155
75+78.90	76+18.48	SI 517	70	SI 517	35

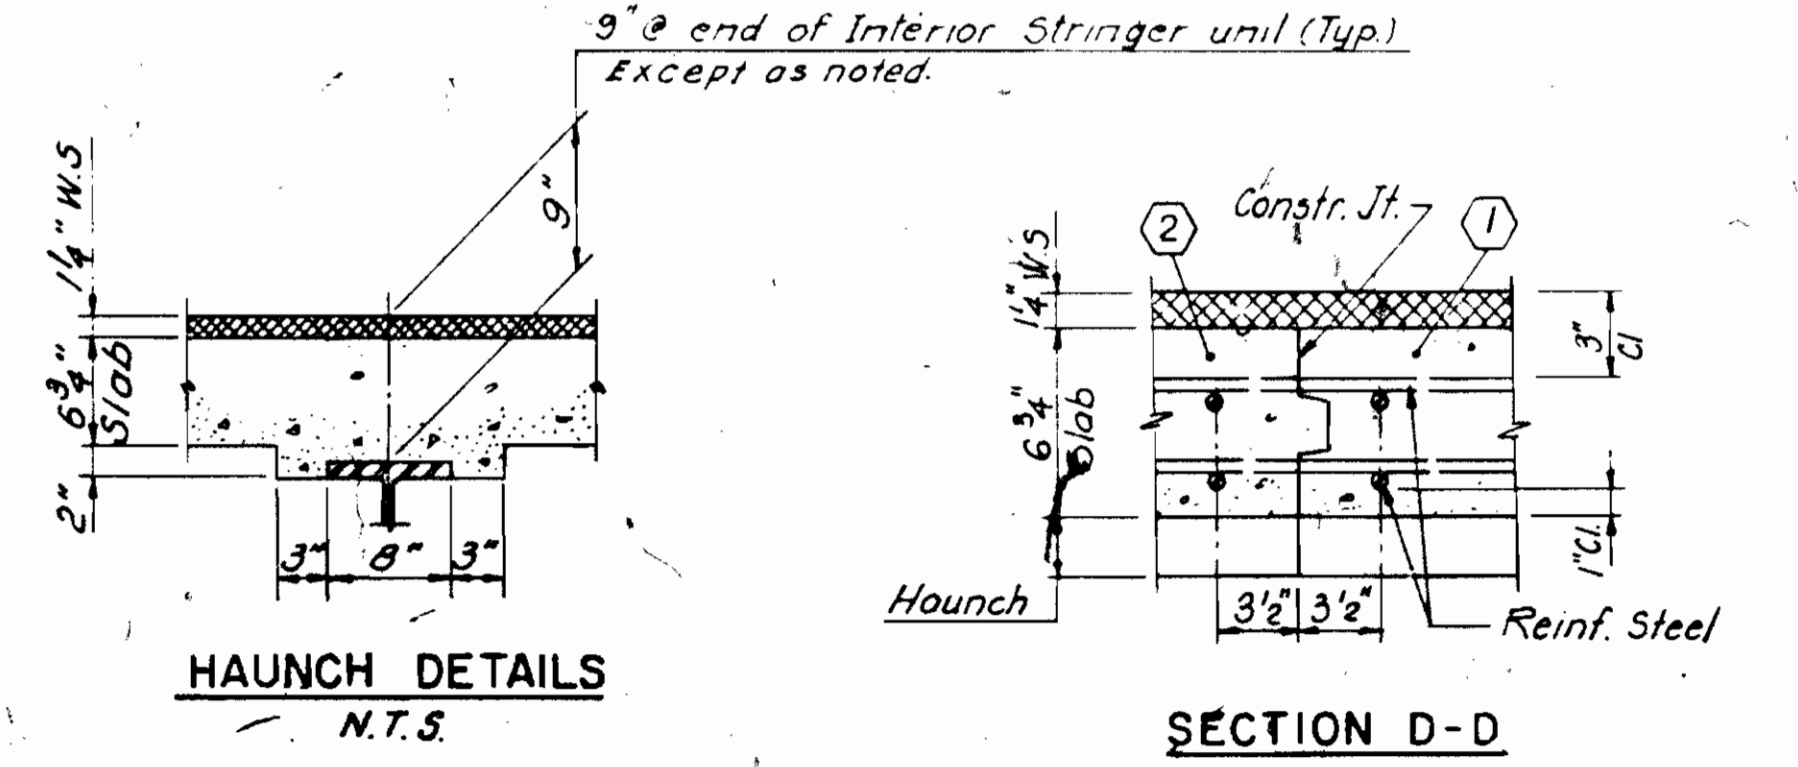

**REFERENCES:** For References

Rev.	Description	DWG. NO.
1	Plan Revision	3-7-91

PAVLO ENGINEERING CO., P.C.  
NEW YORK, NEW YORK

**CUYAHOGA COUNTY ENGINEER**  
CLEVELAND OHIO

**MAIN AVENUE BRIDGE**  
CITY OF CLEVELAND  
BRIDGE OVER THE CUYAHOGA RIVER VALLEY

**EAST APPROACH-LAKEFRONT RAMP SECTION I**  
**DECK SLAB REINFORCEMENT - 2**


BRIDGE NO. 193 REPORT NO. 7119 DATE Oct 23, 1992

**NO. B-136**


DESIGN	DRAWN	CHECKED	REVISED TO AS BUILT
AS/A.P.	T.C.	R.M.Mc.	AS BUILT 2/94

538  
46


ODOT 3-14-91 TES

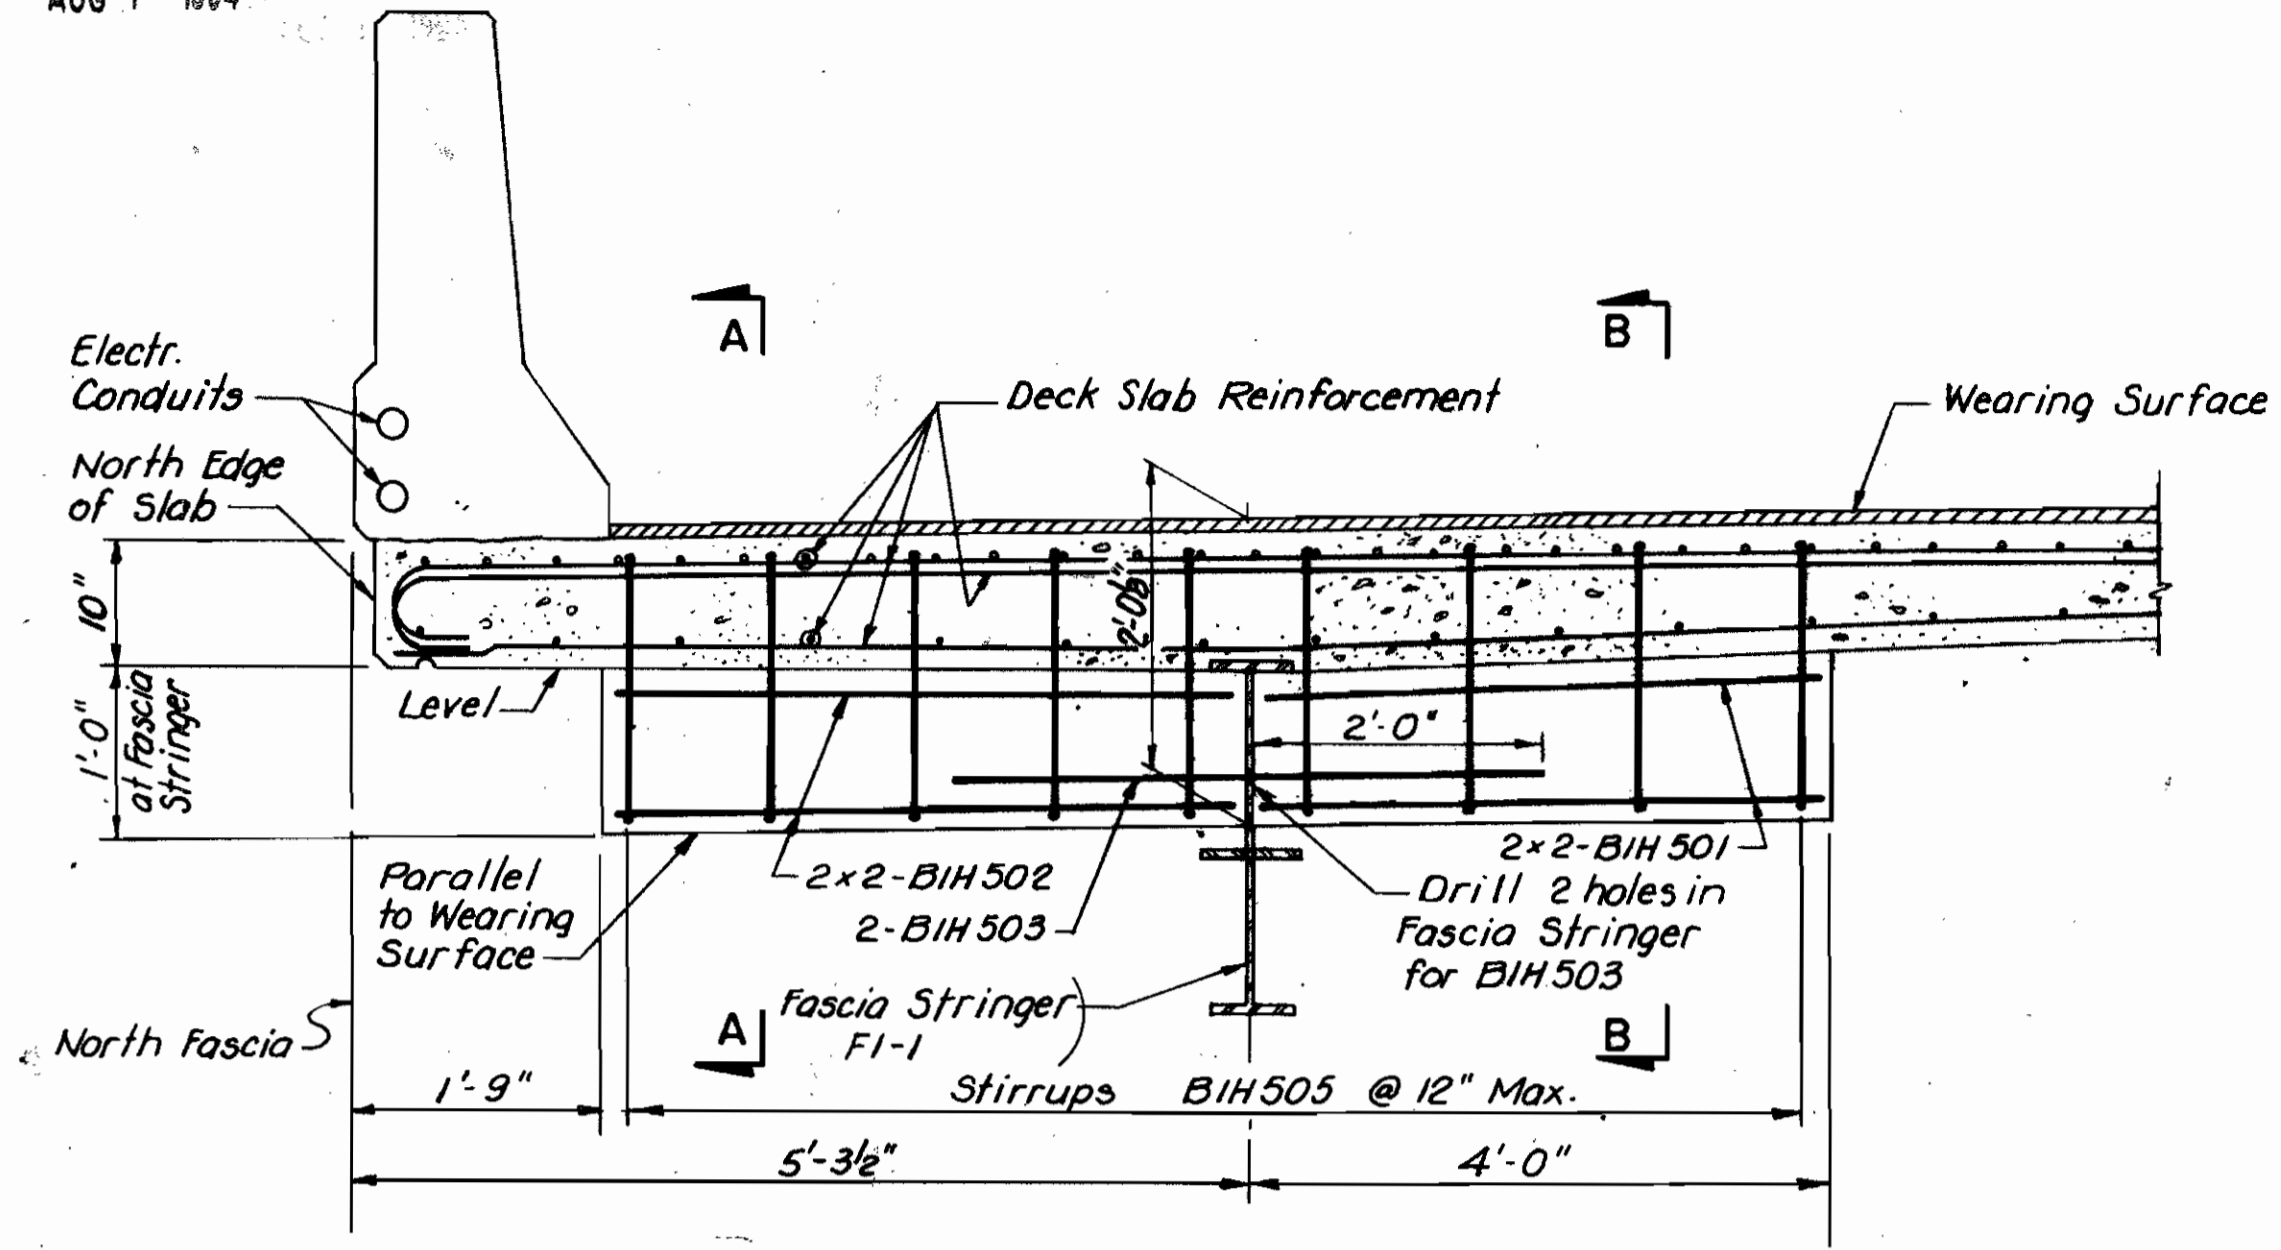


**BRACKET BIH**

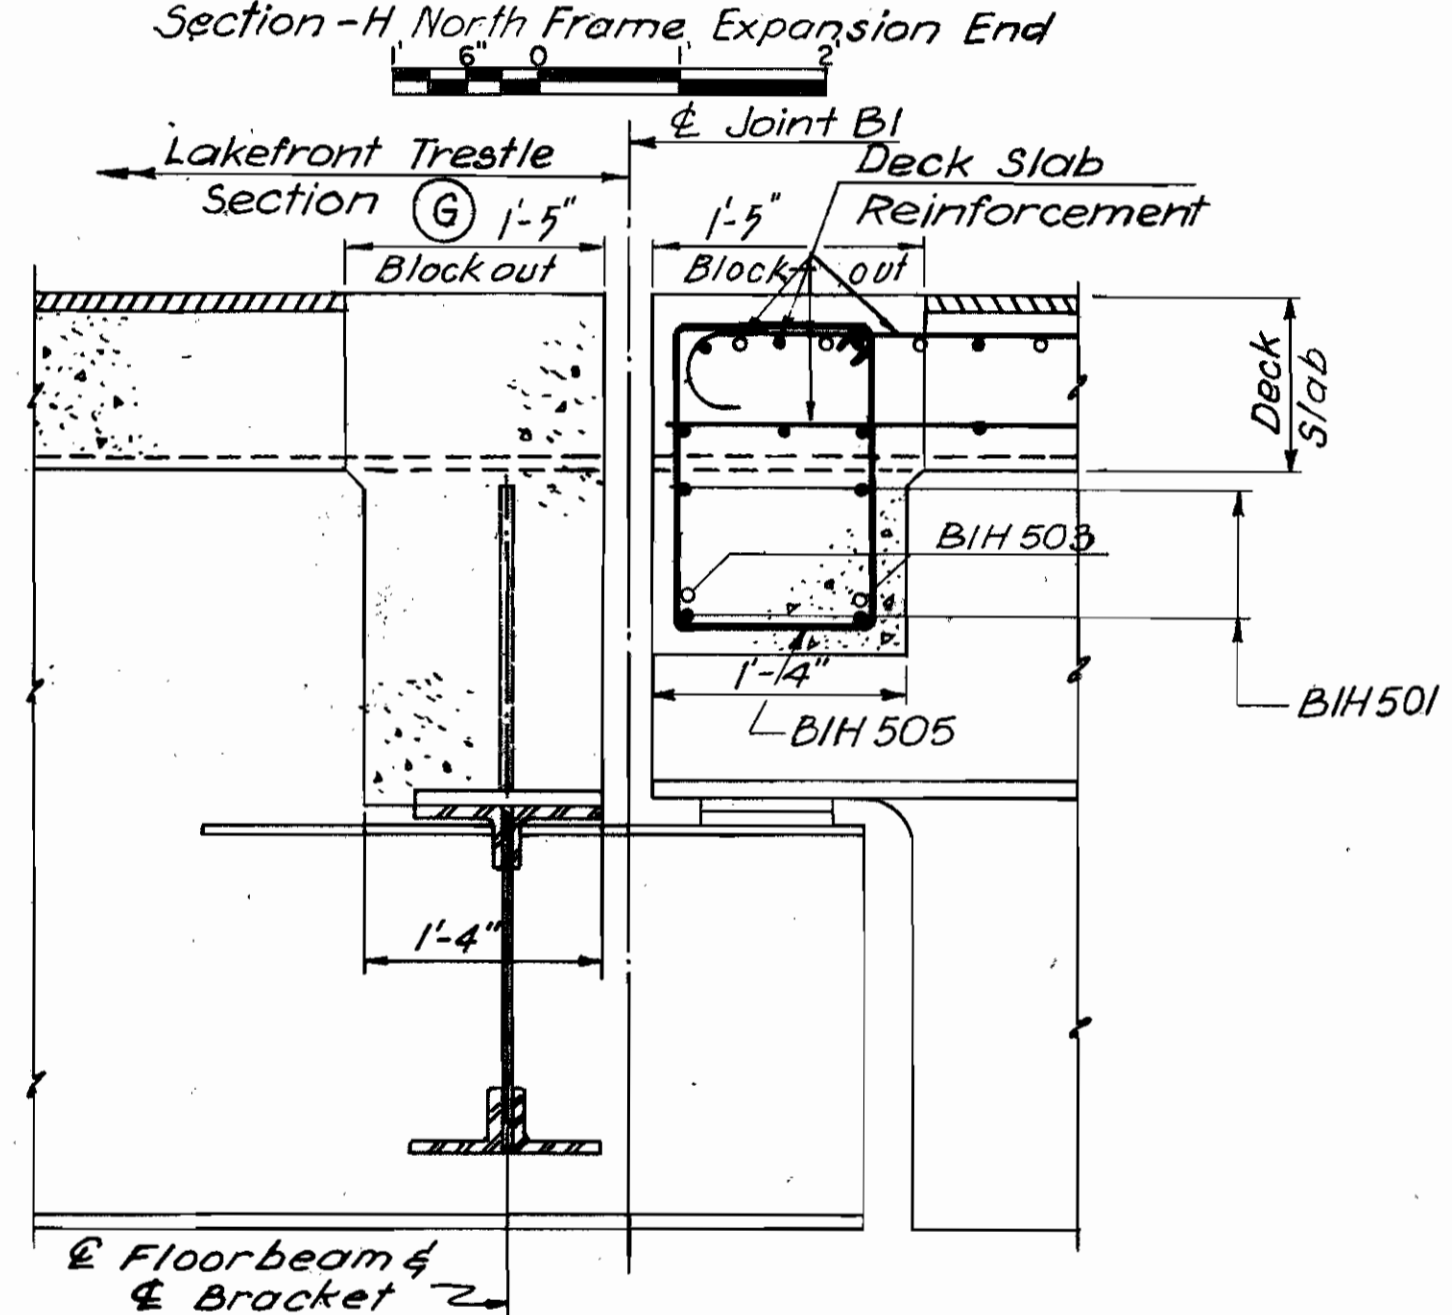


**SECTION B-B**

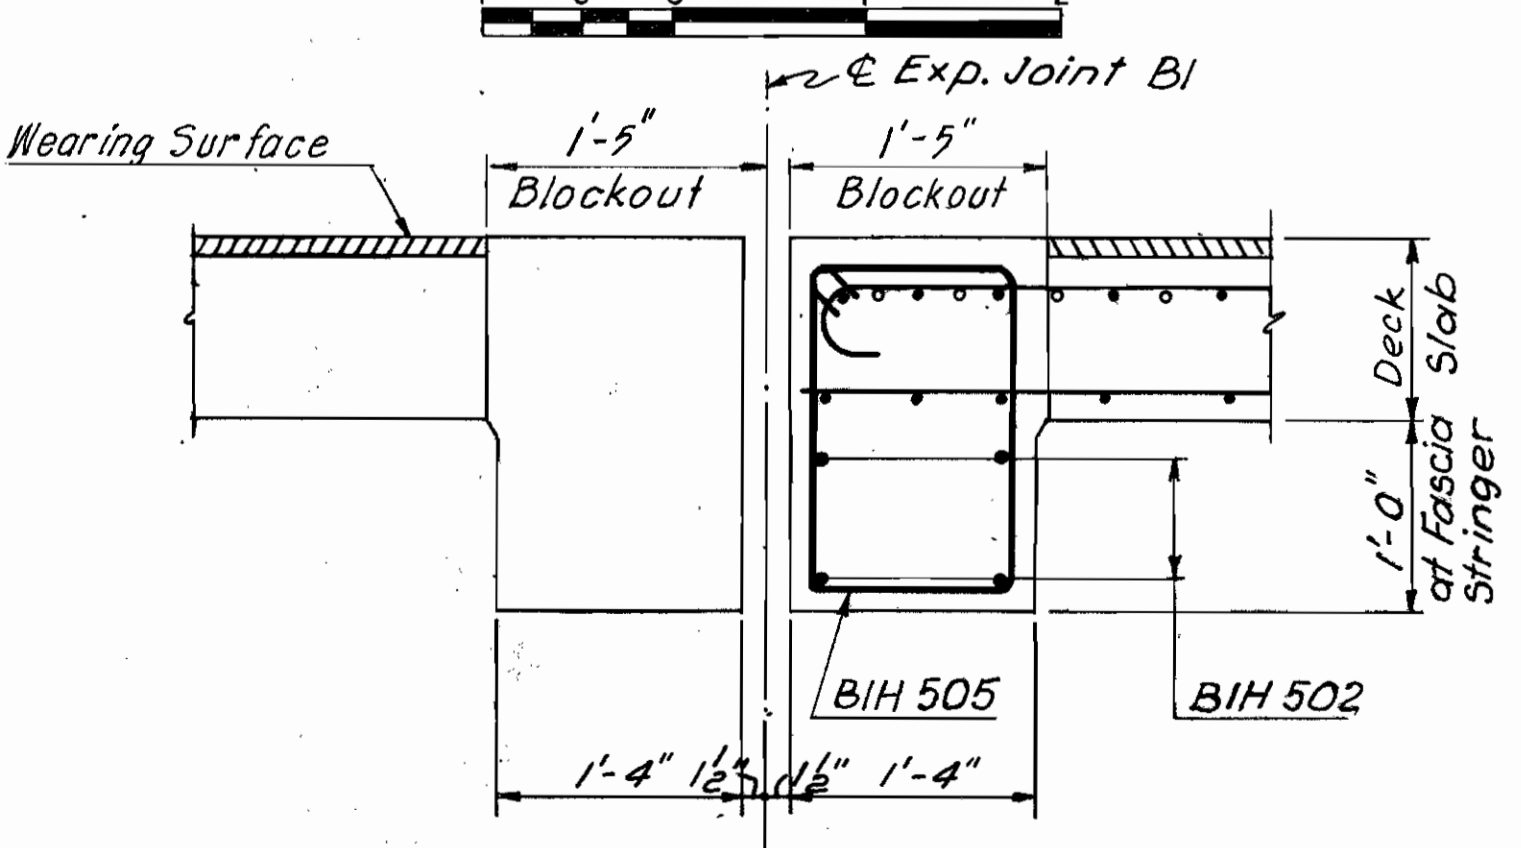

**SECTION A-A**

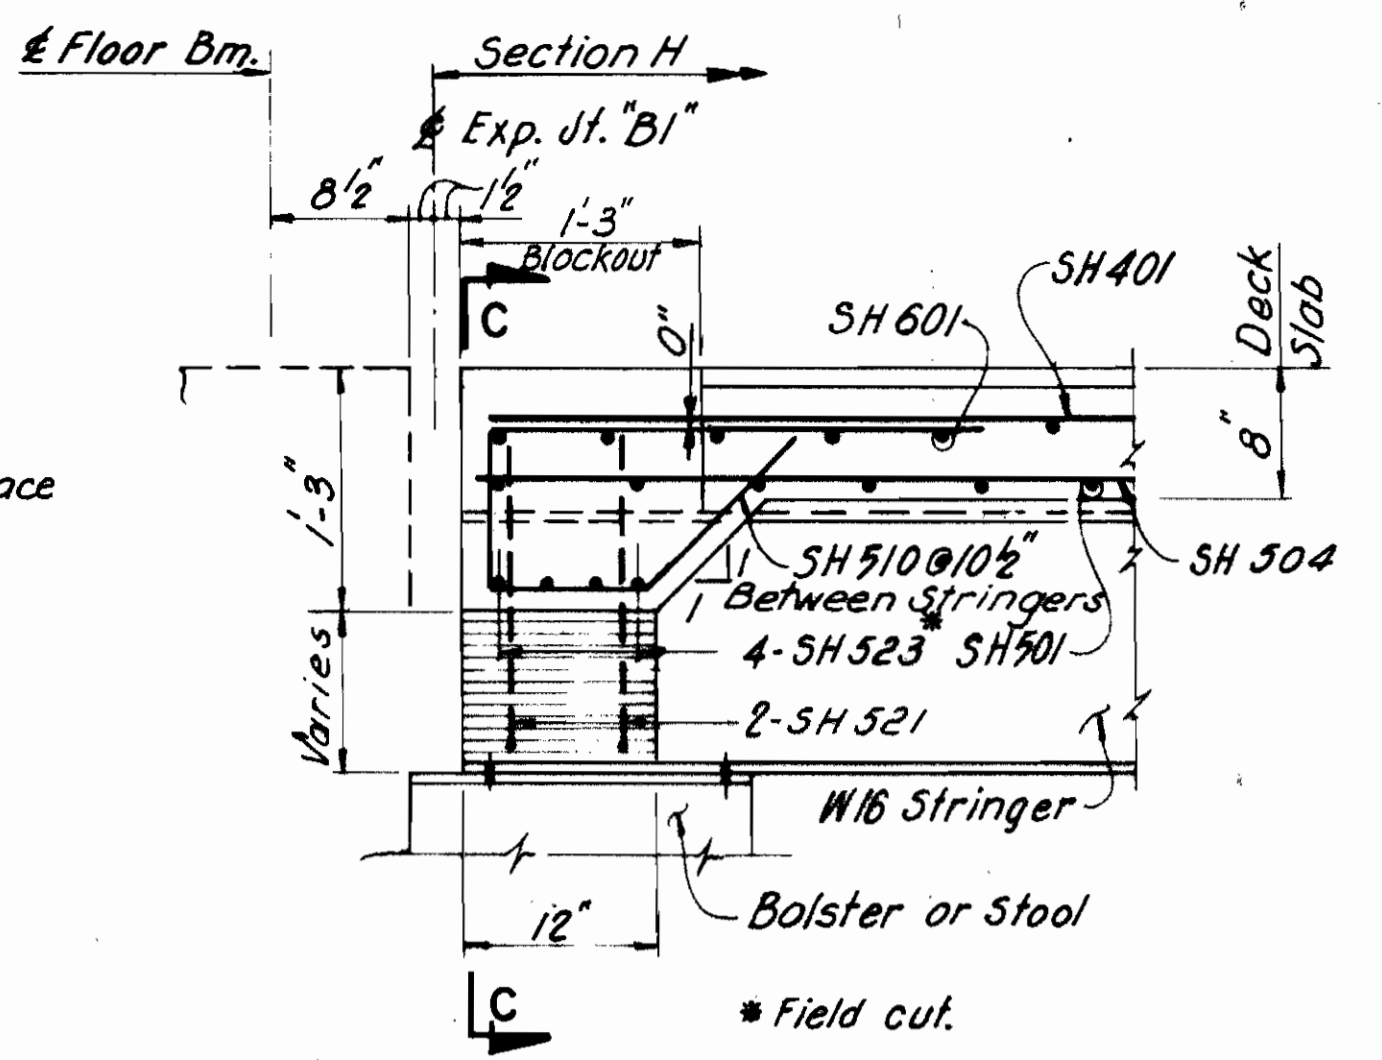


**SECTION E1-E1**

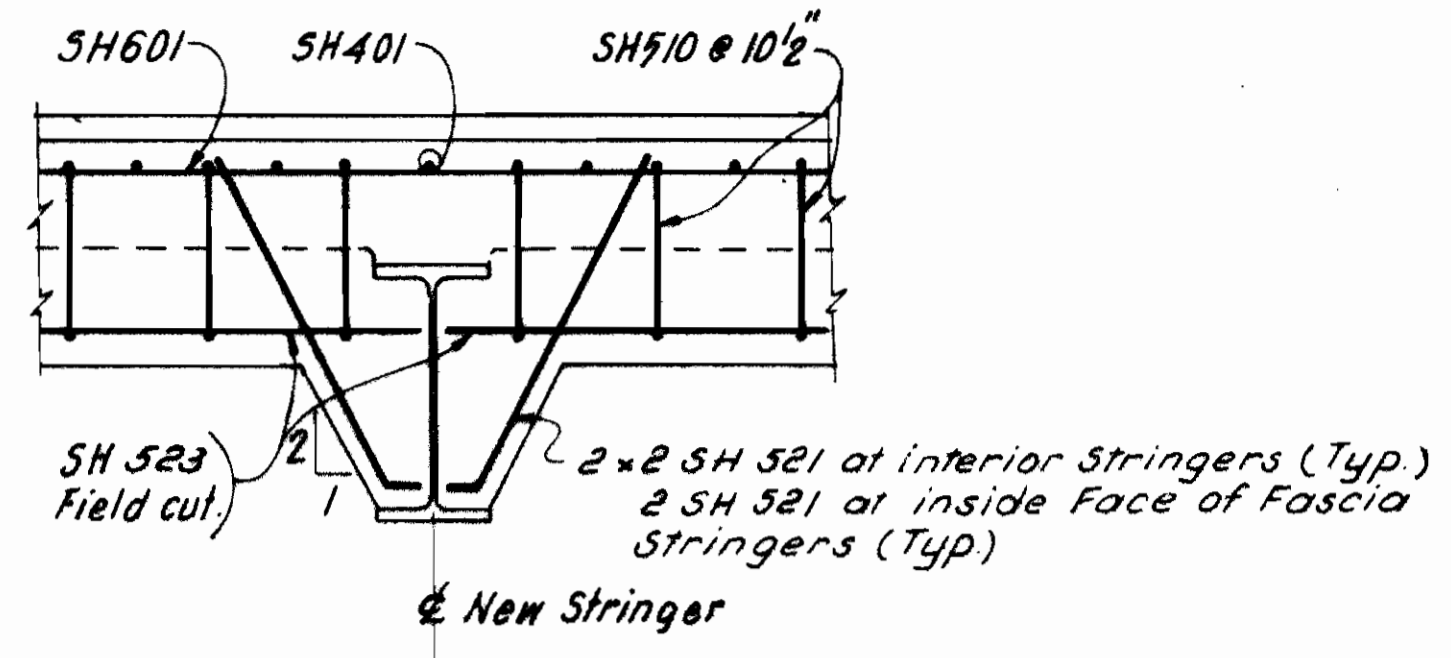


**ELEVATION C-C**


\*\* Bars shall be arranged between the Fascia Stringers.

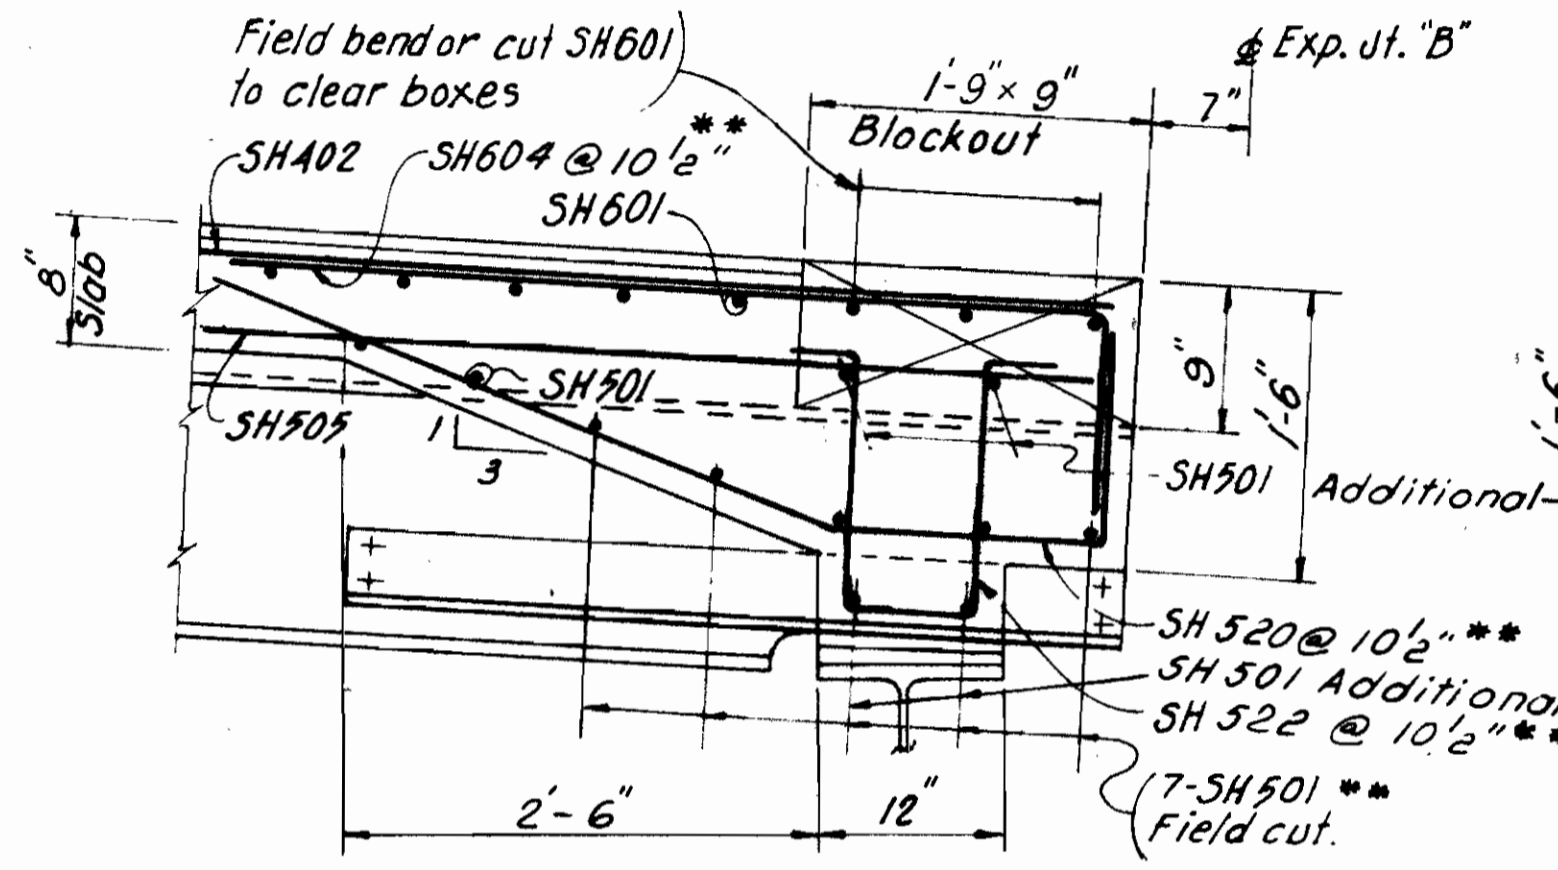

**SECTION E2-E2**

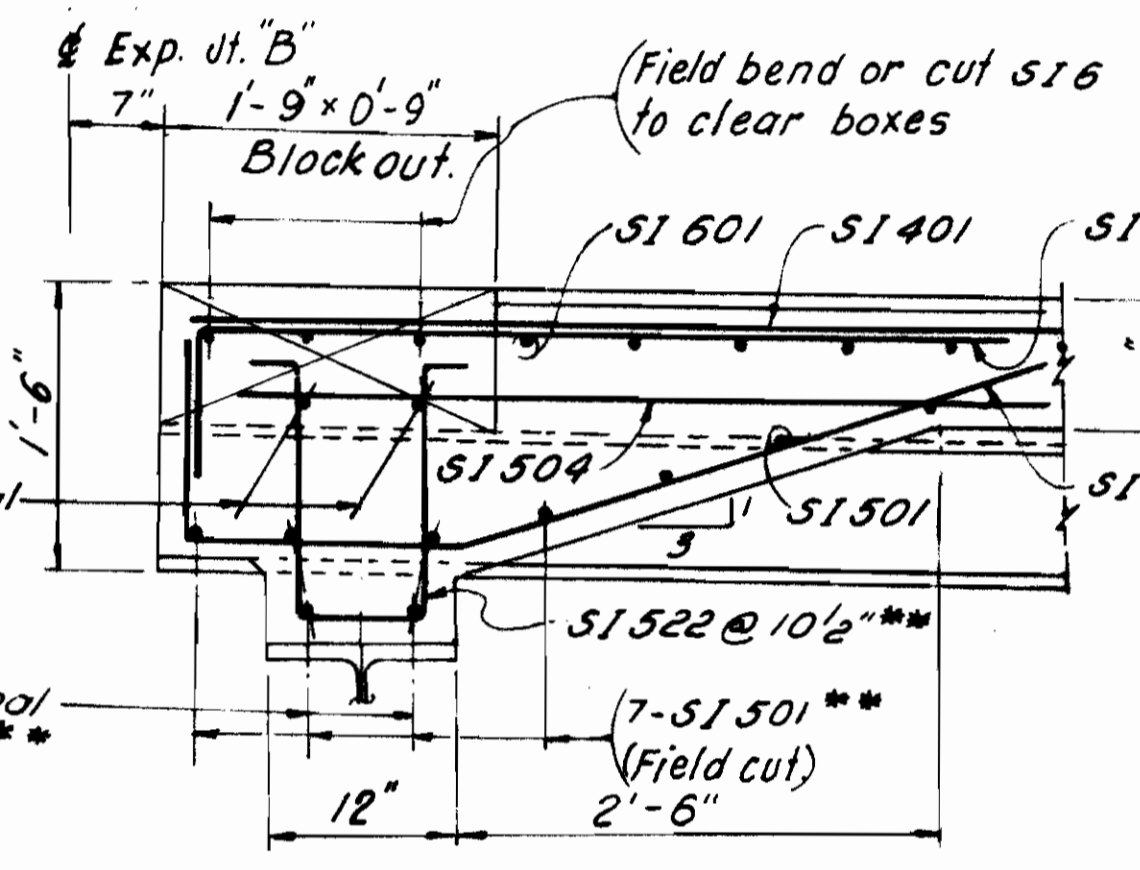

**SECTION E3-E3**

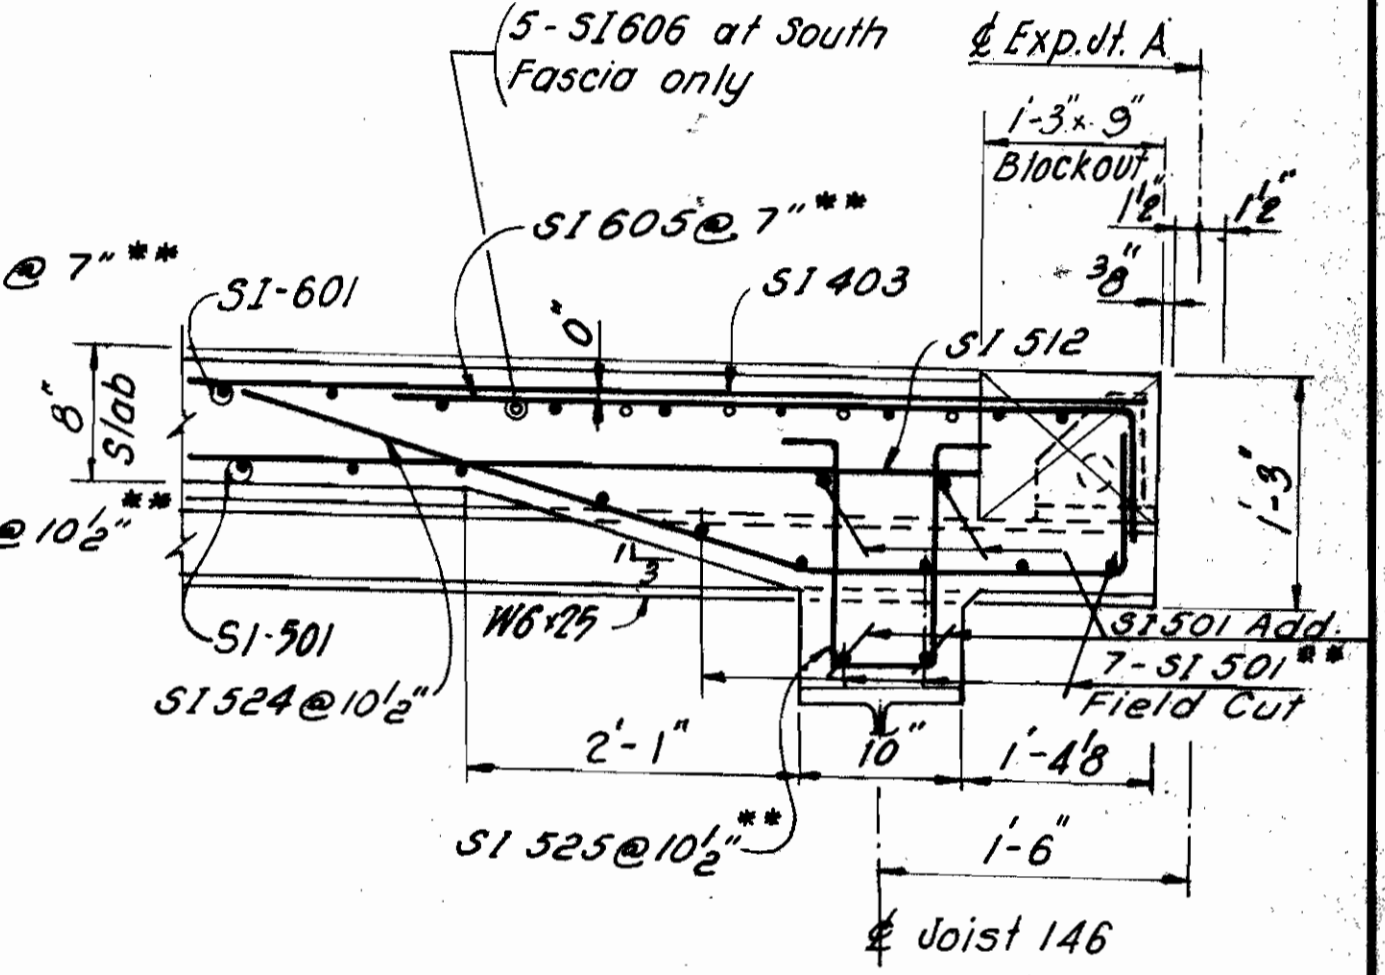

**SECTION E4-E4**

REFERENCES:	DWG. NO.
Deck Slab Reinforcement Section H	536
Deck Slab Reinforcement-1/2 Section I	537 & 538
Location Sections E1-E1 & E2-E2	536
Location Section E3-E3	537
Location of Bracket B-IH	536
For Details of Exp. Jt. B1, see	461
For Details of Exp. Jt. B, see	542
For Details of Exp. Jt. A, see	540
Bar Lists	544, 545

PAVLO ENGINEERING CO., P.C.  
NEW YORK, NEW YORK

**CUYAHOGA COUNTY ENGINEER**  
CLEVELAND OHIO

**MAIN AVENUE BRIDGE**  
CITY OF CLEVELAND  
BRIDGE OVER THE CUYAHOGA RIVER VALLEY

EAST APPROACH LAKEFRONT RAMP-SECTION H & I  
**DECK SLAB REINFORCEMENT-DETAILS**

BRIDGE NO. 193    REPORT NO. 7119    DATE Oct. 23/1982

**NO. B-136**    539

DESIGN B.R.	DRAWN T.C.	CHECKED R.Mc.	REVISED TO AS BUILT AS BUILT 2/94
----------------	---------------	------------------	--------------------------------------

46


# SCHEMATIC LOCATION PLAN

FHWA REGION	STATE	PROJECT
5	OHIO	BHF-73(51)

467  
547

CUYAHOGA COUNTY  
CUY-2-14.66

601  
677

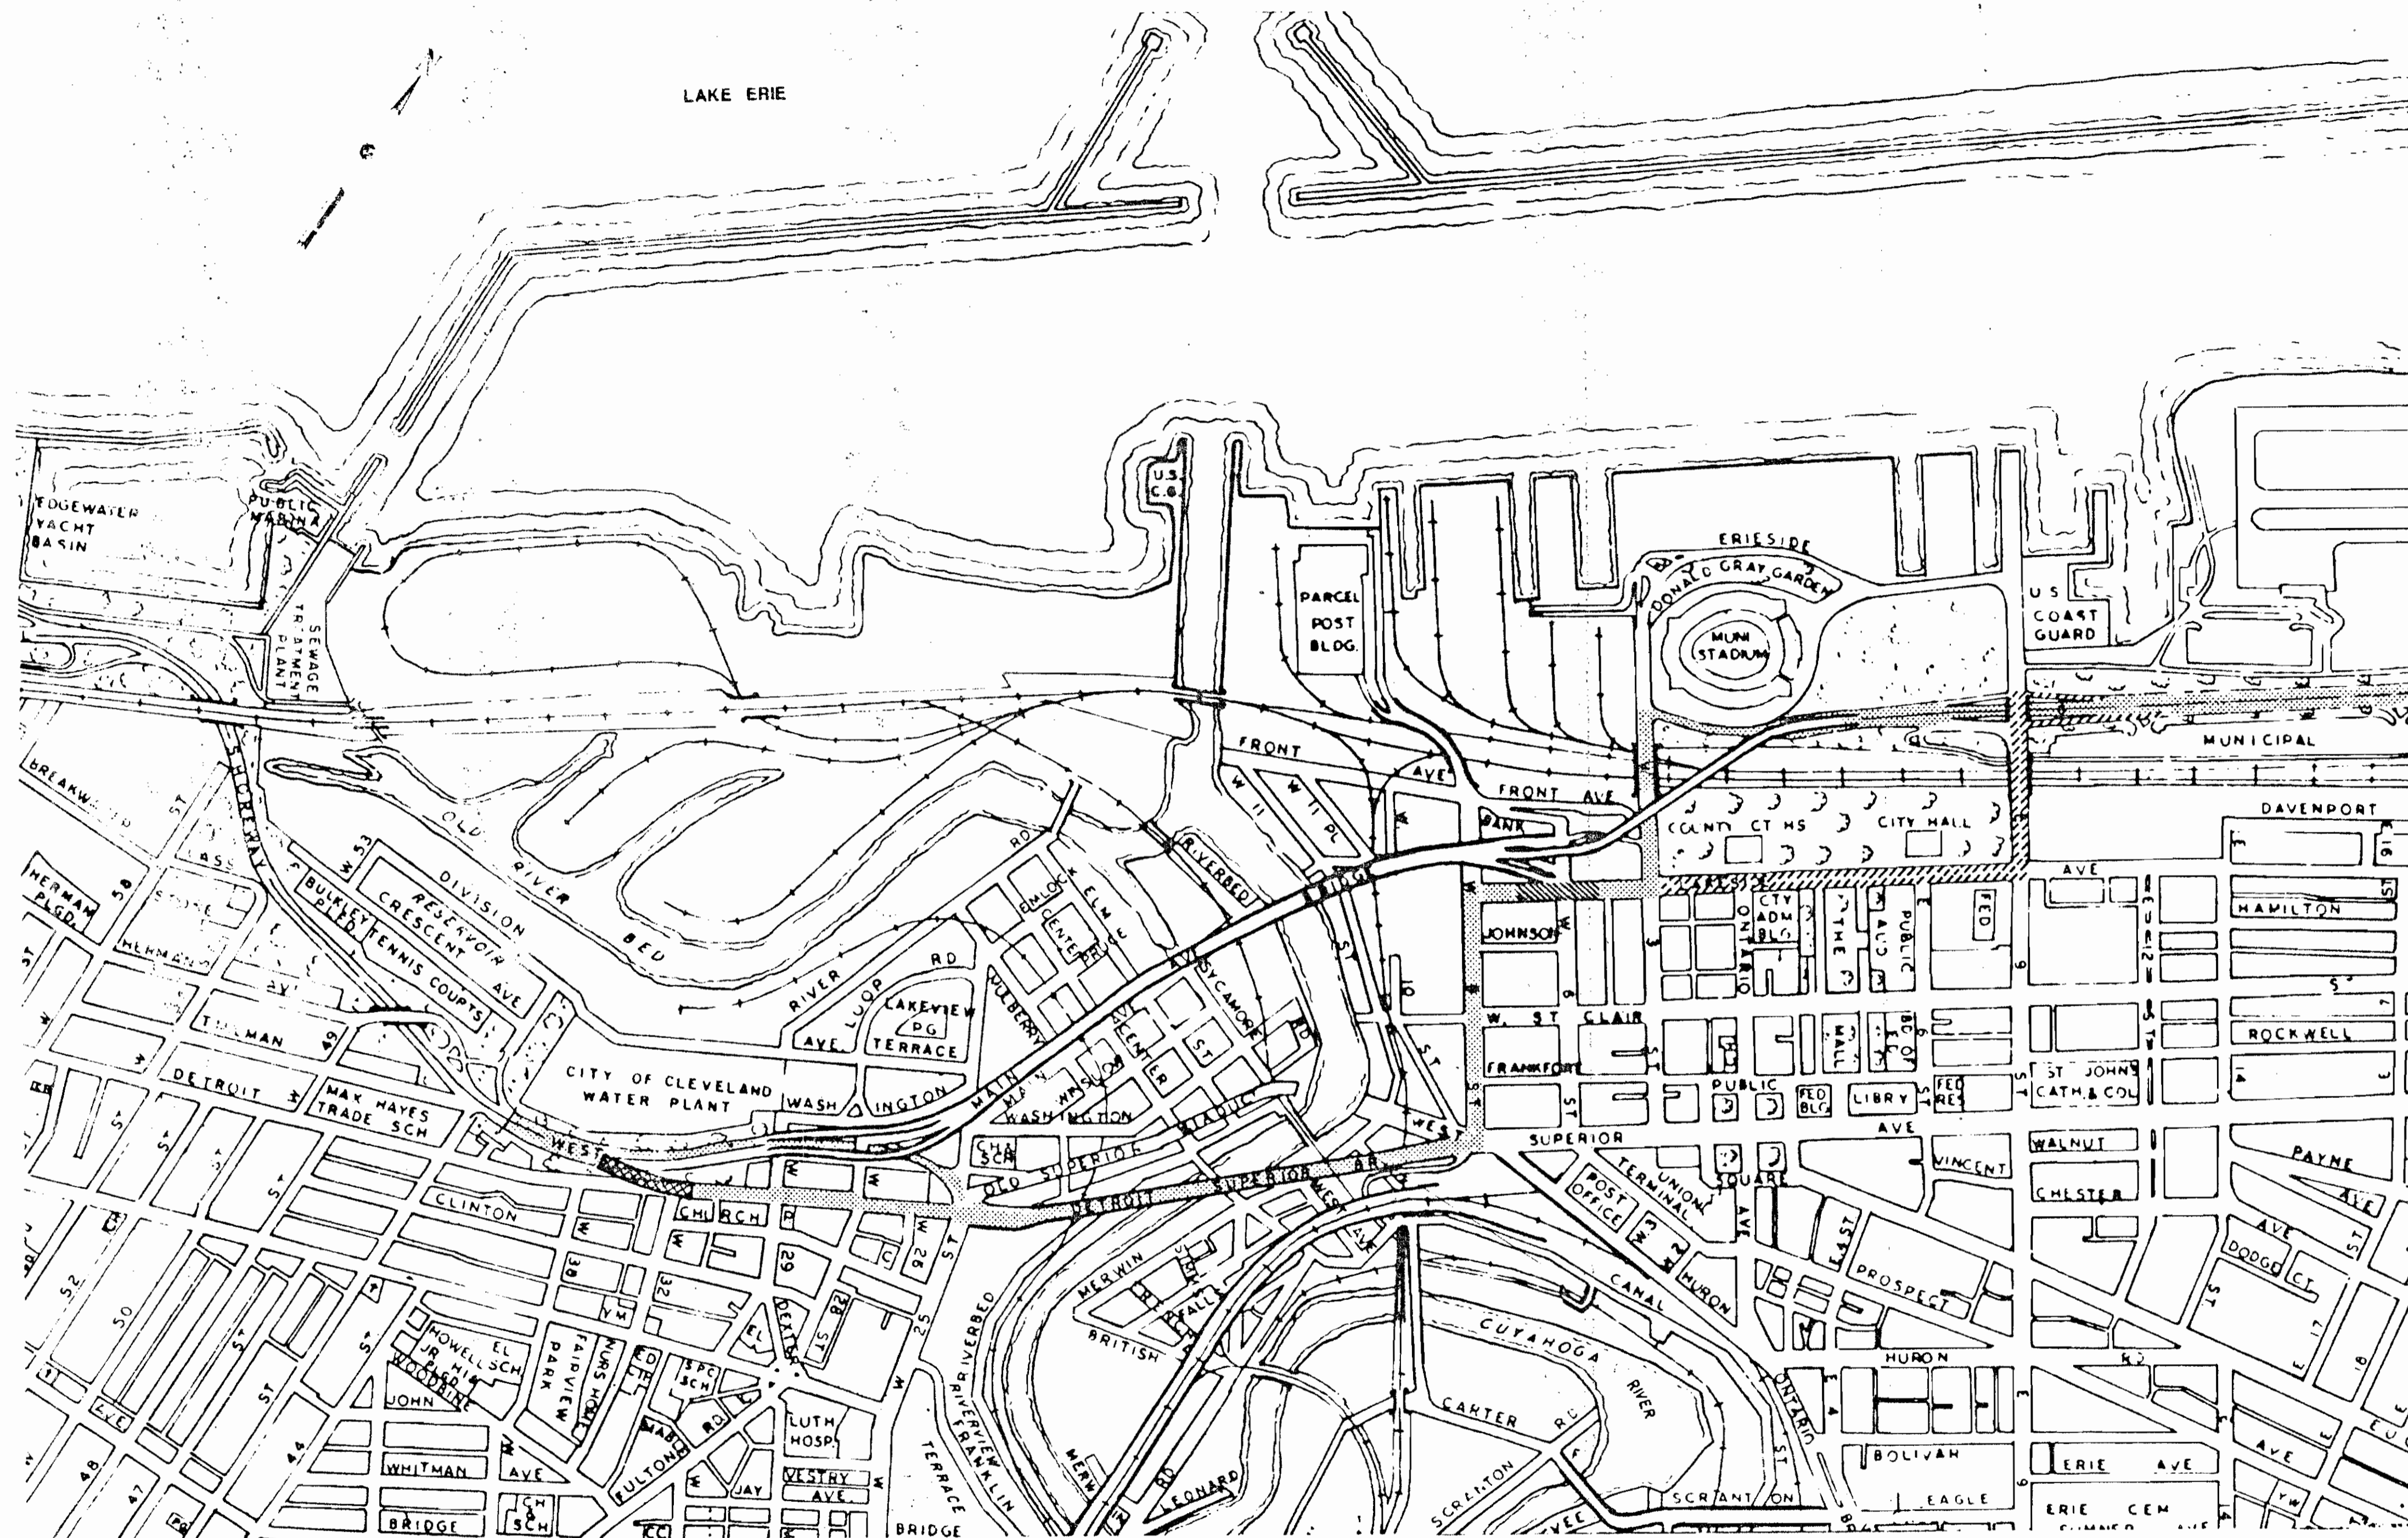

### INDEX

- 601 SCHEMATIC LOCATION PLAN
- 602 GENERAL NOTES
- 603 SUBSUMMARY
- 604-608 S.R.2 & DETROIT AVE. CONNECTION; PLAN, PROFILE, TYP. SECTION, QUANTITIES, CROSS SECTIONS AND DRAINAGE DETAILS
- 609-612 RESURFACING PLANS FOR AFTER DETOUR CONDITION
- 613, 613A
- 614 LAKESIDE AVE. AT W. 6TH ST. MODIFICATIONS
- 615-619 S.R. 2 & DETROIT AVE. CONNECTIONS; REMOVAL PLAN, DETAILS, QUANTITIES AND CROSS-SECTIONS.
- 620-625 SUBWAY RAMP; PLAN, PROFILE, TYPICAL SECTIONS, QUANTITIES AND DETAILS.
- 626-629 MAINTENANCE OF TRAFFIC GENERAL NOTES
- 630 MAINTENANCE OF TRAFFIC GENERAL SUMMARY
- 630A B, 631, 631A
- 632-651 MAINTENANCE OF TRAFFIC PLANS
- 652-661 TEMPORARY TRAFFIC SIGNAL DETAILS
- 662-665 TEMPORARY LANE CONTROL SIGNAL DETAILS
- 666 FINAL PAVEMENT MARKING SUB-SUMMARIES
- 667-672 FINAL PAVEMENT MARKING PLANS
- 673-677 LIGHTING GENERAL NOTES, SUB-SUMMARIES, PLAN AND DETAILS

- PROPOSED LAKESIDE AVE. IMPROVEMENTS (AFTER DETOUR CONDITION)
- REMOVAL OF S.R.2 & DETROIT AVE. CONNECTION (AFTER DETOUR CONDITIONS)
- EXISTING MAIN AVE. BRIDGE DETOUR ROUTE
- EXISTING SPECIAL EVENT DETOUR

MADE 1/11/66 DATE 1-30-66  
 TRACED 7/7 DATE 1-31-66  
 CHECKED 7/7 DATE 1-31-66  
 SCALE NO 50/16

**Howard, Needles, Tammen & Bergendoff**  
 CONSULTING ENGINEERS  
 CLEVELAND, OHIO

**HNTB**