



PHOTO SHOWS RUSTED THRU HOLES AND RUSTED SECTION LOSS TO UPPER CORD MEMBERS OF TRUSS #2 (NORTH MIDDLE).

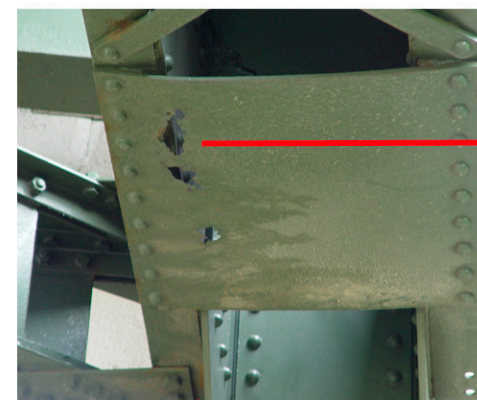

PHOTOS SHOW RUSTED THRU HOLES TO LOWER GUSSET PLATE OF TRUSS #4 (SOUTH).

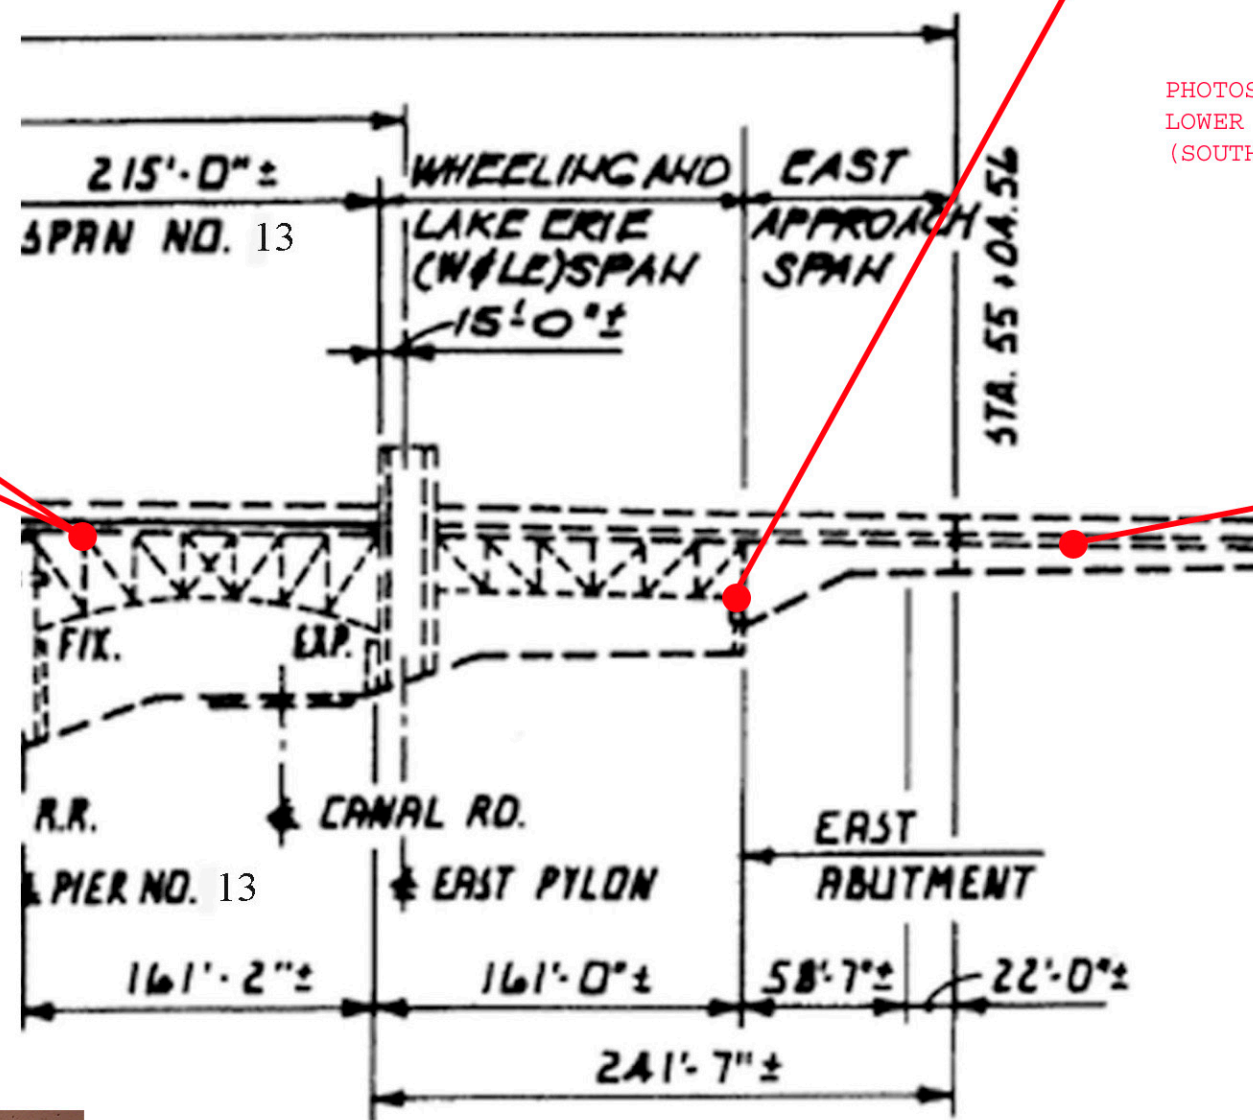

**PIER #13 TO EAST ABUTMENT**

CUY-10-1613

SFN-1801503



PHOTO SHOWS A SPALL FORMING OVER UTILITY CONDUIT INSIDE FINISH (EAST) ABUTMENT CELLULAR CONSTRUCTION. THIS IS APPROXIMATELY 75' WEST OF EAST CELLULAR ABUTMENT WALL.



PHOTO #1

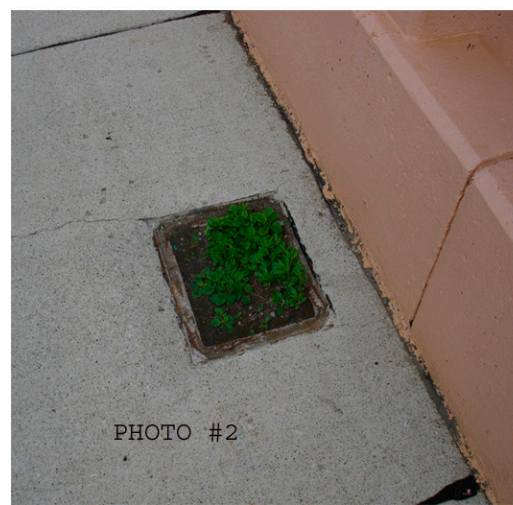


PHOTO #2

BOTH PHOTOS SHOW TYPICAL CONDITIONS TO SIDEWALK UTILITY PULL BOX COVER PLATES. SEVERAL ARE RUSTING LIKE PHOTO #1. 4 ARE MISSING LIKE PHOTO #2.