




CONFINE SPACE ENTRY OF PIER TOWER. LOOKING DOWN INSIDE OF SOUTH LEG.




TYPICAL PHOTO OF WATER TRAPPED IN BEARING CHAMBER.



HEAVY SPALLING TO DECORATIVE PART OF PIER TOWER.

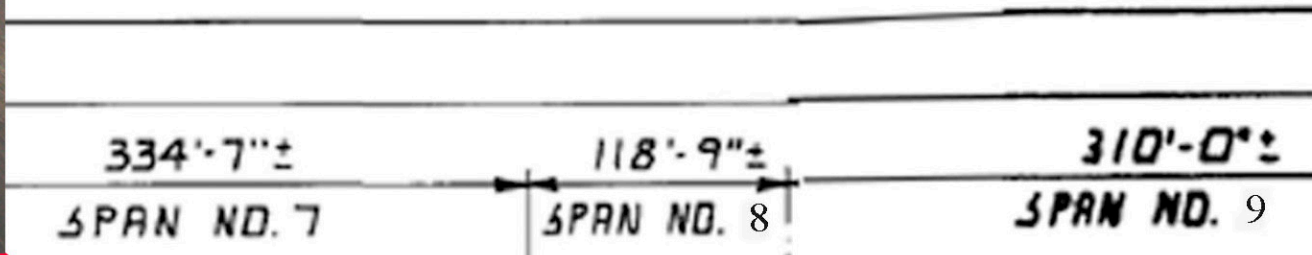

CONFINE SPACE ENTRY OF PIER TOWER. LOOKING UP INSIDE OF SOUTH LEG. NOTE SOME MOISTURE TO PIER SHELF.

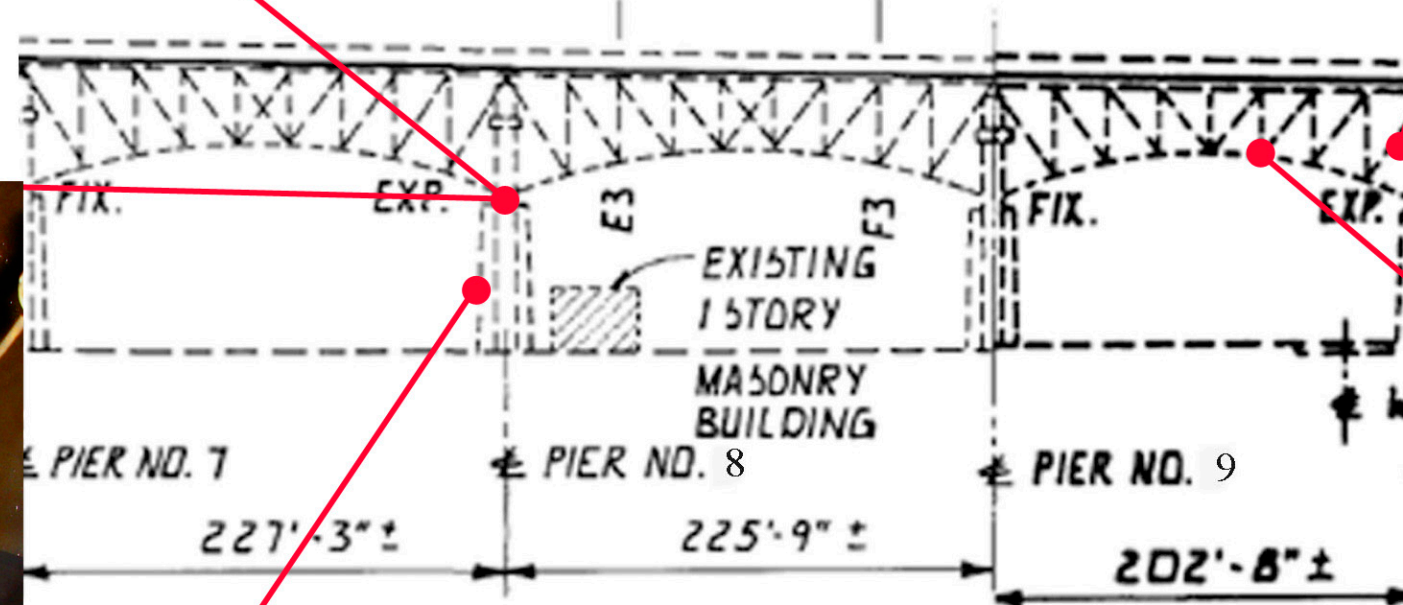

SOUTH COLUMN DOWNSPOUT FULL.



NOTE PAINTED OVER CONCRETE TO LEFT (NORTH) TRUSS.

**PIER #7 TO PIER #10**  
CUY-10-1613  
SFN-1801503

