


CLOSE UP SHOT.

PHOTO SHOWS A WELDED PLATE TO LEFT (SOUTH) OUTSIDE GUSSET PLATE.

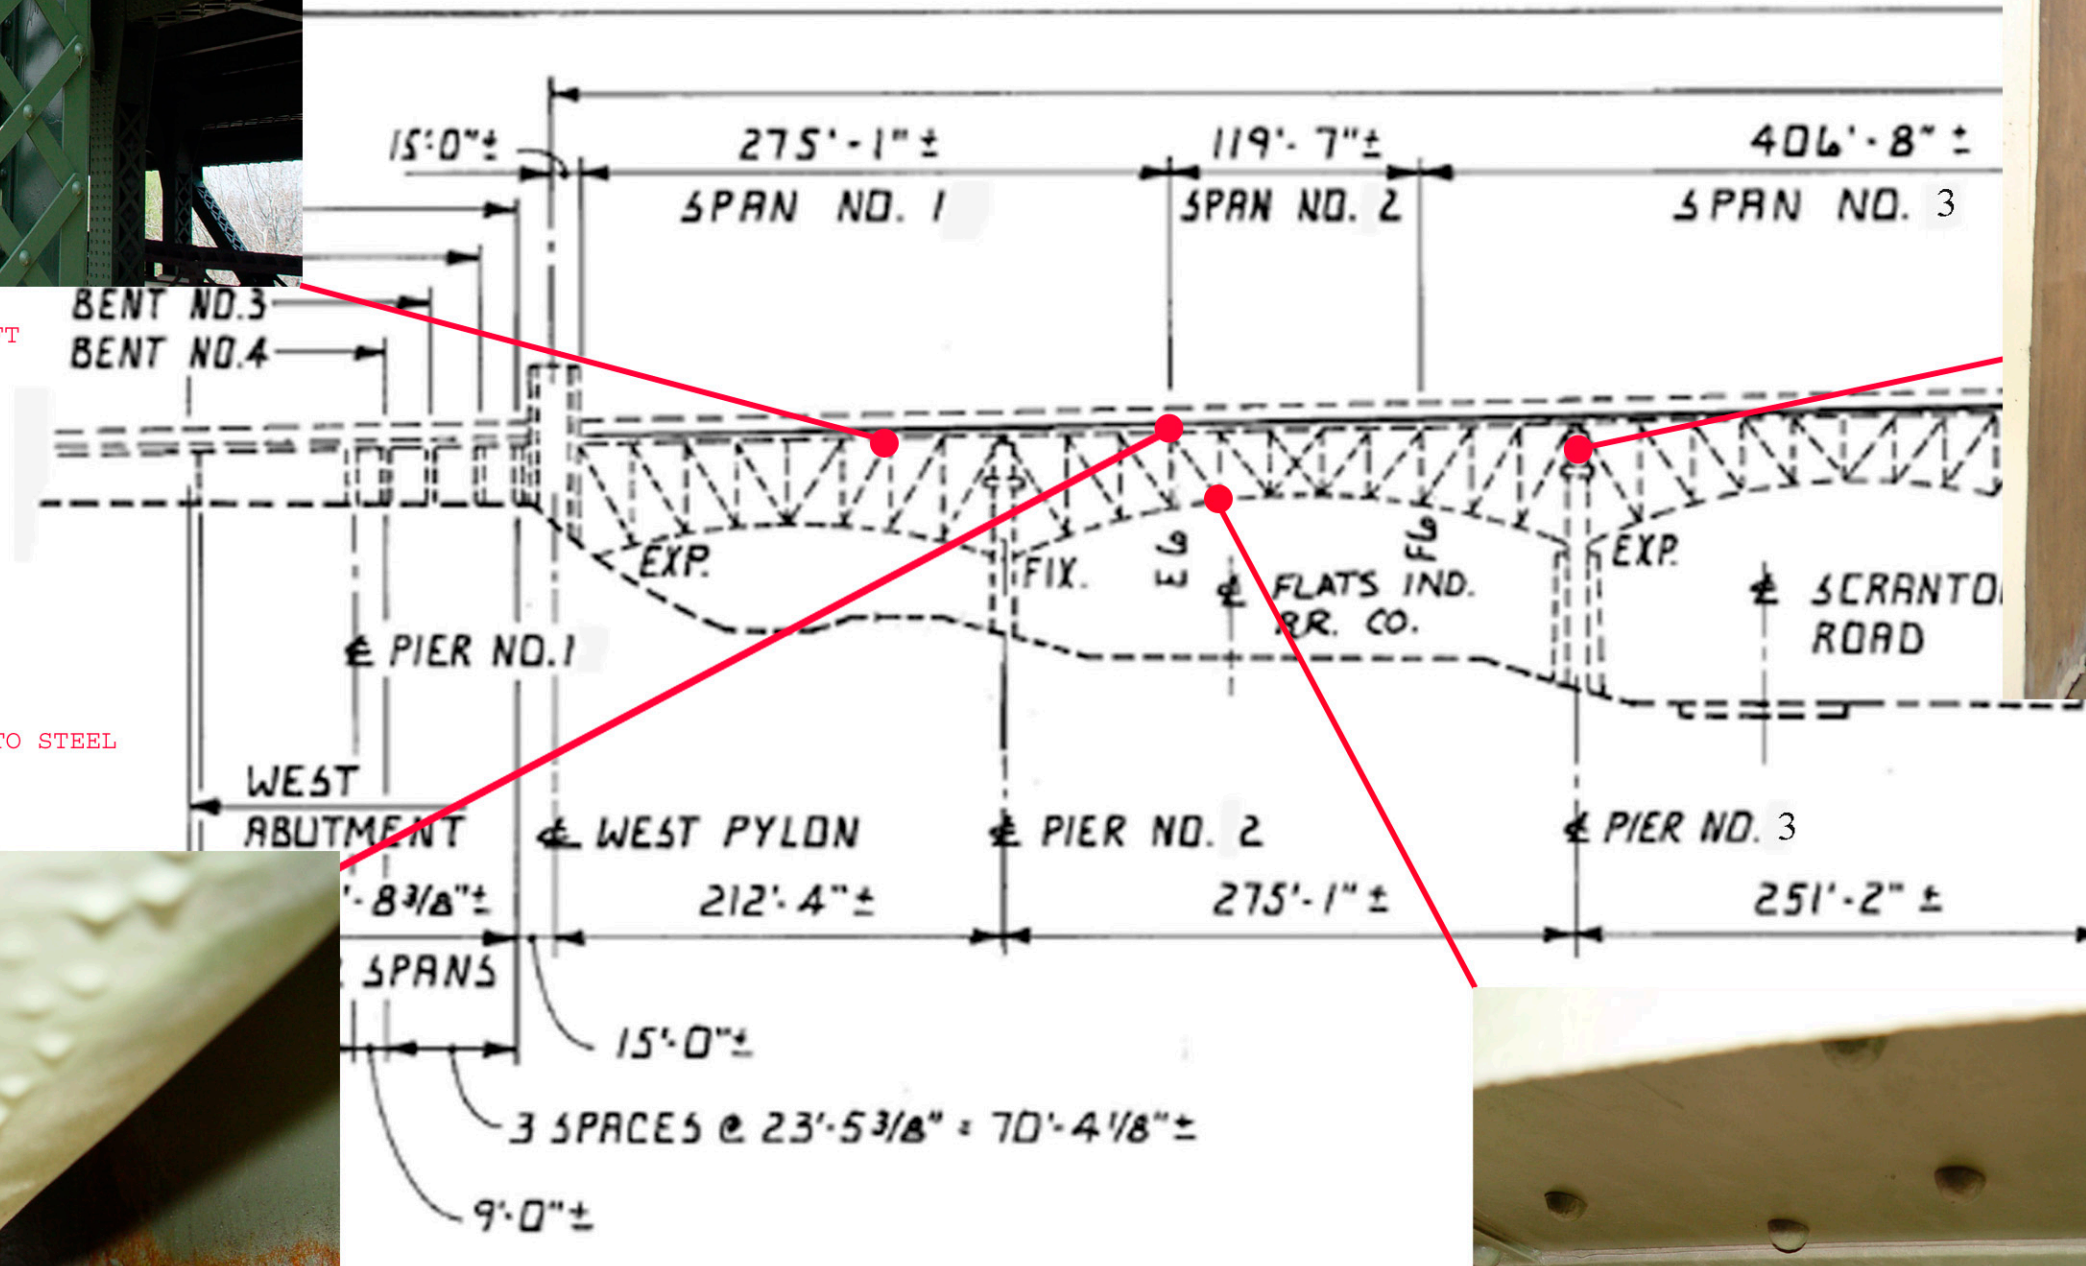

RED ARROW SHOWS WATER LEAKING ONTO STEEL FROM LEFT (SOUTH) TRUSS EXPANSION JOINT TROUGH.



PHOTO SHOWS SOUTH FACE OF THE RIGHT (NORTH) ARCHITECTURAL PILASTER, ELECTRICAL CONDUIT RUNS THRU HERE. NOTE THE CONCRETE ENCASUREMENT HAS SHEARED OFF AND IS WEDGED BETWEEN PILASTER AND LOWER CORD STRUT.



BLUE ARROW SHOWS END OF CRACK. THIS IS LOCATED TO TRUSS #3 (SOUTH MIDDLE). CRACK WAS MARKED IN THE FIELD.



WEST ABUTMENT TO PIER #4

CUY-10-1613
SFN-1801503