

2012 In-Depth Inspection Report



Elevation Looking Southwest

I-71/SR 176 Double Decked Bridge – (SR 176 Lower Deck)

**CUY-00176-1334
(SFN 1805436)**

Owner:

Ohio Department of Transportation
District 12
5500 Transportation Blvd.
Garfield Heights, OH 44125

Inspectors:

HDR Engineering, Inc.
9987 Carver Rd, Suite 200
Cincinnati, OH 45242

Northwest Consultants, Inc.
3220 Central Park West
Toledo, Ohio 43617

Inspection Dates: 07/30/2012 to 08/10/2012

2012 In-Depth Bridge Inspection

**I-71/SR 176 DOUBLE DECKED BRIDGE (SR 176 Lower Deck)
CUY-00176-1334 (SFN 1805436)**

Owner

Ohio Department of Transportation
District 12
5500 Transportation Blvd.
Garfield Heights, OH 44125

Consultant:

HDR Engineering, Inc.
9987 Carver Rd, Suite 200
Cincinnati, OH 45242
(513) 984-7500

Subconsultant:

NCI, Inc.
3220 Central Park West
Toledo, OH 43617
(419)841-4704

Inspectors

HDR Engineering, Inc.
Ann Griessmann, PE (Team Leader)
Nina Sass, PE
NCI, Inc.
Jon Drummond, PE
Jack Ebert, EI

Inspection Dates: 07/30/2012 to 08/10/2012

Prepared by:

Reviewed by:



Ann M. Griessmann, P.E.
Civil Engineer

Brian J. Leshko, P.E.
Vice President
Senior Professional Associate

Date Submitted: January 2013

TABLE OF CONTENTS

Summary	03
General.....	04
Bridge Description.....	04
Elevation & End Views.....	05
Location Map.....	06
Individual Item Condition Ratings	07
Summary Condition Ratings	07
Protective Coating System (PCS).....	08
Deck Summary	09
Floor.....	09
Wearing Surface.....	10
Railing	10
Drainage.....	12
Expansion Joints.....	13
Superstructure Summary	13
Alignment.....	14
Beams/Girders/Slabs.....	15
Diaphragms or Crossframes	15
Bearing Devices.....	18
Protective Coating System	21
Pins/Hangers/Hinges	21
Fatigue Prone Connections	22
Live Load Response	22
Substructure Summary	23
Abutments	23
Abutment Seats	24
Piers	24
Pier Seats.....	28
Backwalls.....	29
Wingwalls	29
Slope Protection.....	29
Approaches Summary	30
Pavement.....	30
Approach Slabs.....	30
Guardrail.....	30
Relief Joints.....	31
Embankment.....	31
General	31
Warning Signs	31
Sign Supports	31
Vertical Clearance.....	31
Recommendations	32

Appendix

- A.** Plan View with Mapped Out Deficiencies
- B.** BR-86
- C.** Subconsultant Report for Deck
- D.** Labeling of Spans
- E.** Floor Sketches
- F.** Pier Sketches
- G.** Daily Logs
 - ♦ HDR
 - ♦ NCI

SUMMARY

Overall, the SR 176 bridge (SFN 1805436) is rated a 6, meaning it is in satisfactory condition.

- The deck floors have areas of honeycombing, cracking, spalling, and delaminations.
- The railing has areas of spalling and cracking with efflorescence.
- Scuppers and drains are clogged.
- A portion of the drain has fallen off or is about to fall off near the seated hinges.
- The expansion joint glands show signs of minor leakage.
- Portions of the elastomeric seal joint near Pier 18BE are missing.
- There are loose bolts at a few locations along the superstructure.
- Surface corrosion exists at the seated hinges and at various locations on the superstructure.
- There are corrosion holes in the crossbracing.
- There are 6 bearings that are rocked $\geq 10^\circ$.
- There is a bearing rocked beyond recall.
- The fatigue prone connections have surface corrosion.
- The abutments have hairline cracking.
- The piers have cracking, spalling, and delamination.
- The backwalls have cracking and spalling.
- One impact attenuator has vehicular damage.

GENERAL

HDR Engineering, Inc. performed the in-depth inspection of the I-71/SR 176 double decked bridge with the help of Northwest Consultants, Inc. The inspection was performed between July 30, 2012 and August 10, 2012. The purpose of the inspection was to fulfill the annual requirement to inspect and document the existing physical and functional conditions of the bridge and note any changes since the previous inspection. The bridge was inspected using an Aspen Aerial A75 UBIV. The substructure was inspected from the ground and with the Aspen Aerial UBIV.

All inspectors followed the guidelines and standards established by the Federal Highway Administration (FHWA) and the American Association of State Highway and Transportation Officials (AASHTO). The condition assessments and bridge ratings coded were in accordance with the Bridge Inspector's Reference Manual and the Ohio Department of Transportation Manual of Bridge Inspection.

Traffic control was used for the UBIV work, using multiple lane closures. Due to the amount of traffic on the bridge, the work was performed at night. In order to inspect the SR 176 bridge (lower deck), the following closures were necessary:

- Single right lane closure.
- Single to a double right lane closure. This allows for a right lane closure on Ramp BW.
- Ramp BE closure starting at 1:00 am.
- Left lane closure to inspect just before the ramp.


A police officer was not used during this inspection, but it is recommended on future inspections to use one. There were a couple of incidences where motorcycles felt it was okay to drive in the closed lane. The police officer would be most beneficial wherever the bucket is going to be over the roadway.

BRIDGE DESCRIPTION

The SR 176 bridge (lower deck) is a continuous steel beam structure with a concrete substructure. There are 18 spans with a maximum span length of 79 ft and a total length of 1,073 ft. It was constructed in 1968 and has 3 lanes of traffic that decreases to two lanes on the main route and a single lane on the ramp. The bridge carries SR 176 traffic toward I-90 and W 14th St. It runs north and south. The girders and piers are called out per the bridge plans.




Elevation View Looking West

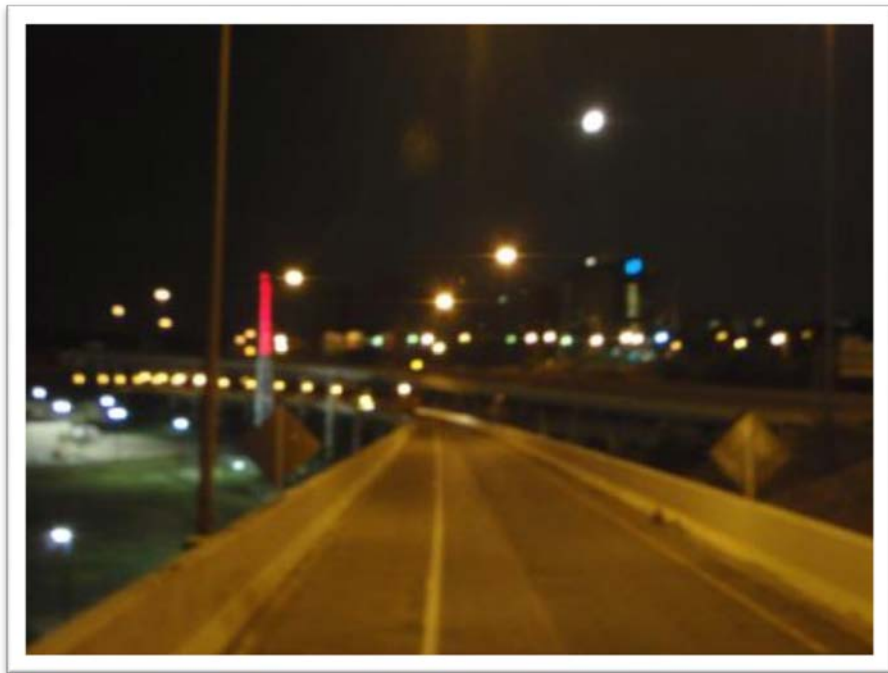

End View Looking South

LOCATION MAP

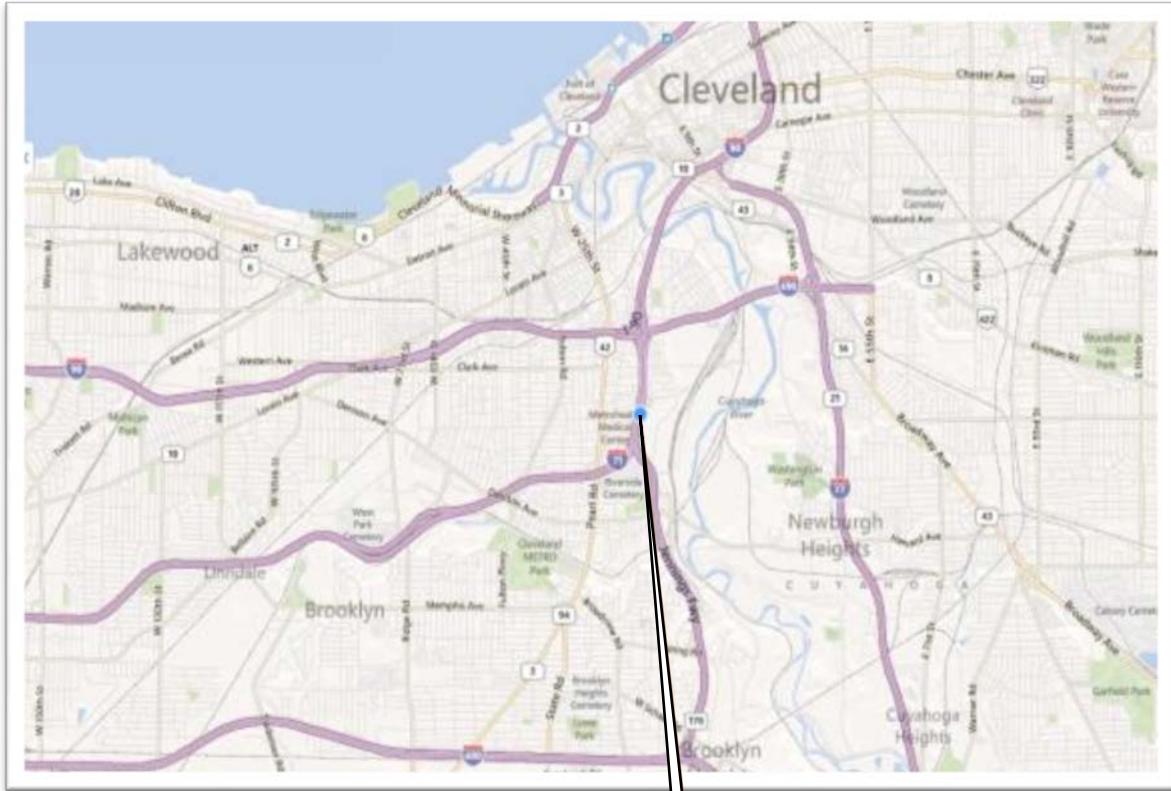

INDIVIDUAL ITEM CONDITION RATINGS

The individual items are rated on a 1-4 rating system as described below.

- 1 **Good** – Element limited to only minor problems, no repairs necessary.
- 2 **Fair** – All primary elements are sound, but have minor section loss, deterioration, cracking, spalling or scour, minor repairs, etc.
- 3 **Poor** – Advanced section loss, deterioration, spalling or scour; item is no longer functioning as designed (load path is significantly redistributed, fatigue cracks, wide shear cracks, local failures possible).
- 4 **Critical** – Support removed, corrective action or close monitoring necessary, consider partial or full closure, negative response (ex. crushing, bending) to the primary element due to structural loads.

SUMMARY CONDITION RATINGS

Member condition ratings used in this report are in accordance with Report No. FHWA-PD-96-001, *Recording and Coding Guide for the Structure Inventory and Appraisal of the Nation's Bridges*, 1995, and are reproduced below. The following rating system also appears in the Bridge Inspector's Reference Manual, FHWA NHI 12-049, Revised February, 2012.

- N **Not Applicable**
- 9 **Excellent Condition**
- 8 **Very Good Condition** – no problems noted.
- 7 **Good Condition** – some minor problems.
- 6 **Satisfactory Condition** – structural elements show some minor deterioration.
- 5 **Fair Condition** – all primary structural elements are sound but may have minor section loss, cracking, spalling or scour.
- 4 **Poor Condition** – advanced section loss, deterioration, spalling or scour.
- 3 **Serious Condition** – loss of section, deterioration, spalling or scour have seriously affected primary structural components. Local failures are possible. Fatigue cracks in steel or shear cracks in concrete may be present.
- 2 **Critical Condition** – advanced deterioration of primary structural elements. Fatigue cracks in steel or shear cracks in concrete may be present, or scour may have removed substructure support. Unless closely monitored, it may be necessary to close the bridge until corrective action is taken.
- 1 **“Imminent” Failure Condition** – major deterioration or section loss present in critical structural components or obvious vertical or horizontal movement affecting structure stability. Bridge is closed to traffic, but corrective action may put back in light service.
- 0 **Failed Condition** – out of service – beyond corrective action.

PROTECTIVE COATING SYSTEM (PCS)

- 9 There is no evidence of corrosion; the protective coating system (PCS) is sound, fully intact, and functioning as intended to protect the metal or concrete surfaces. No workmanship related issues.
- 8 Less than 1% of total surface area of the protective coating system is failed. Isolated light surface or freckled rusting along flange edges, cross frame members, end cross frames, bearings, phase or lap marks, or at bolted splices. Isolated chalking or fading or other early evidence of paint system distress. Isolated workmanship issues (painted surfaces only), surface defects less than 5% of total surface area. Workmanship defects include painted over grit, rust, mill scale, heavy paint drips, mud cracking in paint, or other related workmanship issues. No finish coat separation from intermediate coat.
- 7 Greater than 1% and less than 5% of the total protective coating system is failed. Light surface rusting along flange edges, cross frame members, end cross frames, bearings, phase or lap marks, or at bolted splices. Multiple workmanship issues (painted surfaces only), surface defects less than 10% of total surface area. Workmanship defects include painted over old paint, grit, rust, mill scale, heavy paint drips, mud cracking in paint, or other related workmanship issues. Finish coat separation from intermediate coat less than 10%. Chalking or fading or other early evidence of paint system distress. Candidate for zone painting (outside fascia beams or beam ends near joints).
- 6 Greater than 5% and less than 10% of the total protective coating system is failed. Surface or freckled rust is prevalent throughout. The paint system is no longer effective at beam ends beneath joints. There may be exposed metal, but there is no corrosion, which is causing loss of section. Peeling, cracking, or separation of any caulking material. Workmanship issues (painted surfaces only), surface defects less than 15% of total surface area. Workmanship defects include painted over old paint, grit, rust, mill scale, heavy paint drips, mud cracking in paint, or other related workmanship issues. Finish coat separation from intermediate coat greater than 10%. Candidate for zone painting (outside fascia beams or beam ends near joints).
- 5 Greater than 10% and less than 15% of the total protective coating system is failed. Surface or freckled rust is prevalent. The paint system is no longer effective at steel ridge bearings, beam ends near joints at abutments and piers and along outside face of fascia beams. There is exposed metal with active corrosion causing light loss of section or pitting, typically less than 1/8". Peeling, cracking, or separation of any caulking material with rust staining. Workmanship issues (painted surfaces only), surface defects greater than 20% of total surface area. Candidate for zone painting (outside fascia beams and beam ends near joints).
- 4 Greater than 15% and less than 20% of the total protective coating system is failed. Surface or freckled rust is prevalent. The PCS system is no longer effective. There is exposed steel throughout the structure with active corrosion. Failure of caulking on crevice corrosion. Old paint system was painted over. Candidate for total recoating.
- 3 Greater than 20% and less than 30% of the total protective coating system is failed. The paint system is no longer effective. There is exposed steel throughout the structure with active corrosion. Candidate for total recoating.
- 2 Greater than 30% and less than 40% of the total protective coating system is failed. Candidate for total recoating.
- 1 Greater than 40% and less than 50% of the total protective coating system is failed. Should be programmed for total recoating, or structure replacement.

- 0 Greater than 50% of the protective coating system has failed. Corrosion has caused section losses. Should be programmed for total recoating or structure replacement.

DECK SUMMARY

SATISFACTORY

The deck is rated a 6, meaning that it is in satisfactory condition. The rating is based on the condition of the Floor which is rated 2 – Fair.

The individual items are as follows:

<u>Item</u>	<u>SR 176 Rating</u>
Floor	2 – Fair
Wearing Surface	2 – Fair
Railing	2 – Fair
Drainage	2 – Fair
Expansion Joints	2 – Fair

Floor	Fair
-------	------

The underside of the deck is in fair condition. See the sketch of the floor in Appendix E. The following deficiencies were noted:

- There is hairline to narrow transverse cracking in Ramps BW and BE. Efflorescence is typical.



- One 10” diameter area of honeycombing in Span 14.
- Map cracking exists in Spans 24BE and 25BE.

- Spalling exists in Spans 11, 13, 14, 17, 18BW, 18BE, 22BE, 24BE, and 28BE.



- Delaminations exist in Spans 17, 19BE, 20BE, 23BE, 24BE, 25BE, 26BE, and 27BE.



Wearing Surface	Fair
-----------------	------

The wearing surface is in fair condition. The following deficiencies are noted in the Supplemental Report found in Appendix C, but are reiterated here. Detailed locations and sizes are located in the deck mapping section of the Supplemental Report.

- Large areas of the deck are patched with good quality, full-depth patches.
- There are transverse cracks spaced roughly at 10 ft intervals in the positive moment regions and at 6 ft intervals in the negative moment regions.
- There are a few small, shallow spalls in random locations away from the joints (<1% deck area).
- Several spalls were found along or near construction joints.
- Numerous locations exist where RPMs are missing.

Railing	Fair
---------	------

The railing is in fair condition. The following deficiencies are noted in the Supplemental Report found in Appendix C, but are reiterated here. Deficiency locations are called out in the deck mapping section of the Supplemental Report. Deficiencies found on the exterior face were noted from the snooper inspection.

- Spalls and deteriorations exist along the large portions of the toe of the barrier, especially on the low (east) side of the structure.
- Random vertical cracks exist in both barriers.
- Longitudinal cracking with efflorescence in the rail's exterior face in Span 19BE.



The drainage is in fair condition. The deficiencies for the drains on the deck are noted in the Supplemental Report found in Appendix C, but are reiterated here. The following deficiencies were noted:

- The drains at Piers 16 and 18BE are clogged with debris and water is not draining properly.
- The scupper pans in the top of the deck are clogged with debris in most locations. See Appendix C for details.
- Drains are clogged at the following locations.
 - ♦ Span 16, near Pier 16
 - ♦ Span 19BE, near Pier 18BE



- Corroded downspout with section loss in Span 25BE near Pier 24BE.



- Corrosion on the downspout in Span 27BE near the North Abutment AE.
- Corrosion and section loss on the downspout in Span 18BW near Pier 17.

Expansion Joints	Fair
------------------	------

The expansion joints are in fair condition. The deficiencies for the expansion joints are noted in the Supplemental Report found in Appendix C, but are reiterated here. Detailed findings and expansion joint measurements can be found in the Supplemental Report. The following deficiencies were noted:

- The intermediate expansion joints vary in clear spacing from 1 $\frac{7}{8}$ " to 2 $\frac{1}{2}$ ".
- The abutment expansion joints vary in clear spacing from 1 $\frac{5}{8}$ " to 2 $\frac{5}{8}$ ".
- The glands show signs of minor leakage.
- The elastomeric seal joint near Pier 13 and Pier 24BE have a portion of the sealer sticking up out of the joint with tears in the sealer visible.
- The elastomeric seal joint at Pier 24BE also has a $\frac{1}{4}$ " to $\frac{1}{2}$ " elevated lip from one side of the joint to the other.
- The elastomeric seal joint near Pier 18BE has portions of the armor missing as well as the sealer sticking up out of the joint.
- The elastomeric seal joints are full of debris in most locations.

SUPERSTRUCTURE SUMMARY

SATISFACTORY

The superstructure is rated a 6, meaning that it is in satisfactory condition. The rating is based on the condition of the Pins/Hangers/Hinges, which are rated 2 – Fair.

The individual items are as follows:

<u>Item</u>	<u>SR 176 Rating</u>
Alignment	1 – Good
Beams/Girders/Slabs	1 – Good
Diaphragms or Crossframes	2 – Fair
Bearing Devices	2 – Fair
Protective Coating System	6 – Satisfactory
Pins/Hangers/Hinges	2 – Fair
Fatigue Prone Connections	1 – Good
Live Load Response	S – Satisfactory

Alignment	Good
-----------	------

The alignment is in good condition. The following deficiencies were noted:

- Bottom flange of beam bent at the following locations
 - ♦ Beam D (Span 16) – 1/8” over a 1’-0” length.



- ♦ Beam A (Span 18BW) – 1/8” over a 1’-6” length.
- ♦ Beam A (Span 11) – 1/8” over a 10” length.

The beams and girders are in good condition. The following deficiencies were noted:

- Light surface corrosion with isolated locations of moderate corrosion on the web and flanges, specifically the bottom flange.
- Surface corrosion at the seated hinges with up to 1/16" section loss.



- There is a loose bolt in the bottom cover plate of the splice in Span 18BW, Beam C.



- The end of Beam B, at the cope, in Span 7 is bent.



Diaphragms or Crossframes

Fair

The crossframes are in fair condition. The following deficiencies were noted:

- Corrosion holes exist at the following locations.
 - ♦ Beam F between Beams E & F in Span 18BW.
 - ♦ Beam L between Beams F & L in Span 13.



- There are angles welded to the ends of the crossbracing in order to lengthen them in Span 14 and others.
- A paint crack exists in the weld where the crossbracing is attached to the web of Beam L in Span 15. Monitor this location.



- Surface corrosion exists at various locations. Section loss in Span 18BW at seated hinges.
- There is an incomplete weld with gaps in Beam A in Span 15.



- Pack rust and 1" bowing exists at the top gusset plate in Span 18BW.



Bearing Devices	Fair
-----------------	------

The bearing devices are in fair condition. The following deficiencies were noted:

- Surface corrosion is typical. The exterior bearings show a moderate amount of corrosion.
- Six bearings are rocked $\geq 10^\circ$.
 - ♦ South Abut 10°S Bearing F
 - ♦ South Abut 10°N Bearing L
 - ♦ North Abut BW 17°N Bearing E
 - ♦ Pier 28BE 10°S Bearing L
 - ♦ North Abut BE 32°S Bearing G
 - ♦ North Abut BE 15°S Bearing J

- One bearing is rocked beyond recall (Horizontal Distance > $\frac{1}{3}$ H).
 - ♦ North Abut BE 32°S Bearing G



- The following tables list the bearing measurements.

Bearing Measurements – SR 176												
Pier/Abut	A	B	C	D	E	F	G	H	J	K	L	N
S Abut	5°N	7°S	7°S	0°	5°S	10°S					10°N	
Pier 1												
Pier 2												
Pier 3												
Pier 4												
Pier 5												
Pier 6												
Pier 7												
Pier 8	0°	2°N	0°	0°	0°	0°					0°	
Pier 9	1°S	1°S	2°S	3°S	2°S	1°S					2°S	
Pier 10	Fixed	Fixed	Fixed	Fixed	Fixed	Fixed					Fixed	
Pier 11	0°	0°	0°	0°	0°	0°					0°	
Pier 12	3°S	1°S	1°S	1°S	0°	2°S					0°	
Pier 13	1°S	1°S	0°	1°N	2°N	3°N					2°N	
Pier 14	2°N	2°N	0°	2°S	1°S	2°S			5°N		1°S	
Pier 15	Fixed	Fixed	Fixed	Fixed	Fixed	Fixed			Fixed		Fixed	
Pier 16	0°	4°N	3°N	2°N	0°	0°	3°N		3°N	1°N	1°N	
Pier 17	2°S	3°S	1°S	1°S	0°	1°S	4°N		1°N	1°N	1°N	
Pier 18BW	1°N	3°N	1°N	0°	5°N	1°N						
Pier 19BW	Fixed	Fixed	Fixed	Fixed	Fixed	Fixed						
Pier 20BW	2°N	1°N	1°N	3°N	3°N	3°N						
N Abut BW	4°N	7°N	3°N	4°N	17°N	3°S						
Pier 18BE							1°S		1°S	1°S	0°	
Pier 19BE							1°N		0°	1°S	4°N	
Pier 20BE							Fixed		Fixed	Fixed	Fixed	
Pier 21BE							Fixed		Fixed	Fixed	Fixed	
Pier 22BE							1°N		0°	1°S	1°S	
Pier 23BE							1°N		1°S	1°S	1°S	
Pier 24BE							3°N		4°N	4°N	5°N	
Pier 25BE							4°S		4°S	2°S	2°S	
Pier 26BE							Fixed		Fixed	Fixed	Fixed	
Pier 27BE							5°S		3°S	0°	1°N	
Pier 28BE							8°S	4°S	5°S	5°S	10°S	
N Abut BE							32°S	7°N	15°S	7°N	7°S	

Protective Coating System

Satisfactory

The protective coating system is rated a 6, meaning it is in satisfactory condition. The following deficiencies were noted:

- Greater than 5% and less than 10% of the total protective coating system is failed.
- Surface or freckled rust is prevalent throughout.
- Candidate for zone painting (outside fascia beams or beam ends near joints).
- Random locations of peeling paint and surface corrosion.

Pins/Hangers/Hinges

Fair

The seated hinges are in fair condition. The following deficiencies were noted:

- Surface corrosion. Heavier corrosion at the groove.



- Laminating corrosion beginning at the lower portion of the seated hinge.

Seated Hinge Measurements – SR 176										
Span	A	B	C	D	E	F	G	J	K	L
Span 13	1 ¼" N	1 ½" N	¼" N	1 ¾" N	½" N	⅝" N				1 ¾" N
Span 18BW	¾" N	⅝" N	1" N	⅝" N	⅝" N	0"				
Span 18BE							1" N	1 ⅝" N	1 ¾" N	1 ¾" N
Span 24BE							⅜" N	2" N	2 ⅛" N	2 ¼" N

Fatigue Prone Connections

Good

The fatigue prone connections are in good condition. The following deficiencies were noted:

- Surface corrosion on the intersecting welds under the seated hinge.
- Surface corrosion on the welds along the bottom cover plate and at the ends.



Live Load Response

Satisfactory

The live load response is in satisfactory condition, which is normal. There was no excessive deflection or vibration noted under live load.

SUBSTRUCTURE SUMMARY

SATISFACTORY

The substructure is rated a 6, meaning that it is in satisfactory condition. The rating is based on the condition of the Piers, which are rated 2 – Fair.

The individual items are as follows:

<u>Item</u>	<u>SR 176 Rating</u>
Abutments	1 – Good
Abutment Seats	1 – Good
Piers	2 – Fair
Pier Seats	1 – Good
Backwalls	2 – Fair
Wingwalls	1 – Good
Slope Protection	2 - Fair

Abutments	Good
-----------	------

The abutments are in good condition. The following deficiencies were noted (see sketches in Appendix F):

- North Abutment AE – Rust staining is evident on the breastwall.
- North Abutment BE – Some rust staining is evident on the breastwall.
- North Abutment BW – Map cracking on the breastwall.



Abutment Seats

Good

The abutment seats are in good condition. No significant deficiencies were noted.

Piers

Fair

The piers are in fair condition. The following deficiencies were noted (see sketches in Appendix F):

- Pier 8 – The pier cap has multiple cracks. The west side of the south face has cracking with a delamination. The east side of the south face has a 4' x 3' spall with exposed rebar. The east side of the north face has hairline cracking with a delamination.



- Pier 9 – The pier cap has multiple cracks with some rust spots and a small delamination. There is a 5' horizontal crack with a delamination under Bearing A along with a 10" x 10" spall.



- Pier 10 – The pier cap has multiple cracks. The east side of the south face has a 2' x 10" delamination with a 3 ft horizontal crack.
- Pier 11 – The pier cap has multiple cracks and map cracking. The east side of the south face has a 3 ½ ft horizontal crack with a delamination. The west side of the north face has a 7' x 4" x 10" spall.
- Pier 12 – The pier cap has multiple cracks. The east column has two spalls, 4" x 3" and 16" x 3" with exposed rebar. The west column has a 6" x 2" spall with exposed rebar.
- Pier 13 – The pier cap has multiple cracks. The east side of the south face has delaminations. The east side of the north face has 6' x 4" and 2 ½' x 8" delaminations.

- Pier 14 – The pier cap has hairline cracking. The north side of the east column has multiple spalls with exposed rebar. The south side of the east column has three large spalls with exposed rebar; 5' x 2 ½', 4' x 2 ½', and 3 ½' x 2'.



- Pier 15 – The pier cap has multiple cracks. The east side of the north face has a 3' x 2' and a 2' x 1' spall with exposed rebar. The east side of the south face has a 5' x 4' spall with exposed rebar and 4' x 2' and 3' x 1' delaminations. A 2' x 4" spall exists on the south wall.



- Pier 16 – The pier cap has multiple cracks. There are two spalls on the east side of the south face, 3' x 2' and 2 ½' x 1'. The area below Beams K and L is delaminated.



- Pier 17 – The pier cap has multiple cracks. The east column has a 1' x 4' spall with exposed rebar and a 3' x 2' spall with exposed rebar. There is also an 8" diameter area of delaminated concrete.
- Pier 18BW – The pier cap has multiple cracks. There is a 3' x 2' delamination on the top east face of the cap. A 1 SF spall exists on the north face.
- Pier 19BW – The pier cap has multiple cracks.
- Pier 20BW – The pier cap has multiple cracks.
- Pier 18BE – The pier cap has multiple cracks. There is a 1 SF delamination on the south face and a 1 SF spall on the north face.
- Pier 19BE – The pier cap has multiple cracks.
- Pier 20BE – The pier cap has multiple cracks.
- Pier 21BE – The pier cap has multiple cracks. The east column has a 4" x 1" spall with exposed rebar.
- Pier 22BE – The pier cap has multiple cracks. Two small spalls with exposed rebar exist on the pier cap.
- Pier 23BE – The pier cap has multiple cracks.
- Pier 24BE – The pier cap has multiple cracks. There is a 1 ½' diameter delamination on the south side.
- Pier 25BE – The pier cap has multiple cracks.
- Pier 26BE – No significant deficiencies noted.
- Pier 27BE – No significant deficiencies noted.
- Pier 28BE – There are cracks on the north side of the pier cap.

The pier seats are in good condition. The following deficiencies were noted:

- There are multiple areas along the pier seat edge that are cracking or have delaminations.
- There is a 3' x 2' spall with exposed steel on the pier seat at Pier 16.



Backwalls

Fair

The backwalls are in fair condition. The following deficiencies were noted:

- North Abutment BW – Map cracking in the backwall.



Wingwalls

Good

The wingwalls are in good condition. No significant deficiencies were noted.

Slope Protection

Fair

The slope protection is in fair condition. The following deficiencies were noted:

- The stone slope protection shows signs of erosion.

APPROACHES SUMMARY

GOOD

The approaches are rated a 7, meaning that they are in good condition.

The individual items are as follows:

<u>Item</u>	<u>SR 176 Rating</u>
Pavement	1 – Good
Approach Slabs	1 – Good
Guardrail	1 – Good
Relief Joint	1 – Good
Embankment	1 – Good

Pavement	Good
----------	------

The pavement is in good condition. The following deficiencies are noted in the Supplemental Report found in Appendix C, but are reiterated here. Detailed locations and sizes are located in the deck mapping section of the Supplemental Report. The following deficiencies were noted:

- There are spalls and patches in the asphalt adjacent to the expansion joints.

Approach Slabs	Good
----------------	------

The approach slabs are in good condition. The following deficiencies are noted in the Supplemental Report found in Appendix C, but are reiterated here. Detailed locations and sizes are located in the deck mapping section of the Supplemental Report. The following deficiencies were noted:

- No significant deficiencies noted.

Guardrail	Good
-----------	------

The guardrail is in good condition. The following deficiencies are noted in the Supplemental Report found in Appendix C, but are reiterated here. Detailed locations and sizes are located in the deck mapping section of the Supplemental Report. The following deficiencies were noted:

- The impact attenuator between Pier 17 and Pier 18BW has been hit by a vehicle.

Relief Joints	Good
---------------	------

The relief joints are in good condition. No significant deficiencies were noted.

Embankment	Good
------------	------

The embankments are in good condition. No significant deficiencies were noted.

GENERAL

SATISFACTORY

The individual items are as follows:

<u>Item</u>	<u>SR 176 Rating</u>
Warning Signs	4 – Critical
Sign Supports	1 – Good
Vertical Clearance	1 – Good

Warning Signs	Critical
---------------	----------

The warning signs are in critical condition. The following deficiencies were noted:

- There are no bridge end markers.

Sign Supports	Good
---------------	------

The sign supports are in good condition. The following deficiencies were noted:

- No significant deficiencies were noted.

Vertical Clearance	Good
--------------------	------

The vertical clearance is in good condition. No significant deficiencies were noted.

RECOMMENDATIONS

1. Immediate

- The portions of the drain that have broken off should be removed or reattached. It does not appear that they are able to fall past the seated hinge, but it is better to be proactive with them.

2. Maintenance and Monitoring

- Clean the expansion joints from debris.
- Tighten the loose bolt in the bottom cover plate at the splice in Span 18BW, Beam C.
- Repair the impact attenuator between Pier 17 and Pier 18BW.

3. Short Term

- Clear the drains at the following locations:
 - ♦ Span 16, Pier 16
 - ♦ Span 19BE, near Pier 18BE
- Clear the scuppers on the deck.
- Consider spot painting near the bearings and at the seated hinges.
- Repair the corroded (with section loss) crossbracing in Span 18BW and 13.
- Abrasively clean and paint the exposed rebar. Patch the spalled areas.
- Remove the delaminated concrete then abrasively clean, paint, and patch the areas.

4. Rehabilitation

- None

5. Future Inspection or Testing

- Note any changes to the delaminations in the floor.
- Note any changes in the leakage at the expansion joint glands. Replace the glands if the condition worsens.
- Note whether the missing joint armor near Pier 18BE becomes significant enough to repair.
- Continue to note the condition of the surface corrosion on the superstructure.
- Note any changes at the paint crack on Beam L in Span 15.
- Continue to watch the rotation at the following bearings:

♦ South Abut	10°S	Bearing F
♦ South Abut	10°N	Bearing L
♦ North Abut BW	17°N	Bearing E
♦ Pier 28BE	10°S	Bearing L
♦ North Abut BE	32°S	Bearing G
♦ North Abut BE	15°S	Bearing J
- Reset the bearing at the following location:


♦ North Abut BE	32°S	Bearing G
-----------------	------	-----------
- Continue to note the amount of corrosion on the fatigue prone details.
- Note any changes to the cracking in the backwall at the North Abutment BW. The amount of cracking may lead to spalling in the near future.

I-71/SR 176 Double Decked Bridge (SR 176 Lower Deck)
2012 In-Depth Bridge Inspection

APPENDIX

A

SR 176 (Lower Deck)
Spans 8 - 13

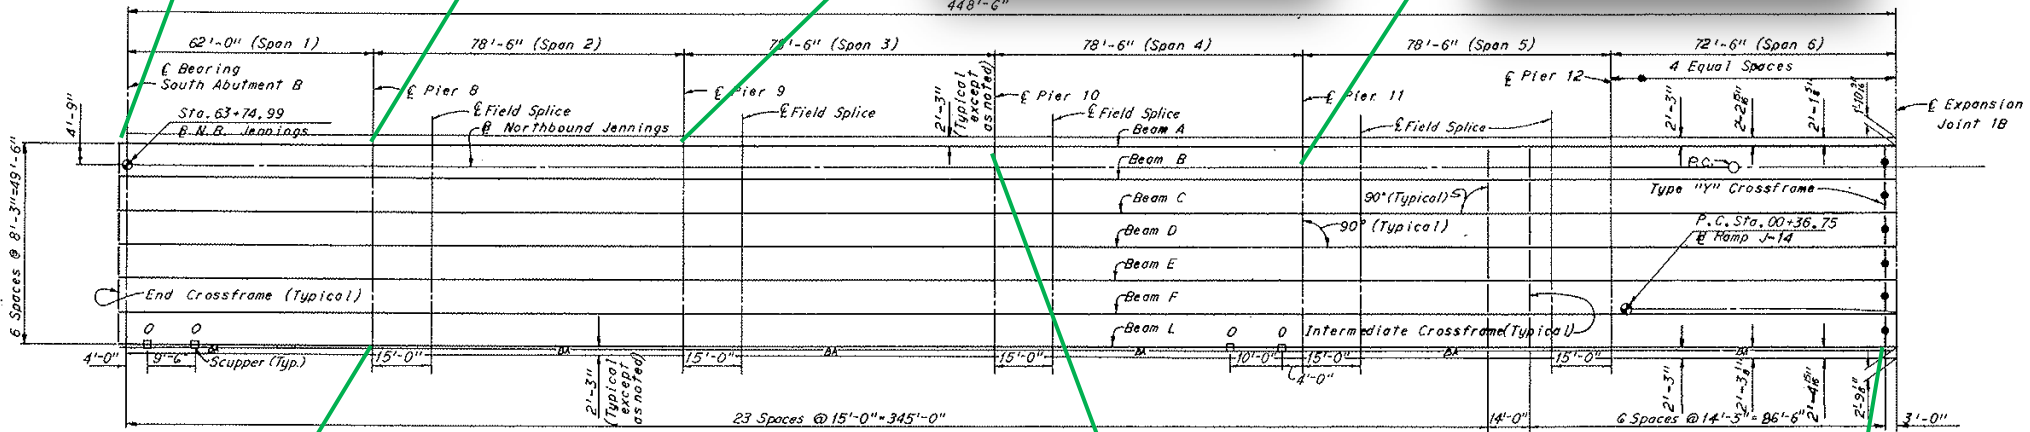


—BA— Denotes Bulb Angle Gutter

FRAMING PLAN




SR 176 (Lower Deck)
Spans 14 – 18BW/18BE

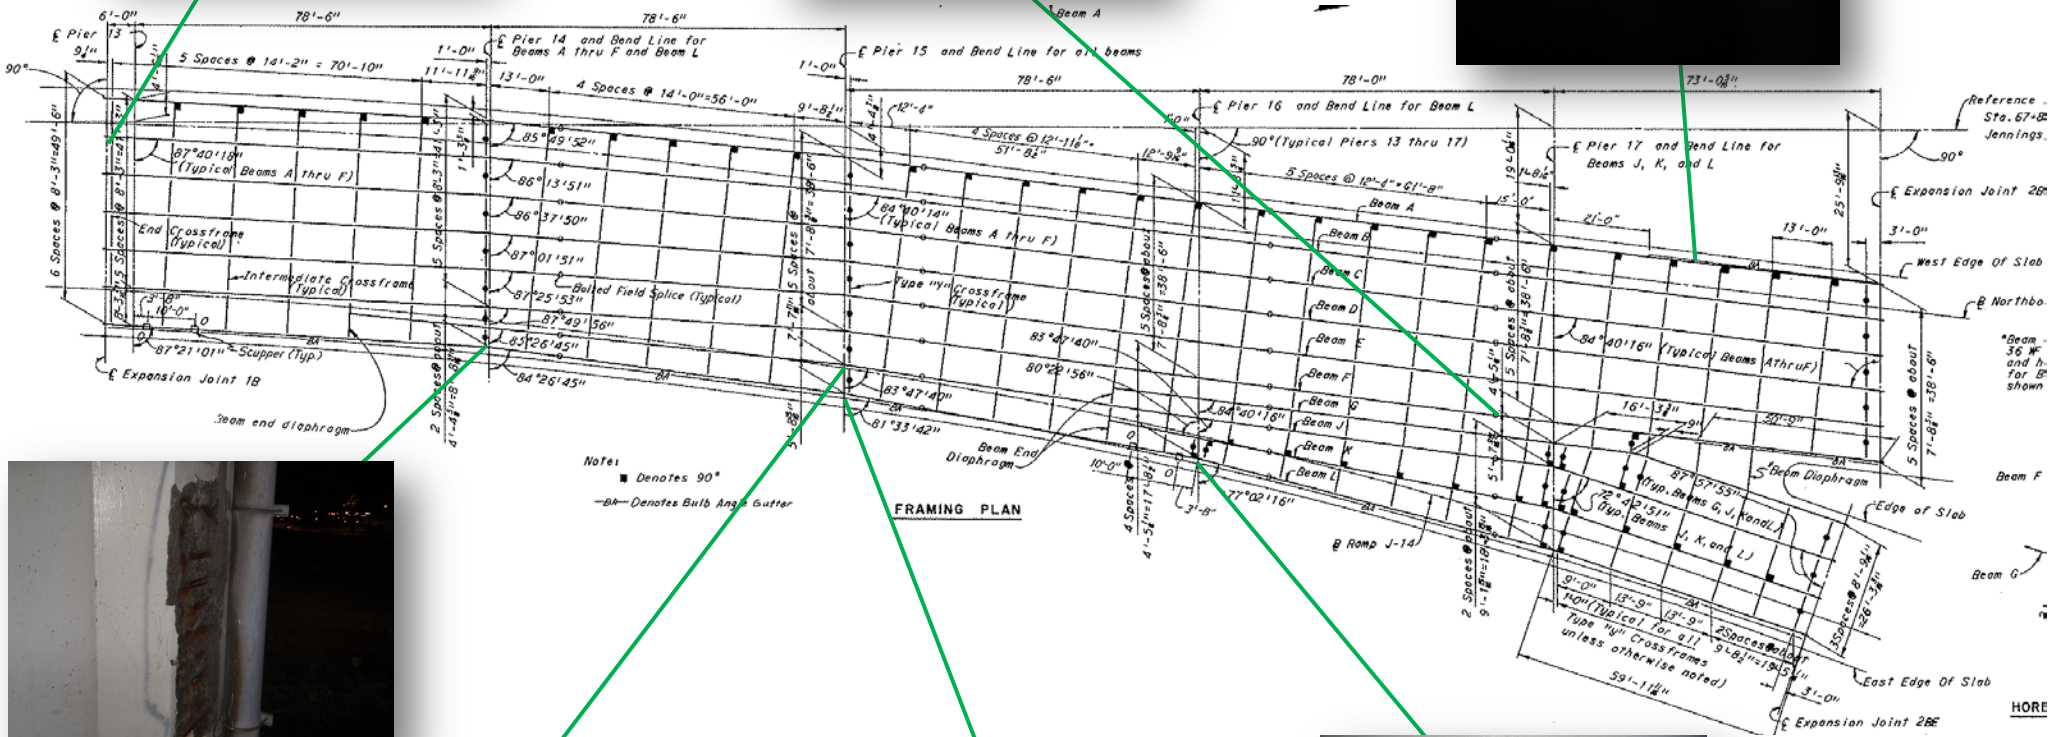

HORE


SR 176 (Lower Deck)
Spans 19BW – 21BW

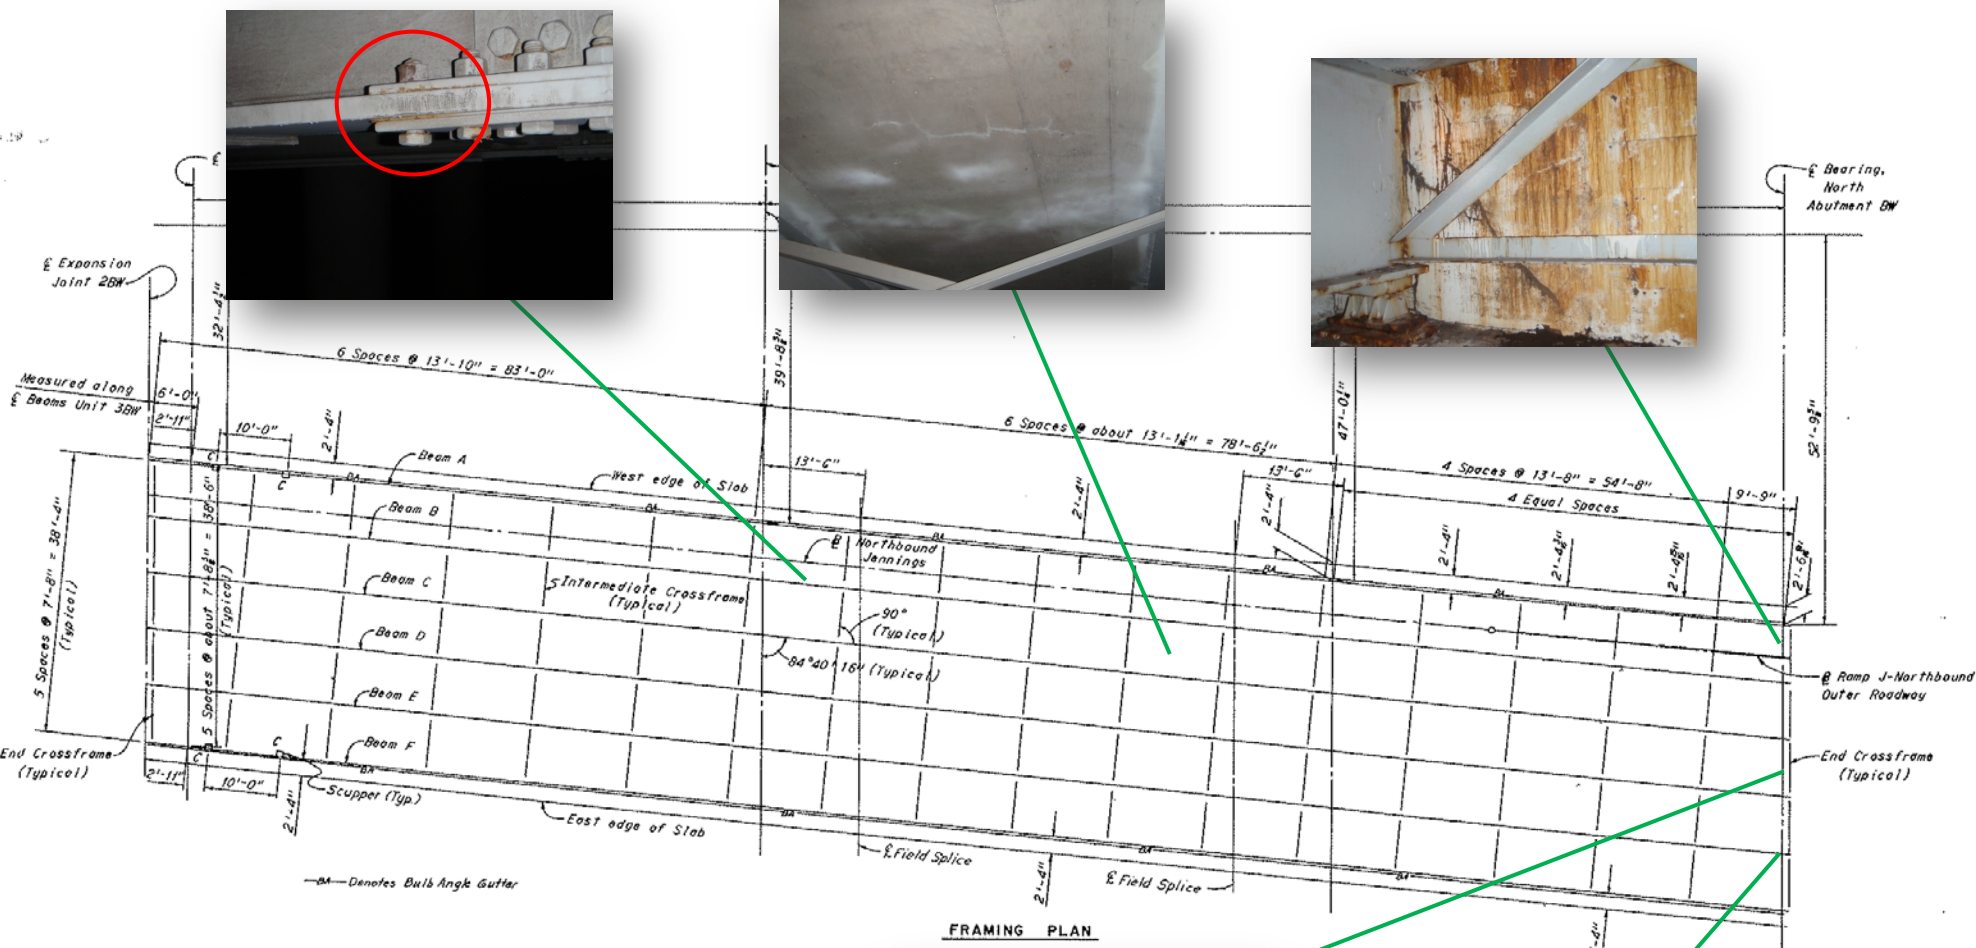


FRAMING PLAN



**SR 176 (Lower Deck)
Spans 19BE – 24BE**

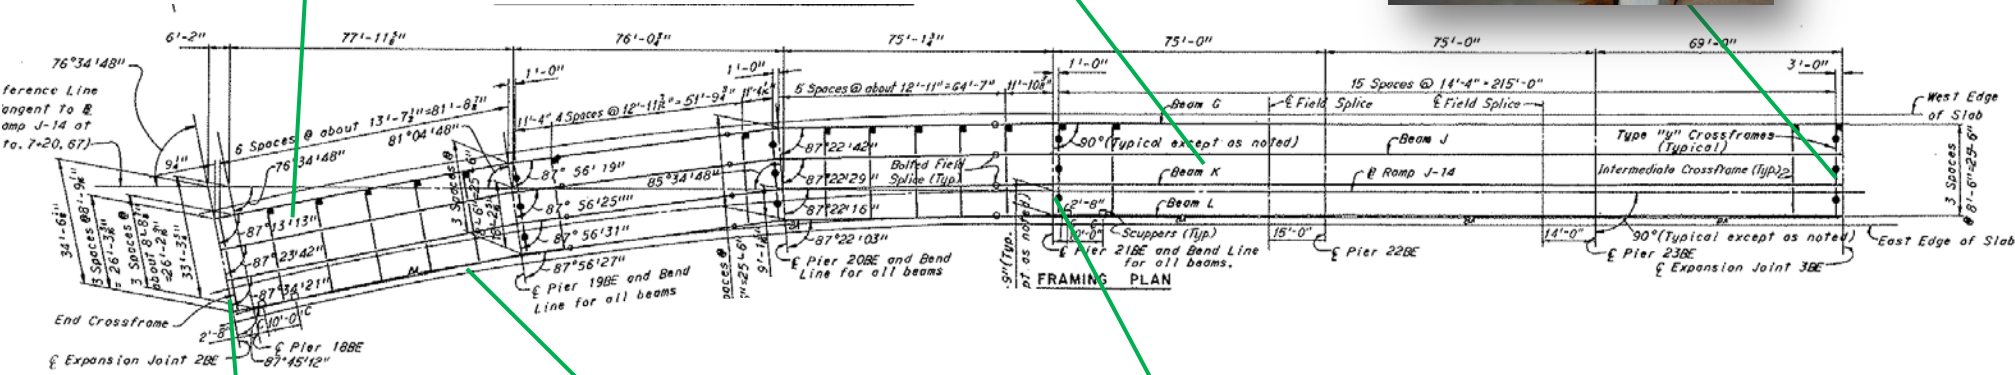

SR 176 (Lower Deck)
Spans 25BE – 29BE

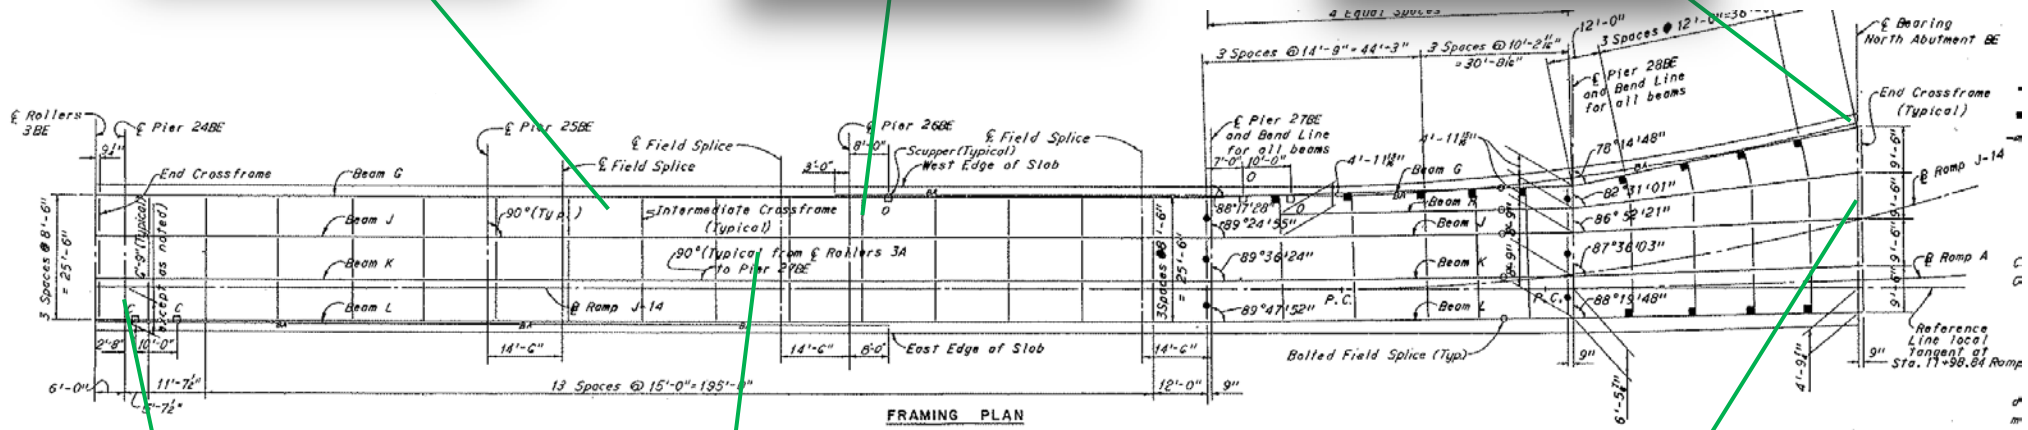

I-71/SR 176 Double Decked Bridge (SR 176 Lower Deck)
2012 In-Depth Bridge Inspection

APPENDIX B

OHIO DEPARTMENT OF TRANSPORTATION

BRIDGE INSPECTION REPORT

1	8	0	5	4	3	6	CUY	00176	1334	YEAR BUILT	7/1/1968	
STRUCTURE FILE NUMBER							CO	ROUTE	UNIT			
DIST	12	BRIDGE TYPE					322	TYPE OF SERVICE	10	IR-71NB (CUY-71-1791R)		

DECK

1. Floor	2	2. Wearing Surface	2
3. Curbs, Sidewalks & Walkways		4. Median	
5. Railing	2	6. Drainage	2
7. Expansion Joints	2	8. SUMMARY	6

SUPERSTRUCTURE

9. Alignment of Members	1	10. Beams/Girders/Slab	1
11. Diaphragms or Cross frames	2	12. Joists/Stringers	
13. Floorbeams		14. Floorbeam Connections	
15. Verticals		16. Diagonals	
17. End posts		18. Upper Chord	
19. Lower Chord		20. Gusset Plates	
21. Lateral Bracing		22. Sway Bracing	
23. Portals		24. Bearing Devices	2
25. Arch		26. Arch Columns or Hangers	
27. Spandrel Walls		28. Protective Coating System (PCS)	6
29. Pins/Hangers/Hinges	2	30. Fatigue Prone Detail (E & E')	1
31. Live Load Response (<i>E or S</i>)	S	32. SUMMARY	6

SUBSTRUCTURE

33. Abutments	1	34. Abutment Seats	1
35. Piers	2	36. Pier Seats	1
37. Backwalls	2	38. Wingwalls	1
39. Fenders and Dolphins		40. Scour (<i>Insp Type - 1, 2, 3</i>)	
41. Slope Protection	2	42. SUMMARY	6

CULVERT

43. General		44. Alignment	
45. Shape		46. Seams	
47. Headwall or Endwalls		48. Scour (<i>Insp Type - 1,2,3</i>)	
49. Abutments		50. SUMMARY	

CHANNEL

51. Alignment		52. Protection	
53. Hydraulic Opening		54. SUMMARY	

APPROACHES

55. Pavement	1	56. Approach Slabs	1
57. Guardrail	1	58. Relief Joint	1
59. Embankment	1	60. SUMMARY	7

GENERAL

61. Navigation Lights		62. Warning Signs	4
63. Sign Supports	1	64. Utilities	
65. Vertical Clearance (<i>1, 2-change, N</i>)	1	66. General Appraisal & Operational Status	6 A

67. Inspected By, First & Last Name

A	n	n													
G	r	i	e	s	s	m	a	n	n						

0	6	8	1	7	7
PE Number					

68. Reviewed By, First & Last Name

PE Number															

Date 0 8 1 0 1 2

1	1	1	1	1	N	N	N
---	---	---	---	---	---	---	---

Date

--	--	--	--	--	--

69. Survey (1, 0, N)

STATE OF OHIO DEPARTMENT OF TRANSPORTATION
BRIDGE INSPECTION REPORT

BR-86 REV 2-95

1	8	0	5	4	3	6
---	---	---	---	---	---	---

STRUCTURE FILE NUMBER 7

BRIDGE NUMBER CUY 00176 1334 CUYAHOGA YEAR BUILT 1968
CO ROUTE UNIT
DIST 12 BRIDGE TYPE 322 TYPE SERVICE 10 IR-71 NB (CUY-71-1791R)

For Full Report, Please See Bridge File. Curbs, Sidewalks, & Walkways do not exist so this item was removed.

DECK

FLOOR: The floor is in fair condition. There are hairline to narrow transverse cracks with efflorescence. A few areas show honeycombing and spalling with exposed rebar. There also are areas of delaminated concrete.

WEARING SURFACE: The wearing surface is in fair condition. There are areas of full-depth patches that are in good quality. There are transverse cracks spaced roughly at 10 ft intervals in the positive moment regions and at 6 ft intervals in the negative moment regions. There are isolated areas of map cracking, spalling, and deteriorated patches. Several RPMs are missing leaving shallow holes.

RAILING: The railing is in fair condition. There are several spalls along the toe of the barrier. Vertical cracks exist throughout. There are longitudinal cracks with efflorescence on the exterior face in Span 19BE. The spalling and cracking in the railing is the reason for lowering the rating to a 2, per the 2010 revision of the ODOT Manual of Bridge Inspection.

DRAINAGE: The drains are in fair condition. Several drains are clogged. The rating was raised to a 2 since the amount of scuppers clogged is up to 1/4, per the 2010 revision of the ODOT Manual of Bridge Inspection.

EXPANSION JOINTS: The expansion joints are in fair condition. The glands show signs of minor leakage. Debris exists in most of the joints. The elastomeric seal joint near Piers 13 & 24BE have a portion of the sealer sticking up out of the joint with tears in the sealer visible. The elastomeric seal joint at Pier 24BE also have a 1/4" to 1/2" elevated lip from one side of the joint to the other. The elastomeric seal joint near Pier 18BE has portions of the armor missing.

SUPERSTRUCTURE

BEAMS/GIRDERS: The beams and girders are in good condition. There is surface corrosion at various locations, especially on the bottom flange, splice bolts, and near the seated hinges. The area near the seated hinges has up to 1/16" section loss. A loose bolt exists at the splice at Beam C, Span 18BW.

DIAPHRAGMS OR CROSSFRAMES: The crossframes are in fair condition. There are locations of corrosion holes in Spans 18BW and 13. A paint crack exists in Span 15 on Beam L. There is an incomplete weld in Beam A, Span 15. Pack rust is bowing the top gusset plate 1" in Span 18BW.

BEARING DEVICES: The bearings are in fair condition. There are six bearings that are rocked $\geq 10^\circ$. One bearing is rocked beyond recall; North Abut BE, Bearing G.

PAINT: The paint is in satisfactory condition. There is greater than 5% and less than 10% of the total coating system has failed. Surface or freckled rust is prevalent throughout. There are random locations of peeling paint and surface corrosion.

PINS/HANGERS/HINGES: The seated hinges are in fair condition. The hinges have surface corrosion with the corrosion heavier at the groove.

FATIGUE PRONE CONNECTIONS: The fatigue prone connections are in good condition. There is surface corrosion on the welds.

LIVE LOAD RESPONSE: The live load response is in satisfactory condition.

SUBSTRUCTURE

ABUTMENTS: The abutments are in good condition. There is rust staining and map cracking. This is the reason for raising the rating to a 1. The previous deficiency noted is actually located on the backwall and that rating correlates with the problem.

PIERS: The piers are in fair condition. There are hairline to medium cracks, spalling with exposed rebar, and delaminations.

PIER SEATS: The pier seats are in good condition. There are multiple areas along the pier seat edge that are cracking.

BACKWALLS: The backwalls are in fair condition. There is map cracking at North Abut BW.

SLOPE PROTECTION: The slope protection is in good condition. The stone slope protection shows signs of erosion.

APPROACHES

PAVEMENT: The pavement is in good condition. There are spalls and patches in the asphalt adjacent to the expansion joints.

GUARDRAIL: The guardrail is in good condition. The impact attenuator between Pier 17 and Pier 18BW has been hit by a vehicle.

GENERAL

WARNING SIGNS: There are no bridge end markers.

SIGN SUPPORTS: The rating was raised to a 1 because there were no significant deficiencies noted.

VERTICAL CLEARANCE: The rating was changed to a 1 since there is a restriction for traffic on the bridge and there are no changes from last year.

I-71/SR 176 Double Decked Bridge (SR 176 Lower Deck)
2012 In-Depth Bridge Inspection

APPENDIX

C

2012 Annual Inspection of the S.R. 176 Bridge CUY-176-1331 SFN 1805436

Supplemental Report of 2012 Inspection Results

Deck

The wearing surface of the bridge deck was visually inspected with deficiencies mapped, but not sounded as part of this inspection. The wearing surface is in overall satisfactory condition, providing a smooth riding surface. Large areas of this deck have been patched with good quality, full-depth concrete patches that are behaving similar to the original deck. Transverse cracking is spaced at roughly 10' intervals in the positive moment regions, and 6' intervals in the negative moment regions. There are isolated areas of map cracking, spalling, and deteriorating patches. There are very few small, shallow spalls in random locations away from the joints but these spalls account for less than 1% of the total deck area. Most spalls were found along or near construction joints in the wearing surface. There are also numerous locations where RPMs are missing from the wearing surface. See deck mapping for more detailed locations and sizes of deficiencies.

Railing

The barriers are in satisfactory condition, and are structurally sound. There are spalls and deteriorations along large portions of the toe of the barrier, especially on the east (low) side of the structure. This may be due to the runoff sloping toward the east barrier and ponding because most of the scupper pans are full of debris. There are also some random vertical cracks in both barriers. The impact attenuator between Pier 17 and Pier 18-BW has been hit by a vehicle. See deck mapping for more detailed locations of deficiencies.

Drainage System

The drains at Piers 16 and 18-BE are clogged with debris and water is not draining properly. The scupper pans in the tops of the decks are clogged with debris in most locations. See deck mapping for more detailed locations.

Expansion Joints

The expansion joints are in satisfactory condition. The intermediate expansion joints vary in clear spacing from 1 $\frac{7}{8}$ " to 2 $\frac{1}{2}$ " (measured perpendicular to the joints). The abutment expansion joints vary in clear spacing from 1 $\frac{5}{8}$ " to 2 $\frac{5}{8}$ " (measured perpendicular to the joints). The glands showed signs of minor leakage. The abutment joints near Abutment B and Abutment BE and the expansion joint near Pier 18-BW are in good condition. The elastomeric seal joint near Pier 13 and Pier 24-BE have a portion of the sealer sticking up out of the joint with tears in the sealer visible. The elastomeric seal joint at Pier 24-BE also has a $\frac{1}{4}$ " to $\frac{1}{2}$ " elevated lip from one side of the joint to the other. The elastomeric seal joint near Pier 18-BE has portions of the armor missing as well as the sealer sticking up out of the joint. The elastomeric seal joint neat Abutment BW has asphalt covering part of the joint. Spalls were found at most expansion joints. The elastomeric seal joints are also full of debris in most locations. See attached table giving expansion joint measurements and temperatures when the measurements were taken.

Recommendations

No major issues were found during the bridge inspection. It is recommended that the scuppers and downspouts be cleared of debris to avoid deterioration at the toe of barrier at the east barrier due to standing water. The expansion joints should be cleared of all debris to allow for proper expansion and contraction of the deck.



Longitudinal cracking in right shoulder.




Two holes drilled through barrier.



Elastomeric sealer missing from right portion of abutment joint.

END APPROACH SLAB
STA. 63+72.74

BEGIN APPROACH SLAB
STA. 74+45.47

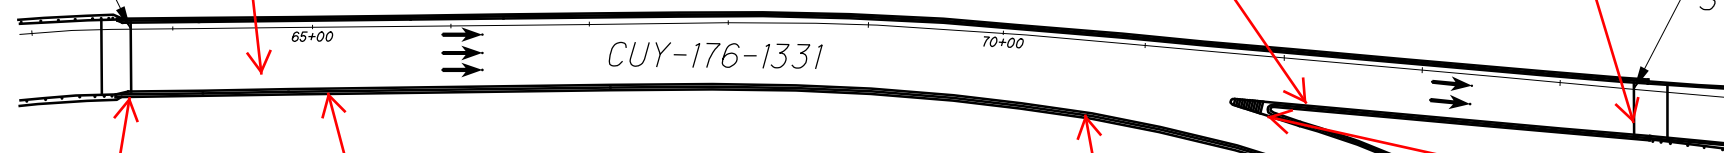

PLAN VIEW



Impact attenuator has been hit by vehicle.

WEST 14TH STREET



Abutment joint has debris covering part of joint.



Typical spall at toe of barrier.



Typical clogged drain.



Typical RPM missing.

EXPANSION JOINT MEASUREMENT TABLE

Expansion Joint	Measurement (in)	Temperature (°F)
CUY-71-1791		
South Abutment Joint A	2 7/8	85
Expansion Joint 1-A	2 1/8	85
Expansion Joint 2-A	2 1/4	85
Expansion Joint 3-AW	2 1/4	80
Expansion Joint 3-AE	2 1/2	75
North Abutment Joint AW	2 1/8	80
North Abutment Joint AE	1 1/2	75
CUY-176-1331		
South Abutment Joint B	1 5/8	82
Expansion Joint 1-B	1 3/4	82
Expansion Joint 2-BW	1 7/8	76
Expansion Joint 2-BE	1 7/8	74
North Abutment Joint BW	2 1/4	72
Expansion Joint 3-BE	2 1/2	70
North Abutment Joint BE	2 5/8	70




82° F

6' transverse spacing

1 5/8" Joint space (82° F)

(edge of steel to edge of steel)

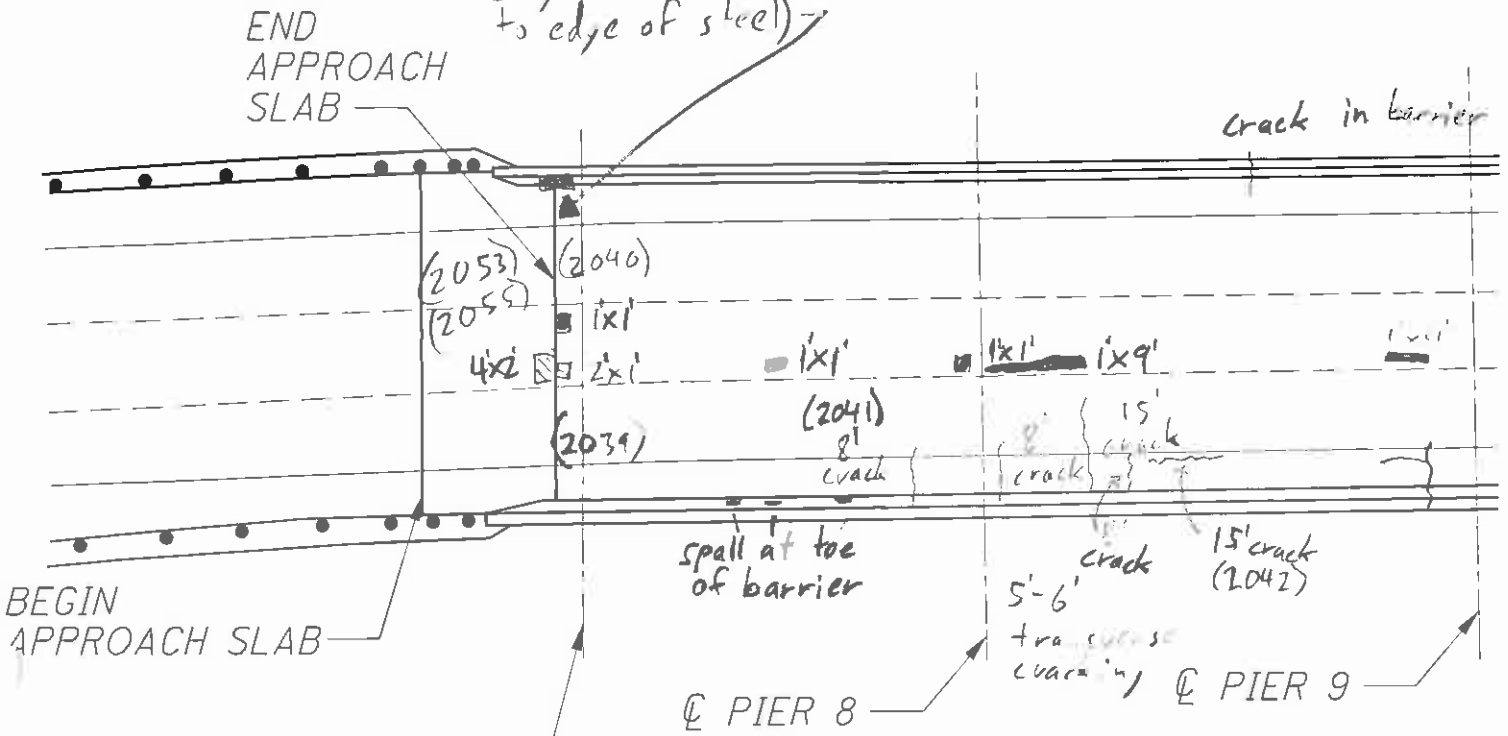

© BRG. SOUTH ABUTMENT B


photos:

- 2039 - Exp. Jt.
- 2040 - Exp. Jt.
- 2041 - crack transverse
- 2042 - longitudinal crack
- 2053 - S. Approach - good
- 2055 - spall 1'x9'

spall - ■
 patch - ◻
 (photo)



5' - transverse spacing (P.C.)
10' - transverse spacing (span)

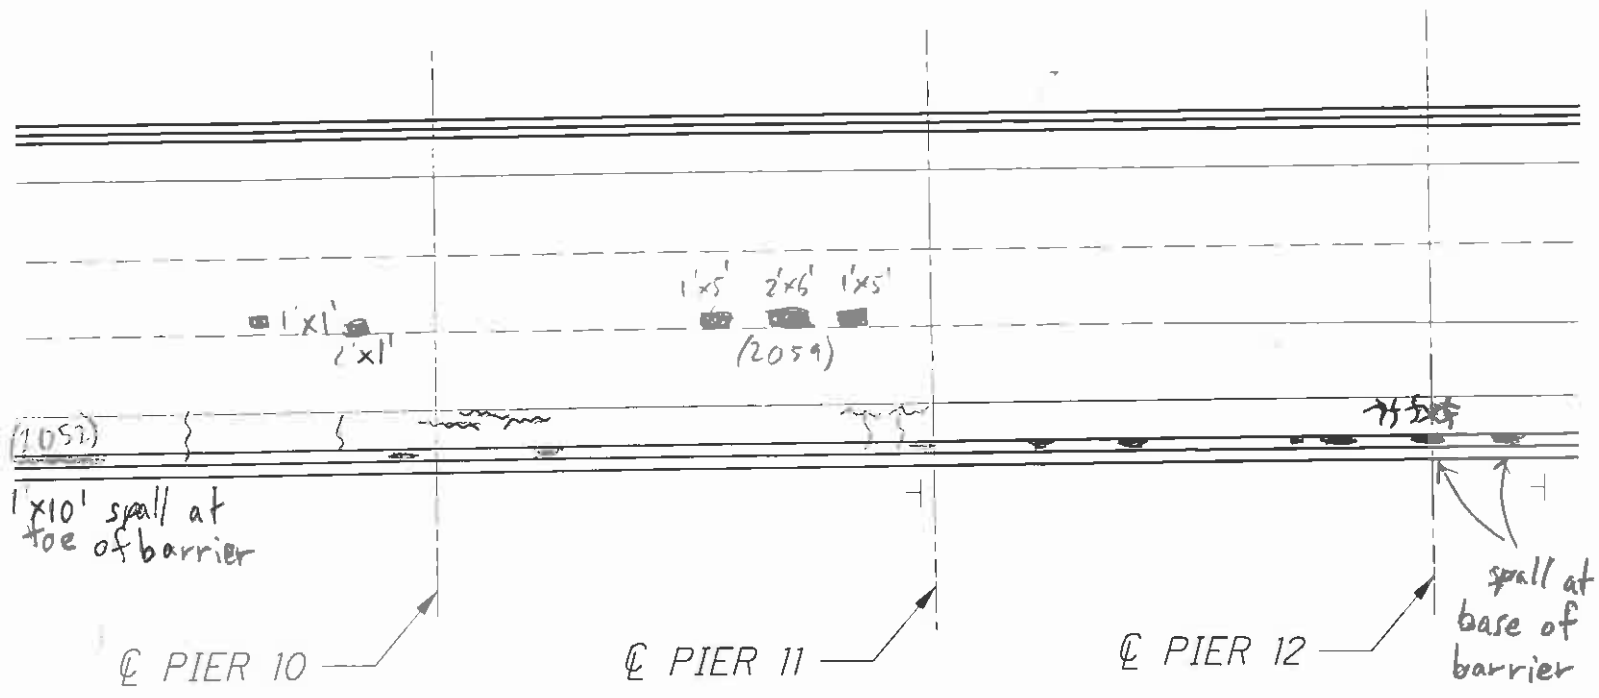

photos:

2052 - spall at toe of barrier (typ.)

2059 - large spall

spall - ■

patch - ▨

minor map cracking - ~~~~~
(photo)

176 BRIDGE
PLAN VIEW
SECTION 2 OF 9

82°F




1 1/16" Jt' space (82°F)
(edge of steel
to edge of steel)

Clean spouts

⊕ INTERMEDIATE
EXPANSION JOINT 1-B

⊕ PIER 14

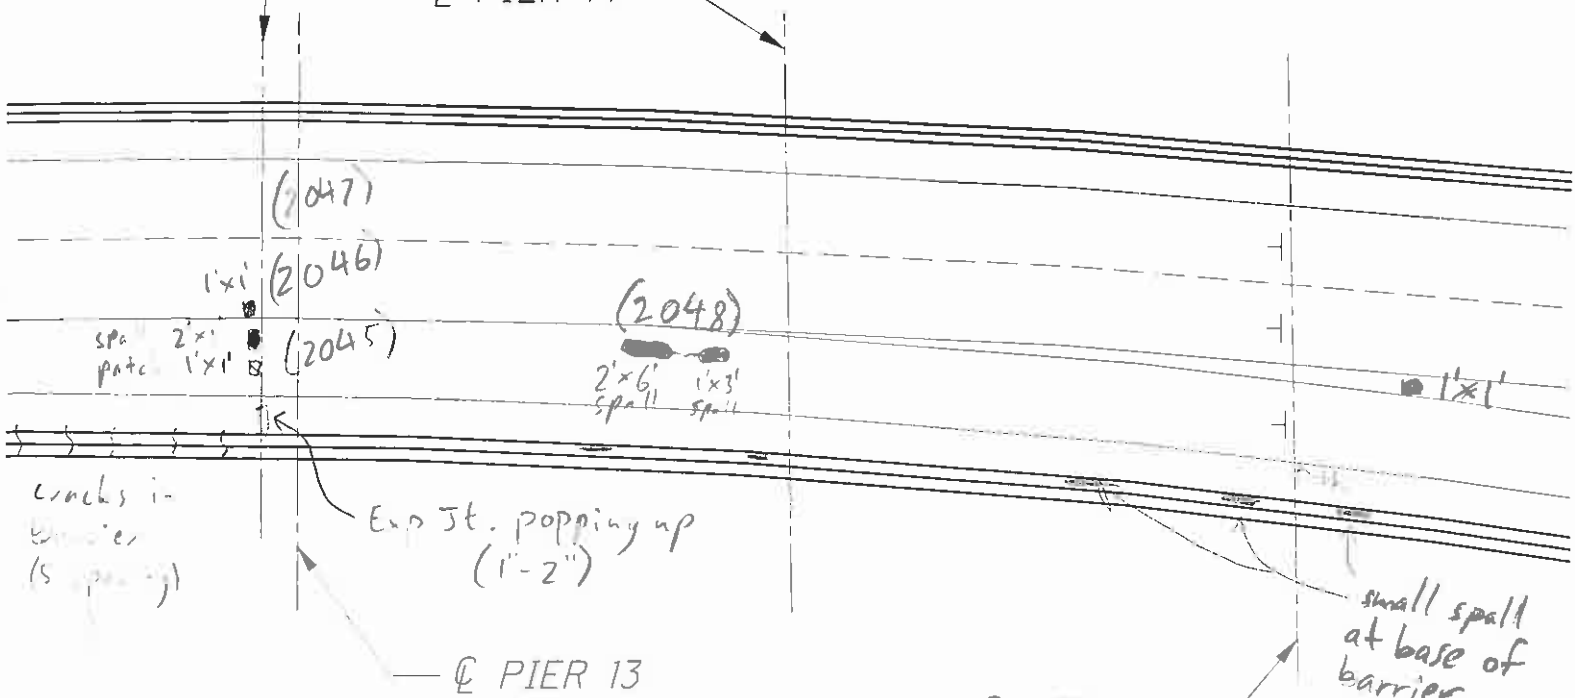

Photos:

- 2045 - Exp Jt
- 2046 - Exp Jt
- 2047 - Exp Jt
- 2048 - spall 2'x6', 1'x3'


⊕ PIER 15

spall - ■
patch - ▣

minor map cracking - ~~~~~
(photo)



temp - 76°F

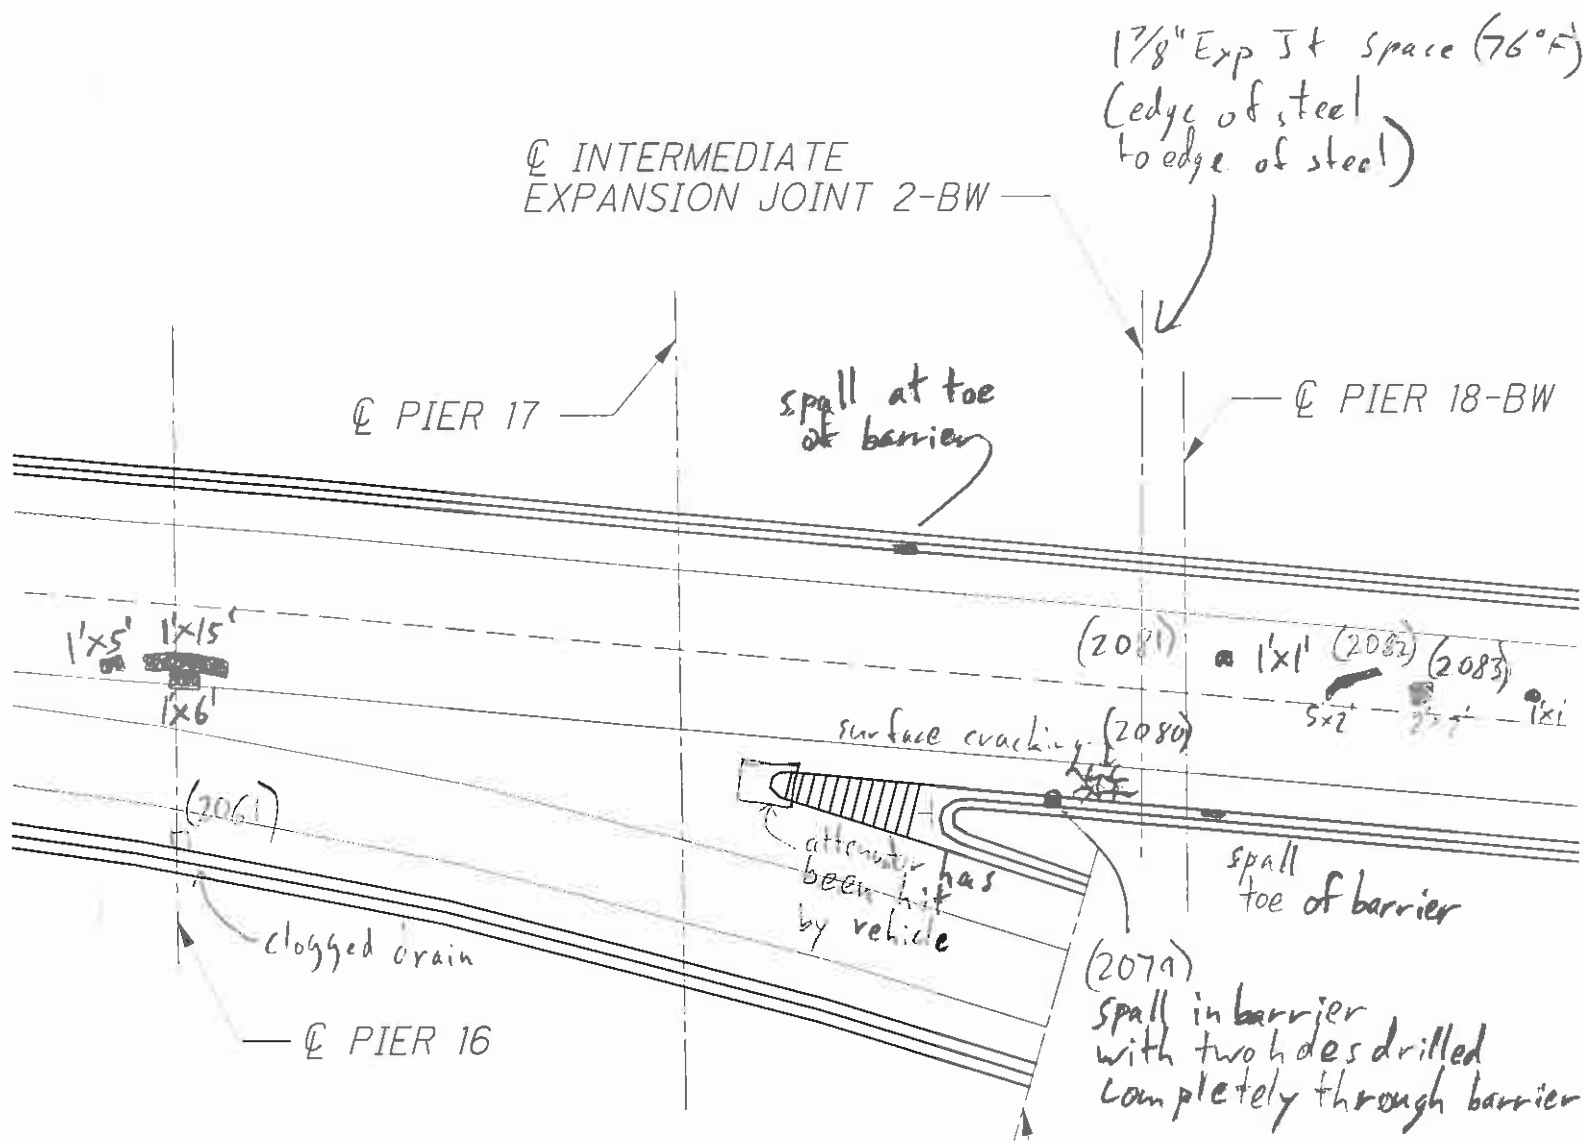

photo


- 2049 - drain (typ.)
- 2050 - drain (typ.)
- 2079 - barrier spall - two holes drilled
- 2080 - Exp. Jt
- 2081 - Exp. Jt
- 2082 - spall 5'x2'
- 2083 - spall 2'x2'
- 2061 - clogged drain (typ.)

- spall - ■
- patch - ▨
- minor map cracking - ✂
- (photo)

176 BRIDGE
 PLAN VIEW
 SECTION 4 OF 9



temp - 72° F

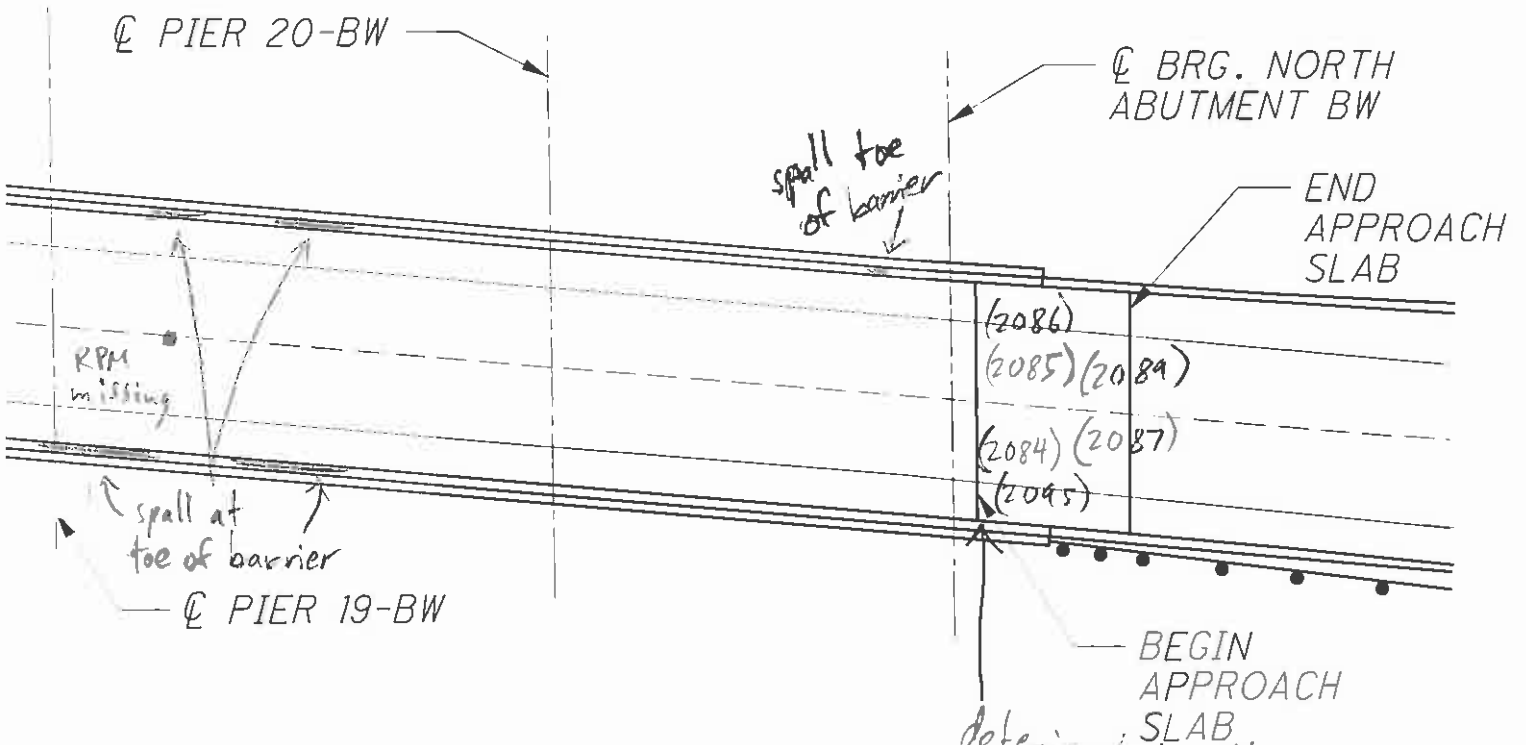


Photos:


- 2084 - Exp Jt
- 2085 - Exp Jt
- 2086 - Exp Jt
- 2087 - App Slab
- 2089 - App Slab
- 2095 - Exp Jt

determined rubber joint has asphalt over it
 2 1/4" Exp. Jt. space (72° F)

- spall - ■
- patch - ▨
- minor map cracking - ~~~~~ (photo)

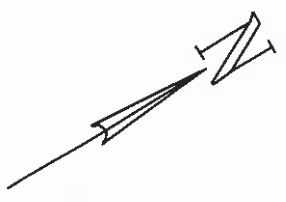

74° F

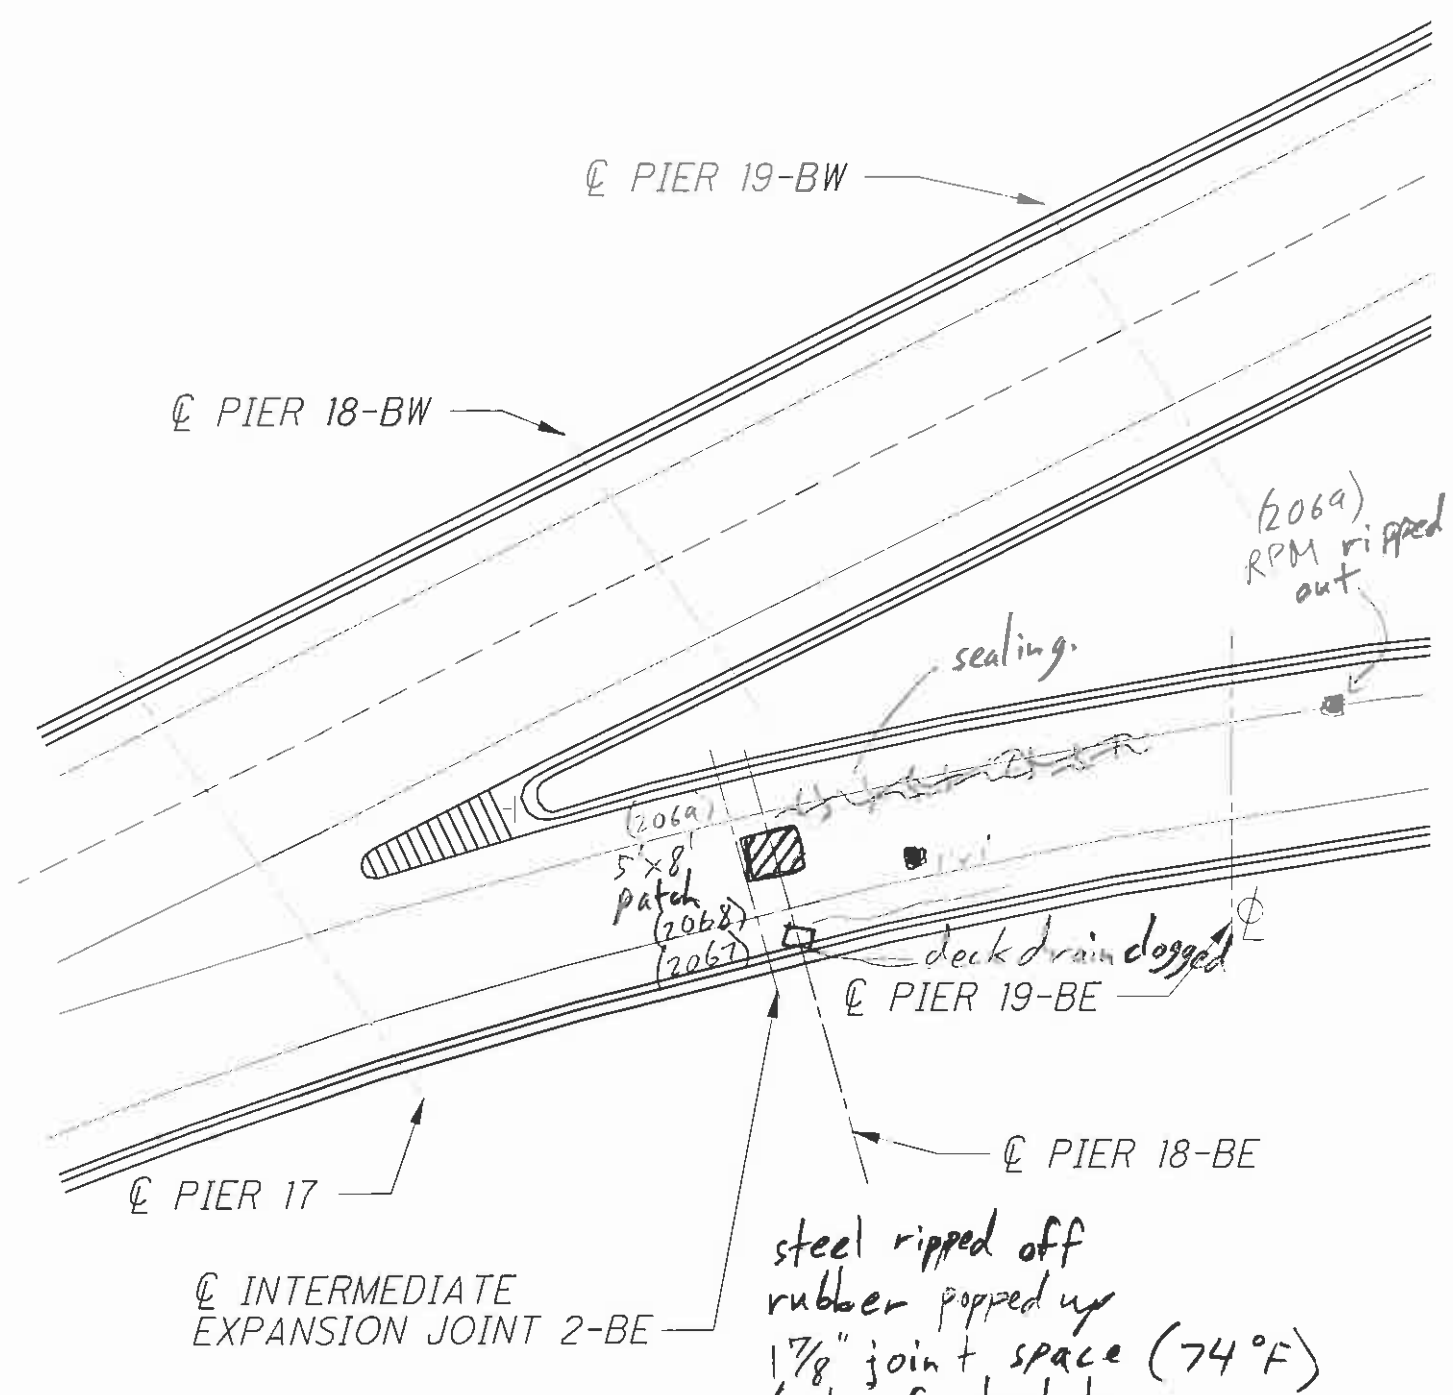


photos:

- 2067 - Exp Jt
- 2068 - Exp Jt
- 2069 - Exp Jt
- 2069 - RPM missing


- spall - ■
- patch - ▨
- minor map coding - #
- (photo)

176 BRIDGE
 PLAN VIEW
 SECTION 6 OF 9

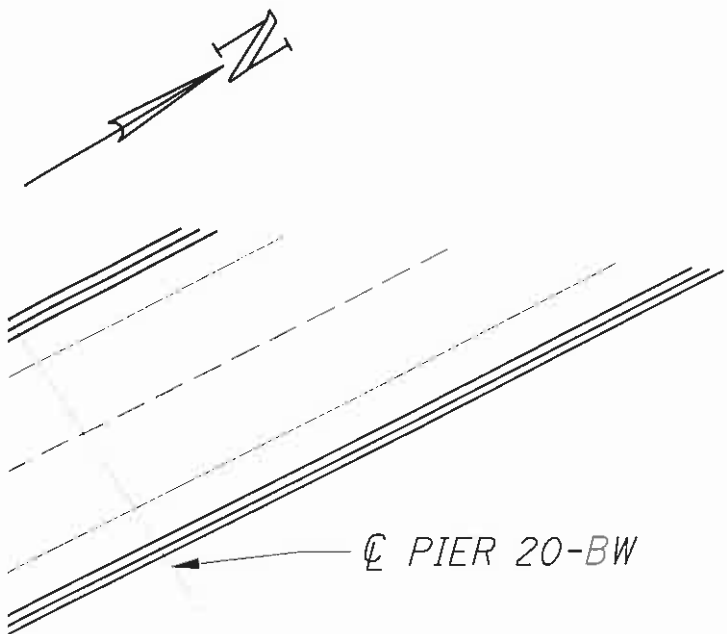

toe of barrier has many spalls

⊙ PIER 20-BW

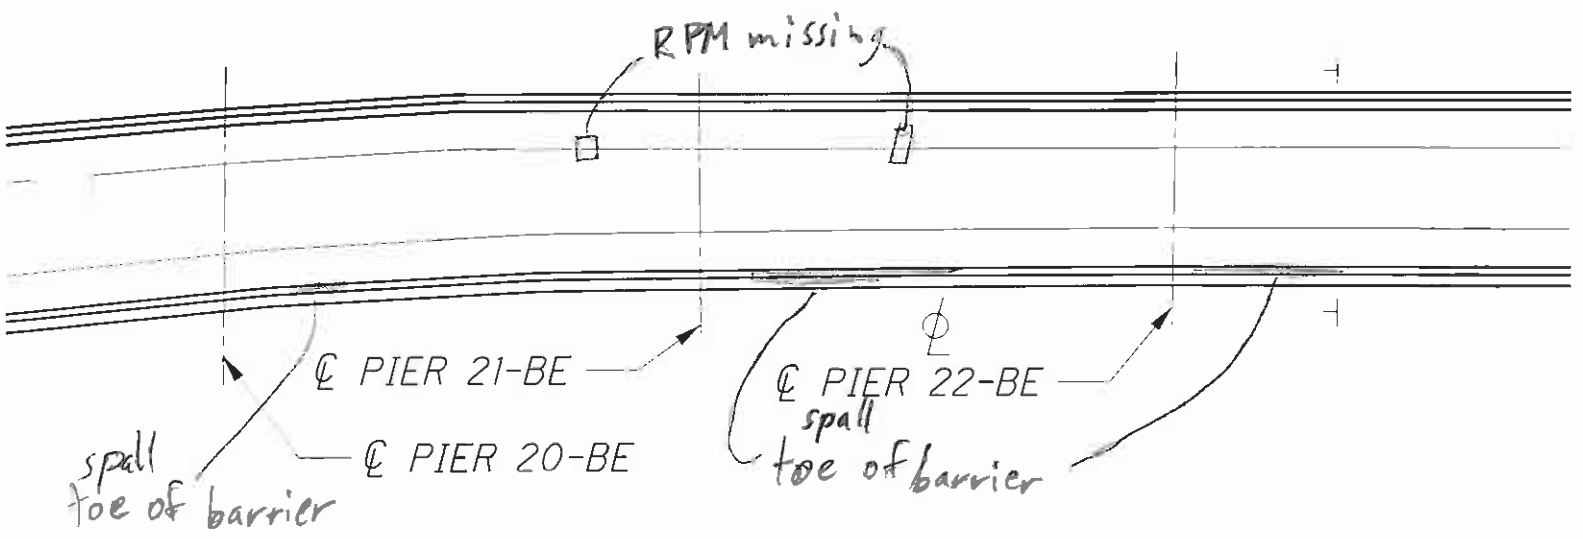

RPM missing

⊙ PIER 21-BE


⊙ PIER 20-BE

⊙ PIER 22-BE

spall toe of barrier


spall toe of barrier

spall - ■

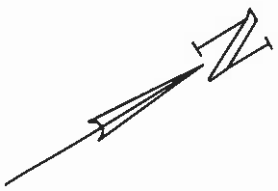


70°F

WEST 14TH STREET

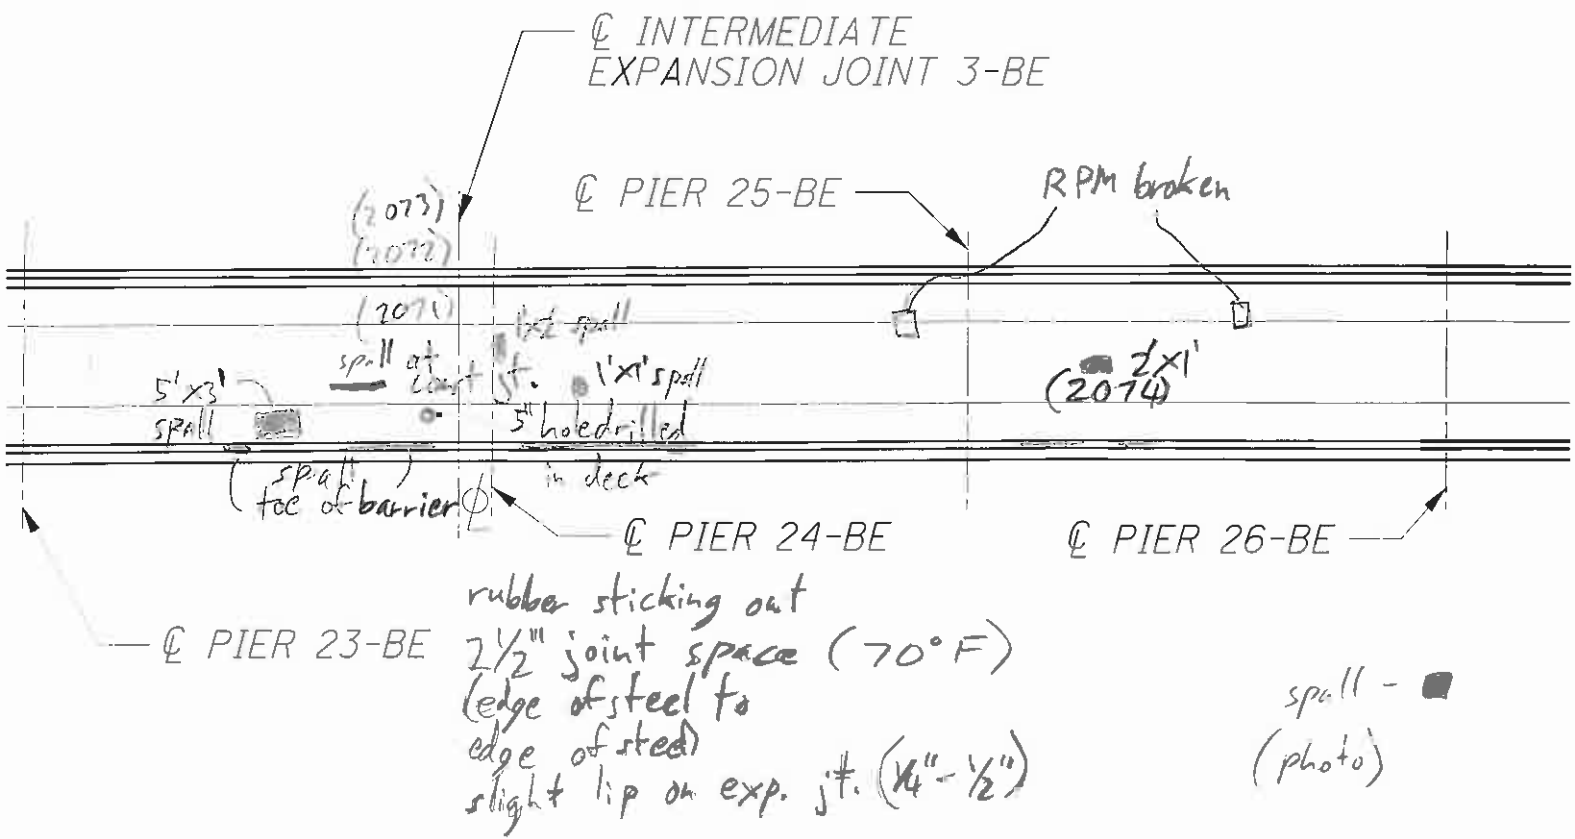


- 2071 - Exp Jt
- 2072 - Exp Jt
- 2073 - Exp Jt
- 2074 - spall 2'x1'

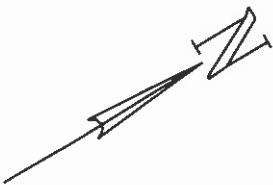

70°F

WEST 14TH STREET

2 5/8" joint space (70°F)
edge of steel
to edge of steel

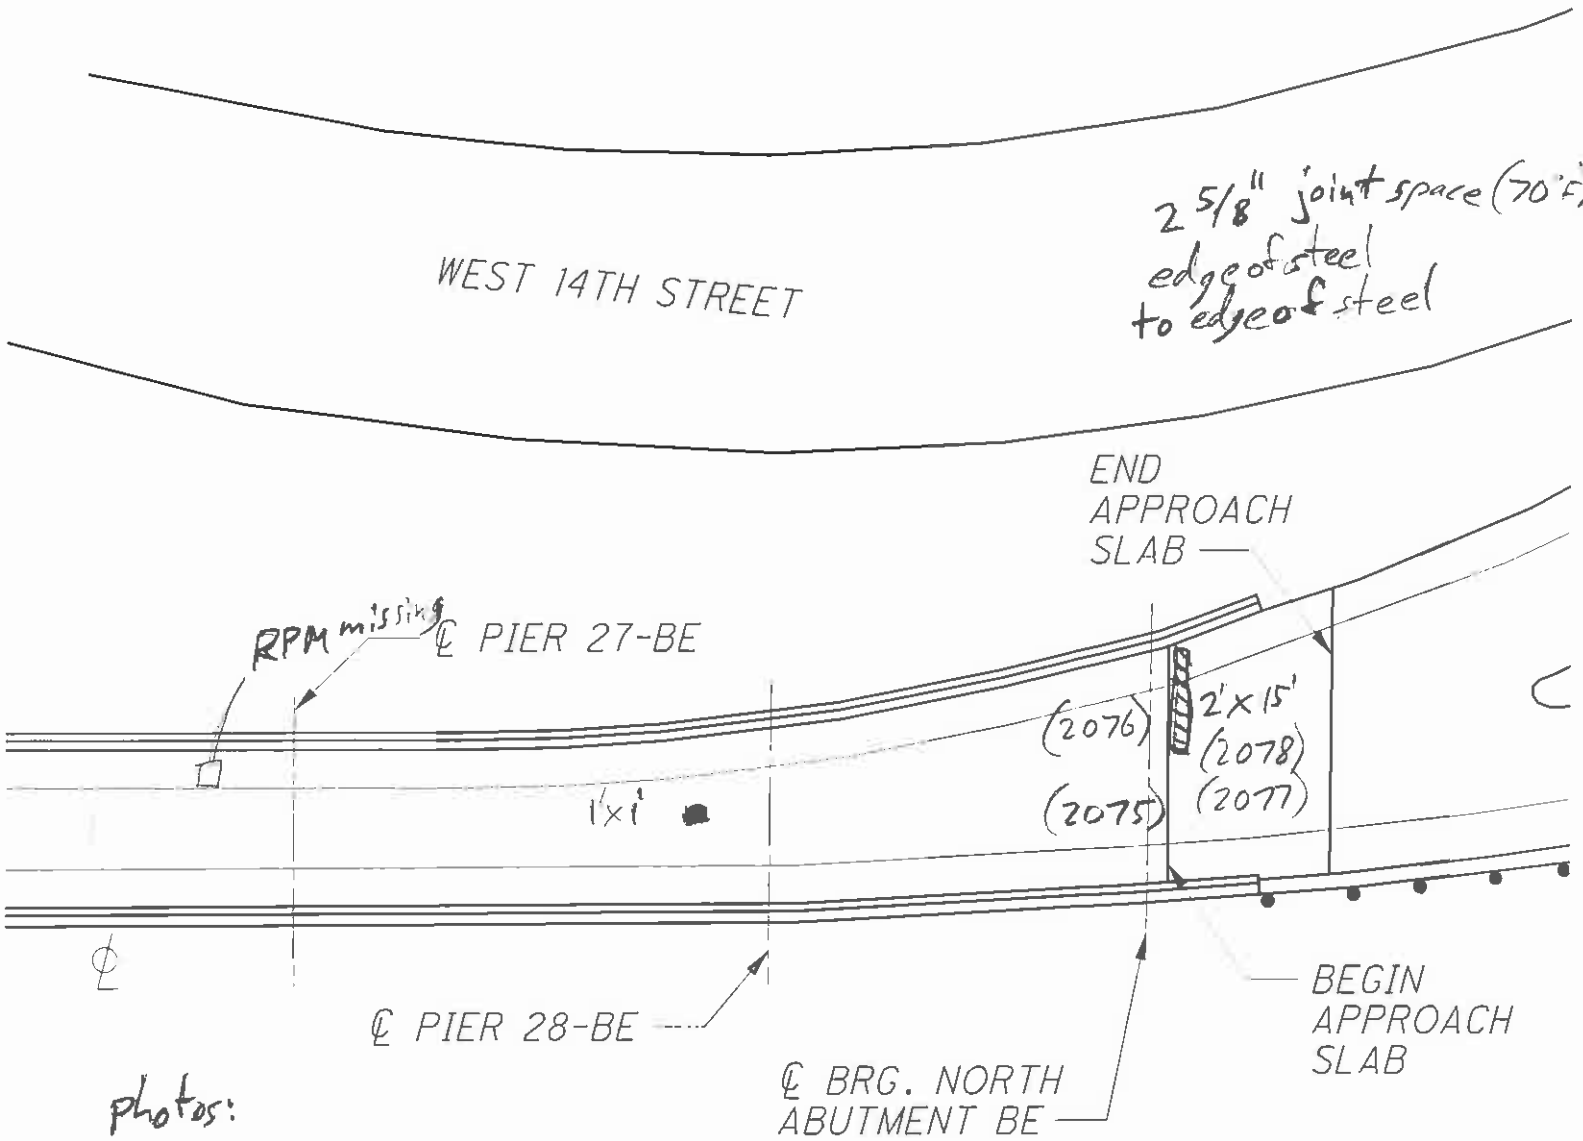

photos:

- 2075 - Exp Jt
- 2076 - Exp Jt
- 2077 - App Slab
- 2078 - App Slab

Construction joint in center of lane is starting to deteriorate


- spall - ■
- patch - ▨
- (photo)

I-71/SR 176 Double Decked Bridge (SR 176 Lower Deck)
2012 In-Depth Bridge Inspection


APPENDIX D

FIG. NO.	STATE	PROJECT	408 646
1	OHIO		

CUYAHOGA COUNTY
 CUY 71-17.83
 CUY-176-12.76

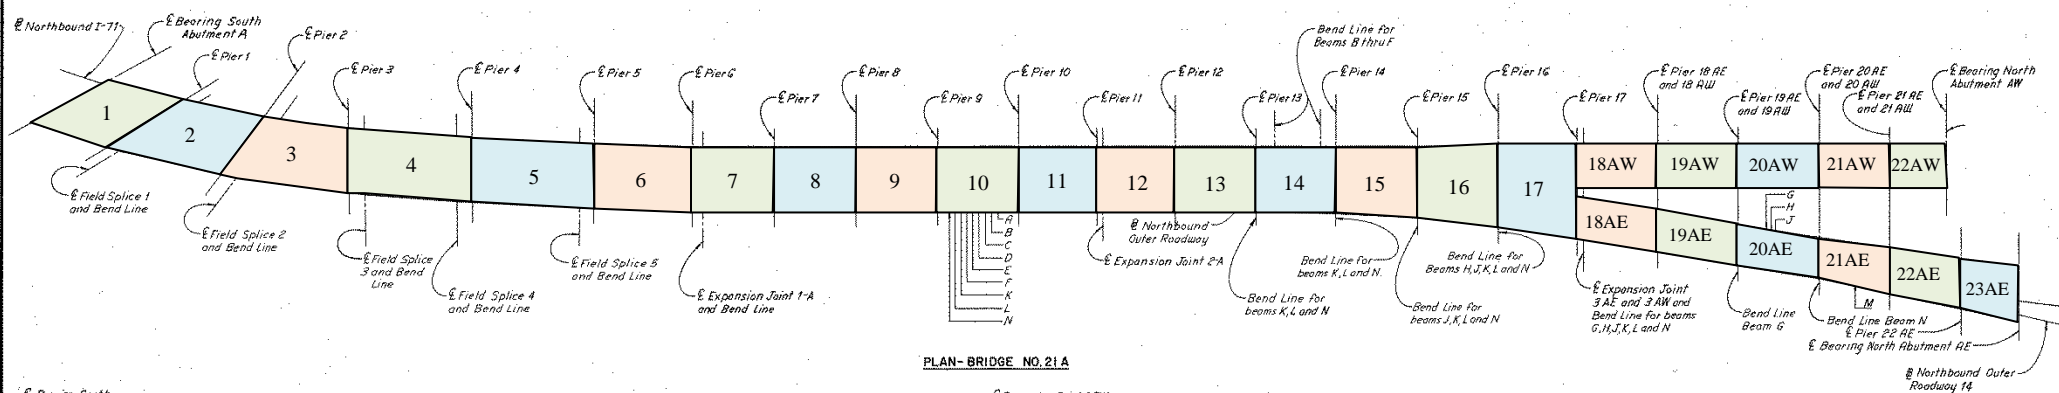

PLAN-BRIDGE NO. 21A

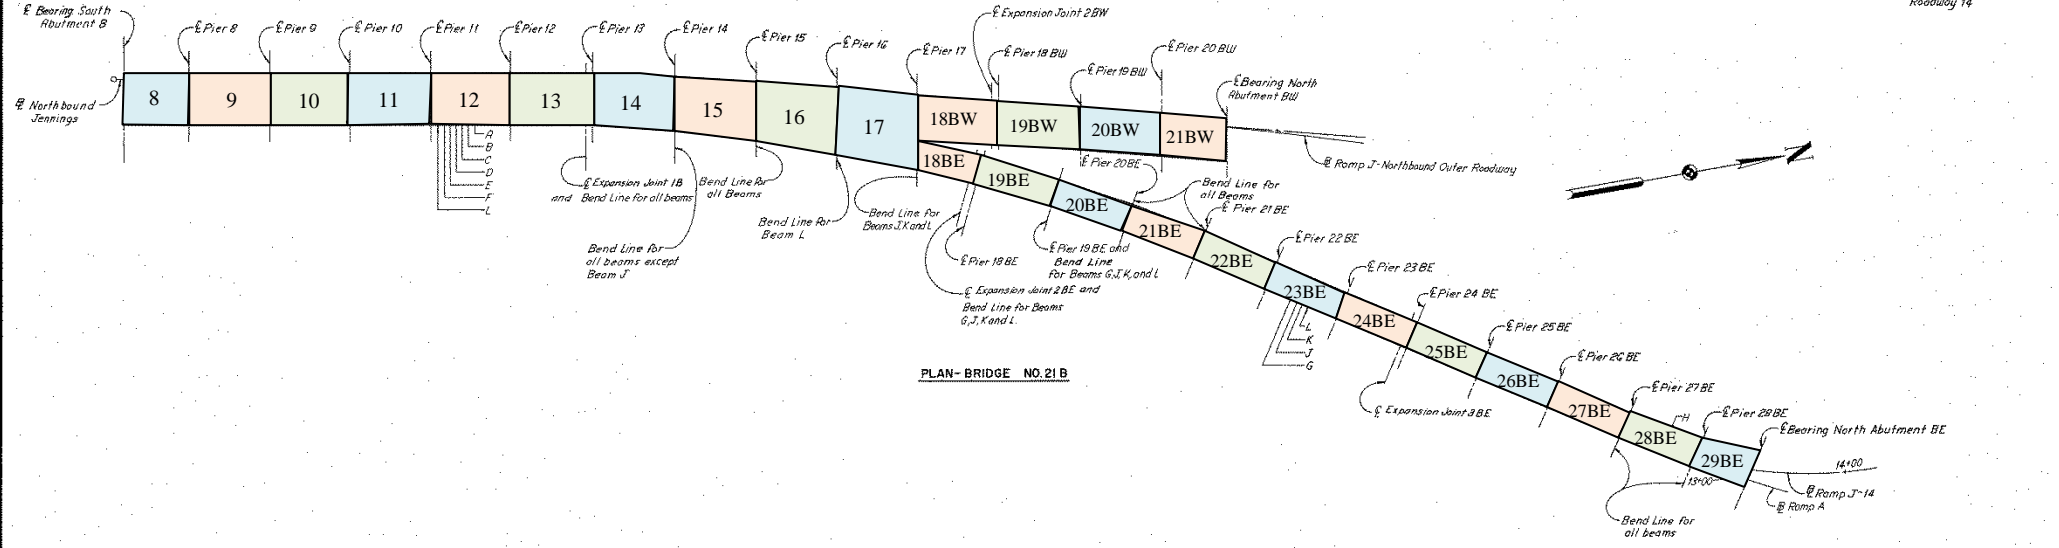

PLAN-BRIDGE NO. 21B



N.B. BRIDGE NOS. 21A & 21B

HOWARD, NEEDLES TAMMEN & BERENDOFF
 CONSULTING ENGINEERS
 KANSAS CITY CLEVELAND NEW YORK

SCHEMATIC FRAMING PLAN

NORTHBOUND I-71 OVER NORTHBOUND JENNINGS,
 AND NORTHBOUND JENNINGS


BR. NO. CUY-71-1789R STA. 917+10.09
 STA. 935+21.25

CLEVELAND	CUYAHOGA COUNTY	OHIO
DRAWN: J.M.C.	CHECKED: J.M.C.	REVIEWED: J.M.C.
DATE: 12-17-66	DATE: 12-13-66	DATE: 12-22-66

SHEET 408

I-71/SR 176 Double Decked Bridge (SR 176 Lower Deck)
2012 In-Depth Bridge Inspection


APPENDIX E

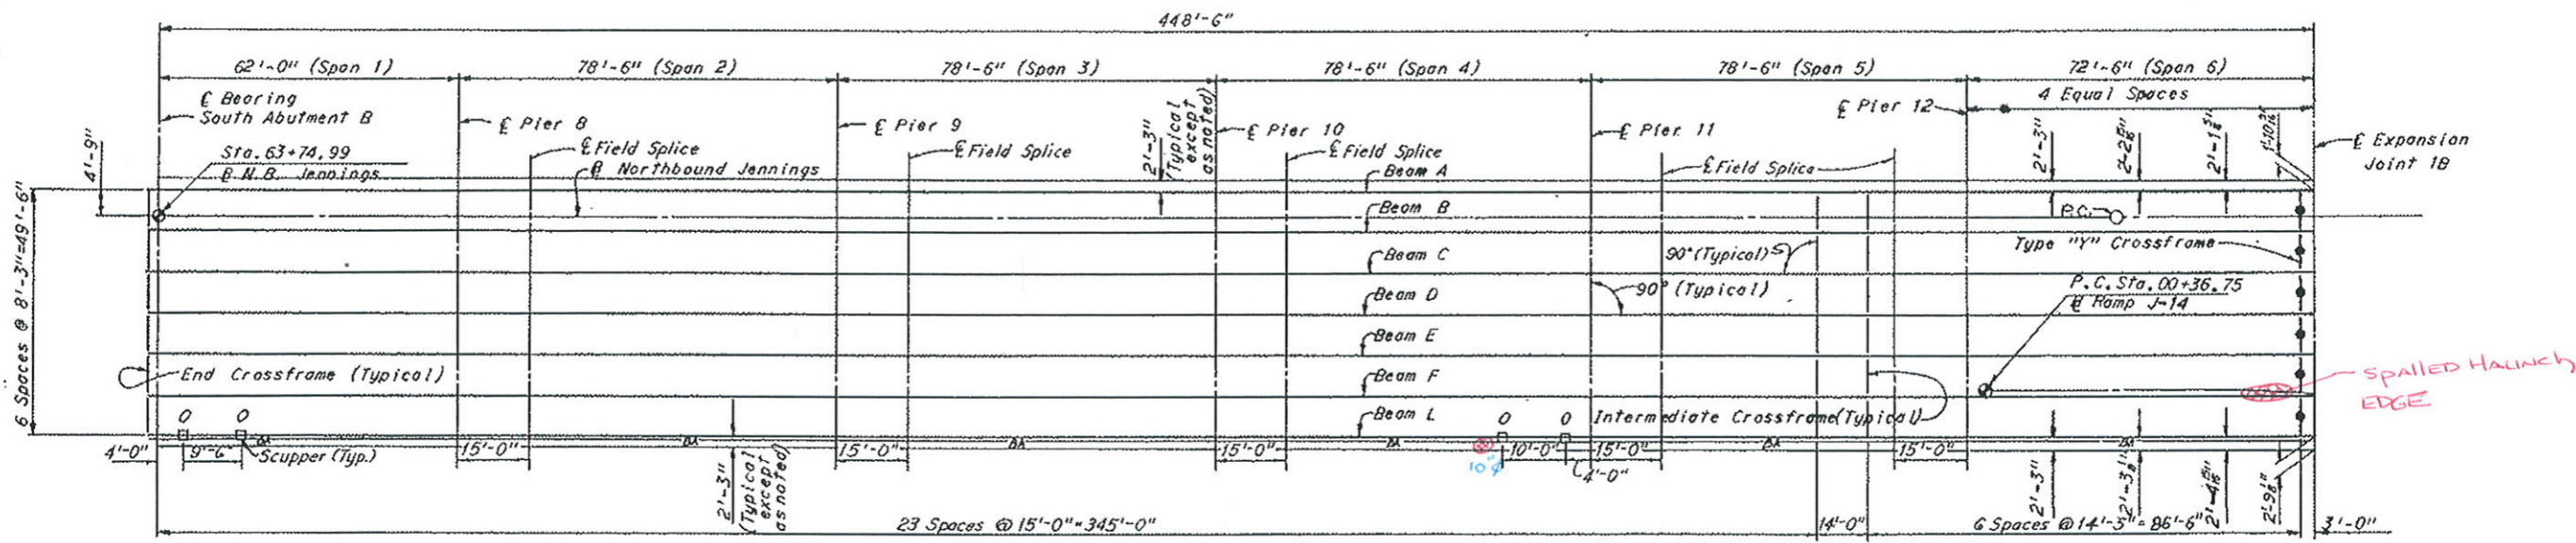

—A— Denotes Bulb Angle Gutter

FRAMING PLAN

- ⊗ Spalled Area
- ⊕ Delamination
- HC = Honeycomb
- LB = Loose Bolt

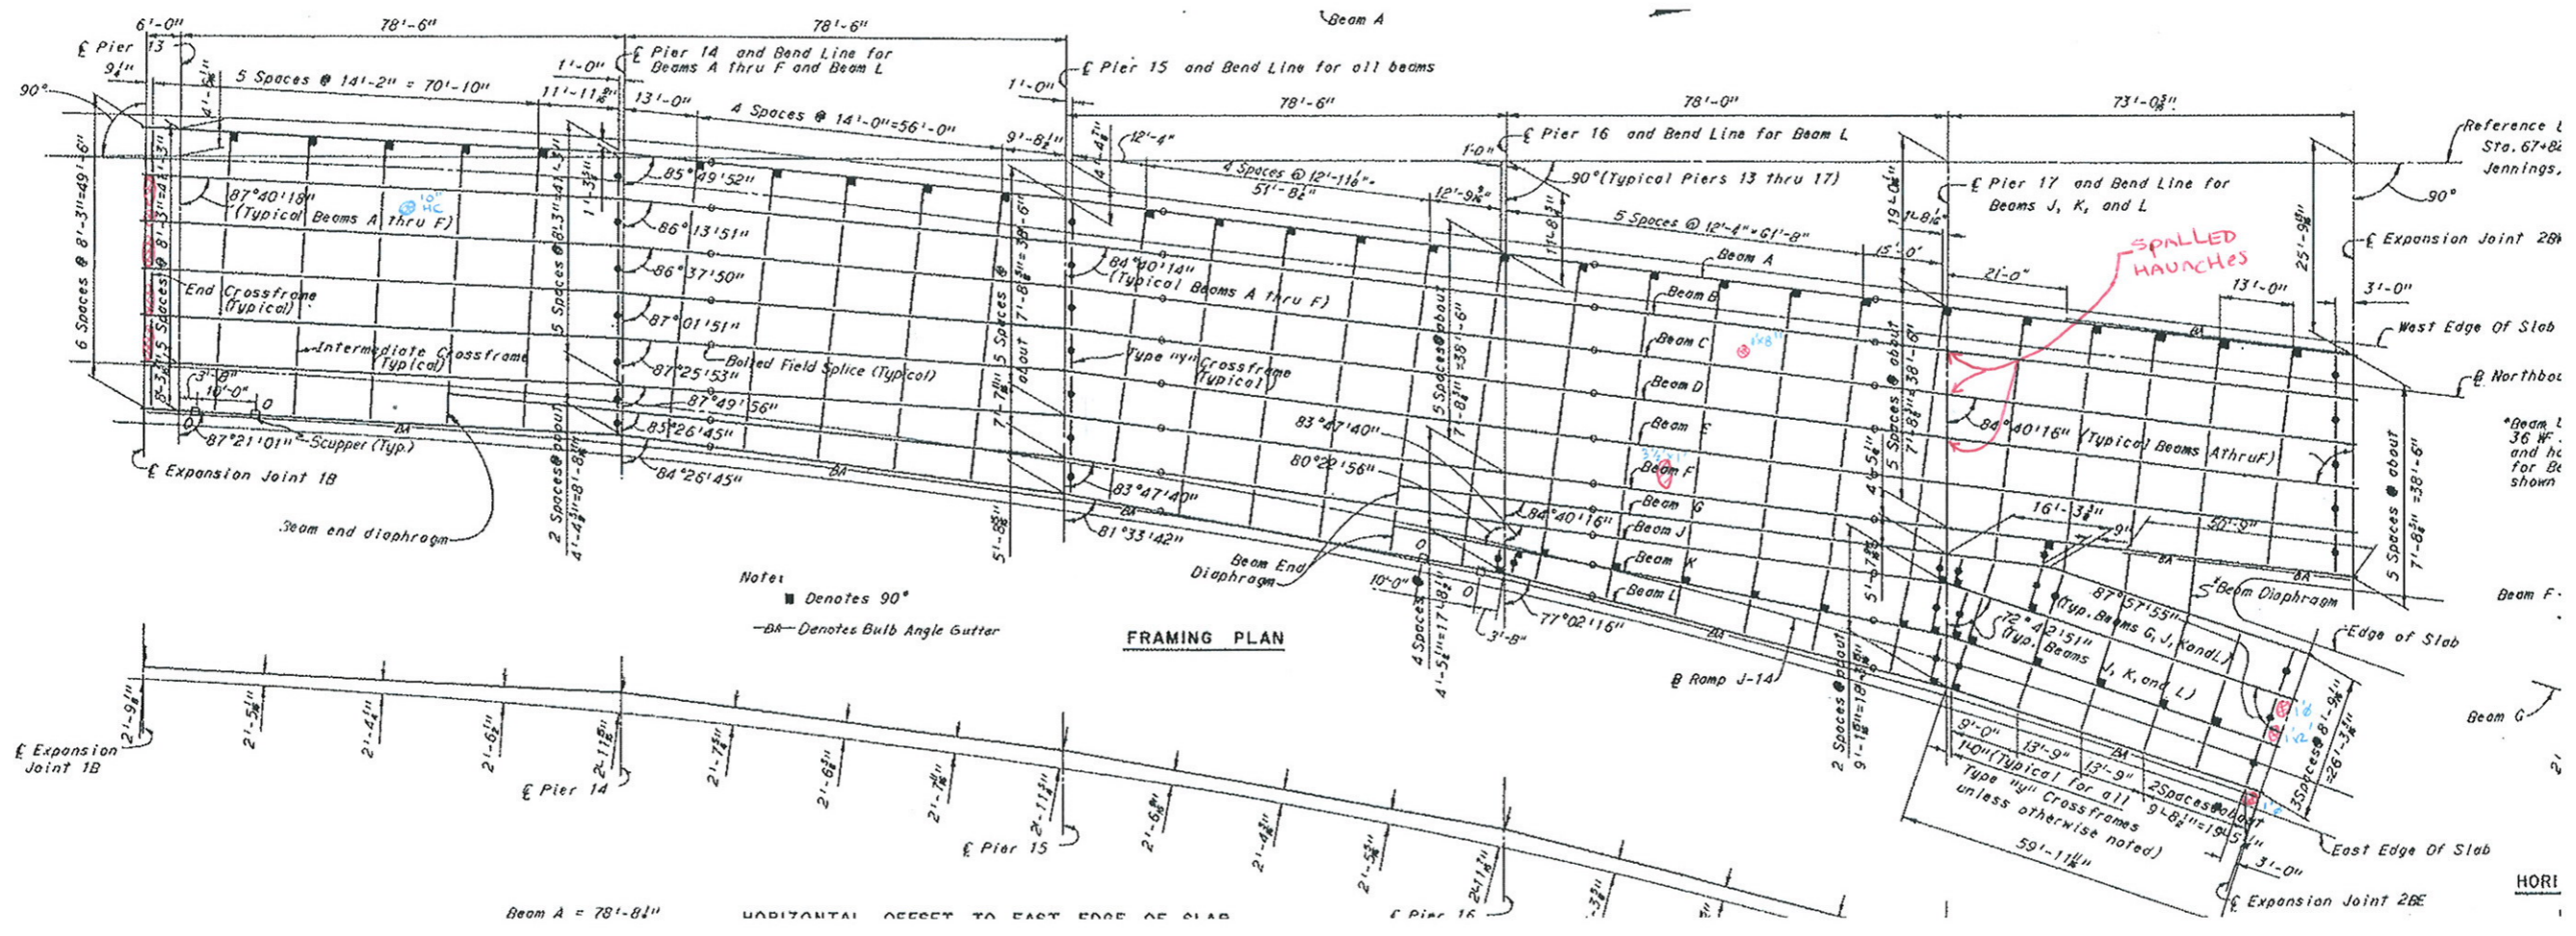


Notes:
 ■ Denotes 90°
 -BA- Denotes Bulb Angle Gutter

FRAMING PLAN

Beam A = 78'-8 1/2"
 HORIZONTAL OFFSET TO EAST EDGE OF SLAB

HORI

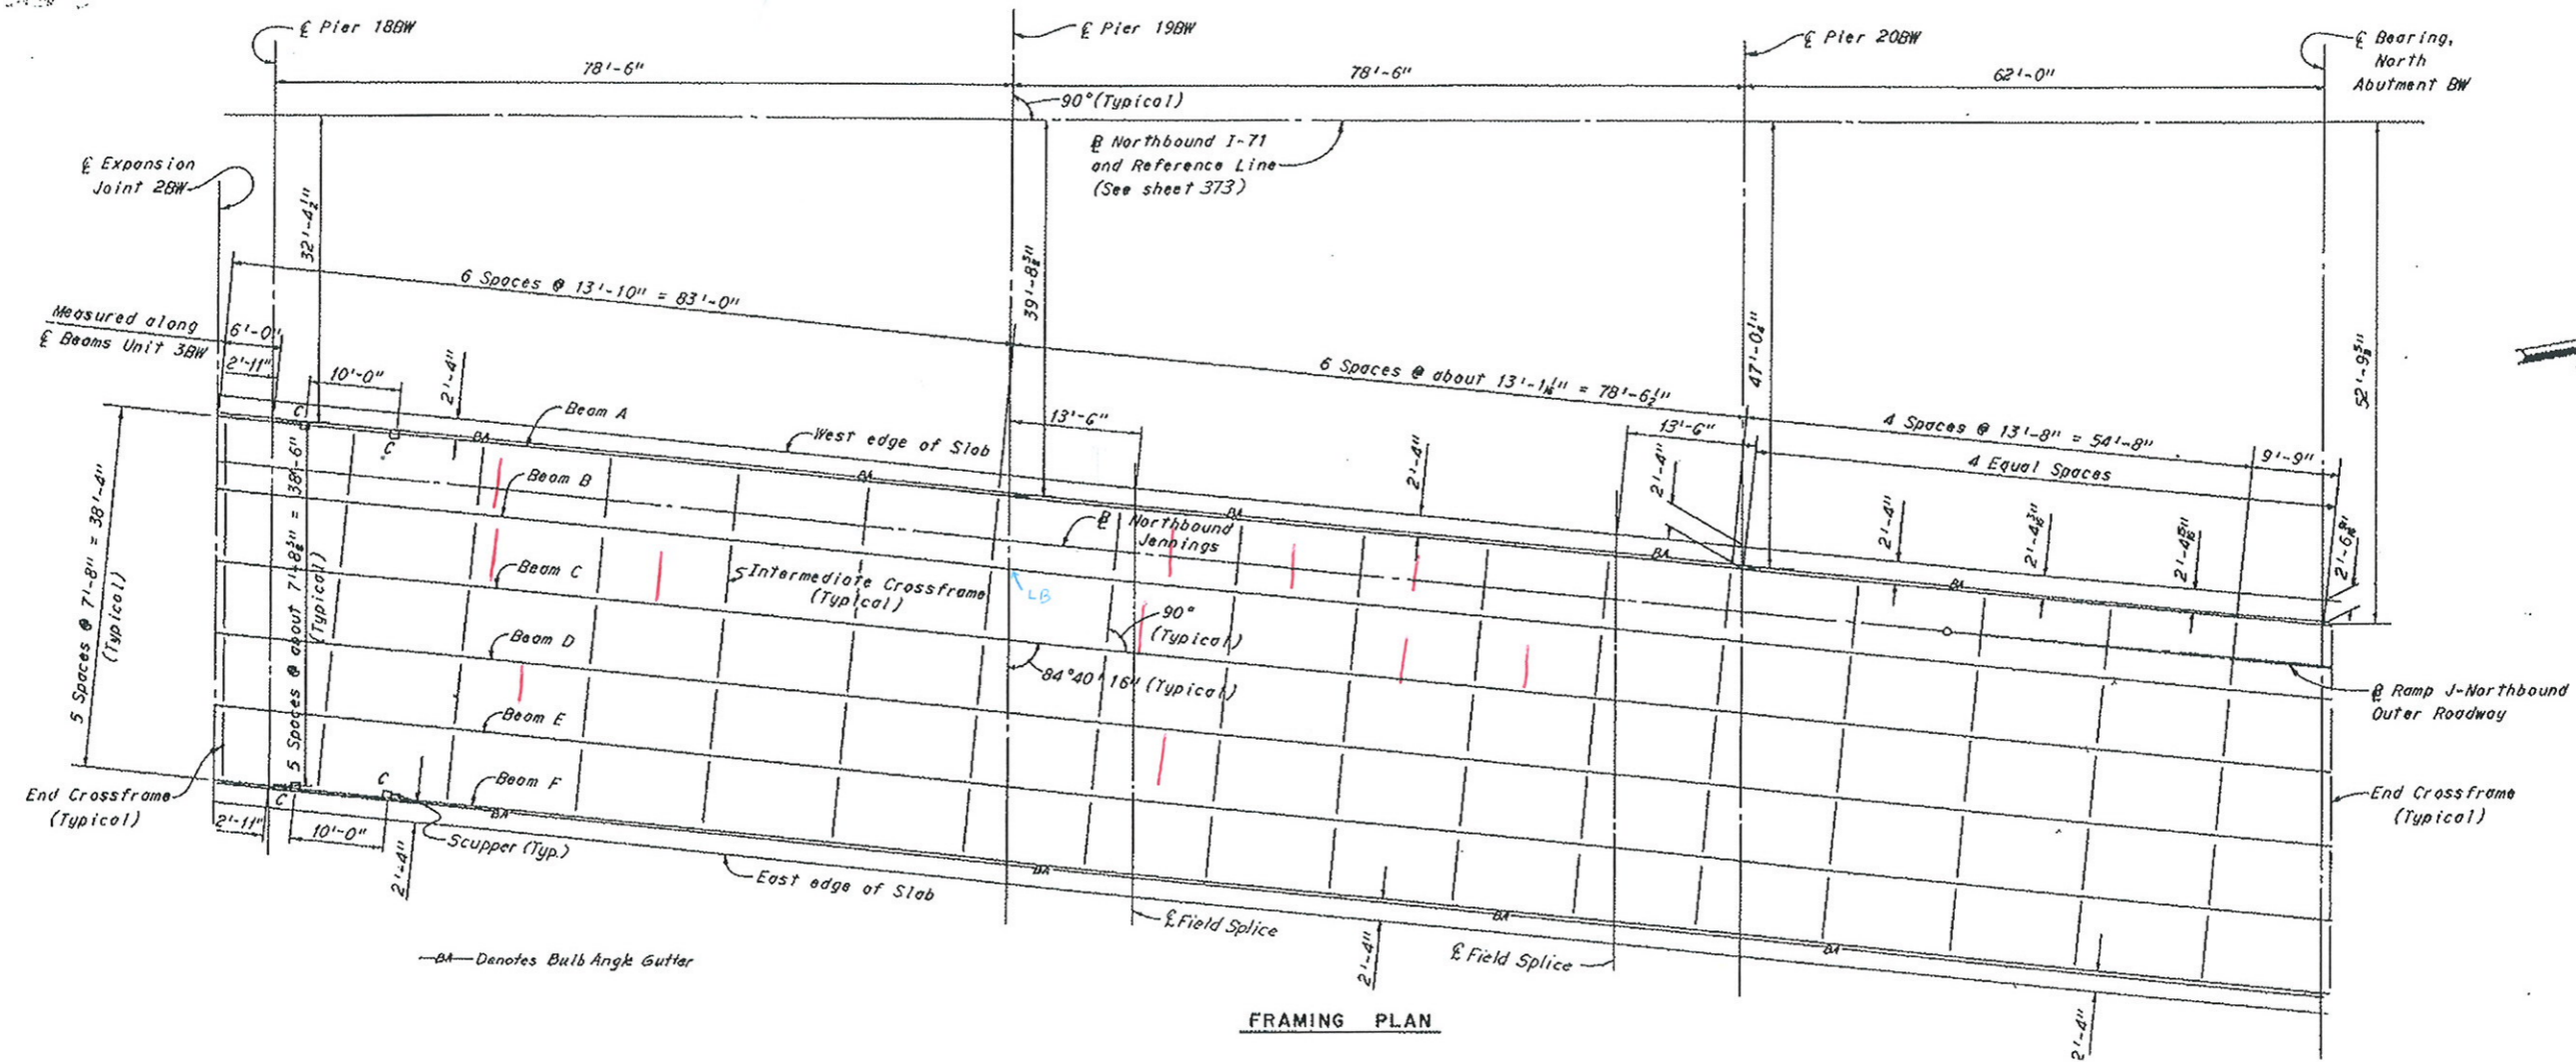

FRAMING PLAN

LB = LOOSE BOLT


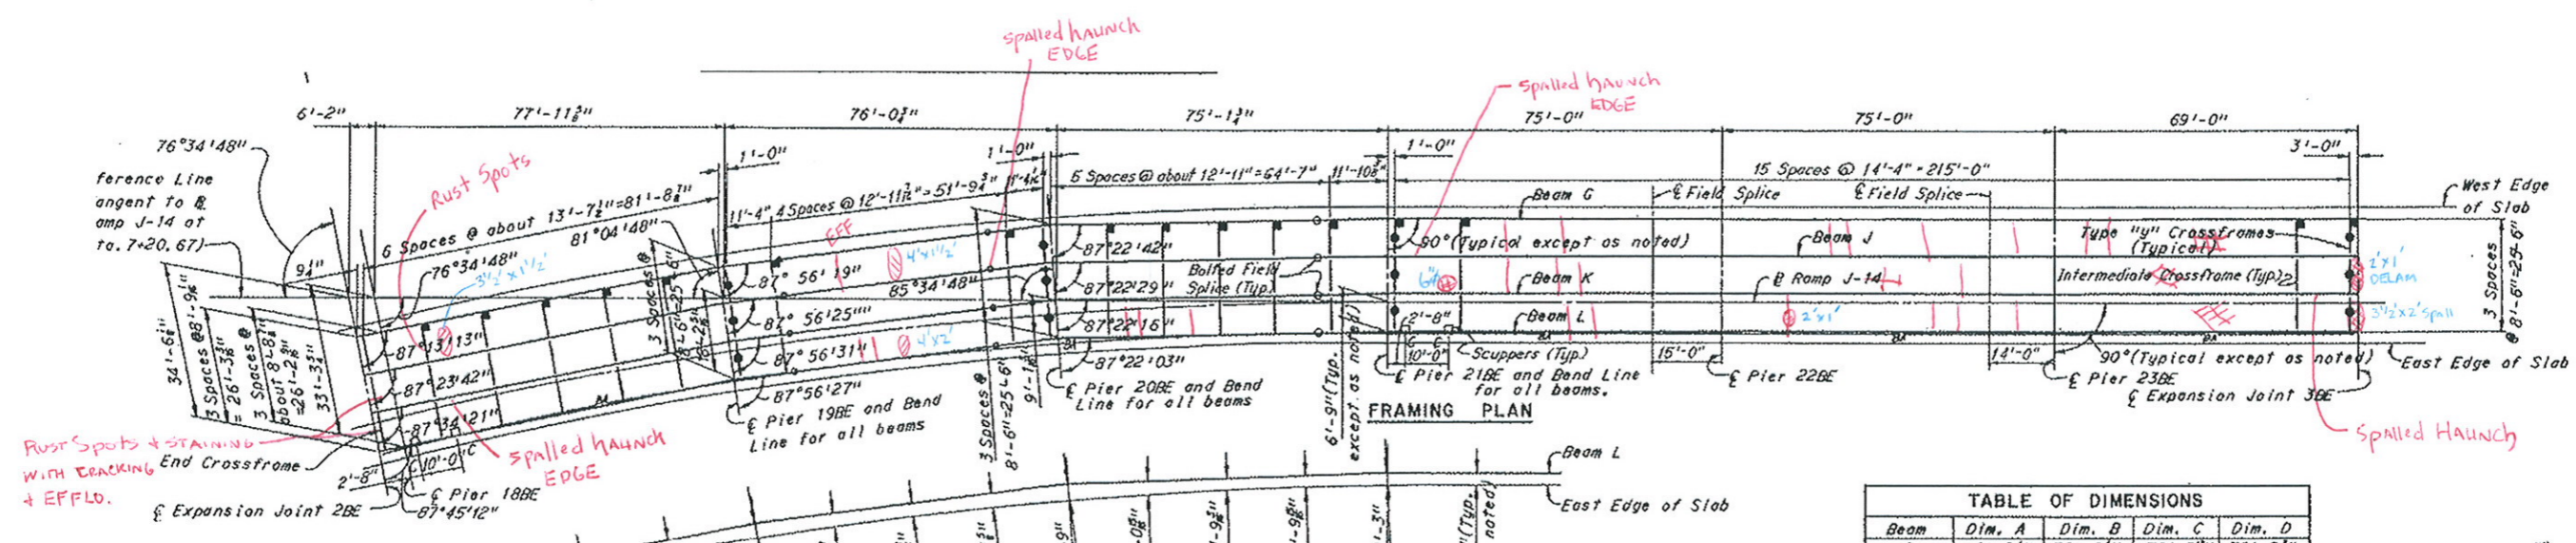


TABLE OF DIMENSIONS

Beam	Dim. A	Dim. B	Dim. C	Dim. D
Beam G	215'-0"	64'-7"	11'-10"	11'-0"
Beam J	215'-0"	64'-7"	11'-10"	11'-0"
Beam K	215'-0"	64'-7"	11'-10"	11'-0"
Beam L	215'-0"	64'-7"	11'-10"	11'-0"

HORIZONTAL OFFSETS TO WEST EDGE OF SLAB

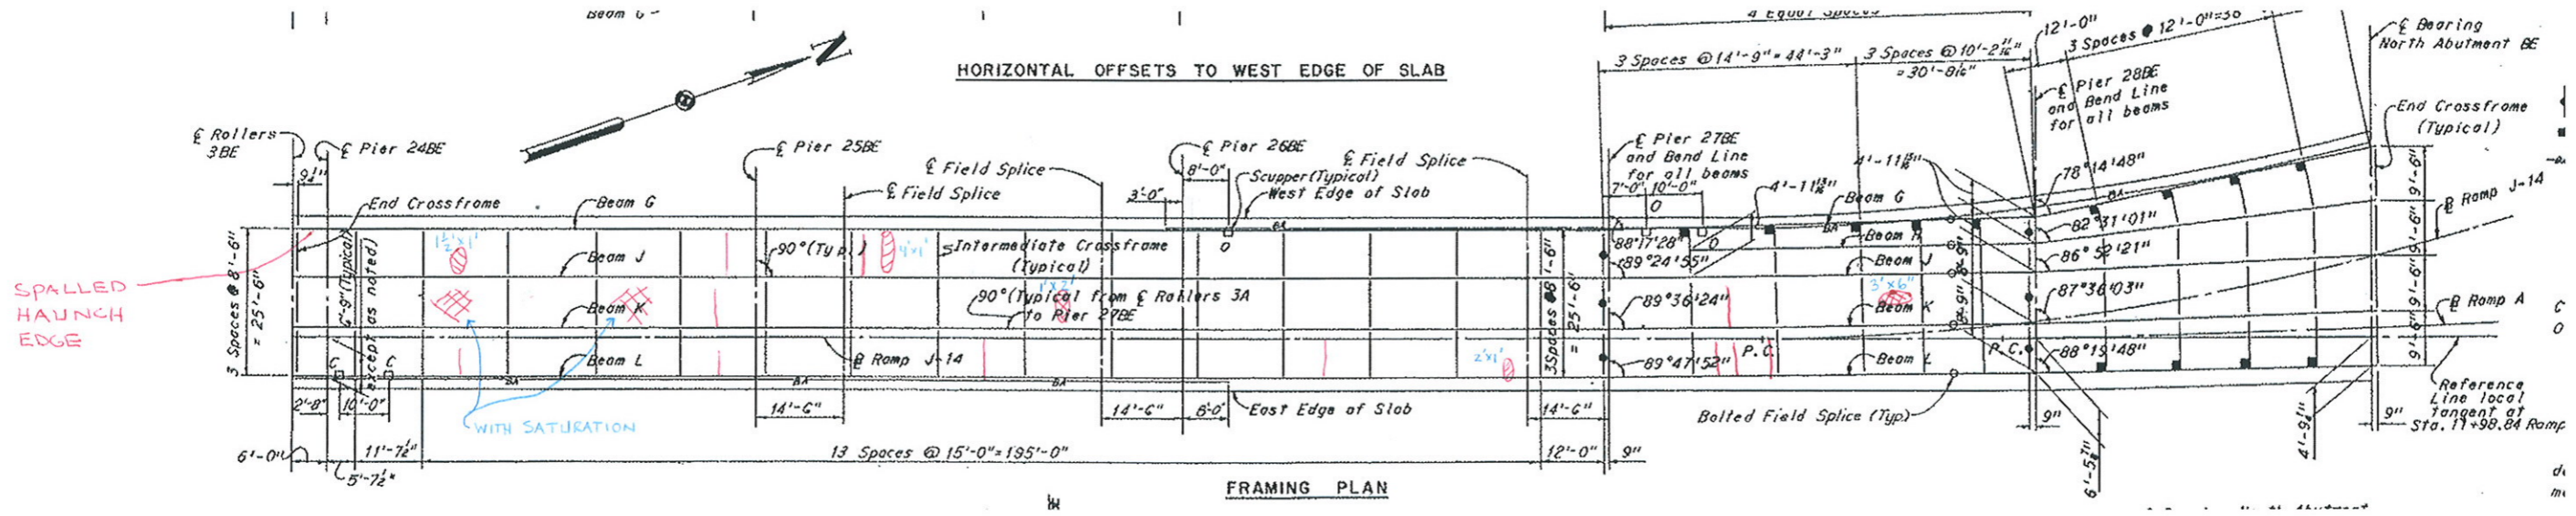

FRAMING PLAN


dm

I-71/SR 176 Double Decked Bridge (SR 176 Lower Deck)
2012 In-Depth Bridge Inspection

APPENDIX






F

CUYAHOGA COUNTY
CUY 71-17.83
CUY-176-12.76

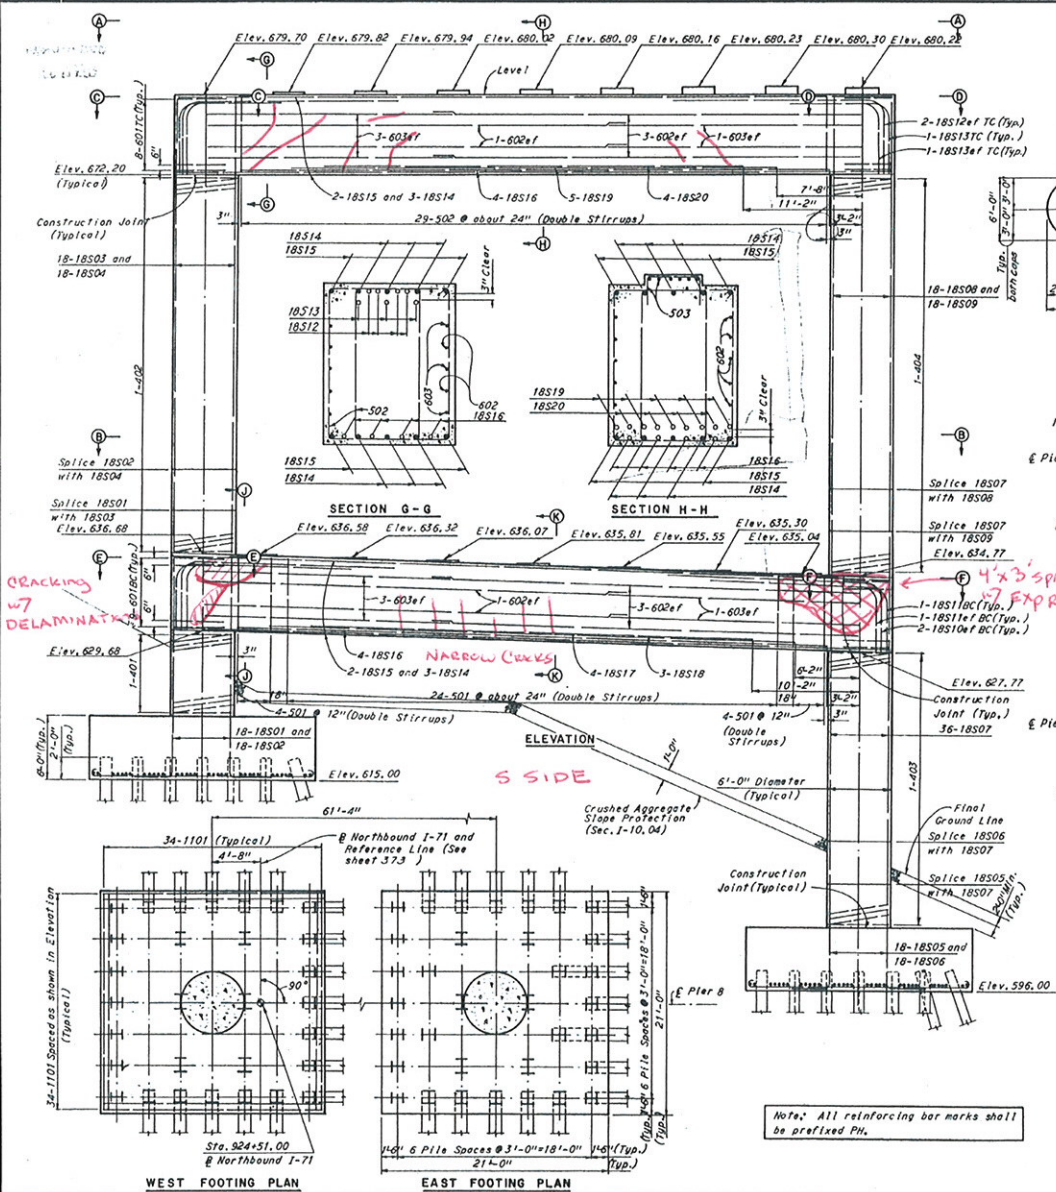

Notes: Chip or grind root to sound metal before welding roof or second side. Alternate mechanical or welded splice may be used subject to the approval of the Director.

DETAIL FOR FIELD WELDING OF NO. 18S REINFORCING BARS

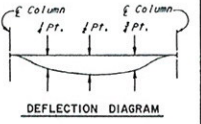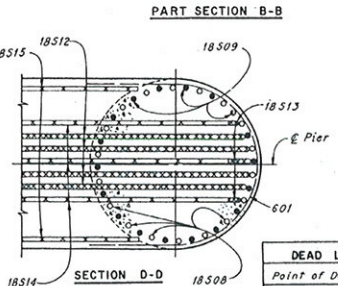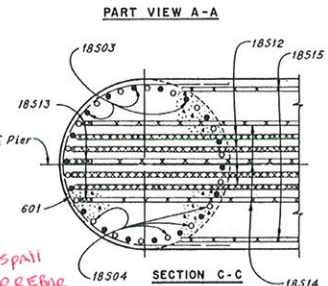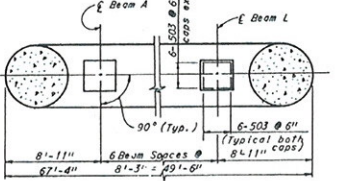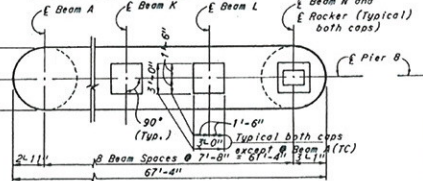

DEAD LOAD DEFLECTION TABLE

Point of Deflection	I.P.T.	I.P.T.	I.P.T.
Initial - Cap Beam Only	1/4"	1/4"	1/4"
Initial - Total Structure	1/4"	1/4"	1/4"
Ultimate - Total Structure	1/4"	1/4"	1/4"

Notes: Pier construction, Piers 8 thru 16, shall be complete prior to the erection of any superstructure steel. Cap beams shall be cambered for ultimate dead load deflections. Bearing pads shall be set so that after initial total structure deflection the designated bearing pad elevations are reached. The above table is typical for top and bottom cap beams, Piers 8 thru 13.

Notes: All piles shall be 12BPS3 steel bearing piles. The following abbreviations are used: ef = each face, BC = bottom cap, TC = top cap. For additional notes see sheet 385.



H.K.T. BRIDGE NOS. 21A & 21B
HOWARD, NEEDLES, TAMMEN & BERGENDOFF
CONSULTING ENGINEERS
KANSAS CITY CLEVELAND NEW YORK

PIER 8
NORTHBOUND I-71 OVER NORTHBOUND JENNINGS,
AND NORTHBOUND JENNINGS
BR. NO. CUY-71-1789R STA. 917+10.09
STA. 935+21.25
CLEVELAND CUYAHOGA COUNTY OHIO
DRAWN BY DATE CHECKED BY DATE REVISION BY DATE

Note: All reinforcing bar marks shall be prefixed PH.

CUYAHOGA COUNTY
 CUY 71-17-83
 CUY-178-1576

APPROVED FOR CONSTRUCTION
 DATE: _____
 PROJECT: _____

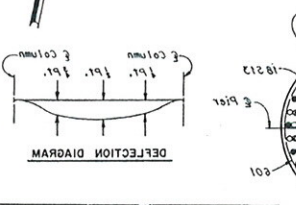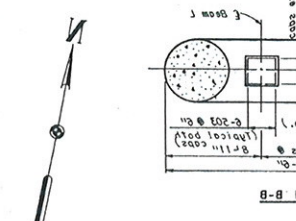










DEAD LOAD DEFLECTION TABLE

Point of Deflection	Initial - Cap Beam Only	Initial - Total Structure	Ultimate - Total Structure
Top of Pier	1/4"	1/4"	1/4"
Mid Pier	1/4"	1/4"	1/4"
Bottom of Pier	1/4"	1/4"	1/4"

Notes:
 1. All piers shall be 15#22 steel bearing plates.
 2. The following observations are made:
 a. et = each face
 b. c = bottom cap
 c. t = top cap
 For additional notes see sheet 387.











PIER 8
 NORTHBOUND I-75 OVER NORTHBOUND RAMPWAYS
 AND NORTHBOUND RAMPWAYS
 STA 917+10.00
 BR. NO. CUY-71-1789
 STA 917+10.00
 STA 933+51.58
 CLEVELAND, OHIO
 CUYAHOGA COUNTY
 PROJECT 383

DESIGNED BY: _____
 CHECKED BY: _____
 DATE: _____

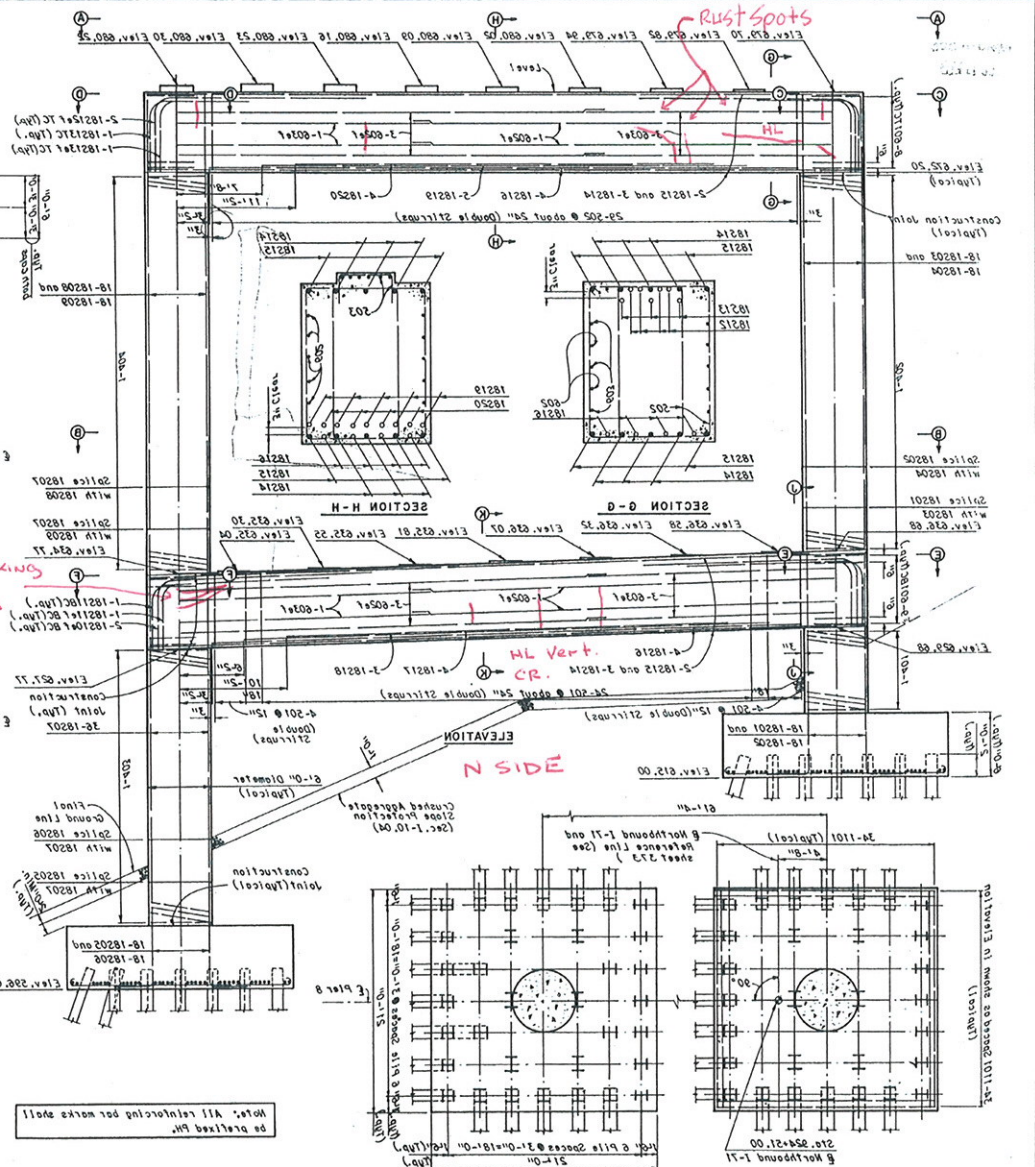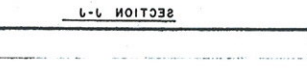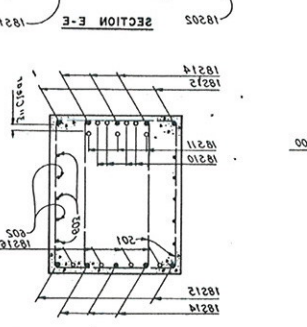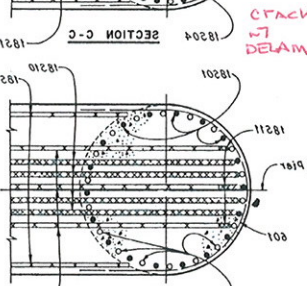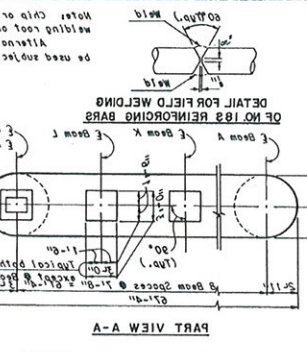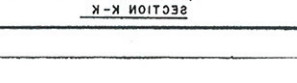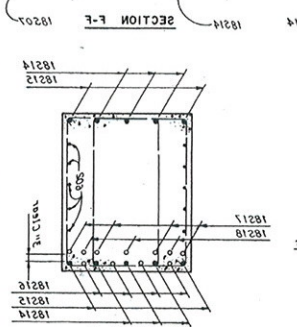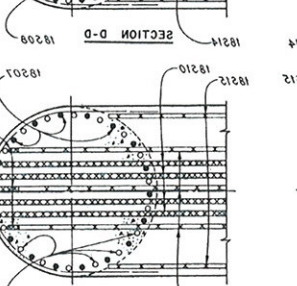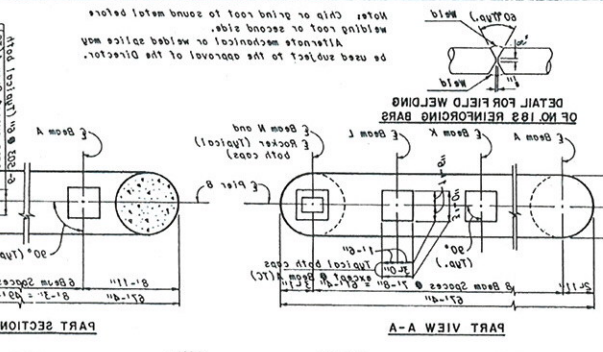

Notes:
 1. All reinforcing bar marks shall be placed per _____

Notes:
Special care shall be taken when placing reinforcing steel so as not to interfere with anchor bolt setting.

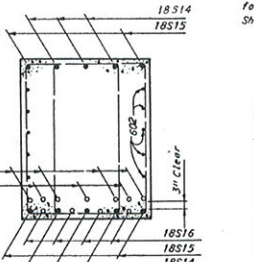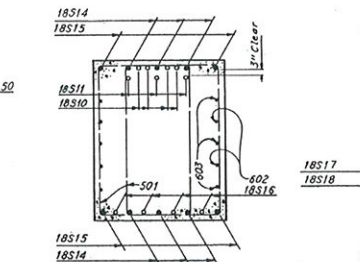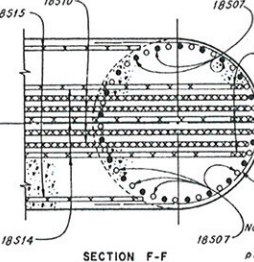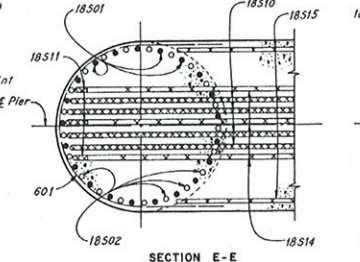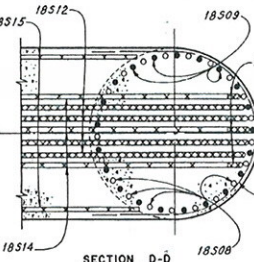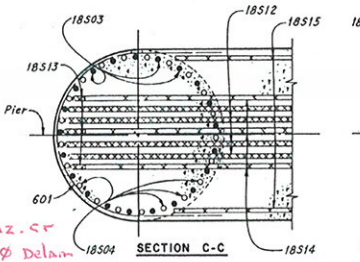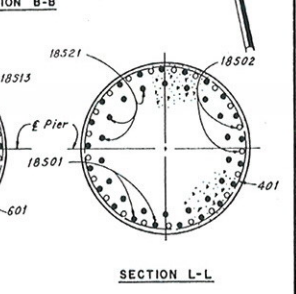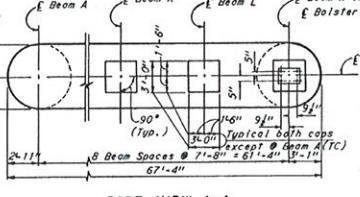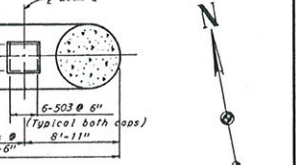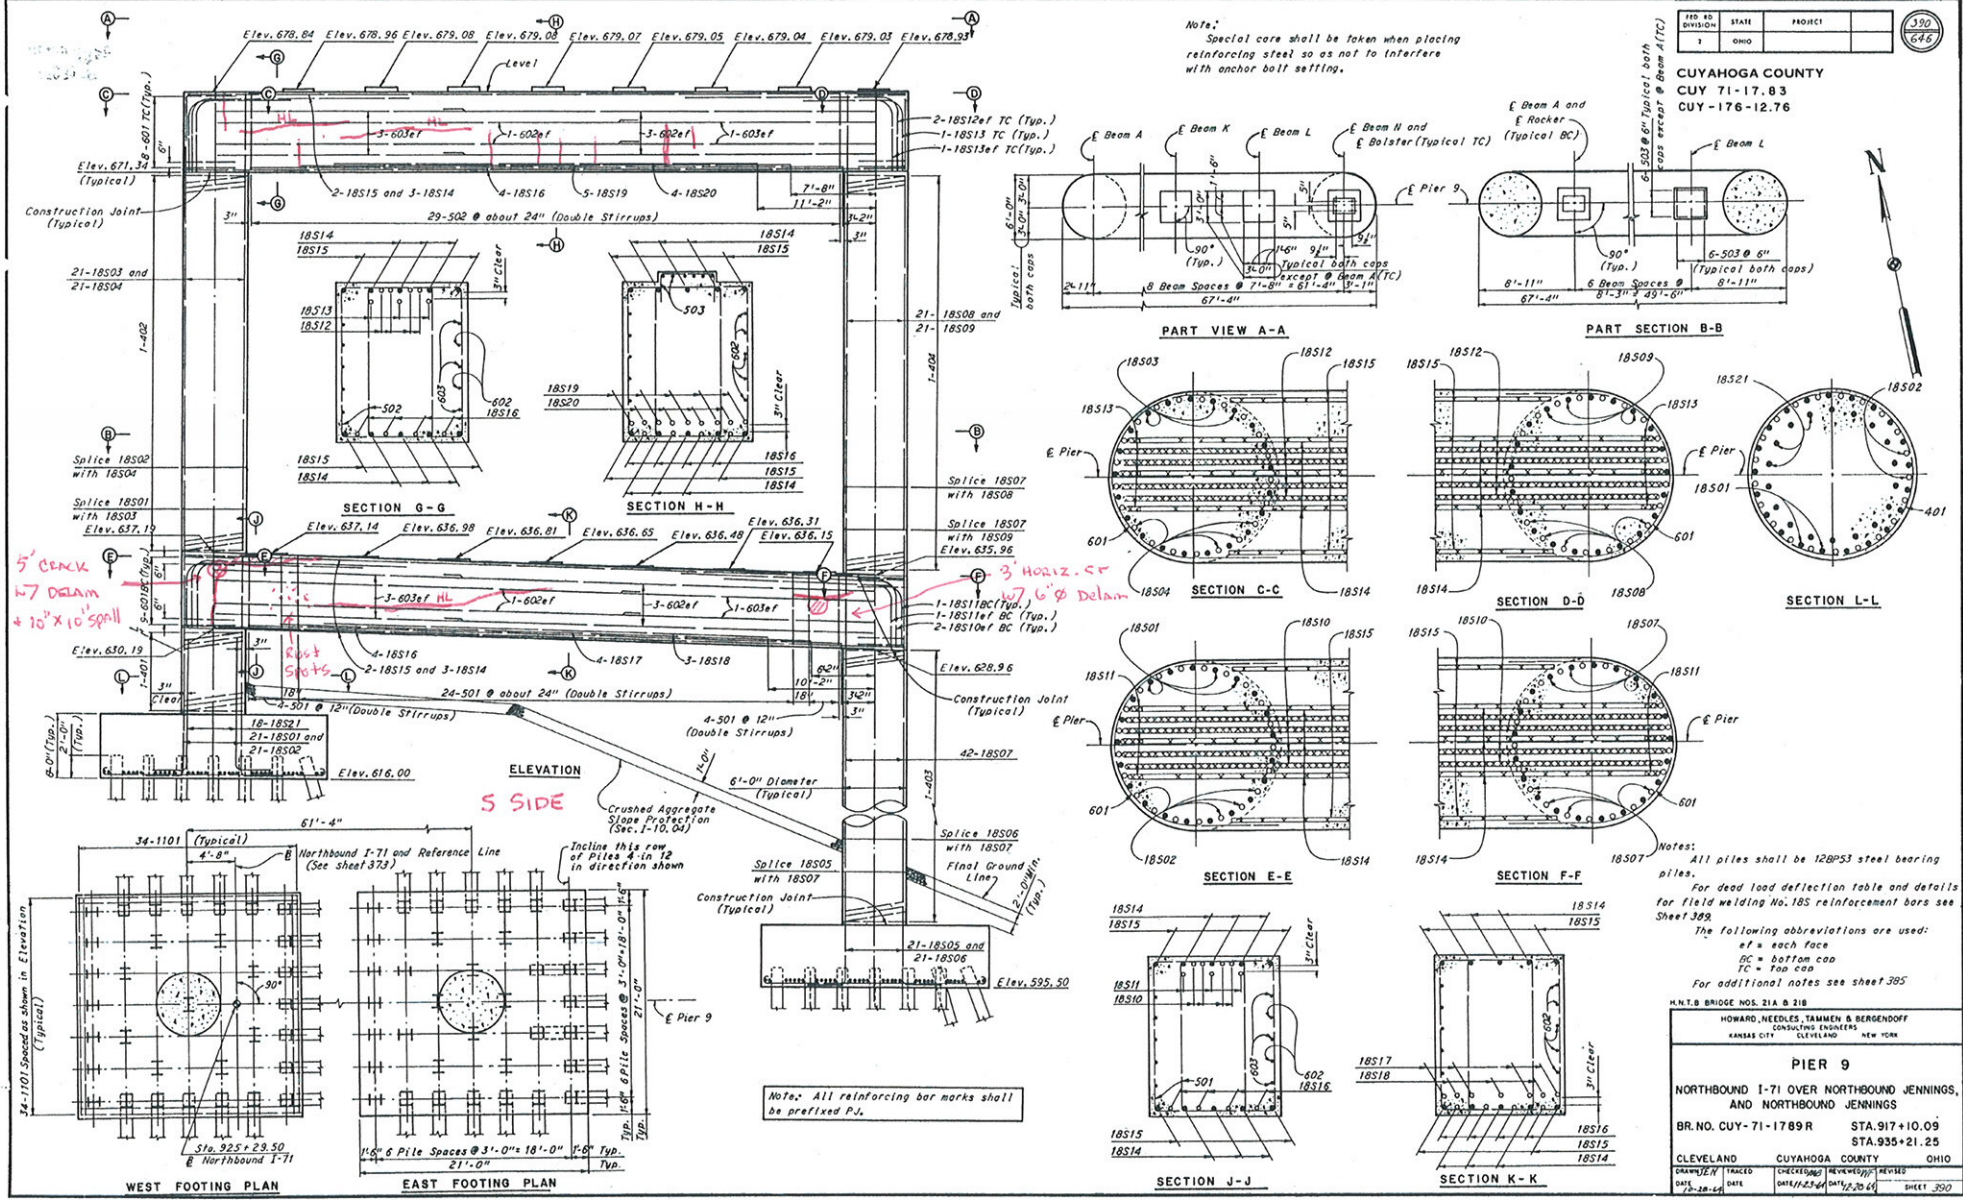

Notes:
All piles shall be 12BPS3 steel bearing piles.
For dead load deflection table and details for field welding No. 18S reinforcement bars see Sheet 389.
The following abbreviations are used:
ef = each face
BC = bottom cap
TC = top cap
For additional notes see sheet 395

M.N.T.S BRIDGE NOS. 21A & 21B

HOWARD, NEEDLES, TAMMEN & BERGENDOFF
CONSULTING ENGINEERS
CLEVELAND NEW YORK

PIER 9

NORTHBOUND 1-71 OVER NORTHBOUND JENNINGS,
AND NORTHBOUND JENNINGS

BR. NO. CUY-71-17899 STA. 917+10.09
STA. 935+21.25

CLEVELAND CUYAHOGA COUNTY OHIO

DATE 7-28-64 DATE 12-24-64 DATE 12-20-64

DRW. J.E.H. TRACED BY J.E.H. CHECKED BY J.E.H. DESIGNED BY J.E.H.

SHEET 390

Note: All reinforcing bar marks shall be prefixed P.V.

5" CONC. 1/2" DEAM + 10" X 10" SPALL

3 Horiz. CR 1/2" 6" DELAM

ELEVATION
S SIDE

WEST FOOTING PLAN













EAST FOOTING PLAN

SECTION J-J

SECTION K-K

NO. 300	PROJECT
3	CUYAHOGA COUNTY
	CUY 11-1783
	CUY-118-1578

Notes:
 Special care shall be taken when placing
 reinforcing steel so as not to interfere
 with anchor bolt setting.

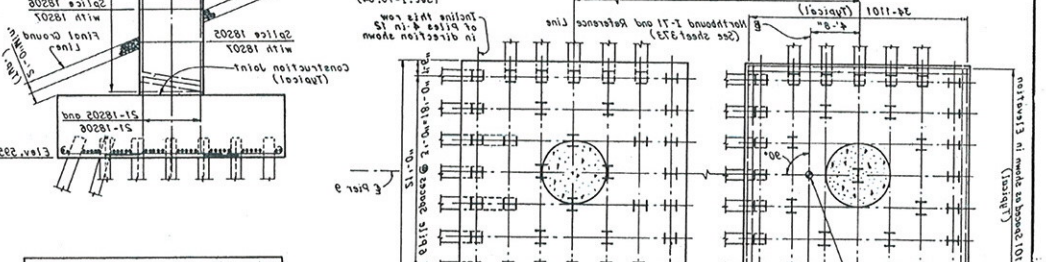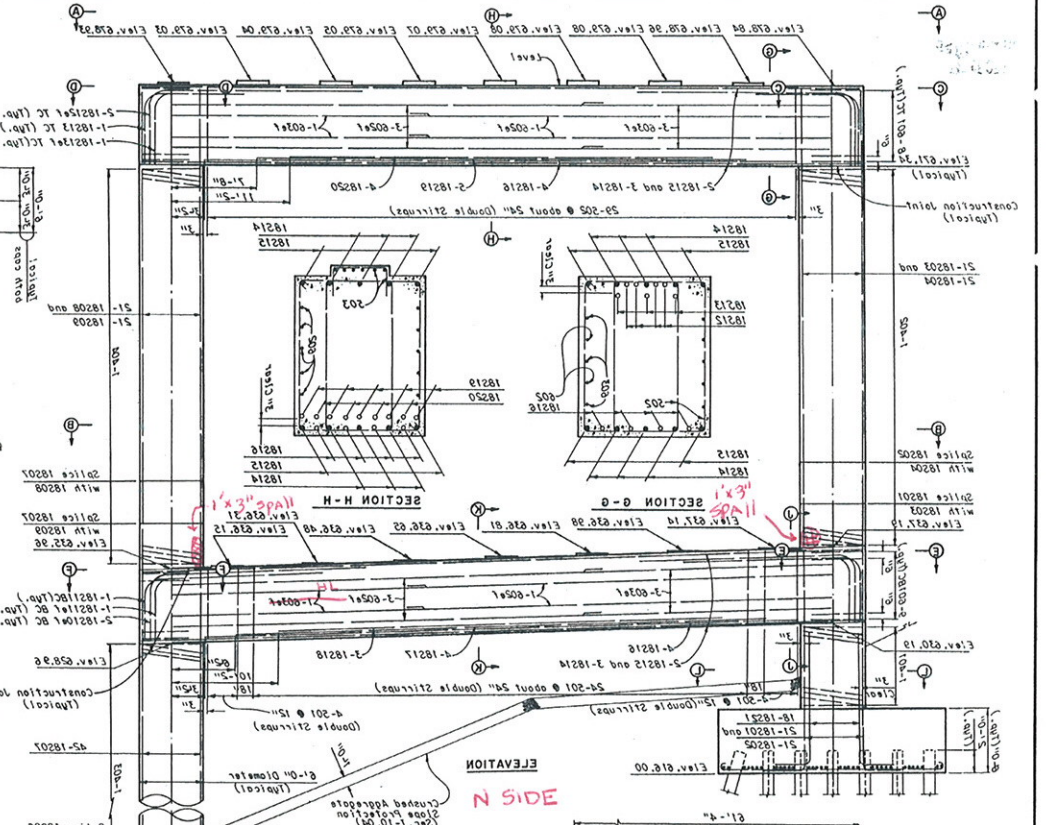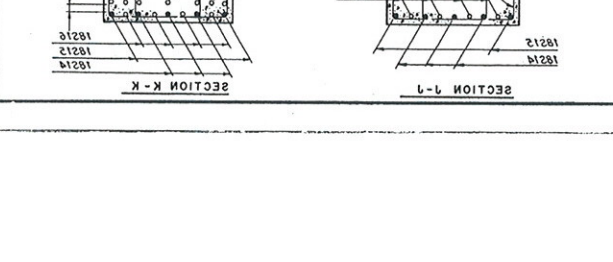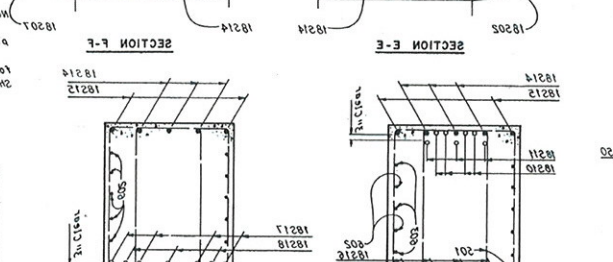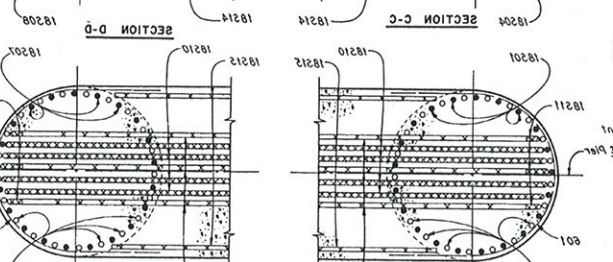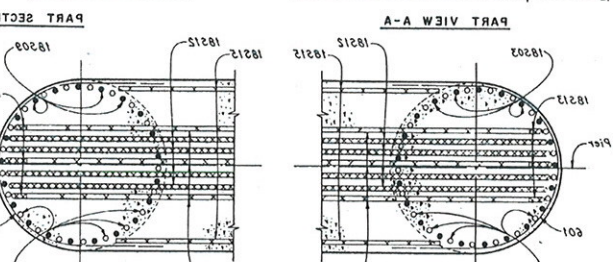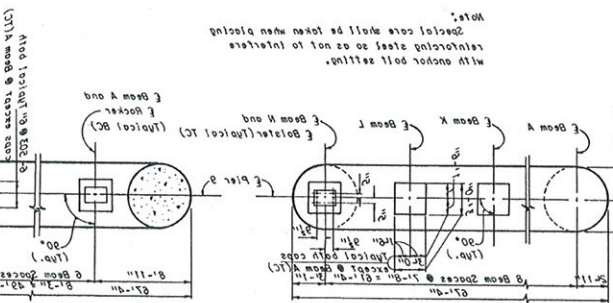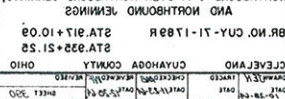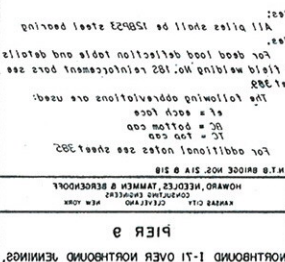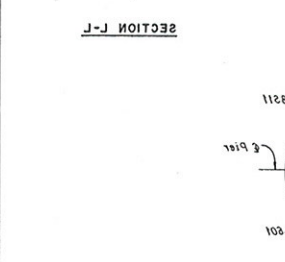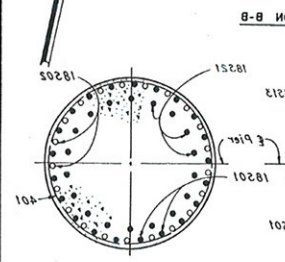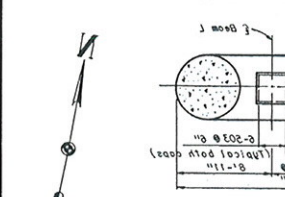









Notes:
 All sizes shall be 15823 steel bearing
 bars.
 For load deflection table and details
 for field welding No. 182 reinforcement bars see
 sheet 302.
 The following observations are noted:
 1. All sizes shall be 15823 steel bearing
 bars.
 2. All sizes shall be 15823 steel bearing
 bars.
 3. All sizes shall be 15823 steel bearing
 bars.

Notes:
 All reinforcing bar marks shall
 be marked on
 the pier.

PIER 3
 NORTHBOUND I-71 OVER NORTHBOUND JENNINGS
 AND NORTHBOUND JENNINGS
 BR. NO. CUY-11-1789 STA 917+10.00
 STA 923+51.55
 CUYAHOGA COUNTY
 CLEVELAND
 DATE: 11/17/89
 DRAWN BY: [Signature]
 CHECKED BY: [Signature]
 IN CHARGE: [Signature]

CUYAHOGA COUNTY
 CUY 71-17.83
 CUY-176-12.76

Note:
 Special care shall be taken when placing reinforcing steel so as not to interfere with anchor bolt setting.

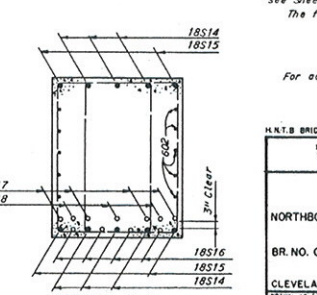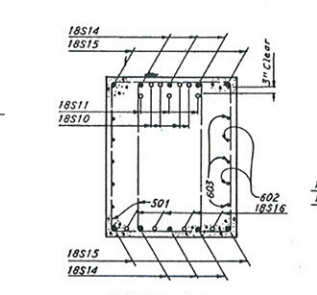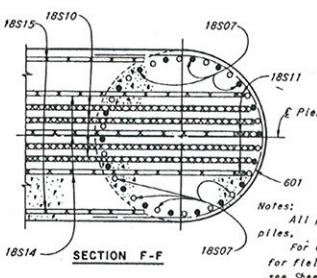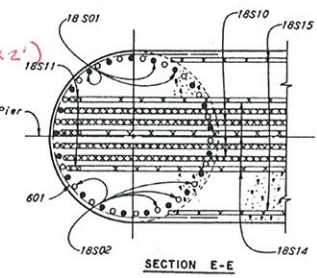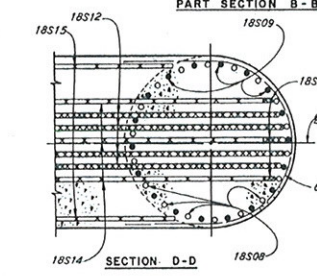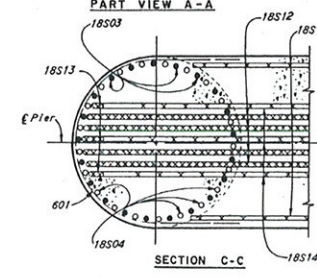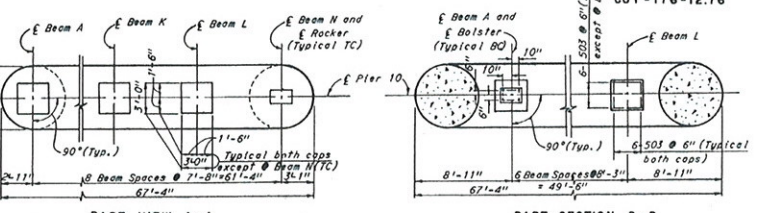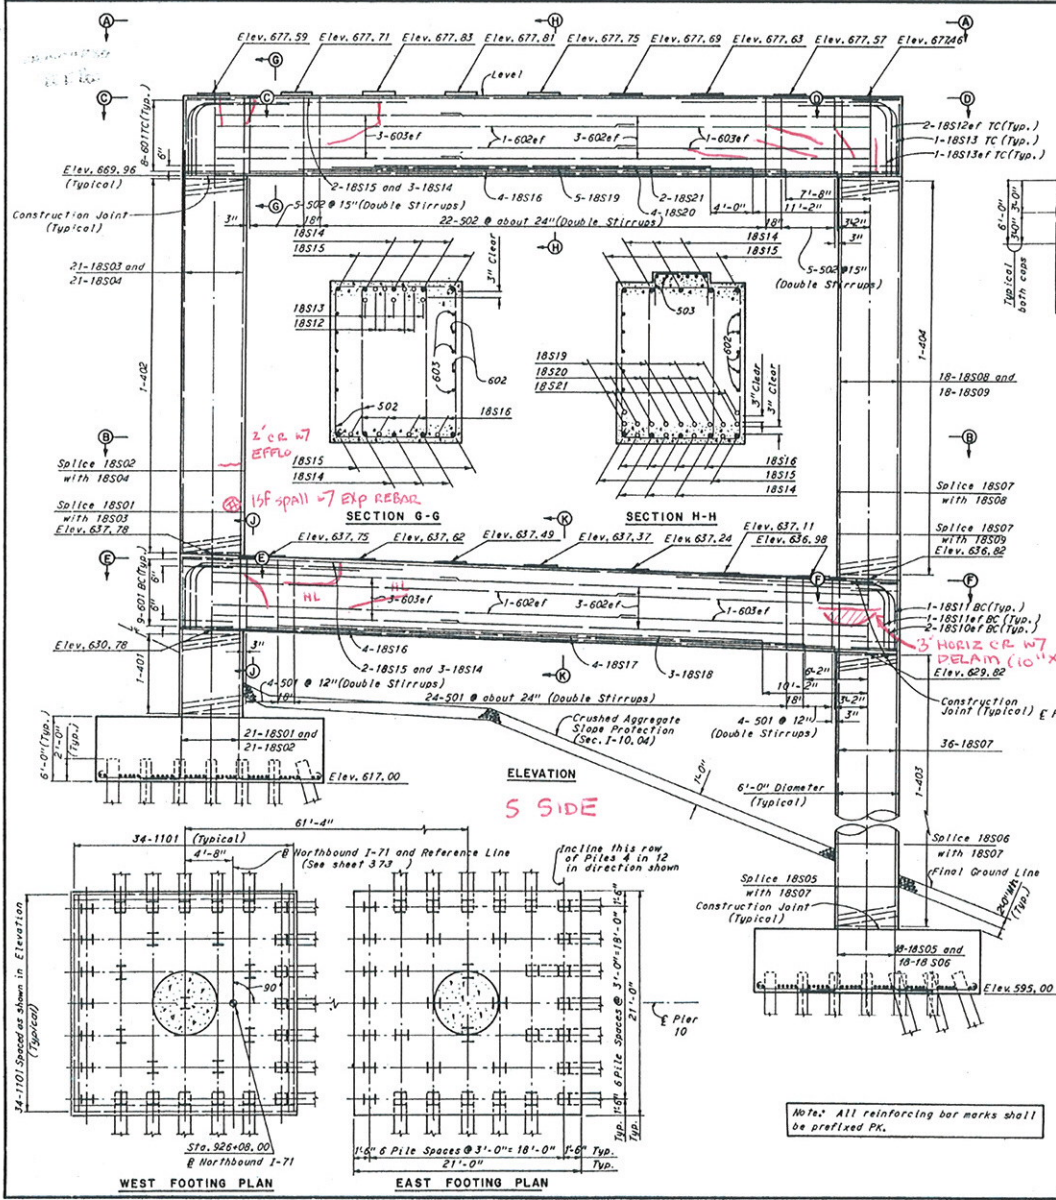

Notes:
 All piles shall be 12BPS3 steel bearing piles.
 For dead load deflection table and details for field walking No. 185 reinforcement bars see Sheet 389.
 The following abbreviations are used:
 ef = each face
 BC = bottom cap
 TC = top cap
 For additional notes see Sheet 395.

H.K.T.B. BRIDGE NOS. 21A & 21B
 HOWARD, NEEDLES, TAMMEN & BERGENDOFF
 CONSULTING ENGINEERS
 CLEVELAND NEW YORK





PIER 10
 NORTHBOUND I-71 OVER NORTHBOUND JENNINGS,
 AND NORTHBOUND JENNINGS
 BR. NO. CUY-71-1789R STA. 917+10.09
 STA. 935+21.25
 CLEVELAND CUYAHOGA COUNTY OHIO

DESIGNED BY	TRACED	CHECKED BY	REVIEWED BY
DATED	DATE	DATE	DATE


SHEET 397

PROJECT	NO.	DATE	BY
CUYAHOGA COUNTY	17-18	11-83	...

CUYAHOGA COUNTY
 CUY 17-18
 CUY-17-18


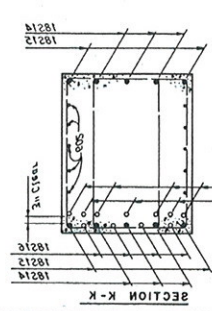
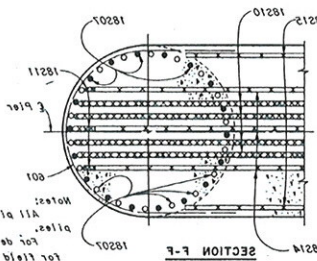
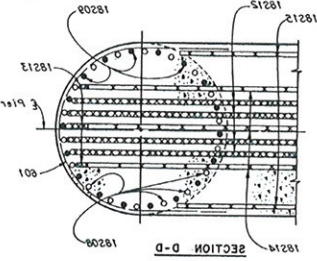
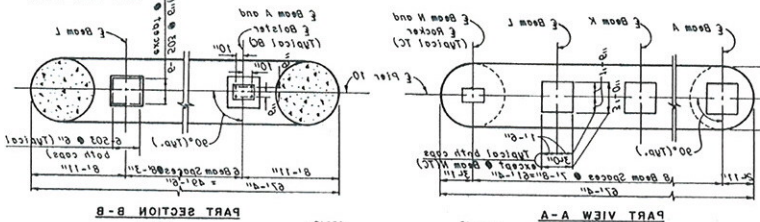


Note: All reinforcing bar marks shall be placed PK.

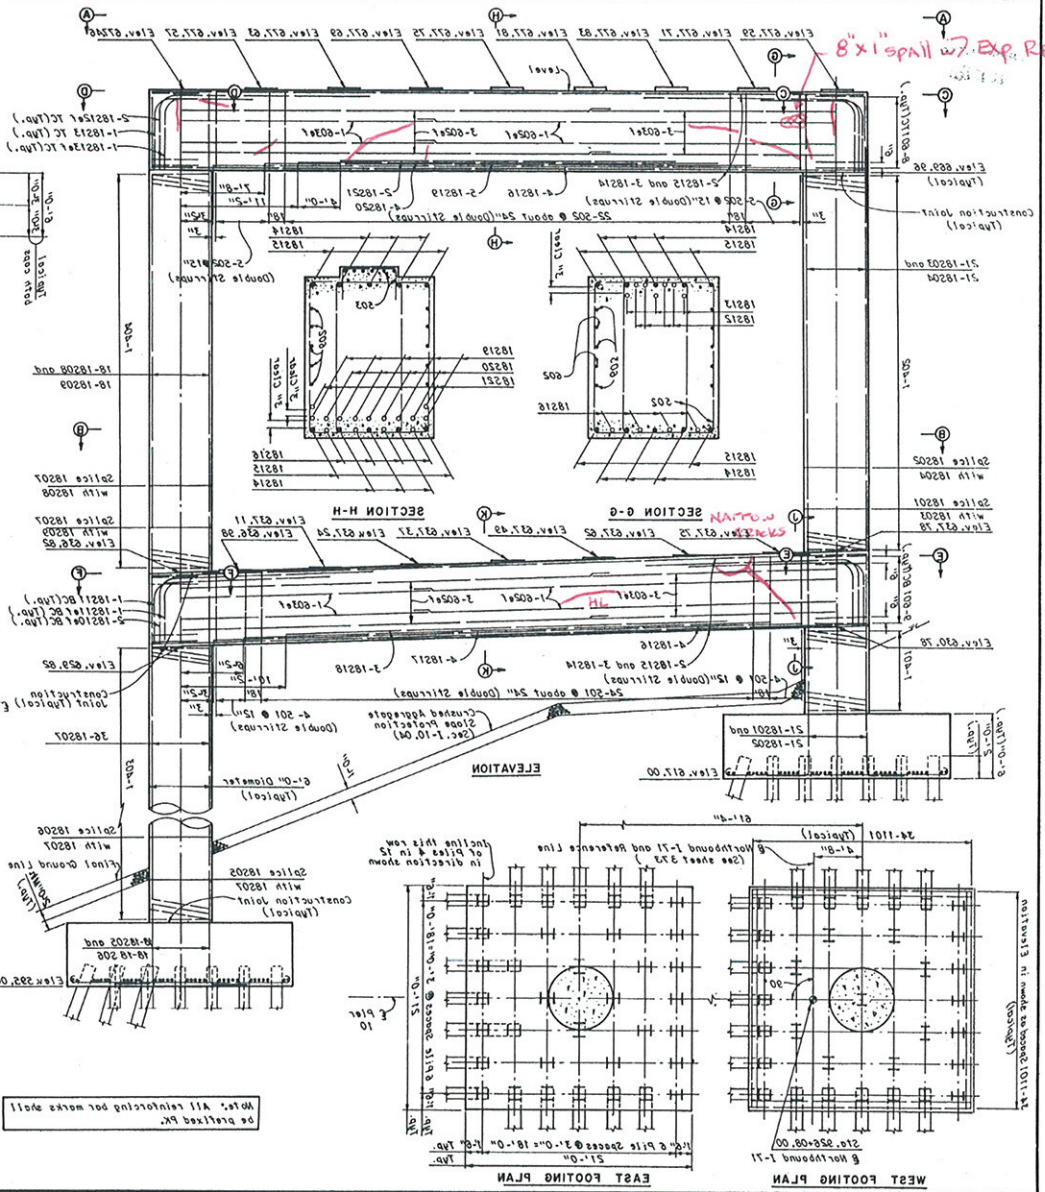

PIER 10
NORTHBOUND-11 OVER NORTHBOUND LENNINGS AND NORTHBOUND LENNINGS
BR. NO. CUY-17-1899 STA. 917+10.03 STA. 923+51.23
CLEVELAND CUYAHOGA COUNTY OHIO
DESIGNED BY: ...
CHECKED BY: ...
DATE: ...
SHEET 381

CUYAHOGA COUNTY
 CUY 71-17.83
 CUY-176-12.76

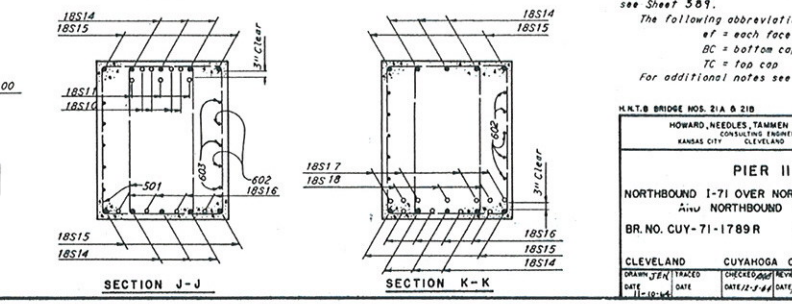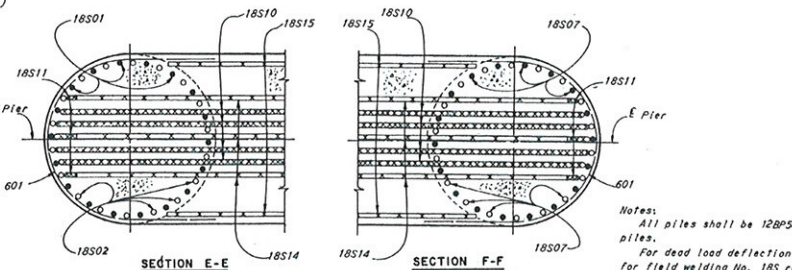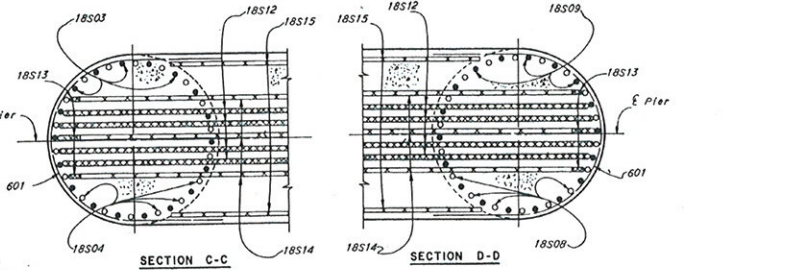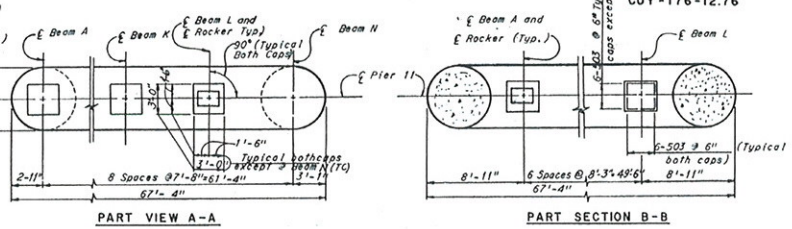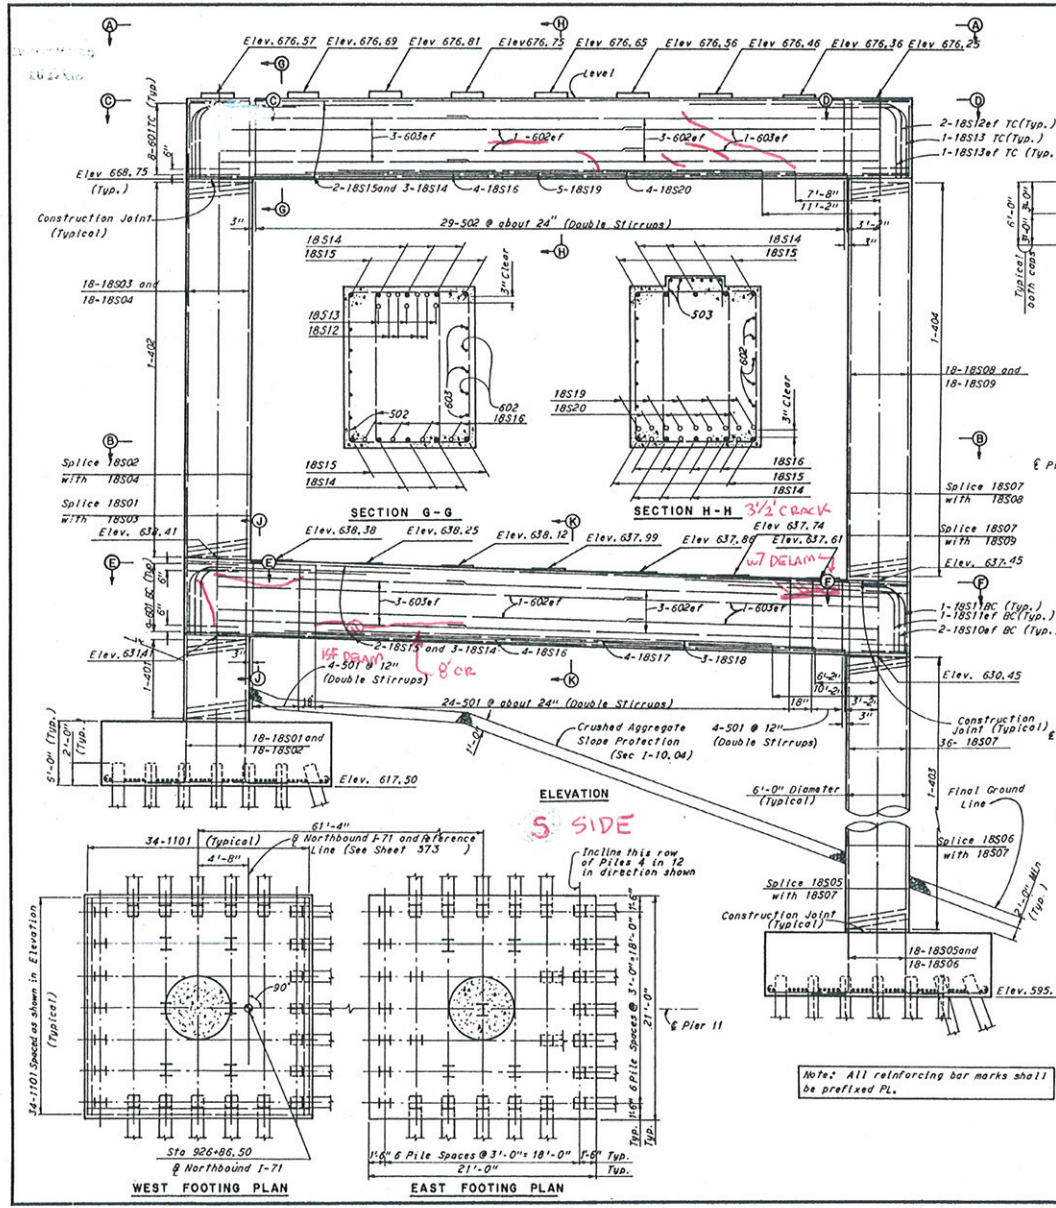

Notes:
 All piles shall be 12BPS3 steel bearing piles.
 For dead load deflection table and details for field welding No. 18S reinforcement bars see Sheet 589.
 The following abbreviations are used:
 ef = each face
 BC = bottom cap
 TC = top cap
 For additional notes see Sheet 385.

H.A.T. & BRIDGE NOS. 21A & 21B

HOWARD, NEEDLES, TAMMEN & BERGENOFF
 CONSULTING ENGINEERS NEW YORK

PIER II
 NORTHBOUND I-71 OVER NORTHBOUND JENNINGS,
 AND NORTHBOUND JENNINGS

BR. NO. CUY-71-1789R STA. 917+10.09
 STA. 935+21.25

CLEVELAND CUYAHOGA COUNTY OHIO

DRAWN	TRACED	CHECKED	REVIEWED
DATE	DATE	DATE	DATE





SHEET 392

Note: All reinforcing bar marks shall be prefixed PL.


PROJECT	DATE	BY

CUYAHOGA COUNTY
 CUY 11-17-83
 CUY-116-1576

11-17-83
 11-17-83
 11-17-83

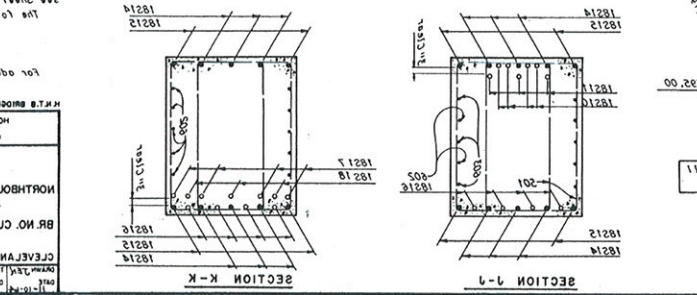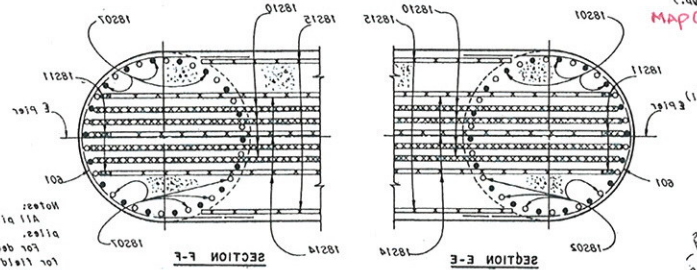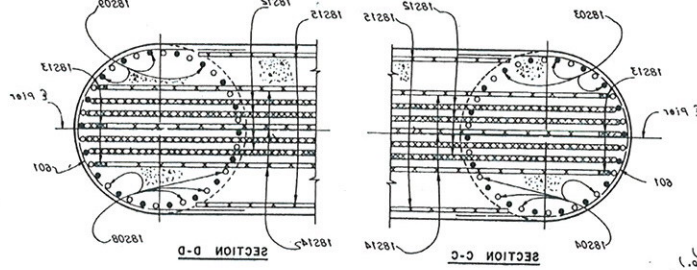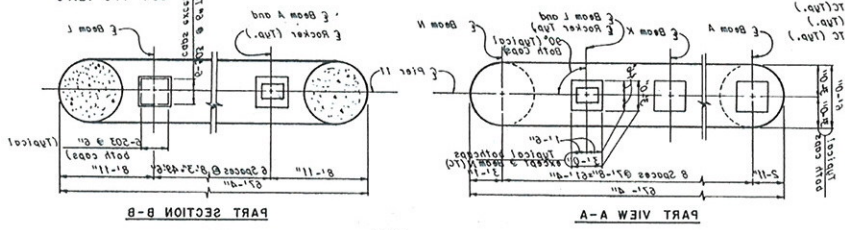

PIER II
 NORTHBOUND 1-71 OVER NORTHBOUND JENNINGS
 BR. NO. CUY-11-1789 STA 317+10.08
 STA 323+51.28
 CLEVELAND CUYAHOGA COUNTY OHIO









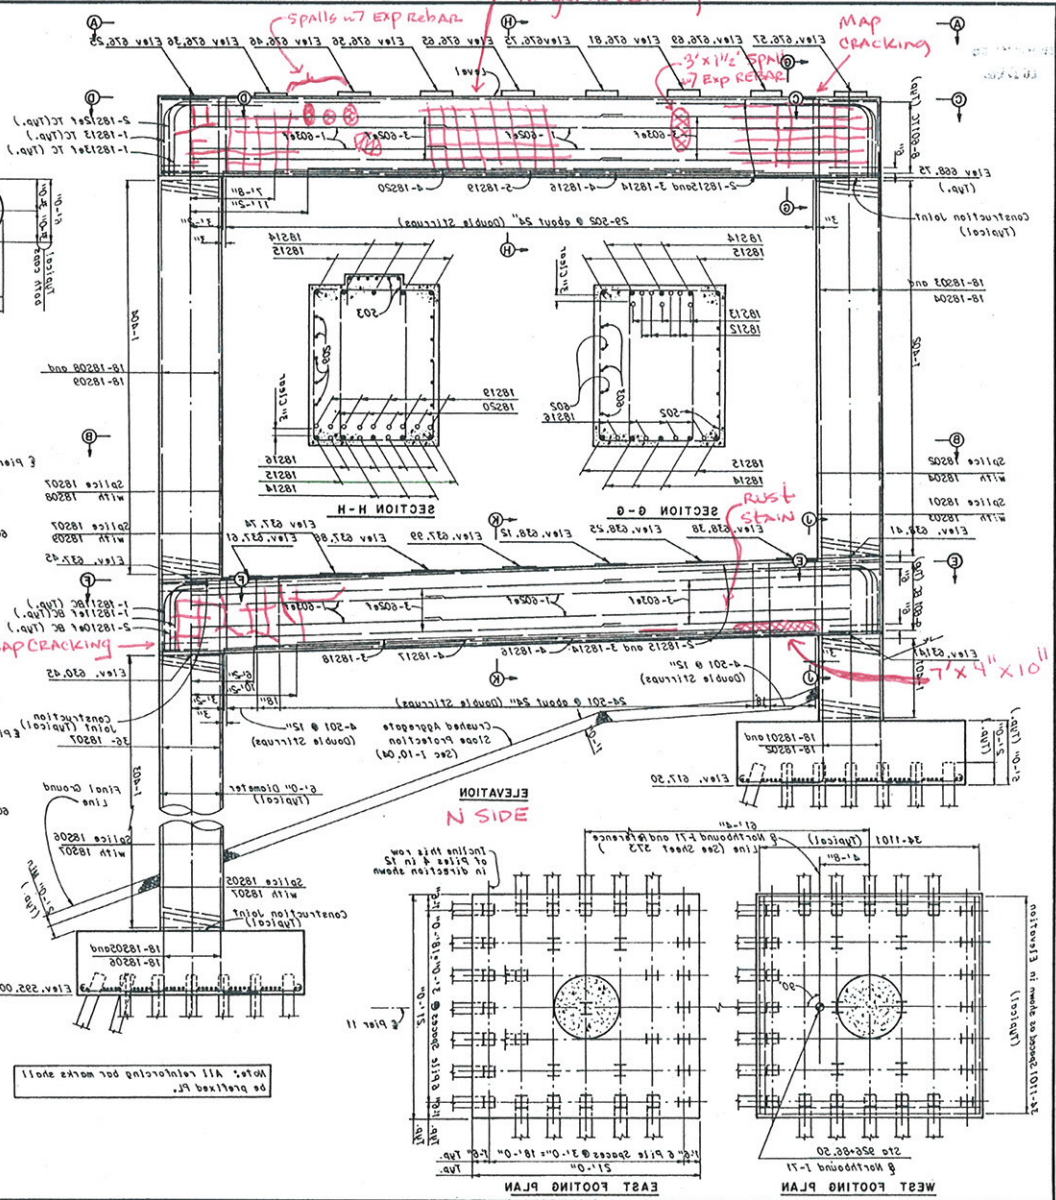


Spalls w/ EXP REBAR
 Alligator cracking
 MAP CRACKING
 3" x 1/2" SPN w/ 7 EXP REBAR

MAP CRACKING
 7' x 4" x 10" SPALL

Notes: All reinforcement bar marks shall be placed PL.
 Notes: All pier shall be 15M23 steel bearing
 pier dead load deflection table and details
 for live loading No. 182 reinforcement bars
 see Sheet 207.
 The following observations are used:
 EF = rock face
 BC = bottom cord
 TC = top cord
 For additional notes see Sheet 207.

CUYAHOGA COUNTY
 CUY 71-17.83
 CUY - 176-12.76

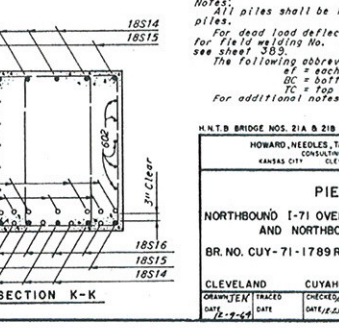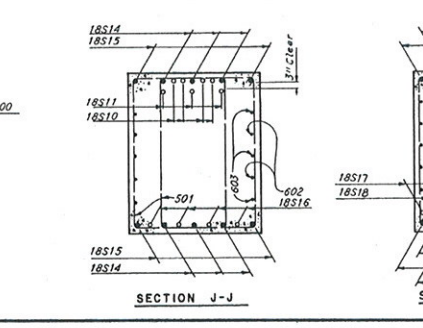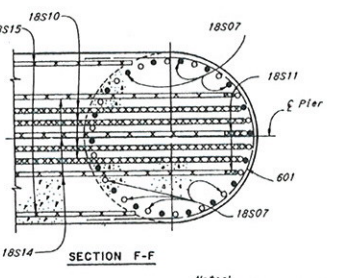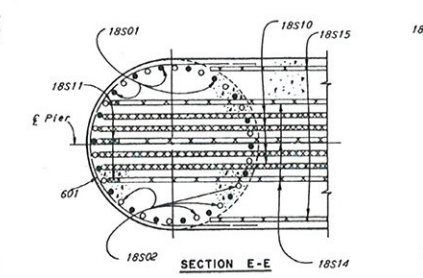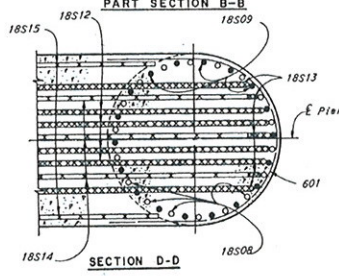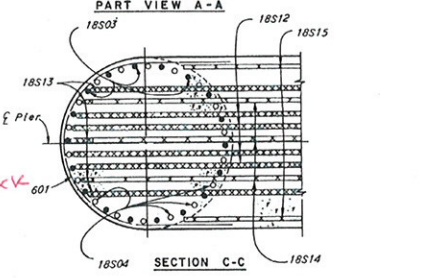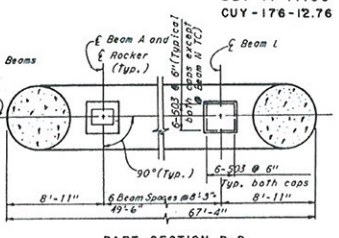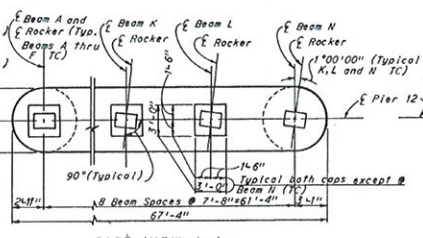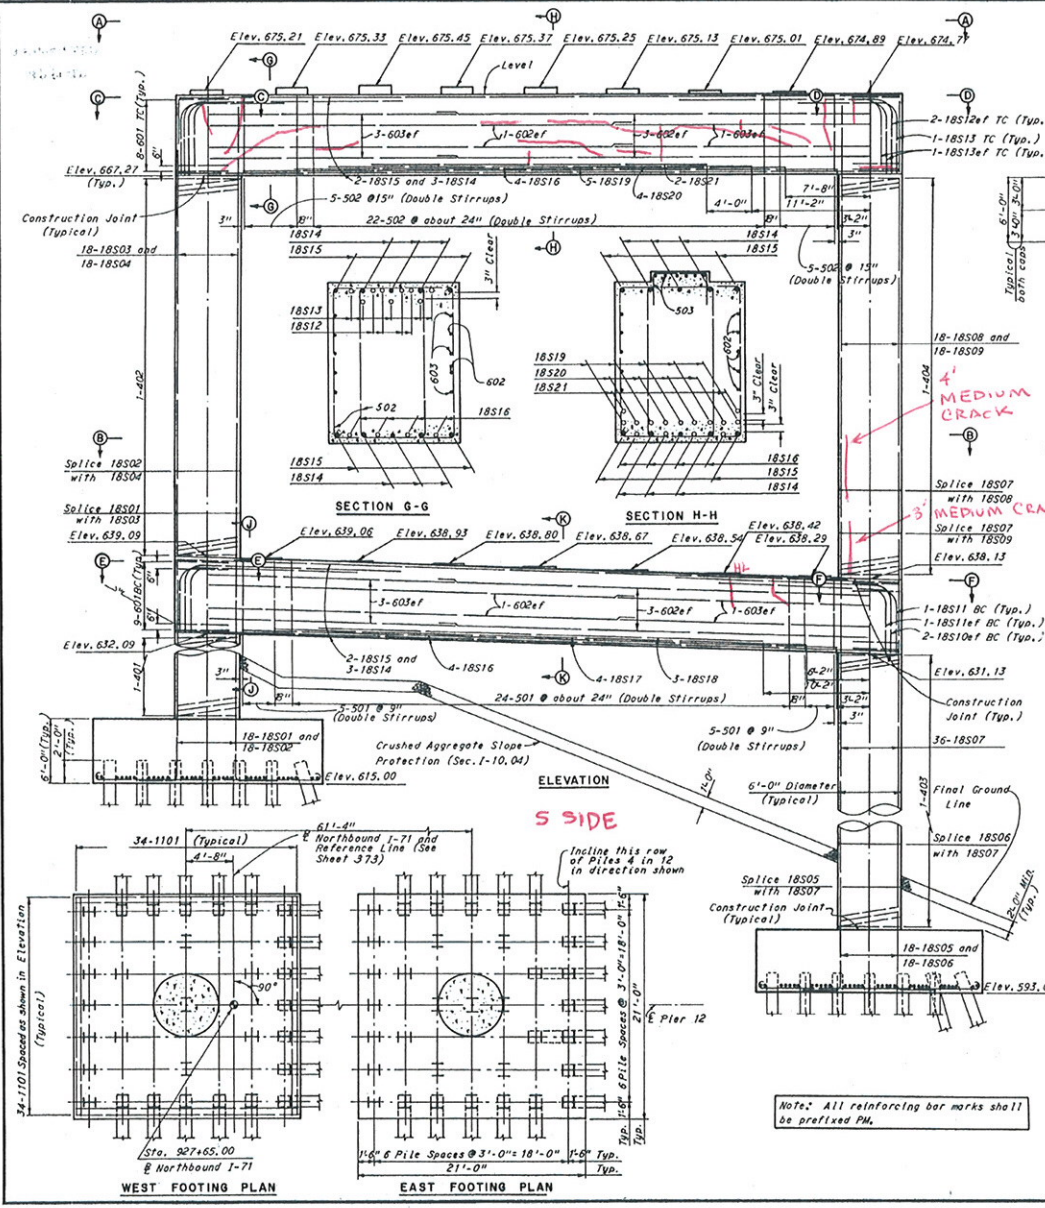









Note: All reinforcing bar marks shall be preflexed PM.

Notes:
 All piles shall be 12RP53 steel bearing piles.
 For dead load deflection table and details for field welding No. 18S reinforcement bars see sheet 305.
 The following abbreviations are used:
 ef = each face
 OC = top cap
 TC = top cap
 For additional notes see sheet 385.

H.N.T.B. BRIDGE NOS. 21A & 21B			
HOWARD, NEEDLES, TAMMEN & BERGENDOFF CONSULTING ENGINEERS KANSAS CITY, CLEVELAND, NEW YORK			
PIER 12			
NORTHBOUND I-71 OVER NORTHBOUND JENNINGS, AND NORTHBOUND JENNINGS			
BR. NO. CUY-71-1789R		STA. 917+10.09	
		STA. 935+21.25	
CLEVELAND	CUYAHOGA COUNTY	OHIO	
DATE: 12-2-64	DATE: 01/12/2004	DATE: 01/12/2004	DATE: 01/12/2004
DESIGNED BY: [Signature]	CHECKED BY: [Signature]	REVIEWED BY: [Signature]	REVISED BY: [Signature]
SHEET 333			

PROJECT	NO. 1	DATE	1-18-78
CITY	CUYAHOGA COUNTY	STATE	OHIO

CUYAHOGA COUNTY
CUY 71-17.83
CUY-178-15.78

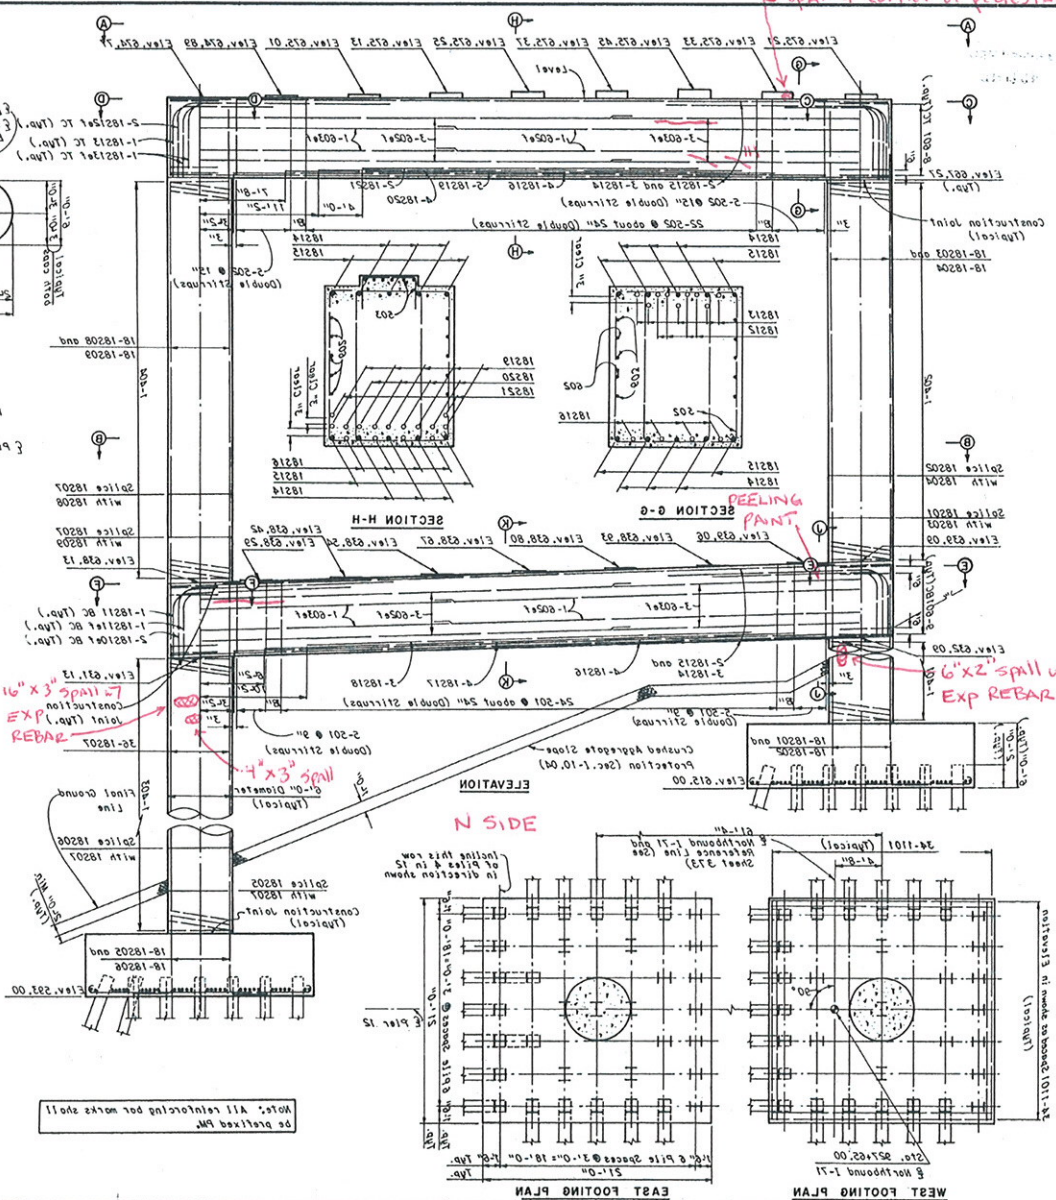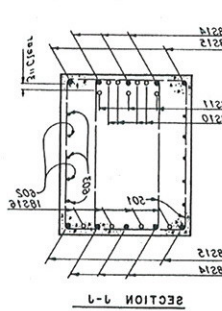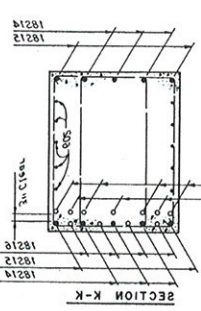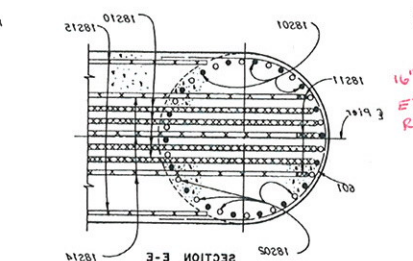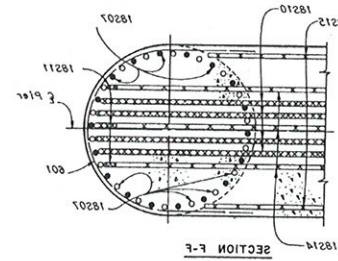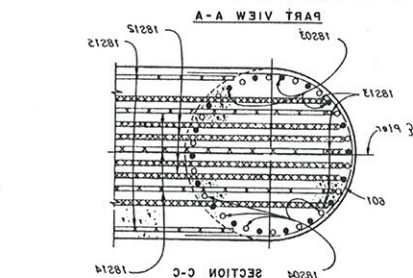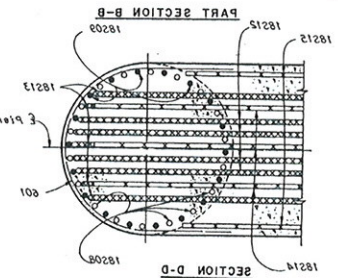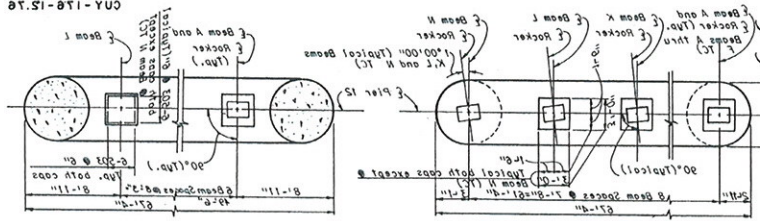

spalled corner of pedestal

PEELING PAINT

6"x2" spall w/ EXP REBAR

16"x3" spall w/ EXP REBAR

4"x3" spall w/ EXP REBAR










N SIDE

Note: All reinforcing bar marks shall be perforated PM

Note: All piers shall be 15M25 steel bearing piers. For dead load deflection table and details for live loading use 150% reinforcement ratio see sheet 282. The following observations are noted: BC = bottom cap RC top cap. For additional notes see sheet 282.

PIER IS	NORTHWARD 1-21 OVER NORTHWARD REMAINS AND NORTHWARD REMAINS
BR. NO.	CUY-71-1789 STA. 917+10.03 STA. 938+51.52
CITY AND COUNTY	CUYAHOGA COUNTY OHIO
DATE	1-18-78
DESIGNED BY	CONSTRUCTION ENGINEERS
CHECKED BY	CONSTRUCTION ENGINEERS
SCALE	AS SHOWN

CUYAHOGA COUNTY
 CUY 71-17.83
 CUY-176-12.76

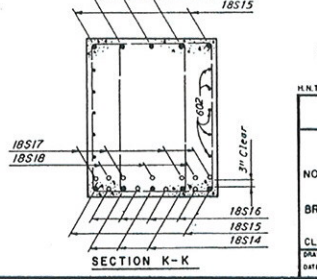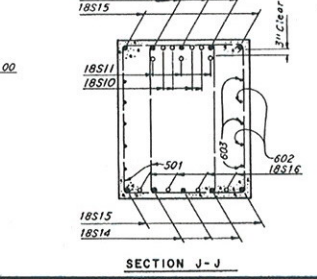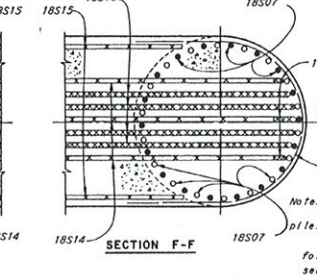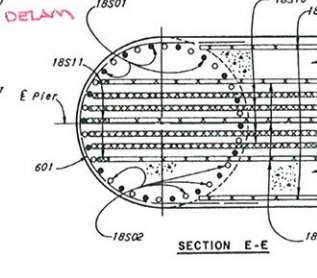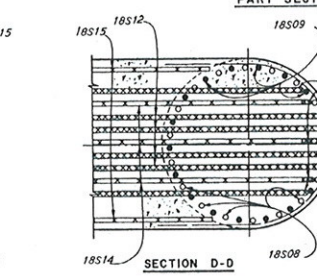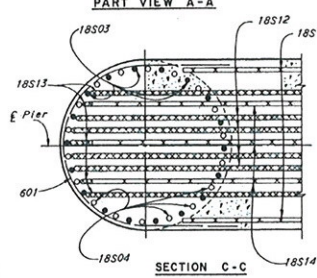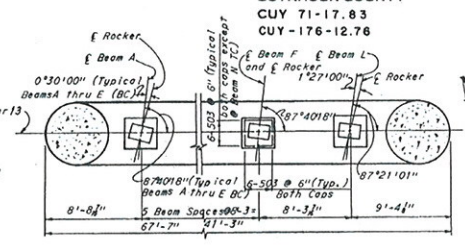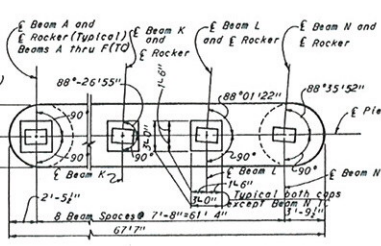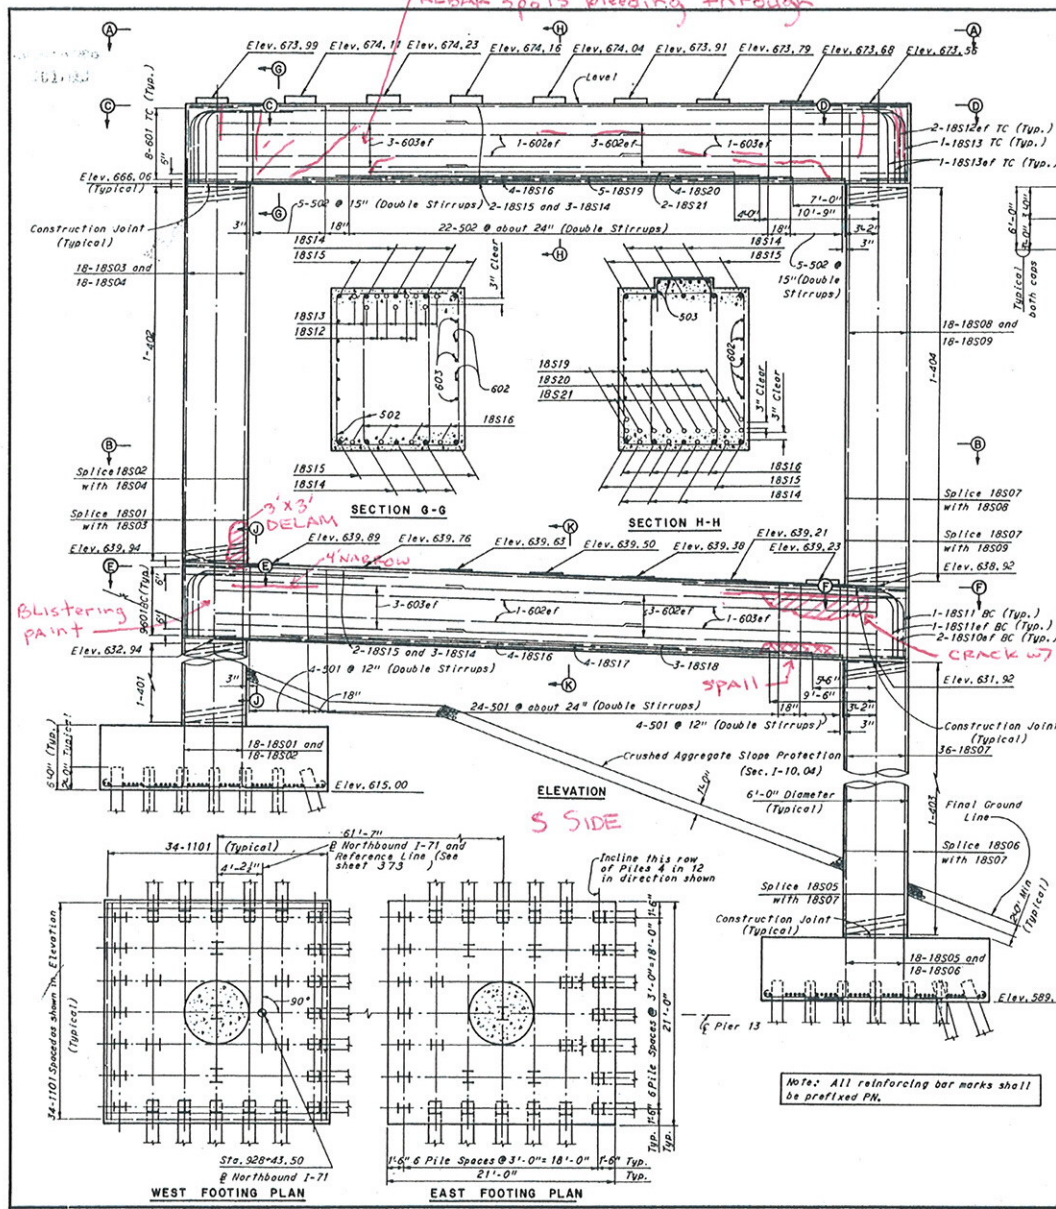


Notes: All piles shall be 12 #P53 steel bearing piles.
 For dead load deflection table and details for field welding No. 18S reinforcement bars see Sheet 389.
 The following abbreviations are used:
 BC = bottom cap
 TC = top cap
 For additional notes see Sheet 385.

H.N.T. BRIDGE NOS. 21A & 21B
 HOWARD, NEEDLES, TAMMEN & BERGENDOFF
 CONSULTING ENGINEERS
 CLEVELAND, OHIO
PIER 13
 NORTHBOUND I-71 OVER NORTHBOUND JENNINGS,
 AND NORTHBOUND JENNINGS
 BR. NO. CUY-71-1789R STA. 917+10.09
 STA. 935+21.25
 CLEVELAND CUYAHOGA COUNTY OHIO
 DRAWN BY: [Name] TRACED DATE: [Date] CHECKED BY: [Name] DATE: [Date] REVISIONS: [List] SHEET 391 OF 394


18213	18214	18215	18216
18217	18218	18219	18220

CUYAHOGA COUNTY
CUY 71-17.83
CUY-176-12.78

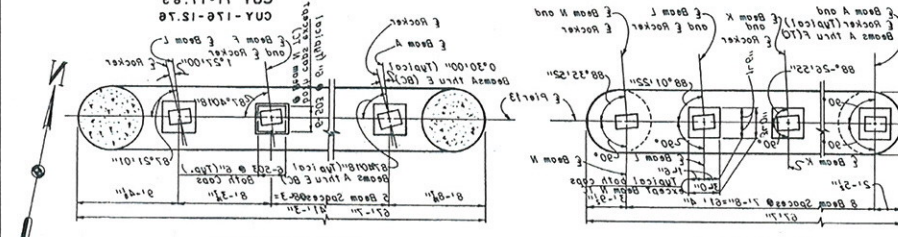


PART SECTION B-B


PART VIEW A-A

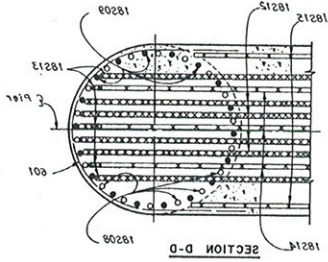


SECTION D-D

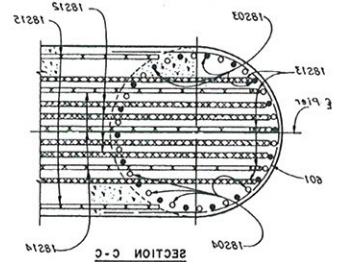

SECTION C-C

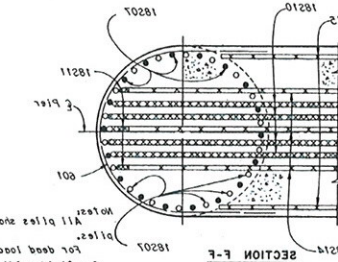


SECTION F-F

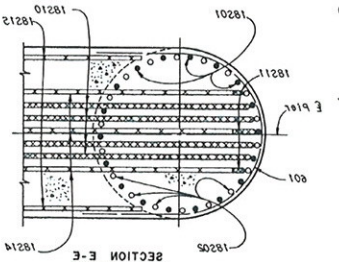


SECTION E-E

For additional notes see Sheet 382.
 TC = top cap
 BC = bottom cap
 LF = each face
 The following abbreviations are used:
 For dead load deflection table and details
 see Sheet 382.
 All piers shall be 15 #22 steel section.

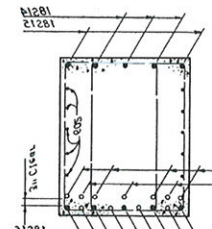


SECTION K-K

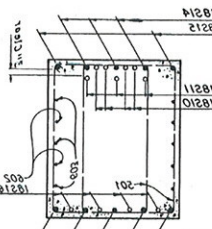

SECTION J-J

PIER 13
 NORTHBOUND - 17 OVER NORTHBOUND LENNINGS
 AND NORTHBOUND LENNINGS
 STA 817+10.08
 STA 833+51.58
 BR. NO. CUY-71-1789
 CLEVELAND CUYAHOGA COUNTY OHIO
 ENGINEER: [Signature]
 DATE: [Date]

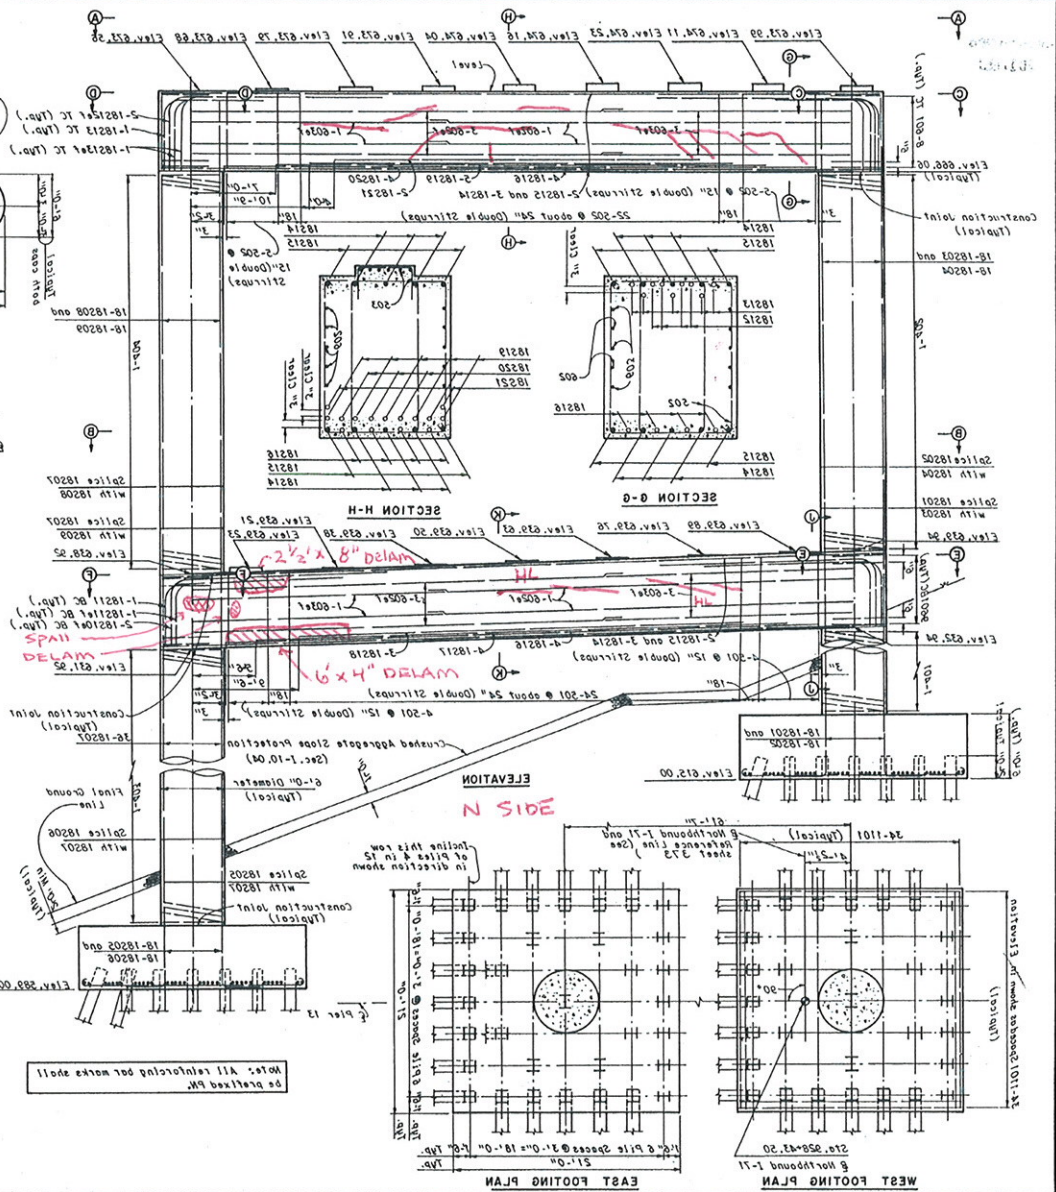


Note: All reinforcement bar marks shall be marked PW.


EAST FOOTING PLAN

WEST FOOTING PLAN

ELEVATION


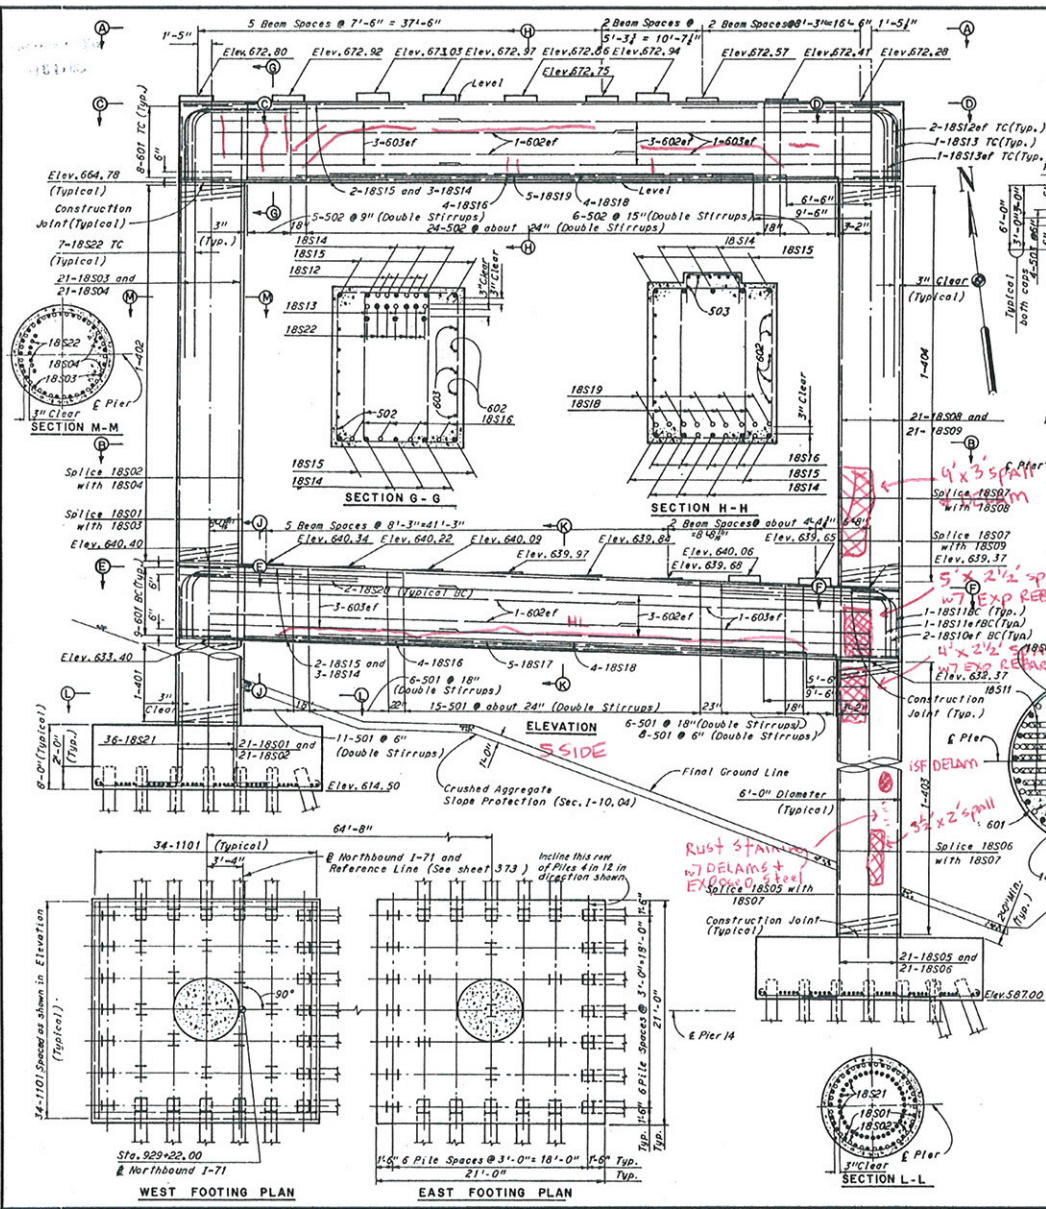


Note: Special care shall be taken when placing reinforcing steel so as not to interfere with anchor bolt setting.

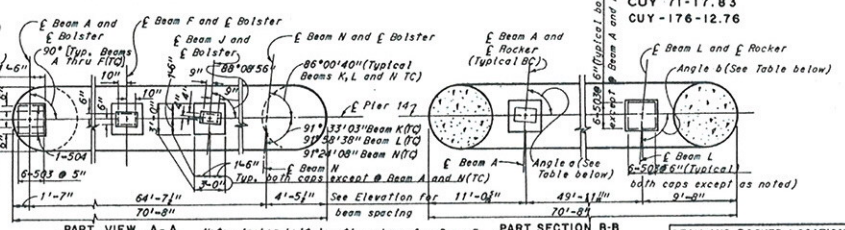

Beam	Angle a	Angle b
A	85°49'52"	92°19'42"
B	86°37'51"	92°19'42"
C	86°37'50"	92°19'42"
D	87°01'51"	92°19'42"
E	87°25'53"	92°19'42"
F	87°49'56"	92°19'42"
J	87°26'45"	92°33'15"
L	84°26'45"	92°33'59"

Note: All reinforcing bar marks shall be prefixed PP.

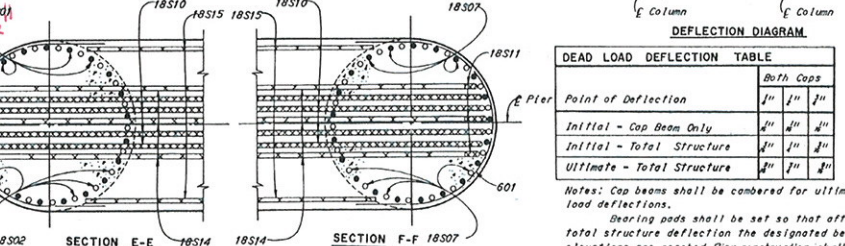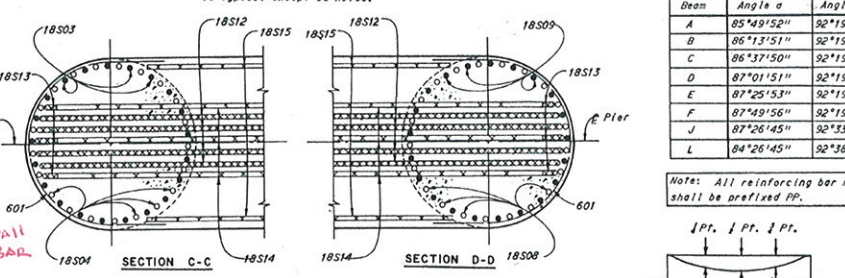


Point of Deflection	Both Caps		
	1"	1"	1"
Initial - Cap Beam Only	1"	1"	1"
Initial - Total Structure	1"	1"	1"
Ultimate - Total Structure	1"	1"	1"

DEFLECTION DIAGRAM
 1/4 P.P., 1/4 P.P.

DEAD LOAD DEFLECTION TABLE

Notes: Cap beams shall be cambered for ultimate dead load deflections.
 Bearing pads shall be set so that after initial total structure deflection the designated bearing pad elevations are reached. Pier construction shall be complete prior to the erection of any superstructure steel.

Notes: All piles shall be 120PS3 steel bearing piles.
 For details for field welding No. 18S reinforcement bars see sheet 185.
 The following abbreviations are used:
 BC = bottom cap
 TC = top cap
 For additional notes see sheet 385.

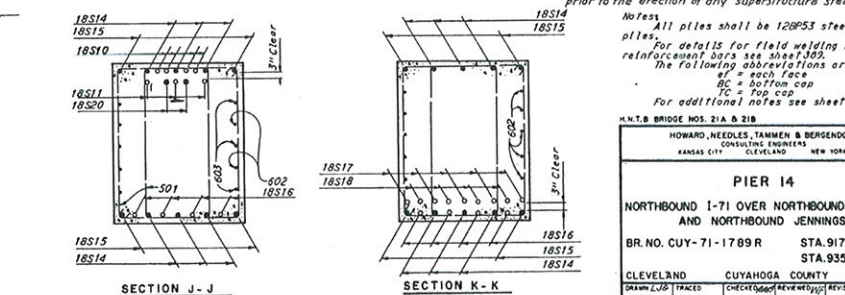

H.M.T.B. BRIDGE NOS. 21A & 21B

HOWARD, NEEDLES, TAMMEN & BERGENDOFF
 CONSULTING ENGINEERS
 KANSAS CITY, MISSOURI NEW YORK

PIER 14
 NORTHBOUND I-71 OVER NORTHBOUND JENNINGS,
 AND NORTHBOUND JENNINGS

BR. NO. CUY-71-1789R STA. 917+10.09
 STA. 935+21.210

CLEVELAND CUYAHOGA COUNTY OHIO

DRAWN LUB TRACED CHECKED GGG REVIEWED JGG
 DATE 12-2-66 DATE 12-2-66 DATE 12-2-66

PORTION BELOW THE SR 176 PIER CAP
 IS A WALL TYPE. PLANS NOT ACCURATE.

CUYAHOGA COUNTY
 CUY 71-17.83
 CUY-17E-15.1E

PROJ. NO. 17E-15.1E
 SHEET NO. 322

DATE: 11-15-2011

DESIGNED BY: [Signature]
 CHECKED BY: [Signature]
 APPROVED BY: [Signature]

PIER 14
 NORTHBOUND I-71 OVER NORTHBOUND LEBANON AND NORTHBOUND JENNINGS
 BR. NO. CUY-71-17.89 STA 917+10.09
 STA 935+51.25

CLEVELAND CUYAHOGA COUNTY OHIO
 ENGINEER: [Signature]
 ARCHITECT: [Signature]

REVISIONS:

NO.	DATE	DESCRIPTION
1	11-15-2011	ISSUED FOR PERMIT


Notes:
 1. All steel shall be 15023 steel bearing plates for details for field welding No. 182 reinforcement details see sheet 323.
 2. The following abbreviations are used: W = wide flange I beam, S = standard I beam, C = channel, L = angle, PL = plate, RC = reinforced concrete, ST = steel tank, etc.
 3. For additional notes see sheet 323.

BEAM AND ROCKER LOCATION BC


Beam	Angle
A	92°19'45"
B	92°13'21"
C	92°37'50"
D	92°19'45"
E	92°19'45"
F	92°19'45"
G	92°19'45"
H	92°19'45"
I	92°19'45"

DEAD LOAD DEFLECTION TABLE

Point of Deflection	Initial - Cap Beam Only	Initial - Total Structure	Ultimate - Total Structure
Both Caps	1/4" 1/4"	1/4" 1/4"	3/4" 3/4"

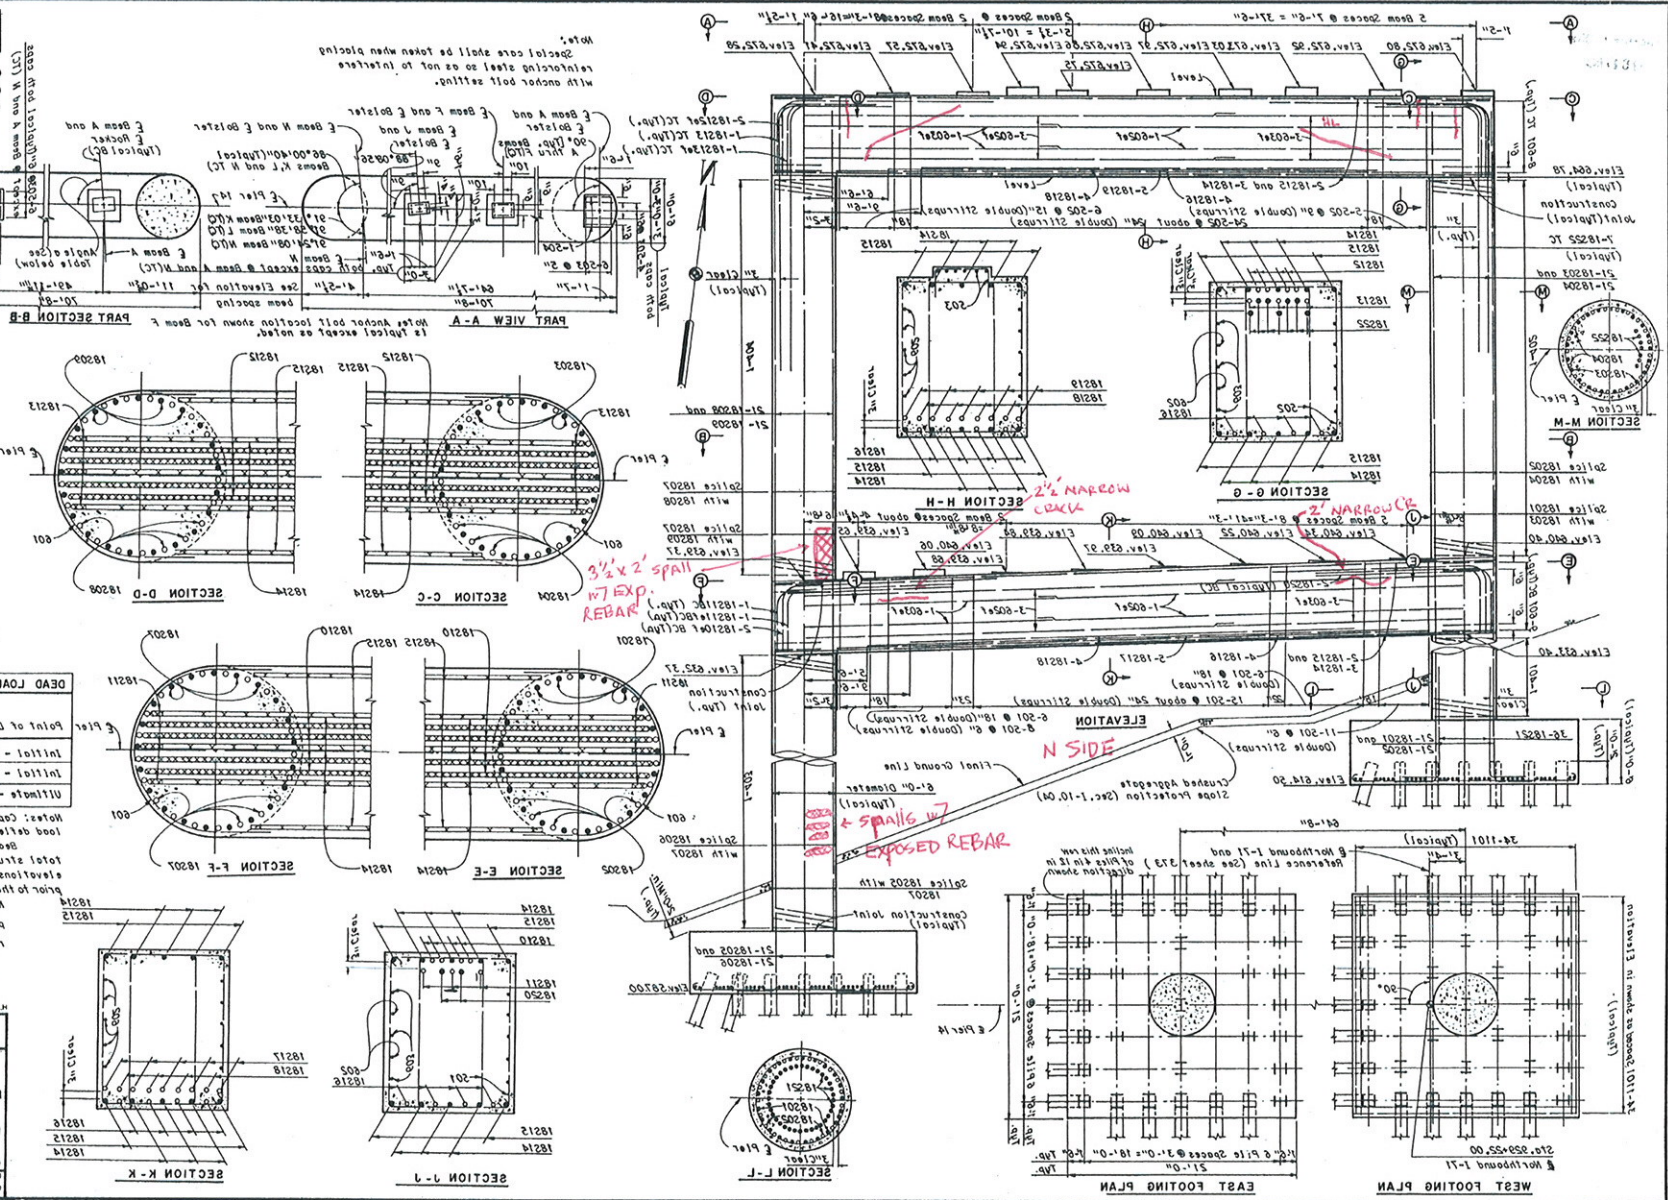

PORTION BELOW THE SR 176 PIER CAP IS A WALL TYPE PLANS NOT ACCURATE.

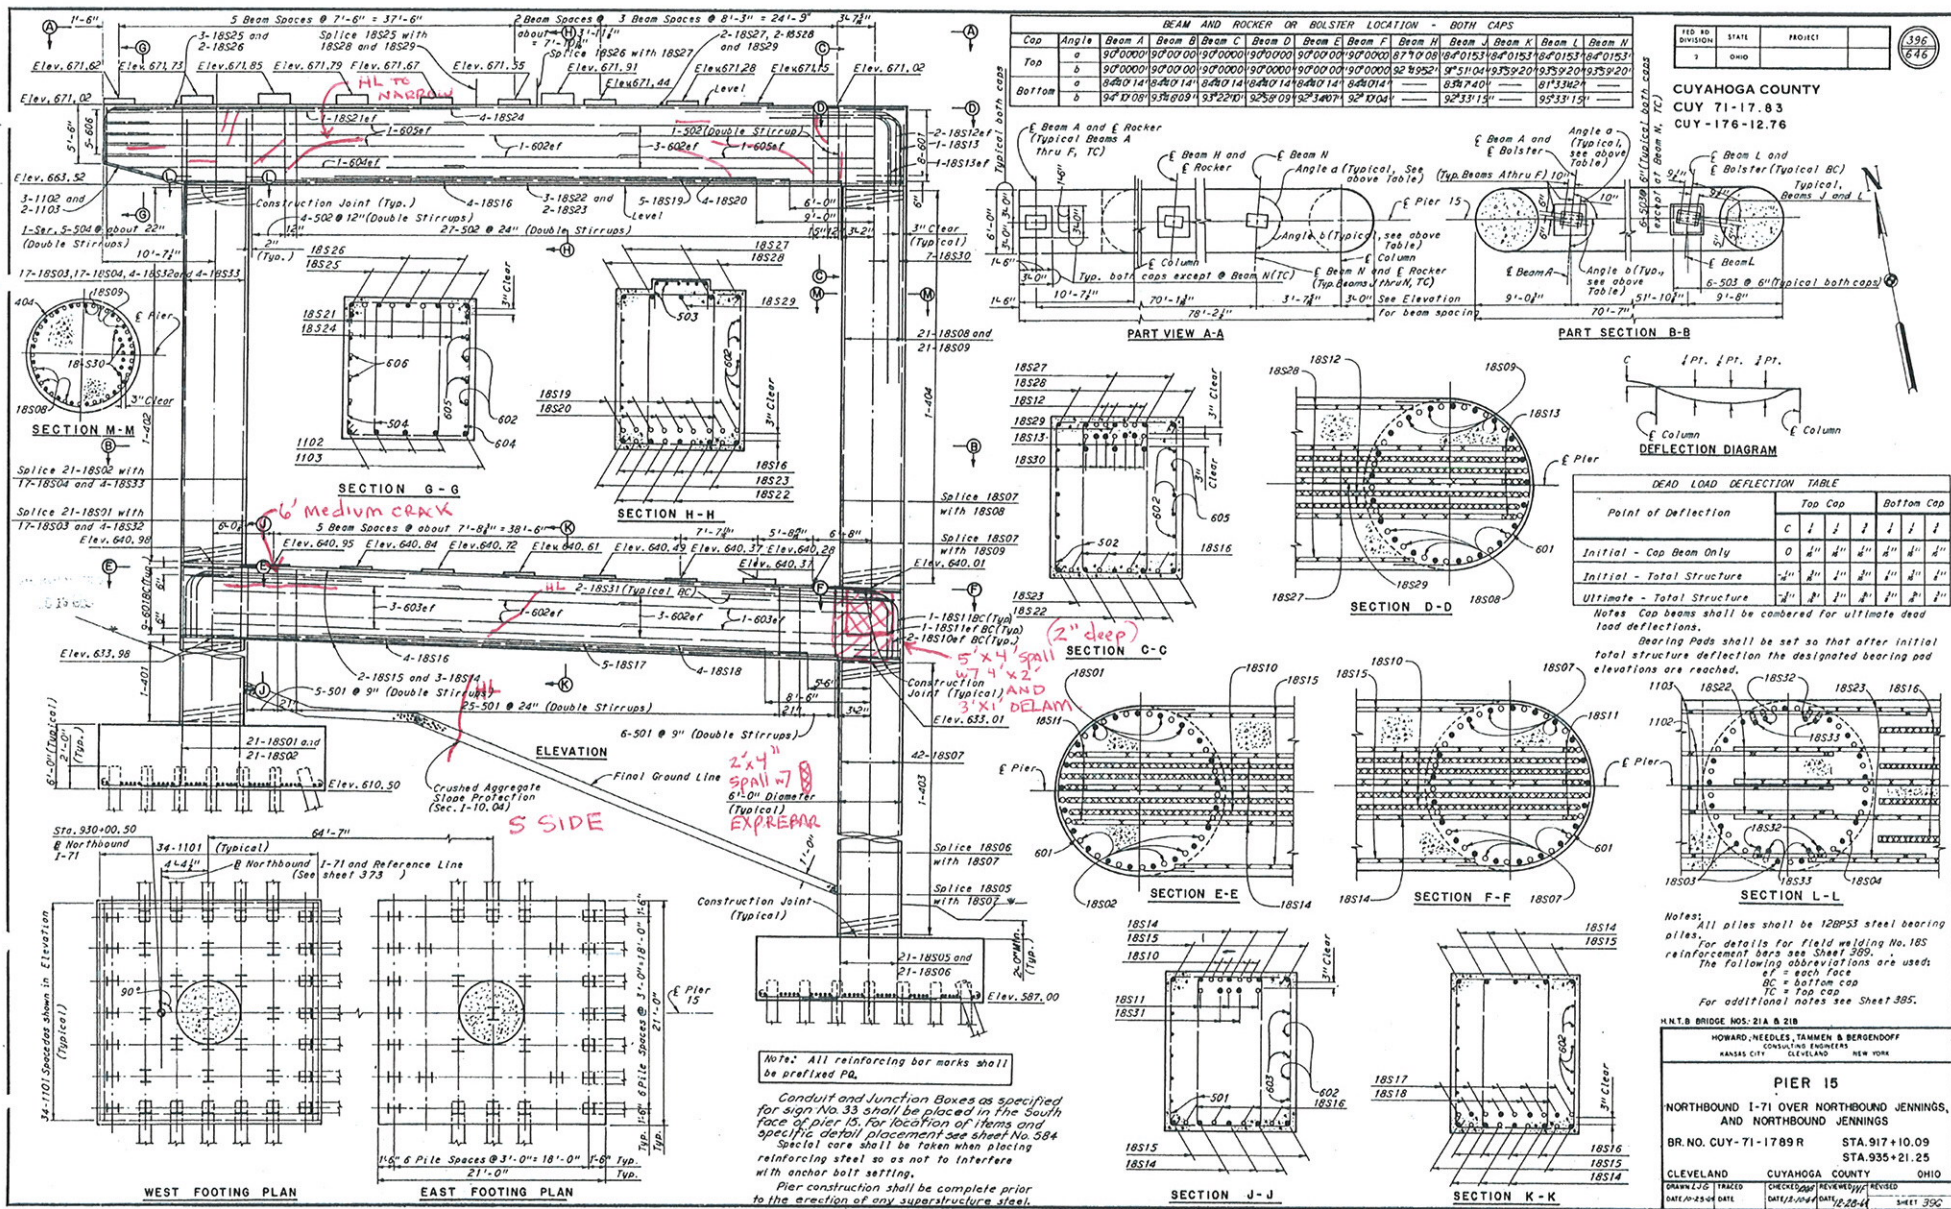

PORTION BELOW SR 176 PIER CAP IS WALL TYPE. PLANS NOT ACCURATE.

SIGNAGE ATTACHED TO PIER

CUYAHOGA COUNTY
 CUY 17-17-B
 CUY-176-17-B

PIER 18
 BR. NO. CUY-17-17-B
 ELEV. 21.00
 NORTHBOUND 1-17 OVER NORTHBOUND LEMINGS
 AND NORTHBOUND LEMINGS



CLEVELAND
 CUYAHOGA COUNTY
 OHIO

DESIGNED BY: [Signature]
 CHECKED BY: [Signature]
 DATE: 1928


HOWARD, INGERS, TAMM & BERNDSON
 CONSULTING ENGINEERS
 CLEVELAND, OHIO

NOTE: All steel shall be 15022 steel bearing plates for field welding No. 182 reinforcement bars see sheet 182. The following quantities are based on a 6" deep cap. For additional notes see sheet 182.


NOTE: All steel shall be 15022 steel bearing plates for field welding No. 182 reinforcement bars see sheet 182. The following quantities are based on a 6" deep cap. For additional notes see sheet 182.

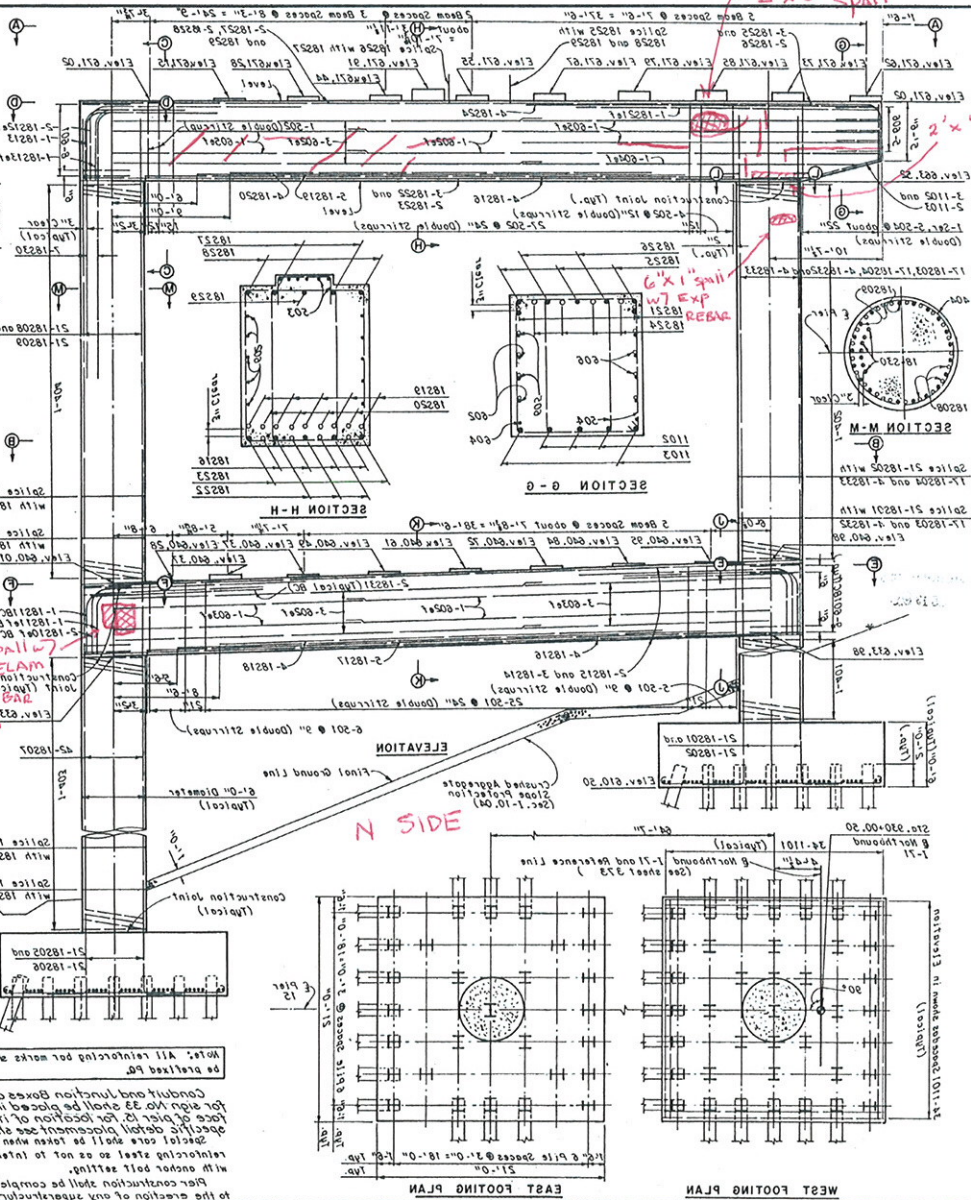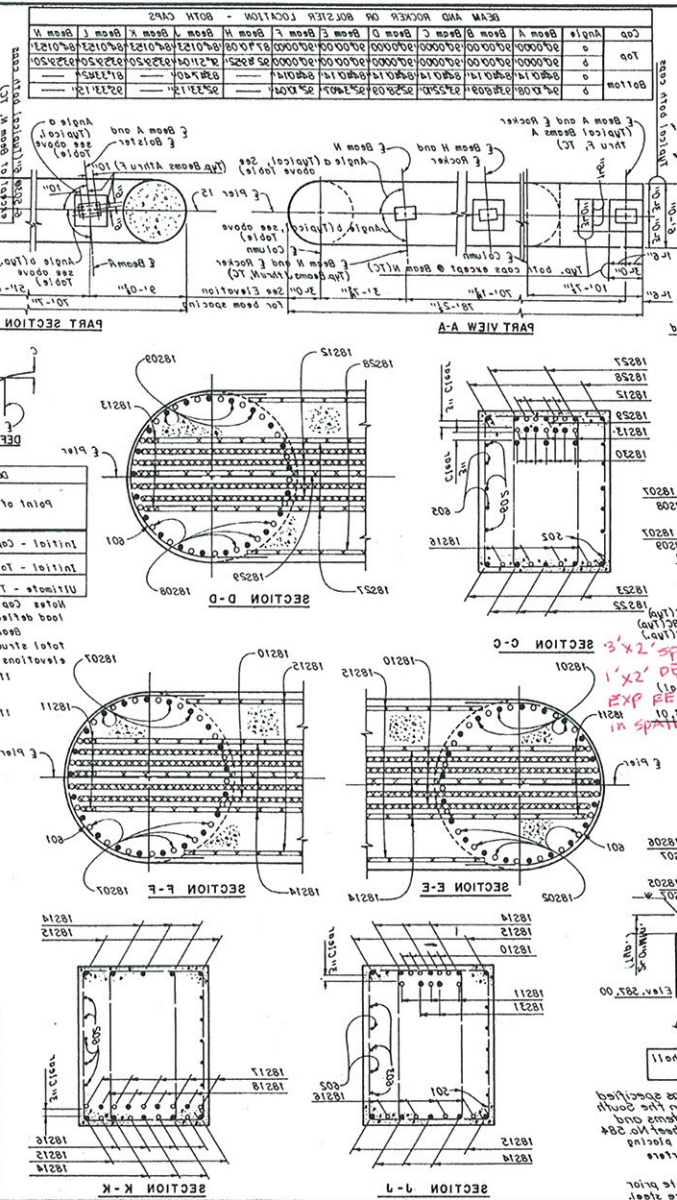

PORTION BELOW SR 176 PIER CAP
 IS WALL TYPE. PLANS ARE NOT ACCURATE.

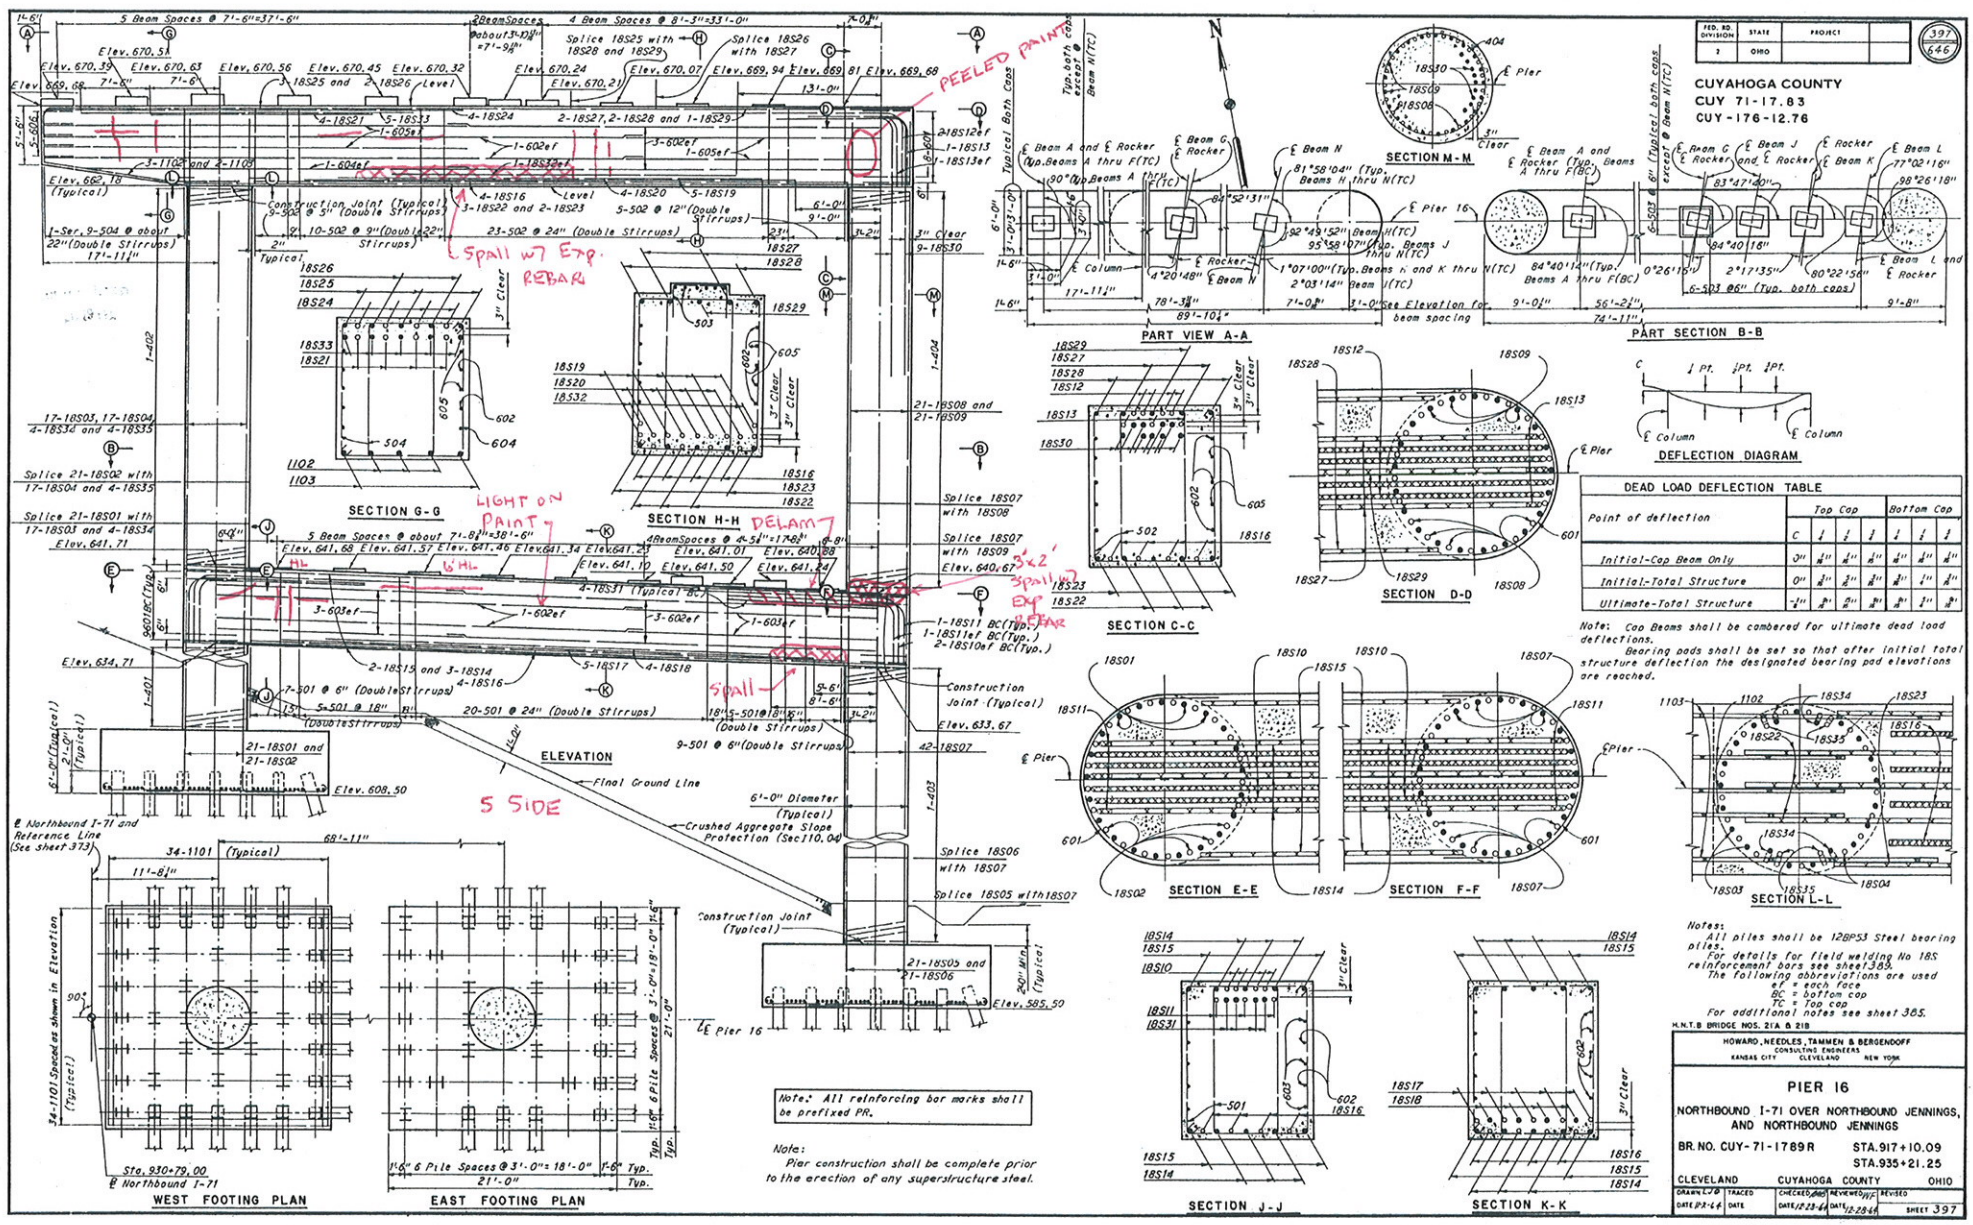








PORTION BELOW SR 176 PIER CAP
 IS WALL TYPE. PLANS NOT ACCURATE.

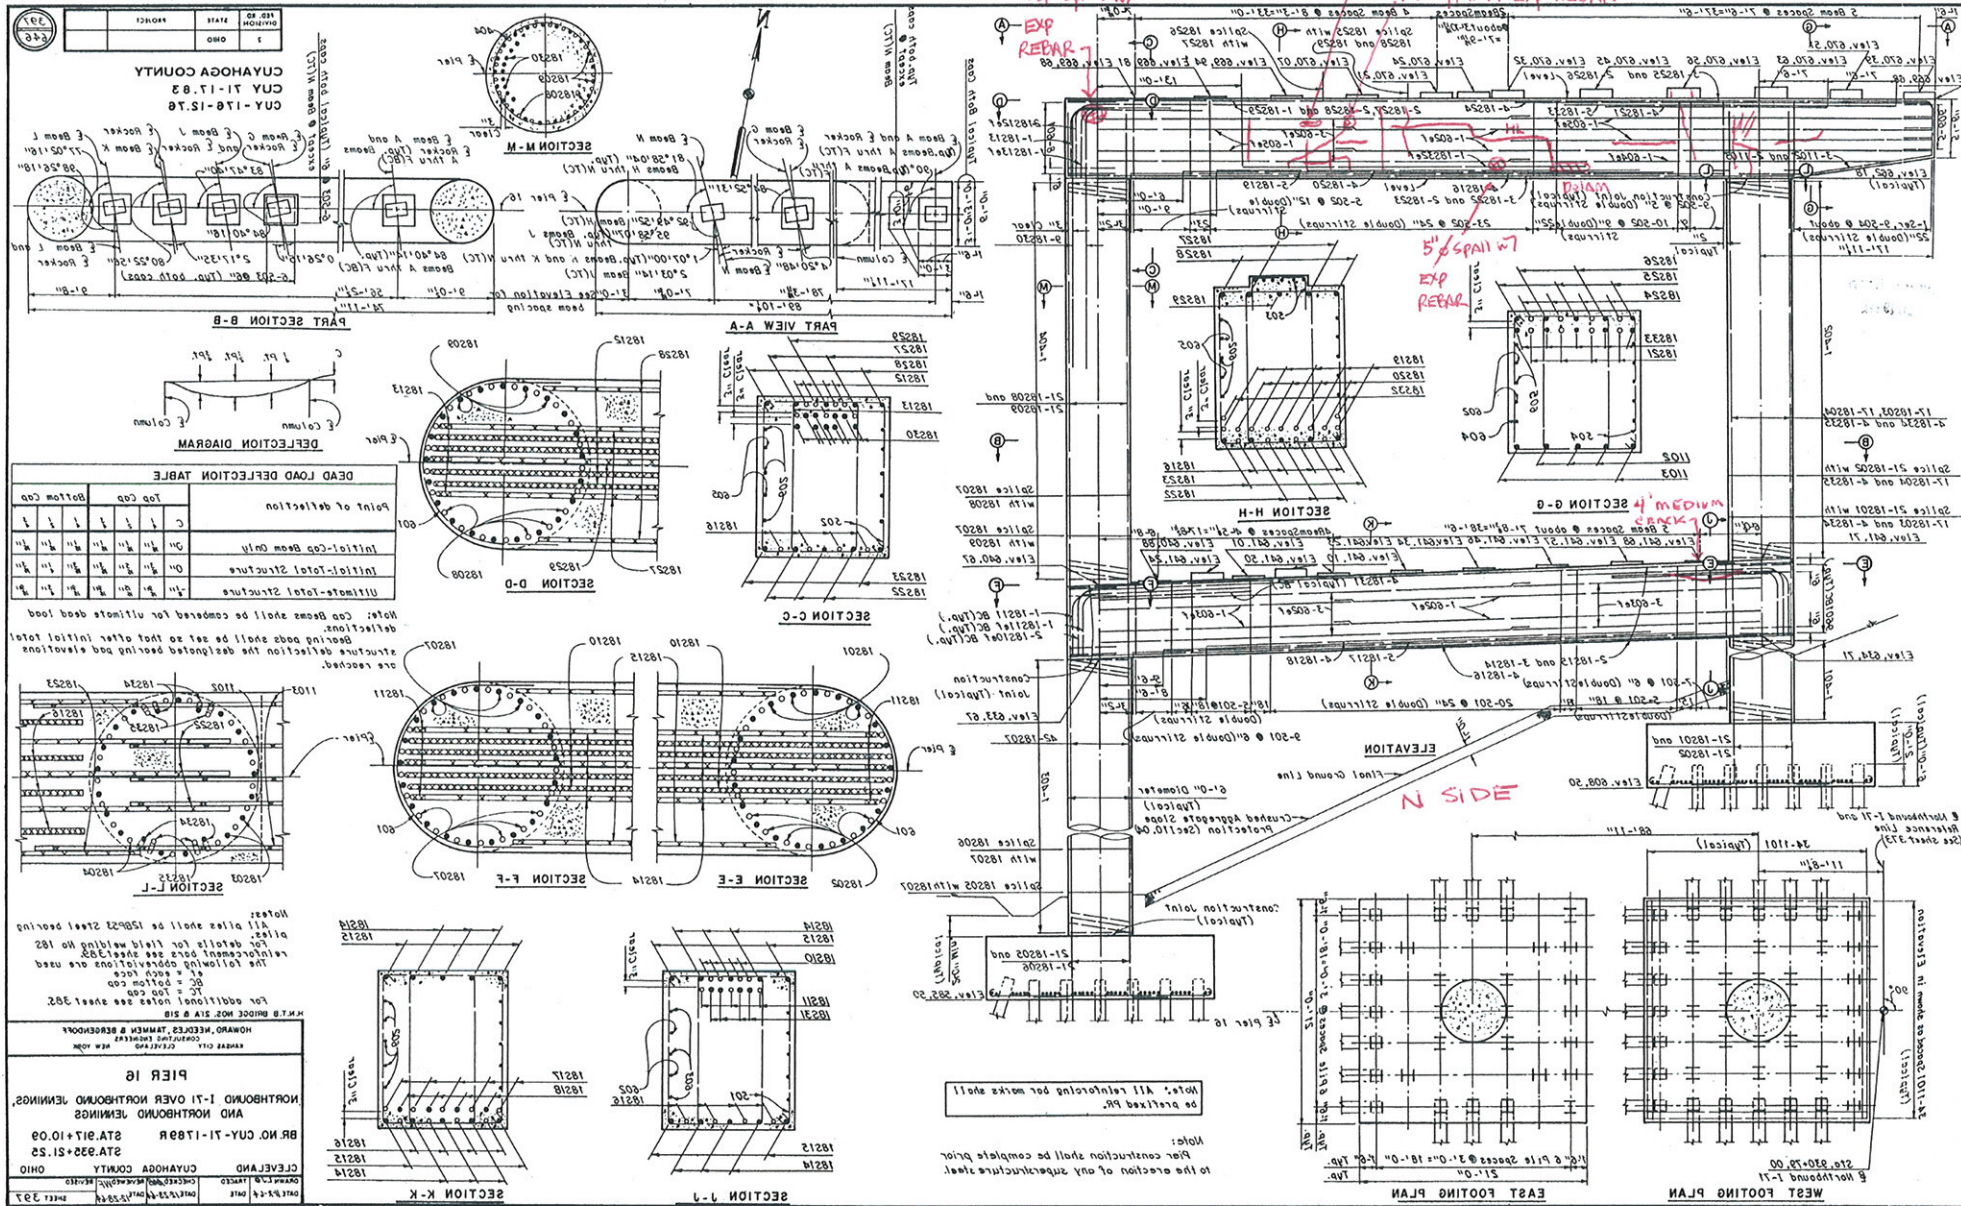

PORTION OF SR 176 PIER CAP
 IS WALL TYPE. PLANS NOT ACCURATE.

NO. 00	STATE	PROJECT	390
1	OHIO		646

CUYAHOGA COUNTY
 CUY 71-17.83
 CUY-176-12.76

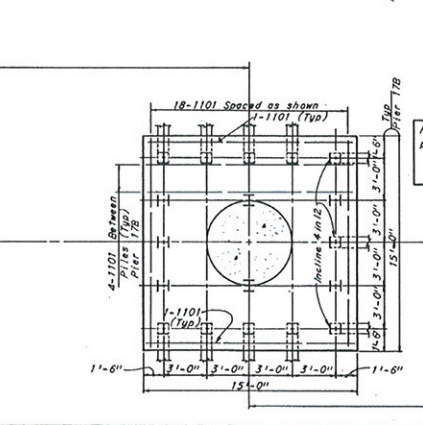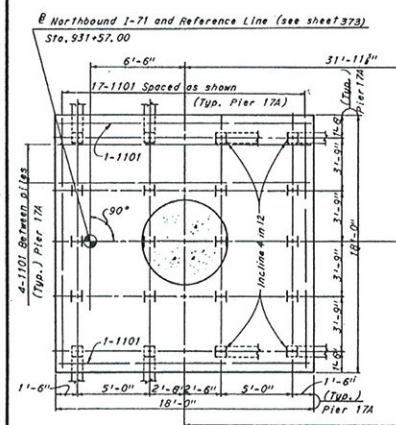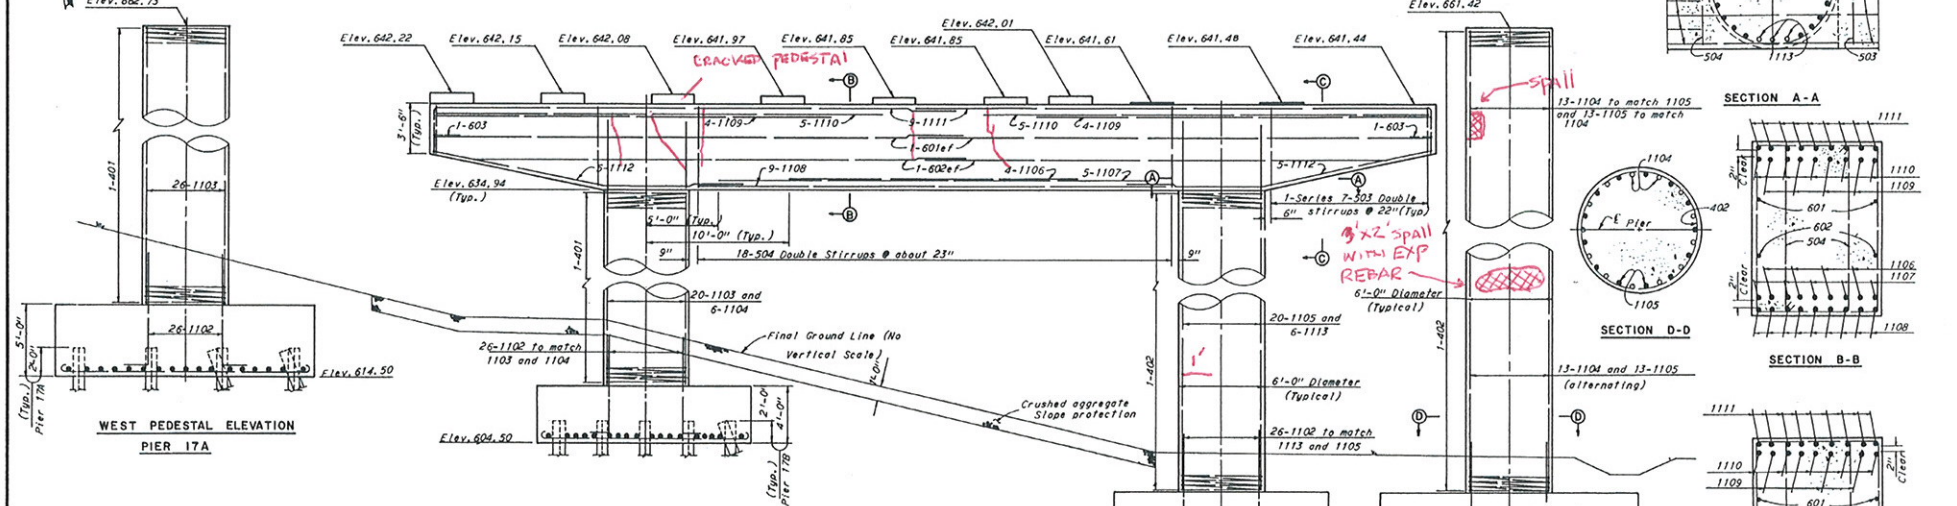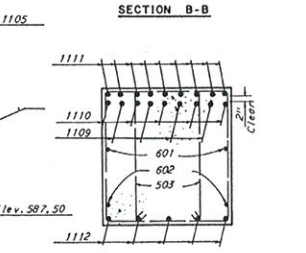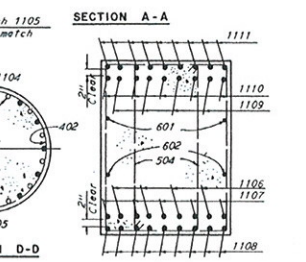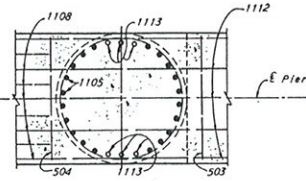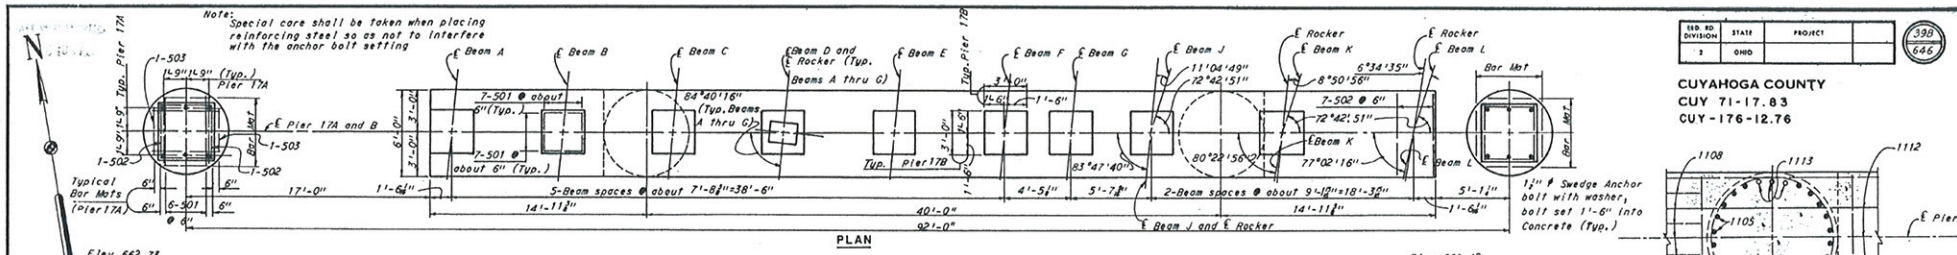

Notes: All reinforcing bar marks shall be prefixed as follows:
 Pier 17A = PS
 Pier 17B = PCC

Notes:
 All piles shall be 12BPS3 steel bearing piles.
 Batterd piles shall be inclined 4 in 12 transversely and 3 in 12 longitudinally in the direction shown.
 The following abbreviation is used:
 4" = each face
 For additional notes see sheet 3B5

H.M.T.B. BRIDGE NOS. 21A & 21B

HOWARD, NEEDLES, TAMMEN & BERGENDOFF
 CONSULTING ENGINEERS
 KANSAS CITY CLEVELAND NEW YORK

PIERS 17A & 17B

NORTHBOUND I-71 OVER NORTHBOUND JENNINGS,
 AND NORTHBOUND JENNINGS

BR. NO. CUY-71-1789R STA. 917+10.09
 STA. 935+21.25









CLEVELAND CUYAHOGA COUNTY OHIO

DRAWN/23 TRACED CHECKED BY/23 REVISIONS/23 SHEET 39B

FED. RD. DIVISION	STATE	PROJECT	401 646
3	OHIO		

CUYAHOGA COUNTY
 CUY 71-17.83
 CUY-176-12.76



Note:
 Special care shall be taken when placing reinforcing steel so as not to interfere with anchor bolt setting.

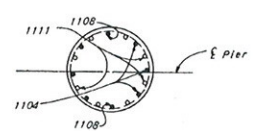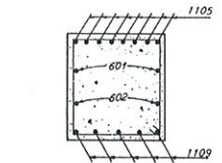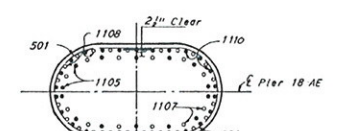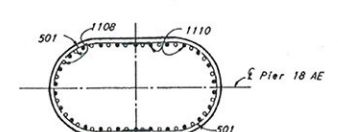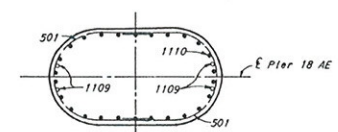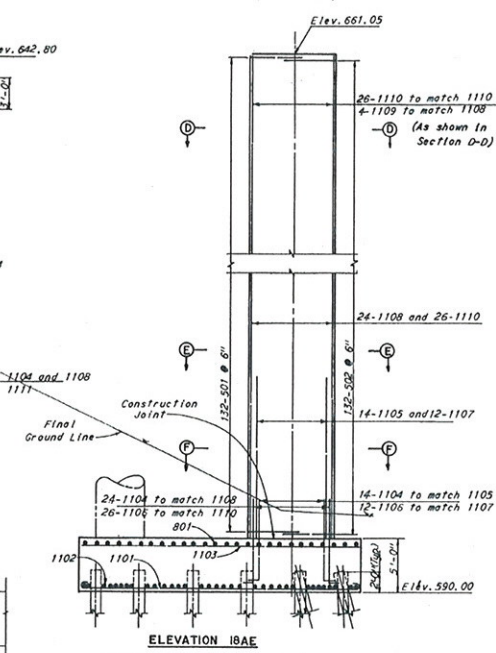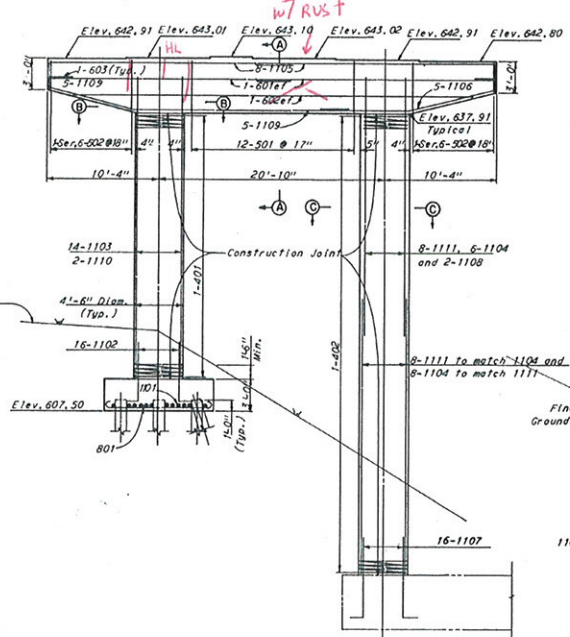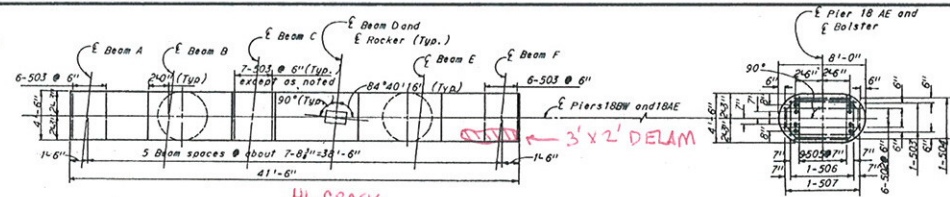

Note:
 Reinforcement in combined footing is included with reinforcement for Pier 18AE.

Note:
 All reinforcing bar marks shall be prefixed as follows:
 Pier 18AE = PX
 Pier 18BW = PDD



Note:
 The following abbreviation is used:
 4" = each face
 For additional notes see Sheet 385.
 All piles are 12BP-53.

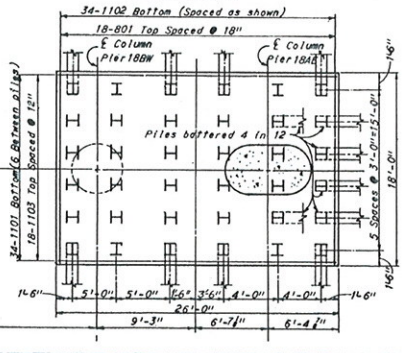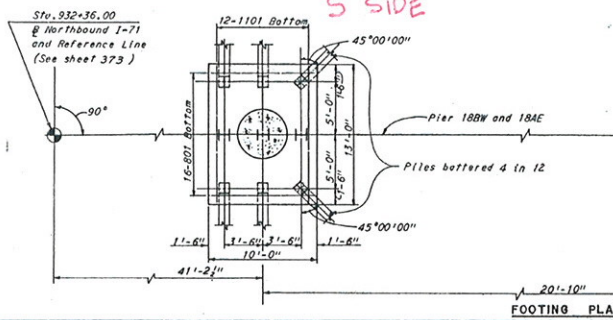

M.H.T.B. BRIDGE NOS. 21A & 21B			
HOWARD, NEEDLES, TAMMEN & BERGENDOFF CONSULTING ENGINEERS KANSAS CITY CLEVELAND NEW YORK			
PIERS 18AE & 18BW			
NORTHBOUND I-71 OVER NORTHBOUND JENNINGS, AND NORTHBOUND JENNINGS			
BR. NO. CUY-71-1789R		STA. 917+10.09 STA. 935+21.25	
CLEVELAND	CUYAHOGA COUNTY	OHIO	
DRAWN J.D.	TRACES	CHECKED T.C.	REVISED
DATE 12-3-64	DATE	DATE 12-3-64	DATE 12-22-64
			SHEET 401

401	PROJECT	NO. 10	DATE
401		3	11-17-83


CUYAHOGA COUNTY
 CUY 71-17-83
 CUY-178-15.78

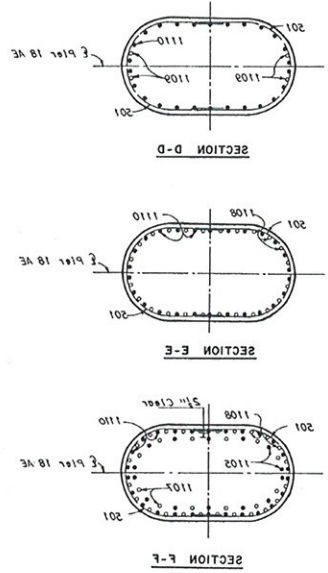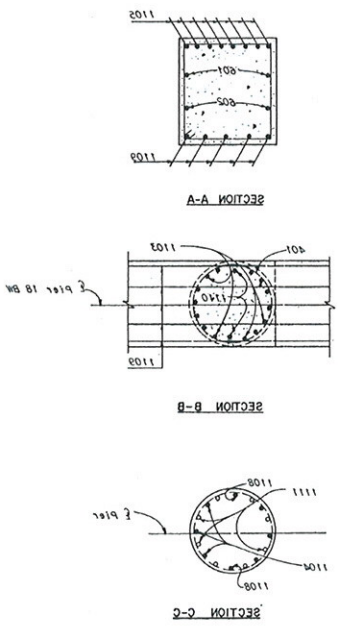

Note:
 Special care shall be taken when placing reinforcing steel so as not to interfere with anchor bolt setting.

Note:
 All reinforcing bar marks shall be placed as follows:
 Pier 18A = 4X
 Pier 18B = 400

Note:
 The following abbreviation is used:
 4" = 4 inch
 for additional notes see Sheet 382.
 All piers are 18" x 23".





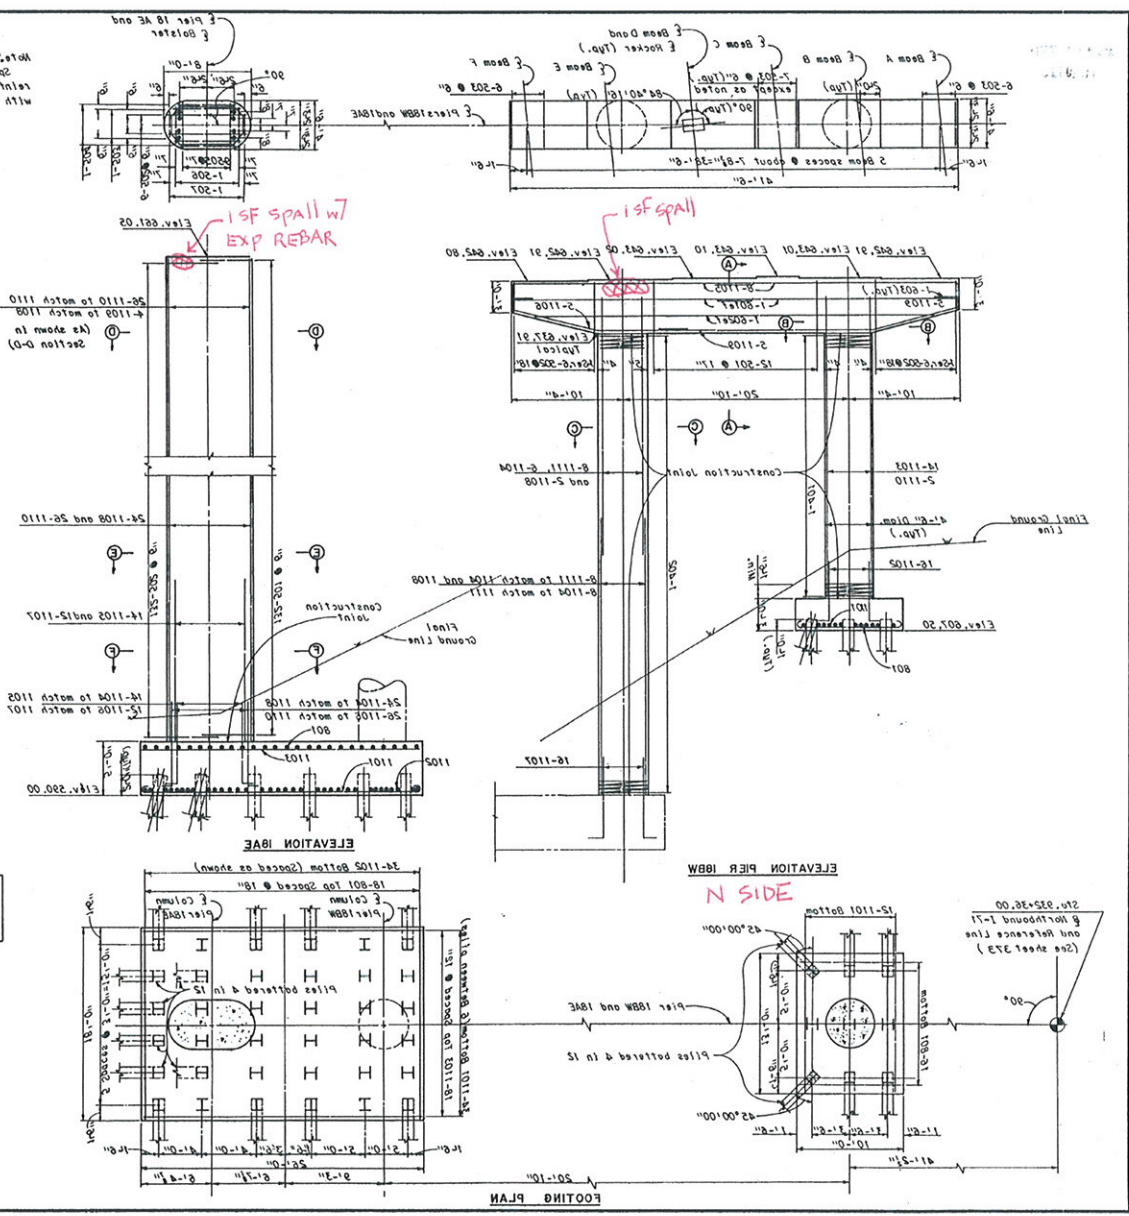


DATE: 11-17-83	DRAWN BY: J. J. [unclear]
CHECKED BY: [unclear]	DESIGNED BY: [unclear]
CUYAHOGA COUNTY	
STA 923+51.53	
BR. NO. CUY-71-1789	
AND NORTHBOUND JENNINGS	
NORTHBOUND I-75 OVER NORTHBOUND JENNINGS	
PIERS 18A & 18B	
KARAS CIVIL ENGINEERING NEW YORK	
HOWARD, HECKER, TAMMEN & BERENSON	
M.T.B. BRIDGE NO. 518 & 519	

CUYAHOGA COUNTY
CUY 71-17.83
CUY-176-12.76

Note: Elevations along backwall are given to top of 8x4ft angle of the end dam.

Note: Curb transition details are typical for both wingwalls.

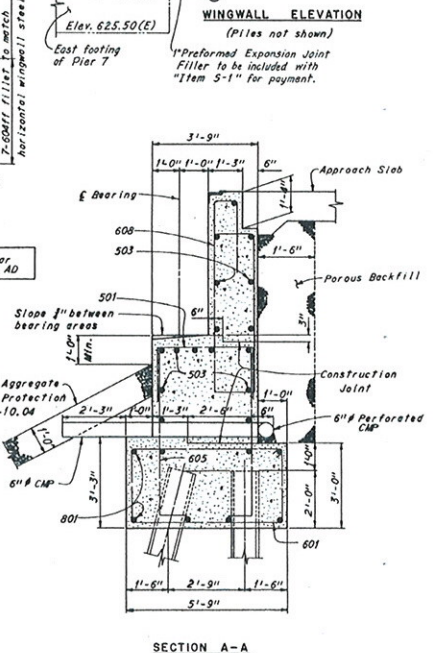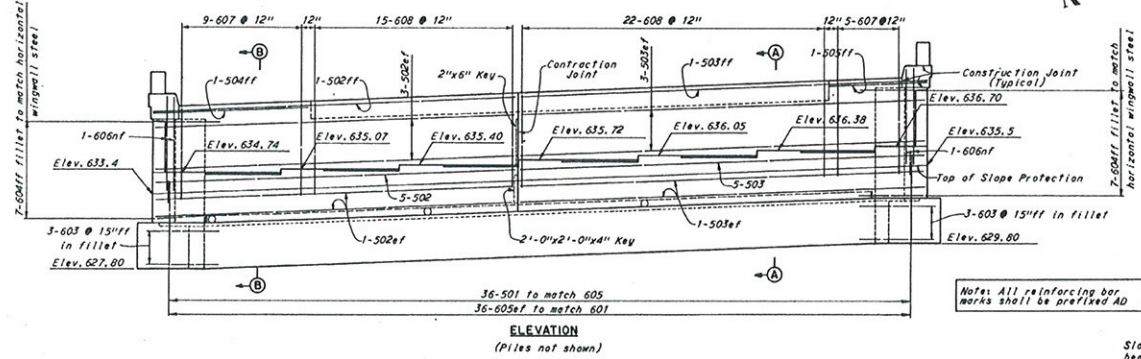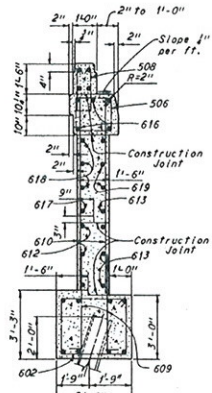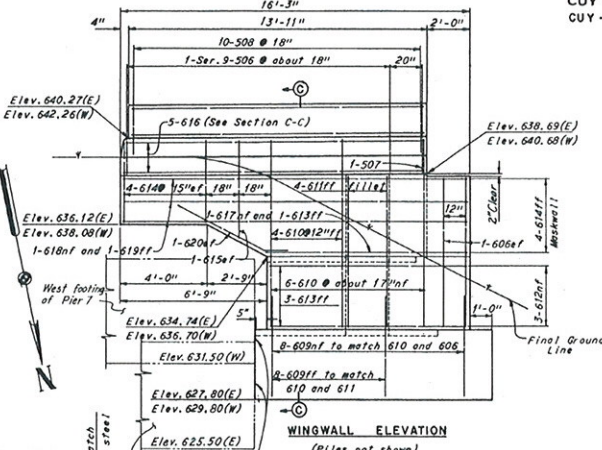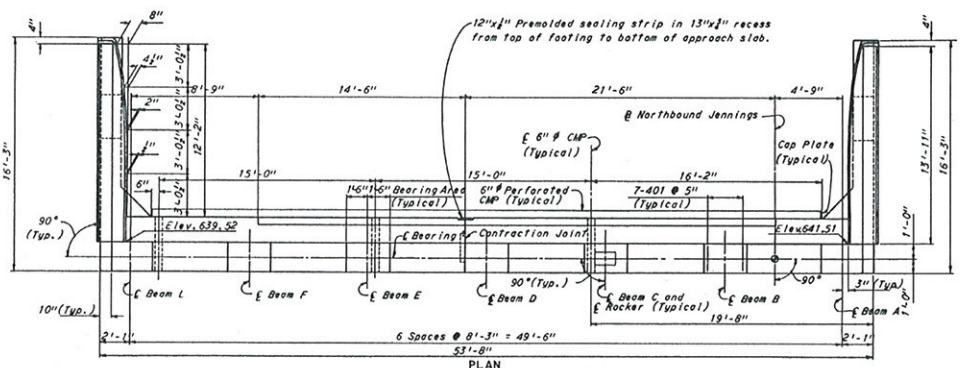

Notes: All piles shall be 12x13 steel bearing piles.
All battered piles shall be inclined 3 in 12 in the direction shown.
For Reinforcement Schedule and Bar Bending Diagrams see sheet 651.
For longitudinal reinforcement in the parapets see sheet 445.
For roadway end dam details see Ohio Standard Drawing, 30-1-62, sheets 2 and 4 of 4.
For railing details, see Ohio Standard Drawings AR-1-57.
Longitudinal footing reinforcement shall be field bent at dead lines as required.
Field bending of reinforcement shall be included in "Item S-4, Reinforcing Steel" for payment.
The following abbreviations are used:
nf = near face of = each face
ff = far face

M. H. B. BRIDGE NOS. 21A & 21B

HOWARD, NEEDLES, TAMMEN & BERGENOFF
CONSULTING ENGINEERS
KANSAS CITY, MISSOURI
NEW YORK

SOUTH ABUTMENT - B
NORTHBOUND I-71 OVER NORTHBOUND JENNINGS,
AND NORTHBOUND JENNINGS

BR. NO. CUY-71-1789R STA. 917+10.09
STA. 935+21.25

CLEVELAND CUYAHOGA COUNTY OHIO

DRAWN BY: TRACED BY: CHECKED BY: REVISIONS
DATE: 12-16-64 DATE: 04-28-1964 DATE: 7-22-64

SHEET 379





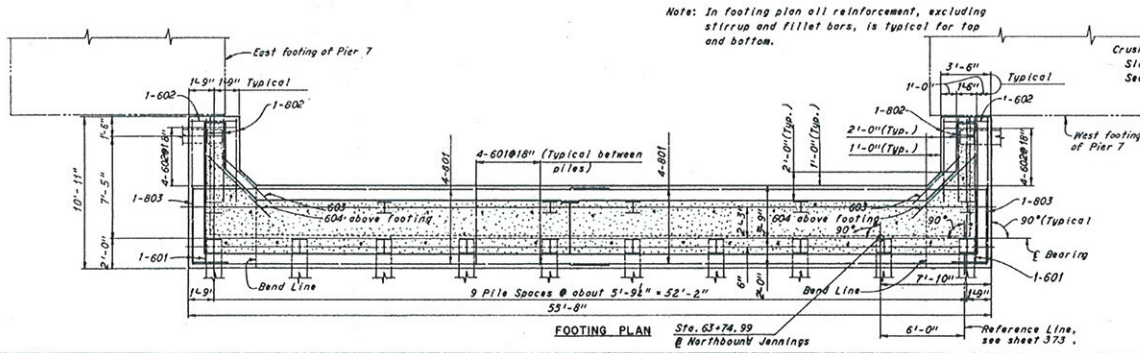




FIG. NO.	STATE	PROJECT	403
1	OHIO		646

CUYAHOGA COUNTY
 CUY 71-17.83
 CUY-176-12.76



Note: All reinforcing bar marks shall be prefixed as follows:
 Pier 19BW = PEE
 Pier 20BW = PFF

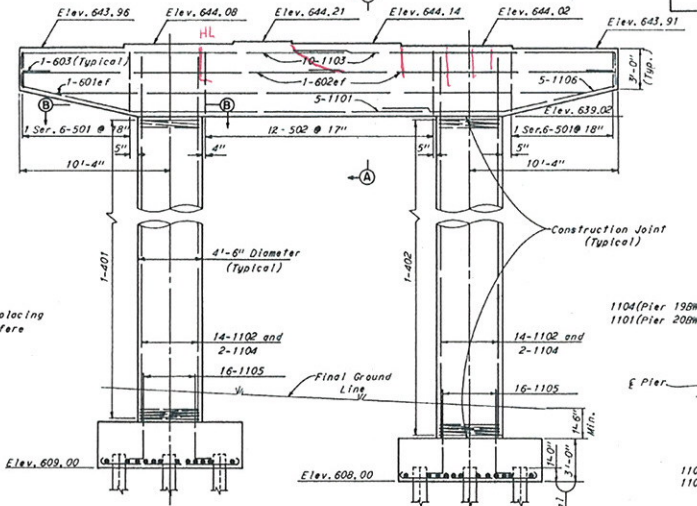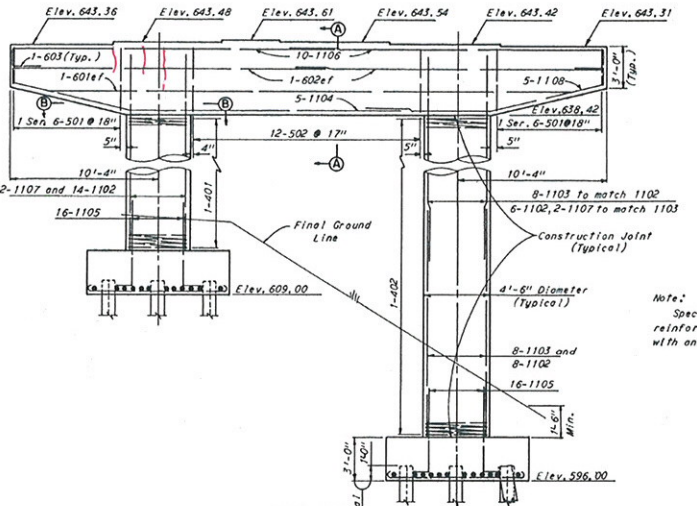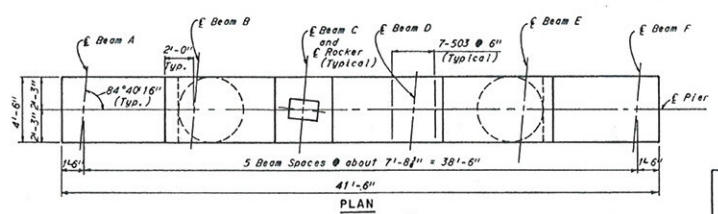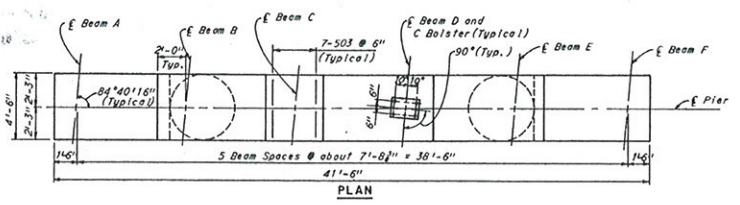

Note:
 Special care shall be taken when placing reinforcing steel so as not to interfere with anchor bolt setting.

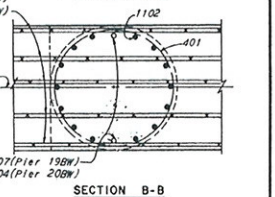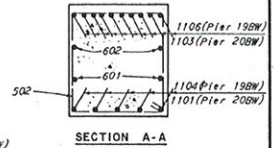

Notes:
 All piles are 12SP53.
 The following abbreviation is used:
 ef = each face
 For additional notes see Sheet 385.

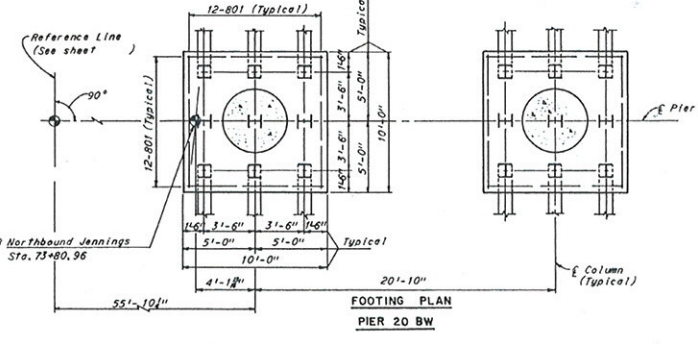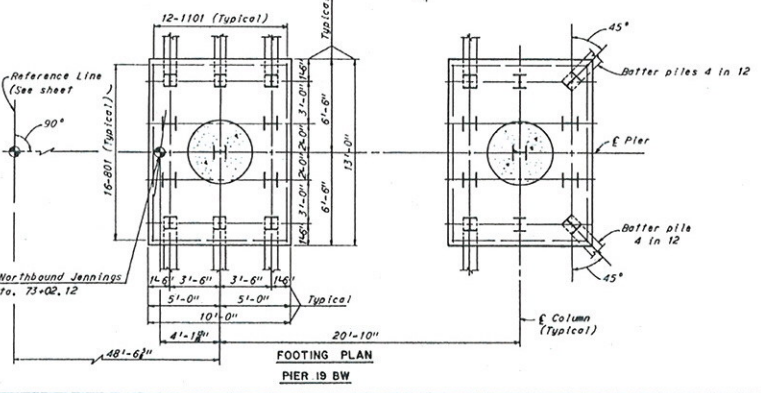


H.N.T.B. BRIDGE NOS. 21A & 21B		
HOWARD, NEEDLES, TAMMEN & BERGENDORF CONSULTING ENGINEERS KANSAS CITY, CLEVELAND, NEW YORK		
PIERS 19BW & 20BW		
NORTHBOUND I-71 OVER NORTHBOUND JENNINGS, AND NORTHBOUND JENNINGS		
BR. NO. CUY-71-1789 R	STA. 917+10.09	STA. 935+21.25
CLEVELAND	CUYAHOGA COUNTY	OHIO
DRAWN BY	TRACED	CHECKED BY
DATE	DATE	DATE
		10/26/24
		SHEET 403

S SIDE

NO. 403	DATE	PROJECT
3		







CUYAHOGA COUNTY
 CUY 17-17.83
 CUY-17B-12.7B

Note: All reinforcing bar marks shall be
 placed as follows:
 Pier 19BW = PEE
 Pier 20BW = PFF

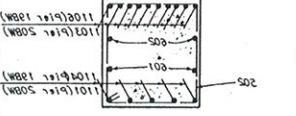

Note:
 All piles are 150#23.
 The following specification is used:
 #2 = steel deck
 For additional notes see sheet 38B.










M.T.B. BRIDGE NO. 214 B. 518
 HOWARD HEDGECOCK, ENGINEER
 CUYAHOGA COUNTY, OHIO
PIERS 19BW & 20BW
 NORTHBOND 1-71 OVER NORTHBOND JENNINGS
 AND NORTHBOND JENNINGS
 BR. NO. CUY-17-17.83 STA. 817+10.03
 STA. 832+51.25
 CLEVELAND CUYAHOGA COUNTY
 OHIO
 DRAWN BY: [Signature] CHECKED BY: [Signature] DATE: 12/25/24
 SHEET NO. 403

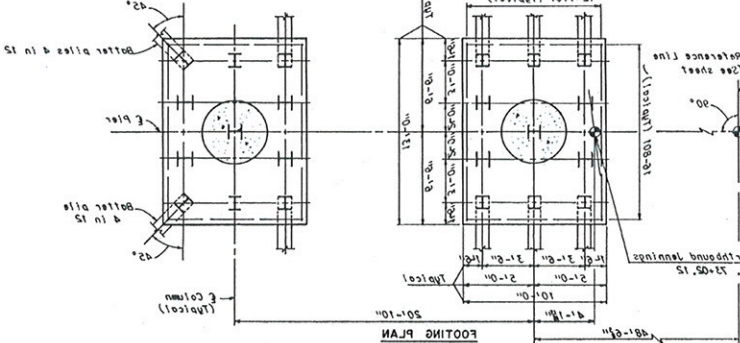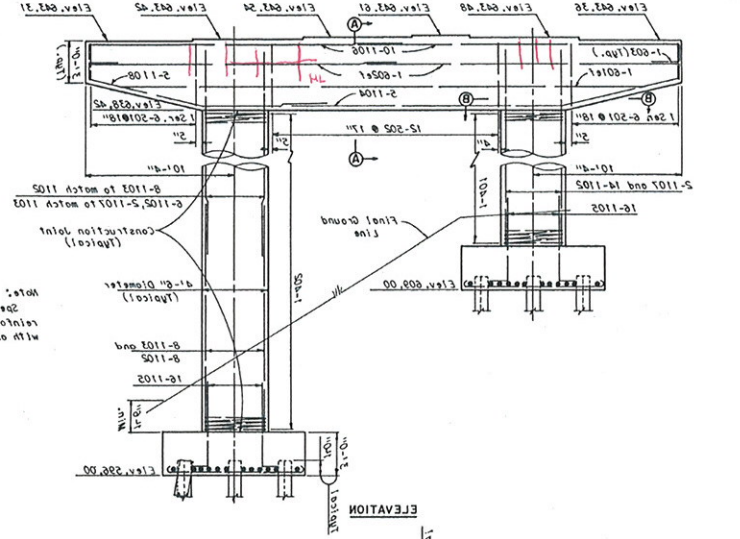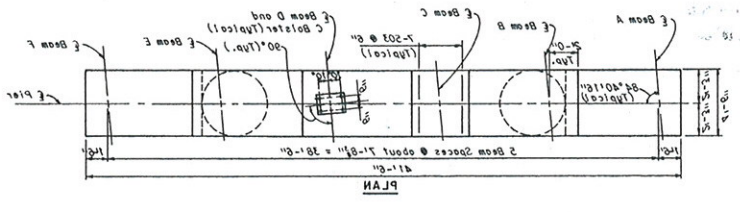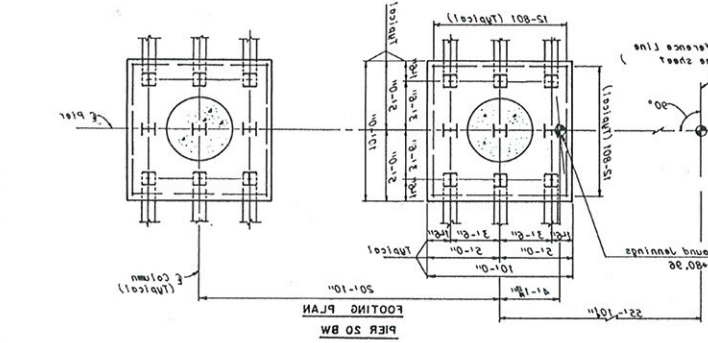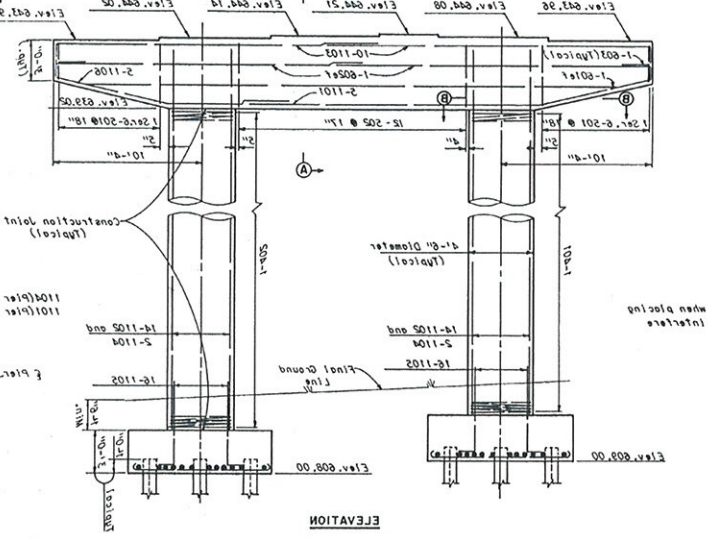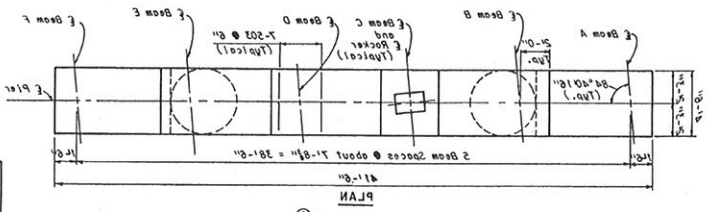

N SIDE

FED. RD. DIVISION	STATE	PROJECT	380 646
3	OHIO		

CUYAHOGA COUNTY
 CUY 71-17.83
 CUY-176-12.76

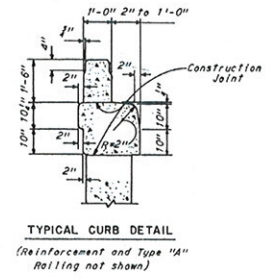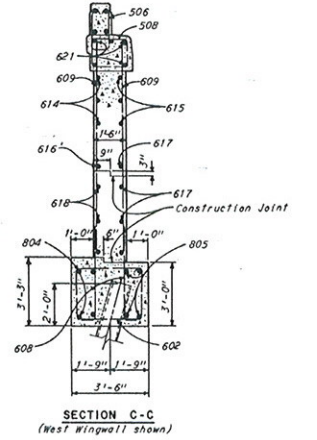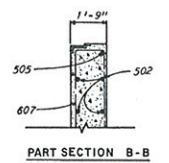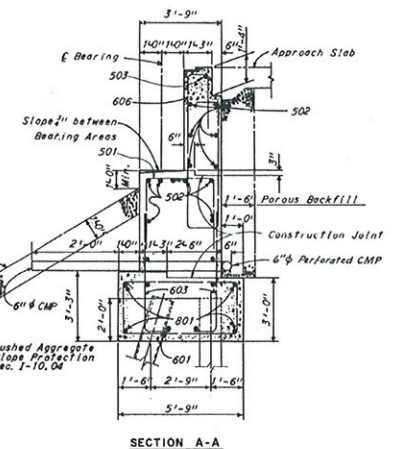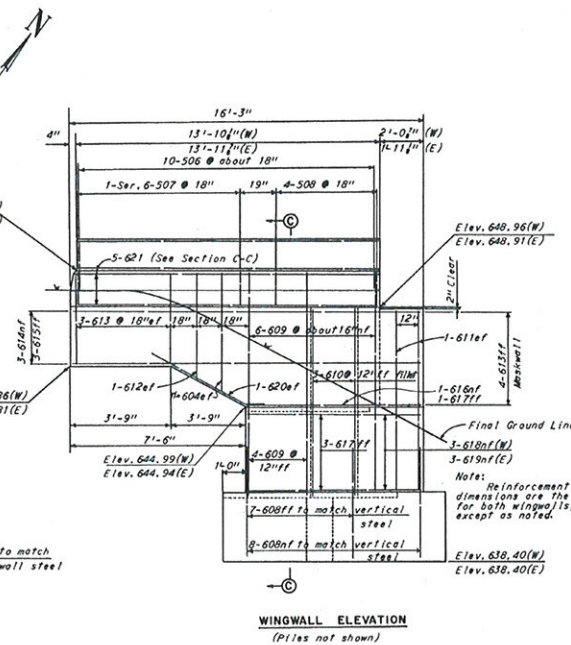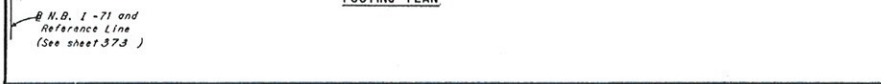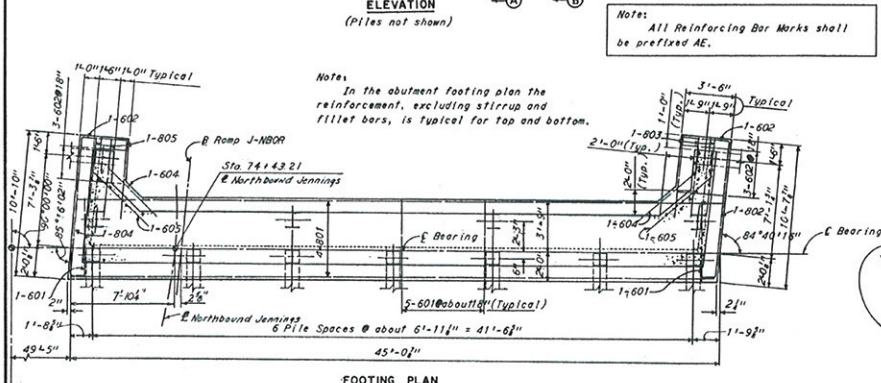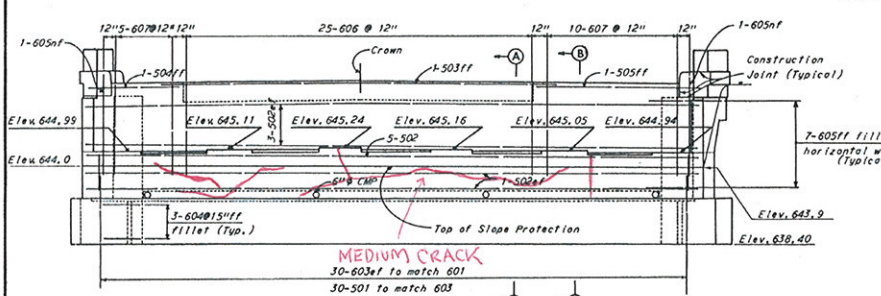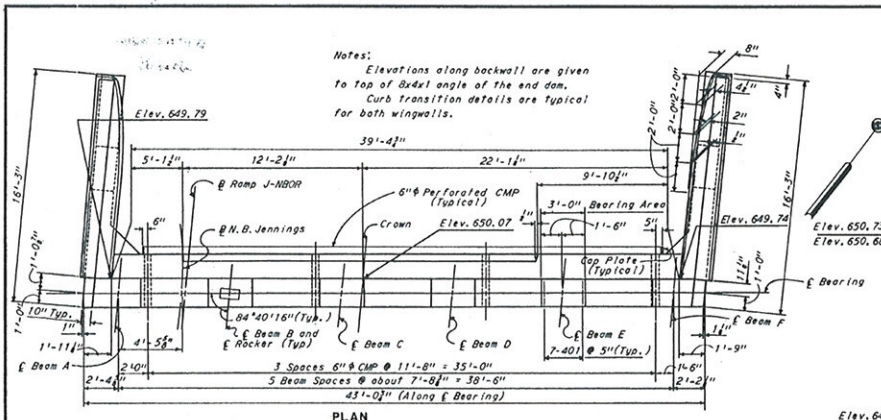

Notes:
 All piles shall be 12 PD 53 steel bearing piles.
 The following abbreviations are used:
 nf = near face
 ff = far face
 ef = each face
 (W) = West
 (E) = East
 For additional notes see Sheet 379.

H.K.T.B. BRIDGE NOS. 21A & 21B

HOWARD, NEEDLES, TAMMEN & BERENDOFF
 CONSULTING ENGINEERS
 KANSAS CITY, MISSOURI

NORTH ABUTMENT - BW
 NORTHBOUND I-71 OVER NORTHBOUND JENNINGS,
 AND NORTHBOUND JENNINGS

BR. NO. CUY-71-1789R STA. 917+10.09
 STA. 935+21.25






CLEVELAND CUYAHOGA COUNTY OHIO
 DRAWN BY: J. FRACCO CHECKED BY: J. FRACCO
 DATE: 2/16/61 DATE: 2/22/61

SHEET 390


1	OHIO	PROJECT
---	------	---------

CUYAHOGA COUNTY
CUY 71-17.83
CUY -176-12.76

Note:
Special care shall be taken when placing reinforcing steel so as not to interfere with anchor bolt setting.

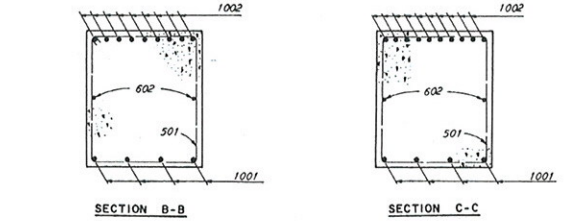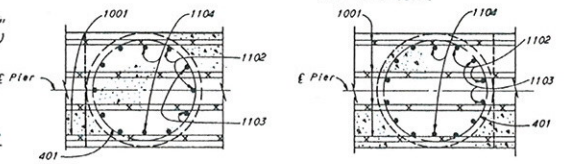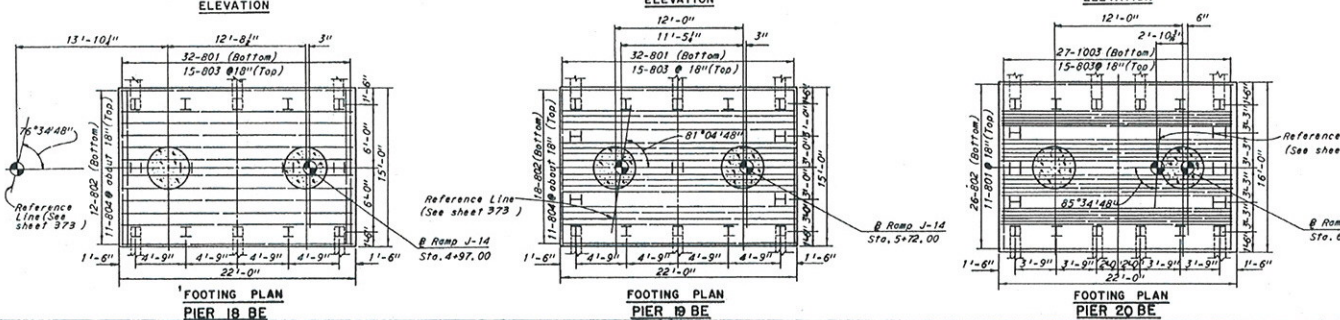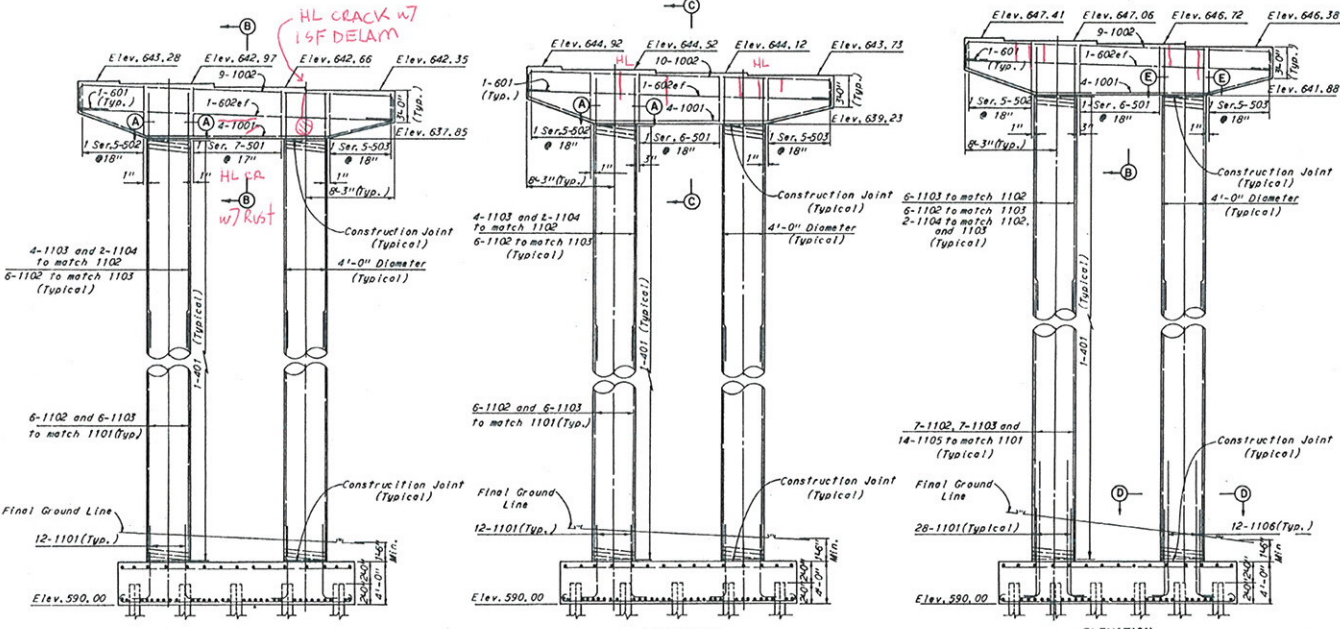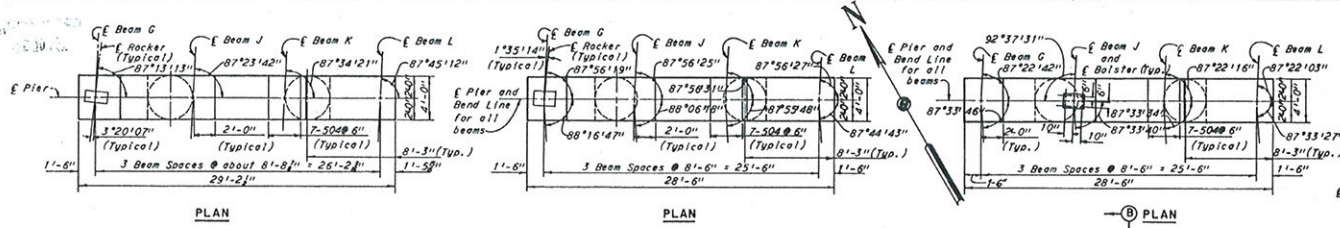

Note: All reinforcing bar marks shall be prefixed as follows:
Pier 18BE = PGG
Pier 19BE = PIH
Pier 20BE = PIJ

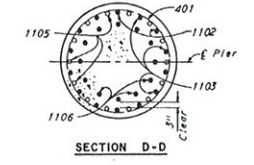

Note:
The following abbreviation is used:
et = each face
For additional notes see Sheet 385
All piles are 12 BP 53.

H.N.T.B. BRIDGE NOS. 21A & 21B
HOWARD, NEEDLES, TAMMEN & BERGENDOFF
CONSULTING ENGINEERS
KANSAAS CITY - CLEVELAND - NEW YORK

PIERS 18BE, 19BE, 20BE
NORTHBOUND I-71 OVER NORTHBOUND JENNINGS,
AND NORTHBOUND JENNINGS






BR. NO. CUY-71-1789R STA. 917+10.09
STA. 935+21.25

CLEVELAND CUYAHOGA COUNTY OHIO
DRAWN BY: P. THOMAS CHECKED BY: J. REVERE
DATE: 11-5-64 DATE: 11-22-64 SHEET 404

S SIDE

NO. OF SHEETS	NO. OF SHEETS
1	1








CUYAHOGA COUNTY
 CUY 17-18.83
 CUY-17E-12.7E

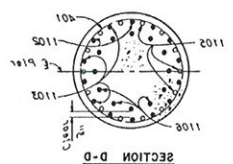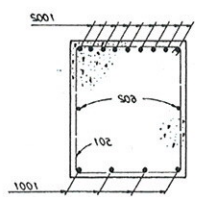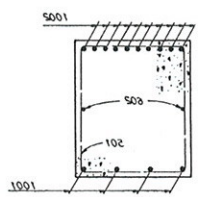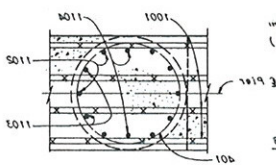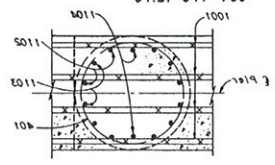

Note: All reinforcing bar marks shall be placed as follows:
 Pier 188E = POC
 Pier 188E = PNH
 Pier 508E = P77

Note:
 The following observation is used:
 of each face
 For additional notes see sheet 302
 All bars are 15B933

NOTE:
 Special care shall be taken when placing reinforcing steel so not to interfere with anchor bolt setting.




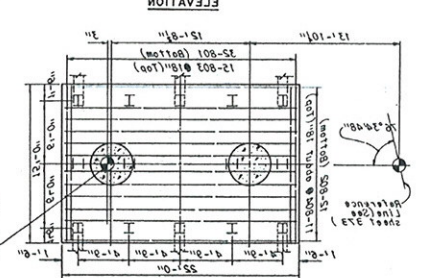
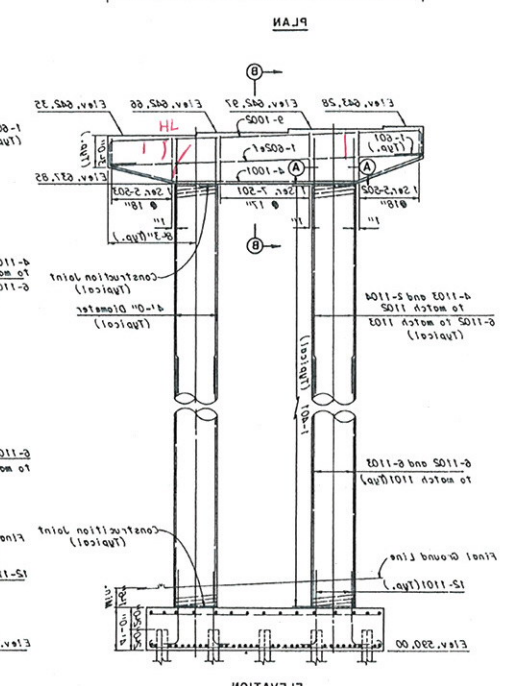
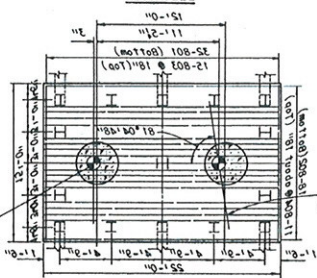
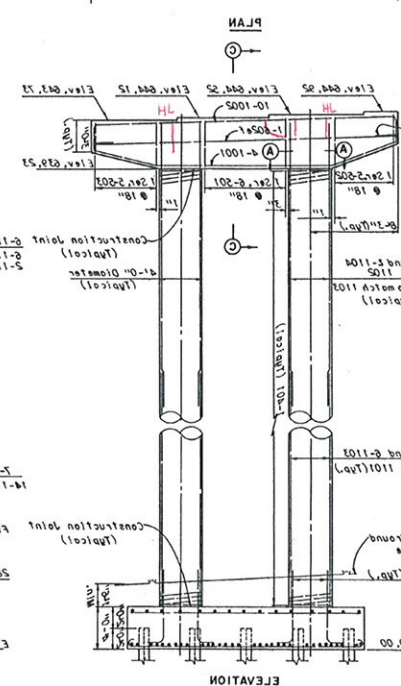
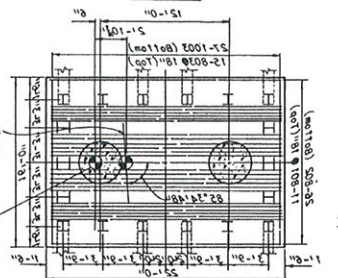
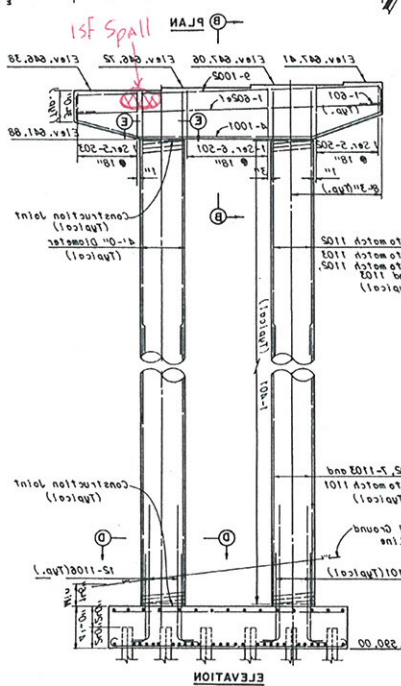
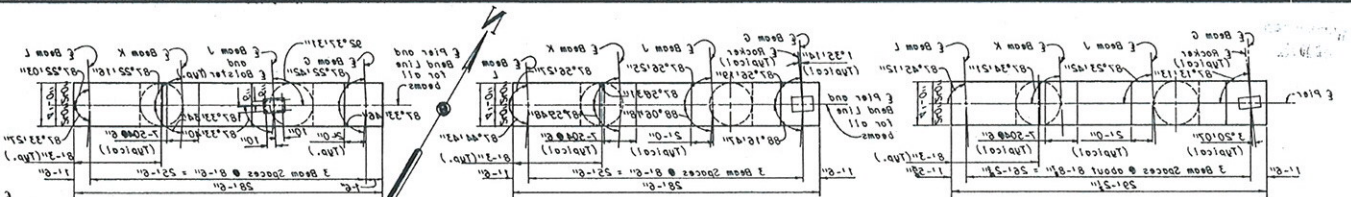


N SIDE

DATE: 11-24-01	DESIGNED BY: J. J. JONES	CHECKED BY: J. J. JONES	REVISED BY: J. J. JONES
CLEVELAND CUYAHOGA COUNTY, OHIO			
BR. NO. CUY-17-188R STA. 17+10.03 AND NORTHWARD TENDING			
PIERS 188E, 188E, 508E			
KERRA CIVIL ENGINEERING NEW YORK			
HOWARD, HEECH, TAMM & BERENSON			
N.H. & BRIDGE NO. 214 @ S18			

NO. 10	STATE	PROJECT	405 646
3	OHIO		

CUYAHOGA COUNTY
 CUY 71-17.83
 CUY-176-12.76

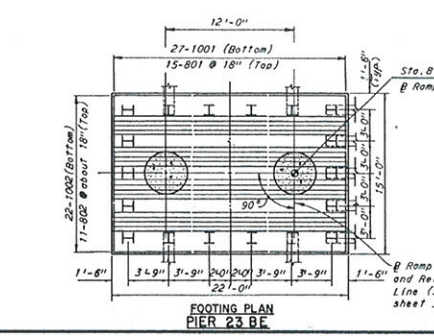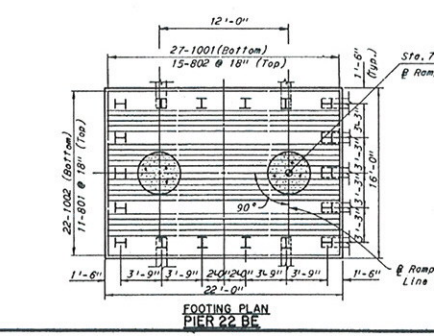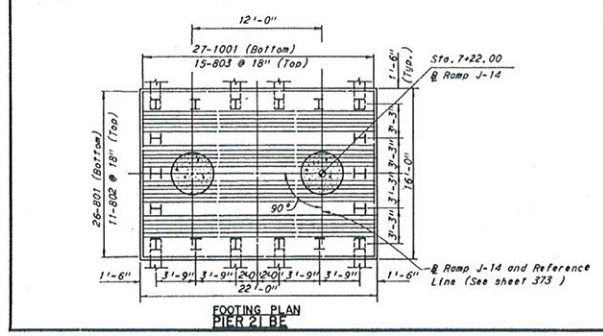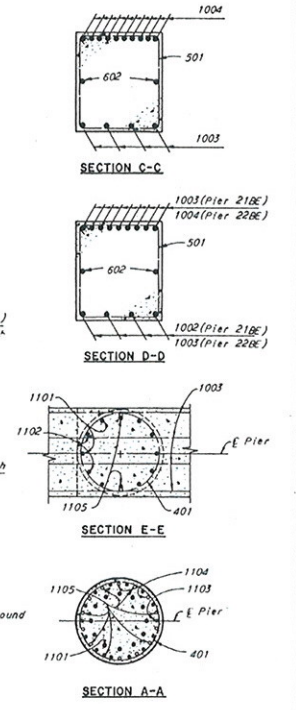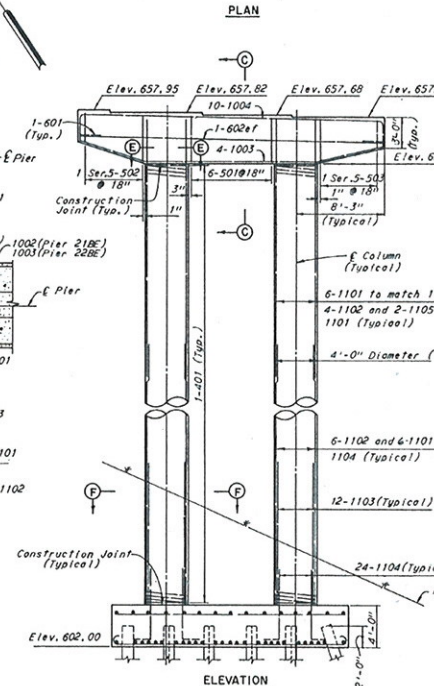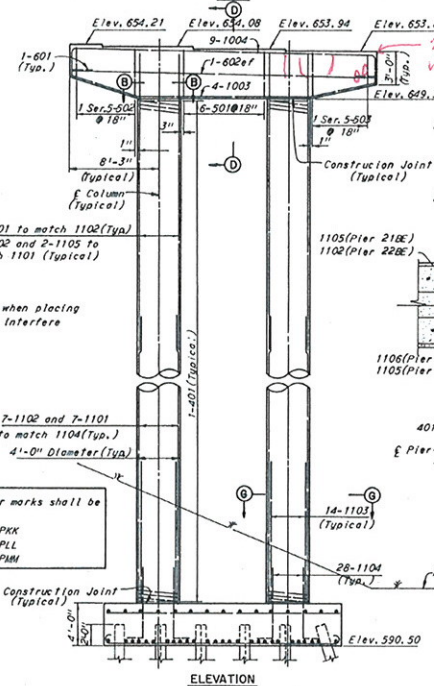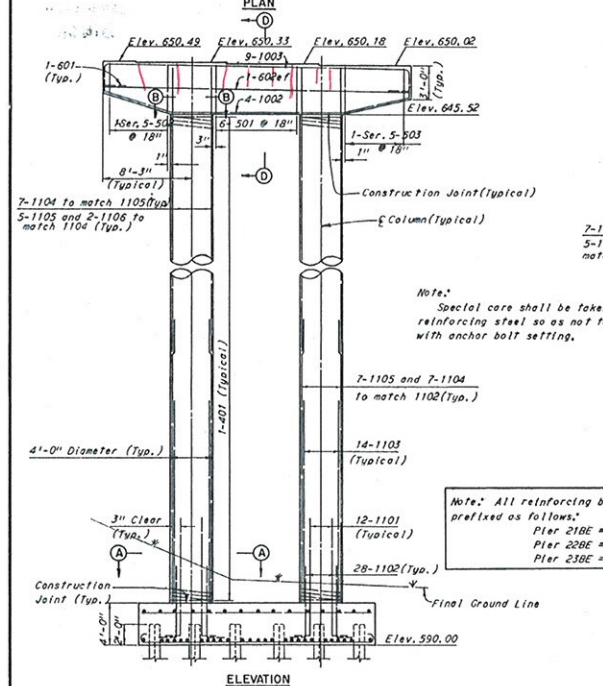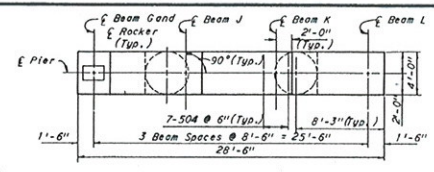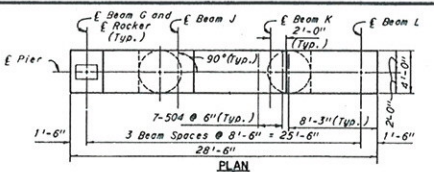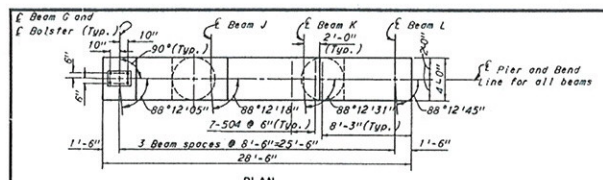

Notes:
 The following abbreviation is used:
 ef = each face
 For additional notes see Sheet 395.
 All piles are 12BP53.

H.N.T.S. BRIDGE NOS. 21A & 21B
 HOWARD, NEEDLES, TAMMEN & BERGENDOFF
 CONSULTING ENGINEERS
 KANSAS CITY, CLEVELAND, NEW YORK

PIERS 21BE, 22BE, 23BE
 NORTHBOUND I-71 OVER NORTHBOUND JENNINGS,
 AND NORTHBOUND JENNINGS





BR. NO. CUY-71-1789R STA. 917+10.09
 STA. 935+21.25

CLEVELAND OHIO
 DRAWN BY: TRACED CHECKED BY: REVERE
 DATE: 11-9-64 DATE: 11-22-64

S SIDE




1	DATE	PROJECT

CUYAHOGA COUNTY
 CUY 11-17-83
 CUY-118-15.78

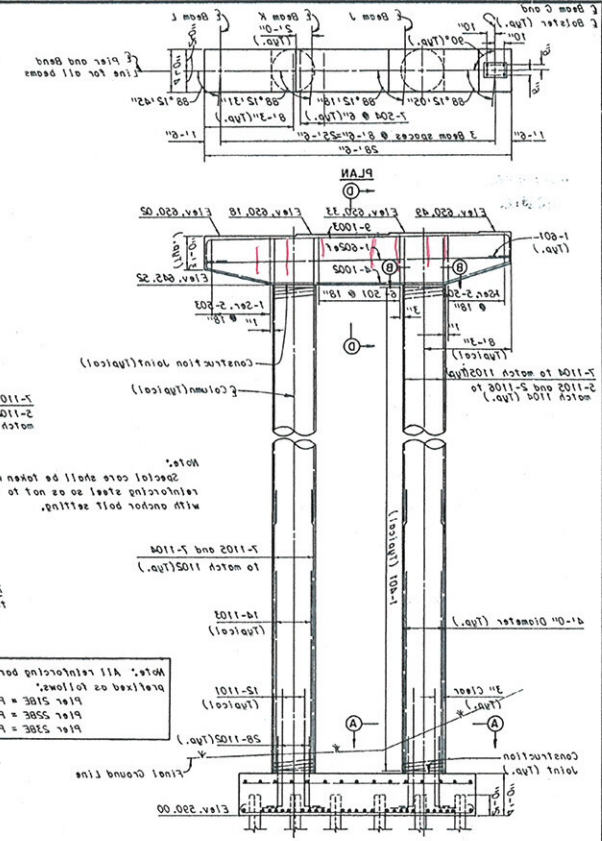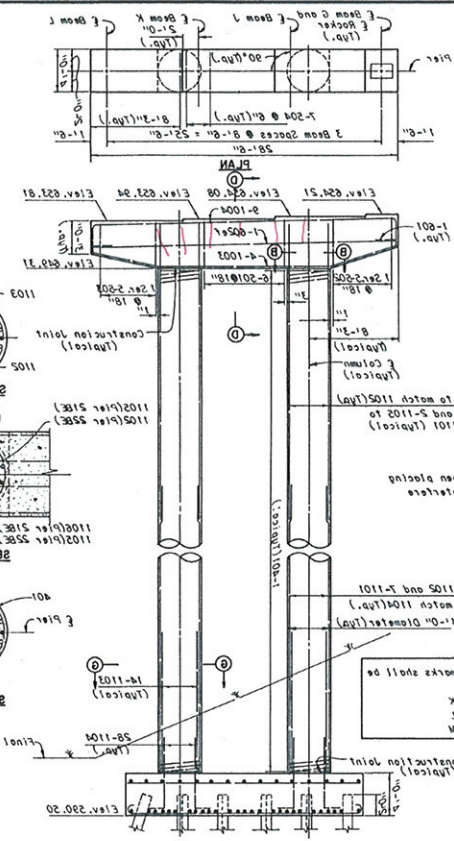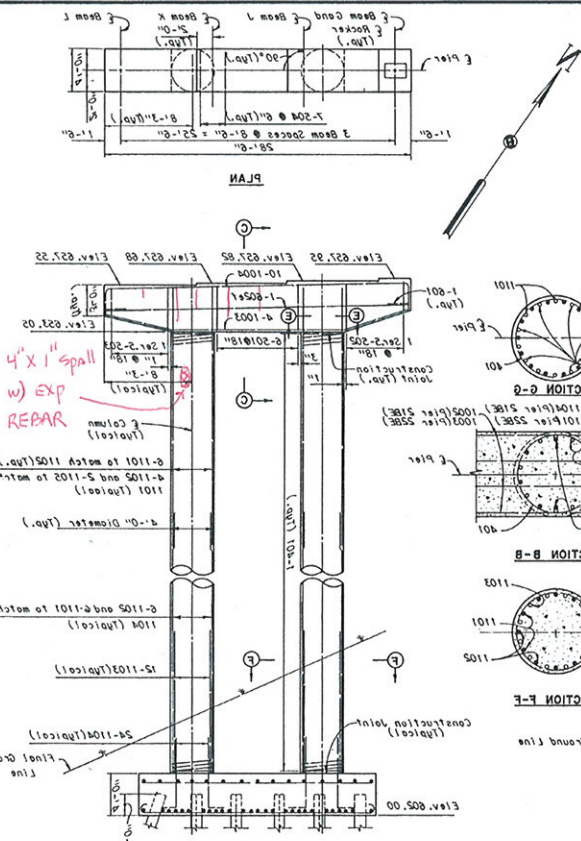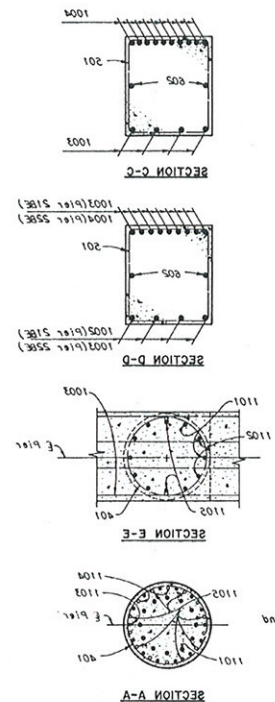

Notes:
 The following observation is noted:
 1/2" = each foot
 All other notes see sheet 382.
 All piles are 15.933.









BR. NO. CUY-11-1789	STA 817+10.00
CLEVELAND	CUYAHOGA COUNTY
DATE 11-17-83	BY 11/17/83
SCALE 1/2" = 1'-0"	PROJECT 118-15.78

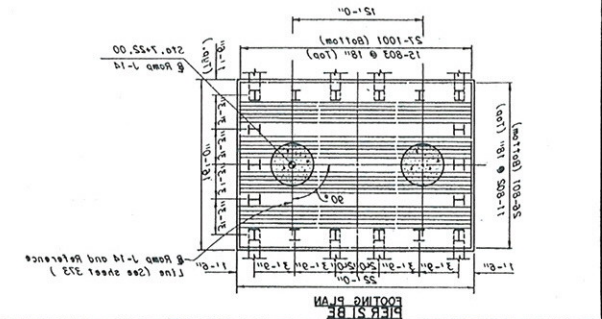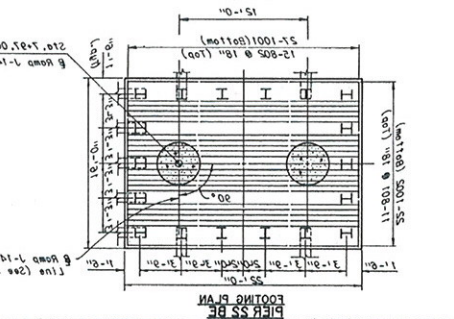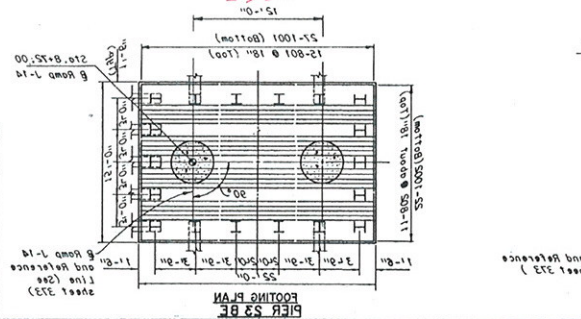

N SIDE

FIG. NO.	STATE	PROJECT	406 646
DIVISION	OHIO		

CUYAHOGA COUNTY
CUJ 71-17.83
CUY-176-12.76

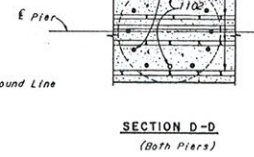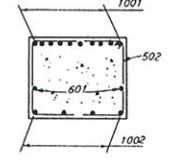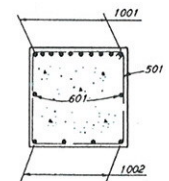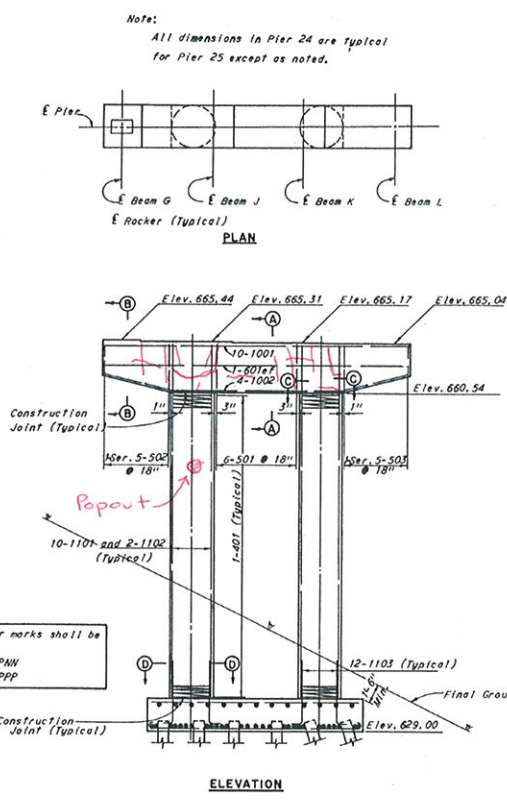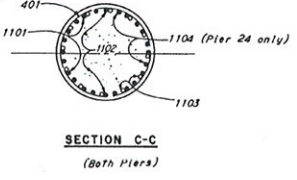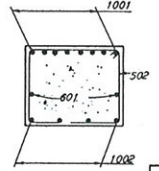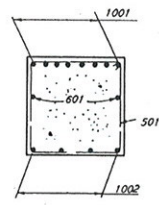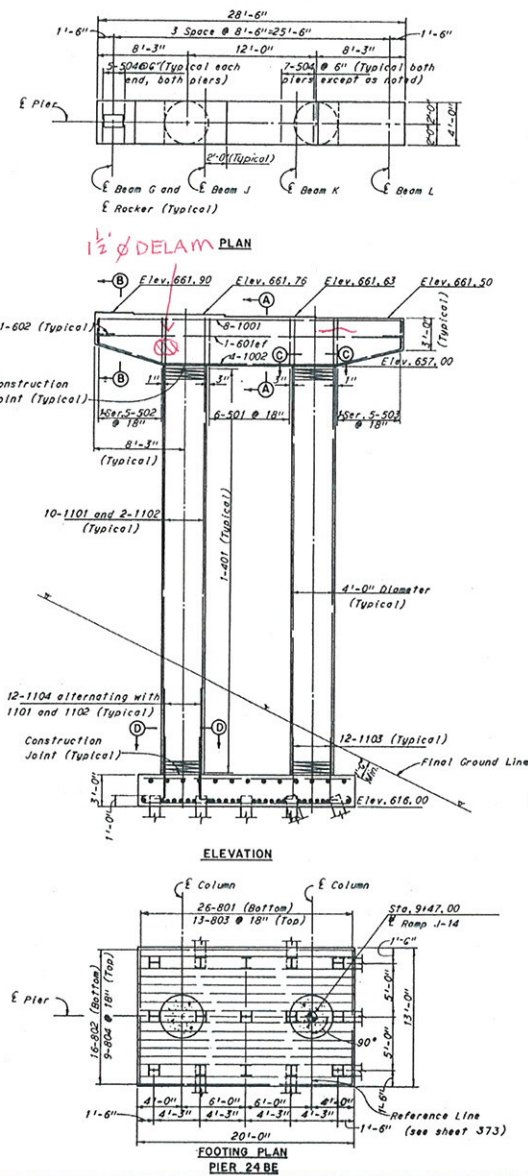

Note: All reinforcing bar marks shall be prefixed as follows:
Pier 24BE = PAN
Pier 25BE = PPP

Notes:
All piles are 128P53.
The following abbreviation is used:
af = each face
For additional notes see Sheet 395.

M.T.B BRIDGE NOS. 21A & 21B
HOWARD, NEEDLES, TAMMEN & BERGENDOFF
CONSULTING ENGINEERS
KANSAS CITY, MISSOURI
NEW YORK, NEW YORK
CLEVELAND, OHIO


PIERS 24BE & 25BE
NORTHBOUND I-71 OVER NORTHBOUND JENNINGS,
AND NORTHBOUND JENNINGS
BR. NO. CUY-71-1789R STA. 917+10.09
STA. 935+21.25

CLEVELAND CUYAHOGA COUNTY OHIO
DRAWN BY: JG TRACES CHECKED BY: JG NEW 6/6/97 REVISIONS:
DATE: 8-31-94 DATE: 12-12-94


S SIDE

PROJECT	NO. OF SHEETS	SHEET NO.
CUYAHOGA COUNTY	1	406


CUYAHOGA COUNTY
 CUY-TI-17.8
 CUY-17.8-12.78

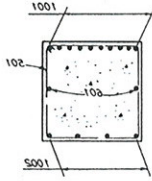

SECTION A-A

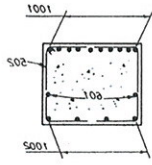


SECTION B-B

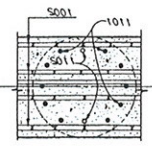


SECTION D-D

Notes:
 All piers are 1500±.
 The following observation is made:
 #7 each face
 For additional notes see sheet 302.


Note:
 All dimensions in Pier 24 are typical
 for Pier 25 except as noted.

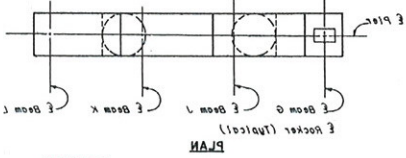


PLAN

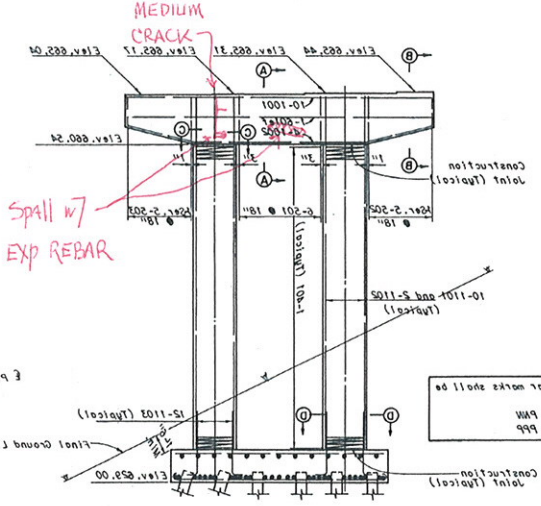


ELEVATION

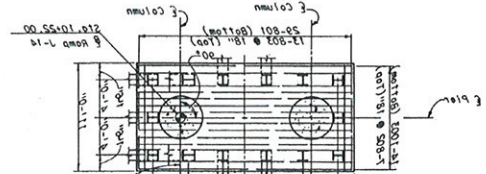


FOOTING PLAN
 PIER 24 BE

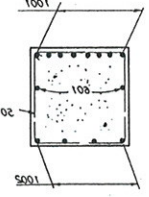


SECTION A-A

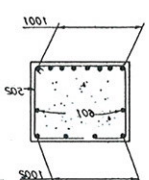


SECTION B-B

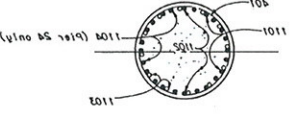


SECTION C-C

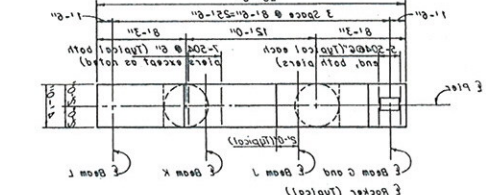

PLAN

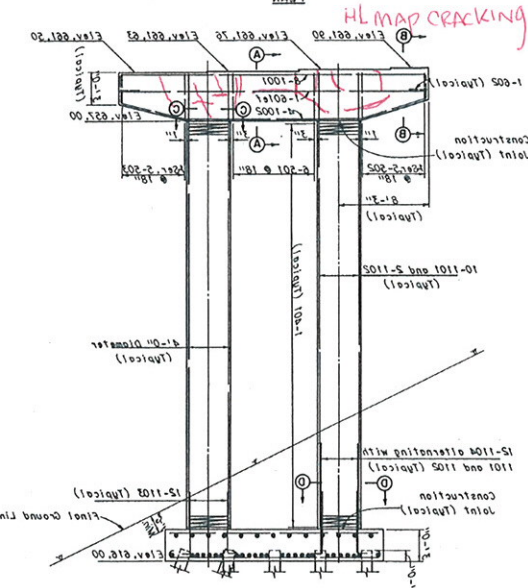

ELEVATION

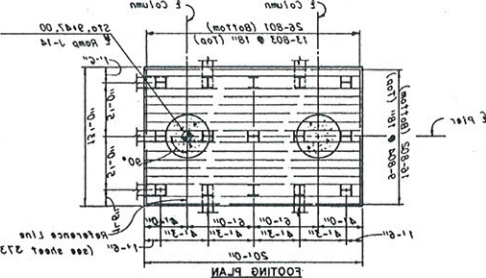

FOOTING PLAN
 PIER 24 BE

MEDIUM CRACK
 Spall w/ EXP REBAR

HL MAP CRACKING

Note: All reinforcing bar works shall be
 placed as follows:
 Pier 24 BE = PM
 Pier 25 BE = PPS



DATE: 12-12-11	BY: J.S.
CHECKED: J.S.	DATE: 12-12-11
DESIGNED: J.S.	DATE: 12-12-11
CLEVELAND COUNTY ENGINEERING	
BR. NO. CUY-TI-17.8 BR. STA. 932+51.28	
NORTHBOUND 1-71 OVER NORTHBOUND JENNINGS	
AND NORTHBOUND JENNINGS	
PIERS 24 BE & 25 BE	
KERRAS CIVIL ENGINEERING NEW YORK	
HOWARD, KEELER, TAMMEN & BERENSON	
N.T. & B. BRIDGE NO. 218 & 219	

N SIDE


DES. NO.	STATE	PROJECT	401 646
2	OHIO		

CUYAHOGA COUNTY
 CUY 71-17.83
 CUY-176-12.76


Notes:
 Special care shall be taken when placing reinforcing steel so as not to interfere with anchor bolt setting.

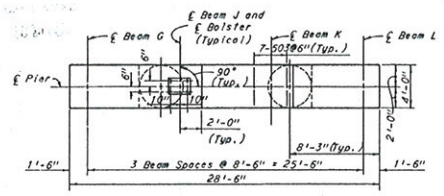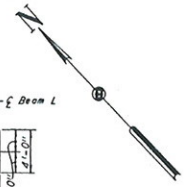


PLAN

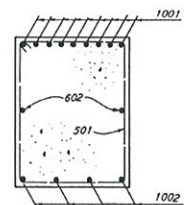


SECTION D-D

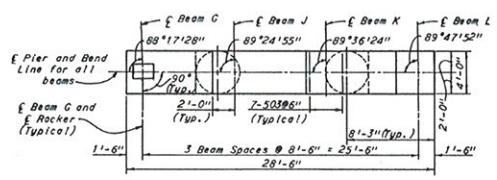


PLAN

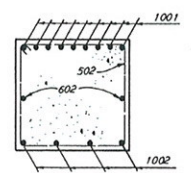


SECTION C-C

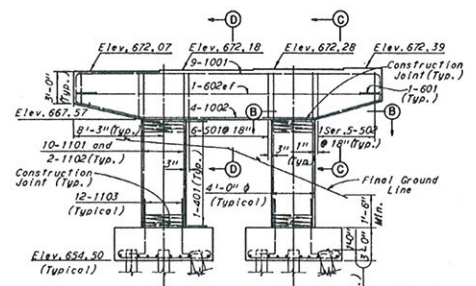


ELEVATION

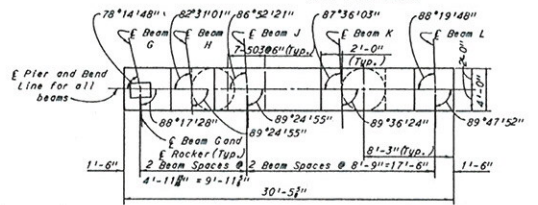


PLAN

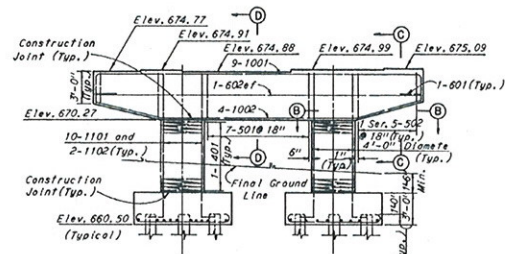


ELEVATION

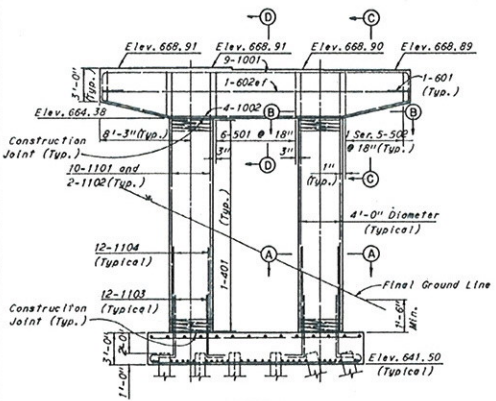


ELEVATION

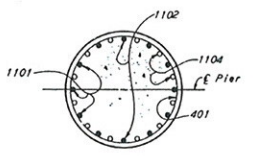


SECTION A-A

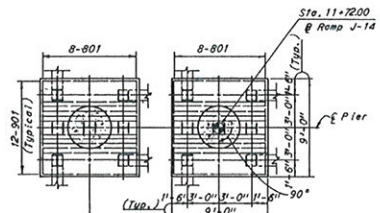

FOOTING PLAN
 PIER 27 BE

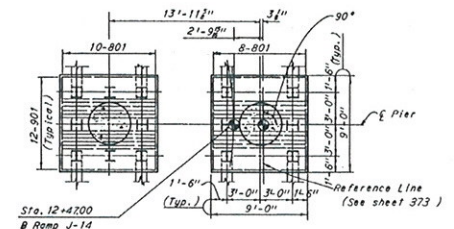

FOOTING PLAN
 PIER 28 BE

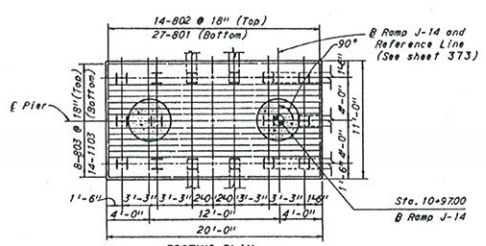

FOOTING PLAN
 PIER 26 BE

Notes: All reinforcing bar marks shall be prefixed as follows:
 Pier 26BE = PQQ
 Pier 27BE = PRR
 Pier 28BE = PSS


Notes:
 All piles are 128P53.
 The following abbreviation is used.
 of = each face
 For additional notes see Sheet 365.

H.N.T.B BRIDGE NOS. 21A & 21B	
HOWARD, NEEDLES, TAMMEN & BERGENDOFF CONSULTING ENGINEERS KANSAS CITY CLEVELAND NEW YORK	
PIERS 26BE, 27BE, 28BE	
NORTHBOUND I-71 OVER NORTHBOUND JENNINGS, AND NORTHBOUND JENNINGS	
BR. NO. CUY-71-1789 R	STA. 917+10.09 STA. 935+21.25
CLEVELAND	CUYAHOGA COUNTY OHIO
DRAWN: DJP	TRACED
DATE: 7-17-64	DATE: 8-22-64
CHECKED: JEM	REVIEWED: JEM
DATE: 7-17-64	DATE: 8-22-64
SHEET 407	

S SIDE


CUYAHOGA COUNTY
CUY 71-17.83
CUY-176-12.76

Note: Elevations along backwall are given to top of 8 x 4 x 1 angle of the end dam.

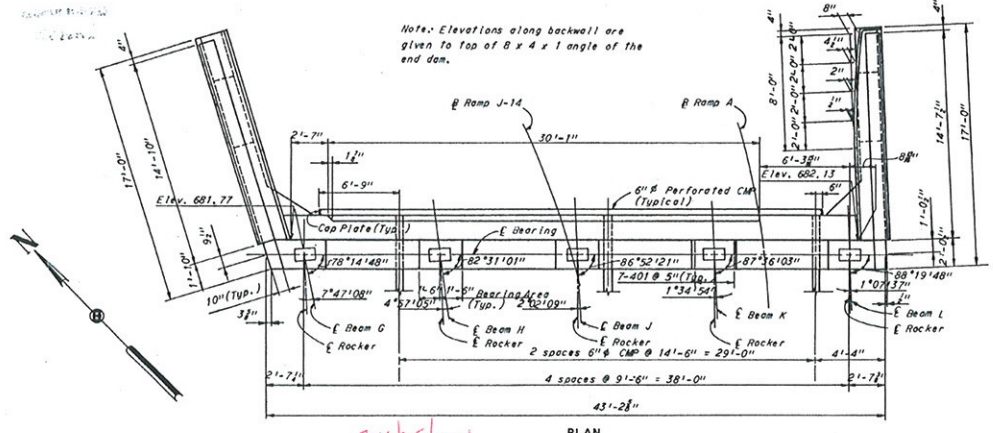


PLAN

RUST STAIN

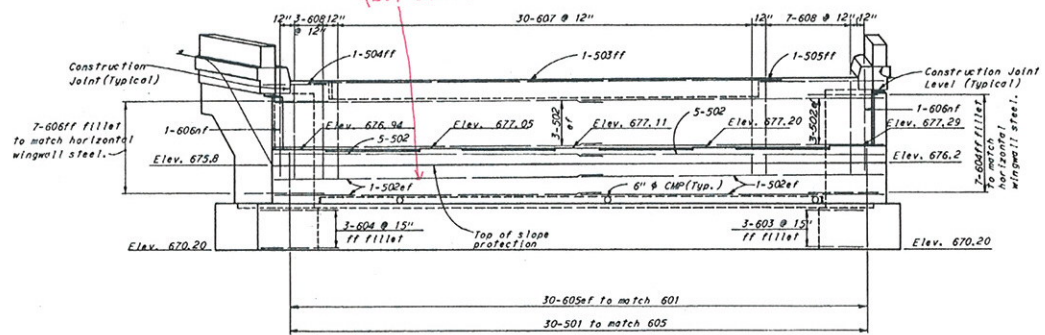


ELEVATION
(Piles Not Shown)


Note: All Reinforcing Bar Marks shall be prefixed AF.

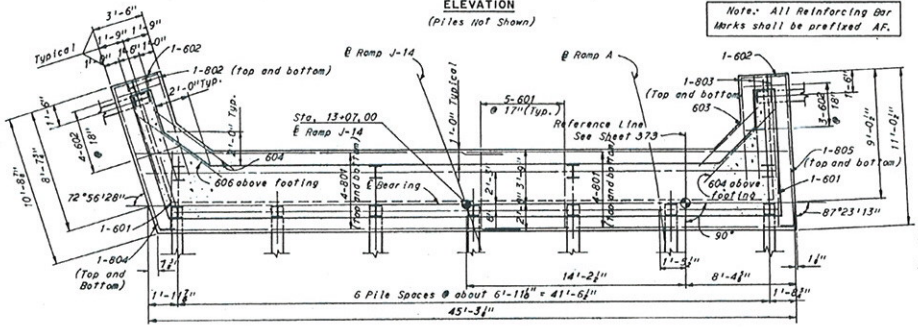


FOOTING PLAN

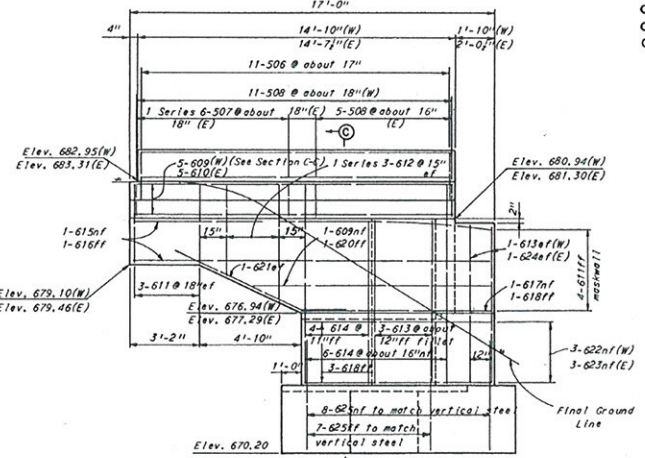


WINGWALL ELEVATION
(Piles not shown)

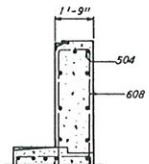


PART SECTION B-B

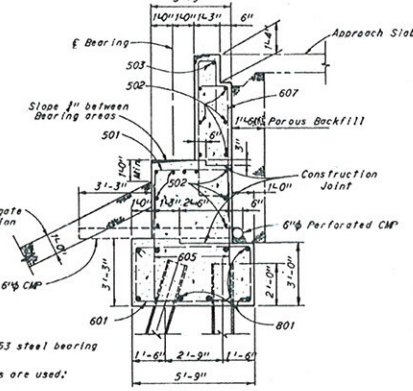

SECTION A-A

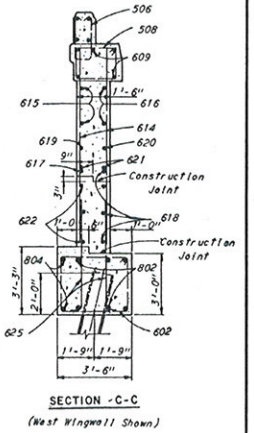

SECTION C-C
(West Wingwall Shown)

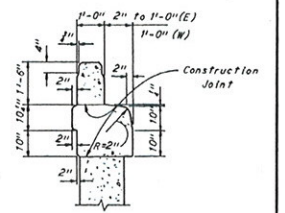

TYPICAL CURB DETAIL
(Reinforcement and Type "A")
(Rolling Not Shown)

Notes:
All piles shall be 12 BP 53 steel bearing piles.
The following abbreviations are used:
nf = near face
ff = far face
of = each face
W = West
E = East

For additional notes see Sheet 379.

H.W.T. BRIDGE NOS. 21A & 21B	
HOWARD, NEEDLES TAMMEN & BERGENDOFF CONSULTING ENGINEERS KANSAS CITY, CLEVELAND, NEW YORK	
NORTH ABUTMENT - BE	
NORTHBOUND I-71 OVER NORTHBOUND JENNINGS, AND NORTHBOUND JENNINGS	
BR. NO. CUY-71-1789 R	STA. 917+10.09
	STA. 935+21.25
CLEVELAND, OHIO	CUYAHOGA COUNTY, OHIO
DESIGNED BY	CHECKED BY
DRAWN BY	DATE
	DATE
	DATE
	SHEET 301

I-71/SR 176 Double Decked Bridge (SR 176 Lower Deck)
2012 In-Depth Bridge Inspection

APPENDIX G

Consultant Contract Bridge Inspection: Daily Work Activities Report

PID No: 87600	County/Route/Section: CUY/00071/1791 CUY/00176/1334	Date: 07/29/12
SFN: 1805371/1805436	BRIDGE NAME: I-71/SR 176 BRIDGES	
Contractor: HDR, Inc.		Sub-Contractor: Northwest Consulting, Inc.
Description of Work: (use back for detail) Inspected the lower deck using an A75 UBIV, Inspected the substructure from the ground and from the A75 UBIV.		

1) Labor

Name	Class	From	To	Regular Hrs	OT Hrs
Ann Griessmann – HDR	PE	7:00 pm	4:30 am	8.0	1.5
Michael Sondles - HDR	EI	7:00 pm	4:30 am	8.0	1.5
Mike Jennings – N.E. Bridge Contractors, Inc.		7:00 pm	4:30 am	8.0	1.5
A&A Safety – 2 traffic control personnel		6:00 pm	5:00 am	8.0	3.0

2) Equipment

A-Consultant Owned, B-Consultant Rented, C-ODOT Owned, D-ODOT Rented

A,B,C,D	Hrs Used	Hrs Idle	Year	Type	Model	HP, GVW, Capacity	Gas/Diesel/Elect	Equip No.
A	9.5	0	2009	2 Harnesses, lanyards, hand tools, helmets, gloves	Yates/ Miller			
B	1.0	9.5		Rental Car				
B	9.5	0		UBIV	A75			


3) Maintenance of Traffic

Location Description:	Direction	Lane No.	Time on	Time off
Single RT lane on SR 176	NB	3	7:00 pm	4:30 am
Local Law Enforcement notified?	Yes	Officer:		

4) Material

Quantity	Unit	Description
1		Binders for field notes
2		Paint Sticks

5) Signatures/Date

Contractor:	
ODOT:	

**Consultant Contract Bridge Inspection:
Daily Work Activities Report**

PID No: 87600	County/Route/Section: CUY/00071/1791 CUY/00176/1334	Date: 07/30/12
SFN: 1805371/1805436	BRIDGE NAME: I-71/SR 176 BRIDGES	
Contractor: HDR, Inc.		Sub-Contractor: Northwest Consulting, Inc.
Description of Work: (use back for detail) Inspected the lower deck and Ramp BE using an A75 UBIV. Inspected the substructure from the ground and from the A75 UBIV.		

1) Labor

Name	Class	From	To	Regular Hrs	OT Hrs
Ann Griessmann – HDR	PE	8:00 pm	4:00 am	8.0	
Michael Sondles - HDR	EI	8:00 pm	4:00 am	8.0	
Mike Jennings – N.E. Bridge Contractors, Inc.		8:00 pm	4:00 am	8.0	
A&A Safety – 2 traffic control personnel		7:00 pm	5:00 am	8.0	2.0

2) Equipment

A-Consultant Owned, B-Consultant Rented, C-ODOT Owned, D-ODOT Rented

A,B,C,D	Hrs Used	Hrs Idle	Year	Type	Model	HP, GVW, Capacity	Gas/Diesel/Elect	Equip No.
A	8	0	2009	2 Harnesses, lanyards, hand tools, helmets, gloves	Yates/ Miller			
B	1.0	8		Rental Car				
B	8	0		UBIV	A75			


3) Maintenance of Traffic

Location Description:	Direction	Lane No.	Time on	Time off
Single RT lane on SR 176; Closed Ramp BE at 1:00 am	NB	3	8:00 pm	4:00 am
Local Law Enforcement notified?	Yes	Officer:		

4) Material

Quantity	Unit	Description
1		Binders for field notes
2		Paint Sticks

5) Signatures/Date

Contractor: 
ODOT:

Consultant Contract Bridge Inspection: Daily Work Activities Report

PID No: 87600	County/Route/Section: CUY/00071/1791 CUY/00176/1334	Date: 07/31/12
SFN: 1805371/1805436	BRIDGE NAME: I-71/SR 176 BRIDGES	
Contractor: HDR, Inc.		Sub-Contractor: Northwest Consulting, Inc.
Description of Work: (use back for detail) Inspected the lower deck, Ramp BW, and Ramp BE using an A75 UBIV. Inspected the substructure from the ground and from the A75 UBIV.		

1) Labor

Name	Class	From	To	Regular Hrs	OT Hrs
Ann Griessmann – HDR	PE	8:00 pm	4:30 am	8.0	0.5
Michael Sondles - HDR	EI	8:00 pm	4:30 am	8.0	0.5
Mike Jennings – N.E. Bridge Contractors, Inc.		8:00 pm	4:30 am	8.0	0.5
A&A Safety – 2 traffic control personnel		7:00 pm	5:00 am	8.0	2.0

2) Equipment

A-Consultant Owned, B-Consultant Rented, C-ODOT Owned, D-ODOT Rented

A,B,C,D	Hrs Used	Hrs Idle	Year	Type	Model	HP, GVW, Capacity	Gas/Diesel/Elect	Equip No.
A	8.5	0	2009	2 Harnesses, lanyards, hand tools, helmets, gloves	Yates/ Miller			
B	1.0	8.5		Rental Car				
B	8.5	0		UBIV	A75			


3) Maintenance of Traffic

Location Description:	Direction	Lane No.	Time on	Time off
Double RT lane on SR 176; Closed Ramp BE at 1:00 am	NB	2 & 3	8:00 pm	4:30 am
Local Law Enforcement notified?	Yes	Officer:		

4) Material

Quantity	Unit	Description
1		Binders for field notes
2		Paint Sticks

5) Signatures/Date

Contractor:	
ODOT:	

Consultant Contract Bridge Inspection: Daily Work Activities Report

PID No: 87600	County/Route/Section: CUY/00071/1791 CUY/00176/1334	Date: 08/01/12
SFN: 1805371/1805436	BRIDGE NAME: I-71/SR 176 BRIDGES	
Contractor: HDR, Inc.		Sub-Contractor: Northwest Consulting, Inc.
Description of Work: (use back for detail) Inspected the upper deck using an A75 UBIV. Inspected the substructure from the A75 UBIV.		

1) Labor

Name	Class	From	To	Regular Hrs	OT Hrs
Ann Griessmann – HDR	PE	7:30 pm	4:00 am	8.0	0.5
Michael Sondles - HDR	EI	7:30 pm	4:00 am	8.0	0.5
Mike Jennings – N.E. Bridge Contractors, Inc.		7:30 pm	4:00 am	8.0	0.5
A&A Safety – 2 traffic control personnel		7:00 pm	5:00 am	8.0	2.0

2) Equipment

A-Consultant Owned, B-Consultant Rented, C-ODOT Owned, D-ODOT Rented

A,B,C,D	Hrs Used	Hrs Idle	Year	Type	Model	HP, GVW, Capacity	Gas/Diesel/Elect	Equip No.
A	8.5	0	2009	2 Harnesses, lanyards, hand tools, helmets, gloves	Yates/ Miller			
B	1.0	8.5		Rental Car				
B	8.5	0		UBIV	A75			


3) Maintenance of Traffic

Location Description:	Direction	Lane No.	Time on	Time off
Single LT lane on I-71; Single LT lane on SR 176	NB	1	7:30 pm	4:00 am
Local Law Enforcement notified?	Yes	Officer:		

4) Material

Quantity	Unit	Description
1		Binders for field notes
2		Paint Sticks

5) Signatures/Date

Contractor:	
ODOT:	

Consultant Contract Bridge Inspection: Daily Work Activities Report

PID No: 87600	County/Route/Section: CUY/00071/1791 CUY/00176/1334	Date: 08/02/12
SFN: 1805371/1805436	BRIDGE NAME: I-71/SR 176 BRIDGES	
Contractor: HDR, Inc.		Sub-Contractor: Northwest Consulting, Inc.
Description of Work: (use back for detail) Inspected the upper deck and Ramp AW using an A75 UBIV. Inspected the substructure from the ground and using the A75 UBIV.		

1) Labor

Name	Class	From	To	Regular Hrs	OT Hrs
Ann Griessmann – HDR	PE	7:30 pm	4:30 am	8.0	1.0
Michael Sondles - HDR	EI	7:30 pm	4:30 am	8.0	1.0
Mike Jennings – N.E. Bridge Contractors, Inc.		7:30 pm	4:30 am	8.0	1.0
A&A Safety – 2 traffic control personnel		7:00 pm	5:00 am	8.0	2.0

2) Equipment

A-Consultant Owned, B-Consultant Rented, C-ODOT Owned, D-ODOT Rented

A,B,C,D	Hrs Used	Hrs Idle	Year	Type	Model	HP, GVW, Capacity	Gas/Diesl/ Elect	Equip No.
A	9	0	2009	2 Harnesses, lanyards, hand tools, helmets, gloves	Yates/ Miller			
B	1.0	9		Rental Car				
B	9	0		UBIV	A75			


3) Maintenance of Traffic

Location Description:	Direction	Lane No.	Time on	Time off
Single LT lane on I-71; Single LT lane on SR 176	NB	1	7:30 pm	4:30 am
Local Law Enforcement notified?	Yes	Officer:		

4) Material

Quantity	Unit	Description
1		Binders for field notes
2		Paint Sticks

5) Signatures/Date

Contractor: 
ODOT:

**Consultant Contract Bridge Inspection:
Daily Work Activities Report**

PID No: 87600	County/Route/Section: CUY/00071/1791 CUY/00176/1334	Date: 08/05/12
SFN: 1805371/1805436	BRIDGE NAME: I-71/SR 176 BRIDGES	
Contractor: HDR, Inc.		Sub-Contractor: Northwest Consulting, Inc.
Description of Work: (use back for detail) Inspected the upper deck using an A75 UBIV. Inspected the substructure from the A75 UBIV.		

1) Labor

Name	Class	From	To	Regular Hrs	OT Hrs
Ann Griessmann – HDR	PE	7:30 pm	5:00 am	8.0	1.5
Michael Sondles - HDR	EI	7:30 pm	5:00 am	8.0	1.5
Mike Jennings – N.E. Bridge Contractors, Inc.		7:30 pm	5:00 am	8.0	1.5
A&A Safety – 2 traffic control personnel		7:00 pm	5:30 am	8.0	2.5

2) Equipment

A-Consultant Owned, B-Consultant Rented, C-ODOT Owned, D-ODOT Rented

A,B,C,D	Hrs Used	Hrs Idle	Year	Type	Model	HP, GVW, Capacity	Gas/Diesel/Elect	Equip No.
A	9.5	0	2009	2 Harnesses, lanyards, hand tools, helmets, gloves	Yates/ Miller			
B	1.0	9.5		Rental Car				
B	9.5	0		UBIV	A75			


3) Maintenance of Traffic

Location Description:	Direction	Lane No.	Time on	Time off
Single RT lane on I-71; Double RT lane on SR 176; Closed Ramp BE at 1:00 am	NB	3/(2 & 3)	7:30 pm	5:00 am
Local Law Enforcement notified?	Yes	Officer:		

4) Material

Quantity	Unit	Description
1		Binders for field notes
2		Paint Sticks

5) Signatures/Date

Contractor: 
ODOT:

**Consultant Contract Bridge Inspection:
Daily Work Activities Report**

PID No: 87600	County/Route/Section: CUY/00071/1791 CUY/00176/1334	Date: 08/06/12
SFN: 1805371/1805436	BRIDGE NAME: I-71/SR 176 BRIDGES	
Contractor: HDR, Inc.		Sub-Contractor: Northwest Consulting, Inc.
Description of Work: (use back for detail) Inspected the upper deck and Ramp AE using an A75 UBIV. Inspected the substructure from the ground and using the A75 UBIV.		

1) Labor

Name	Class	From	To	Regular Hrs	OT Hrs
Ann Griessmann – HDR	PE	7:30 pm	3:30 am	8.0	
Michael Sondles - HDR	EI	7:30 pm	3:30 am	8.0	
Mike Jennings – N.E. Bridge Contractors, Inc.		7:30 pm	3:30 am	8.0	
A&A Safety – 2 traffic control personnel		7:00 pm	4:00 am	8.0	1.0

2) Equipment

A-Consultant Owned, B-Consultant Rented, C-ODOT Owned, D-ODOT Rented

A,B,C,D	Hrs Used	Hrs Idle	Year	Type	Model	HP, GVW, Capacity	Gas/Diesel/Elect	Equip No.
A	8	0	2009	2 Harnesses, lanyards, hand tools, helmets, gloves	Yates/ Miller			
B	1.0	8		Rental Car				
B	8	0		UBIV	A75			


3) Maintenance of Traffic

Location Description:	Direction	Lane No.	Time on	Time off
Single RT lane on I-71; Double RT lane on SR 176. Single RT lane on I-71; Ramp under Span 3	NB	3/(2 & 3) 3/(1)	7:30 pm	3:30 am
Local Law Enforcement notified?	Yes	Officer:		

4) Material

Quantity	Unit	Description
1		Binders for field notes
2		Paint Sticks

5) Signatures/Date

Contractor: 
ODOT:

**Consultant Contract Bridge Inspection:
Daily Work Activities Report**

PID No: 87600	County/Route/Section: CUY/00071/1791 CUY/00176/1334	Date: 08/07/12
SFN: 1805371/1805436	BRIDGE NAME: I-71/SR 176 BRIDGES	
Contractor: HDR, Inc.		Sub-Contractor: Northwest Consulting, Inc.
Description of Work: (use back for detail) Inspected the upper deck using an A75 UBIV. Inspected the substructure from the ground and using the A75 UBIV.		

1) Labor

Name	Class	From	To	Regular Hrs	OT Hrs
Ann Griessmann – HDR	PE	8:00 pm	4:00 am	8.0	
Michael Sondles - HDR	EI	8:00 pm	4:00 am	8.0	
Mike Jennings – N.E. Bridge Contractors, Inc.		8:00 pm	4:00 am	8.0	
A&A Safety – 2 traffic control personnel		7:00 pm	5:00 am	8.0	2.0

2) Equipment

A-Consultant Owned, B-Consultant Rented, C-ODOT Owned, D-ODOT Rented

A,B,C,D	Hrs Used	Hrs Idle	Year	Type	Model	HP, GVW, Capacity	Gas/Diesel/ Elect	Equip No.
A	8	0	2009	2 Harnesses, lanyards, hand tools, helmets, gloves	Yates/ Miller			
B	1.0	8		Rental Car				
B	8	0		UBIV	A75			


3) Maintenance of Traffic

Location Description:	Direction	Lane No.	Time on	Time off
Single RT lane on I-71; Single RT lane on SR 176; Single RT lane under Span 2, then Single LT lane under Span 2	NB	3/(1 & 2 under Sp 2)	8:00 pm	4:00 am
Local Law Enforcement notified?	Yes	Officer:		

4) Material

Quantity	Unit	Description
1		Binders for field notes
2		Paint Sticks

5) Signatures/Date

Contractor: 
ODOT:

Consultant Contract Bridge Inspection: Daily Work Activities Report

PID No: 87600	County/Route/Section: CUY-71-1791 ; CUY-176-1331	Date: 7/30/12
SFN: 1805371 / 1805436	BRIDGE NAME: I-71 OVER SR-176	
Contractor: NORTHWEST CONSULTANTS		Sub-Contractor:
Description of Work: (use back for detail) DECK INSPECTION (SR-176)		

1) Labor

Name	Class	From	To	Regular Hrs	OT Hrs
JON DRUMMOND	PE	7:00 P	12:00 A	5.0	
JACK EBERT	EI	7:00 P	12:00 A	5.0	

2) Equipment

A-Consultant Owned, B-Consultant Rented, C-ODOT Owned, D-ODOT Rented

A,B,C,D	Hrs Used	Hrs Idle	Year	Type	Model	HP, GVW, Capacity	Gas/Diesel/Elect	Equip No.


3) Maintenance of Traffic

Location Description:	Direction	Lane No.	Time on	Time off
(BY HDR)				
Local Law Enforcement notified?	Officer:			

4) Material

Quantity	Unit	Description

5) Signatures/Date

Contractor:	
ODOT:	

Consultant Contract Bridge Inspection: Daily Work Activities Report

PID No: 87600	County/Route/Section: CUY-71-1791 ; CUY-176-1331	Date: 7/31/12
SFN: 1805371/1805436	BRIDGE NAME: I-71 OVER SR-176	
Contractor: NORTHWEST CONSULTANTS	Sub-Contractor:	
Description of Work: (use back for detail) DECK INSPECTION (SR-176)		

1) Labor

Name	Class	From	To	Regular Hrs	OT Hrs
JON DRUMMOND	PE	12:00 A	3:00 A	3.0	
JACK EBERT	EI	12:00 A	3:00 A	3.0	
		8:00 P	12:00 A	4.0	

2) Equipment

A-Consultant Owned, B-Consultant Rented, C-ODOT Owned, D-ODOT Rented

A,B,C,D	Hrs Used	Hrs Idle	Year	Type	Model	HP, GVW, Capacity	Gas/Diesel/Elect	Equip No.


3) Maintenance of Traffic

Location Description:	Direction	Lane No.	Time on	Time off
(BY HDR)				
Local Law Enforcement notified?	Officer:			

4) Material

Quantity	Unit	Description

5) Signatures/Date

Contractor:	
ODOT:	

**Consultant Contract Bridge Inspection:
Daily Work Activities Report**

PID No: 87600	County/Route/Section: CUY-71-1791 ; CUY-176-1331	Date: 8/1/12
SFN: 1805371/1805436	BRIDGE NAME: I-71 OVER SR-176	
Contractor: NORTHWEST CONSULTANTS	Sub-Contractor:	
Description of Work: (use back for detail) DECK INSPECTION (SR-176)		

1) Labor

Name	Class	From	To	Regular Hrs	OT Hrs
JON DRUMMOND	PE				
JACK EBERT	EI	12:00 A	4:00 A	4.0	

2) Equipment

A-Consultant Owned, B-Consultant Rented, C-ODOT Owned, D-ODOT Rented

A,B,C,D	Hrs Used	Hrs Idle	Year	Type	Model	HP, GVW, Capacity	Gas/Diesel/Elect	Equip No.


3) Maintenance of Traffic

Location Description:	Direction	Lane No.	Time on	Time off
(BY HDR)				
Local Law Enforcement notified?	Officer:			

4) Material

Quantity	Unit	Description

5) Signatures/Date

Contractor:	
ODOT:	

**Consultant Contract Bridge Inspection:
Daily Work Activities Report**

PID No: 87600	County/Route/Section: CUY-71-1791 ; CUY-176-1331	Date: 8/2/12
SFN: 1805371 / 1805436	BRIDGE NAME: I-71 OVER SR-176	
Contractor: NORTHWEST CONSULTANTS	Sub-Contractor:	
Description of Work: (use back for detail) DECK INSPECTION (I-71)		

1) Labor

Name	Class	From	To	Regular Hrs	OT Hrs
JON DRUMMOND	PE	7:00 P	12:00 A	5.0	
JACK EBERT	EI				

2) Equipment

A-Consultant Owned, B-Consultant Rented, C-ODOT Owned, D-ODOT Rented

A,B,C,D	Hrs Used	Hrs Idle	Year	Type	Model	HP, GVW, Capacity	Gas/Diesel/Elect	Equip No.


3) Maintenance of Traffic

Location Description:	Direction	Lane No.	Time on	Time off
(BY HDR)				
Local Law Enforcement notified?	Officer:			

4) Material

Quantity	Unit	Description

5) Signatures/Date

Contractor:	
ODOT:	

Consultant Contract Bridge Inspection: Daily Work Activities Report

PID No: 87600	County/Route/Section: CUY-71-1791 ; CUY-176-1331	Date: 8/3/12
SFN: 1805371 / 1805436	BRIDGE NAME: I-71 OVER SR-176	
Contractor: NORTHWEST CONSULTANTS		Sub-Contractor:
Description of Work: (use back for detail) DECK INSPECTION (I-71)		

1) Labor

Name	Class	From	To	Regular Hrs	OT Hrs
JON DRUMMOND	PE	12:00A	4:00A	4.0	
JACK EBERT	EI				

2) Equipment

A-Consultant Owned, B-Consultant Rented, C-ODOT Owned, D-ODOT Rented

A,B,C,D	Hrs Used	Hrs Idle	Year	Type	Model	HP, GVW, Capacity	Gas/Diesel/Elect	Equip No.


3) Maintenance of Traffic

Location Description:	Direction	Lane No.	Time on	Time off
(BY HPR)				
Local Law Enforcement notified?	Officer:			

4) Material

Quantity	Unit	Description

5) Signatures/Date

Contractor:	
ODOT:	