

BRIDGE INSPECTION REPORT

4301714
Structure File NumberBRIDGE NUMBER **LAK 0002 1656 R**YEAR BUILT **1964**DIST **12** Bridge Type **322** TYPE SERVICE **1 5** **GRAND RIVER**

DECK	out/out 36.9 Deck Area 9,784 sqft		3 LATEX MODIFIED CONCRETE OVERLAY	
1. FLOOR	1 REINF CONCRT (PRESTRSD, PRECAST)	1	2. WEARING SURFACE	Thk 1.2 2
3. CURBS, SIDEWALKS AND WALKWAYS	Left N NONE / Right N NONE		4. MEDIAN	Lanes on 2
5. RAILING	C 32" DEFLECTOR-TYPE PARAPET (NJ)	1	6. DRAINAGE	3 SCUPPERS & DWNSPTS 1
7. EXPANSION JOINTS	2 SLIDING METAL PLATE ANGLE	3	8. SUMMARY	6
SUPERSTRUCTURE			3 WELDED BUILT-UP STEEL	
9. ALIGNMENT	Max Spans 100	1	10. BEAMS/GIRDERS/SLAB	1
11. DIAPHRAGMS or CROSSFRAMES		1	12. JOISTS/STRINGERS	
13. FLOOR BEAMS			14. FLOOR BEAM CONNECTIONS	
15. VERTICALS			16. DIAGONALS	
17. END POSTS			18. TOP CHORD	
19. LOWER CHORD			20. LOWER LATERAL BRACING	
21. TOP LATERAL BRACING			22. SWAY BRACING	
23. PORTALS			24. BEARING DEVICES	2 ROCKERS 1
25. ARCH			26. ARCH COLUMNS or HANGERS	
27. SPANDREL WALLS			28. PROTECTIVE COATING SYSTEM	Paint Date 1/1/1992 0 OTHER 6
29. PINS/HANGERS/HINGES			30. FATIGUE PRONE CONNECTIONS	
31. LIVE LOAD RESPONSE		S	32. SUMMARY	7
SUBSTRUCTURE			5 STUB GRAVITY	
33. ABUTMENTS	5 STUB GRAVITY	1	34. ABUTMENT SEATS	Abutment: ON PILING 1
35. PIERS		1	36. PIER SEATS	2 CANTILEVER(TEE) OPEN PANEL Piers: NOT ON PILING 1
37. BACKWALLS		2	38. WINGWALLS	1
39. FENDERS and DOLPHINS	Piers = 02 NN NN Spans = 3		40. SCOUR	3 2
41. SLOPE PROTECTION	3 RIP RAP (DUMPED ROCK)	1	42. SUMMARY	Dive Date 12/30/1899 6
CULVERTS				
43. GENERAL	N NONE/NOT APPLICABLE		44. ALIGNMENT	
45. SHAPE			46. SEAMS	
47. HEADWALLS or ENDWALLS	Culvert Length 0		48. SCOUR	Culvert Fill Depth 0
49.			50. SUMMARY	
CHANNEL				
51. ALIGNMENT		1	52. PROTECTION	5 RIP RAP (DUMPED ROCK OR ROCK) 1
53. WATERWAY ADEQUACY	8 SLIGHT CHANCE OVERTOPPING	1	54. SUMMARY	7
APPROACHES				
55. PAVEMENT	2 BITUMINOUS	2	56. APPROACH SLABS	1
57. GUARDRAIL	1 STEEL BEAM	1	58. RELIEF JOINTS	1
59. EMBANKMENT		1	60. SUMMARY	Percent Legal = 150 6
GENERAL				
61. NAVIGATION LIGHTS			62. WARNING SIGNS	Maint Resp 1 OHIO TRAN DEPT
63. SIGN SUPPORTS	Signs on = N MVC on = 9999.9 Under C = 0		64. UTILITIES	
65. VERTICAL CLEARANCE	Under NC = 0	N	66. GENERAL APPRAISAL & OPERATIONAL STATUS	6 A
67. INSPECTED BY			68. REVIEWED BY	

SIGNED

PE Number

ACP
INITIALS

SIGNED

60048 MJM
PE Number INITIALS

DATE 9/24/2007

1 0 0 0 1 N N N
SURVEY

DATE 3/15/2008

DECK

FLOOR: TRANSVERSE CRACKS. 30 SF OF DELAMINATIONS.
5 SF OF SPALLS (MOSTLY HAUNCH). <1% DETERIORATED.
WEARING SURFACE: CRACKS. A FEW DELAMINATIONS. 1-5%
DETERIORATED.
RAILINGS: VERTICAL CRACKS.
EXPANSION JOINTS: TOP FLANGE OF RIGHT GIRDER TOUCHING FINISH
BACKWALL. START ABUTMENT BEAMS 2,3 AND 4 ARE <1/2" FROM
BACKWALL. 75-F.

SUPERSTRUCTURE

BEAMS: A FEW AREAS OF RUSTING SECTION LOSS AT BEAM ENDS.
XFRAMES: SOME RUSTING SECTION LOSS TO ENDFRAMES.
PAINT: GIRDERS ARE RUSTING NEAR LOWER ENDS OF DOWNSPOUTS
WHICH ARE 3.5" BELOW BOTTOM FLANGES. PAINT FAILING AT BEAM
ENDS. PAINT IS 5-10% DETERIORATED.

SUBSTRUCTURE

BACKWALLS: DELAMINATIONS. CRACKS MOSTLY NEAR TOPS OF BW.
WINGWALLS: SCALING. A FEW CRACKS AND SPALLS.
SCOUR: PIER 1 HAS SOME TOP HORIZONTAL SURFACE EXPOSURE OF
FOOTER AND PIER 2 HAS VERTICAL FACE EXPOSURE WITH NO
UNDERMINING, SEE DIVER REPORT FROM MARINE SOLUTIONS, INC.
FROM 9/24/07, FOR DETAILS.

CHANNEL

APPROACHES

PAVEMENT: MINOR SPALLS AT START EXPANSION JOINT. ASPHALT
PATCHES ON TOP OF FINISH BACKWALL. SOME AREAS OF BREAKING UP
PAVEMENT TO TOPS OF BOTH BACKWALLS.
GUARDRAIL: MINOR COLLISION DAMAGE TO FINISH-RIGHT (SE).

GENERAL

QAR 2007 12-0001.

4301714

Structural File Number

LAK-00002-1656R

Bridge Number

September 24, 2007

Inspection Date

Underwater Inspection Report for:

State Route 2 over Grand River
Lake County, Ohio
(Three Span Steel Beam Bridge)



General Elevation View

Personnel on site during inspection:

ODOT

Ms. Andrea Persanyi

Contractor

Mr. Don W. Wilkins (Primary Diver/ Supervisor)

Mr. James A. Ritchie (Backup Diver/ Inspector)

Mr. Brian B. Butler (Tender)

Prepared for:

ODOT District 12

5500 Transportation Blvd

Garfield Heights, Ohio 44125

Prepared by:



Marine Solutions, Inc.

250 Gold Rush Drive, Suite 4

Lexington, Kentucky 40503

Phone: (859) 260-1055

awilkins@MSIdiving.com

4301714

Structural File Number

LAK-00002-1656R

Bridge Number

September 24, 2007

Inspection Date

Table of Contents

Section	Page No.
1. Introduction.....	1
2. Description of Structure	1
3. Inspection Procedure.....	1
4. Observed Conditions	1
5. Conclusions.....	2

List of Appendixes

Appendix

Appendix A Photographs

Appendix B Figures

1. Introduction

Marine Solutions, Inc (MSI) conducted a routine underwater inspection of the LAK-00002-1656R bridge over Grand River located in Lake County, Ohio. The inspection was completed on September 24, 2007. Details of the inspection, along with observed conditions and conclusions, are provided within this report. Supplemental drawings, pictures and a location map are provided within the Appendixes.

2. Description of Structure

Bridge LAK-00002-1656R (SFN 4301714) carries State Route 2 over Grand River and is located in Lake County, Ohio. The bridge has an overall length of approximately 265 feet. The structure is a three span steel beam bridge supported by two concrete piers and two abutments.

3. Inspection Procedure

The inspection was performed on September 24, 2007. A visual/tactile inspection was performed on the portions of the piers located below the water surface. Soundings were performed up to 30 feet out from each face of the pier. Original plans were not available for review.

Inspection Mode: *Surface Supplied Air diving (SSA)*

Flow Direction / Velocity: *North/ < 1 knot*

Channel Bottom: *Silt, sand, gravel and bedrock*

Scour Checked By: *N/A*

Equipment Used: *Superlite 37 Helmet with hardwire communication to surface,, wet suit, digital camera, survey rod, lights*

Hazards Encountered: *< 2 ft of visibility*

Hydrographic Reference: *Top of Pier 1L to the water surface, 13.8 feet on the downstream face*

4. Observed Conditions

Piers 1R and 2R

- The bottom material consists of silt, sand, gravel and bedrock.
- Light to moderate scaling is present on the concrete surface of the piers below the water surface.
- Light biological growth is present on the concrete surface of the piers below the water surface.
- The footing on Pier 1R is exposed on all faces.
- The footing on Pier 2R is exposed only in the center of the south face measuring approximately 3 feet wide.
- The top of footing on both piers is located 3.7 feet below the water surface.
- No undermining of either footing was observed.

4301714

Structural File Number

LAK-00002-1656R

Bridge Number

September 24, 2007

Inspection Date

- Light tree debris is present on the upstream and downstream faces of the piers.
- There is a small scour depression located on the upstream face of Pier 1R. The depression measures approximately 5 feet in diameter and 2 feet deep.

5. Conclusions

A previous underwater report was not available for this bridge for comparison. The bridge is in good condition with only minor deficiencies noted.

Appendix A
Photographs



Photo by B. Butler 09/24/07

Photo 1. Elevation view looking upstream (east).



Photo by B. Butler 09/24/07

Photo 2. Elevation view looking downstream (west).

4301714

Structural File Number

LAK-00002-1656R

Bridge Number

September 24, 2007

Inspection Date

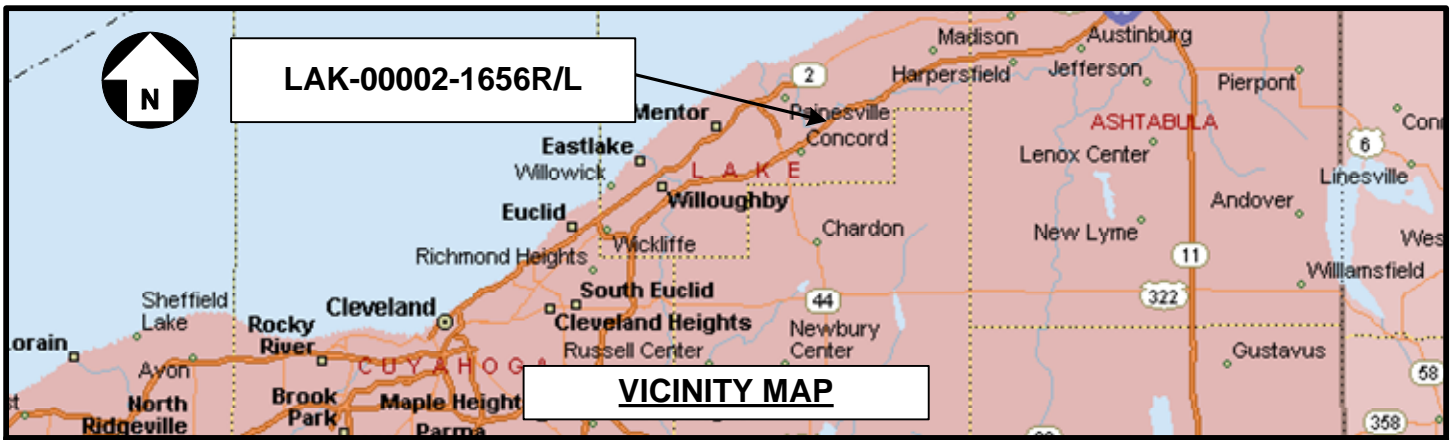


Photo by B. Butler 09/24/07

Photo 3. Pier 2 (north face).

Appendix B

Figures




MSI MARINE SOLUTIONS, INC.
ENGINEERING & COMMERCIAL DIVING SERVICES


GRAPHIC SCALE: Not To Scale	
INSPECTION DATE: September 24, 2007	
DRAWN BY: DW	CKD. BY: ANW
MSI JOB NO.: MSI2007008	
FILE NAME: LAK-00002-1656R/L Location Map	

PROJECT:	ODOT District 12 2007 Underwater Bridge Inspections
SHEET:	LAK-00002-1656R/L Lake County Ohio Location Map

PAGE NO.:	B-1
FIG. NO.:	1

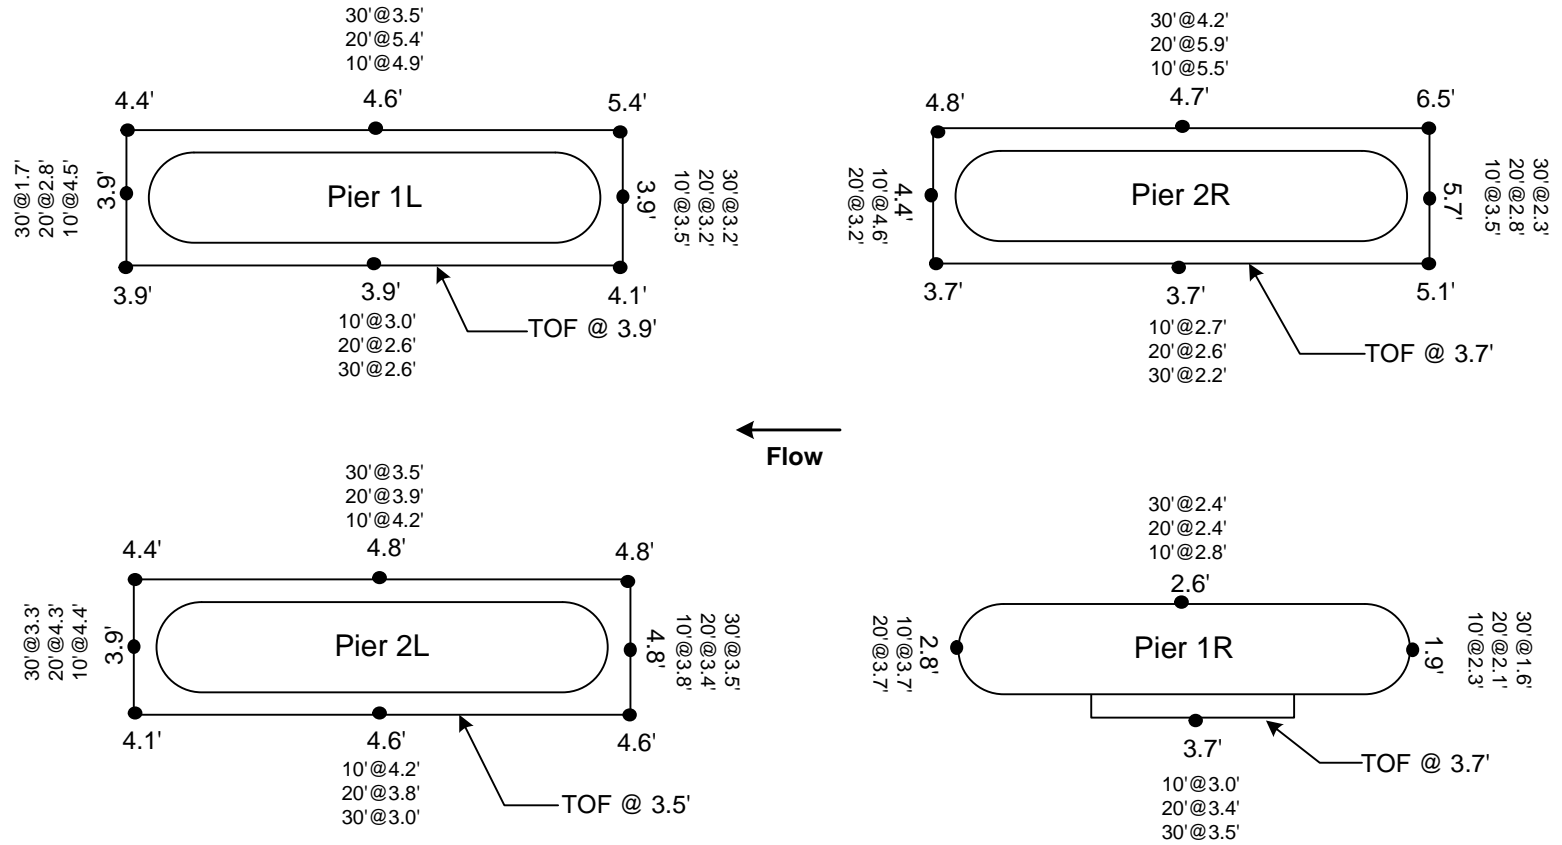

<p>MSI MARINE SOLUTIONS, INC. ENGINEERING & COMMERCIAL DIVING SERVICES</p>	GRAPHIC SCALE: Not to Scale		PROJECT: ODOT District 12 2007 Underwater Bridge Inspections	
	INSPECTION DATE: October 25, 2007		SHEET: LAK-00002-1656R/L	
	DRAWN BY: DW	CKD. BY: ANW	State Route 2 over Grand River Lake County	
	FMSM JOB NO.: MSI2007008		Substructure Plan View	
FILE NAME: LAK-00002-1656R/L		PAGE NO.: B-2		
		FIG. NO.: 2		

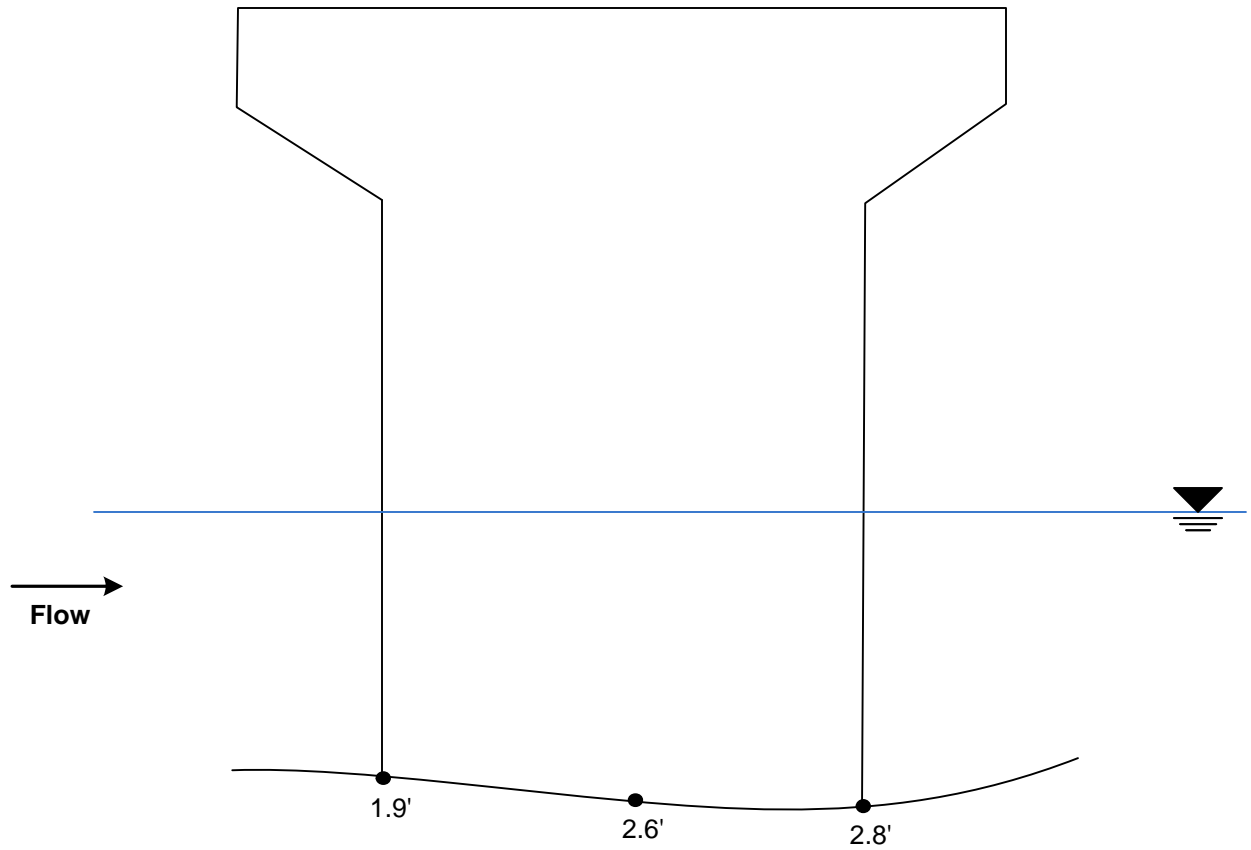

Pier 1R Looking South



GRAPHIC SCALE:
Not to Scale

PROJECT:
ODOT District 12
2007 Underwater Bridge Inspections

INSPECTION DATE: **October 24, 2007**

SHEET: **LAK-00002-1656R**
State Route 2 over Grand River
Lake County

PAGE NO.:
B-3


DRAWN BY: **DW** CKD. BY: **ANW**

FMSM JOB NO.: **MSI2007008**

Pier 1R Looking South

FIG. NO.:
3

FILE NAME: **LAK-00002-1656R – Pier 1R**

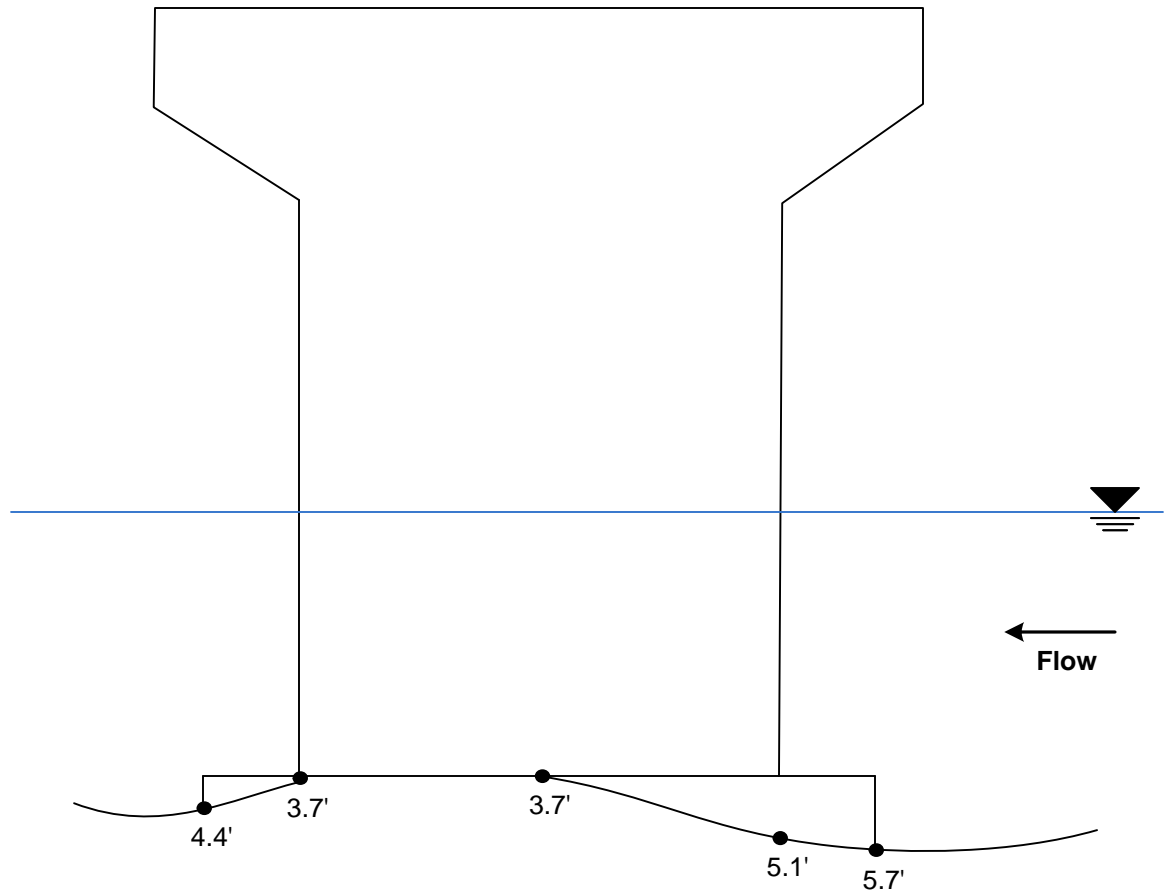

Pier 2R Looking North



GRAPHIC SCALE:
Not to Scale

PROJECT:
ODOT District 12
2007 Underwater Bridge Inspections

INSPECTION DATE: **October 24, 2007**

SHEET: **LAK-00002-1656R**
State Route 2 over Grand River
Lake County

PAGE NO.:
B-4

DRAWN BY: **DW** CKD. BY: **ANW**

FMSM JOB NO.: **MSI2007008**

Pier 2R Looking North

FIG. NO.:
4

FILE NAME: **LAK-00002-1656R – Pier 2R**