


SCHEMATIC PLAN

CALC. _____	CUYAHOGA COUNTY	OHIO
DATE _____		F.H.W.A. 5
CHKD. _____		REGION
DATE _____	CUY - 176 - 10.14	

2
395

NOTE: FOR Q AND B GEOMETRIC DATA SEE SHEETS 42-44.

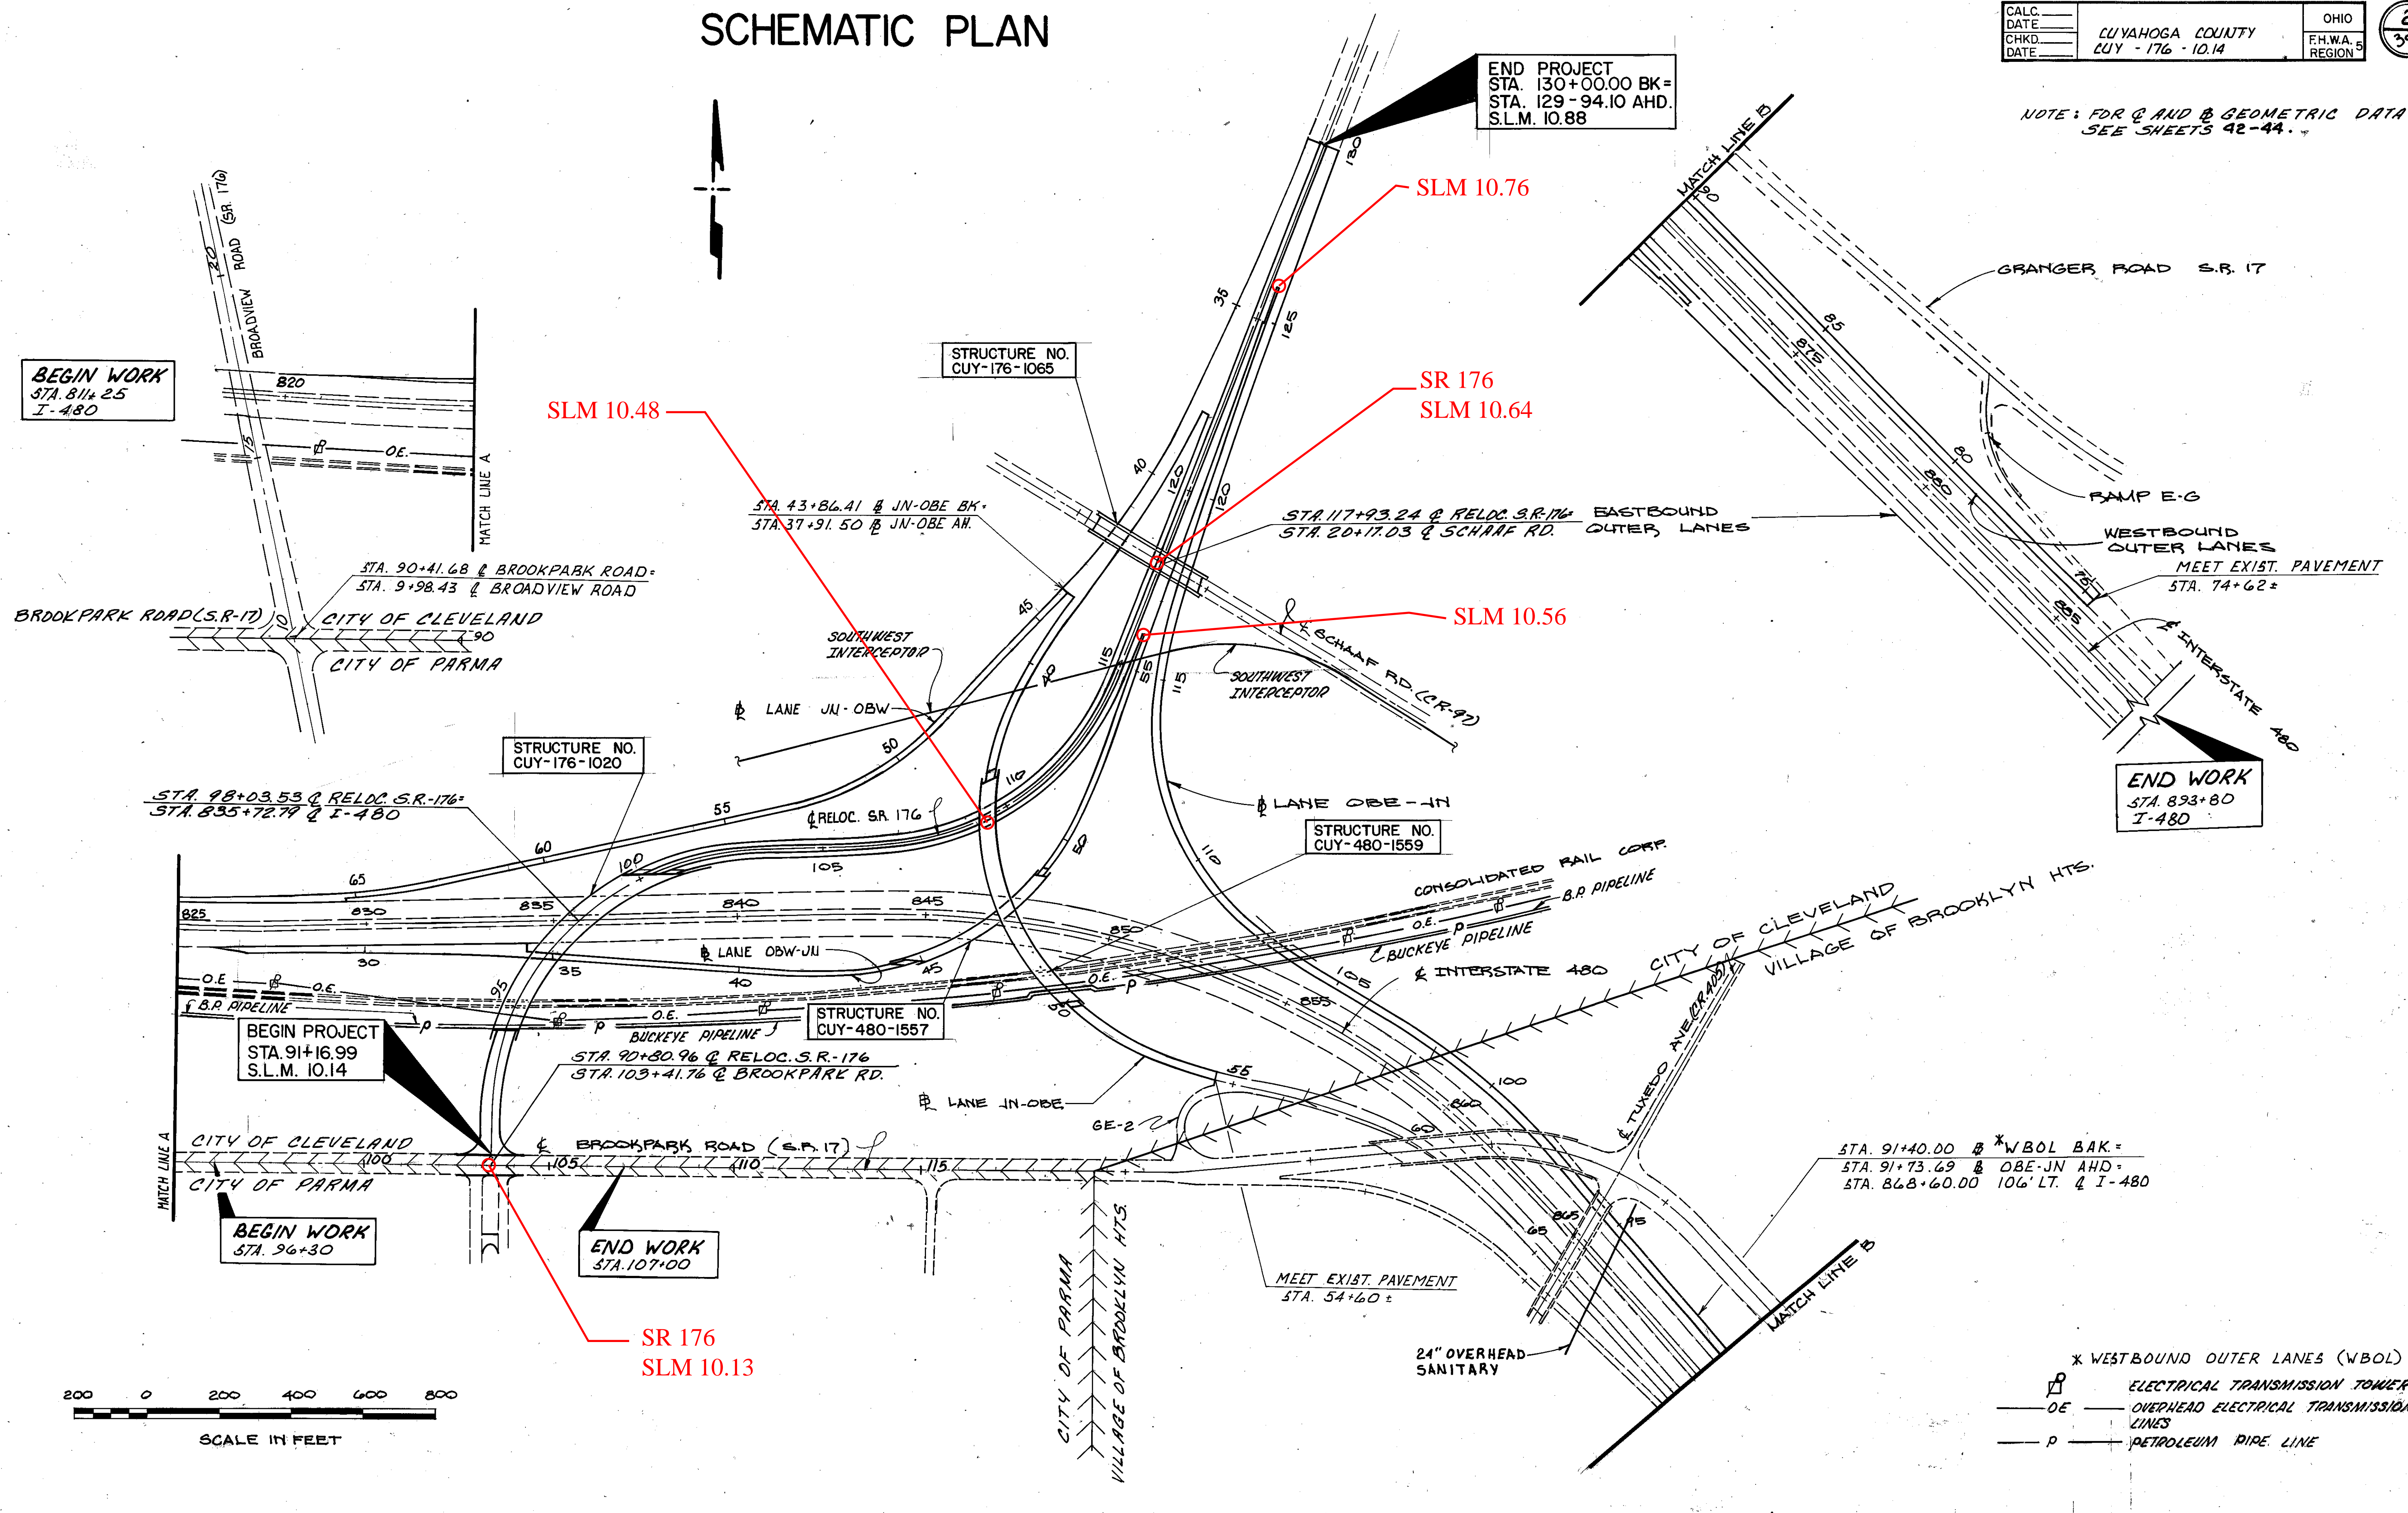

BEGIN WORK
STA. 814+25
I-480

END PROJECT
STA. 130+00.00 BK=
STA. 129-94.10 AHD.
S.L.M. 10.88

END WORK
STA. 893+80
I-480

BEGIN PROJECT
STA. 91+16.99
S.L.M. 10.14

BEGIN WORK
STA. 96+30

END WORK
STA. 107+00

SLM 10.48

SLM 10.76

SR 176
SLM 10.64

SLM 10.56

SR 176
SLM 10.13

- x WESTBOUND OUTER LANES (WBOL)
- ⊕ ELECTRICAL TRANSMISSION TOWER
- OE — OVERHEAD ELECTRICAL TRANSMISSION LINES
- P — PETROLEUM PIPE LINE

SCHEMATIC PLAN

RELOC. S.R. 176