

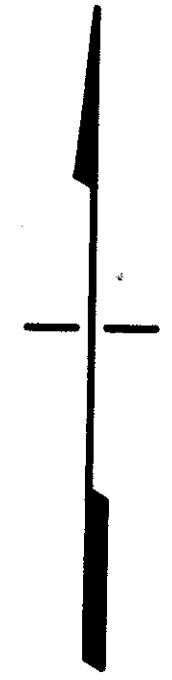


BENCHMARK: TBM 89 CHASELED SQ.
 S.E. CORNER INLET APPROX I-480 STA.
 830+00 LT.
 ELEV. 755.04

CURVE DATA
 THETA-S = 9° 49' 18.80" LT.
 LS = 250
 XC = 249.2663
 YC = 14.2554
 L.T. = 166.9239
 S.T. = 83.5673
 L.C. = 249.6736
 P = 3.5676
 K = 124.8777

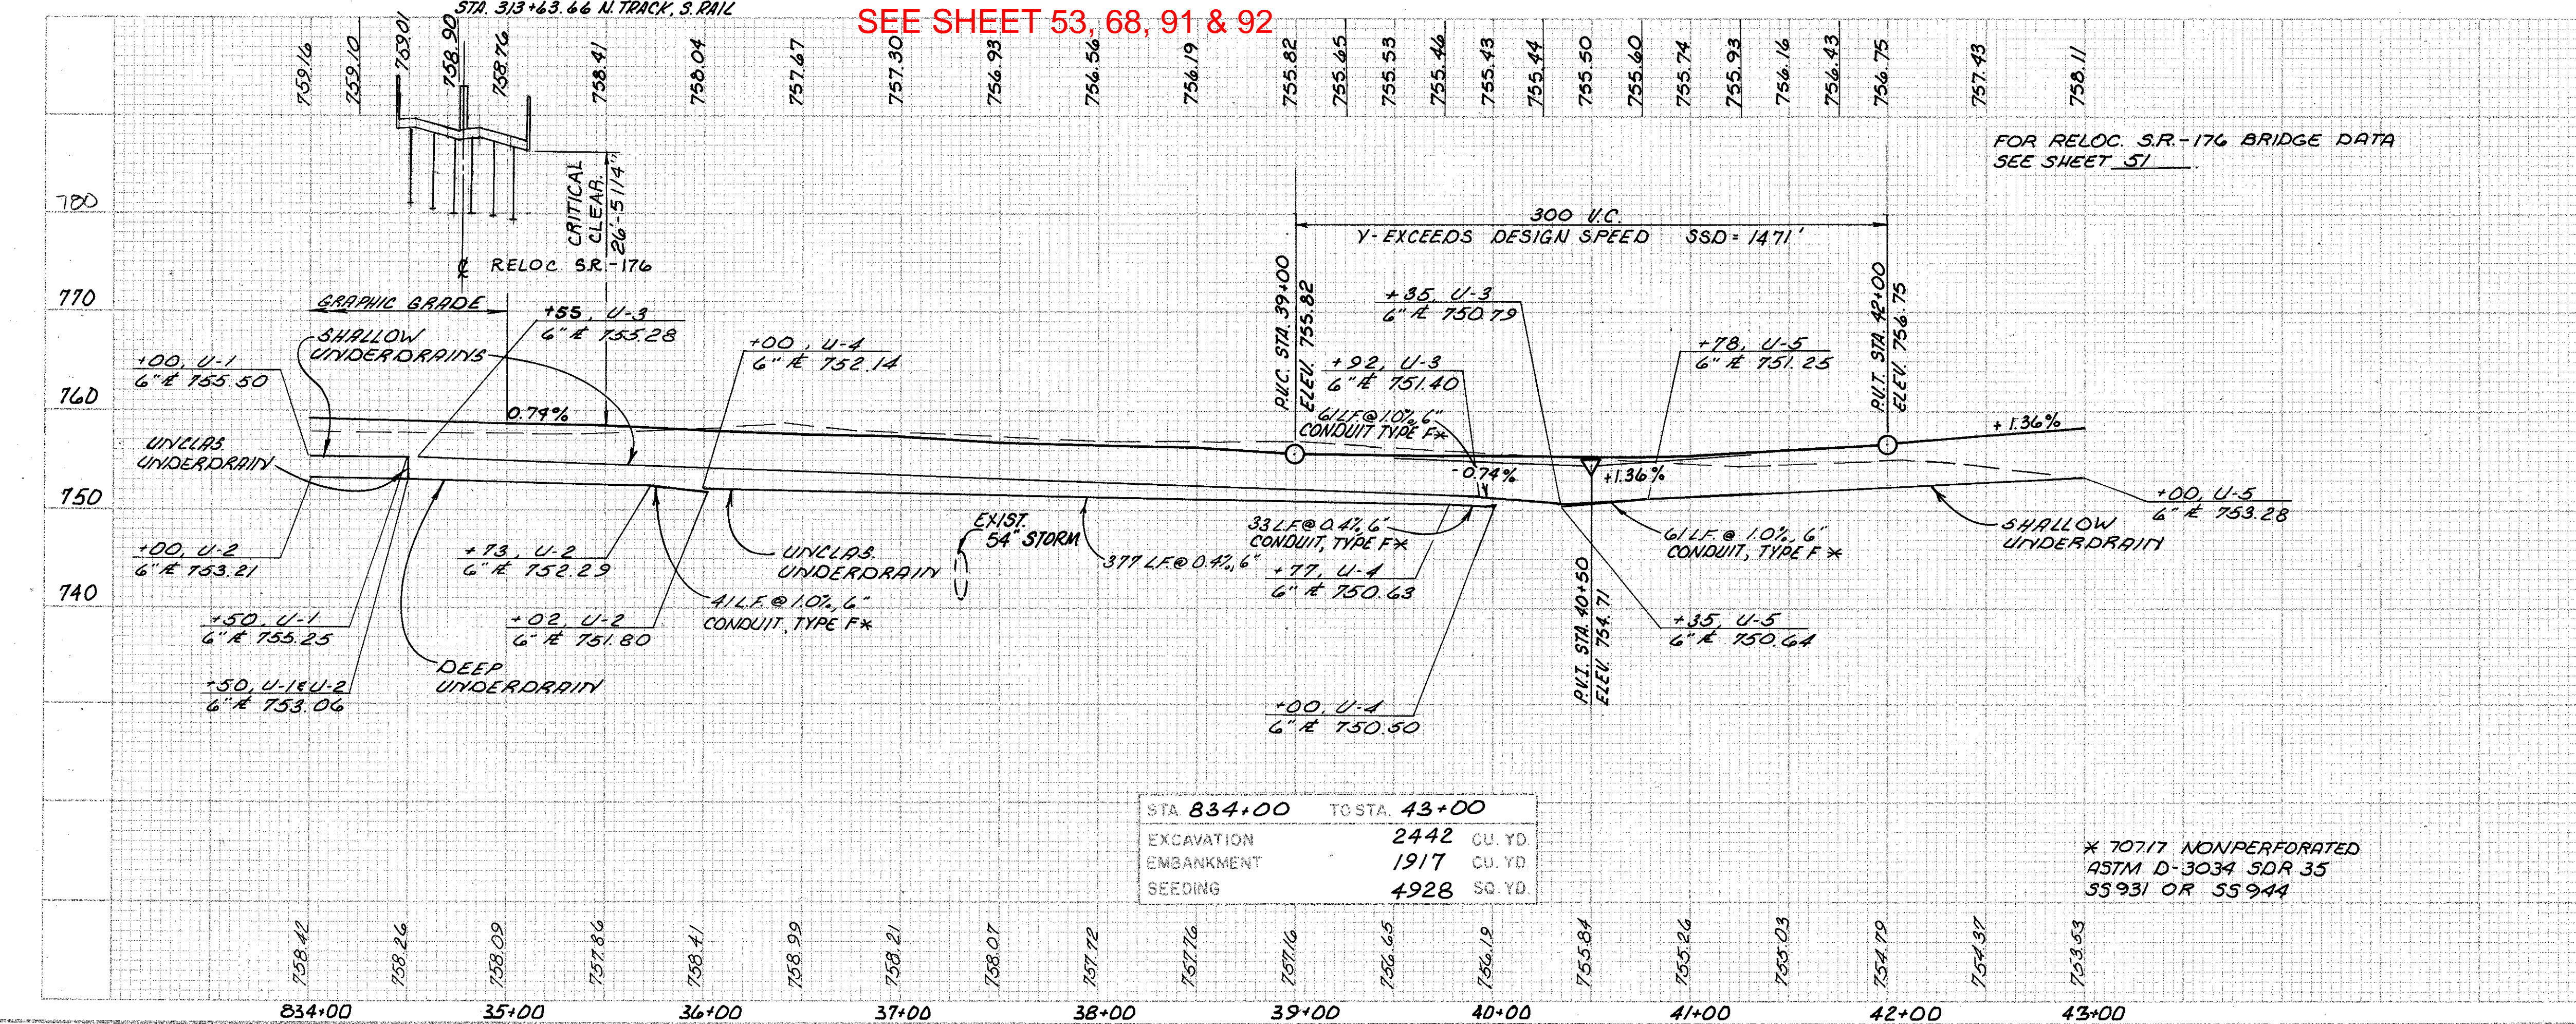

DRAINAGE STRUCTURE DATA
 (D-1) STA. 40+00, 23' RT.
 L.B. N^o. 5 APR 16: 753.25

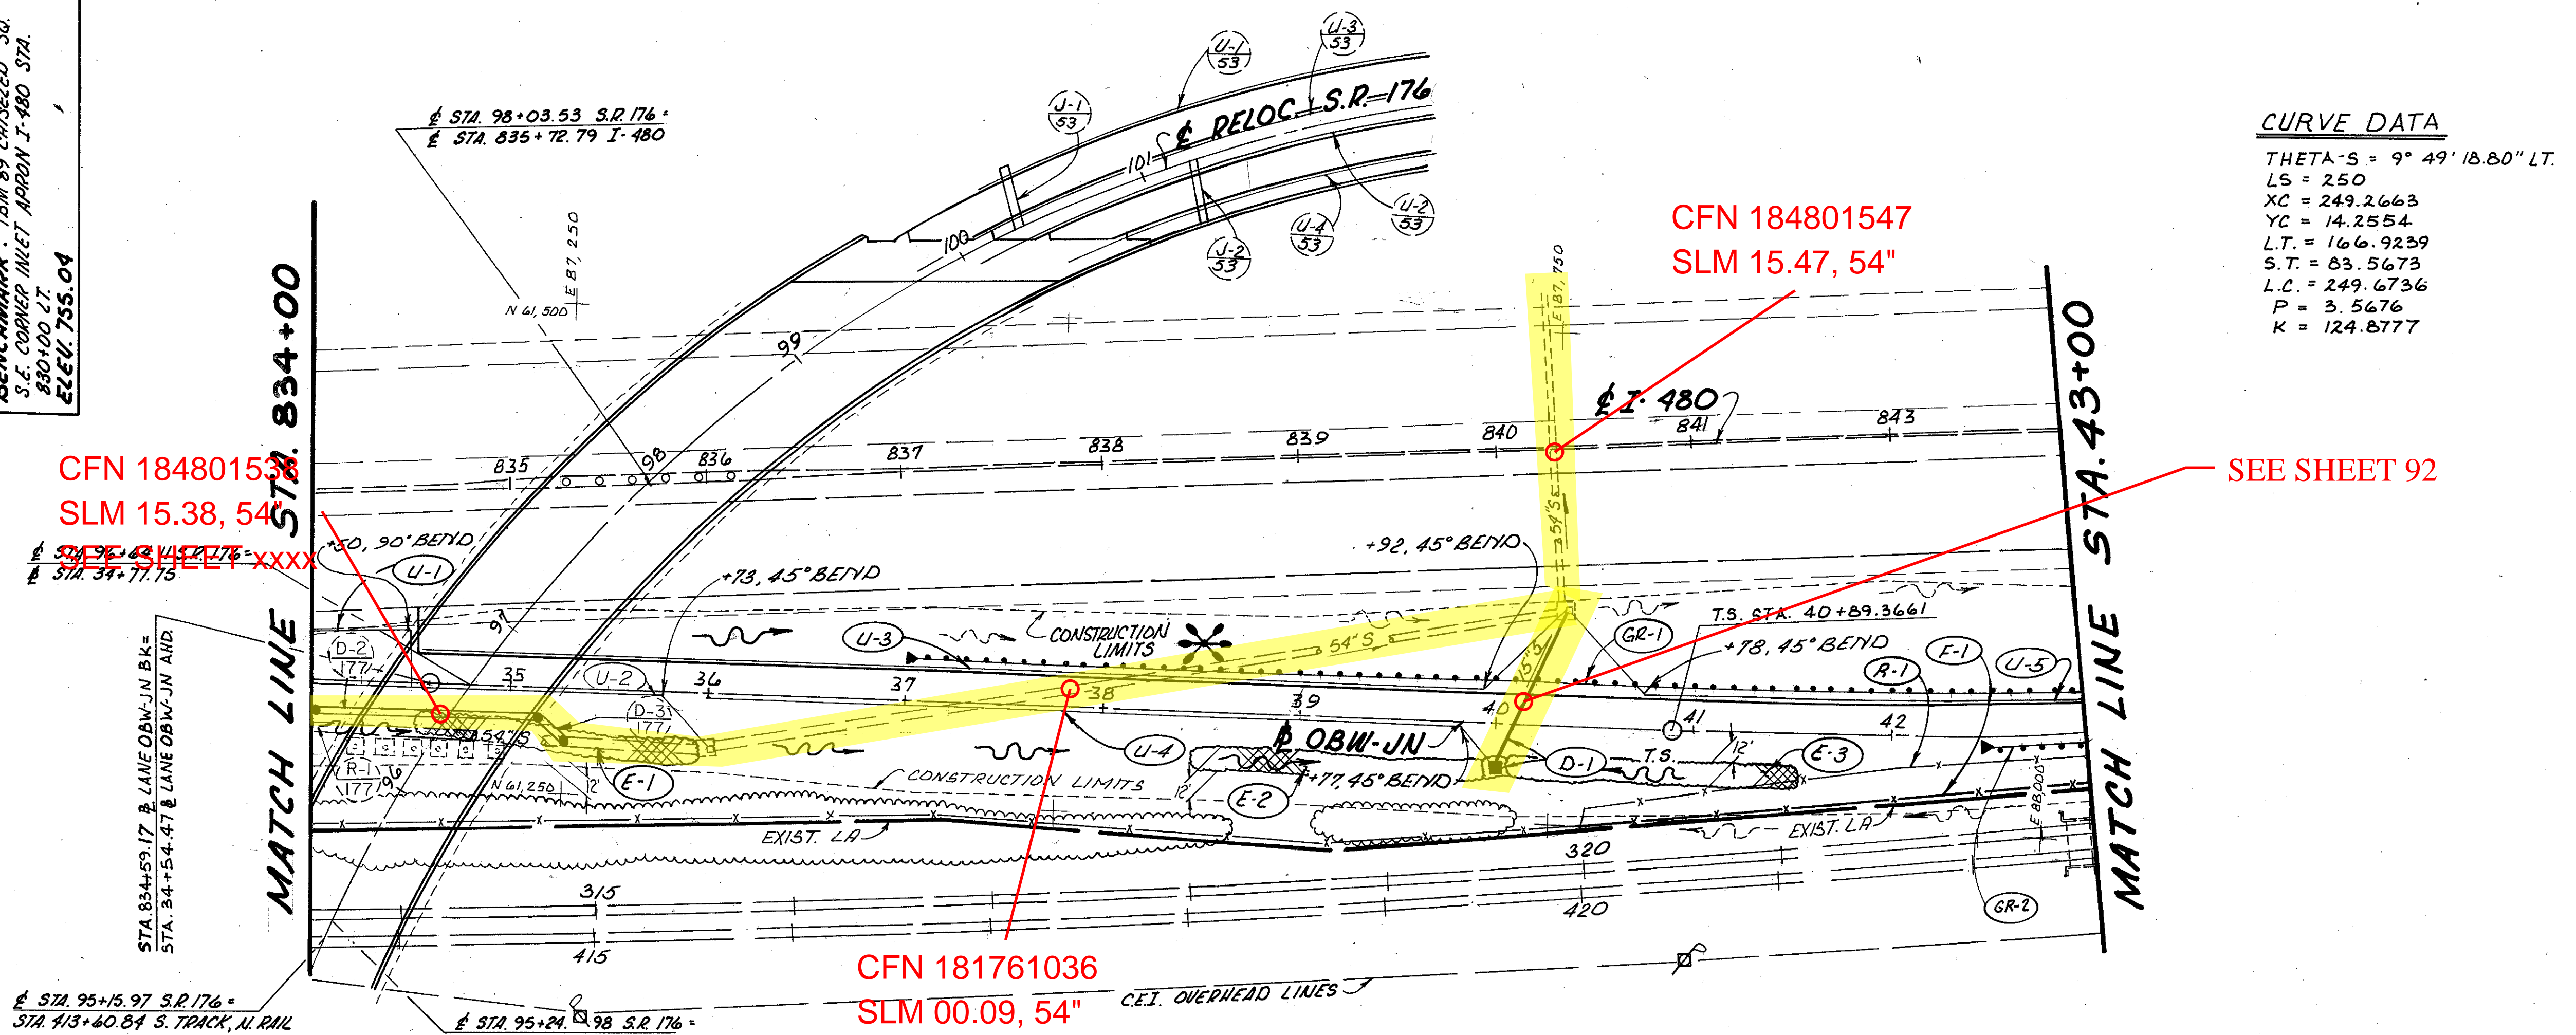

REFERENCES

REFERENCES	SHEET NUMBERS
QUANTITIES FOR REFERENCED ITEMS	85
ADDITIONAL LEGEND ITEMS	2
PIPE PROFILES	92
PAYEMENT DETAILS	168
RELOC. S.R.-176 P&P SHEETS	51, 53, 55, 57 & 59
SPECIAL EXCAVATION	177
PIPE PROFILE - RELOCATED 54" STM	90

FOR RELOC. S.R.-176 BRIDGE DATA
 SEE SHEET 51

* 70717 NONPERFORATED
 ASTM D-3034 SDR 35
 55931 OR 55944

RELOC. S.R.-176