

- Not Yet Installed
- In Service
- Inactive, Assumed Good
- Out of Service/Abandoned

REVISION	DATE	DESCRIPTION
A	11/21/13	REVISIONS BASED ON INSTRUMENTATION STATUS AFTER COMPLETION OF CCG1.
B	2/6/14	REVISIONS BASED ON INSTRUMENTATION STATUS AFTER COMPLETION OF CCG2.

ADDENDUM	DATE
7	8/2/13
1	4/16/13



DRAWN: CDS  
CHECKED: JN


INSTRUMENTATION PLAN  
CUYAHOGA RIVER WEST BANK

CUY-90-14.90

**LEGEND**

- P-001-13 LOCATION OF PIEZOMETER AND/OR INCLINOMETER. THE LOCATION OF EACH INCLINOMETER IS WITHIN 5 FEET OF THE LOCATION OF THE PIEZOMETER.
- B-05-01 LOCATION OF INCLINOMETER/PIEZOMETER INSTALLED BY BBCM IN 2006 (B-05-01 THROUGH B-05-04, B-05-07, B-05-08, B-05-11 THROUGH B-05-13, AND B-05-16). THESE INSTRUMENTS ARE NOT AFFECTED BY THE GRADING AND REMAIN IN SERVICE.
- B-105A LOCATION OF REPLACEMENT INCLINOMETER INSTALLED BY BBCM IN 2006 (B-105A AND B-108A).
- B-101 LOCATION OF INCLINOMETER AND/OR PIEZOMETER INSTALLED BY BBCM BETWEEN 1994 AND 1999 (B-101, B-102, B-105, B-107, B-203, B-204, B-303, AND P-9N).
- B-110 LOCATION OF INCLINOMETER AT B-110, WHICH WAS DESTROYED BY EXCAVATION ACTIVITIES IN MARCH, 2006
- I-010-12 LOCATION OF INCLINOMETER INSTALLED DURING PIER 3 CONSTRUCTION, 2012
- LOCATION OF ABANDONED/DESTROYED INCLINOMETER AND/OR PIEZOMETER (B-05-01, B-05-12, B-05-16, B-035-0-09, B-037-1-09, AND B-037-A-09, B-038-A-09, B-107, B-108A, B-203, B-204, B-05-08), I-010-12
- INCLINOMETER AND/OR PIEZOMETER TO BE REPLACED. THE FUTURE INSTALLATION WILL HAVE THE SAME DESIGNATION PRECEDED BY LETTER 'A' (B-05-02, B-05-04, B-107, I-003-10)

NOTE: THE DEVELOPER NEEDS TO PROTECT ALL THE INSTRUMENTS AND REPLACE ANY IF DAMAGED, PER SCOPE REQUIREMENTS.

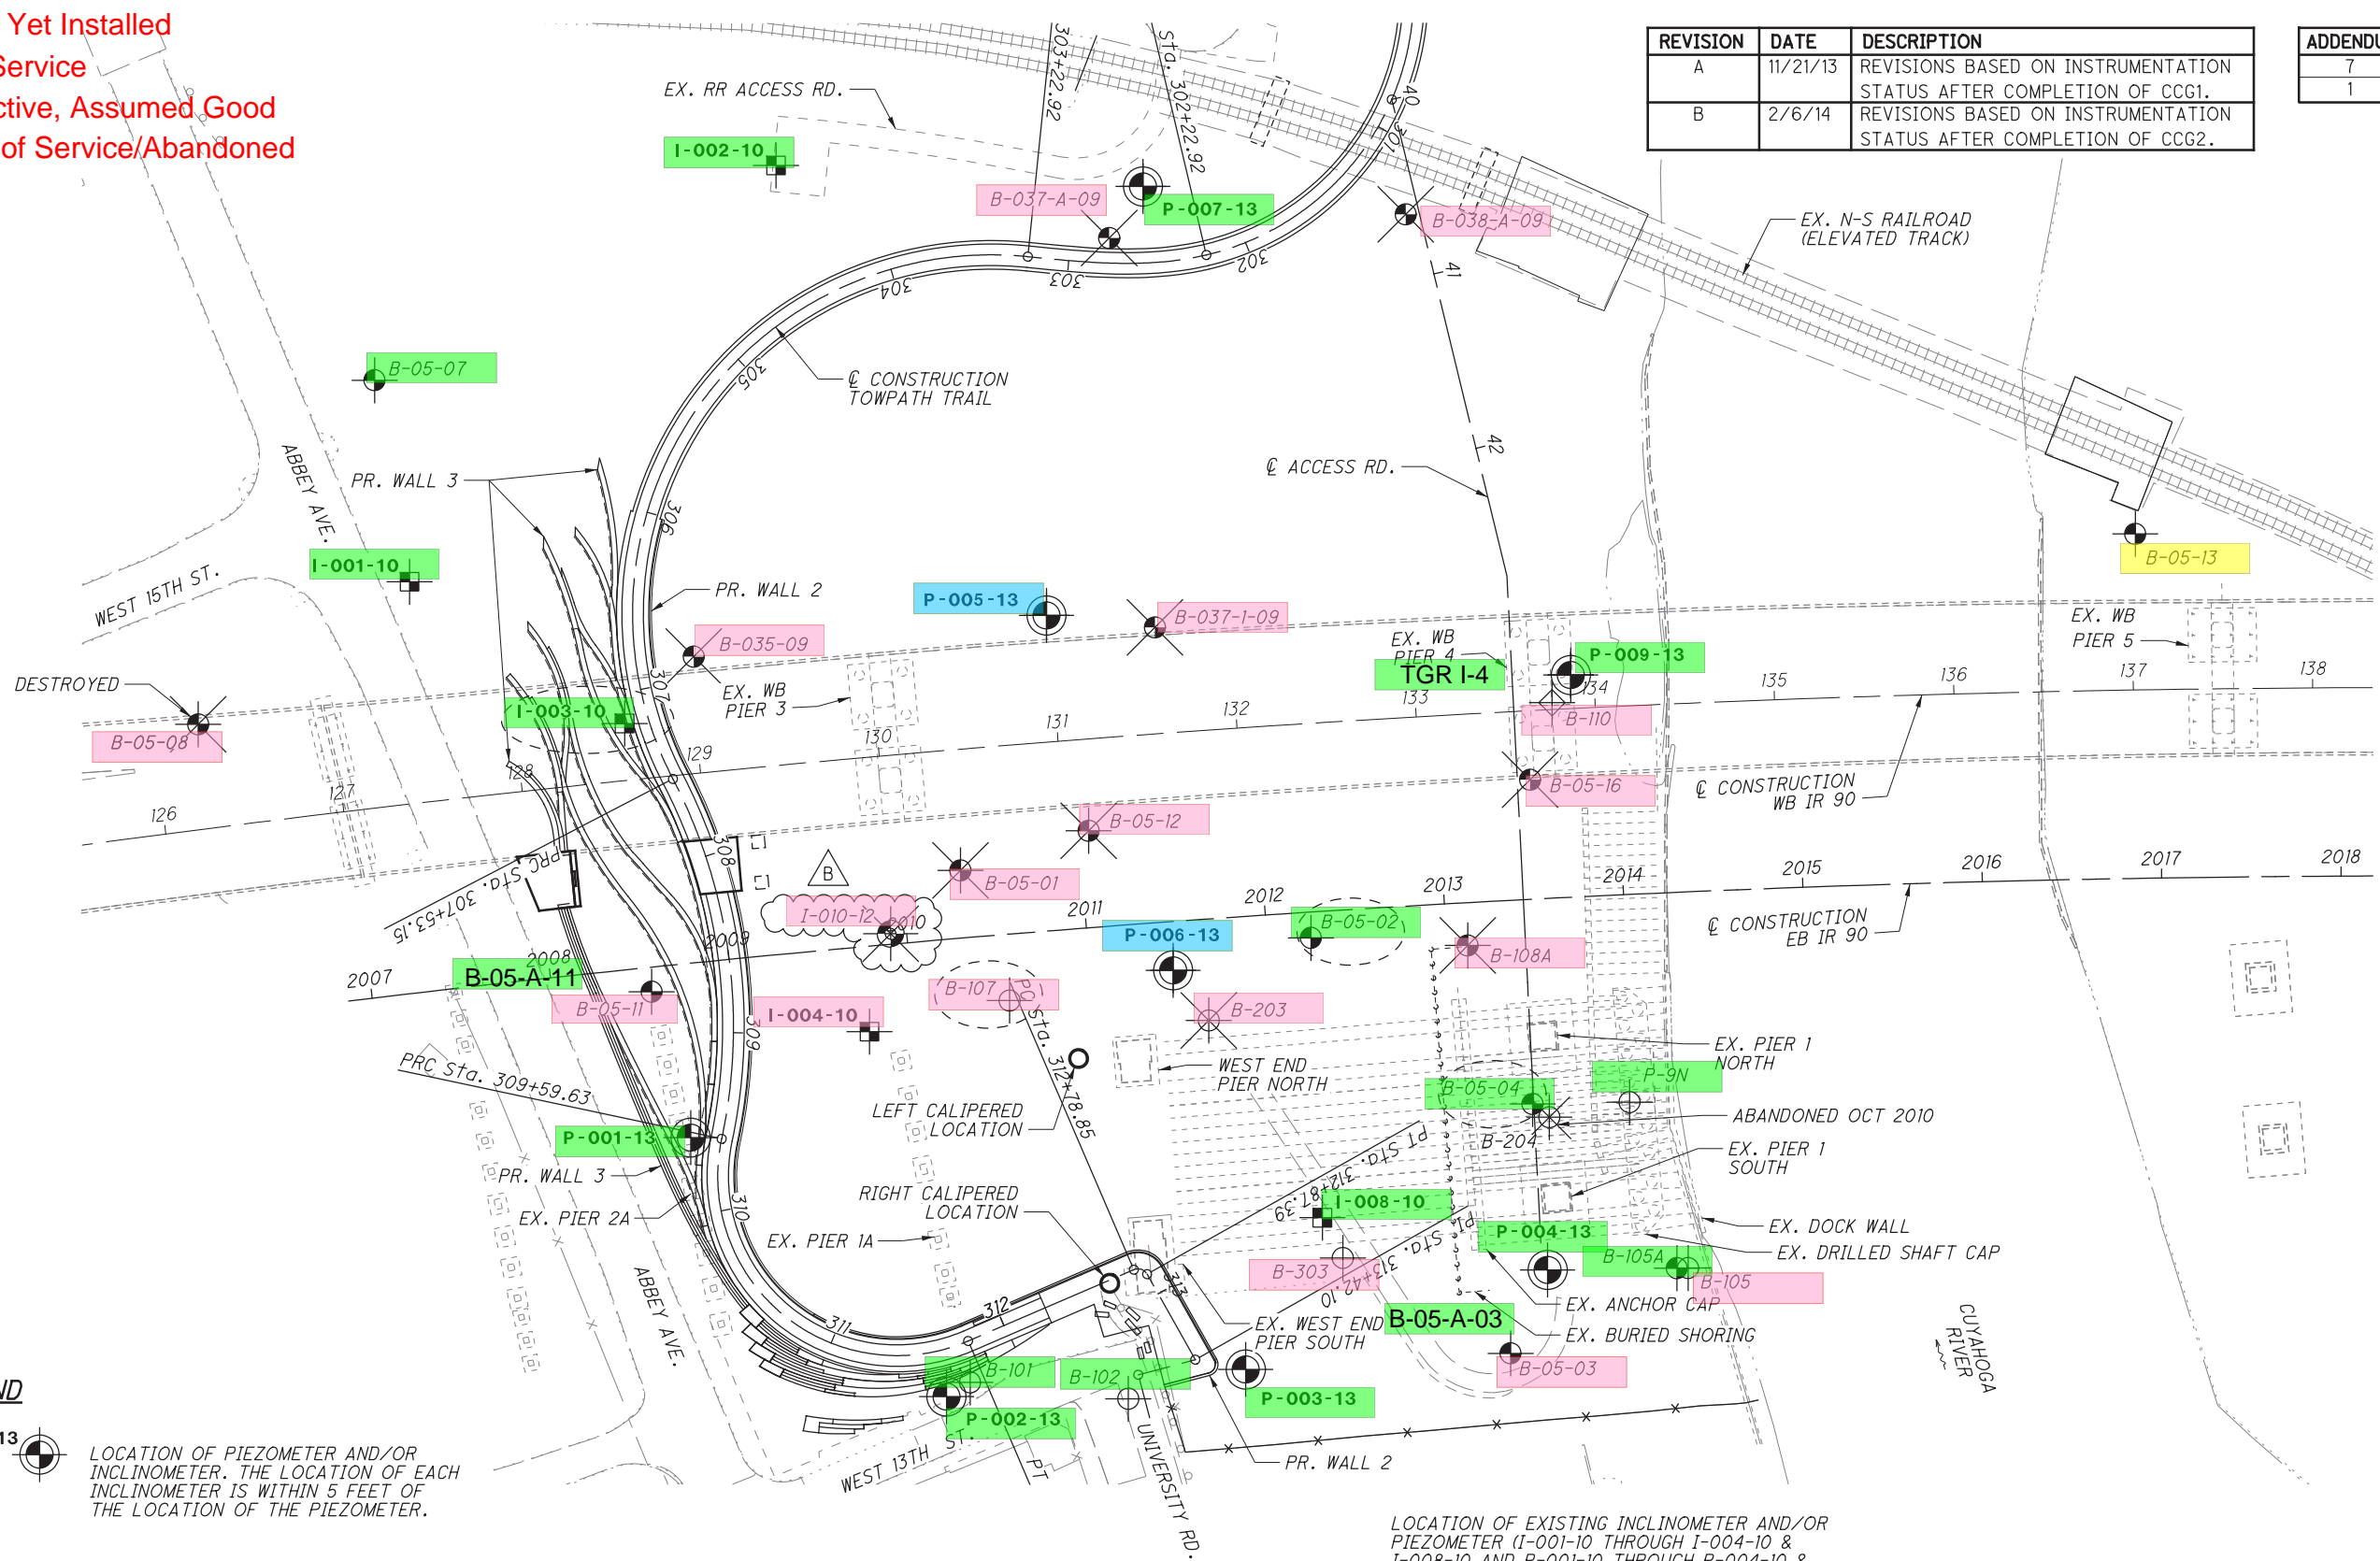

P:\82119\geot\technical\sheets\82119ZP410 Revision B.dgn 2/7/2014 8:43:29 AM csteck