

FED. RD. DIVISION	STATE	PROJECT
2	OHIO	


282
646

CUYAHOGA COUNTY
CUY-71-17.83
CUY-176-12.76

31
54


S-71

No. 2 M.H. (Mod) as per General Notes
Sta. 50+50-43.5' Rt.
(N.B. Jennings)
TIC=641.42

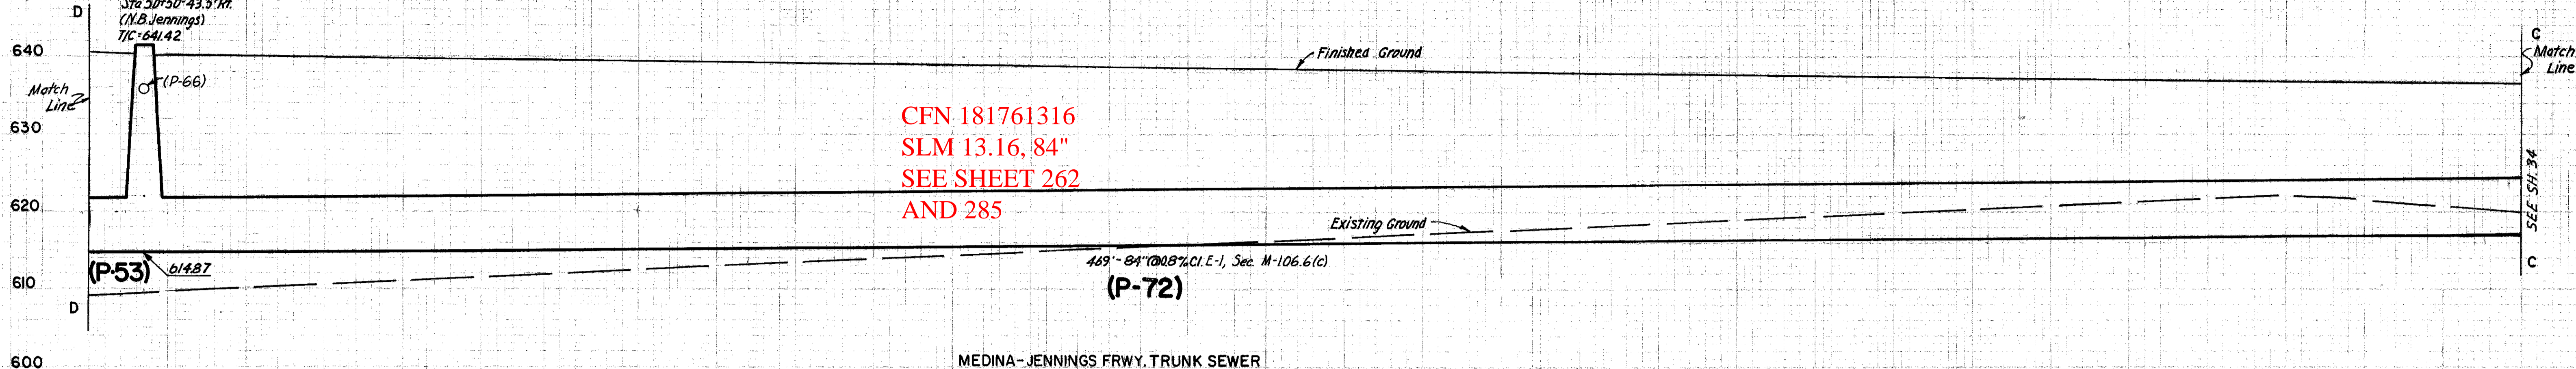


RDJ
JMD
10-9-64
10-14-64

E Match Line

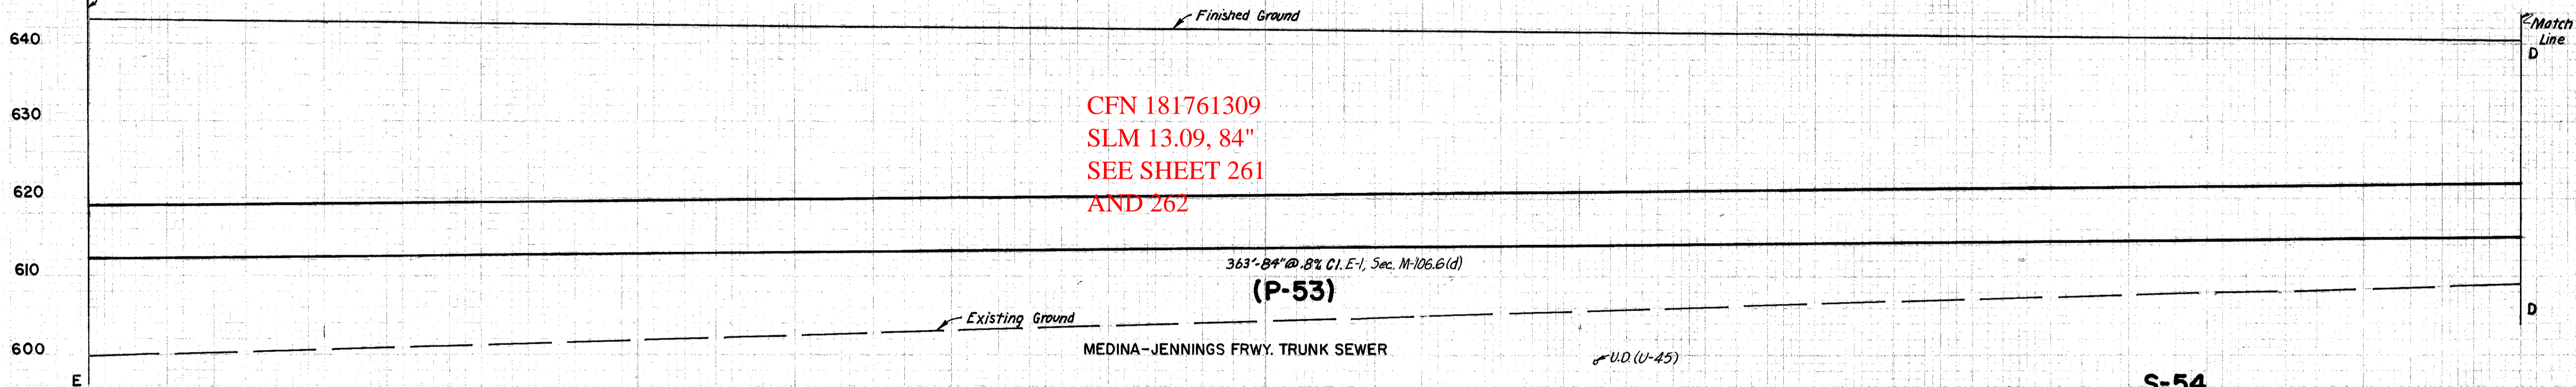

SEE SH. 30

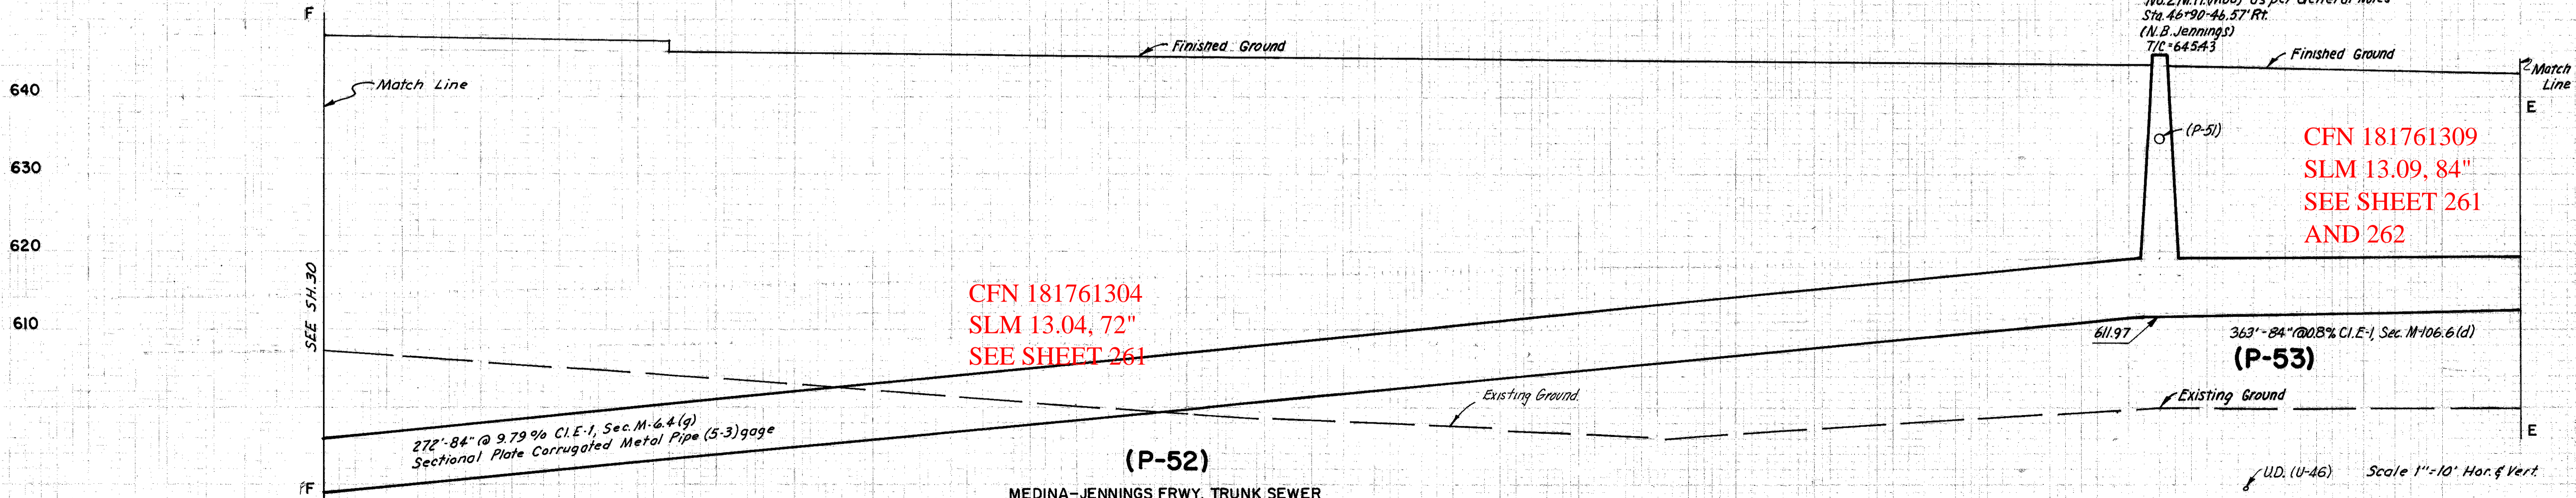

HOWARD, NEEDLES, TAMMEN & BERGENDOFF
CONSULTING ENGINEERS
KANSAS CITY CLEVELAND NEW YORK

U.D. (U-46) Scale 1"=10' Hor. & Vert.
P-72 SEE ALSO SH. 34