


FED. RD. DIVISION	STATE	PROJECT
2	OHIO	

293
646

CUYAHOGA COUNTY
CUY-71-17.83
CUY-176-12.76

42
54

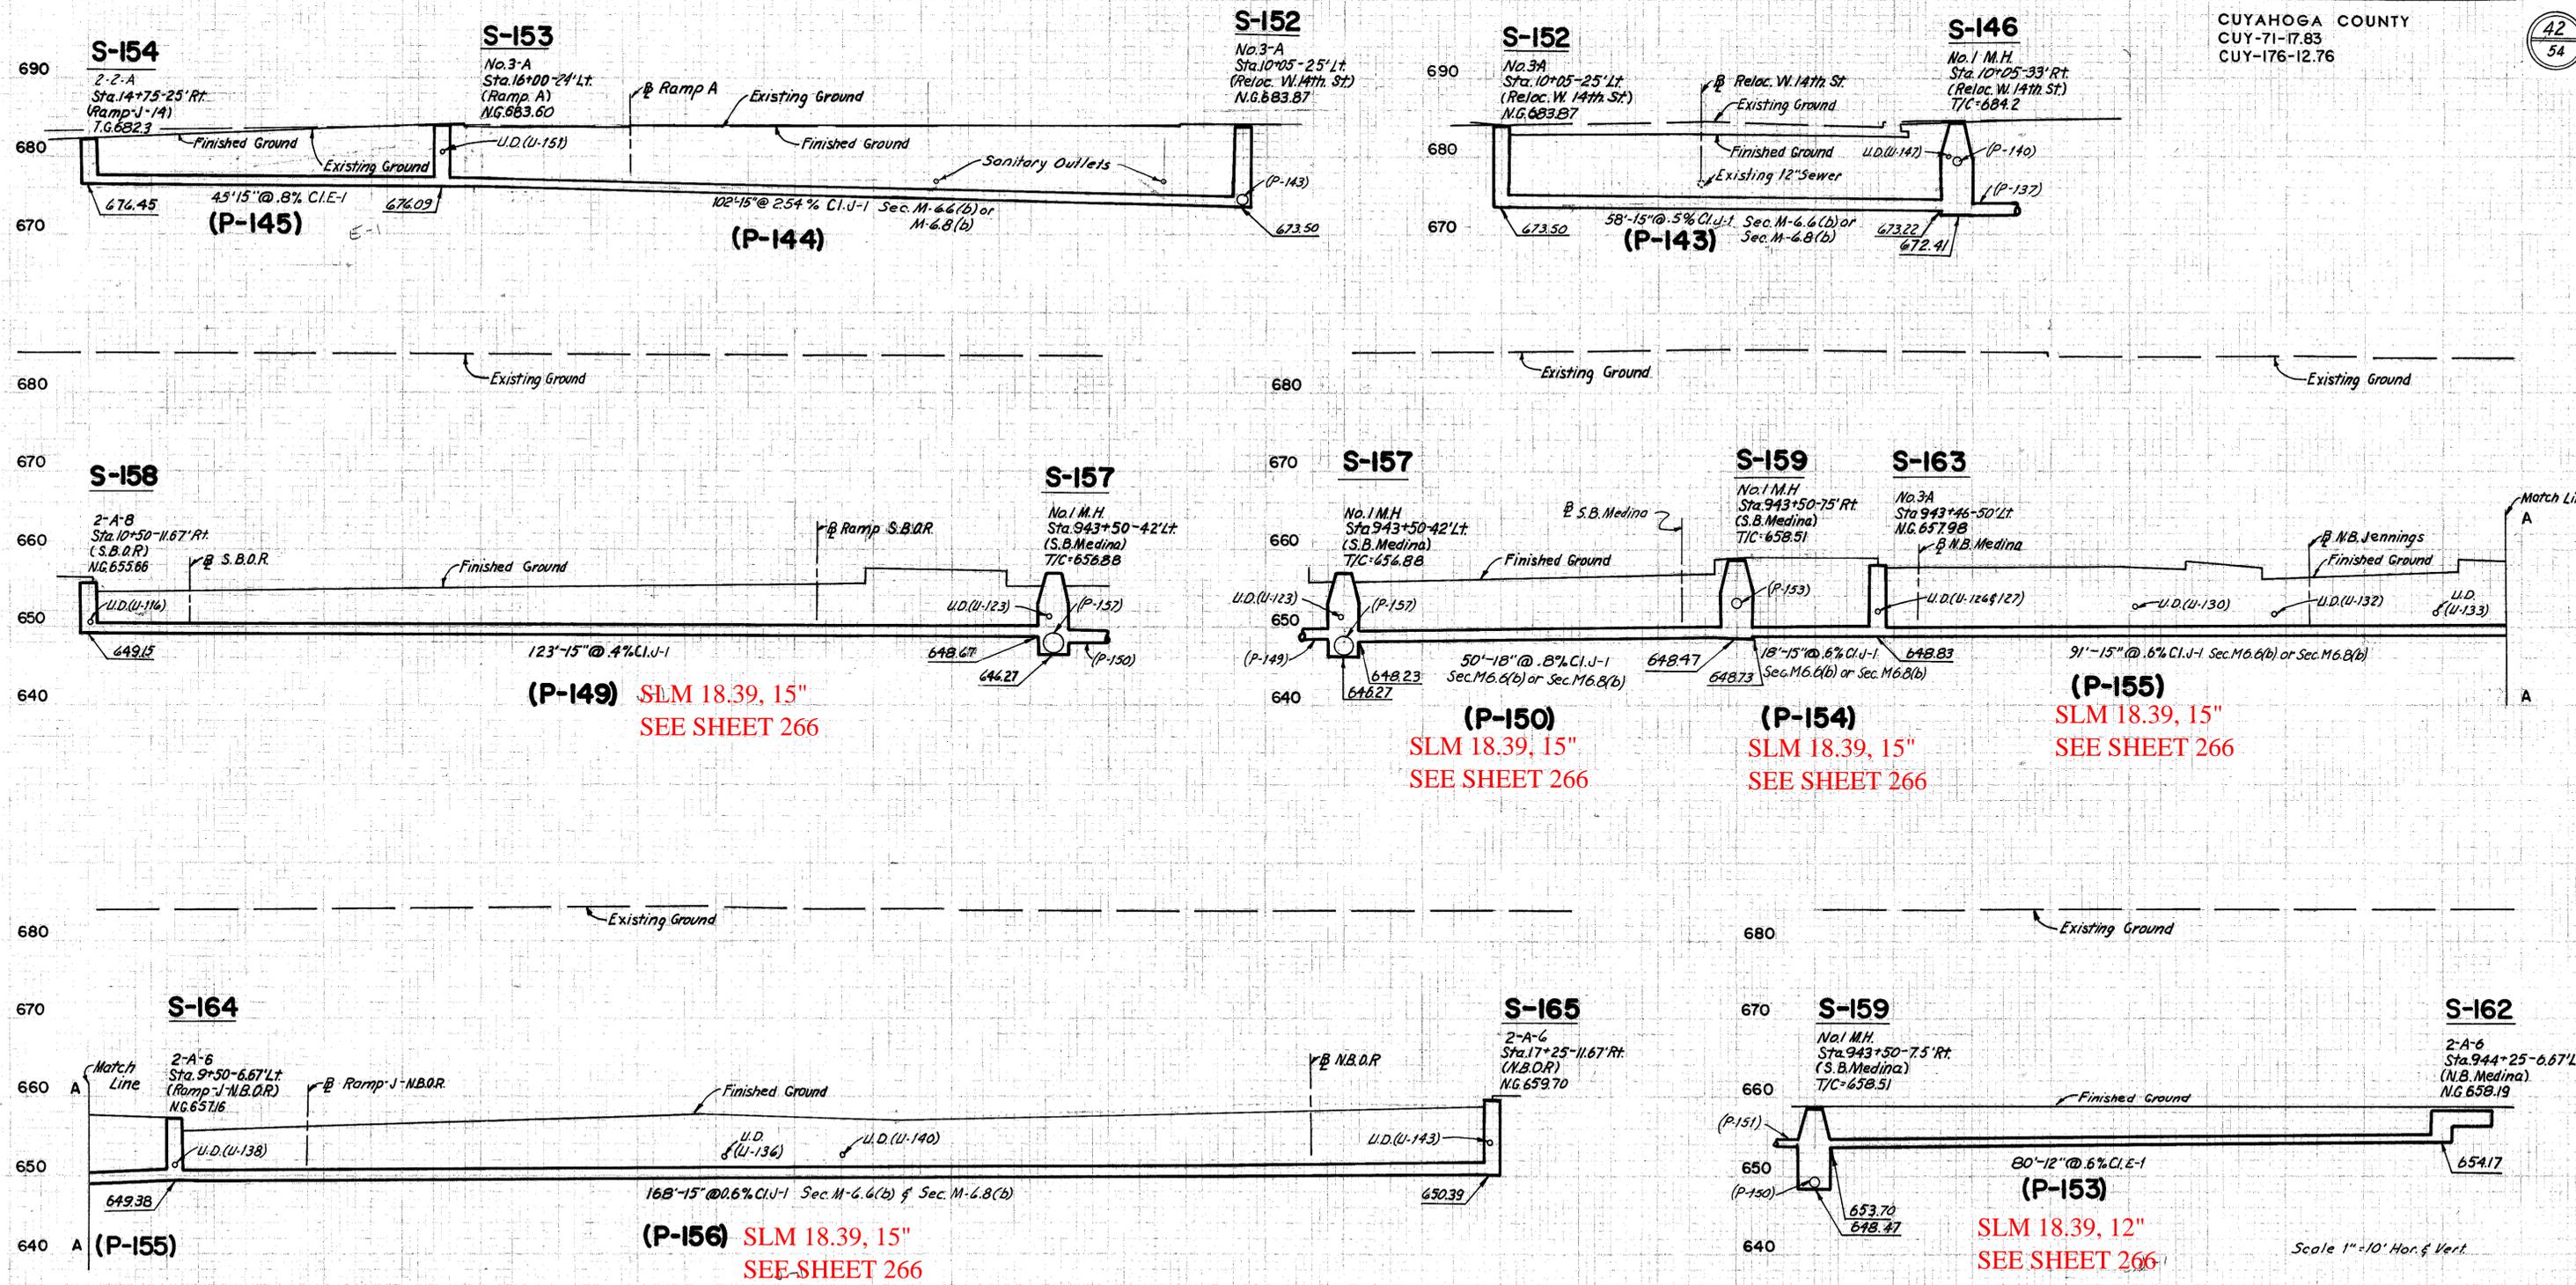

(P-149) SLM 18.39, 15"
SEE SHEET 266

(P-150) SLM 18.39, 15"
SEE SHEET 266

(P-154) SLM 18.39, 15"
SEE SHEET 266

(P-155) SLM 18.39, 15"
SEE SHEET 266

(P-156) SLM 18.39, 15"
SEE SHEET 266

(P-153) SLM 18.39, 12"
SEE SHEET 266

Scale 1" = 10' Hor. & Vert.

P-148 SEE SH. 44
P-151 & P-152 SEE SH. 43