


SEEDING
END SQ.
WIDTH YDS.

2	OHIO	I-75(15)233
---	------	-------------

201
302

CUYAHOGA COUNTY
MED - 42 - 26.17
CUY - 42 - 0.00

END AREA		Cu Yds	
CUT	FILL	CUT	FILL

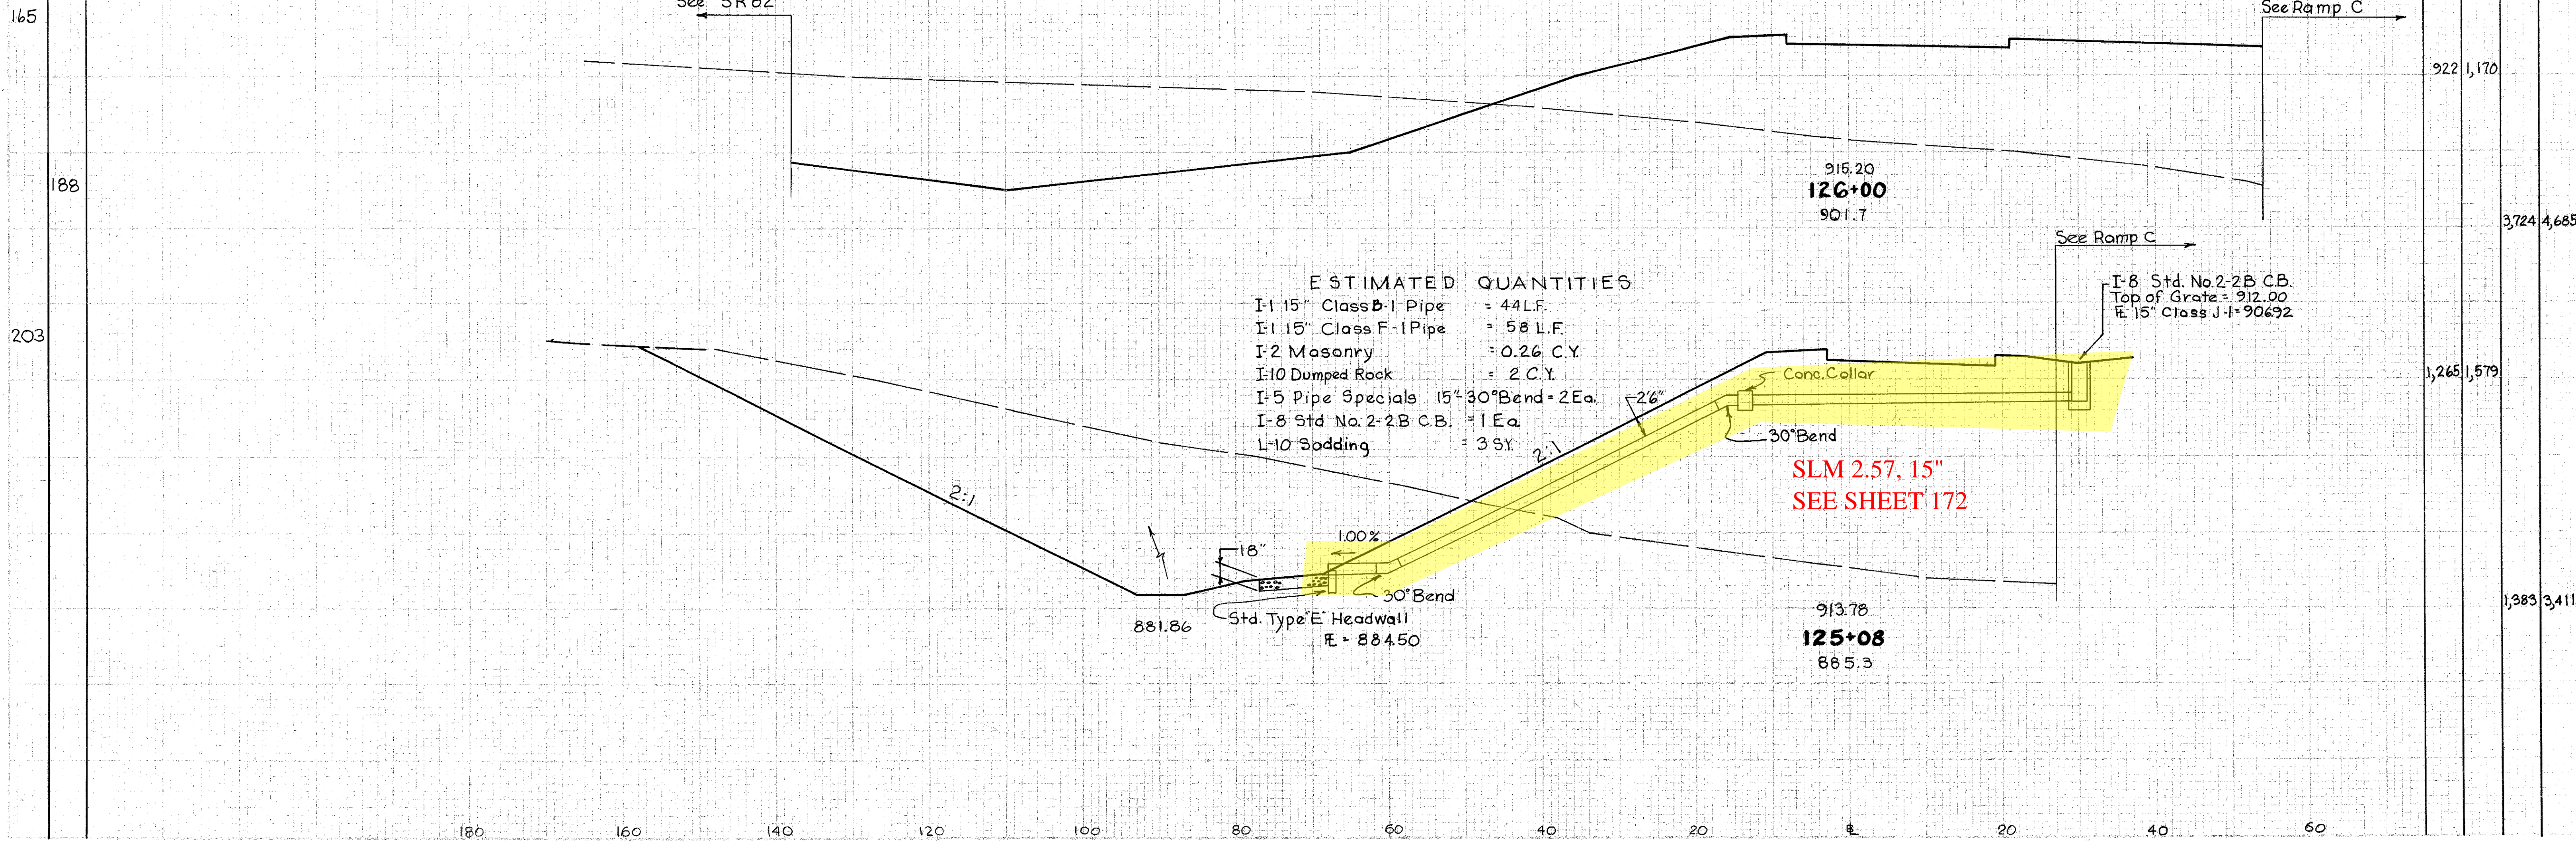

- ESTIMATED QUANTITIES**
- I-1 15" Class B-1 Pipe = 44 L.F.
 - I-1 15" Class F-1 Pipe = 58 L.F.
 - I-2 Masonry = 0.26 C.Y.
 - I-10 Dumped Rock = 2 C.Y.
 - I-5 Pipe Specials 15" 30° Bend = 2 Ea.
 - I-8 Std. No. 2-2B C.B. = 1 Ea.
 - L-10 Sodding = 3 SY.

SLM 2.57, 15"
SEE SHEET 172

I-8 Std. No. 2-2B C.B.
Top of Grate = 912.00
E 15" Class J-1 = 90692

913.78
125+08
885.3

915.20
126+00
901.7

922 1,170

3,724 4,685

1,265 1,579

1,383 3,411