



MEDINA COUNTY  
 CUYAHOGA COUNTY  
 MED-42-26.17  
 CUY-42-0.00

MICROFILMED  
 FEB 18 1985

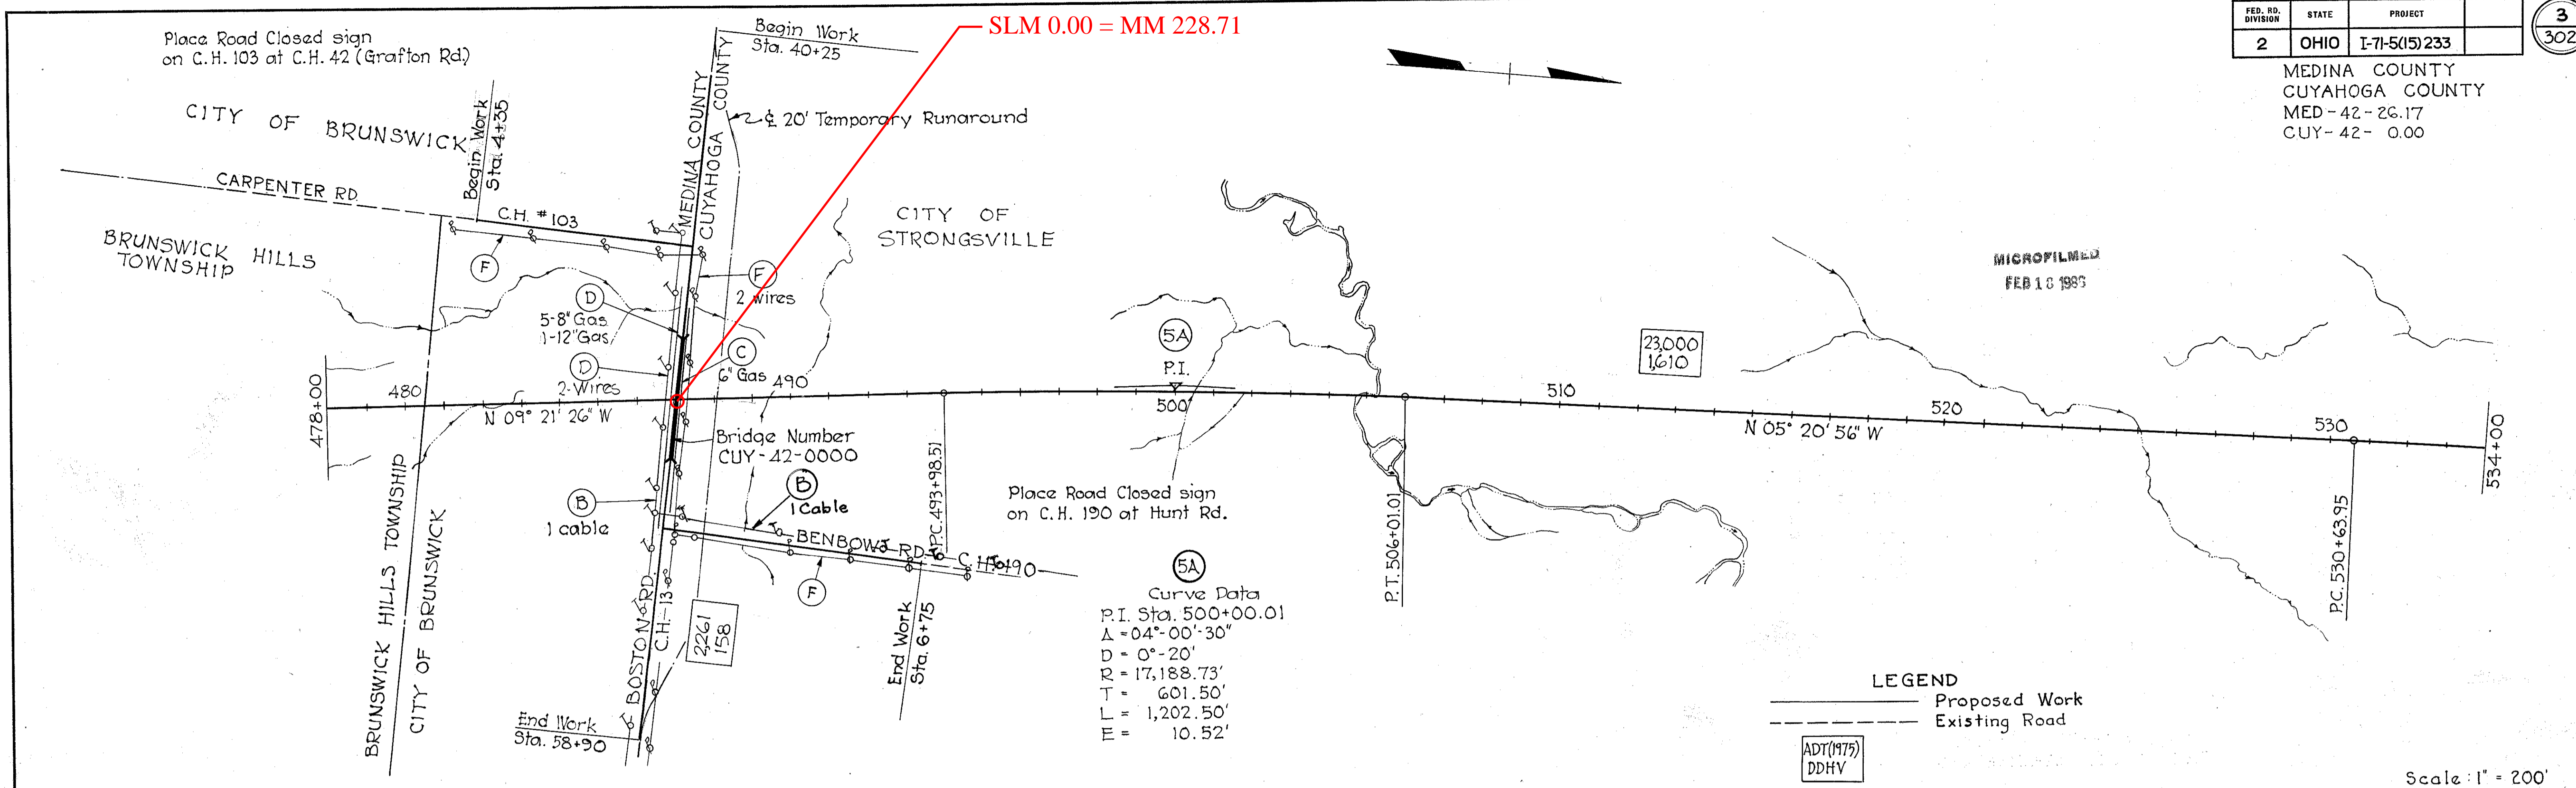

Place Road Closed sign on C.H. 105 at C.H. 188.

**DRAKE ROAD**  
 SLM 0.99 = MM 229.70

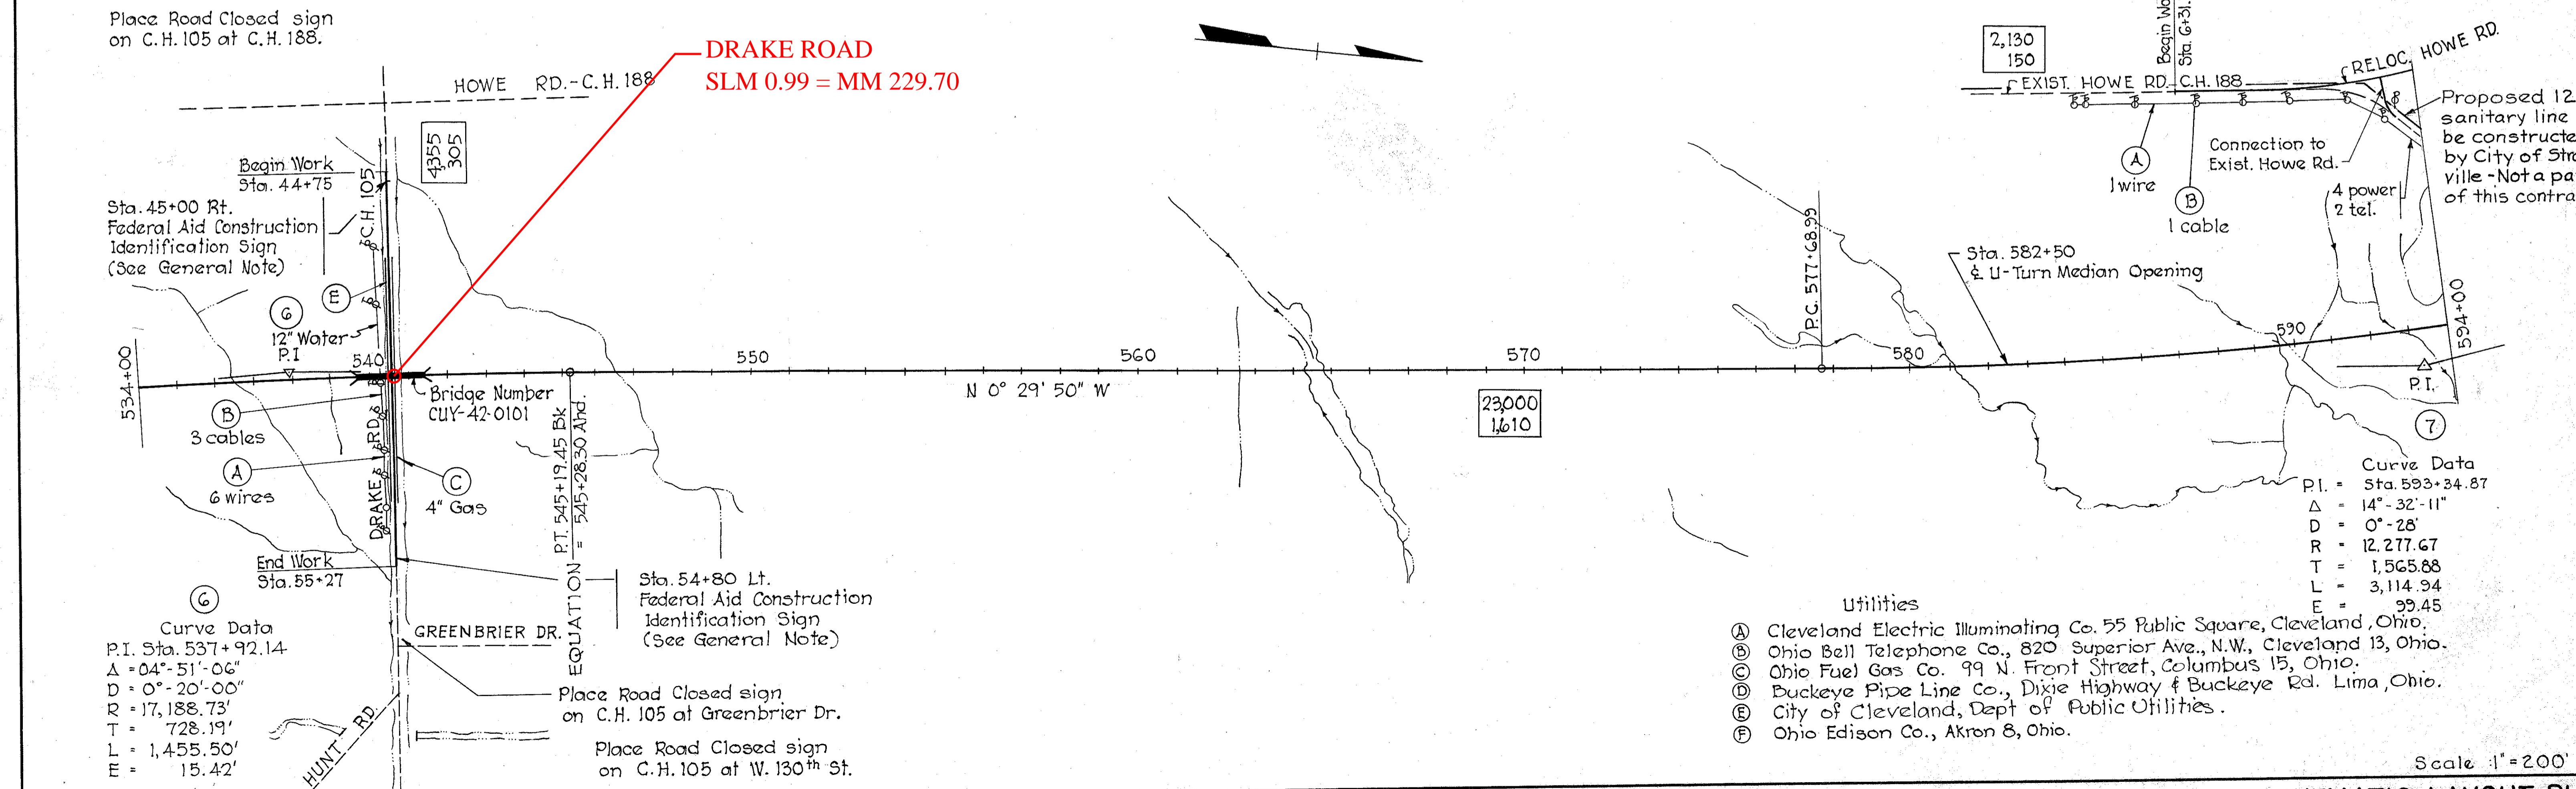

- Utilities
- (A) Cleveland Electric Illuminating Co. 55 Public Square, Cleveland, Ohio.
  - (B) Ohio Bell Telephone Co., 820 Superior Ave., N.W., Cleveland 13, Ohio.
  - (C) Ohio Fuel Gas Co. 99 N. Front Street, Columbus 15, Ohio.
  - (D) Buckeye Pipe Line Co., Dixie Highway & Buckeye Rd. Lima, Ohio.
  - (E) City of Cleveland, Dept of Public Utilities.
  - (F) Ohio Edison Co., Akron 8, Ohio.