


MICROFILMED  
FEB 18 1985

SR 82  
SLM 2.57 = MM 231.28

Proposed twelve-inch sanitary line to be constructed by City of Strongsville - Not a part of this contract.

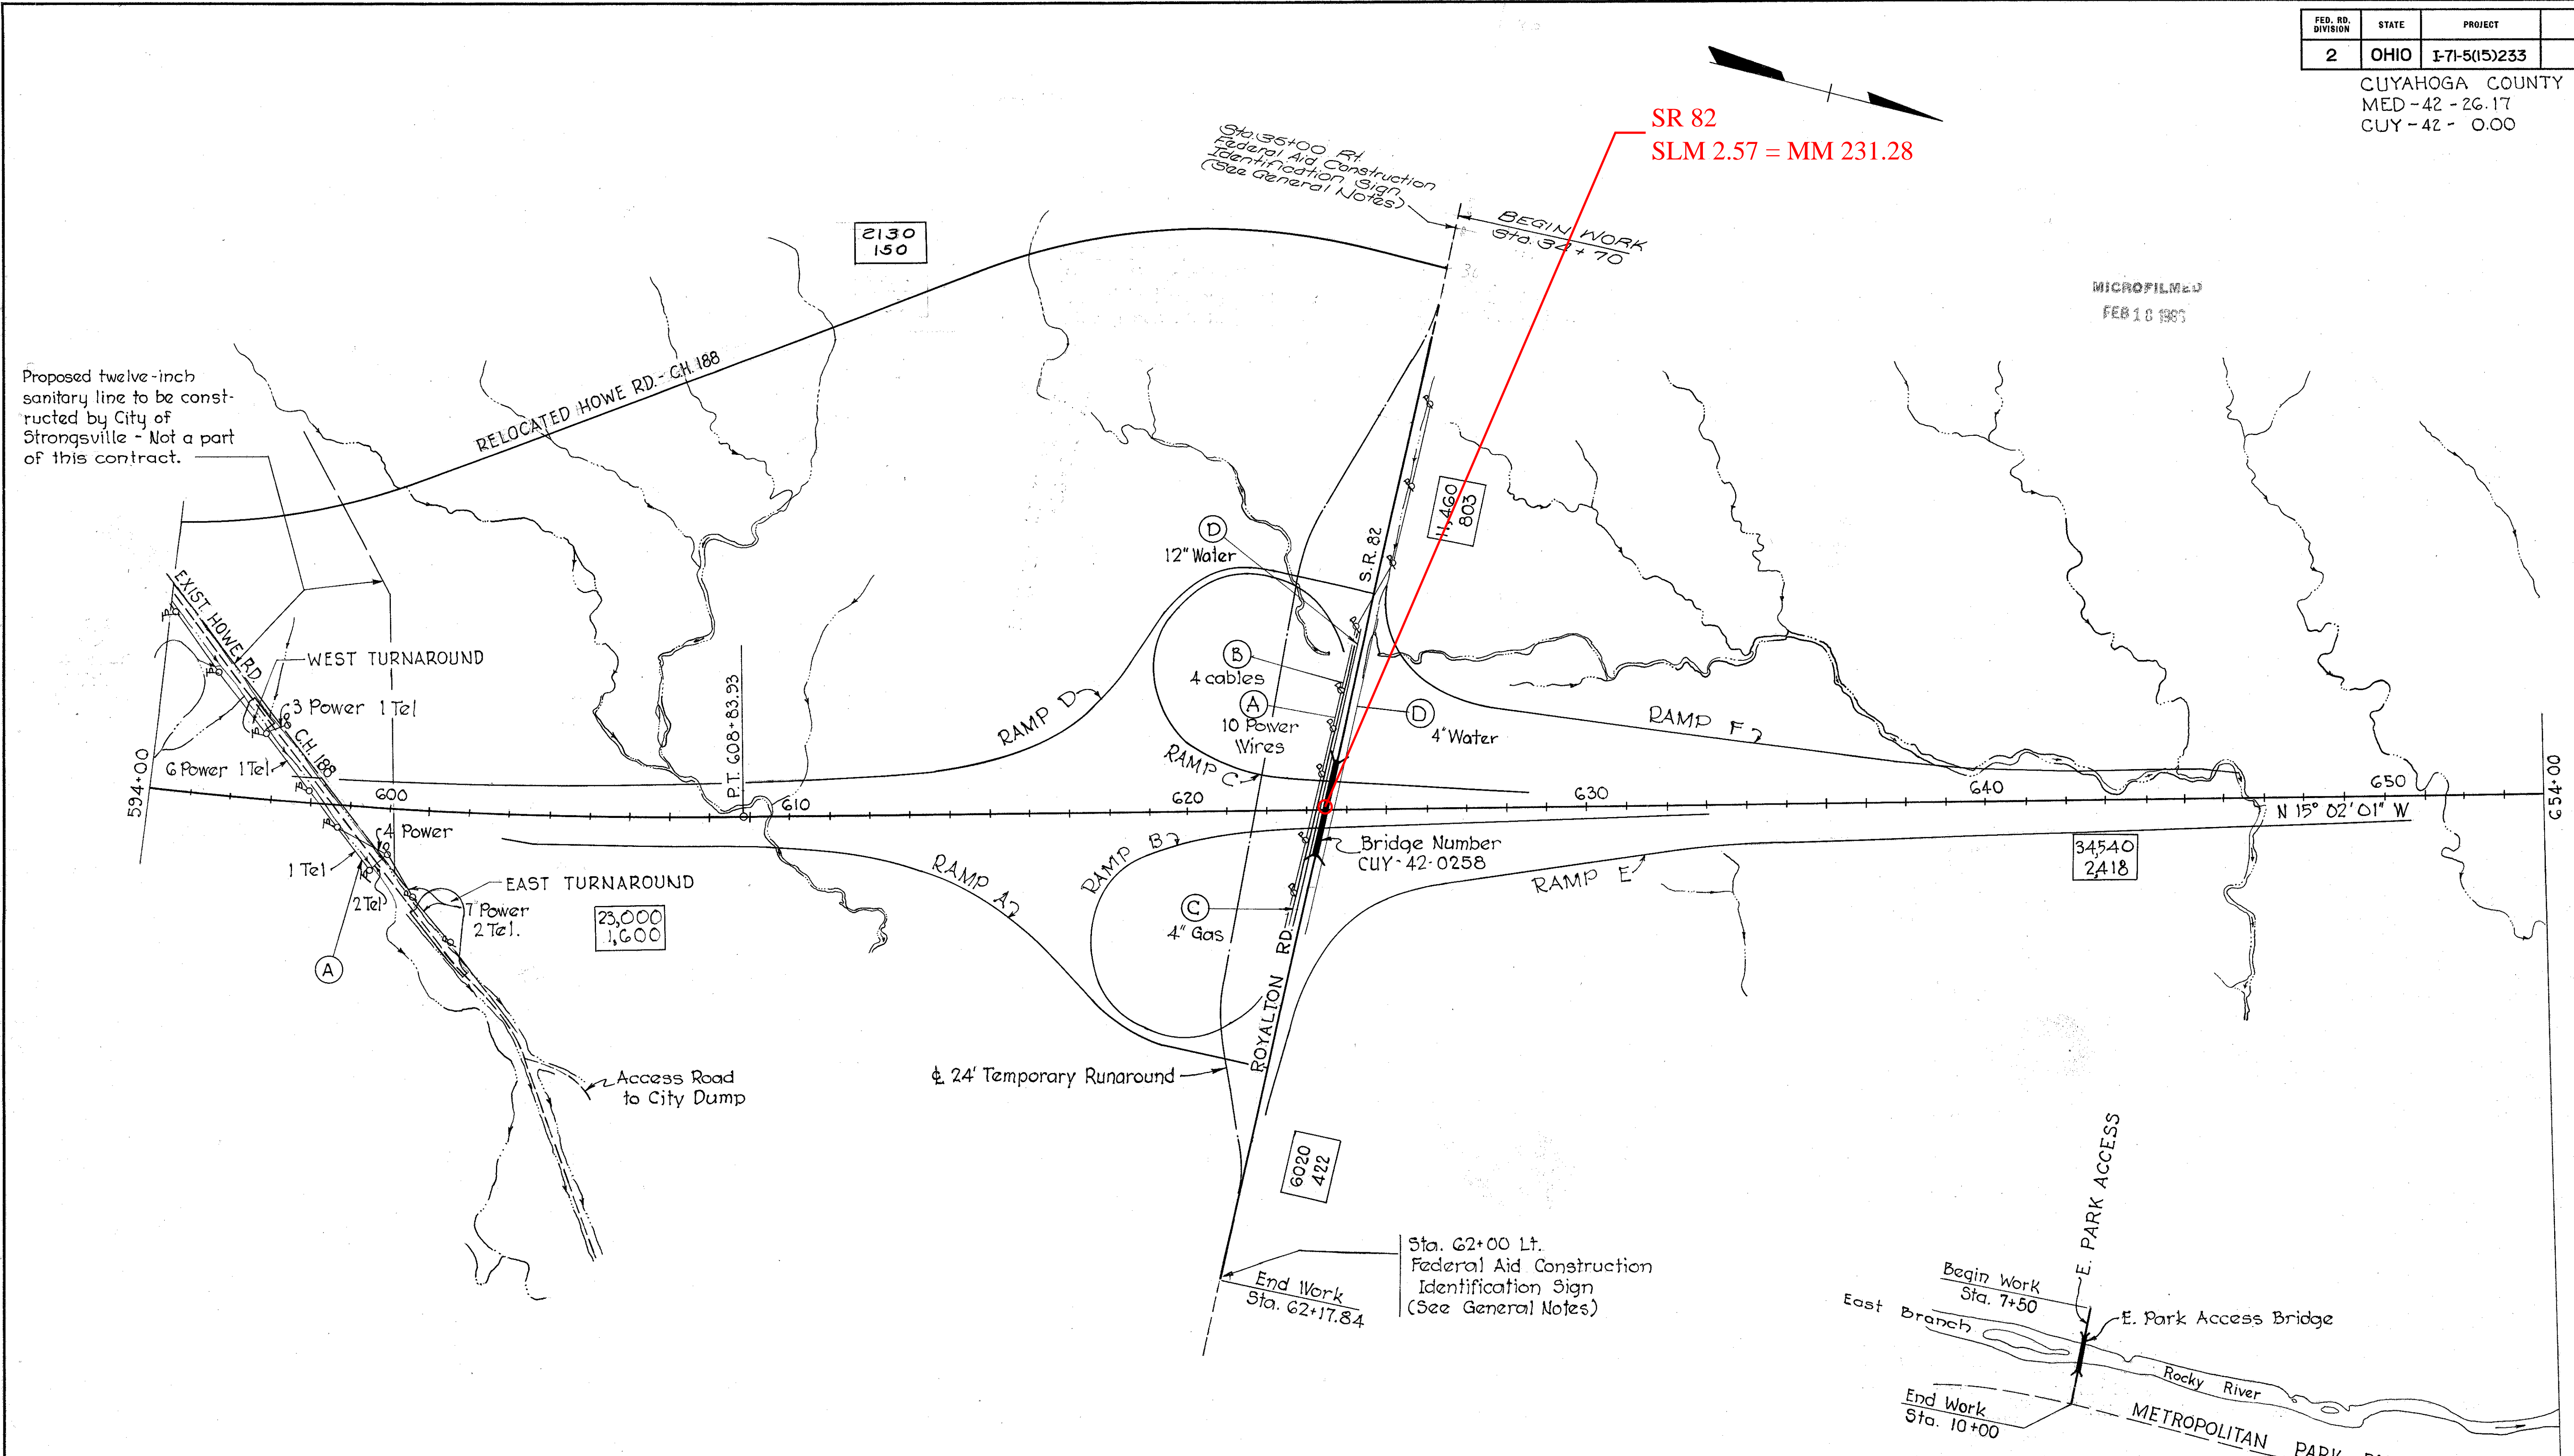

LEGEND  
 — Proposed Work  
 - - - Existing Road

ADT (1975)  
DDHV

- Utilities
- (A) Cleveland Electric Illuminating Co. 55 Public Square, Cleveland Ohio.
  - (B) Ohio Bell Telephone Co. 820 Superior Ave., N.W., Cleveland 13, Ohio.
  - (C) Ohio Fuel Gas Co. 99 N. Front Street, Columbus 15, Ohio.
  - (D) City of Cleveland, Dept. of Public Utilities.

Scale: 1" = 200'