

Marker will be furnished and erected on the Left by State forces prior to acceptance of this improvement.

VALLEY PARKWAY
 SLM 3.32 = MM 232.03


SLM 3.38 = MM 232.09

FED. RD. DIVISION	STATE	PROJECT
2	OHIO	I-71-5(15)233

5
302

CUYAHOGA COUNTY
 MED-42-26.17
 CUY-42- 0.00

MICROFILMED
 FEB 18 1985

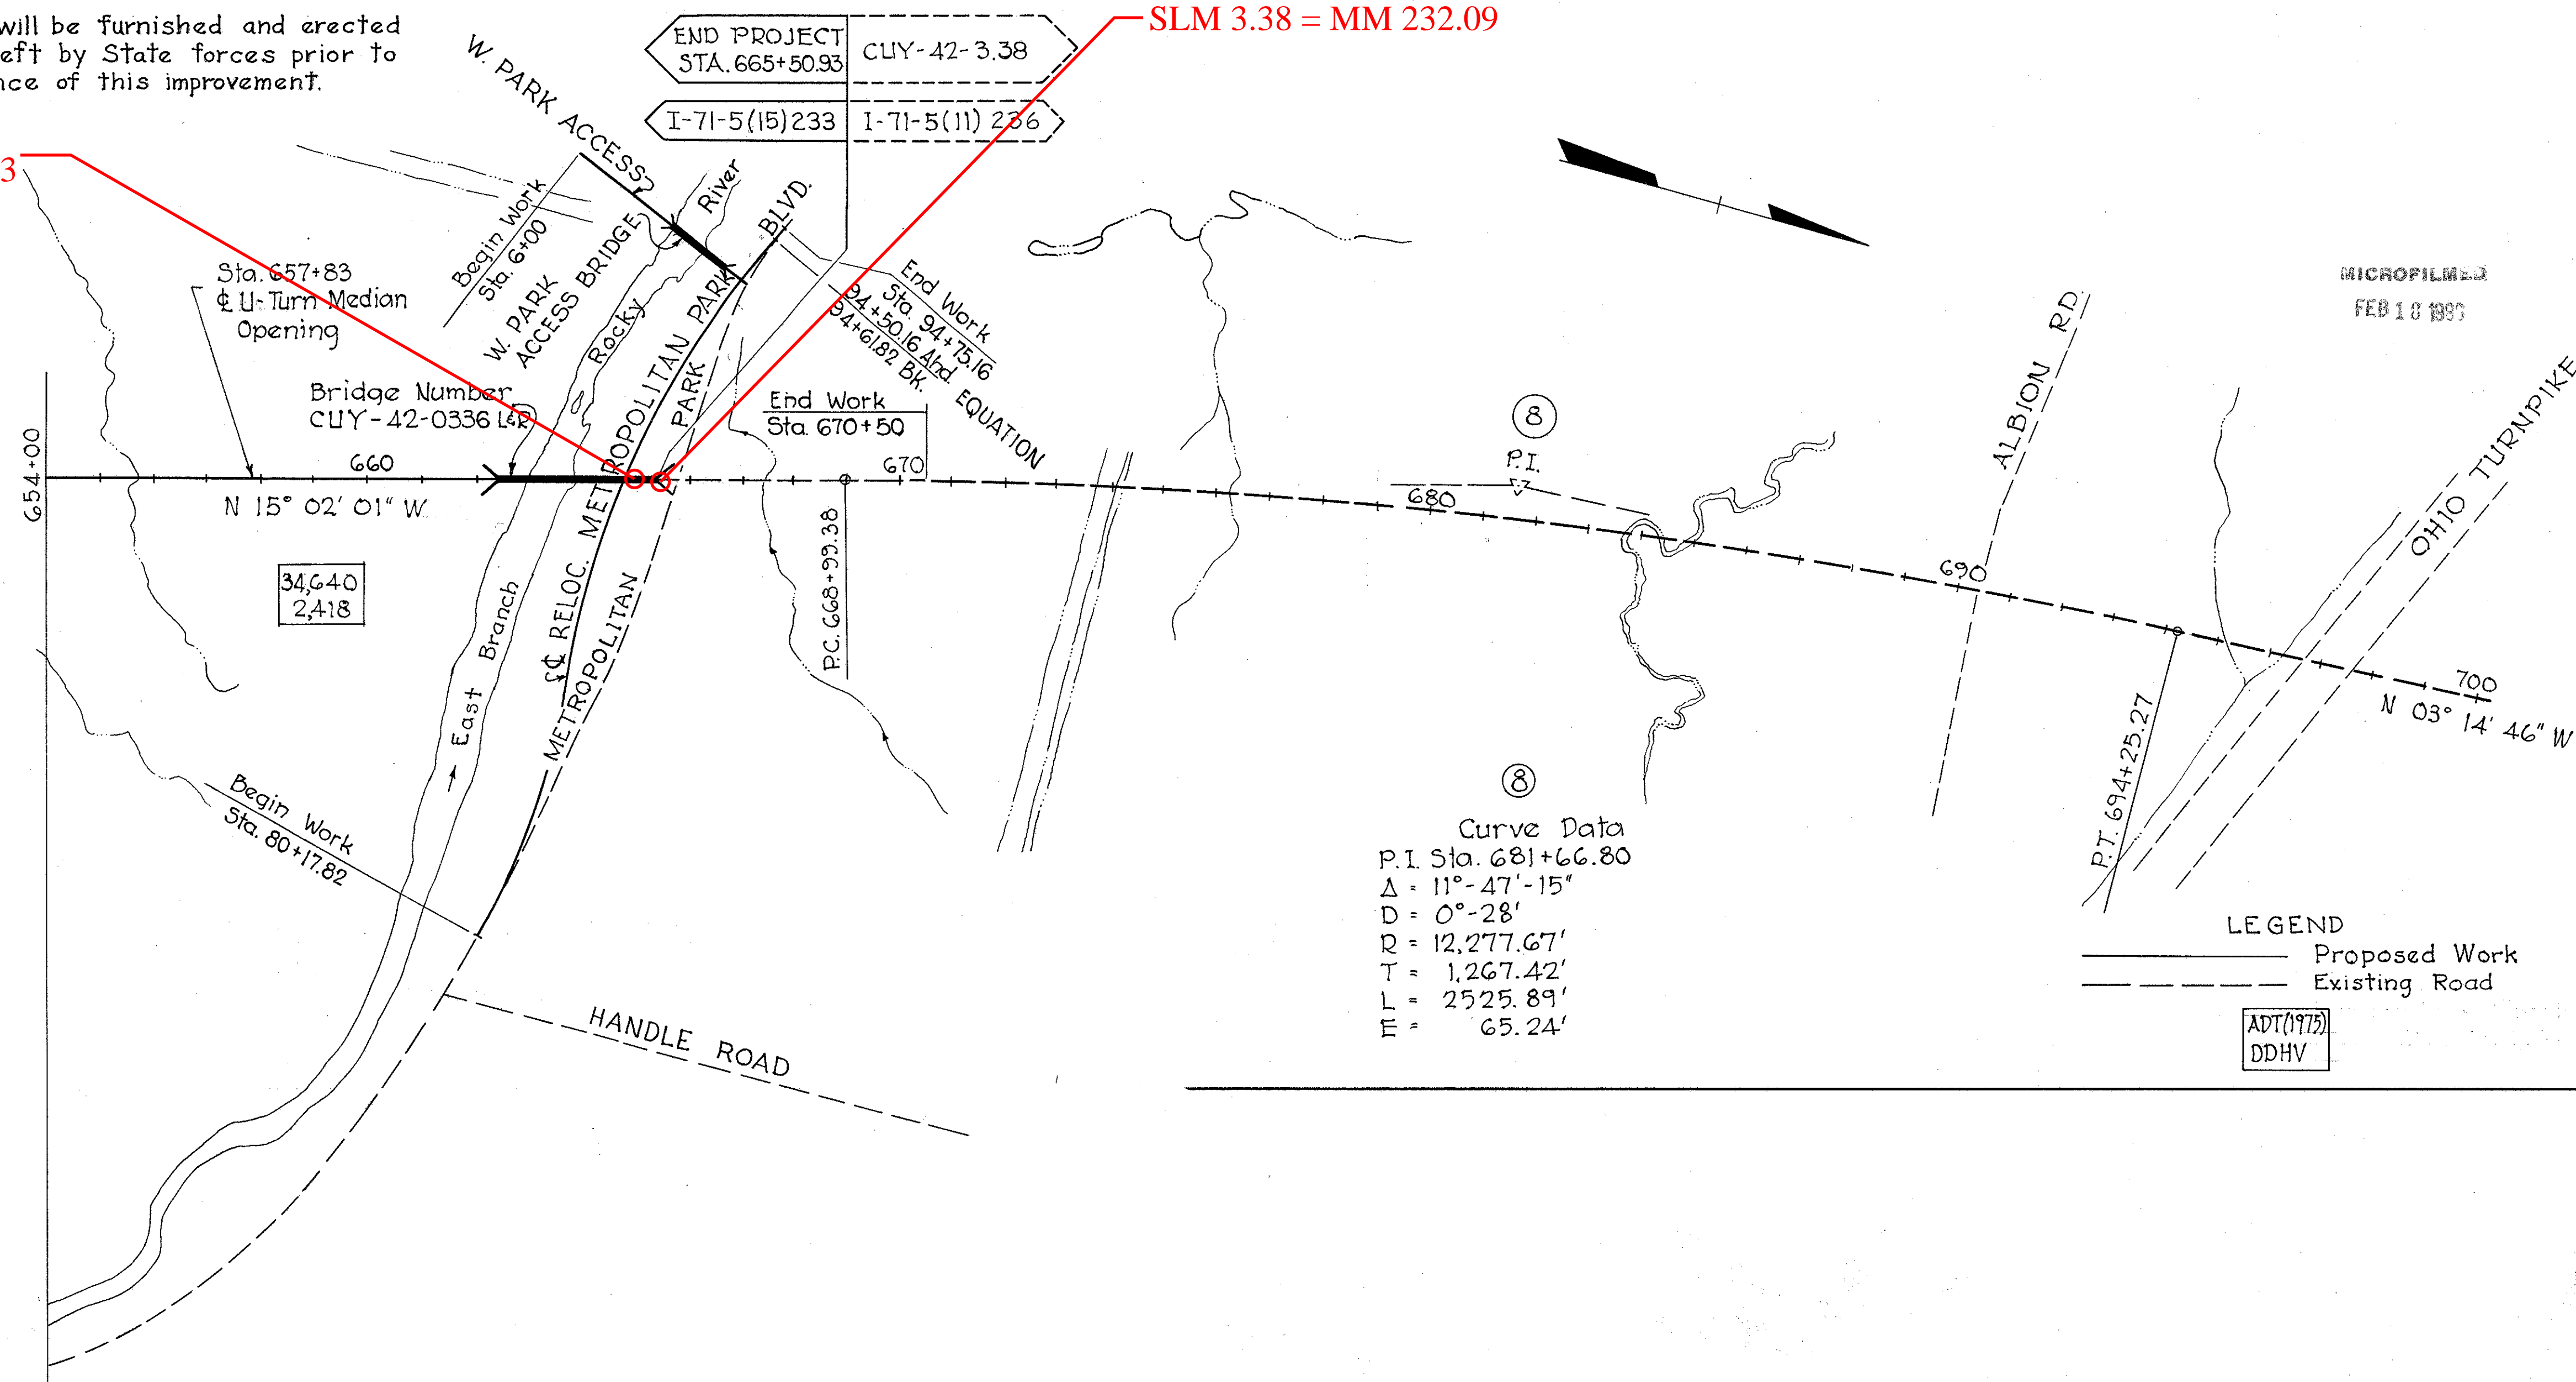

LEGEND
 — Proposed Work
 - - - Existing Road

ADT(1975)
 DDHV

Scale: 1" = 200'