
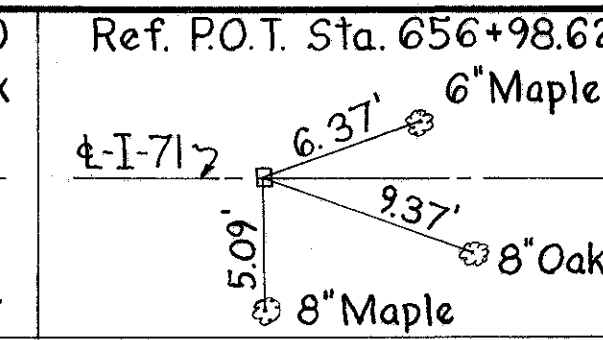
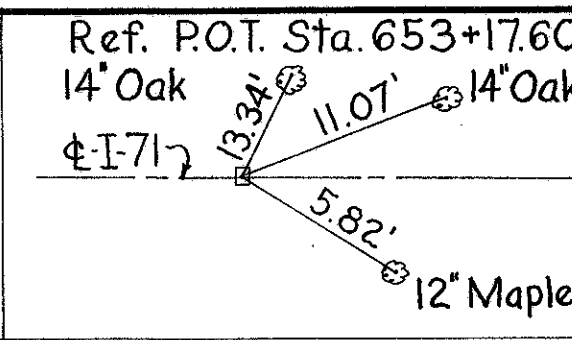


SEE 2001 CUY-71-0.00 PLANS FOR
MODIFICATIONS TO STORM SEWERS


B.M. #C-16 Elev. 864.82
Nail on E. side of 16" Oak Tree
200' W. of Sta. 653+50

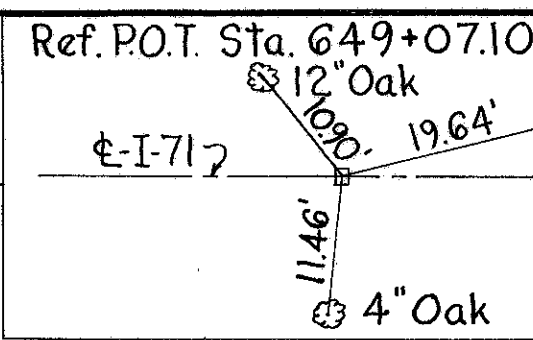

CUYAHOGA COUNTY
MED-42-26.17
CUY-42-0.00

FED. RD. DIVISION	STATE	PROJECT
2	OHIO	I-71-5(15)233

53
302

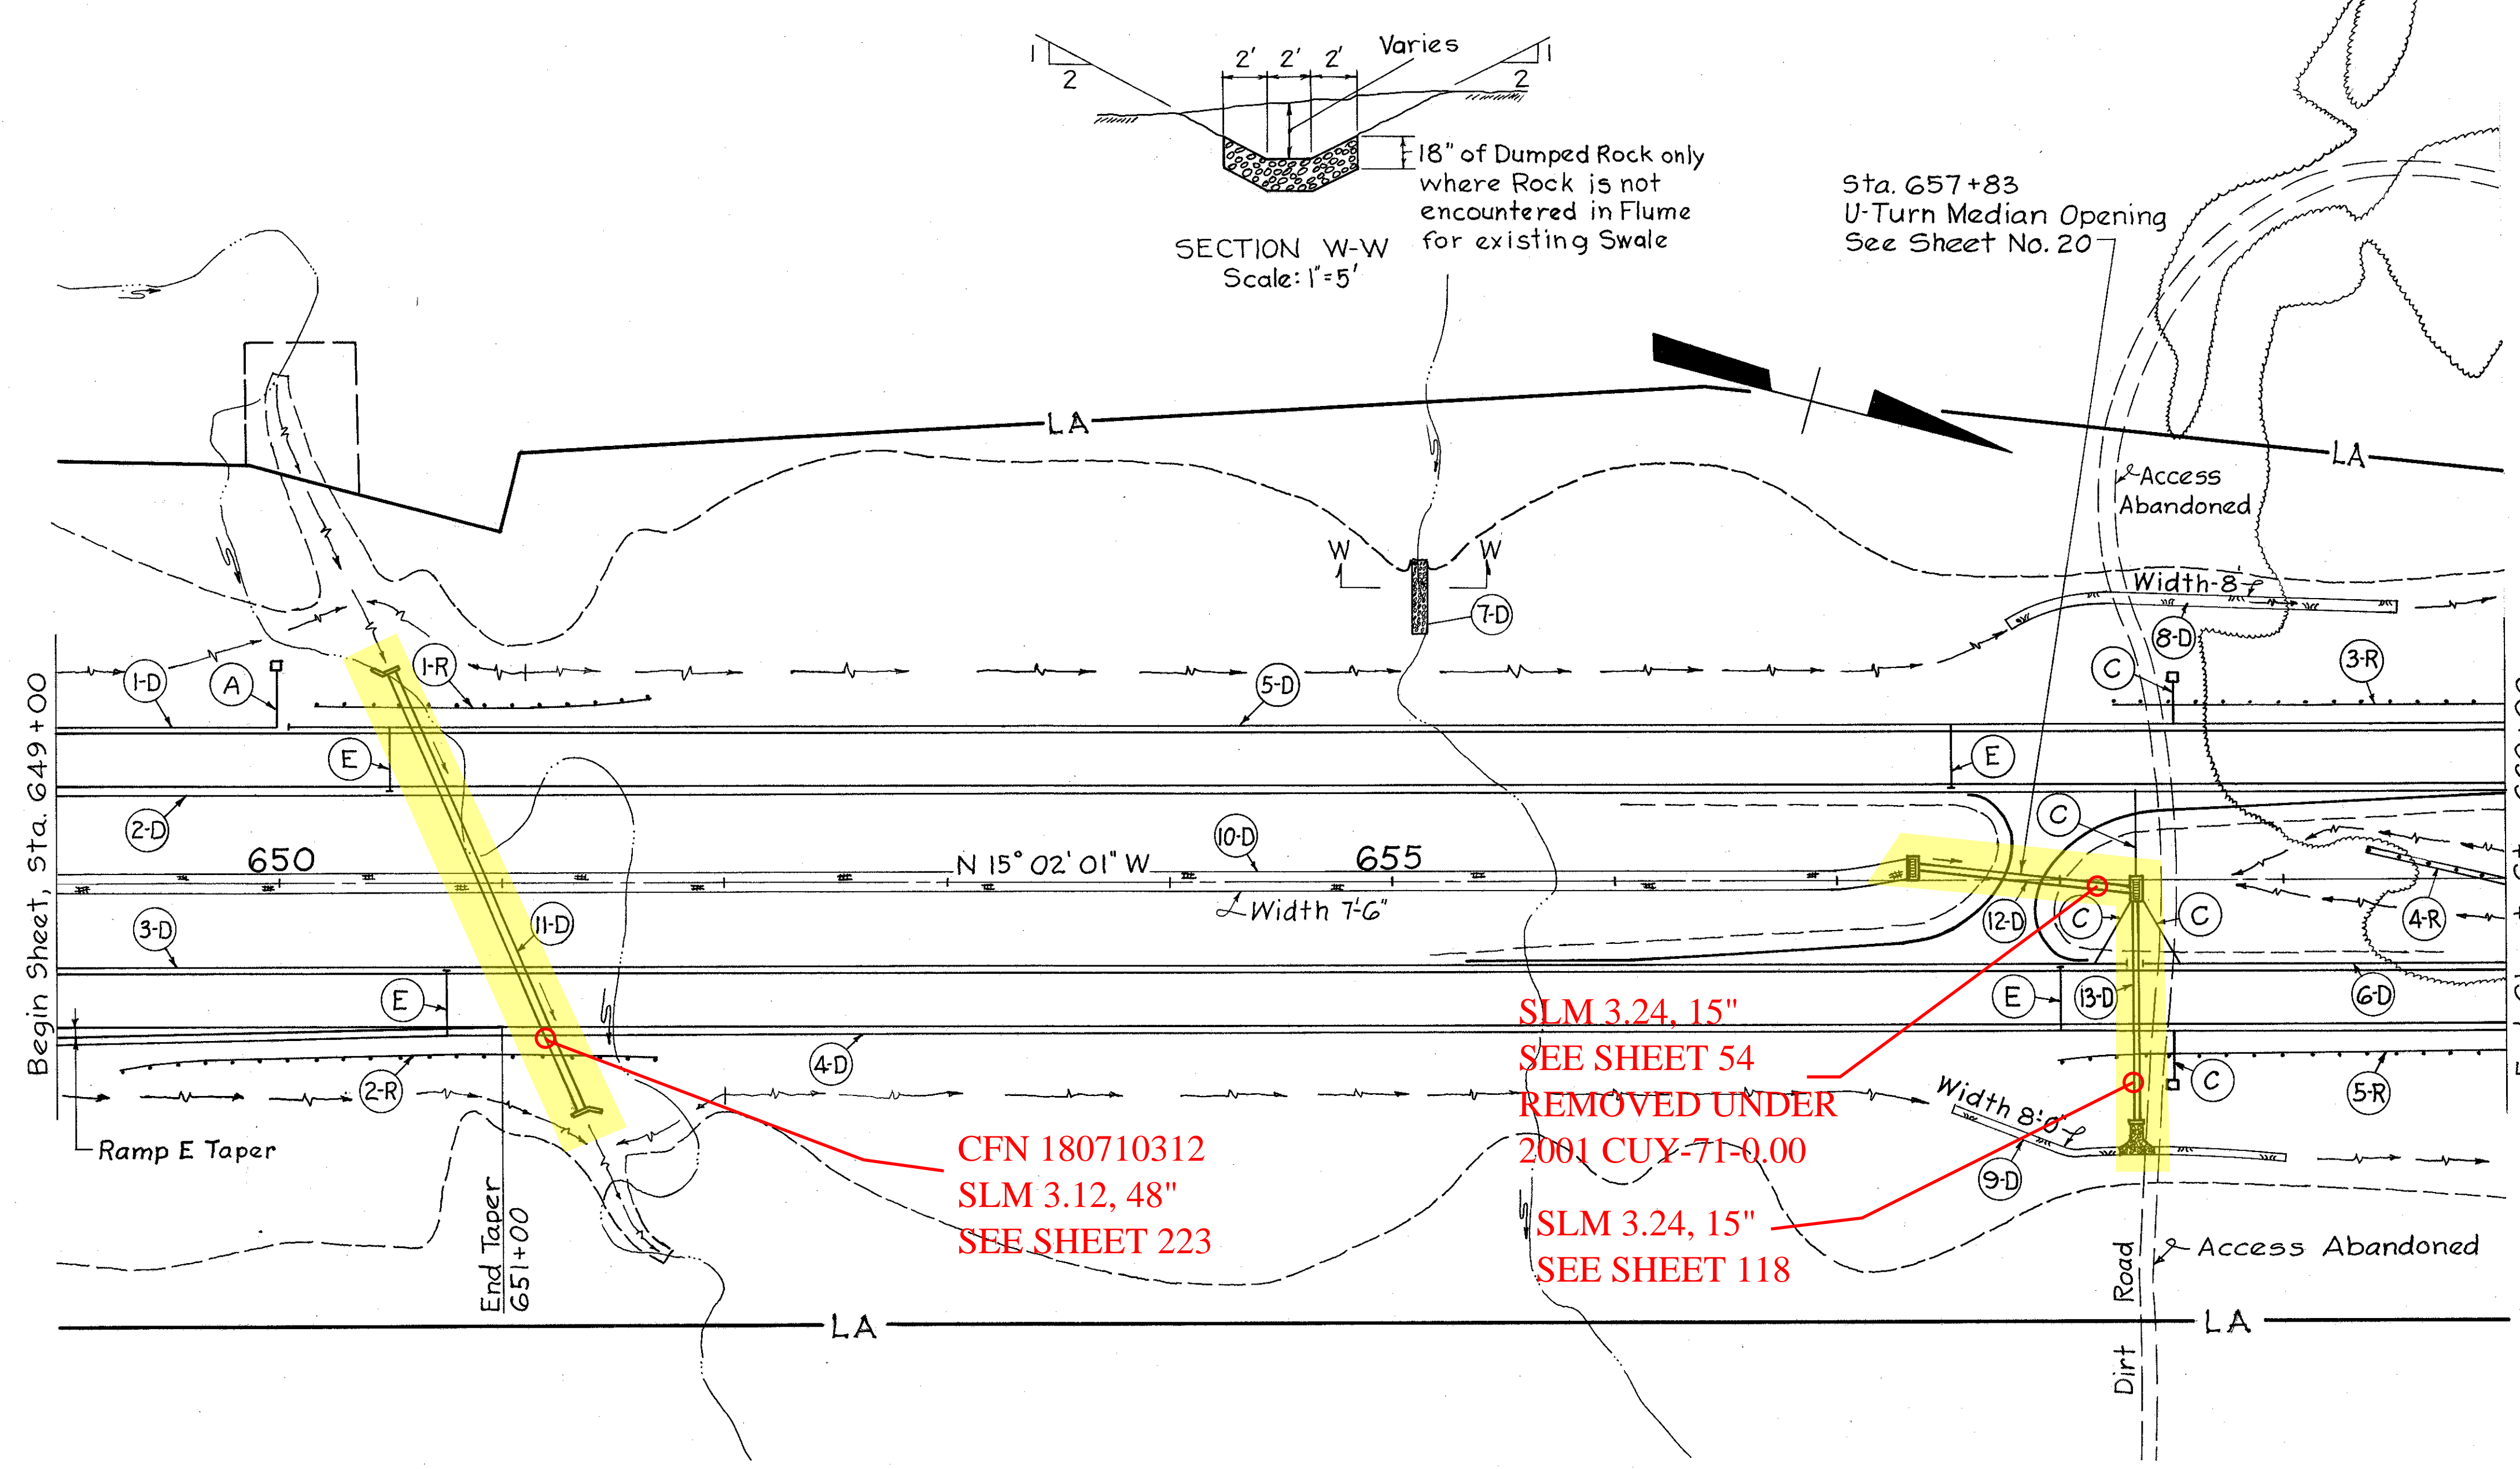

SLM 3.24, 15"
SEE SHEET 54
REMOVED UNDER
2001 CUY-71-0.00
SLM 3.24, 15"
SEE SHEET 118

CFN 180710312
SLM 3.12, 48"
SEE SHEET 223

(A) See Detail Sheet No. 14

REF. STATION TO STATION	SIDE	ESTIMATED QUANTITIES													TOTALS					
		I-1	I-2	I-5	I-8	I-10	I-15	E-3	L-10	L-120	Jute	So. Yd.	So. Yd.							
		Class A-1 Pipe 48" 15' Lin. Ft.	Class A-1 Pipe 15' Lin. Ft.	Class B-1 Pipe 15' Lin. Ft.	Class C-1 Pipe 15' Lin. Ft.	Class D-1 Pipe 15' Lin. Ft.	Masonry Endwall Type D1 Cu. Yd.	Manhole Type E Bend Wye Tee	Pipe Specials	Str. No. 4 Rock C.B.	Dumped Rock	Barrier Channel	Excav. Scaffolding Matting	Excav. Scaffolding Matting	Excav. Scaffolding Matting					
649+00 to 650+00	Lt.	196	120	934	10	10	0	1												
649+00 to 660+00	Lt.	164	962	10	10	10		3												
649+00 to 660+00	Rt.	164	940	10*	10	10		3												
650+00 to 660+00	Lt.	196	164	846	10	10		1												
658+38 to 660+00	Lt.																			
657+90 to 659+50	Lt.																			
657+50 to 659+00	Lt.																			
649+00 to 657+33	Med.	218	100																	
650+52 to 658+33	Med.																			
657+33 to 658+33	Rt.						17.62													
650+18 to 651+68	Lt.						0.26													
649+30 to 651+67.5	Rt.																			
658+25 to 660+00	Lt.																			
658+35 to 660+00	Med.																			
658+00 to 660+00	Rt.																			
TOTALS		104	218	100	720	3802	40	30	1762	0.26	1	2	7	2	46	162.5	70	186	312	694