

SEE 1963 CUY-71-0.00 PLANS
FOR ORIGINAL CONSTRUCTION
OF STORM SEWERS


CFN 180710073
SLM 0.72, 36"
SEE SHEET 136

CUY-71-0.00

OHIO
FHWA REGION 5
FEDERAL PROJECT


84
361

PLOT SUBMITTED: 04-AUG-1998 11:57

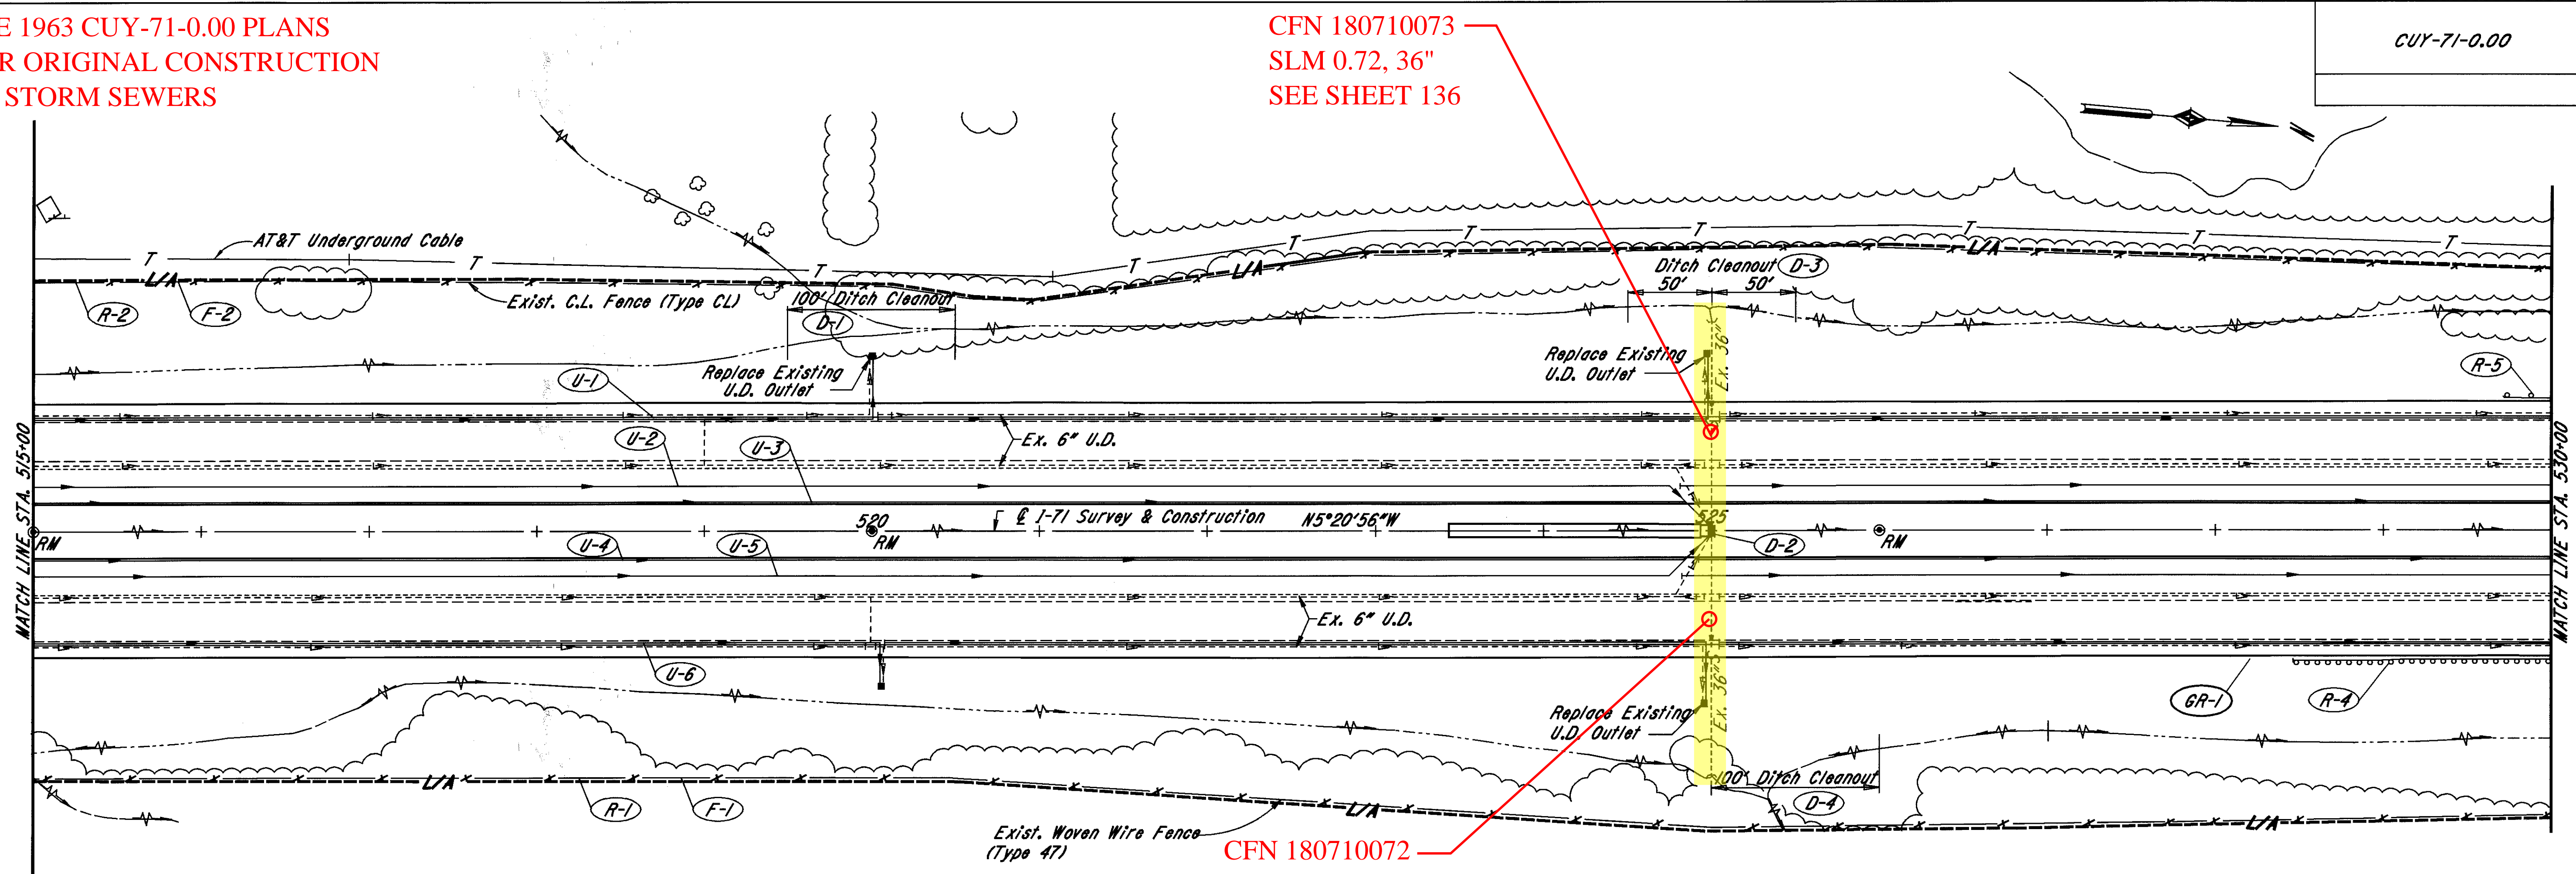

CFN 180710072
SLM 0.72, 36"
SEE SHEET 136

PLOTTED BY: fkonopka
PLOTTER: FROM: sberpi d08459 dgdgn 307pp03.dgn

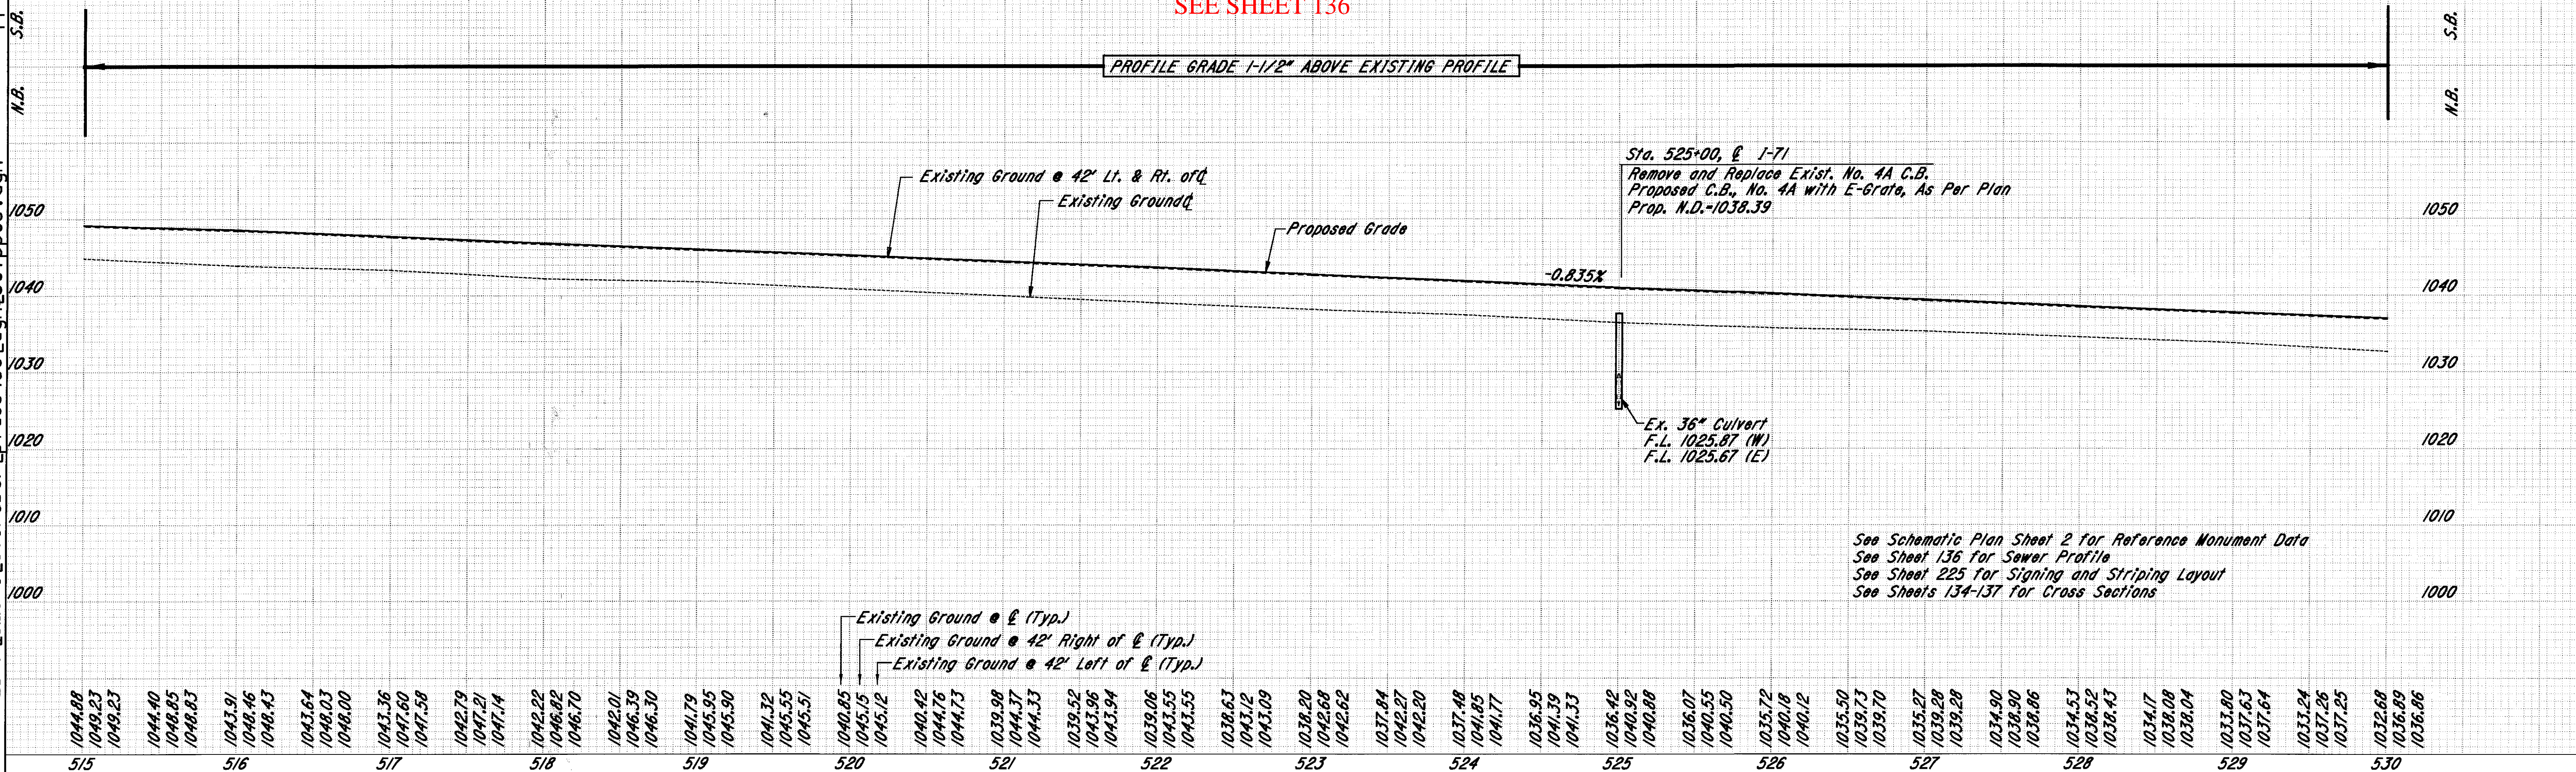

See Schematic Plan Sheet 2 for Reference Monument Data
See Sheet 136 for Sewer Profile
See Sheet 225 for Signing and Striping Layout
See Sheets 134-137 for Cross Sections

I-71 PLAN & PROFILE STA. 515+00 TO STA. 530+00