


SEE 1963 CUY-71-0.00 PLANS  
FOR ORIGINAL CONSTRUCTION  
OF STORM SEWERS

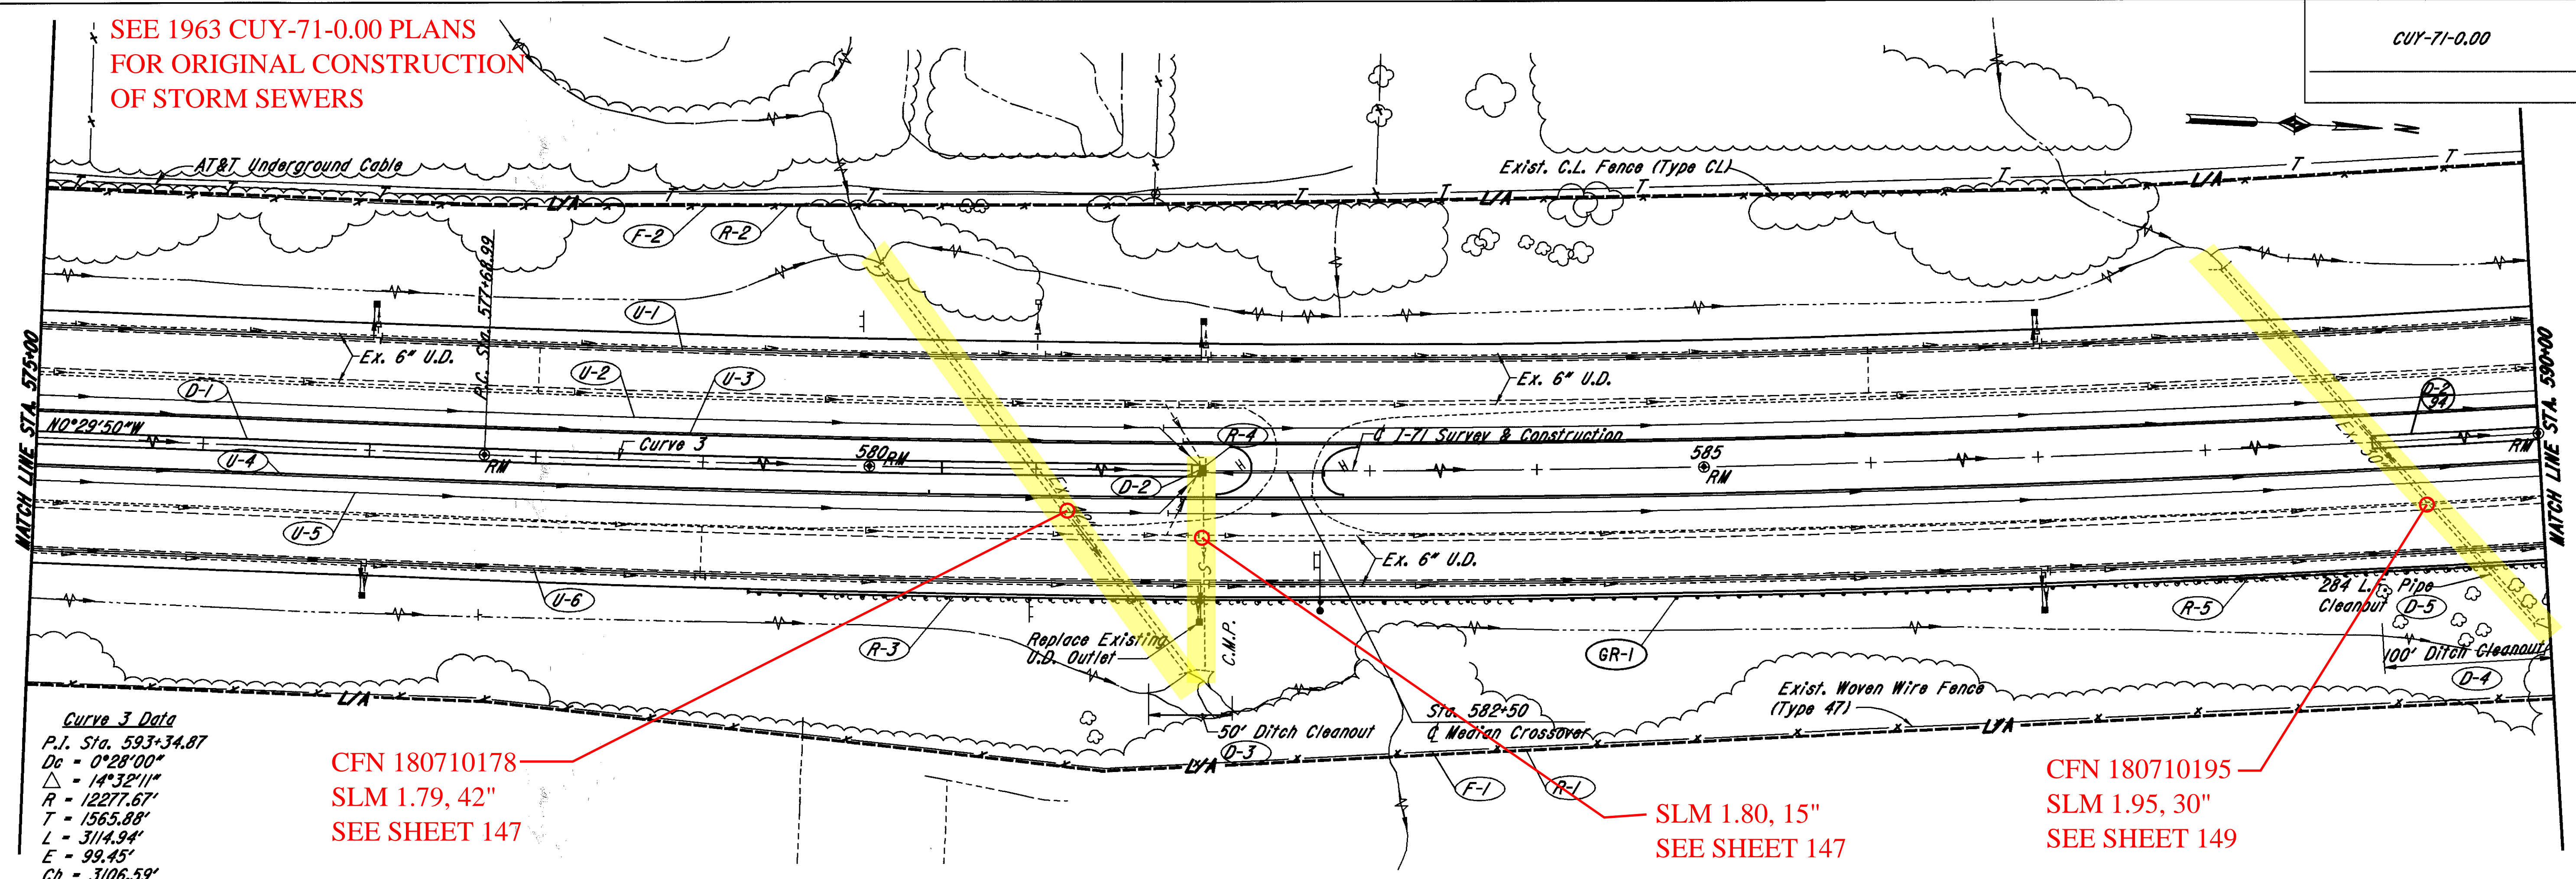

Curve 3 Data  
 P.I. Sta. 593+34.87  
 Dc = 0°28'00"  
 Δ = 14°32'11"  
 R = 12277.67'  
 T = 1565.88'  
 L = 3114.94'  
 E = 99.45'  
 Ch = 3106.59'


CFN 180710178  
 SLM 1.79, 42"  
 SEE SHEET 147

SLM 1.80, 15"  
 SEE SHEET 147

CFN 180710195  
 SLM 1.95, 30"  
 SEE SHEET 149

PLOT SUBMITTED:04 -AUG-1998 11:59

PLOTTED BY: fkonopka  
PLOTTER: 307pp07.dgn

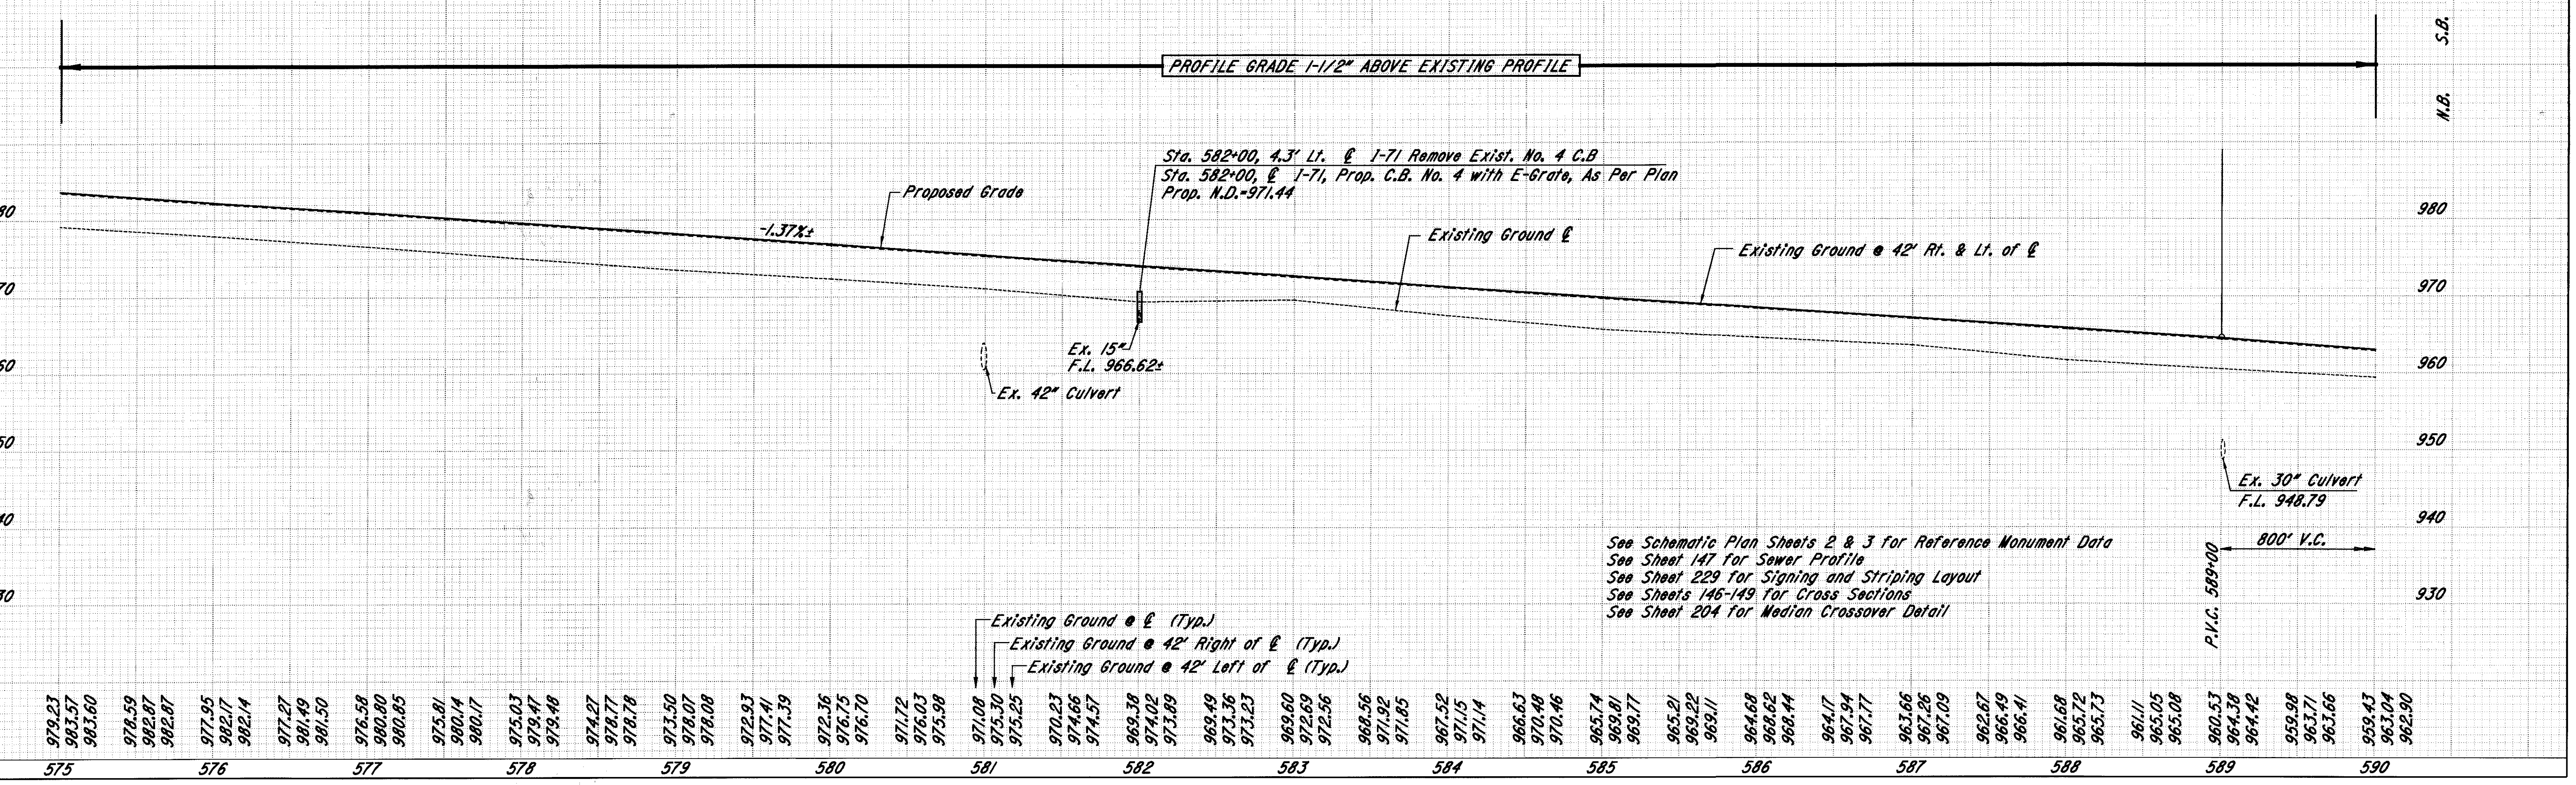

979.23	978.59	977.95	977.27	976.58	975.81	975.03	974.27	973.50	972.93	972.36	971.72	971.08	970.23	993.38	969.60	968.56	967.52	966.63	965.74	964.68	963.66	962.67	961.68	960.53	959.98	959.43	962.90			
983.57	982.87	982.17	981.49	980.80	980.14	979.47	978.77	978.07	977.41	976.75	976.03	975.30	974.66	974.02	973.36	972.69	971.92	971.14	970.48	969.81	969.11	968.42	967.72	967.09	966.42	965.72	965.05	964.42	963.71	963.04
983.60	982.87	982.14	981.49	980.85	980.17	979.48	978.78	978.08	977.39	976.70	976.03	975.30	974.66	974.02	973.36	972.69	971.92	971.14	970.46	969.77	969.11	968.44	967.77	967.09	966.42	965.72	965.08	964.42	963.71	963.04

See Schematic Plan Sheets 2 & 3 for Reference Monument Data  
 See Sheet 147 for Sewer Profile  
 See Sheet 229 for Signing and Striping Layout  
 See Sheets 146-149 for Cross Sections  
 See Sheet 204 for Median Crossover Detail

1-71 PLAN & PROFILE STA. 575+00 TO STA. 590+00