


MICROFILMED
FEB 21 1984

CITY OF STRONGSVILLE

CITY OF MIDDLEBURG HEIGHTS

SLM 5.72 = MM 234.43

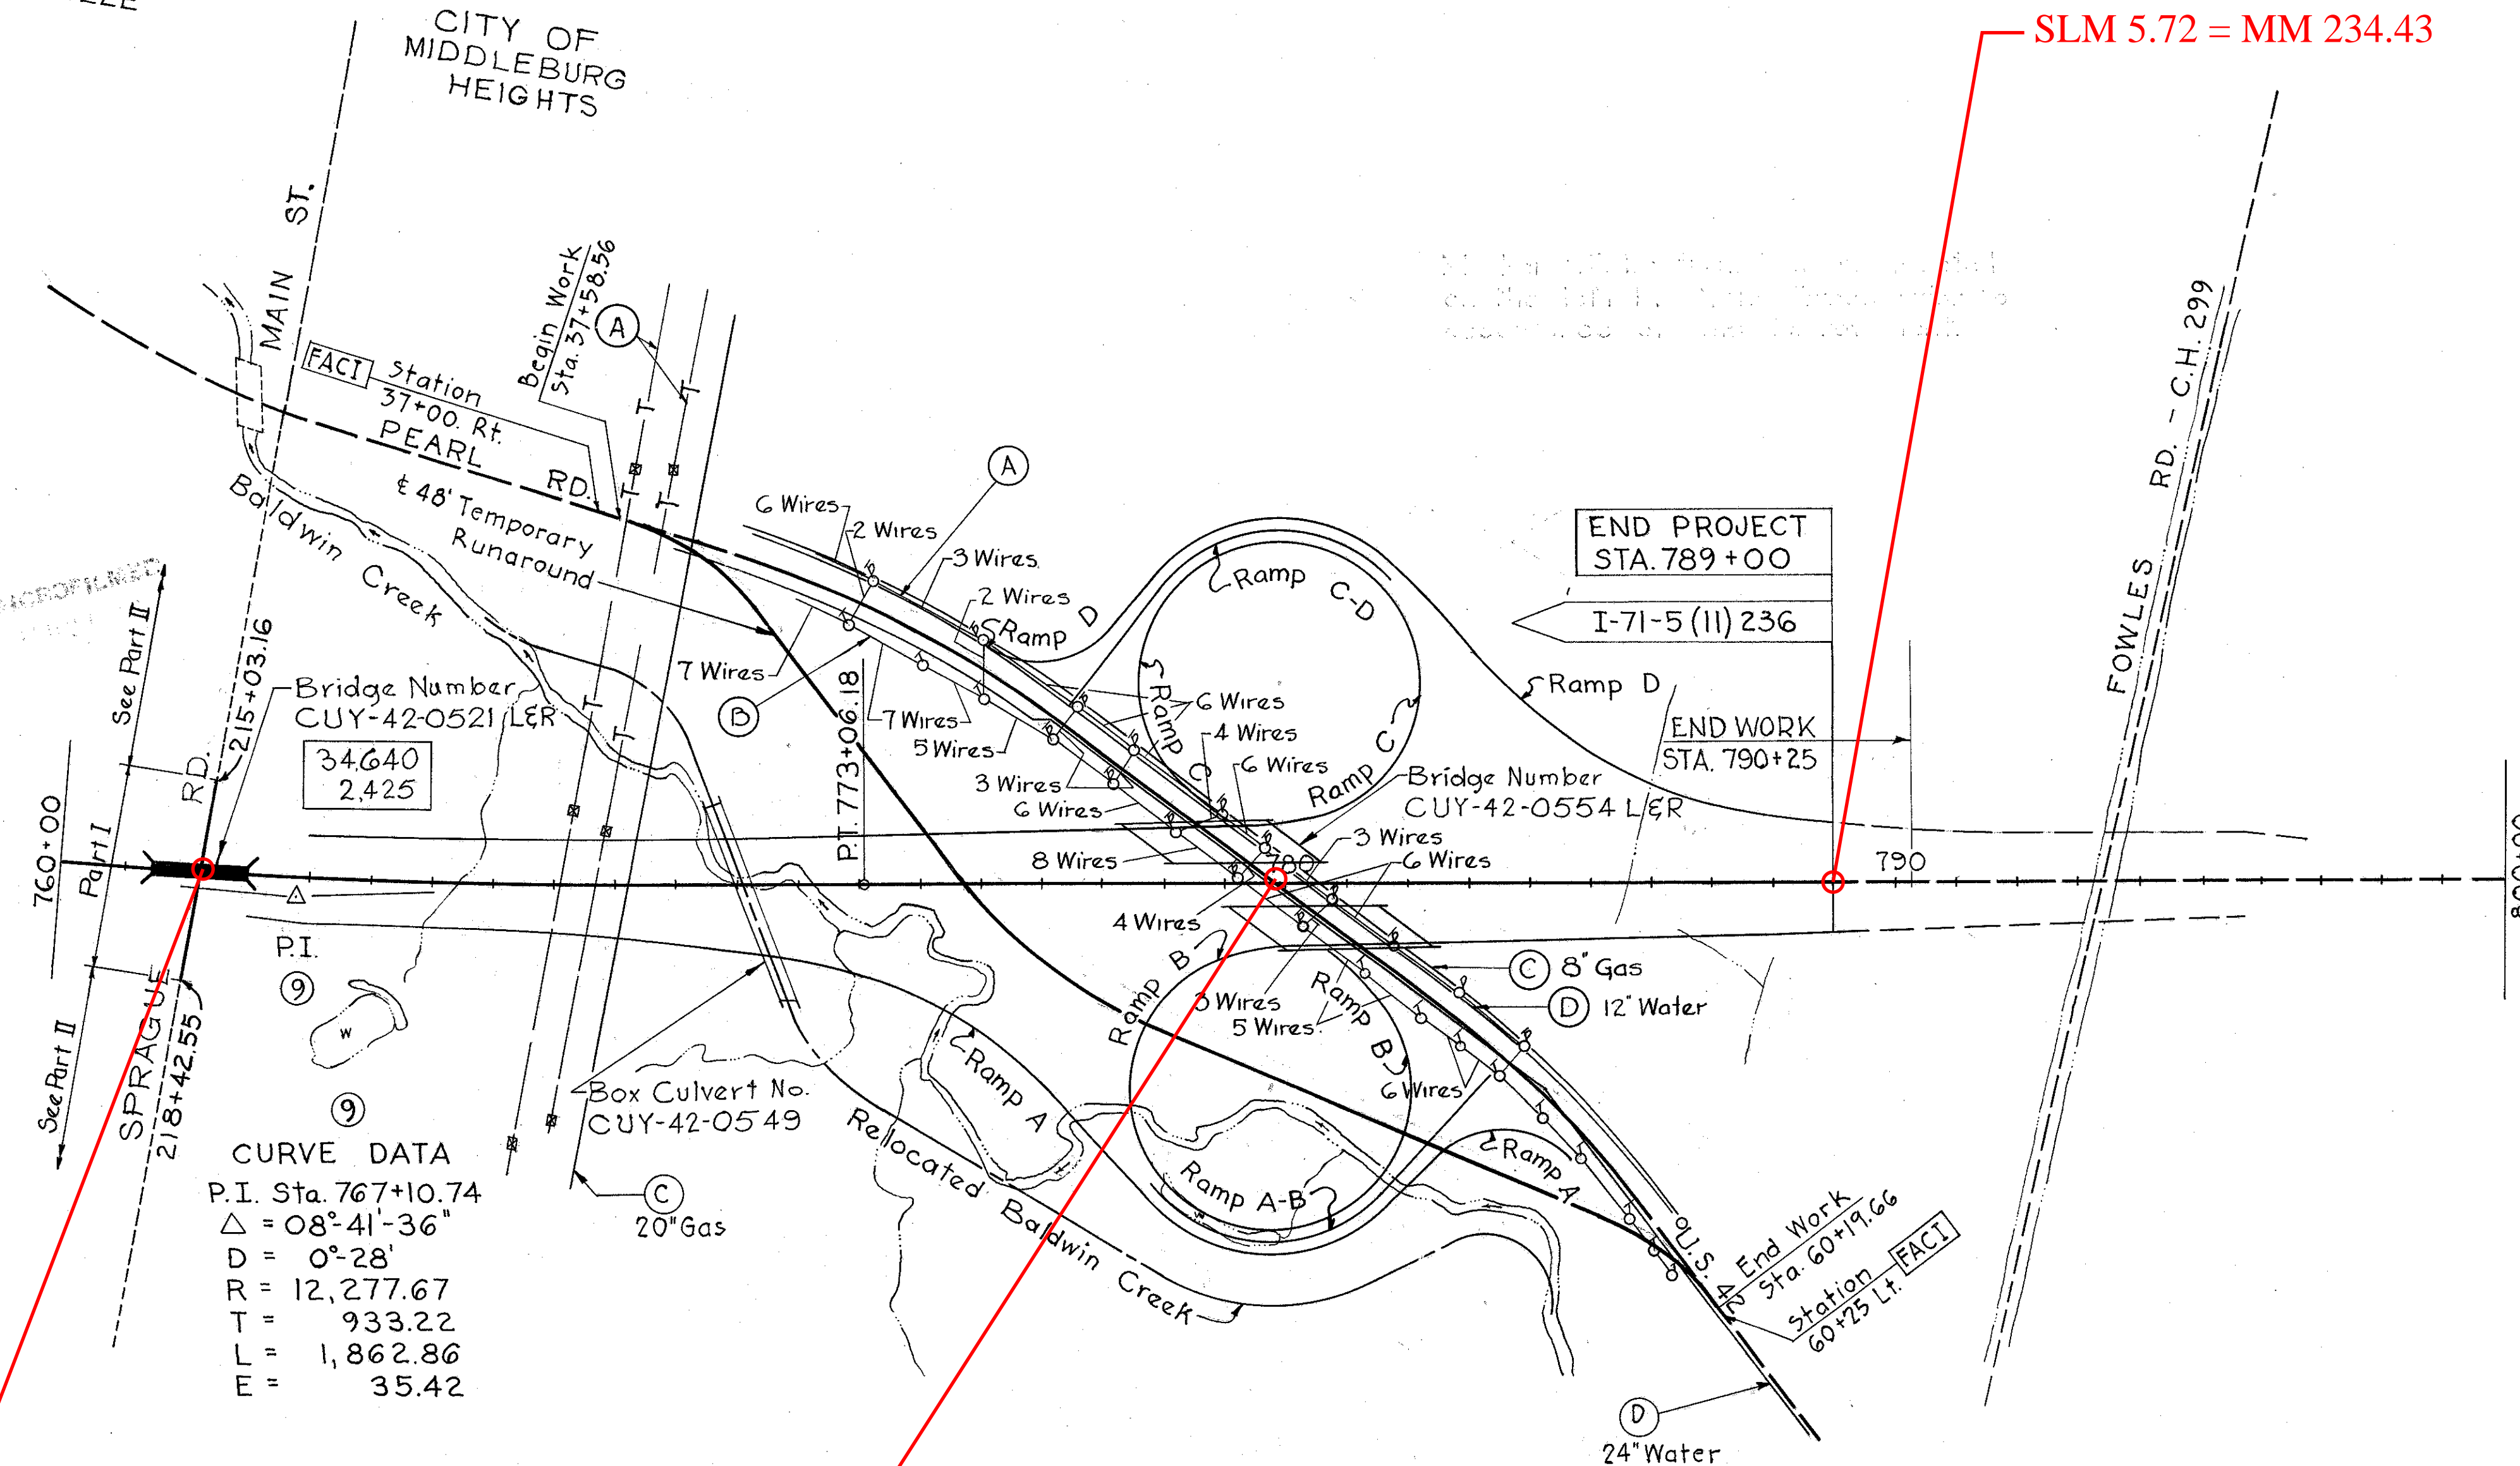

SPRAGUE ROAD
SLM 5.20 = MM 233.91

PEARL ROAD
SLM 5.52 = MM 234.23

CURVE DATA
P.I. Sta. 767+10.74
 $\Delta = 08^{\circ}41'36''$
D = 0'-28'
R = 12,277.67
T = 933.22
L = 1,862.86
E = 35.42

END PROJECT
STA. 789+00

I-71-5(11)236

END WORK
STA. 790+25

- (A) Cleveland Electric Illuminating Co., 55 Public Square, Cleveland, Ohio.
- (B) Ohio Bell Telephone Co., 820 Superior Ave, N.W. Cleveland 13, Ohio.
- (C) Columbia Gas of Ohio, Inc., 99 N. Front St, Columbus 15, Ohio.
- (D) City of Cleveland Dept. of Public Utilities, Cleveland 14, Ohio.

LEGEND
 Proposed Work
 Existing Road

ADT (1975)
DDHV