


See the 1962 GEA-322/306-2.64/11.97 Plans
For the Area Between SLM 2.64 and 2.87

I.C.H. 15 SEC. E
GEAUGA COUNTY

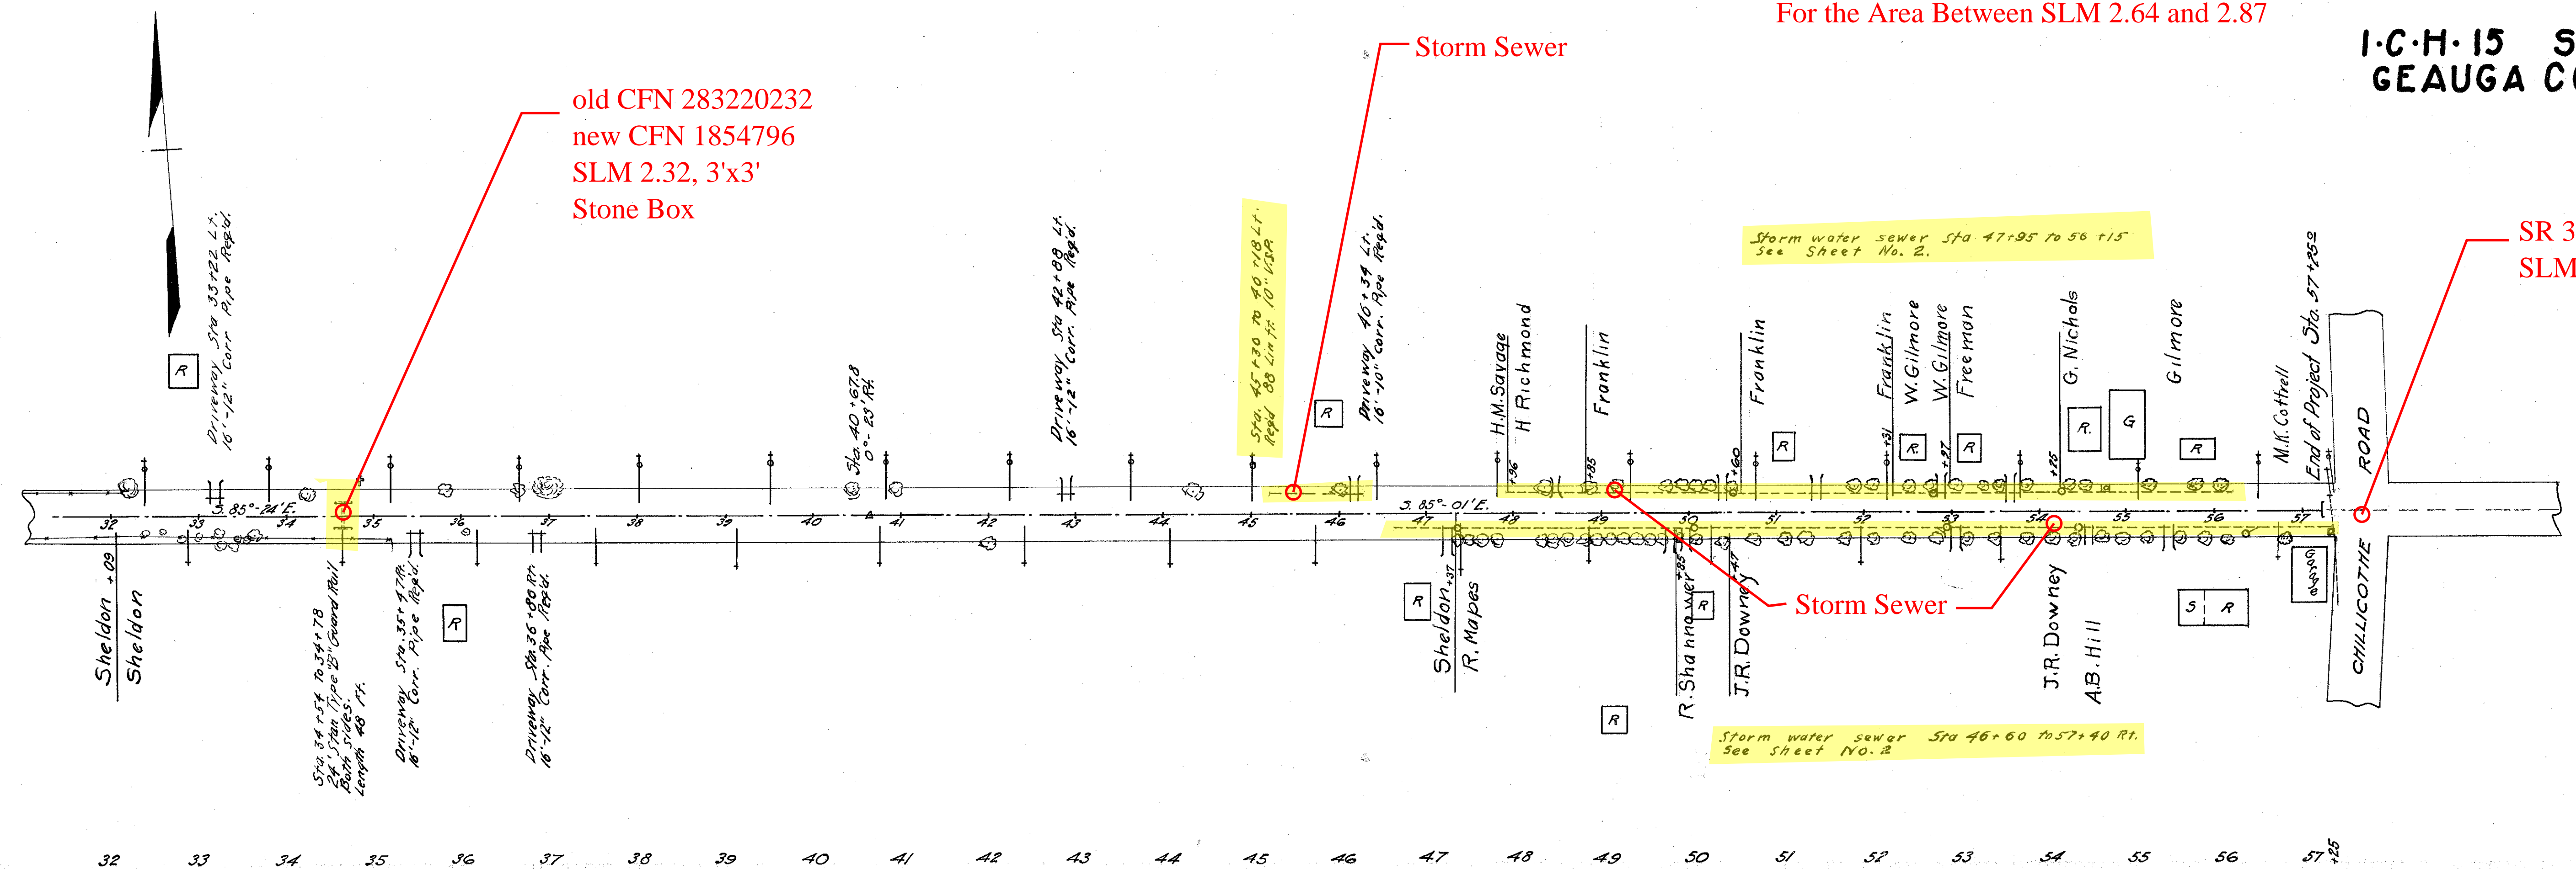

Note: Grade line shown is center line
Profile of old 14' concrete pavement.

Excav. 538.2 cu. yds.
Borrow 100.7 cu. yds.
Emb. 563.4 cu. yds.
+15% 84.5 cu. yds.

Excav. 564.0 cu. yds.
Borrow 76.3 cu. yds.
Emb. 556.8 cu. yds.
+15% 83.5 cu. yds.

Excav. 160.0 cu. yds.
Borrow 16.0 cu. yds.
Emb. 160.5 cu. yds.
+15% 43.9 cu. yds.

Sta. 56+85 to 67+25
Remove 4077.0 of old
concrete pavement
0.2 59. yds.

- 1157.24
- 1159.83
- 1167.35
- 1164.71
- 1165.97
- 1167.14
- 1169.62
- 1172.02
- 1174.64
- 1177.99
- 1181.81
- 1182.00
- 1192.24
- 1197.51
- 1202.71
- 1207.94
- 1212.98
- 1217.25
- 1220.48
- 1222.79
- 1223.53
- 1224.01
- 1224.02
- 1223.69
- 1223.09
- 1222.15
- 1219.68
- 1218.45
- 1217.16
- 1214.62
- 1213.54
- 1212.88
- 1212.70