


Excav. 405.6 Cu. Yds.  
Emb. 485.1 Cu. Yds.

SEE SHEET 3/10 FOR STORM SEWER

SEE SHEET 3/10 FOR STORM SEWER

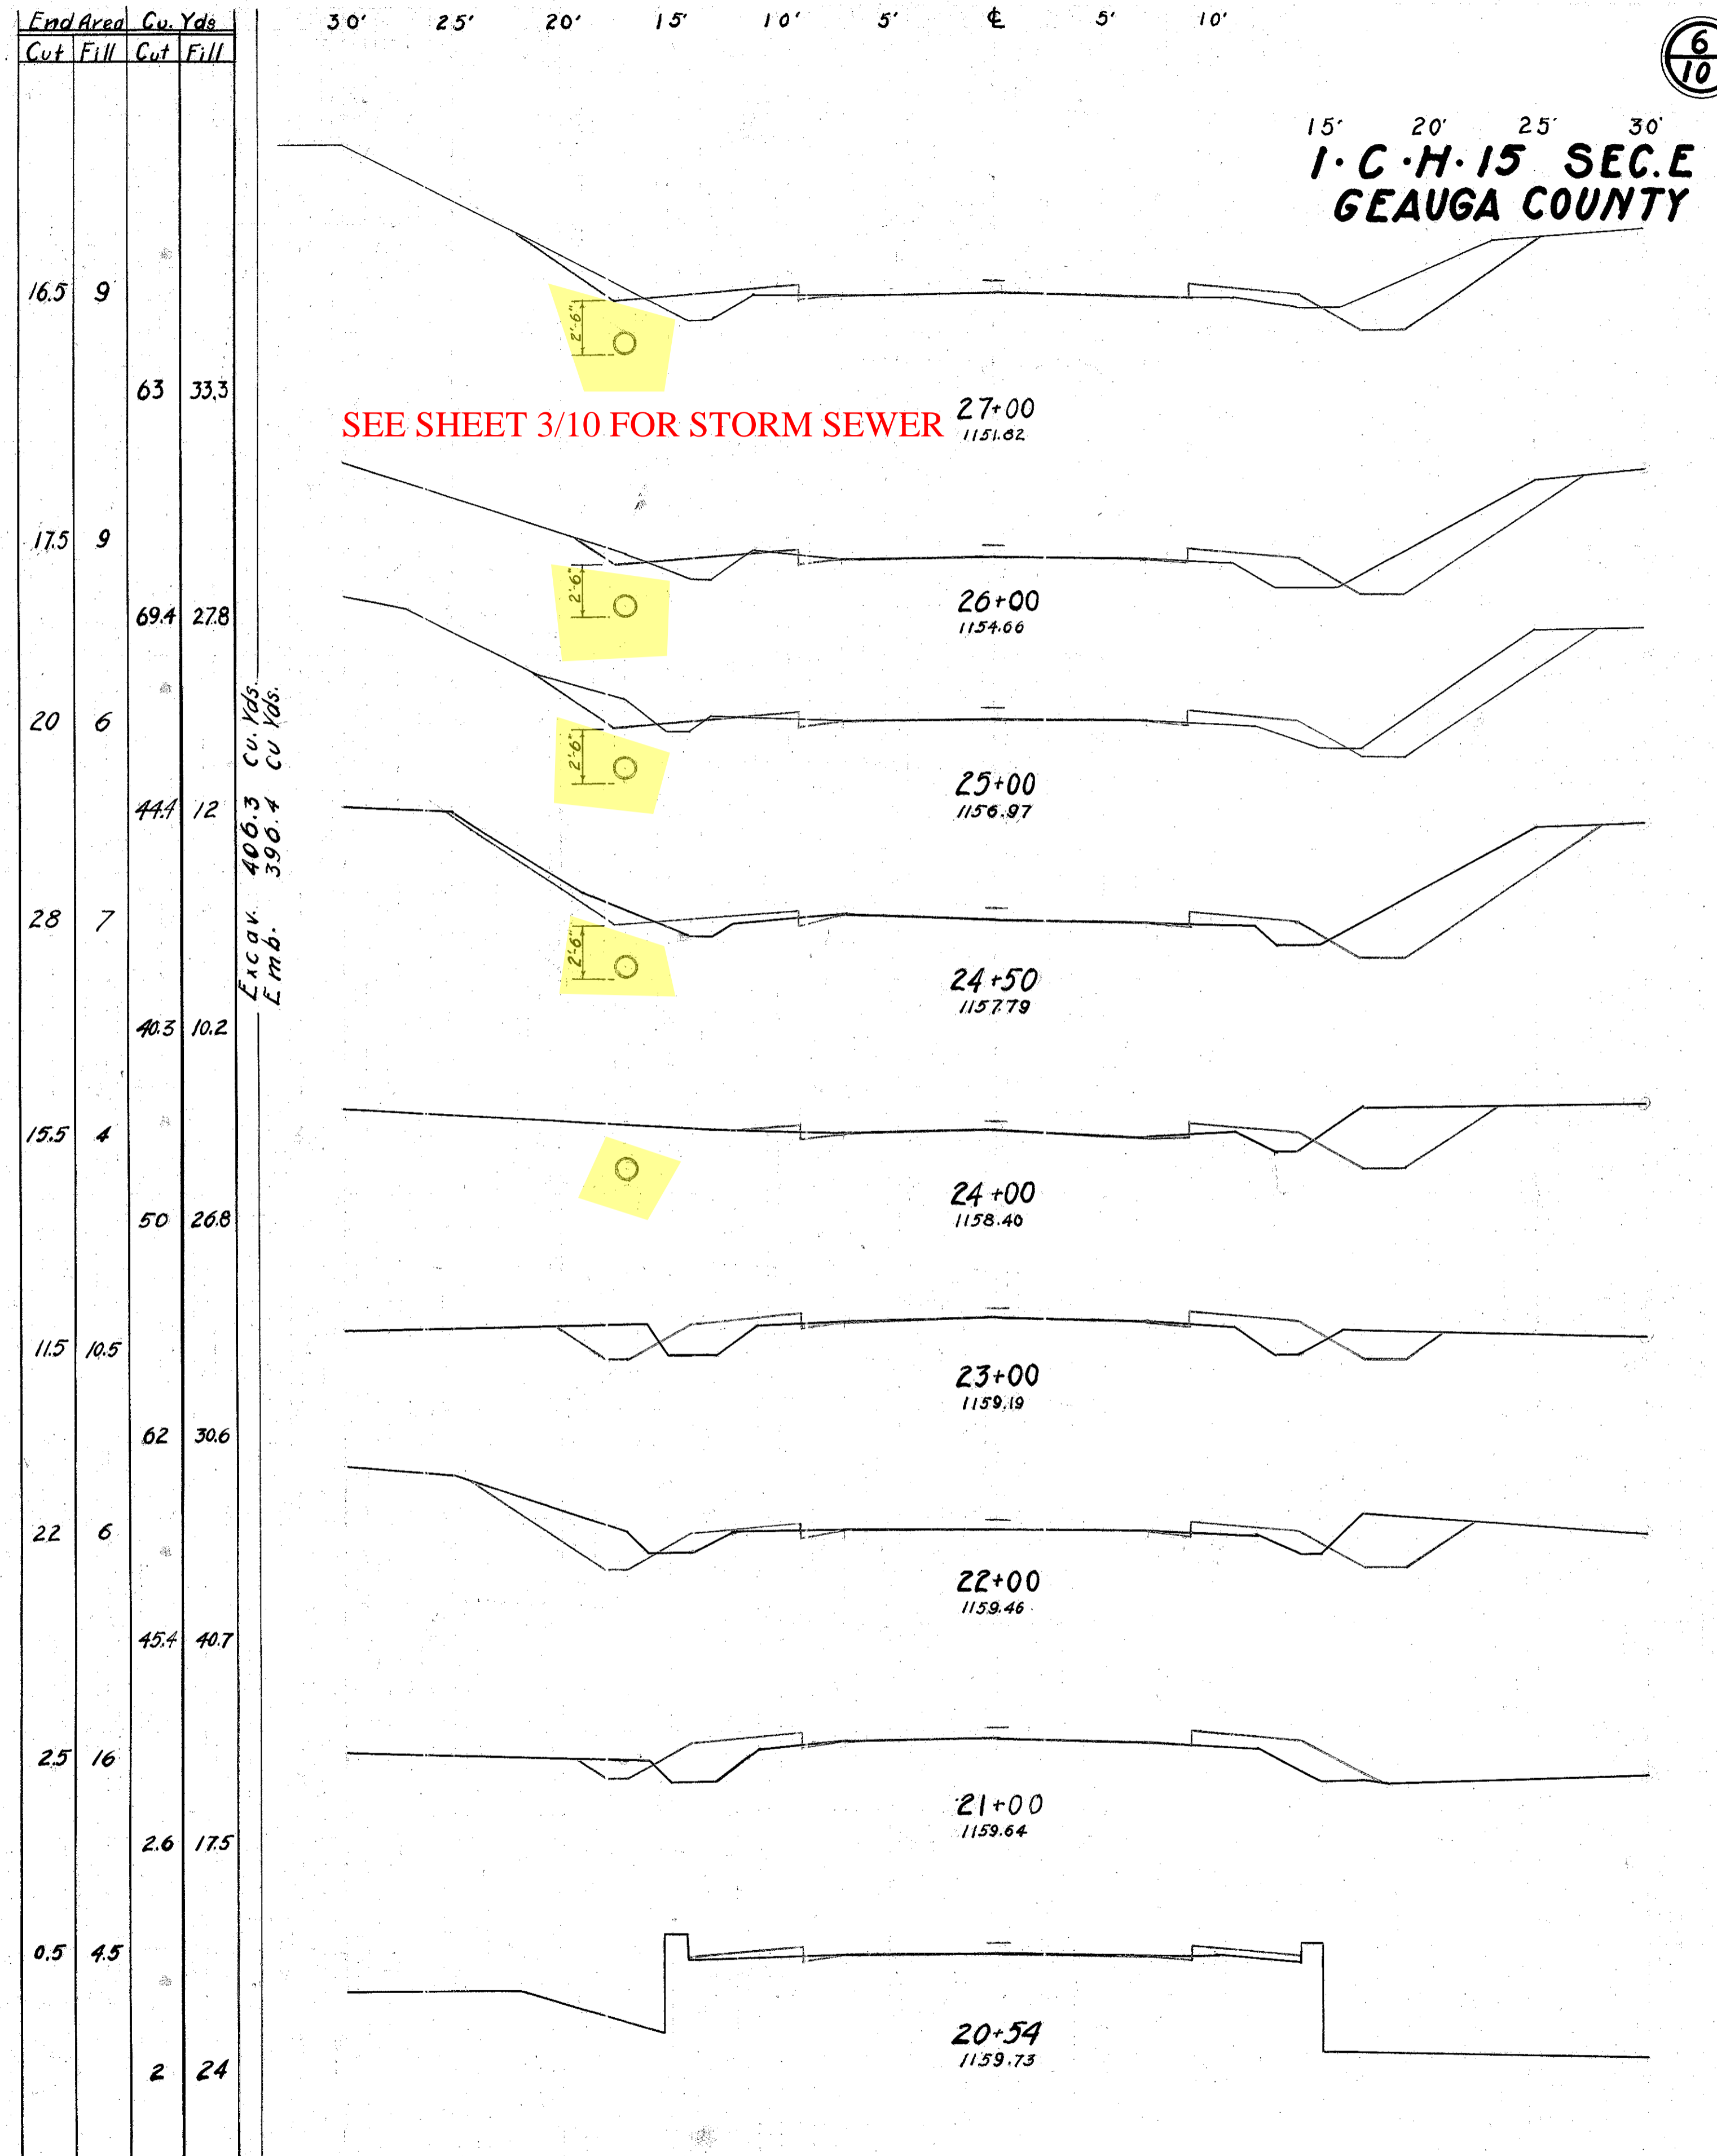

15' 20' 25' 30'  
I.C.H. 15 SEC. E  
GEAUGA COUNTY

Excav. 406.3 Cu. Yds.  
Emb. 390.4 Cu. Yds.

SEE SHEET 3/10 FOR STORM SEWER