


FED. RD. DIST. NO.	STATE	FED. AID PROJECT	FISCAL YEAR
10	OHIO	388-D	1926

I.C.H. 324 SEC. E
 GEAUGA COUNTY
 GEA-44-(8.88-10.92)



Grade line shown is crown of finished pavement.

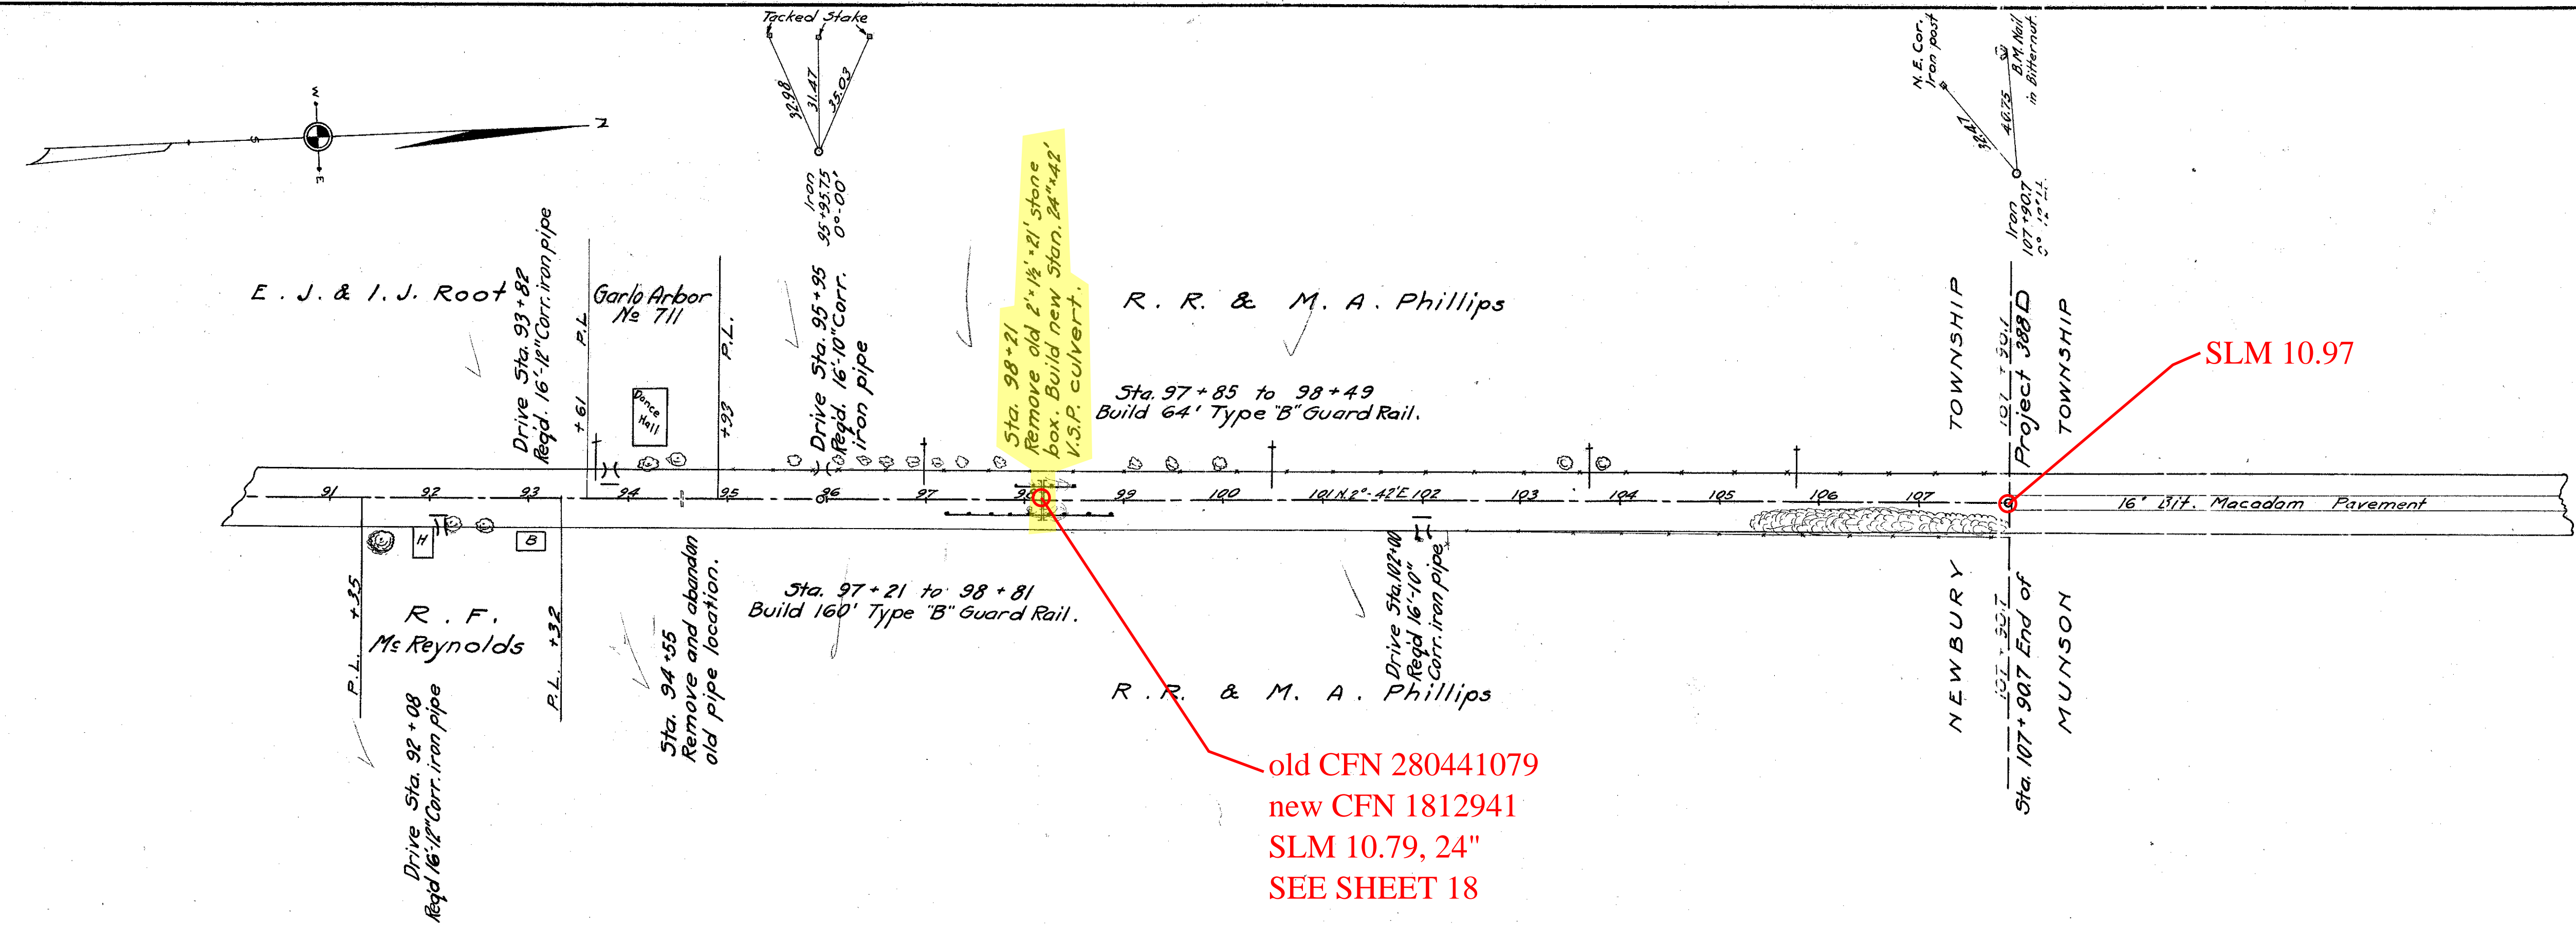