


FED. RD. DIST. NO.	STATE	FED. AID PROJECT	FISCAL YEAR
10	OHIO	388 E	1927

I.C.H. 324 SEC. F.
GEAUGA COUNTY

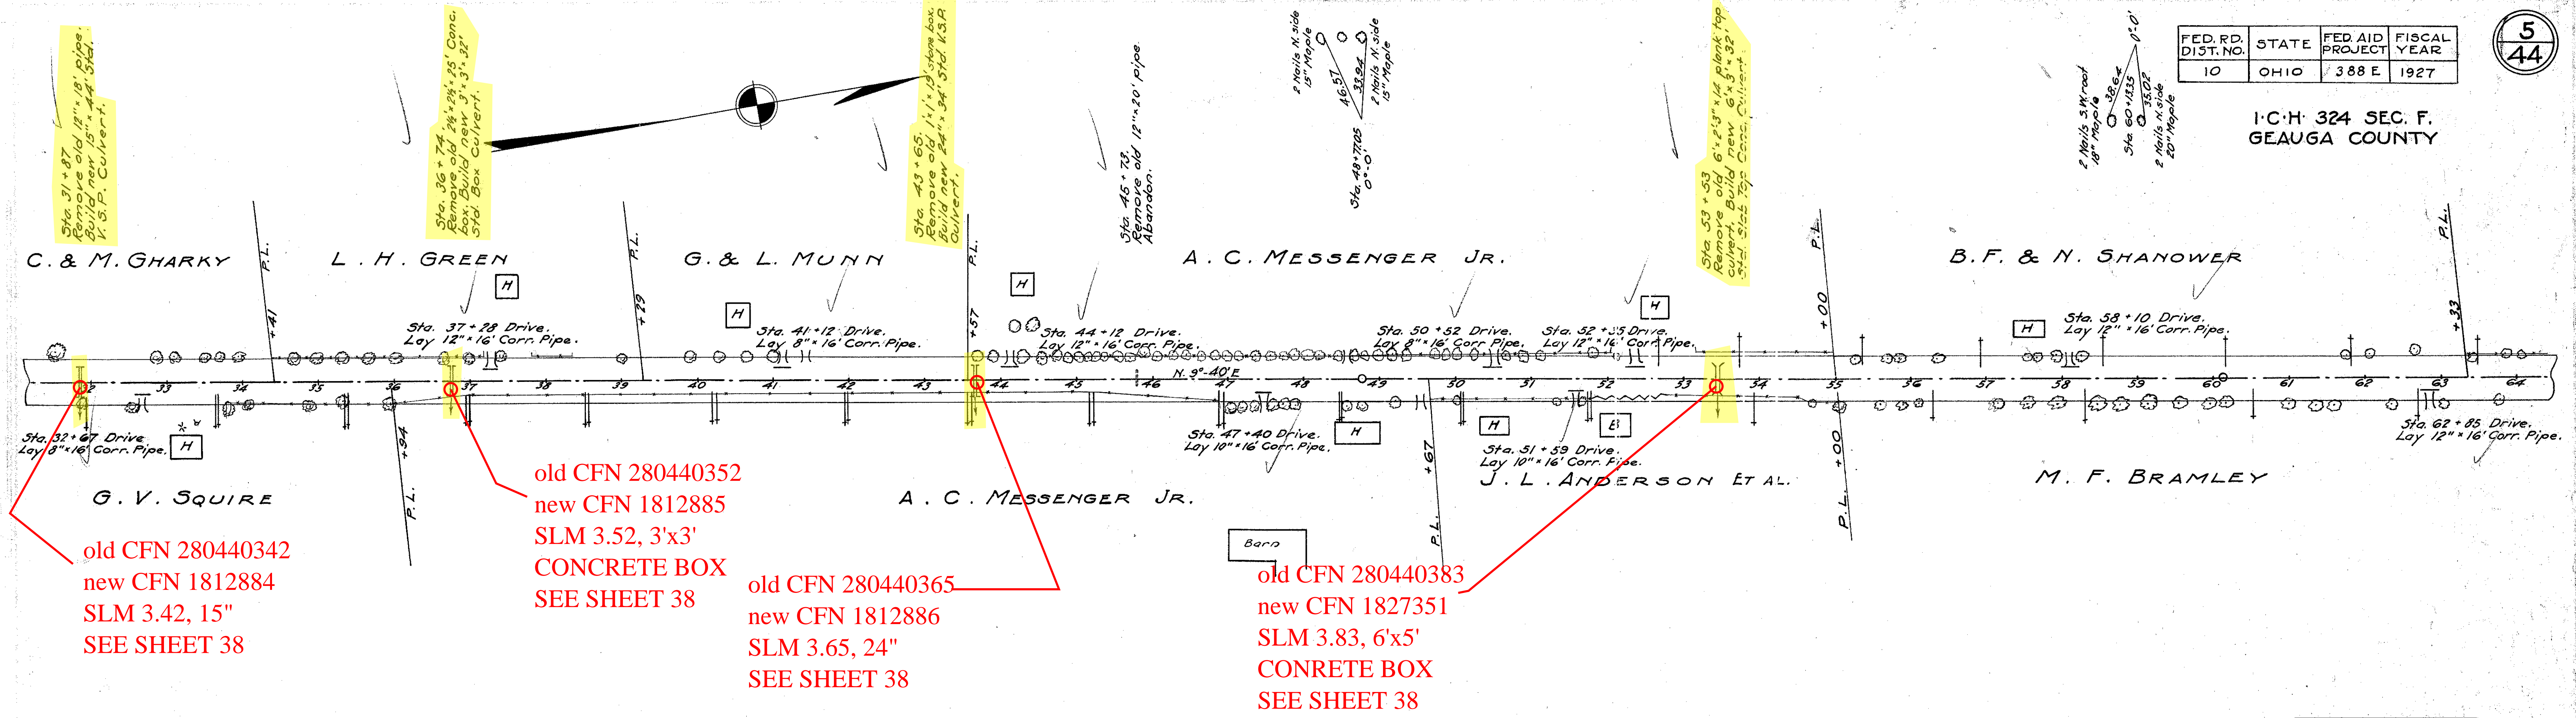

old CFN 280440342
new CFN 1812884
SLM 3.42, 15"
SEE SHEET 38

old CFN 280440352
new CFN 1812885
SLM 3.52, 3'x3'
CONCRETE BOX
SEE SHEET 38

old CFN 280440365
new CFN 1812886
SLM 3.65, 24"
SEE SHEET 38

old CFN 280440383
new CFN 1827351
SLM 3.83, 6'x5'
CONCRETE BOX
SEE SHEET 38

B.M. Sta. 35+30
Roofing nail in W. root
30" Elm 30' Rt.
Elev. 1193.41

B.M. Sta. 50+25
Roofing nail in N.E. root
20" Maple 30' Lt.
Elev. 1204.99

B.M. Sta. 61+55
Roofing nail in S.W. root
30" Maple 35' Rt.
Elev. 1220.69

Note:- Grade line shown is crown of finished pavement.

