


FED. AID DIST.	STATE	FED. AID PROJECT	FISCAL YEAR
10	OHIO	388E	1927

I.C.H. 324 SEC. F.
GEAUGA COUNTY

SR 44.
2.81

1/5

WASHINGTON ST
SLM 2.81

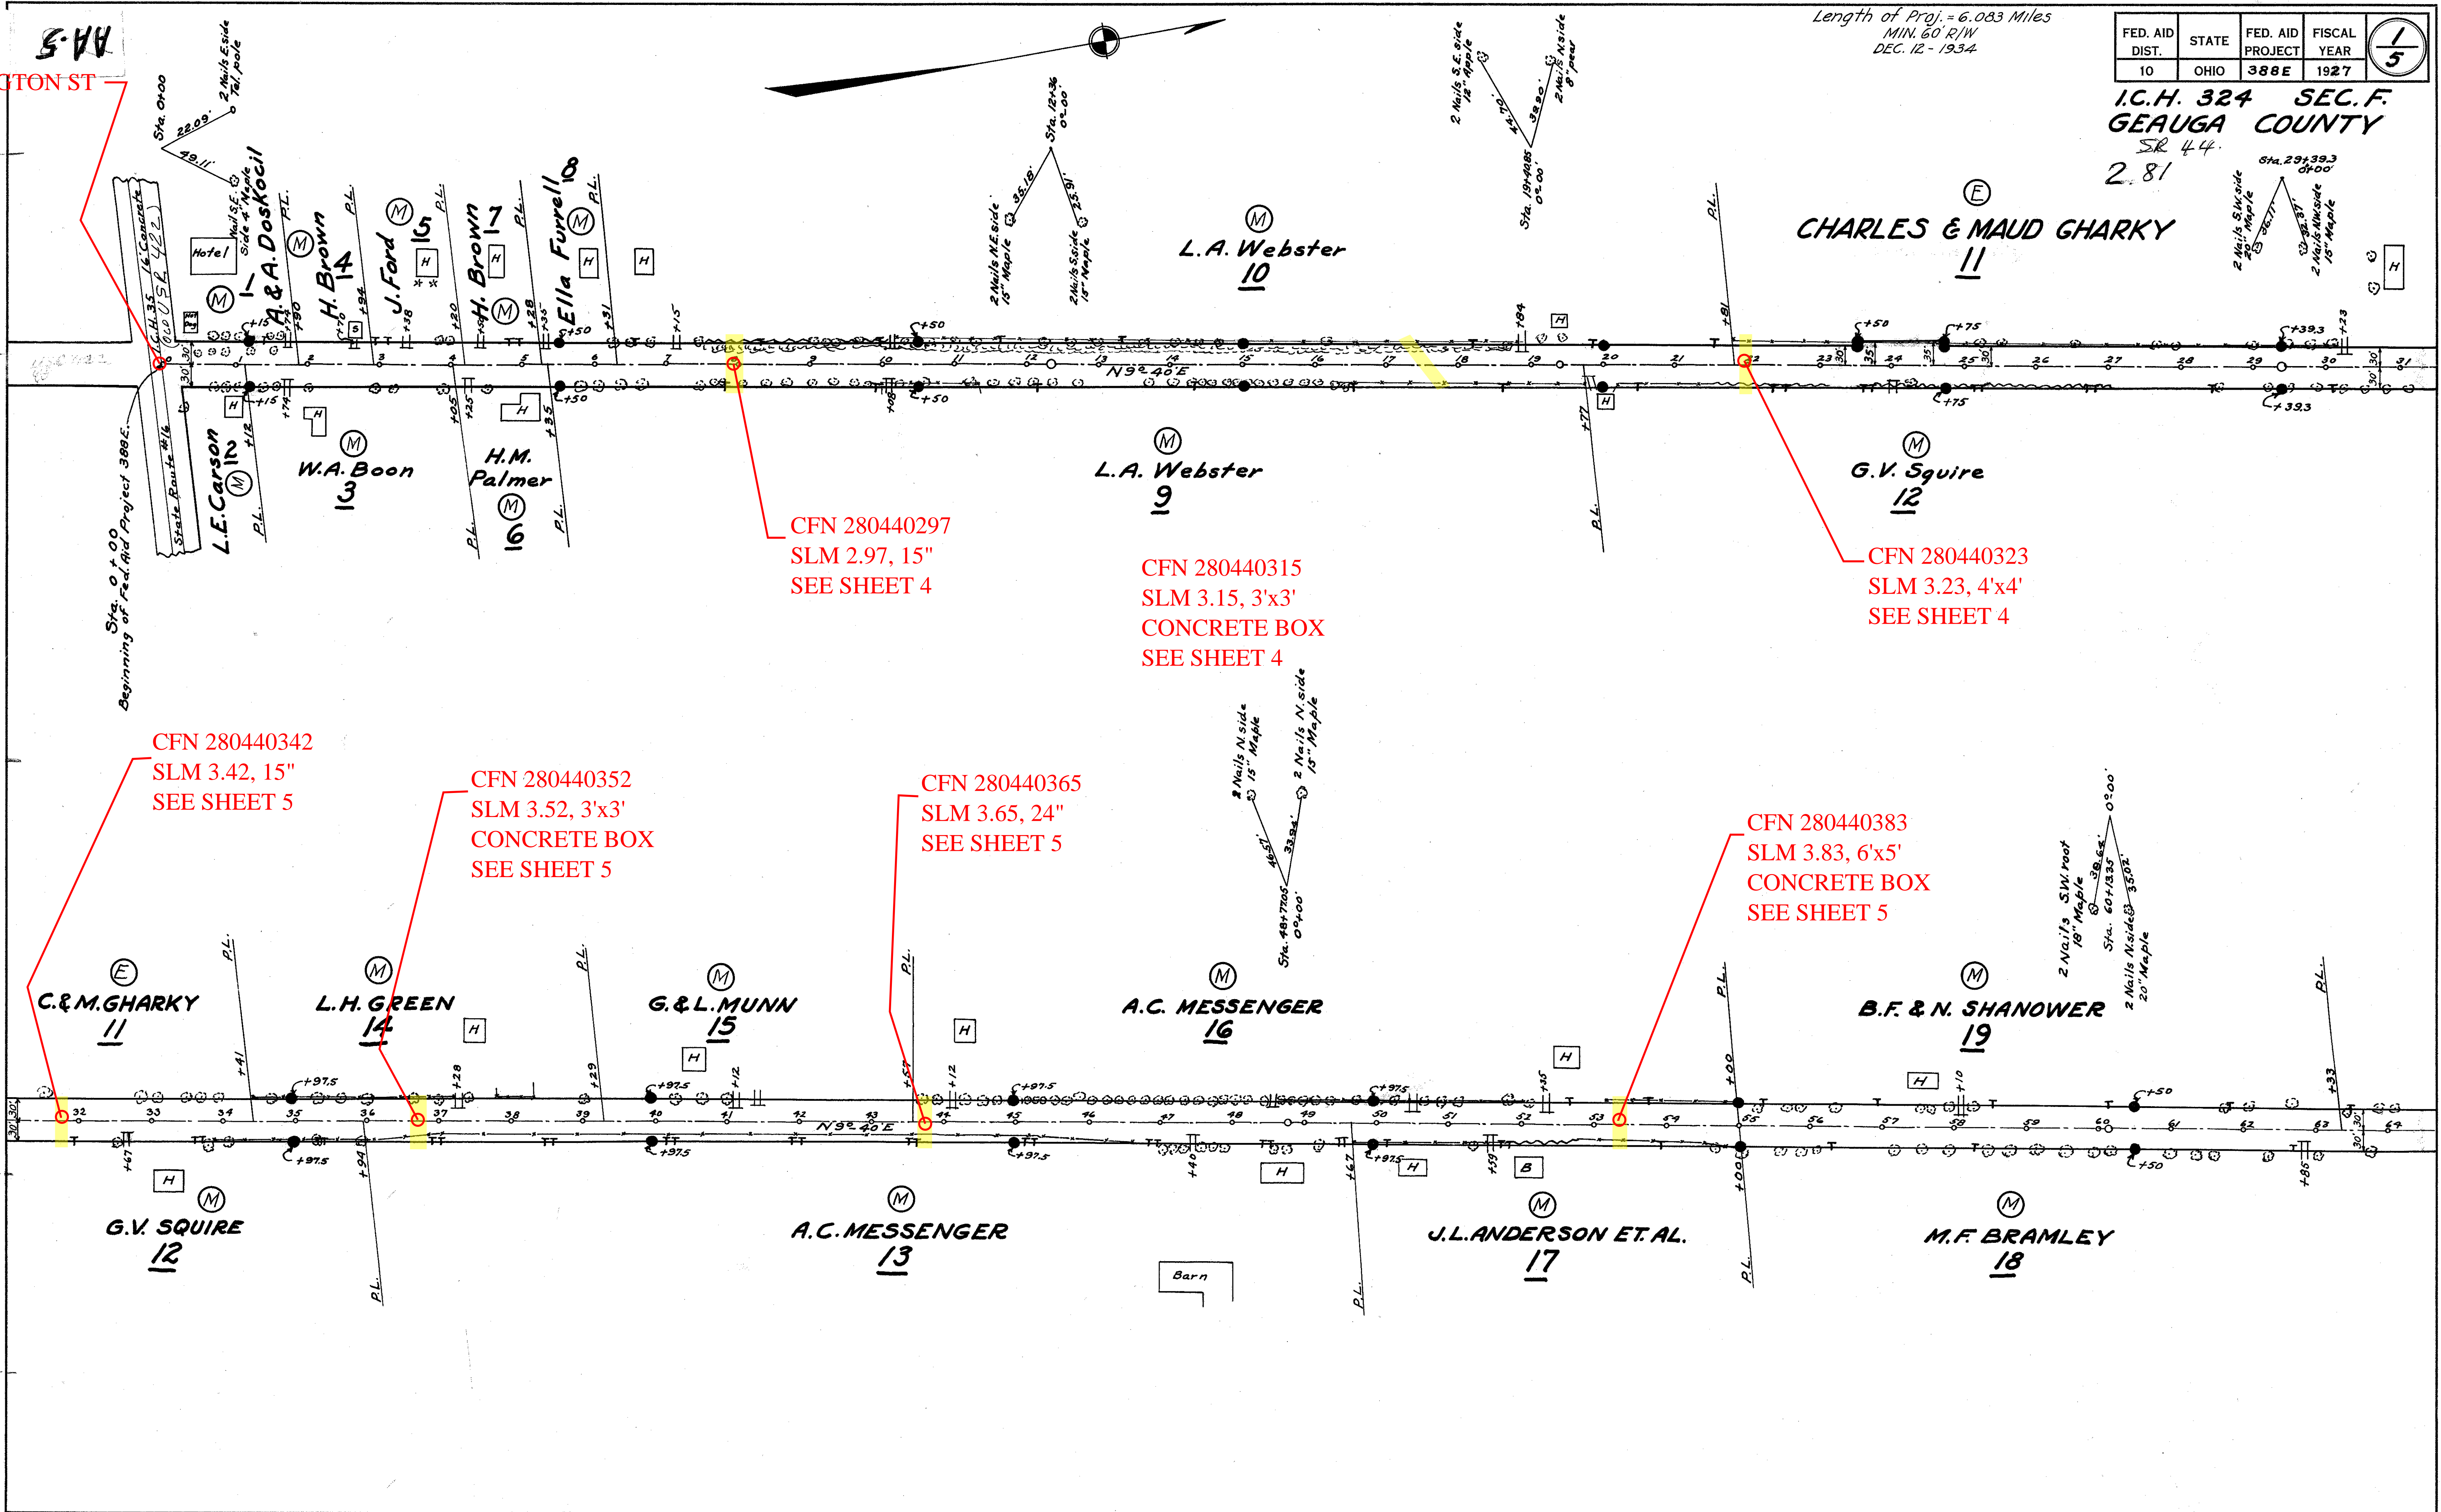

CFN 280440297
SLM 2.97, 15"
SEE SHEET 4

CFN 280440315
SLM 3.15, 3'x3'
CONCRETE BOX
SEE SHEET 4

CFN 280440323
SLM 3.23, 4'x4'
SEE SHEET 4

CFN 280440342
SLM 3.42, 15"
SEE SHEET 5

CFN 280440352
SLM 3.52, 3'x3'
CONCRETE BOX
SEE SHEET 5

CFN 280440365
SLM 3.65, 24"
SEE SHEET 5

CFN 280440383
SLM 3.83, 6'x5'
CONCRETE BOX
SEE SHEET 5

C. & M. GHARKY
11

L. H. GREEN
14

G. & L. MUNN
15

A. C. MESSENGER
16

B. F. & N. SHANOWER
19

G. V. SQUIRE
12

A. C. MESSENGER
13

J. L. ANDERSON ET AL.
17

M. F. BRAMLEY
18

Barn