


FED. AID DIST.	STATE	FED. AID PROJECT	FISCAL YEAR	2 5
10	OHIO	388 E	1927	

**I.C.H. 324 SEC. F.
GEAUGA COUNTY**

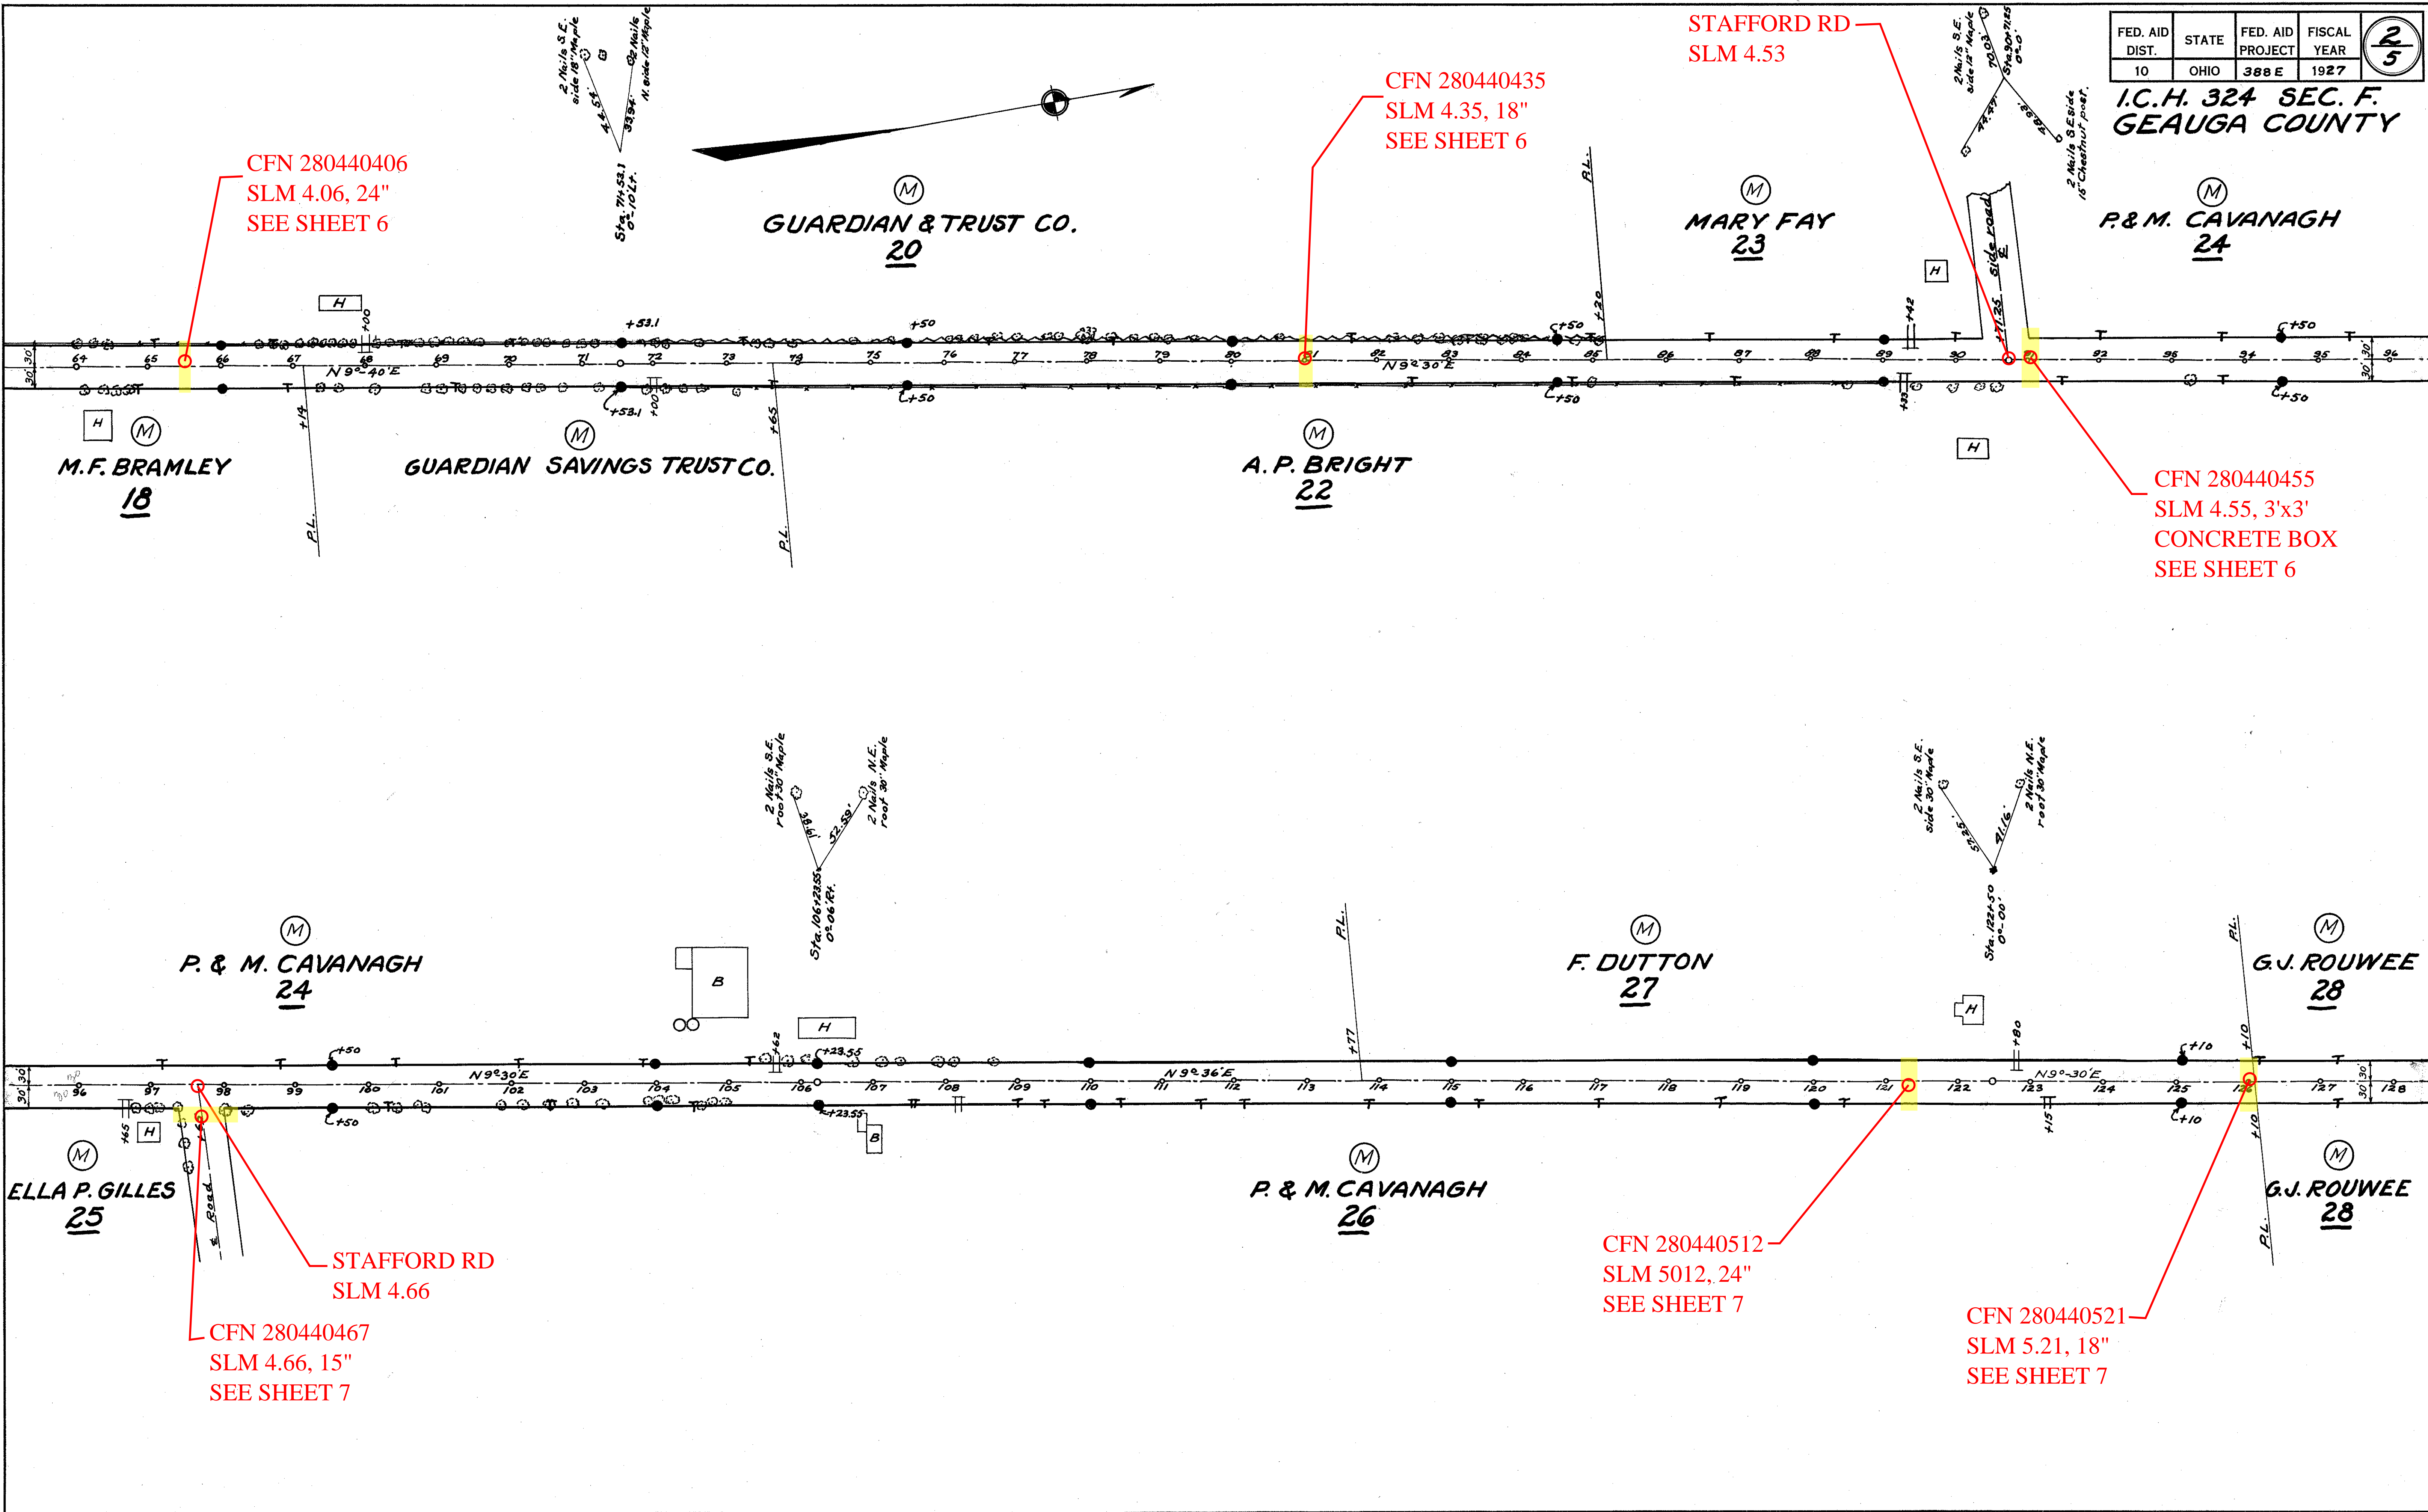

CFN 280440406
SLM 4.06, 24"
SEE SHEET 6

CFN 280440435
SLM 4.35, 18"
SEE SHEET 6

CFN 280440455
SLM 4.55, 3'x3'
CONCRETE BOX
SEE SHEET 6

STAFFORD RD
SLM 4.66

CFN 280440467
SLM 4.66, 15"
SEE SHEET 7

CFN 280440512
SLM 5012, 24"
SEE SHEET 7

CFN 280440521
SLM 5.21, 18"
SEE SHEET 7

**GUARDIAN & TRUST CO.
20**

**MARY FAY
23**

**P. & M. CAVANAGH
24**

**M.F. BRAMLEY
18**

GUARDIAN SAVINGS TRUST CO.

**A. P. BRIGHT
22**

**P. & M. CAVANAGH
24**

**F. DUTTON
27**

**G.J. ROUWEE
28**

**ELLA P. GILLES
25**

**P. & M. CAVANAGH
26**

**G.J. ROUWEE
28**