


FED. RD. DIST. NO.	STATE	FED. AID PROJECT	FISCAL YEAR
10	OHIO	469-B	1923

1" CH 15 SEC. G-H,
GEAUGA COUNTY

10
38

DATE	
BY	
CHIEF ENGINEER	
IN CHARGE	
DESIGNED	
DRAWN	
CHECKED	
APPROVED	
NOTED	
REVISIONS	

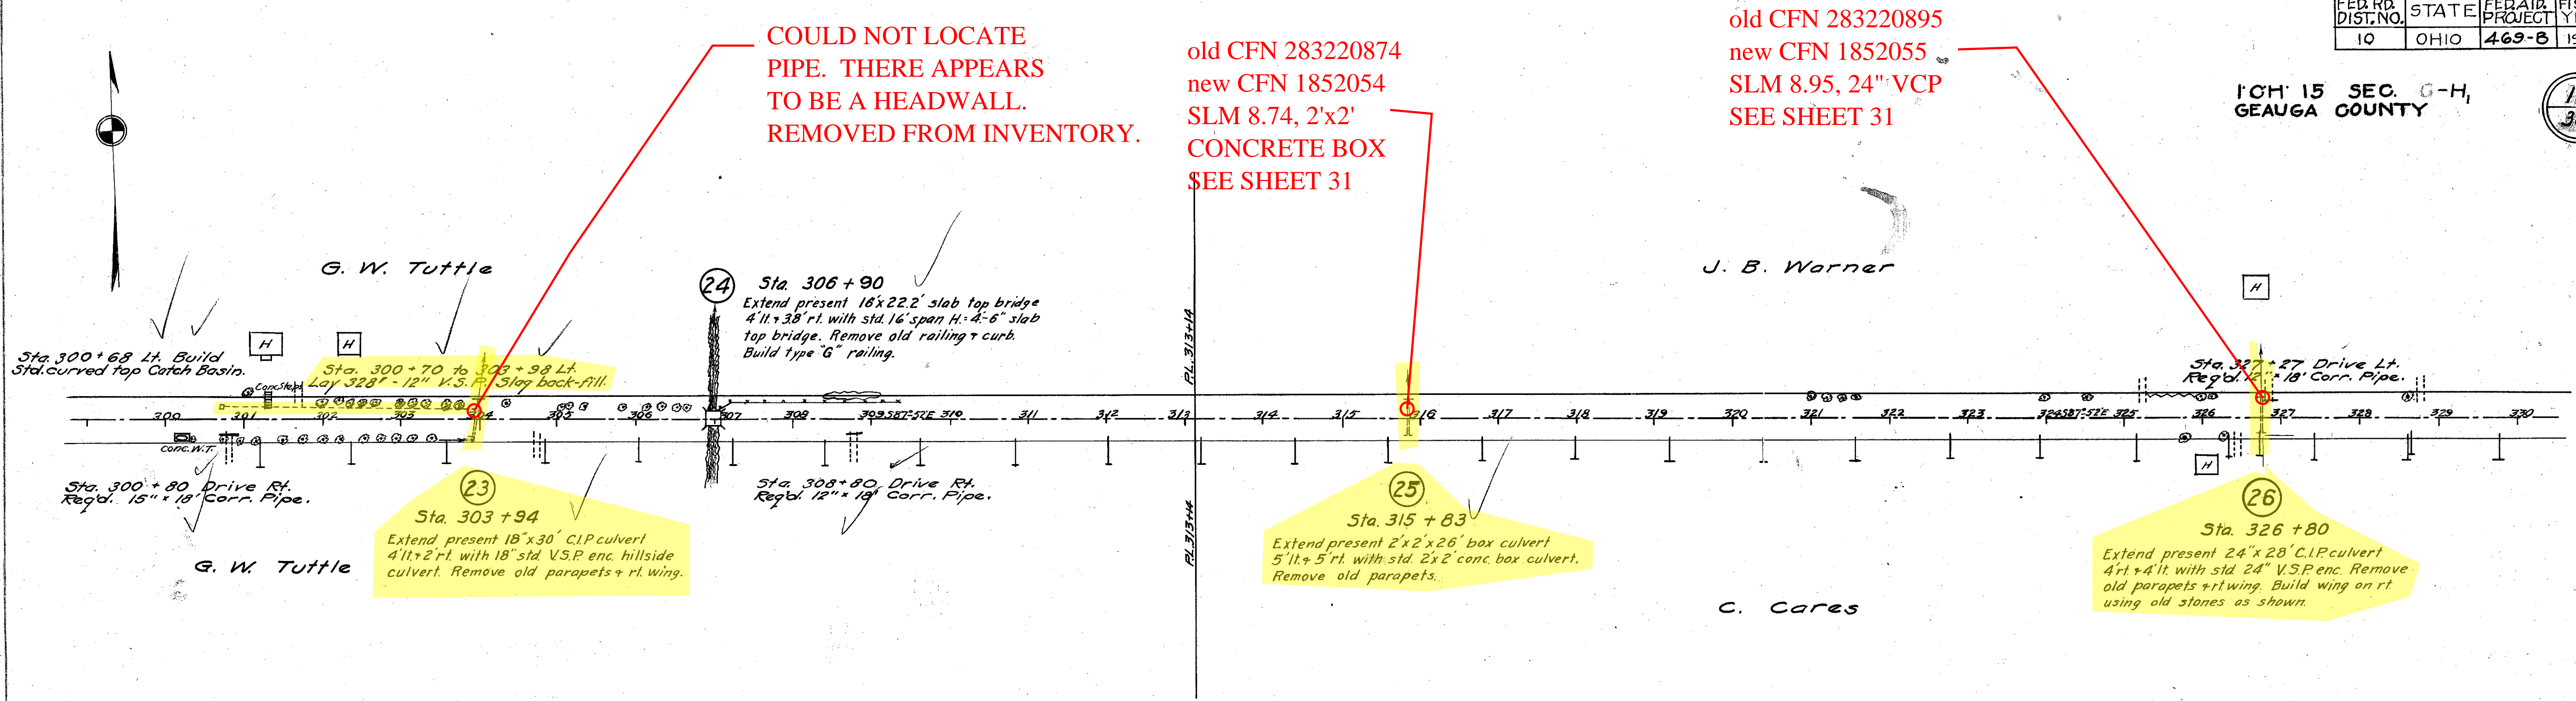


COULD NOT LOCATE PIPE. THERE APPEARS TO BE A HEADWALL. REMOVED FROM INVENTORY.

old CFN 283220874
new CFN 1852054
SLM 8.74, 2'x2'
CONCRETE BOX
SEE SHEET 31

old CFN 283220895
new CFN 1852055
SLM 8.95, 24" VCP
SEE SHEET 31

Note: Grade line shown is crown of existing pavement.

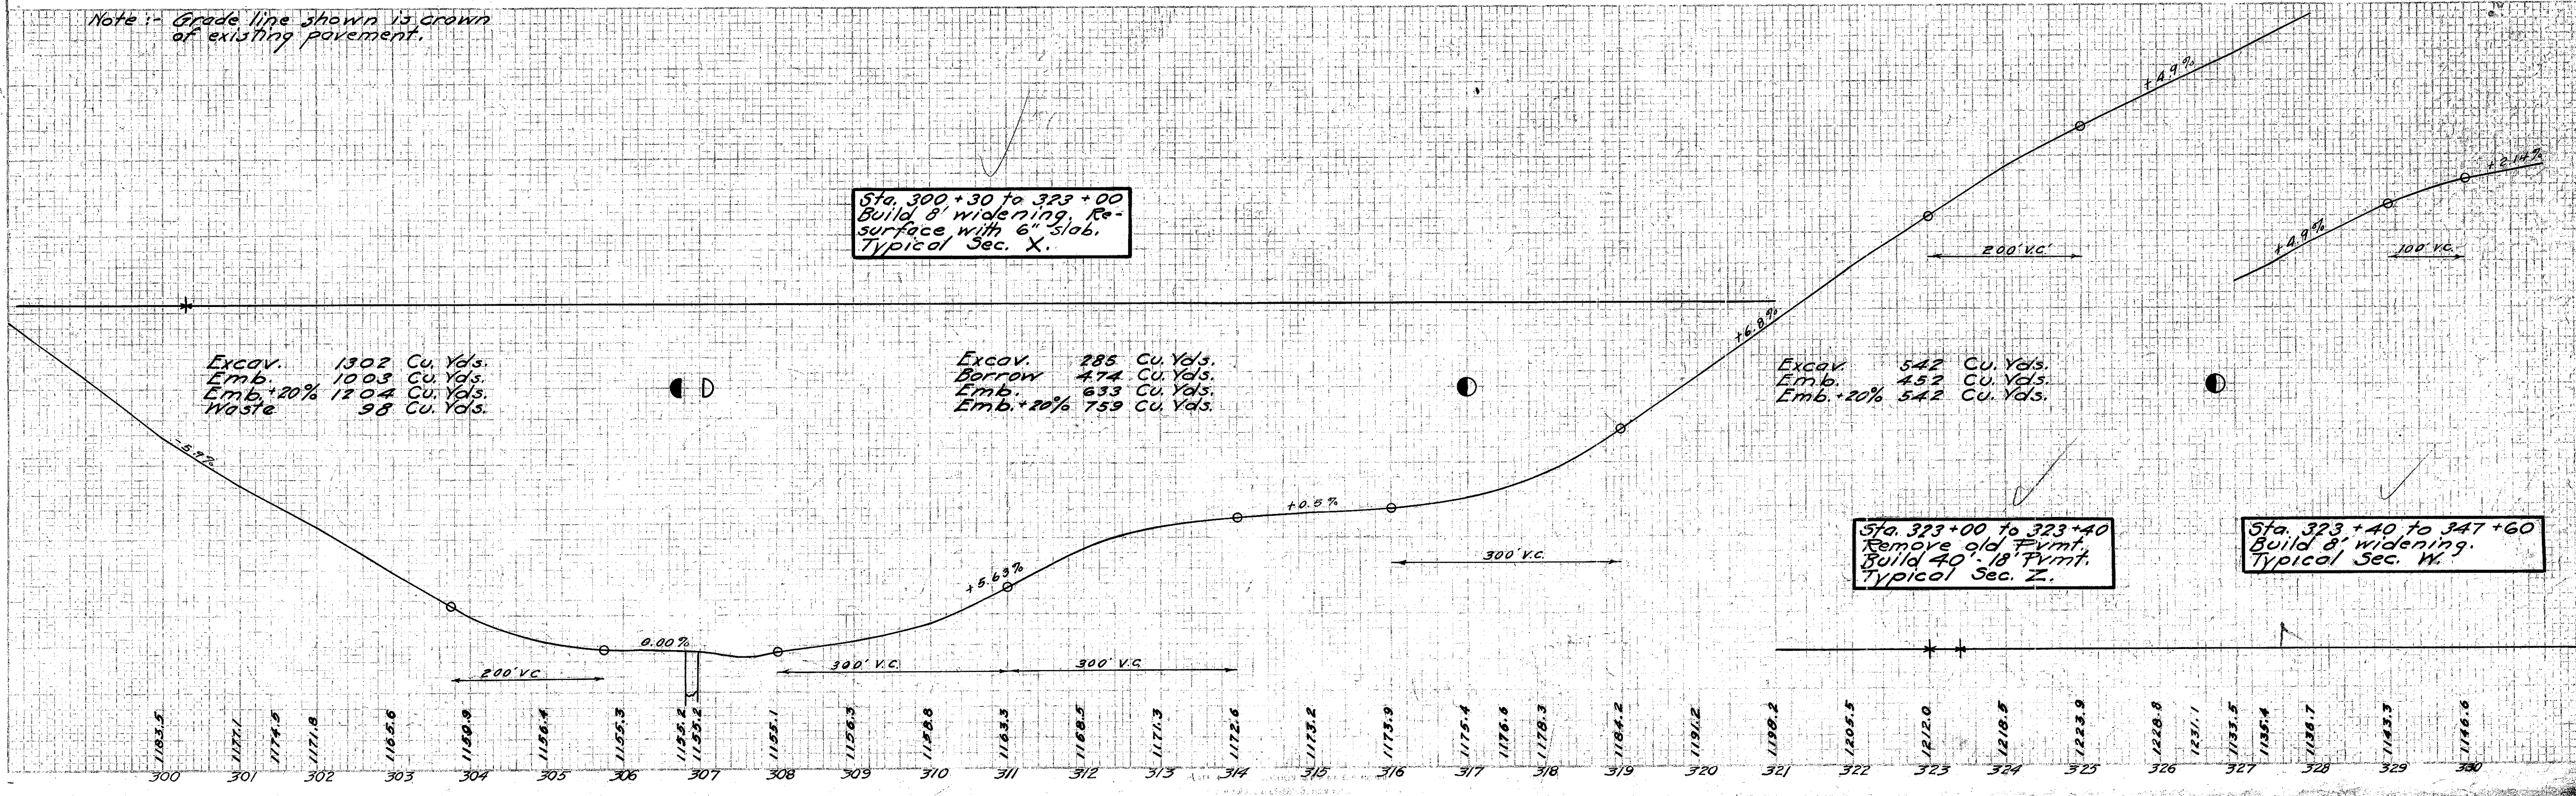

DATE	
BY	
CHIEF ENGINEER	
IN CHARGE	
DESIGNED	
DRAWN	
CHECKED	
APPROVED	
NOTED	
REVISIONS	