



old CFN 283220959
new CFN 1827357
SLM 9.59, 3'x1.5'
CONCRETE BOX
SEE SHEET 32

FINAL SURVEY
NOTY BOOK
AREAS CHECKED

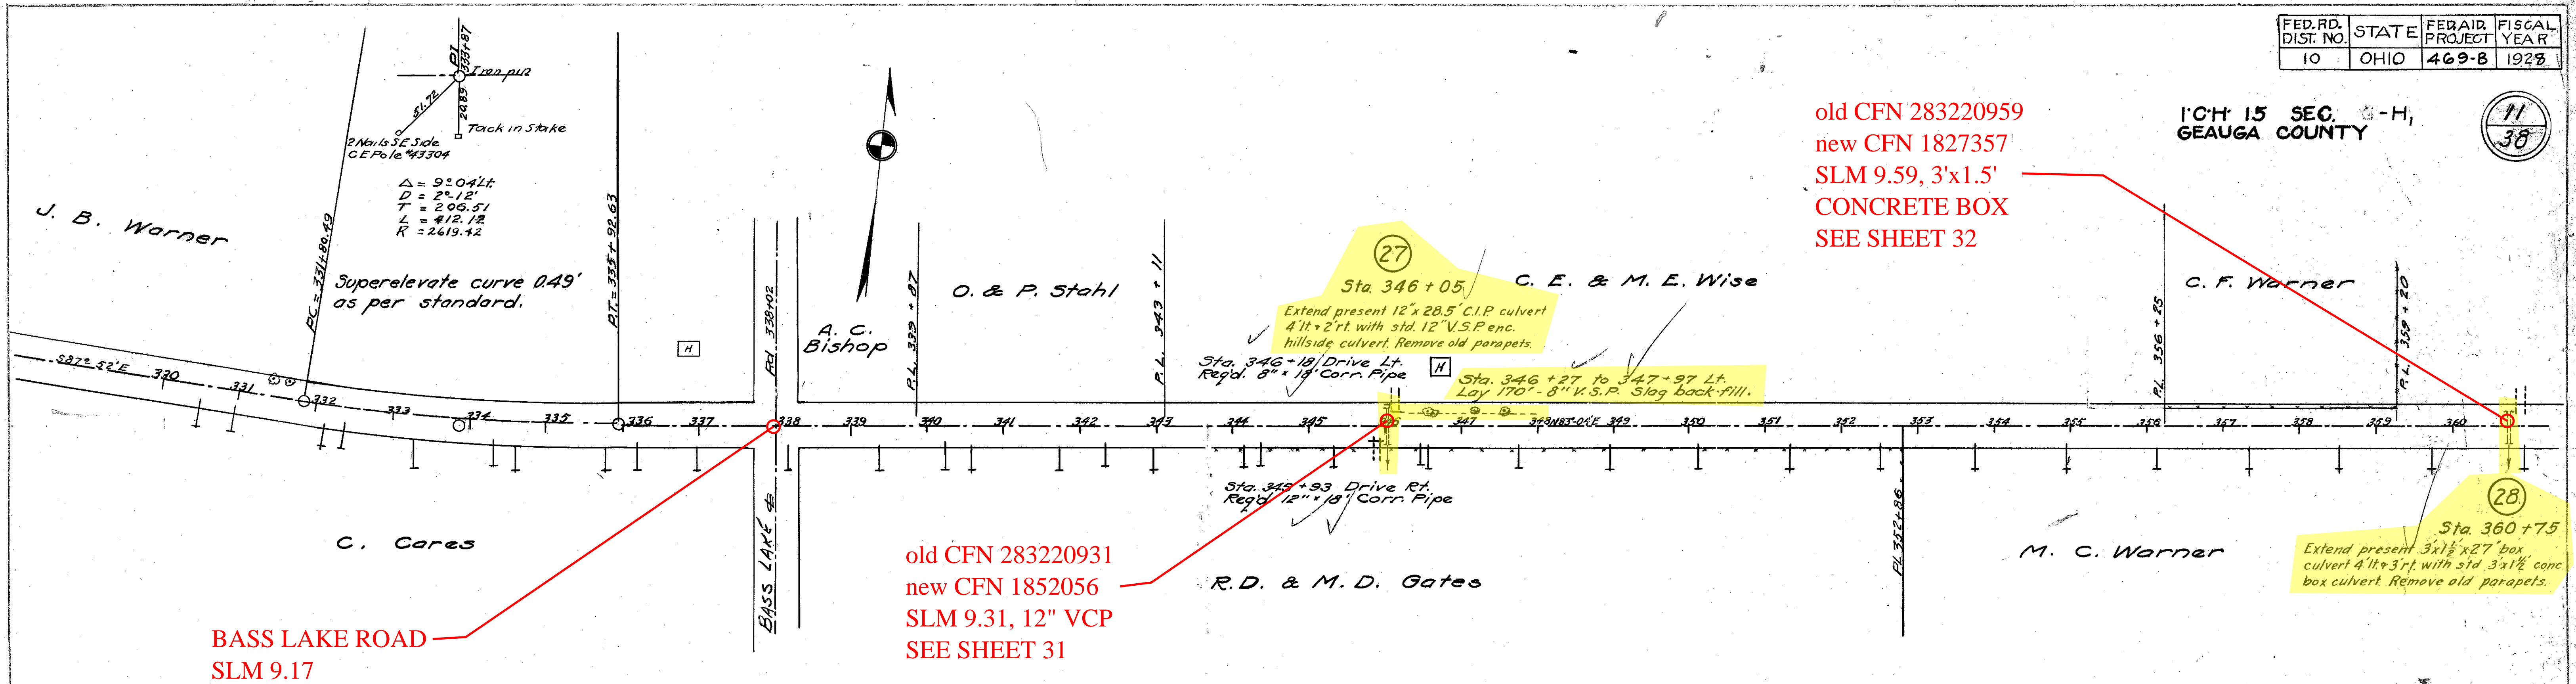

BASS LAKE ROAD
SLM 9.17

old CFN 283220931
new CFN 1852056
SLM 9.31, 12" VCP
SEE SHEET 31

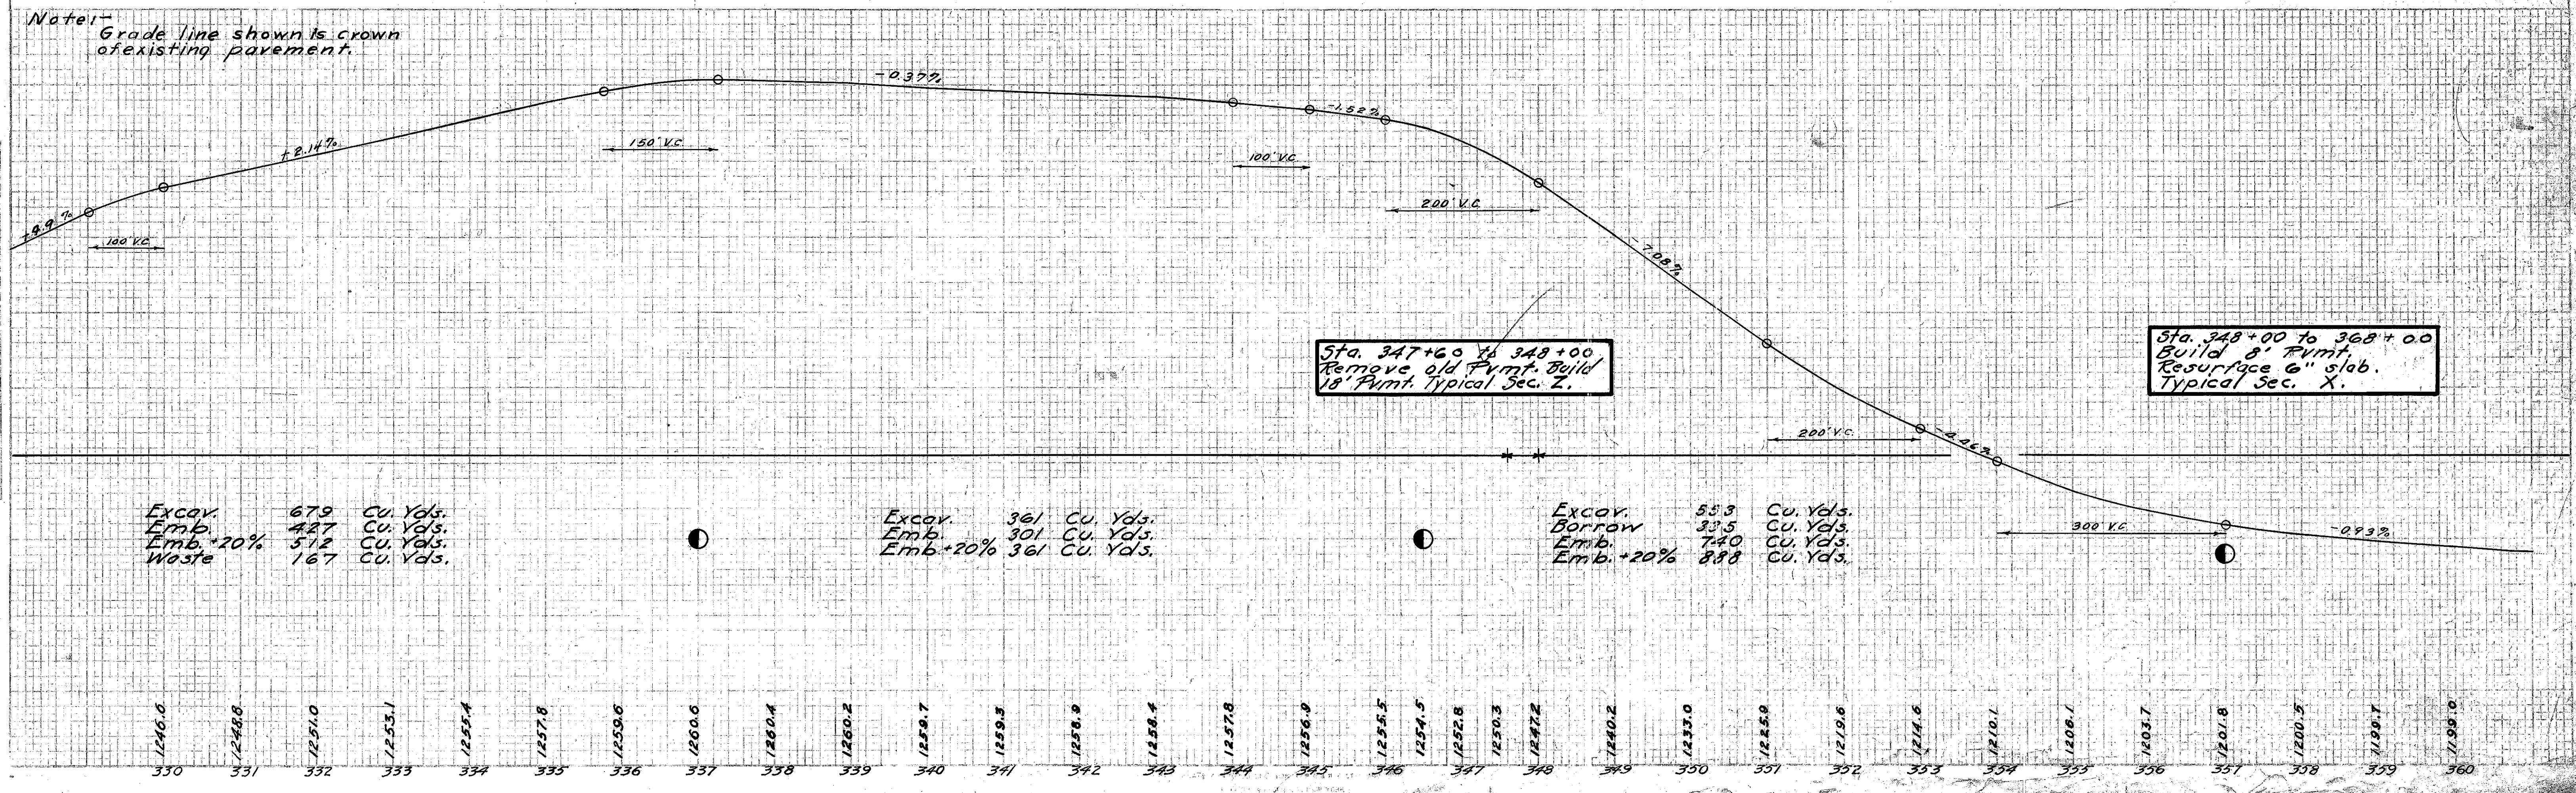

ORIGINAL SURVEY
NOTY BOOK
AREAS CHECKED