


End Area	Cu. Yds	Cut	Fill
89	20		
17	8		
72	24		
22	5		
67	15		
14	3		
46	11		
11	3		
57	28		
20	12		
65	37		
15	8		
76	26		
26	6		
100	17		
28	3		
85	17		
18	6		
81	28		
26	9		
122	28		
40	6		
94	24		
11	7		

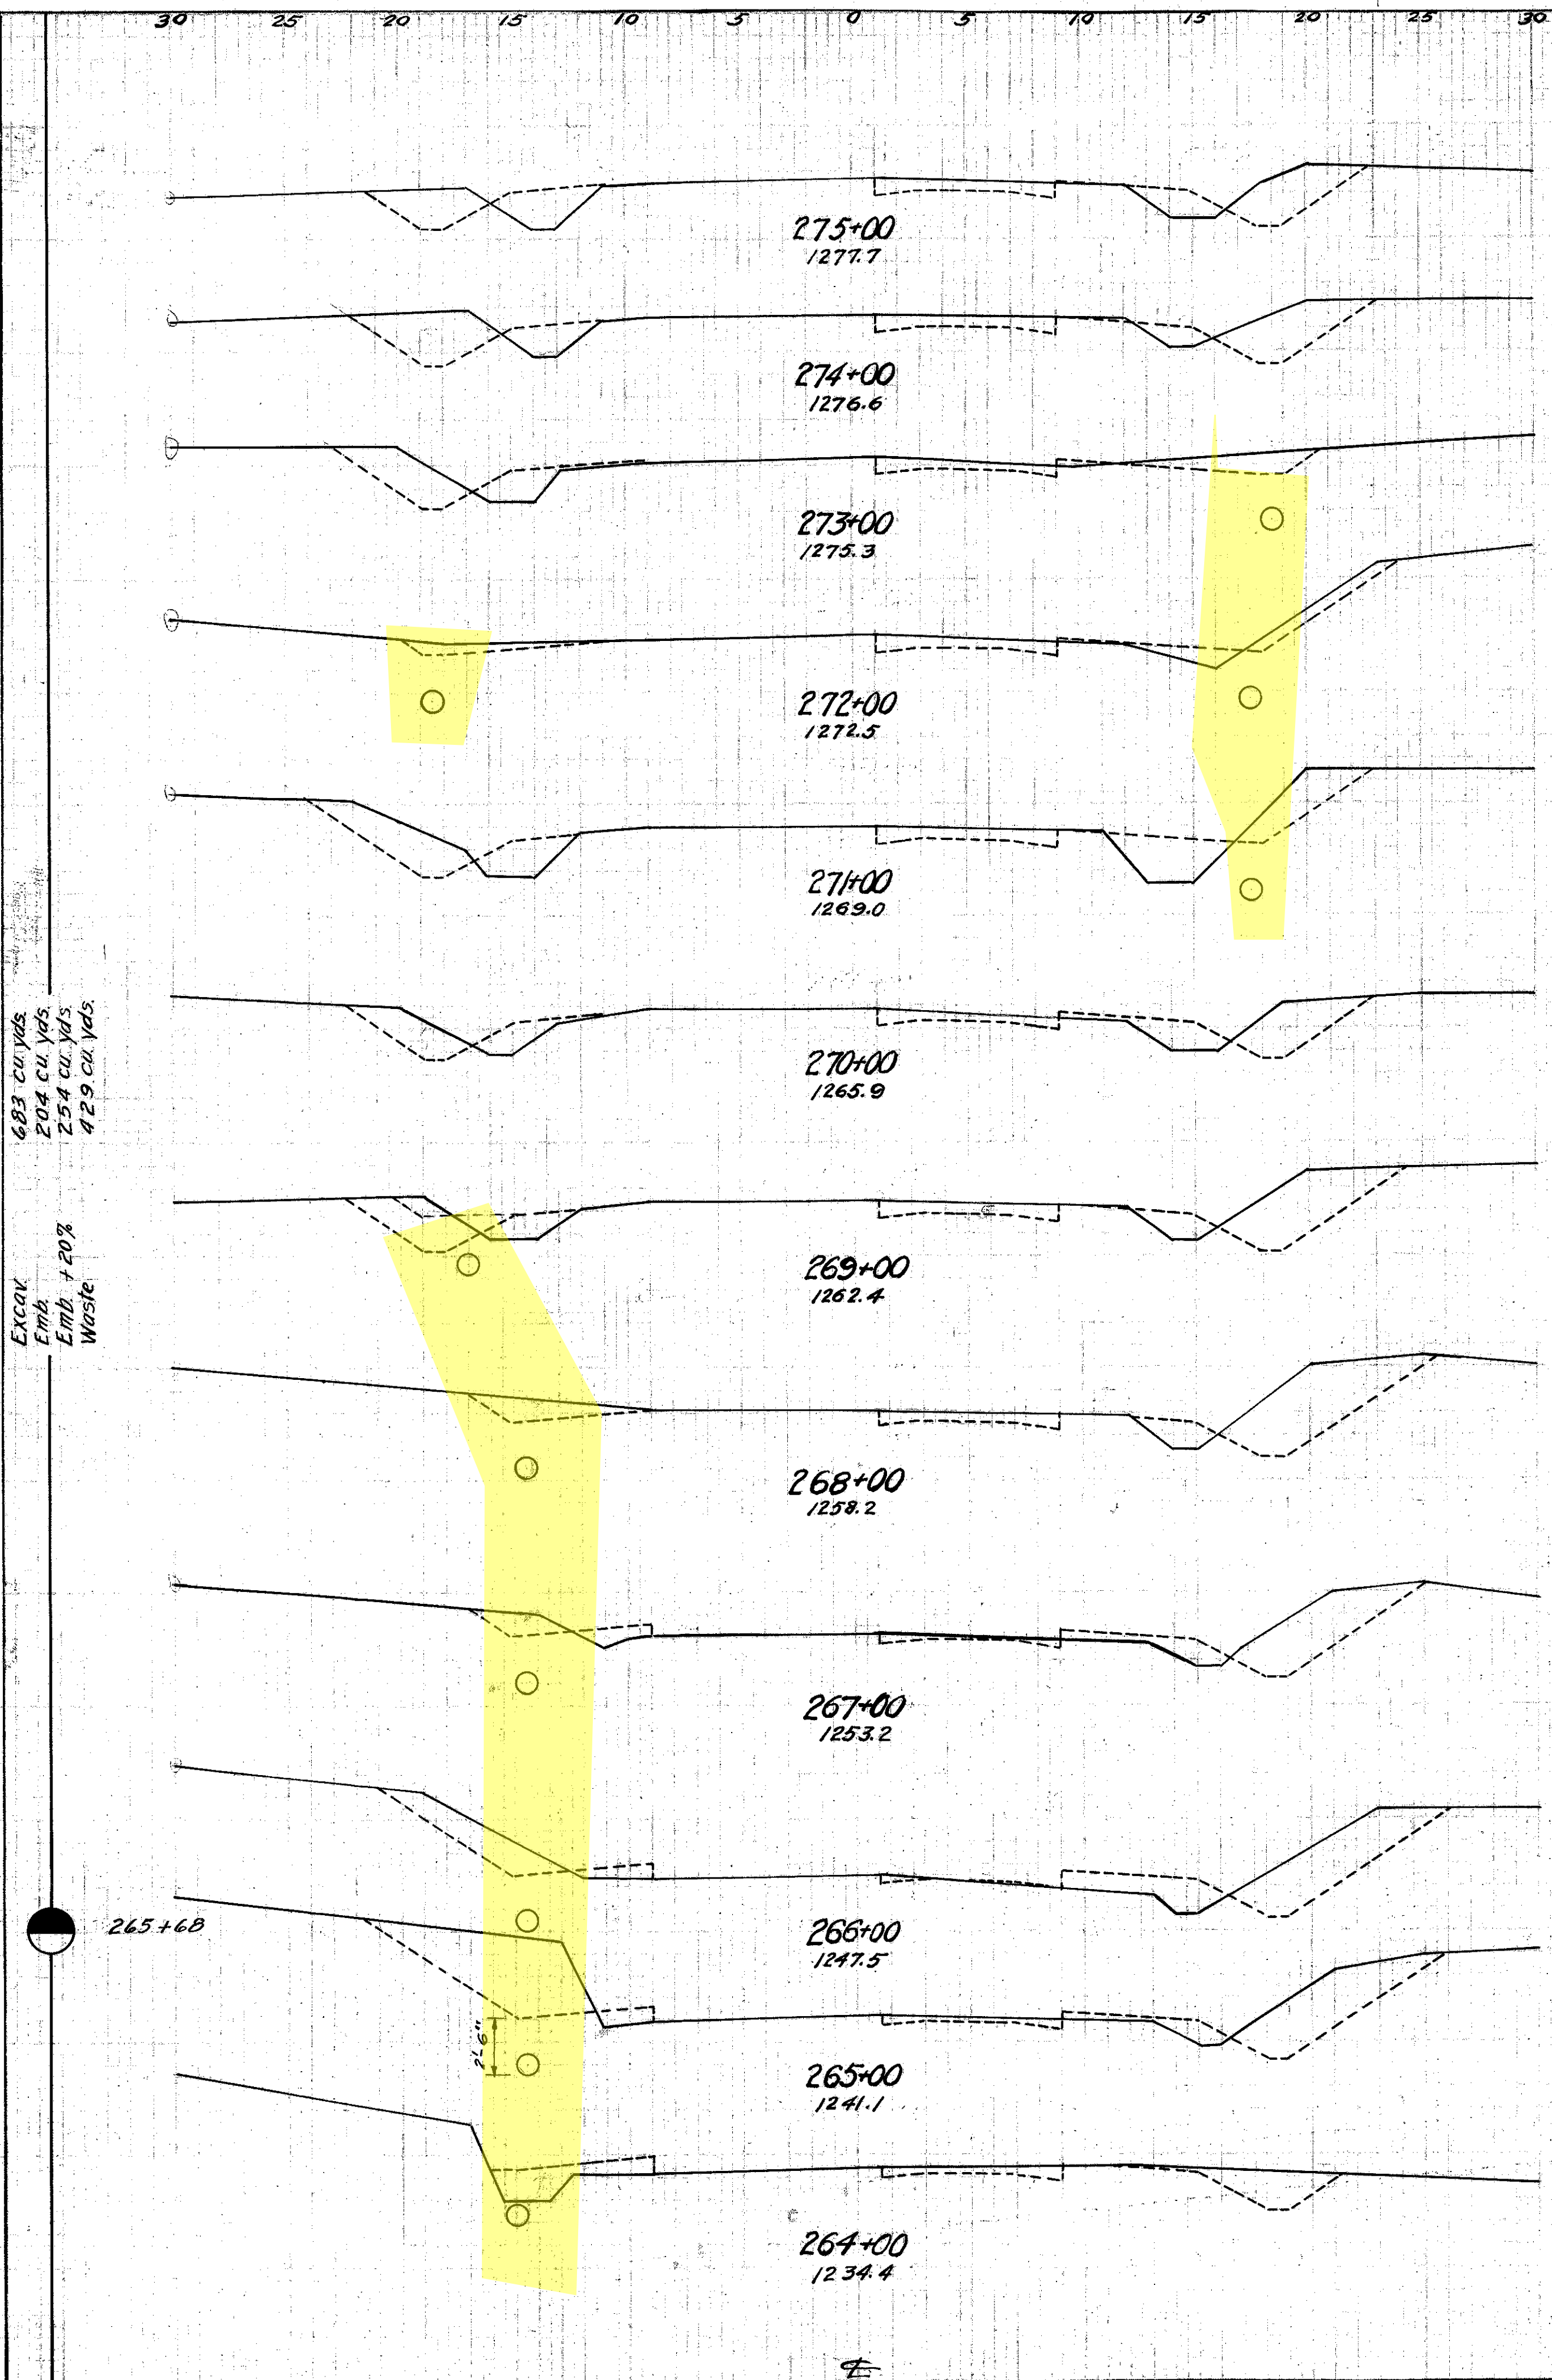


683 cu. yds
 204 cu. yds
 294 cu. yds
 429 cu. yds
 EXCAV
 Emb.
 Emb. + 20%
 Waste

FED. RD. DIST. NO.	STATE	FED. AID PROJECT	FISCAL YEAR
10	OHIO	469-B	1923

1" CH' 15 SEC. -H,
 GEauga COUNTY

21
38

End Area	Cu. Yds	Cut	Fill
78	17		
22	3		
93	11		
28	3		
85	9		
18	2		
72	13		
21	5		
52	22		
7	7		
22	37		
5	13		
35	35		
14	6		
70	22		
24	6		
109	15		
35	2		
122	9		
31	3		

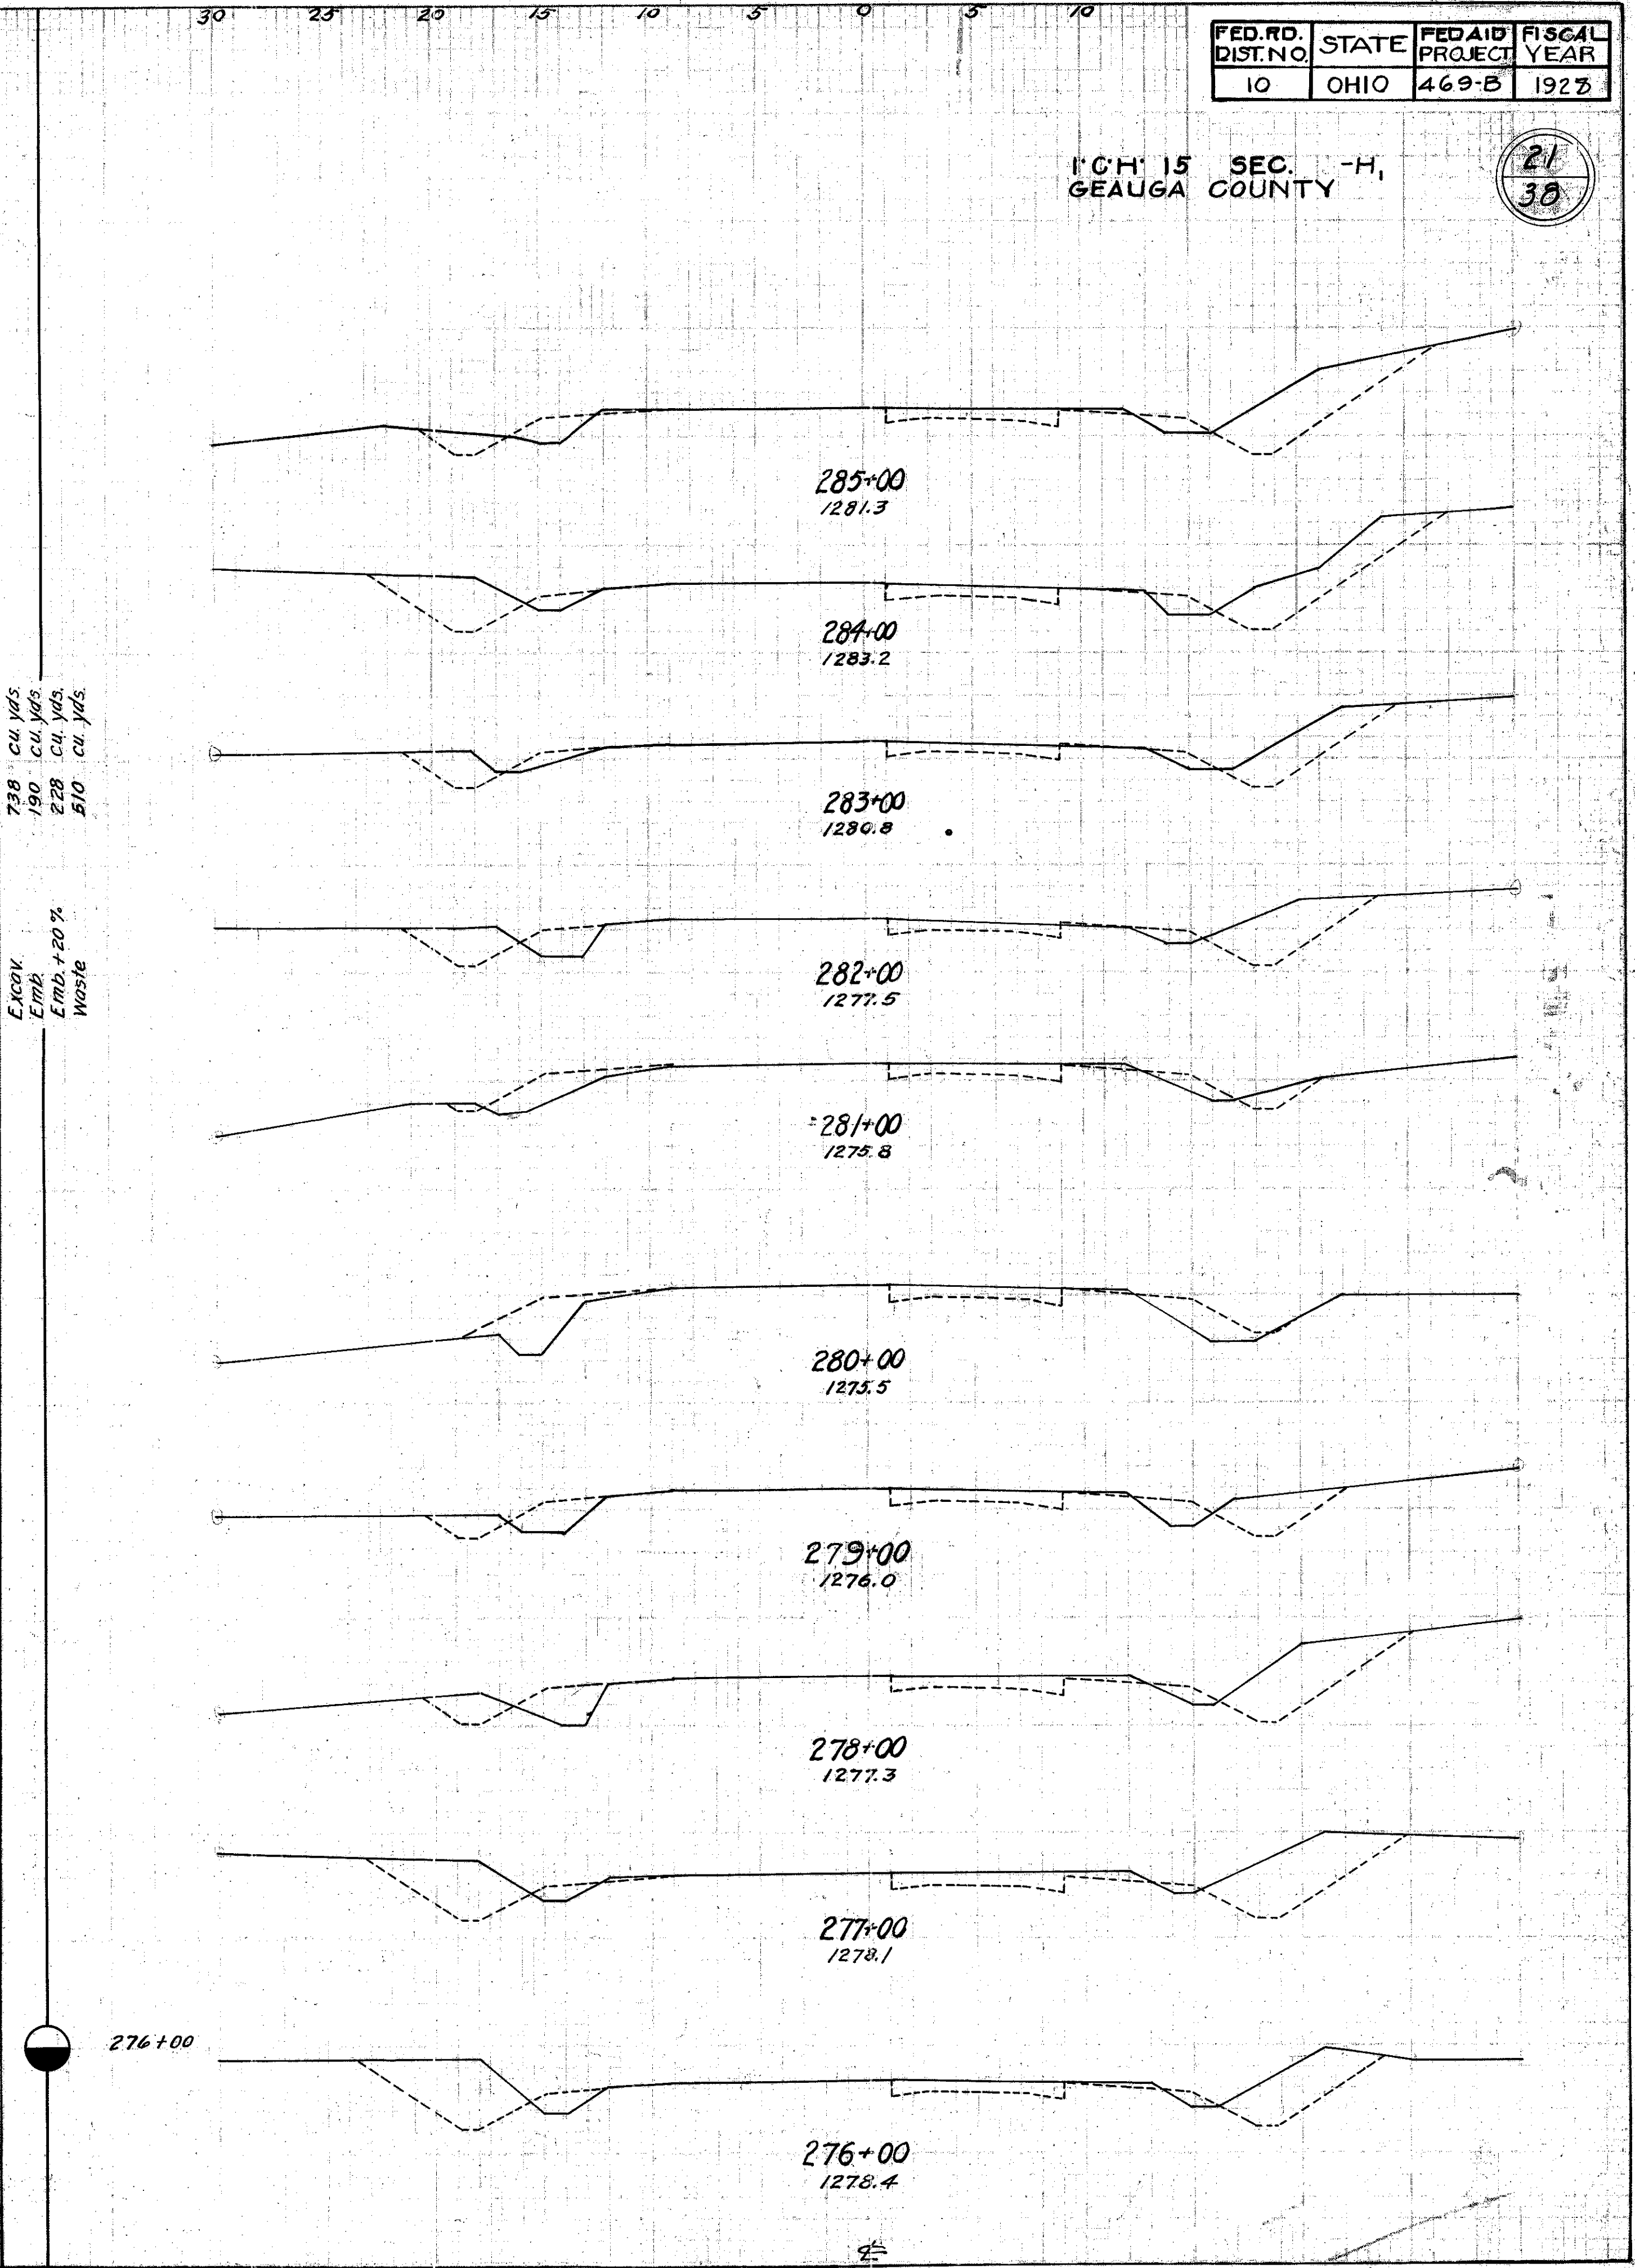

738 cu. yds
 190 cu. yds
 228 cu. yds
 510 cu. yds
 EXCAV
 Emb.
 Emb. + 20%
 Waste