

FED. RD. DIST. NO.	STATE	FED. AID PROJECT	FISCAL YEAR
10	OHIO	469-B	1928


1<sup>ST</sup> 15 SEC. -H,  
GEAUGA COUNTY

3  
38

HEATH ROAD  
SLM 4.89

old CFN 283220490  
new CFN 1832370  
SLM 4.89, 12"  
SEE SHEET 32

old CFN 283220497  
new CFN 1869706  
SLM 4.97, 2.5'x2.5'  
CONCRETE BOX  
SEE SHEET 28

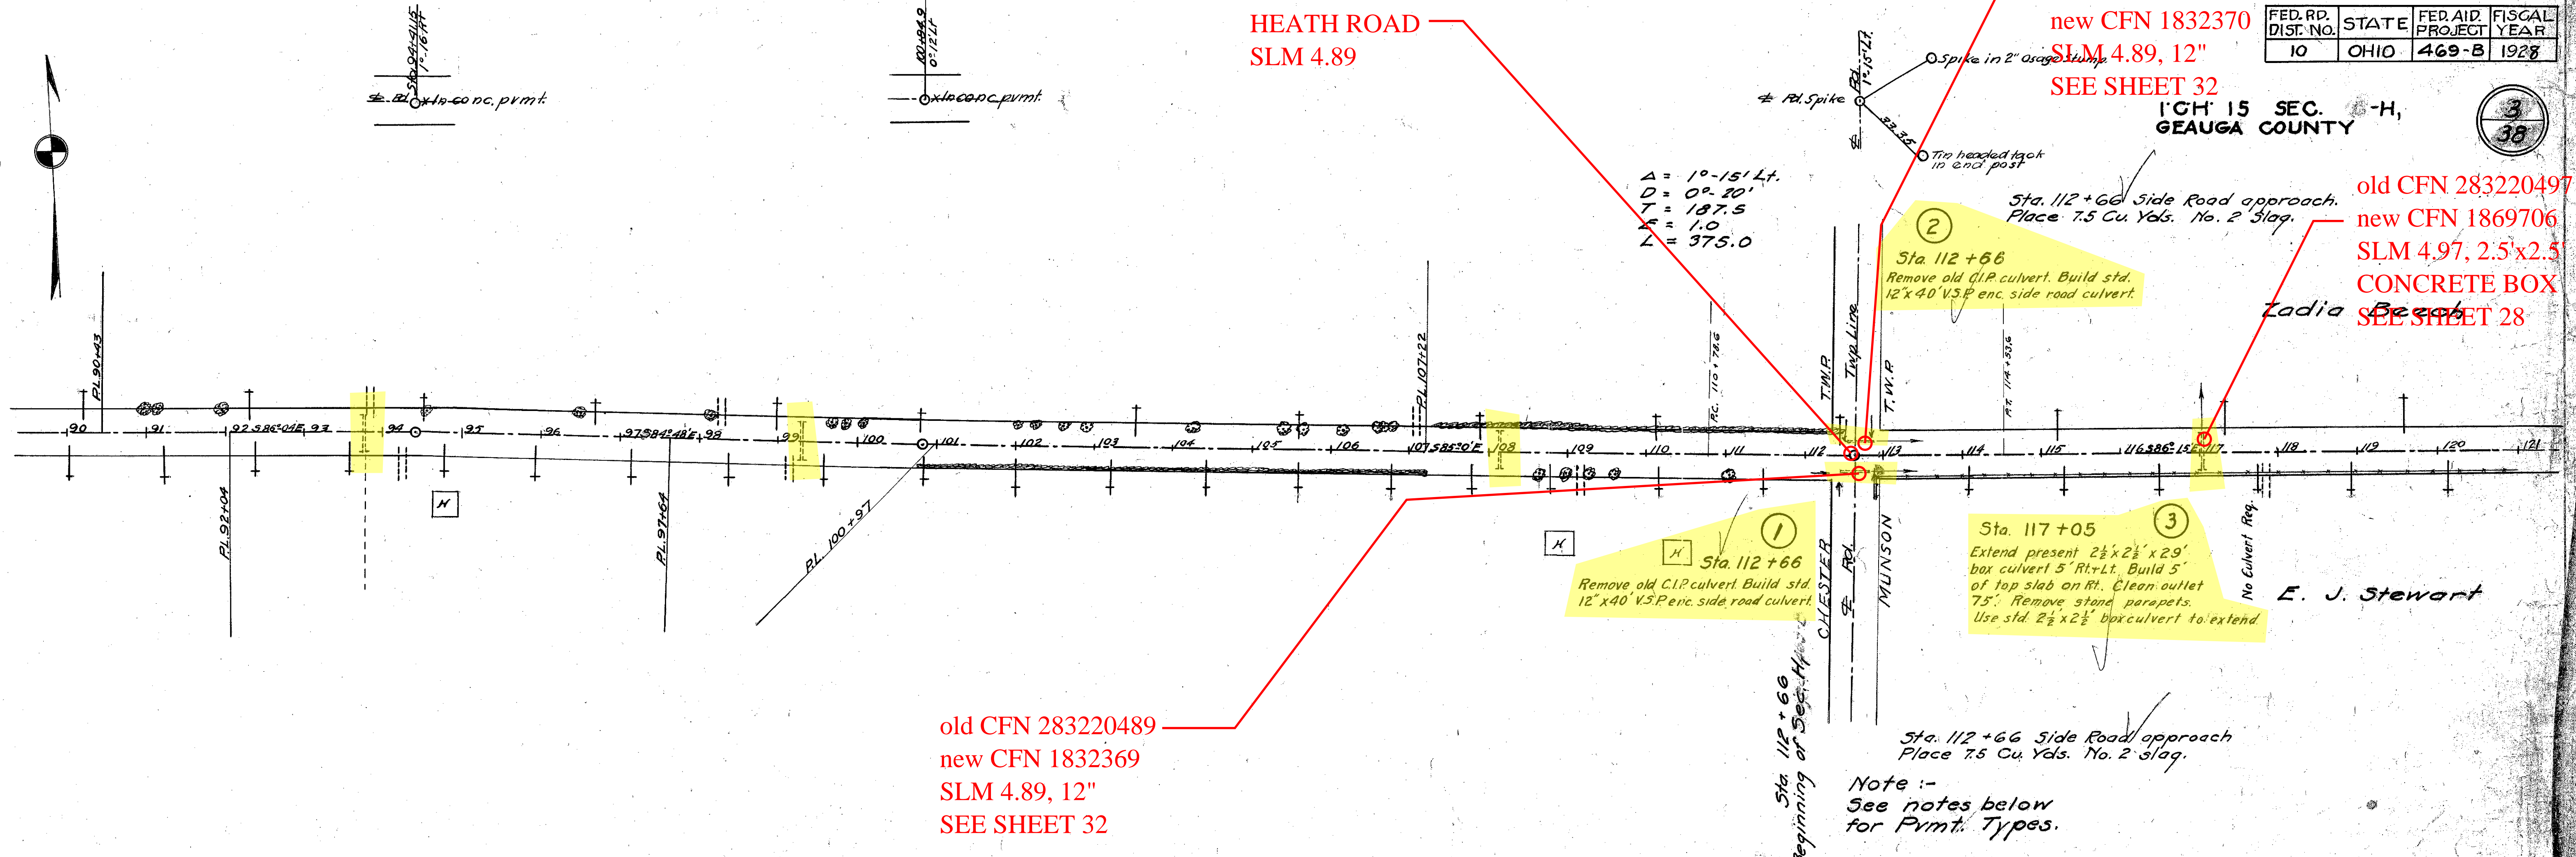

old CFN 283220489  
new CFN 1832369  
SLM 4.89, 12"  
SEE SHEET 32

Note :-  
See notes below  
for Pmnt. Types.


Note :- Grade line shown is crown of existing pavement.

Grade line shown is the grade of existing pavement.

Excav. 472 Cu. Yds.  
Borrow 748 Cu. Yds.  
Emb. 1017 Cu. Yds.  
Emb. +20% 1220 Cu. Yds.

Sta. 112+66 to 113+06  
Remove 40' old Pmnt.  
Build 40'-18' Pmnt.  
Typical Sec. Z.

Sta. 113+06 to 120+75  
Build 8' widening &  
resurface old Pmnt with  
6" slab. Typical Sec. X.

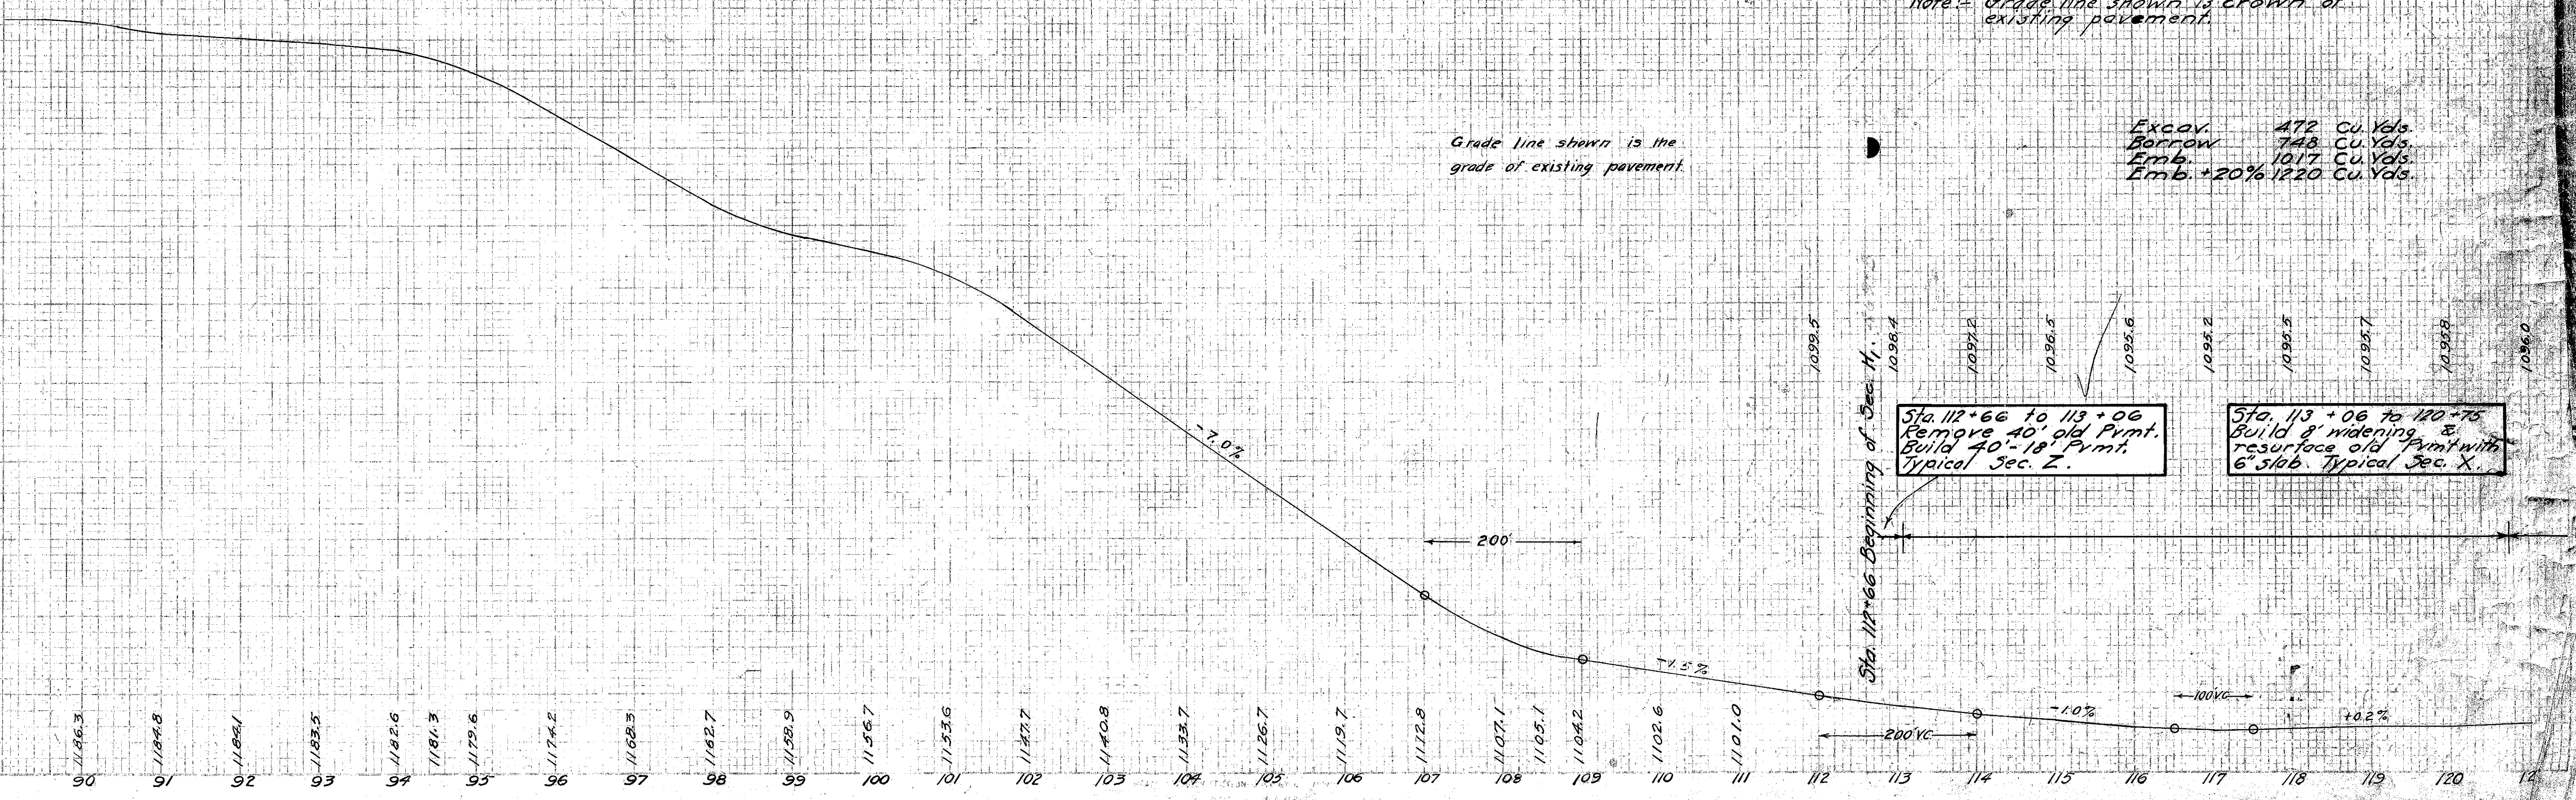

DATE	BY	REVISION

DATE	BY	REVISION