


ROSETTA DR
SLM 5.34 = MM 22.05

FED. RD. DIST. NO.	STATE	FED. AID PROJECT	FISCAL YEAR
10	OHIO	469-B	1978

1/4 CH. 15 SEC. C-H,
GEAUGA COUNTY

4
38

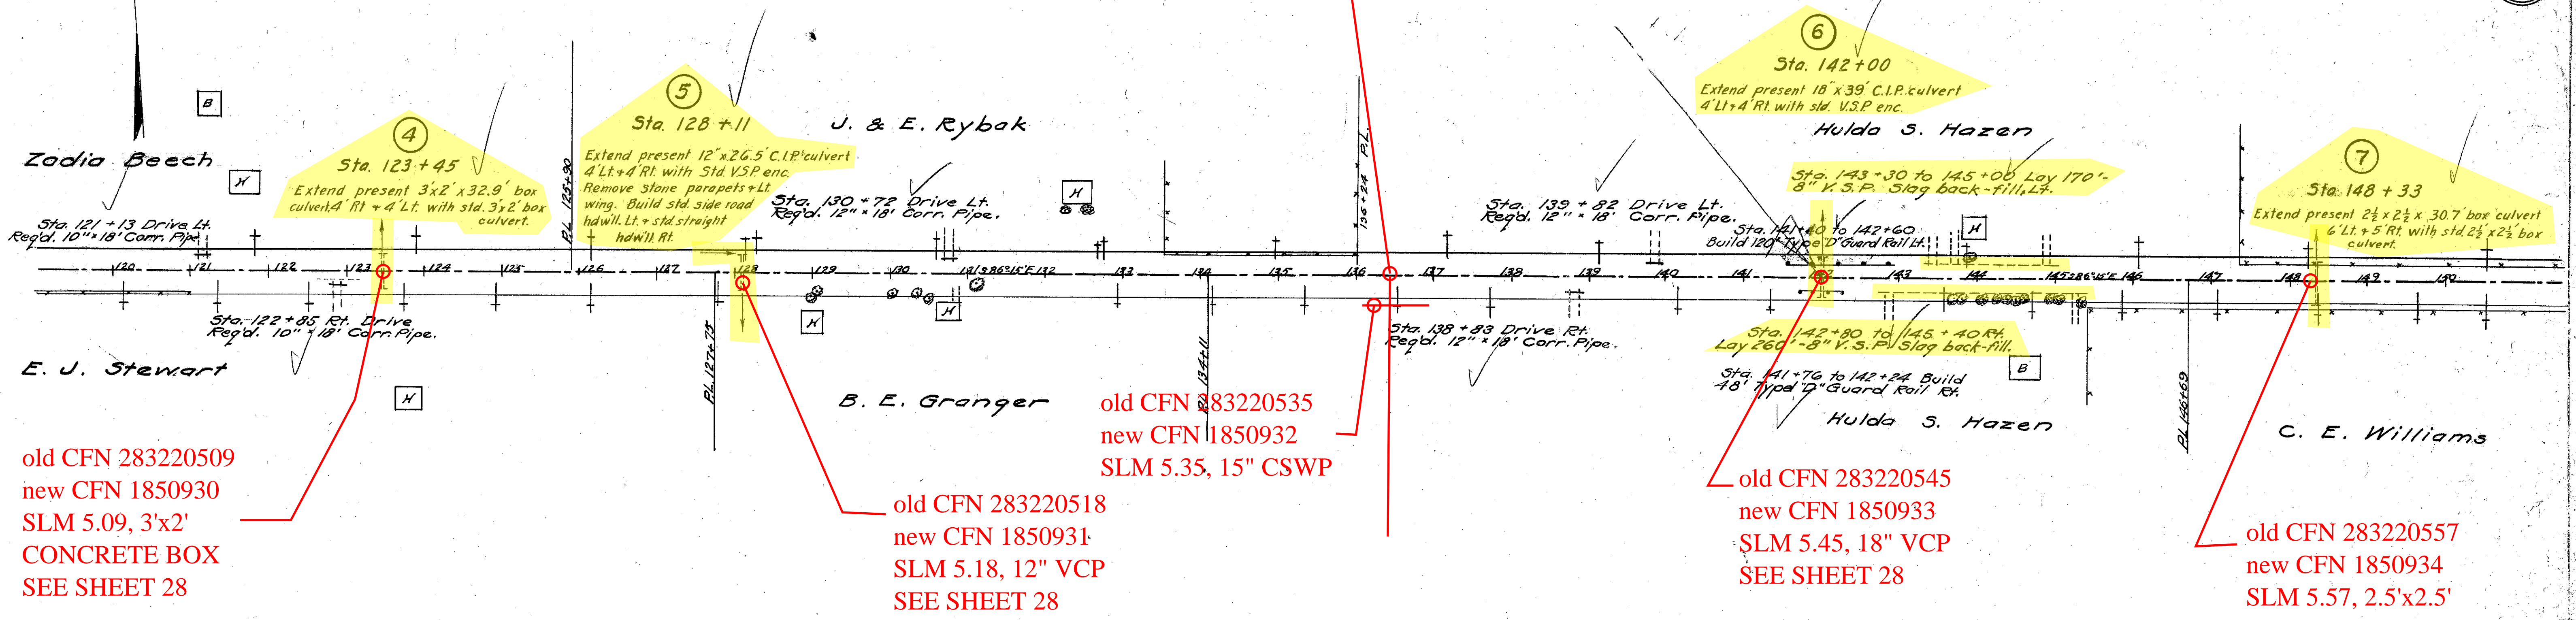

old CFN 283220509
new CFN 1850930
SLM 5.09, 3'x2'
CONCRETE BOX
SEE SHEET 28


old CFN 283220518
new CFN 1850931
SLM 5.18, 12" VCP
SEE SHEET 28

old CFN 83220535
new CFN 1850932
SLM 5.35, 15" CSWP

old CFN 283220545
new CFN 1850933
SLM 5.45, 18" VCP
SEE SHEET 28

old CFN 283220557
new CFN 1850934
SLM 5.57, 2.5'x2.5'
CONCRETE BOX
SEE SHEET 28

Note: Grade line shown is crown of existing pavement.

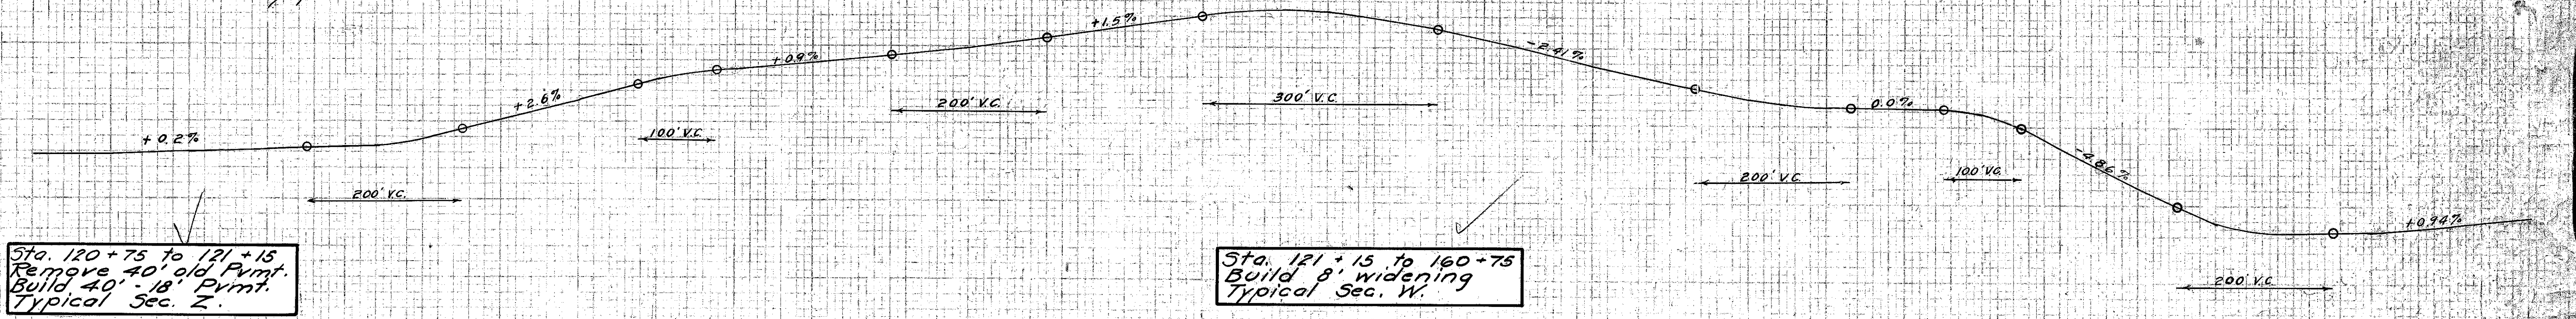

Excav.	336	Cu. Yds.
Borrow	60	Cu. Yds.
Emb.	390	Cu. Yds.
Emb. + 20%	396	Cu. Yds.

Excav.	483	Cu. Yds.
Borrow	70	Cu. Yds.
Emb.	461	Cu. Yds.
Emb. + 20%	553	Cu. Yds.

Excav.	320	Cu. Yds.
Borrow	387	Cu. Yds.
Emb.	594	Cu. Yds.
Emb. + 20%	713	Cu. Yds.

