

1' CH 15 SEC. -H,
GEAUGA COUNTY

BUTTERNUT RD.
SLM 6.54

Left	Station	Grade	Width	Edge of Pav.
1199.18	9.00	192+41.02	1199.23	9.00
1198.55	9.03	+50	1198.70	9.00
1196.80	9.36	+75	1196.95	9.00
1195.05	10.09	123+00	1195.20	9.00
1193.30	11.23	+75	1193.45	9.00
1191.55	12.57	+50	1191.70	9.00
1189.80	13.32	+75	1189.95	9.00
1188.05	13.50	+91.02	1188.20	9.00
1186.30	13.50	+75	1186.45	9.00
1184.55	13.50	+50	1184.70	9.00
1182.80	13.50	+75	1182.95	9.00
1181.05	13.46	195+00	1181.20	9.00
1179.30	13.00	+75	1179.45	9.00
1177.55	11.80	+50	1177.70	9.00
1175.80	10.52	+75	1175.95	9.00
1174.05	9.63	126+00	1174.20	9.00
1172.30	9.13	+25	1172.45	9.00
1170.55	9.00	+45.35	1170.70	9.00

Extra Pavement 117.4 Sp. Yds.


old CFN 283220627
new CFN 1882409
SLM 6.27, 24" VCP
SEE SHEET 29

old CFN 283220668
new CFN 1833262
SLM 6.68, 2.5'x2.5'
CONCRETE BOX
SEE SHEET 29
WAS REPLACED
AT SOME POINT
WITH 30" RCP

old CFN 283220653
new CFN 1833263
SLM 6.53, 2'x2'
CONCRETE BOX
SEE SHEET 29
WAS REPLACED AT
SOME POINT WITH
24" RCP

old CFN 283220643
new CFN 1833264
SLM 6.43, 12" VCP
SEE SHEET 29

Note: Grade line shown is crown of existing pavement.

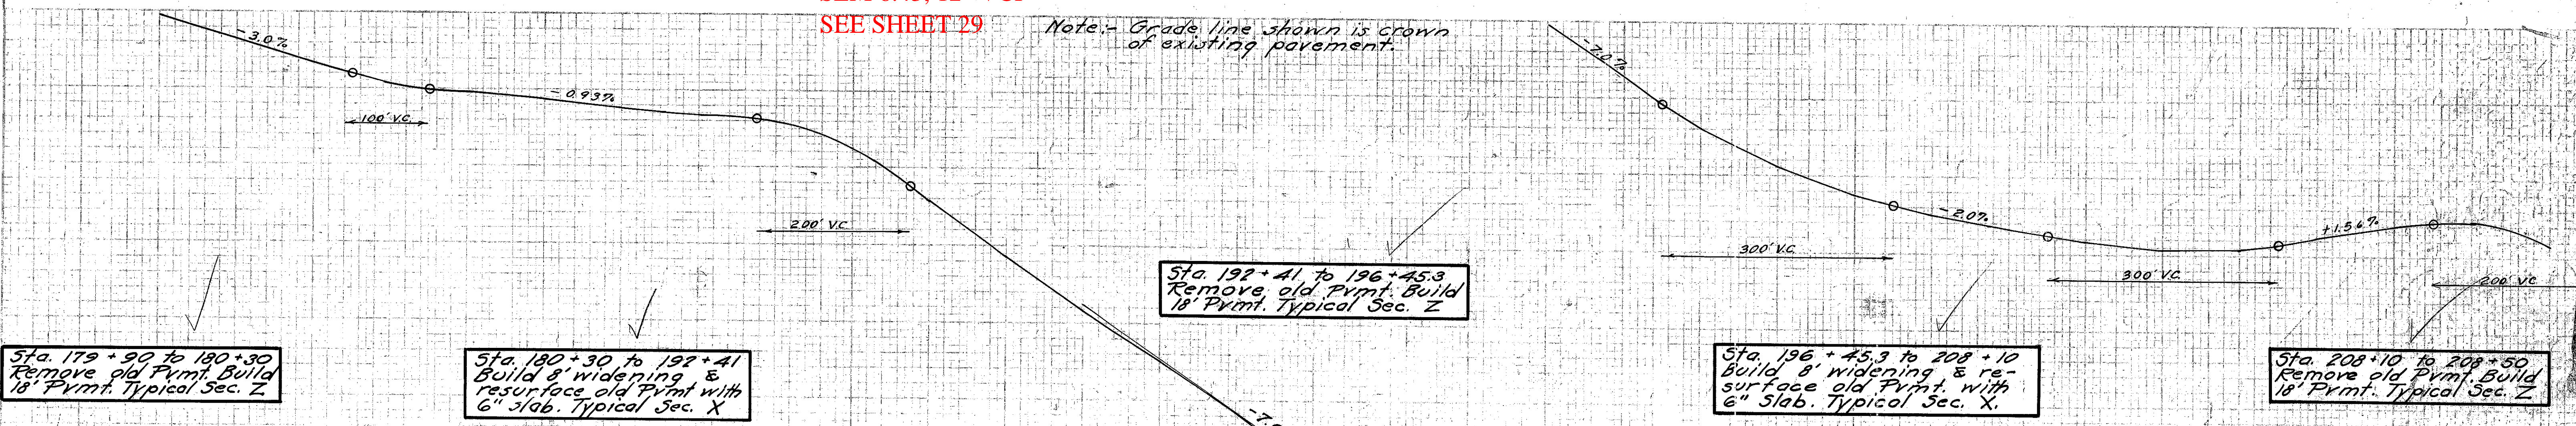

Sta. 179+90 to 180+30
Remove old Pymt. Build
18' Pymt. Typical Sec. Z

Sta. 180+30 to 192+41
Build 8' widening &
resurface old Pymt. with
6" slab. Typical Sec. X

Sta. 192+41 to 196+45.3
Remove old Pymt. Build
18' Pymt. Typical Sec. Z

Sta. 196+45.3 to 208+10
Build 8' widening & re-
surface old Pymt. with
6" slab. Typical Sec. X

Sta. 208+10 to 208+50
Remove old Pymt. Build
18' Pymt. Typical Sec. Z

Excav. 907 Cu. Yds.
Emb. 635 Cu. Yds.
Emb. +20% 762 Cu. Yds.
Waste 145 Cu. Yds.

Excav. 1584 Cu. Yds.
Emb. 1200 Cu. Yds.
Emb. +20% 1440 Cu. Yds.
Waste 744 Cu. Yds.

Excav. 855 Cu. Yds.
Emb. 712 Cu. Yds.
Emb. +20% 855 Cu. Yds.

