



old CFN 283220806
new CFN 1853145
SLM 8.06, 12" VCP
SEE SHEET 31

old CFN 283220822
new CFN 1853146
SLM 8.06, 12" VCP
SEE SHEET 31

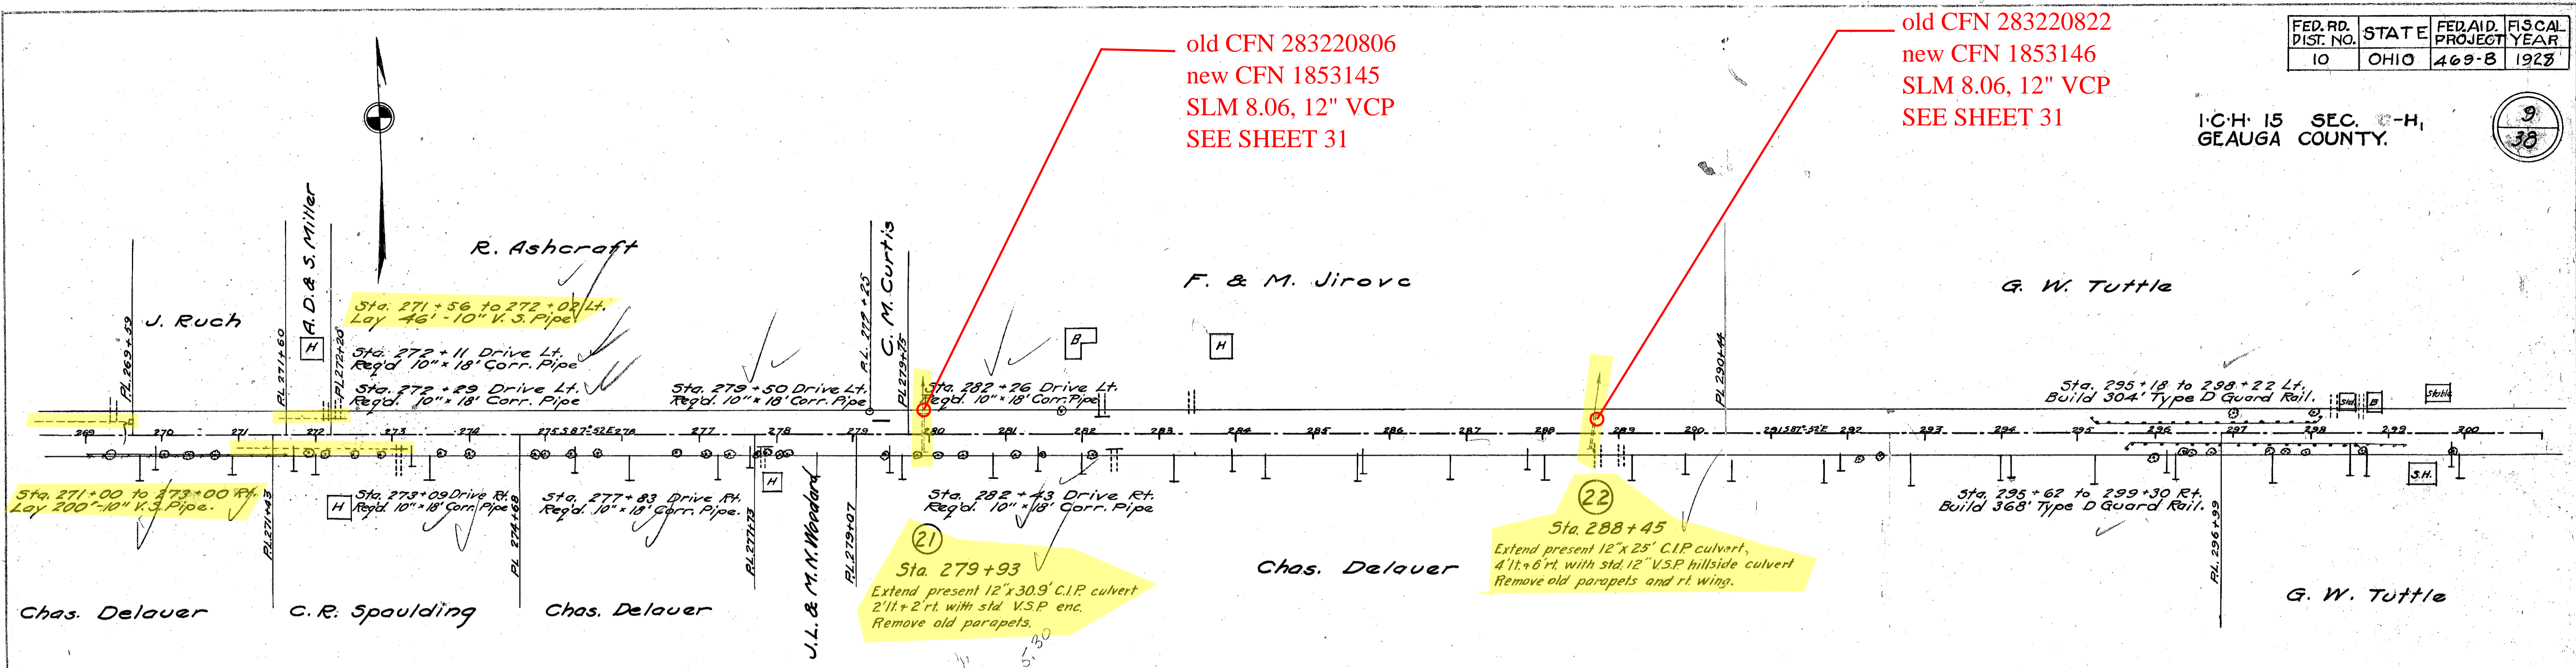

Note: Grade line shown is crown of existing pavement.

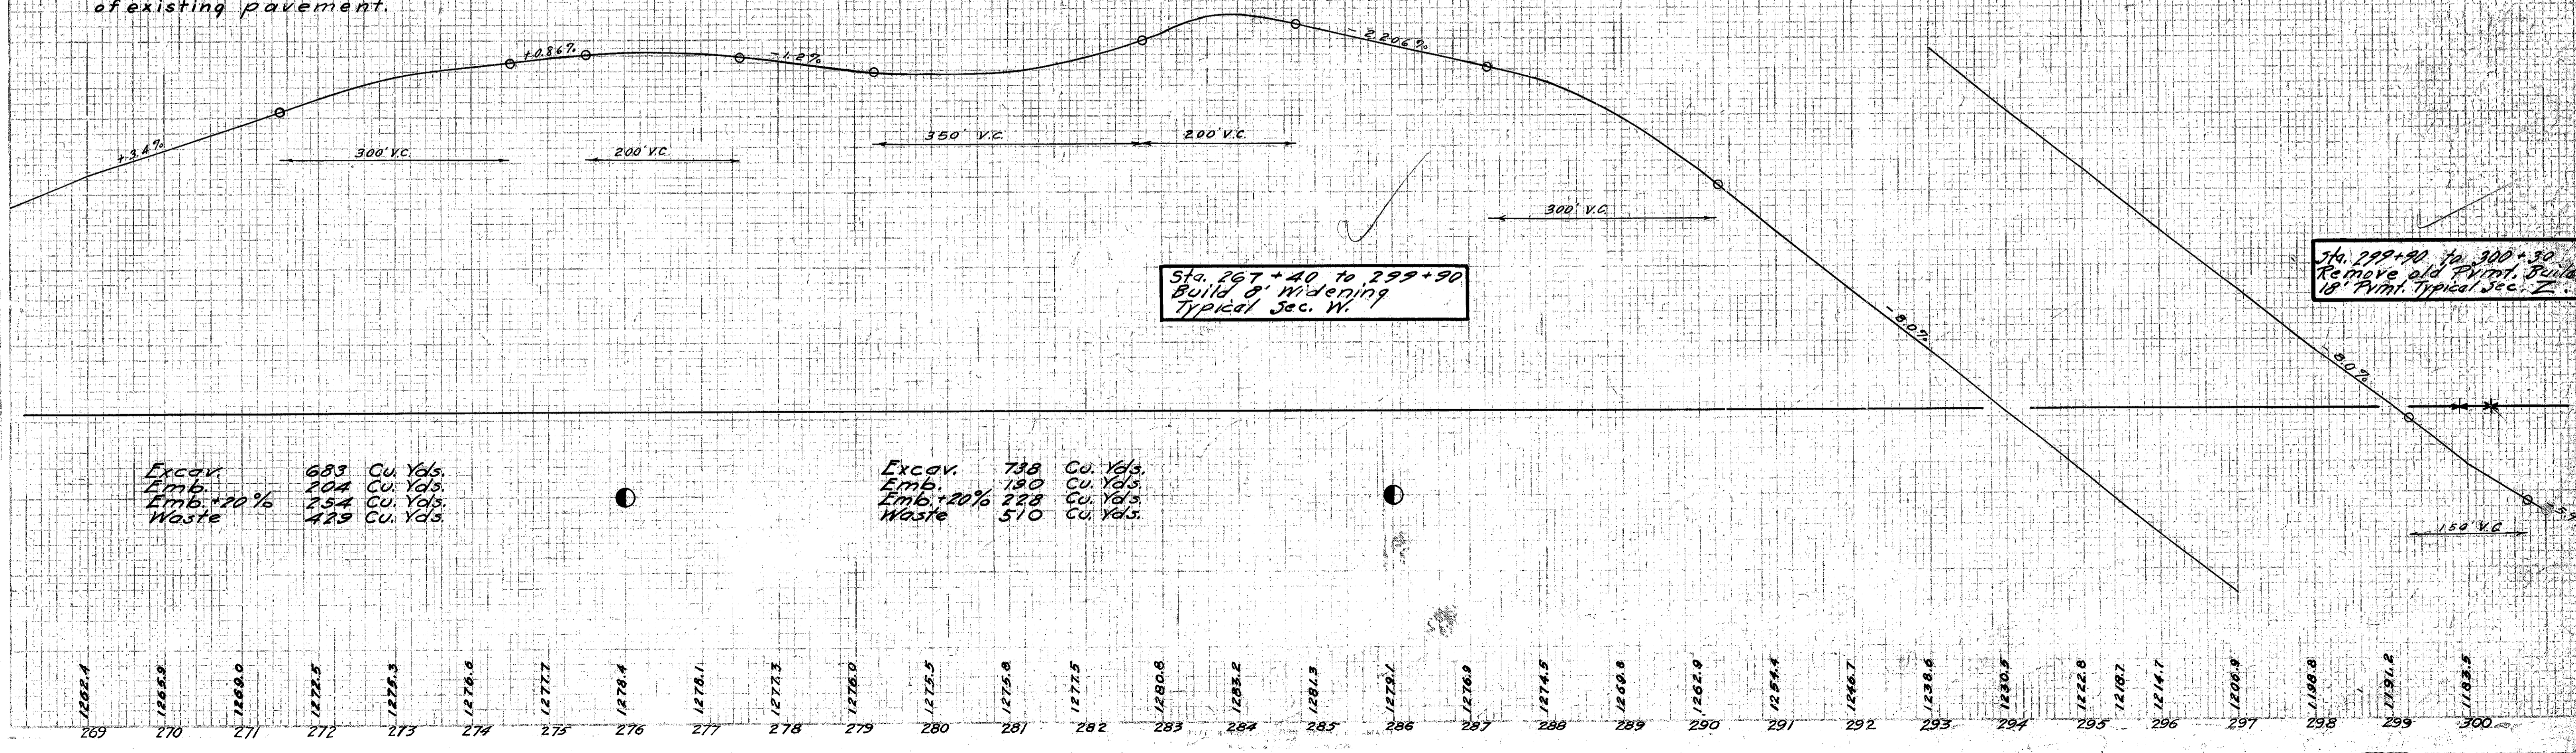

Excav.	683	Cu. Yds.
Emb.	204	Cu. Yds.
Emb. +20%	254	Cu. Yds.
Waste	479	Cu. Yds.

Excav.	738	Cu. Yds.
Emb.	190	Cu. Yds.
Emb. +20%	228	Cu. Yds.
Waste	510	Cu. Yds.

Sta. 267+40 to 299+90
Build 8' Widening
Typical Sec. W.

Sta. 299+40 to 300+30
Remove old P.V.M., Build
18' P.V.M. Typical Sec. Z.