

1'C.H. 315 SEC. F
GEAUGA COUNTY


Sta. 0+16 to 11+94, Storm Sewer Req'd.
Sta. 0+16 to 3+11, 298 ft. 10" V.S.P.
Sta. 3+11 to 5+21, 208 ft. 8" V.S.P.
Sta. 5+21 to 11+94, 666 ft. 10" V.S.P.
Std. No. 1 Side ditch Inlets, complete.
Sta. 0+27 Sta. 7+11
Sta. 3+11 Sta. 8+93
Sta. 5+21 Sta. 10+77.
Tap west end of sewer into culvert.
(Two lin. ft. of pipe are deducted for each inlet).

Detail of intersection Sta. 0+00

old CFN 283220298
new CFN 1807817
SLM 2.98, 4'x2'
CONCRETE BOX
SEE SHEET 13
48" RCP OUTLET EXT.
ADDED AT SOME POINT

old CFN 283220315
new CFN 1807818
SLM 3.15, 3'x2'
CONCRETE BOX
SEE SHEET 13
24" CMP AND CB
ADDED AT INLET
AT SOME POINT

SR 306
SLM 2.75

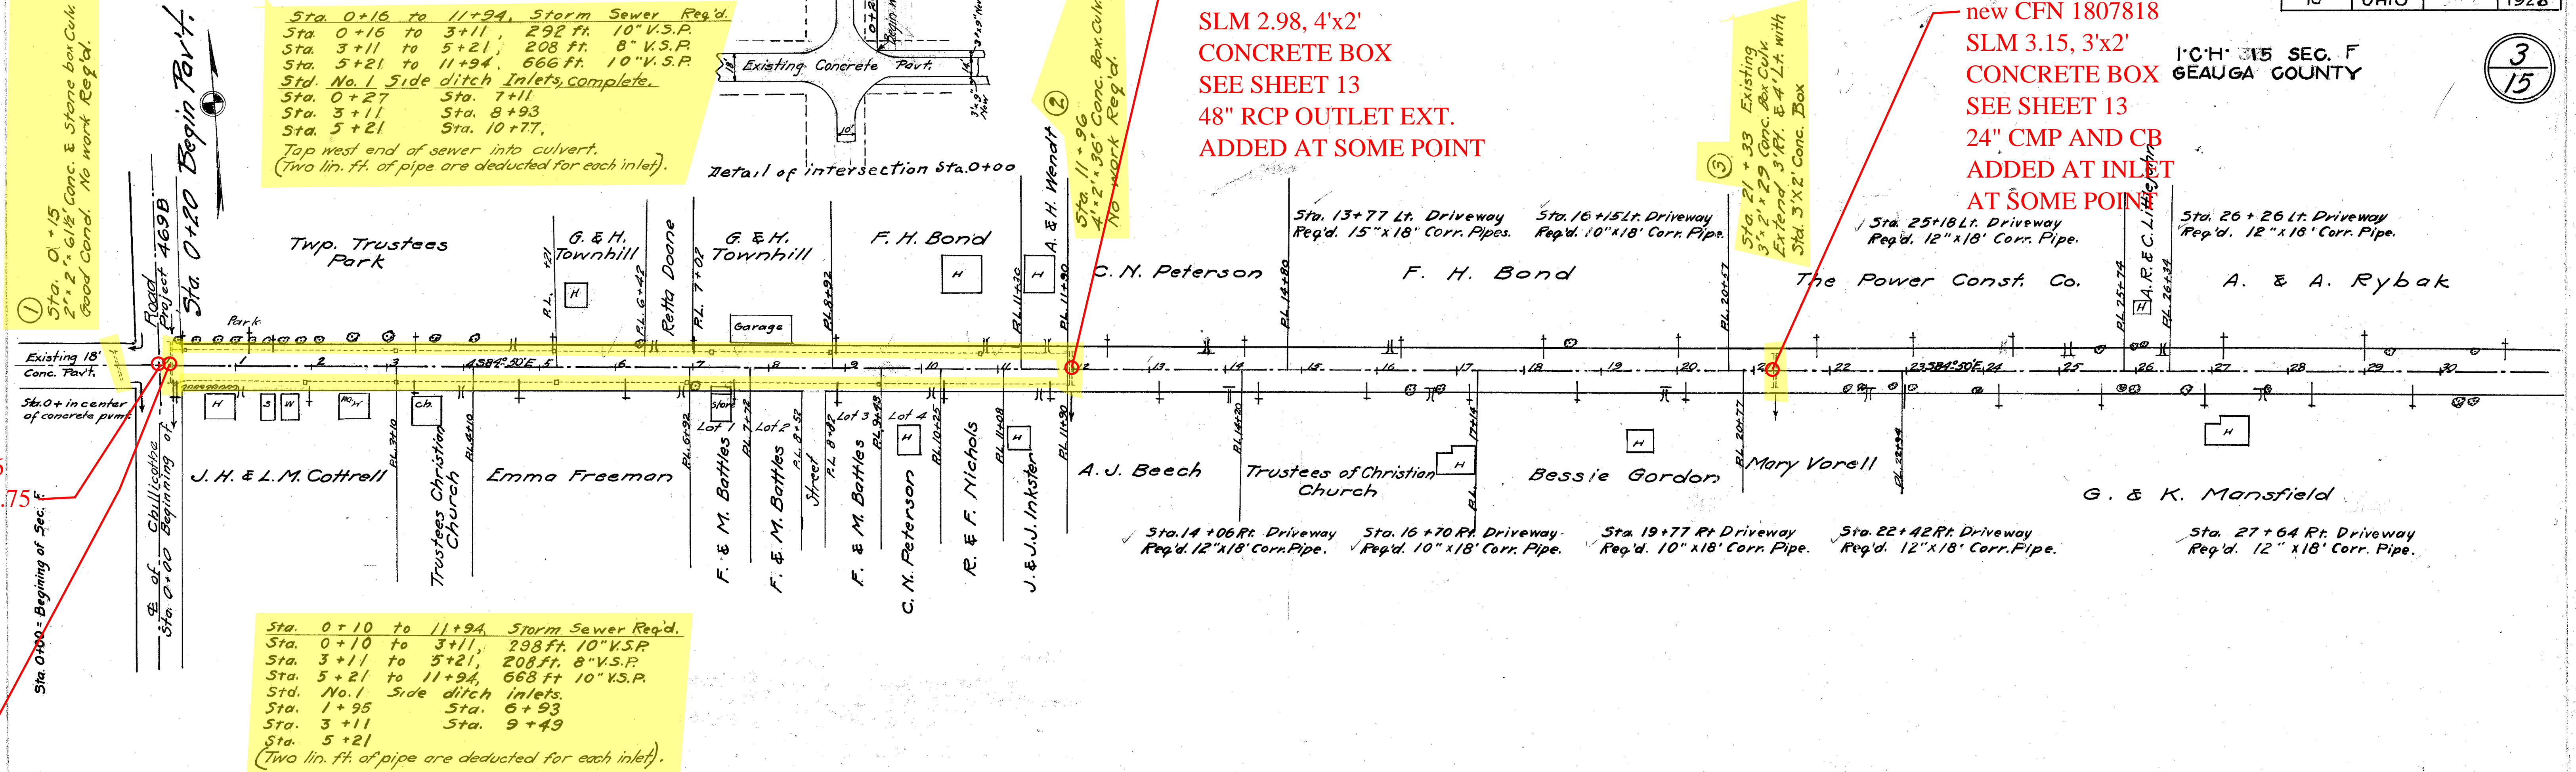

Sta. 0+10 to 11+94, Storm Sewer Req'd.
Sta. 0+10 to 3+11, 298 ft. 10" V.S.P.
Sta. 3+11 to 5+21, 208 ft. 8" V.S.P.
Sta. 5+21 to 11+94, 666 ft. 10" V.S.P.
Std. No. 1 Side ditch inlets.
Sta. 1+95 Sta. 6+93
Sta. 3+11 Sta. 9+49
Sta. 5+21
(Two lin. ft. of pipe are deducted for each inlet).

Note:-
Profile shown is crown
of existing pavement.

SLM 2.75, CULVERT
WAS REPLACED WITH
AN 18" STORM SEWER

