


old CFN 283220452
new CFN 1833183
SLM 4.52, 12"
SEE SHEET 14

old CFN 283220463
new CFN 1807823
SLM 4.63, 12"
SEE SHEET 14

old CFN 283220480
new CFN 1814191
SLM 4.80, 2.5'x2.5'
CONCRETE BOX
SEE SHEET 14

Heath Road
SLM 4.89

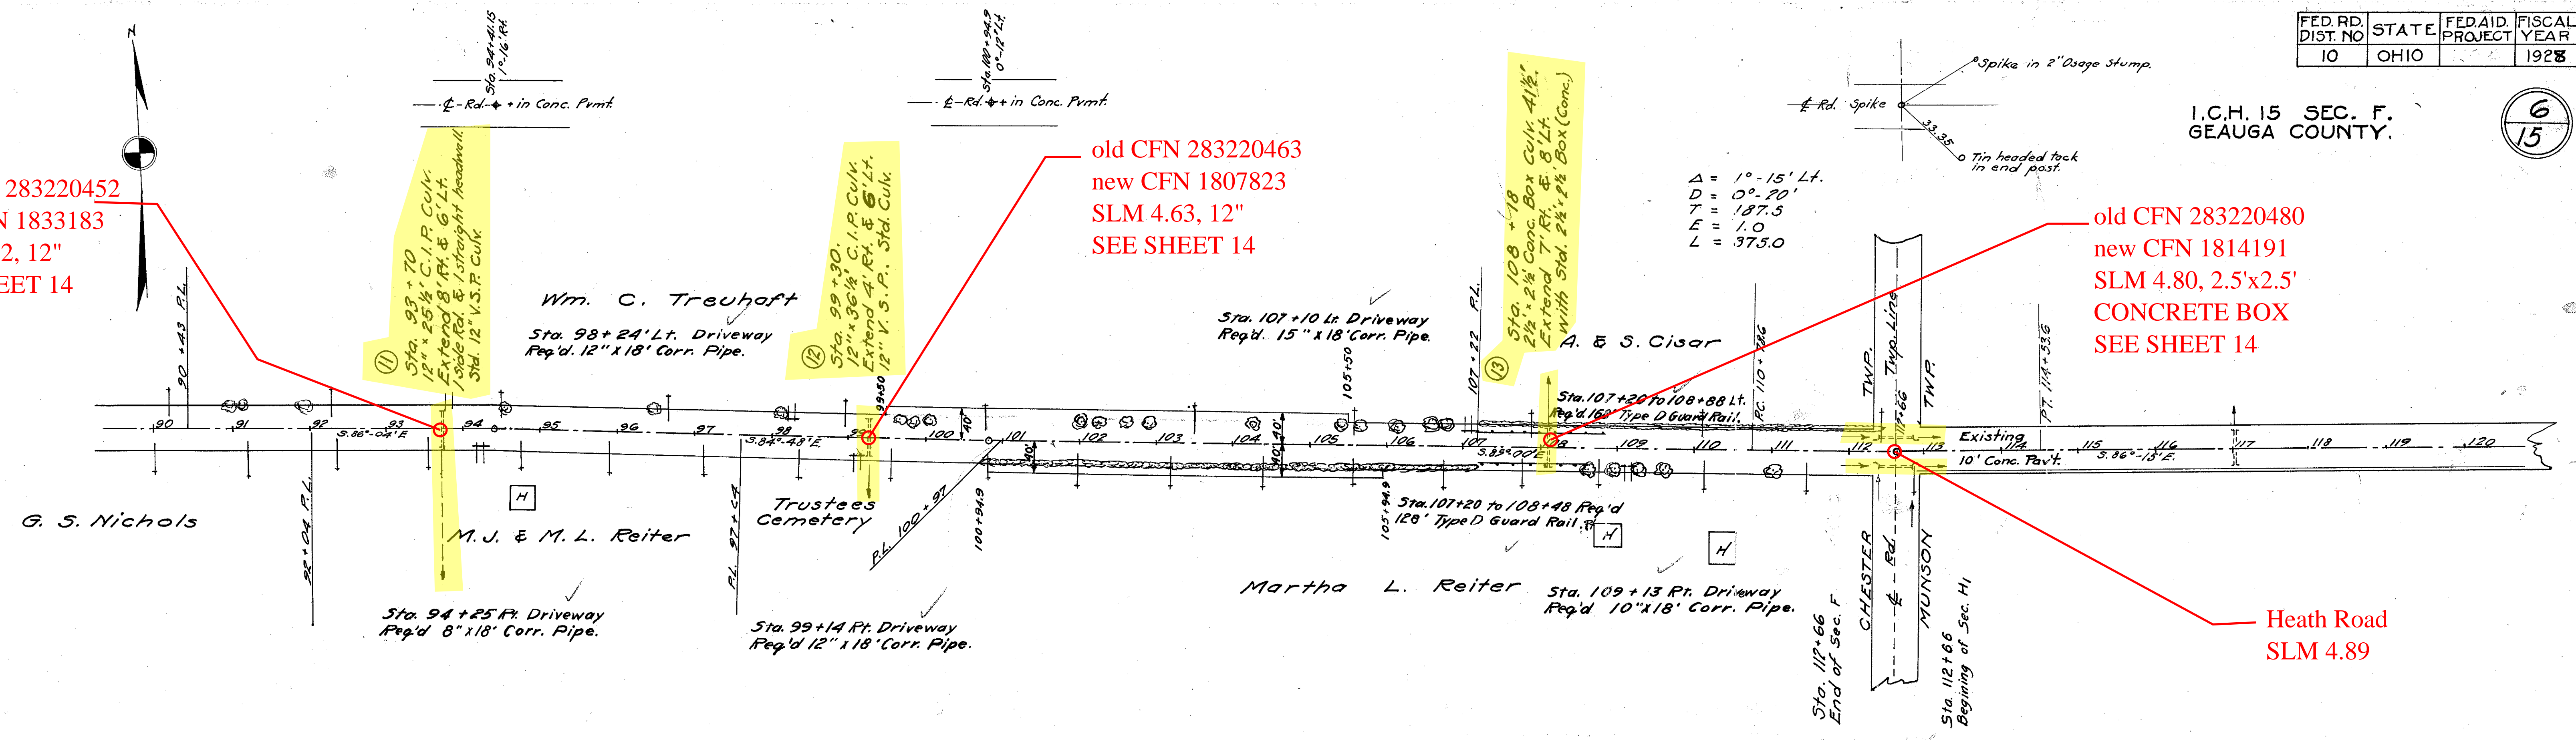

Note:-
Profile shown is crown
of existing pavement.

