

FED. AID DIST. NO.	STATE	FED. AID PROJECT	FISCAL YEAR
10	OHIO	469-C	1930

4  
19

5-H (1-C-H) 15 SEC. H<sub>2</sub>O  
GEAUGA COUNTY.

old CFN 283221103  
new CFN 1821322  
SLM 11.03, 3'x3'  
CONCRETE BOX  
SEE SHEET 16


old CFN 283221149  
new CFN 1807824  
REPLACED IN 1954  
UNDER GEA-322-11.45

old CFN 283221115  
new CFN 1828497  
SLM 11.15, 12" VCP  
SEE SHEET 16

old CFN 283221110  
new CFN 1828496  
SLM 11.10, 12" VCP  
SEE SHEET 16

Aquilla Road  
SLM 11.10

Spencer Road  
SLM 11.55

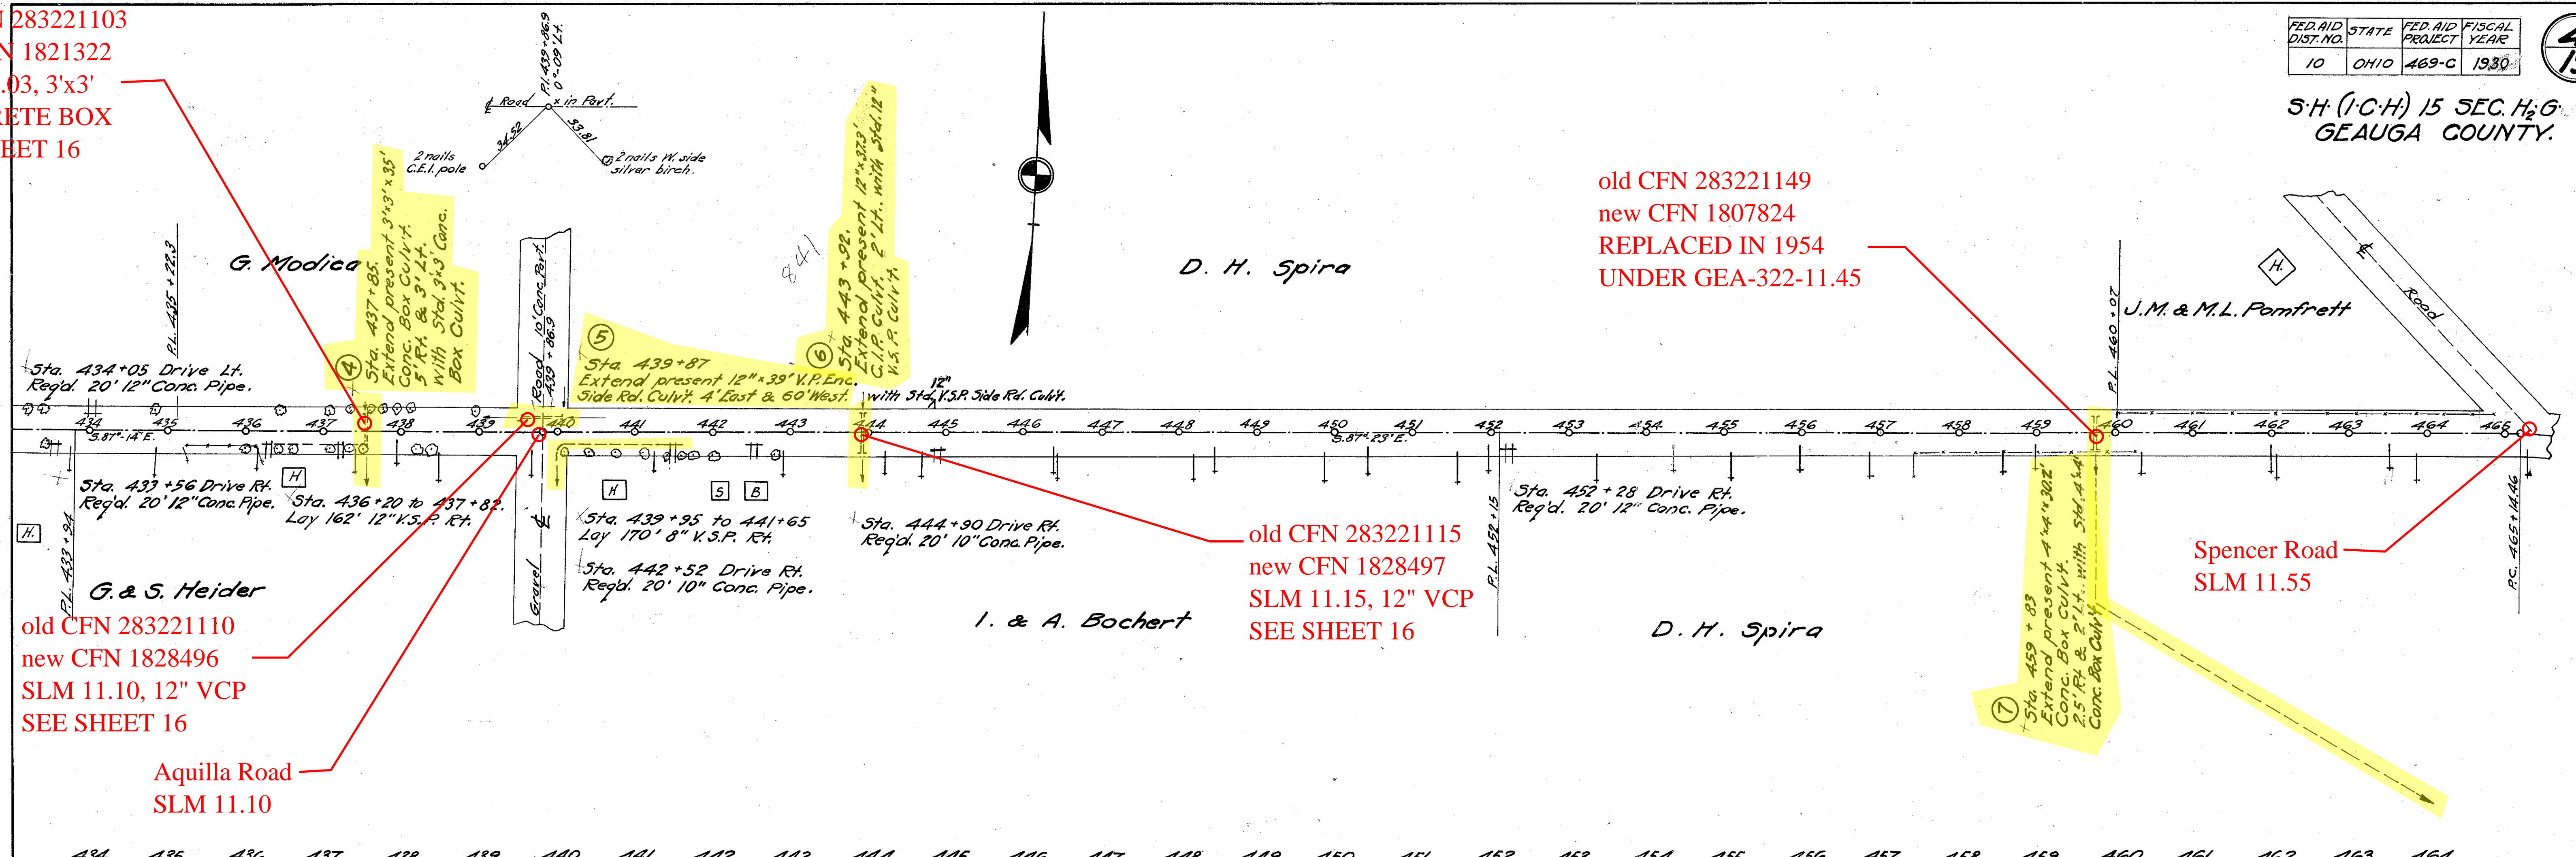


434 435 436 437 438 439 440 441 442 443 444 445 446 447 448 449 450 451 452 453 454 455 456 457 458 459 460 461 462 463 464

Grade line shown is crown of existing pavement.

Excav. 324 Cu. Yds.  
Borrow 445 Cu. Yds.  
Emb. +25% 615 Cu. Yds.  
Waste 769 Cu. Yds.  
3% cu. yds. borrow to be obtained from waste between next balance points

Excav. 1037 Cu. Yds.  
Emb. 609 Cu. Yds.  
Emb. +25% 761 Cu. Yds.  
Waste 276 Cu. Yds.

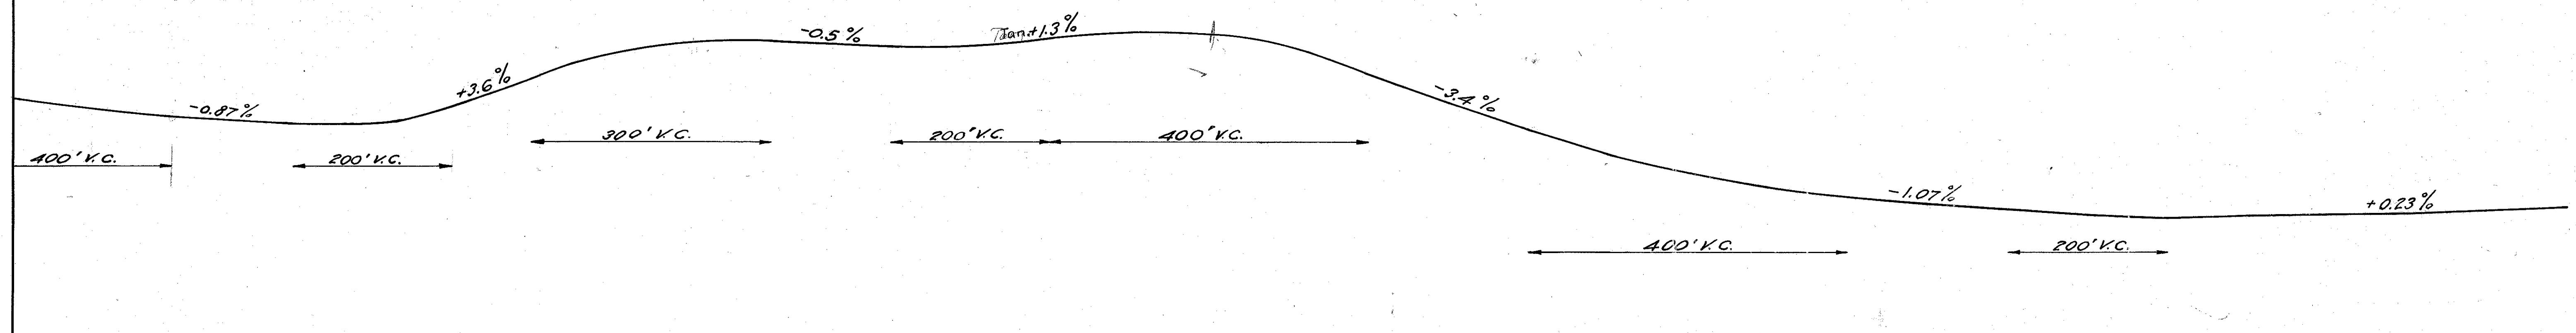

Sta. 428+70.5 to 439+20  
Build 18' Pav't.  
Typical Section X.

Sta. 439+20 to 440+00  
Remove old Pav't.  
Build 18' Pav't. Typical Sec. Z

Sta. 440+00 to 464+76  
Build 8' widening  
Typical Sec. W.

1150.2 1149.3 1148.6 1148.2 1148.4 1149.0 1152.1 1156.0 1158.1 1158.9 1158.3 1158.2 1158.2 1159.1 1160.0 1159.7 1158.2 1154.7 1151.0 1147.6 1144.4 1142.1 1140.1 1138.9 1138.0 1137.2 1136.7 1136.2 1136.5 1136.6 1136.8 1137.2 1137.4