


old CFN 283221885
new CFN 1814188
SLM 18.84

old CFN 283221889
new CFN 1841190
SLM 18.89

old CFN 283221905
new CFN 1828500
SLM 19.05

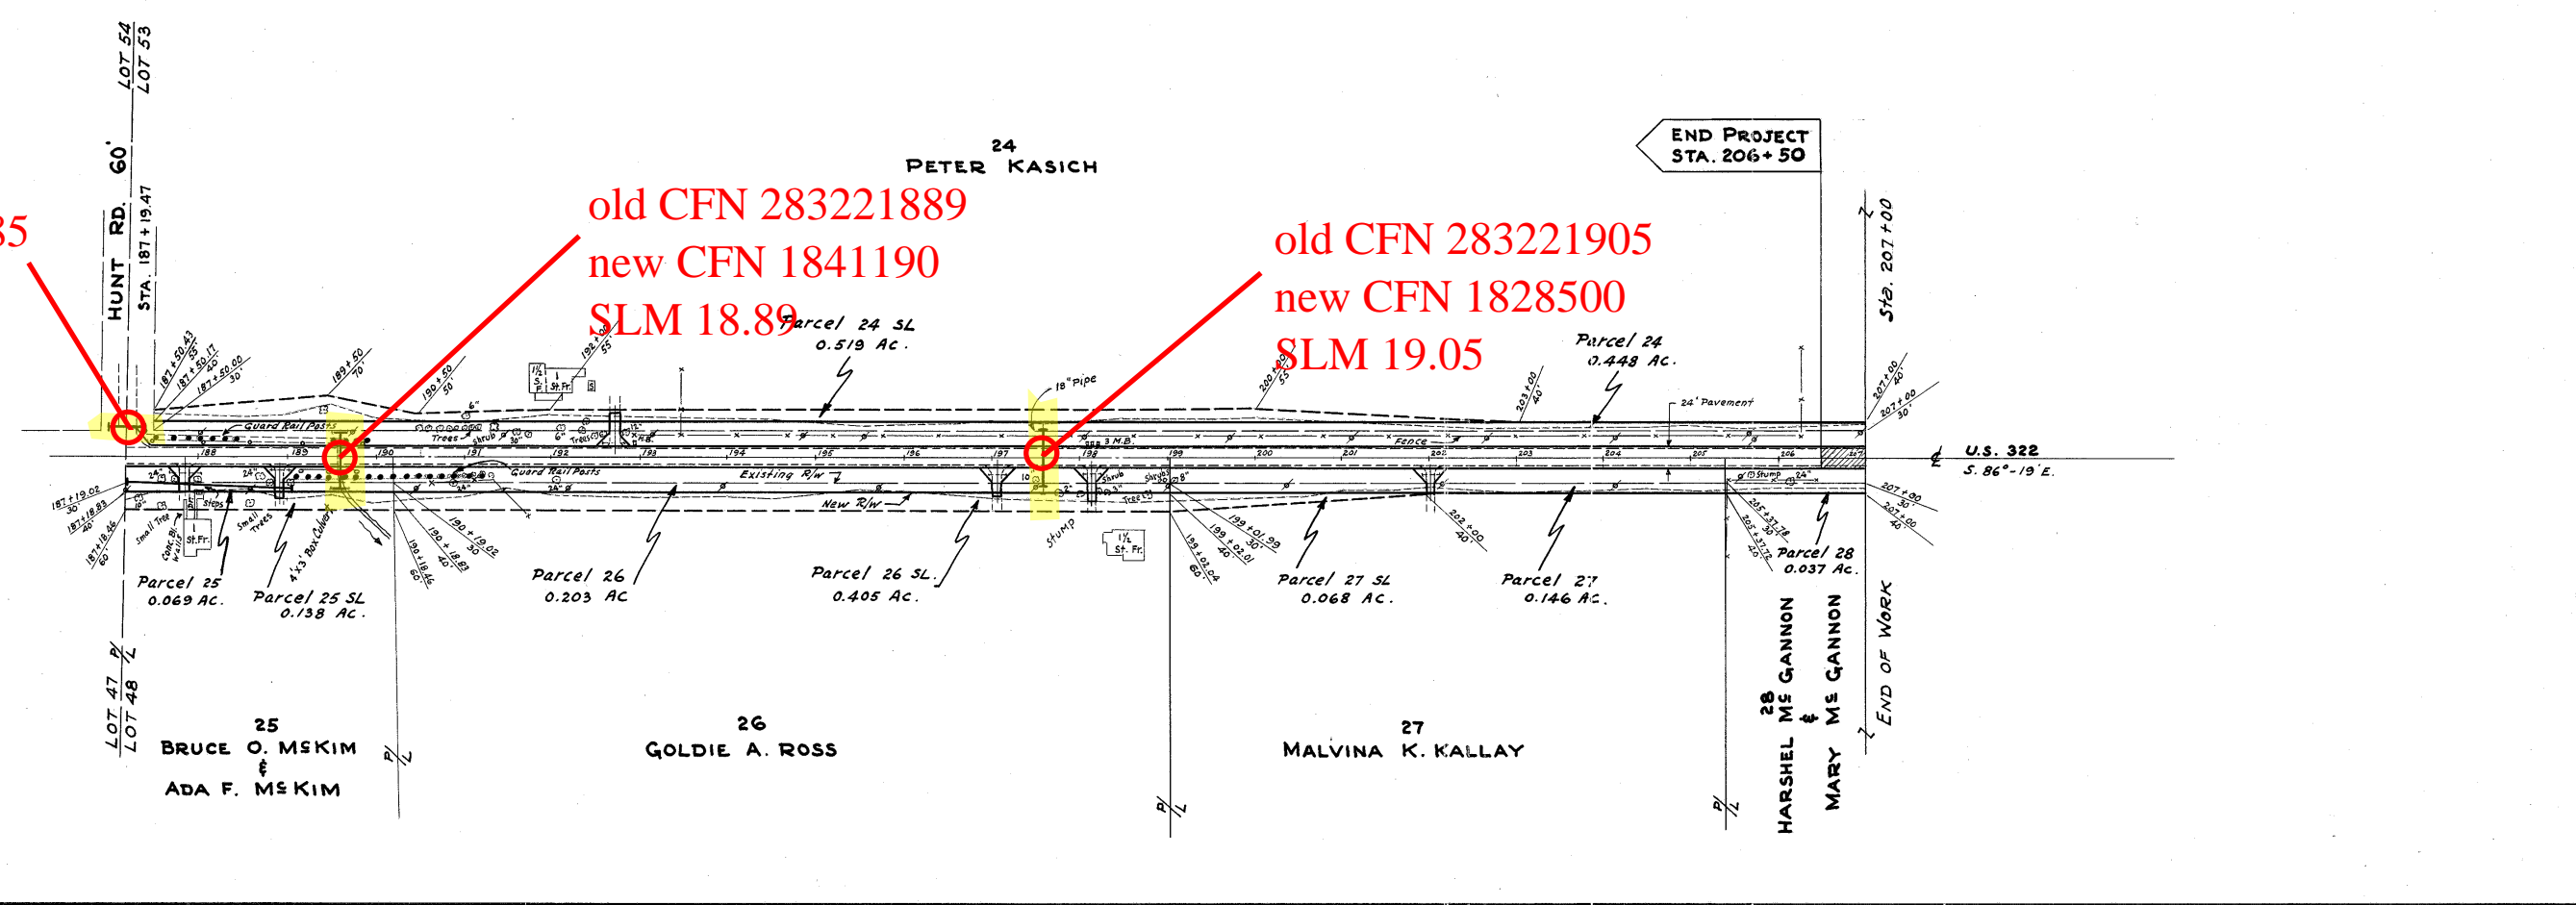

RIGHT - OF - WAY STA 160 + 05.05 TO STA. 207 + 00