



Packed Stake 30' Hub 30' - 200

Packed Stake 30' Hub 30' - 200

Packed Stake 30' Hub 30' - 200

new CFN 1861339
old CFN 284221259
**RETIRED. REPLACED
IN 2016**
SLM 12.59, 3'x2'
CONCRETE BOX

Sta. 654+55 Remove old stone box. Build new Stone Design 3'x2'. Cor. box. Length 32'

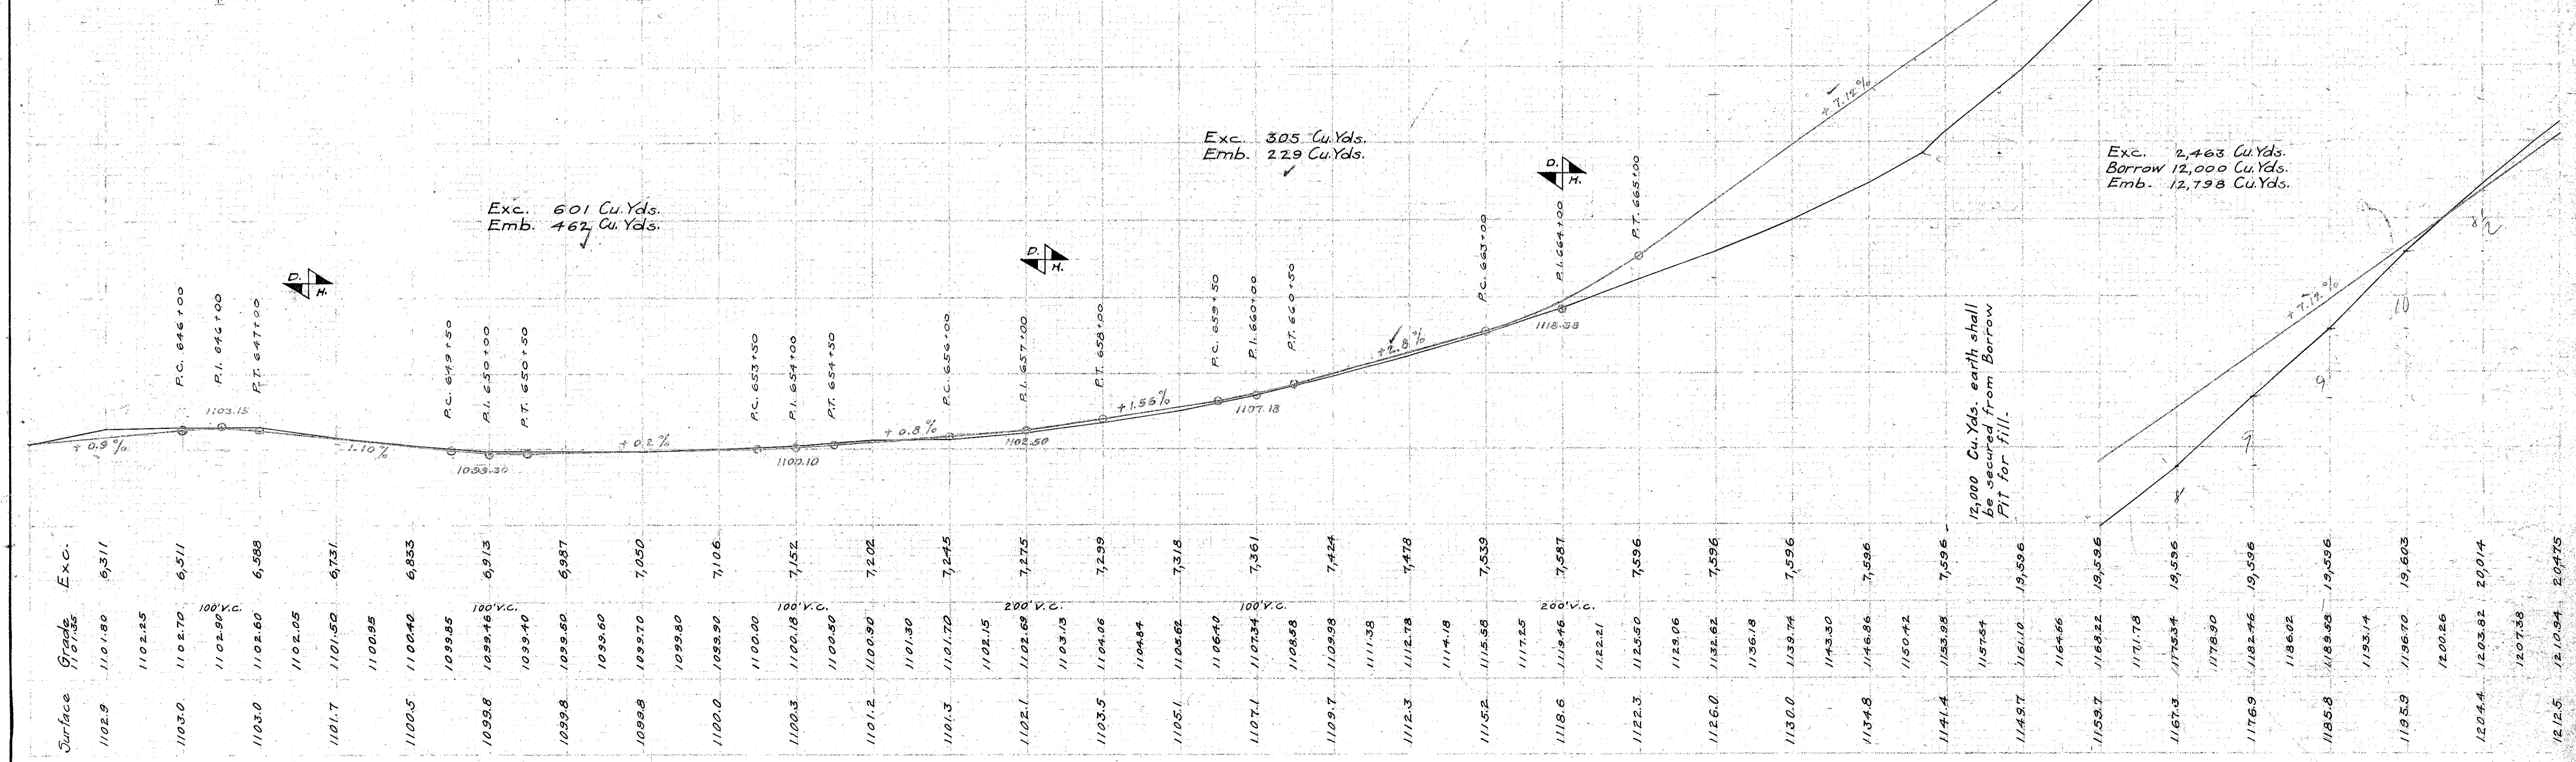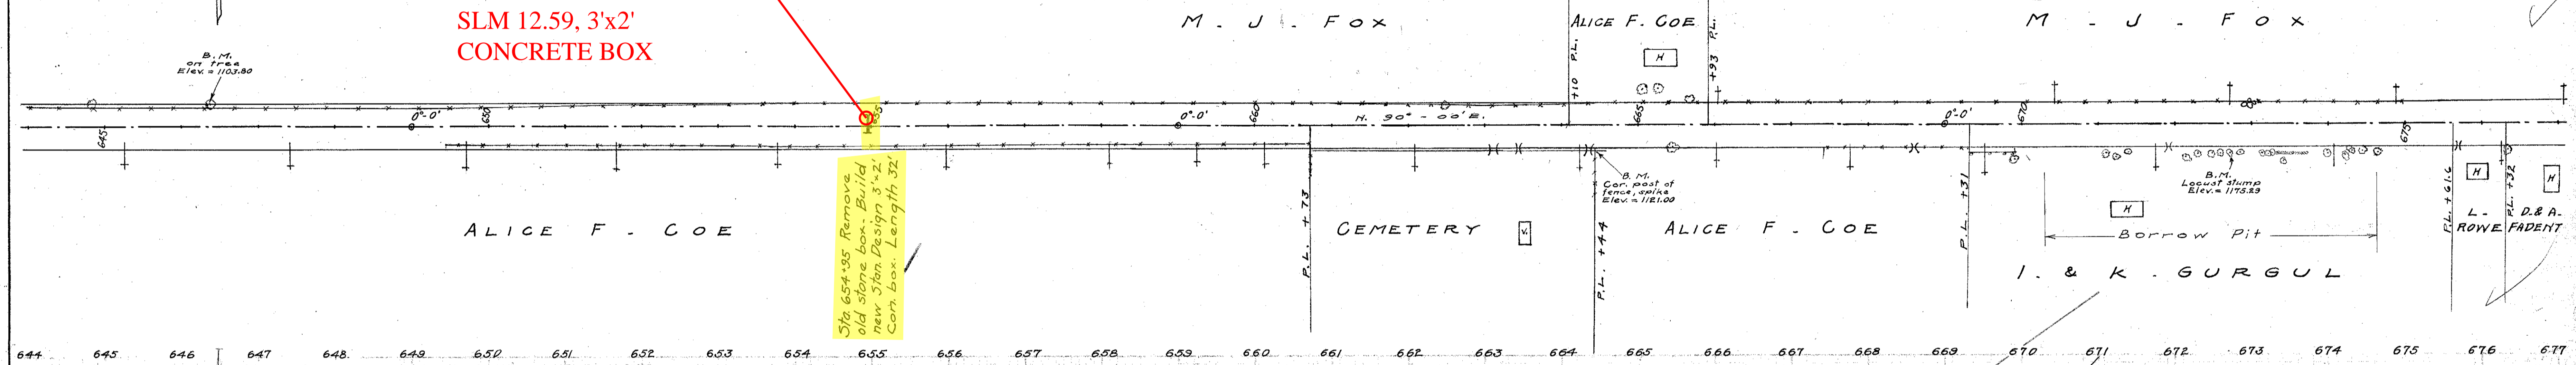

Exc. 601 Cu.Yds.
Emb. 462 Cu.Yds.

Exc. 305 Cu.Yds.
Emb. 229 Cu.Yds.

Exc. 2,463 Cu.Yds.
Borrow 12,000 Cu.Yds.
Emb. 12,798 Cu.Yds.

12,000 Cu.Yds. earth shall be secured from Borrow Pit for fill.