
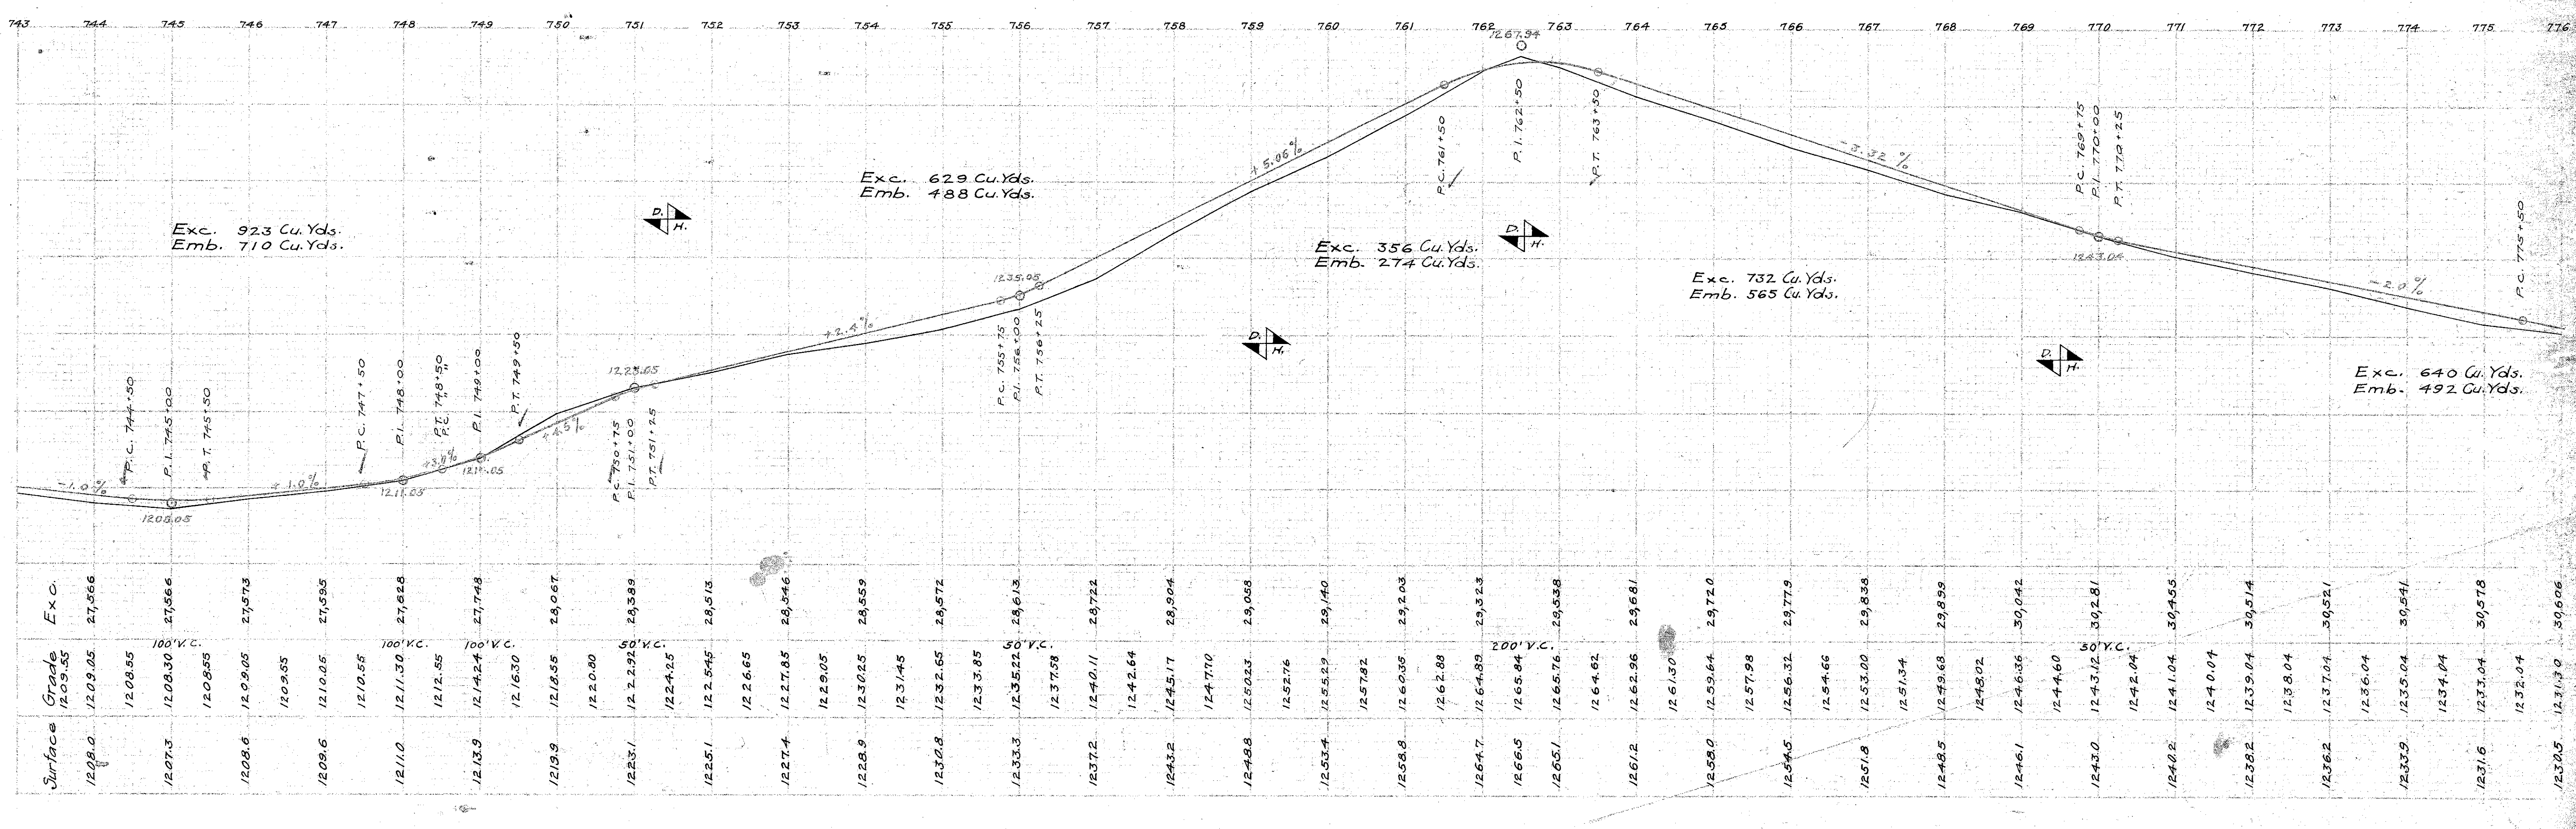


old CFN 284221429
new CFN 1826680
SLM 14.29, 3'x2'
CONCRETE BOX
EXT. IN 1935

Sta. 744+97 Remove old.
Build Stm. Design 3'x2' Box.
Length 32'

772 x 6.56
18
98.56

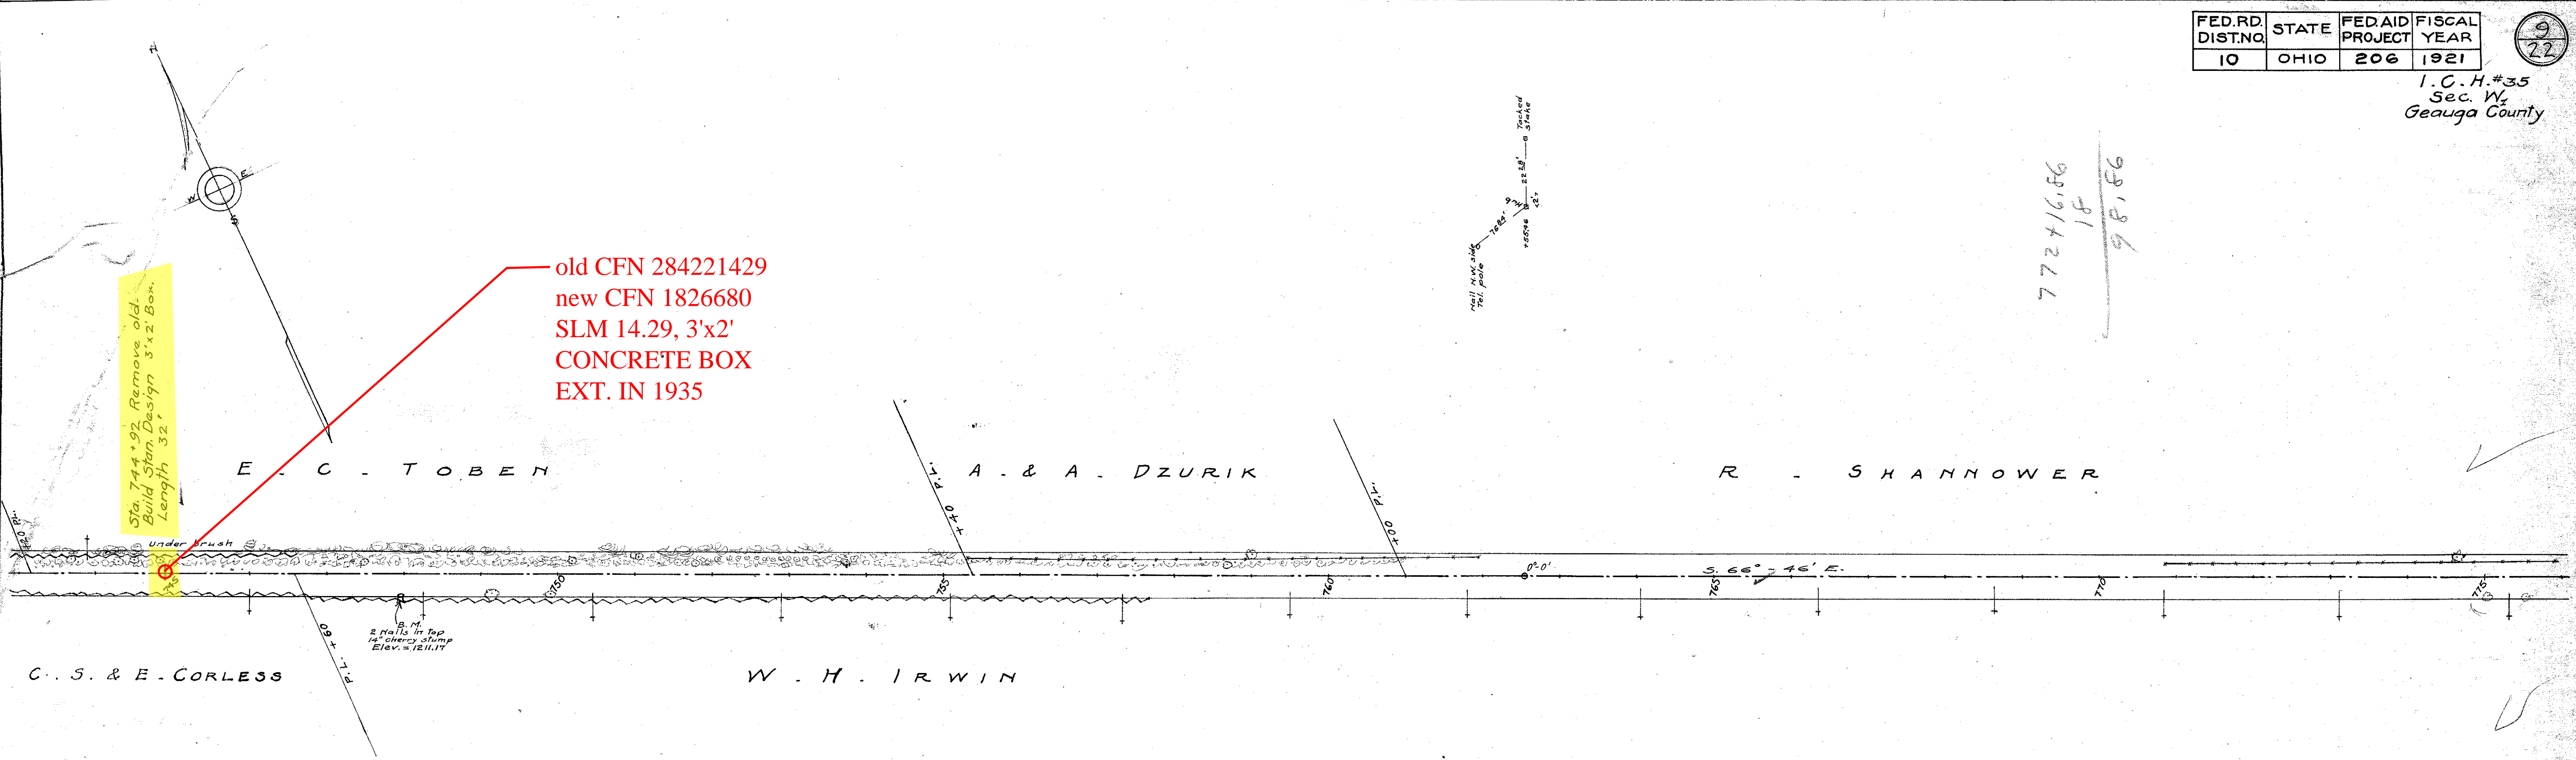

Exc. 923 Cu. Yds.
Emb. 710 Cu. Yds.

Exc. 629 Cu. Yds.
Emb. 488 Cu. Yds.

Exc. 356 Cu. Yds.
Emb. 274 Cu. Yds.

Exc. 732 Cu. Yds.
Emb. 565 Cu. Yds.

Exc. 640 Cu. Yds.
Emb. 492 Cu. Yds.