


FED. RD. DIVISION	STATE	PROJECT
2	OHIO	I-71-5(11)236

149
263


CUYAHOGA COUNTY
CUY-42-3.38

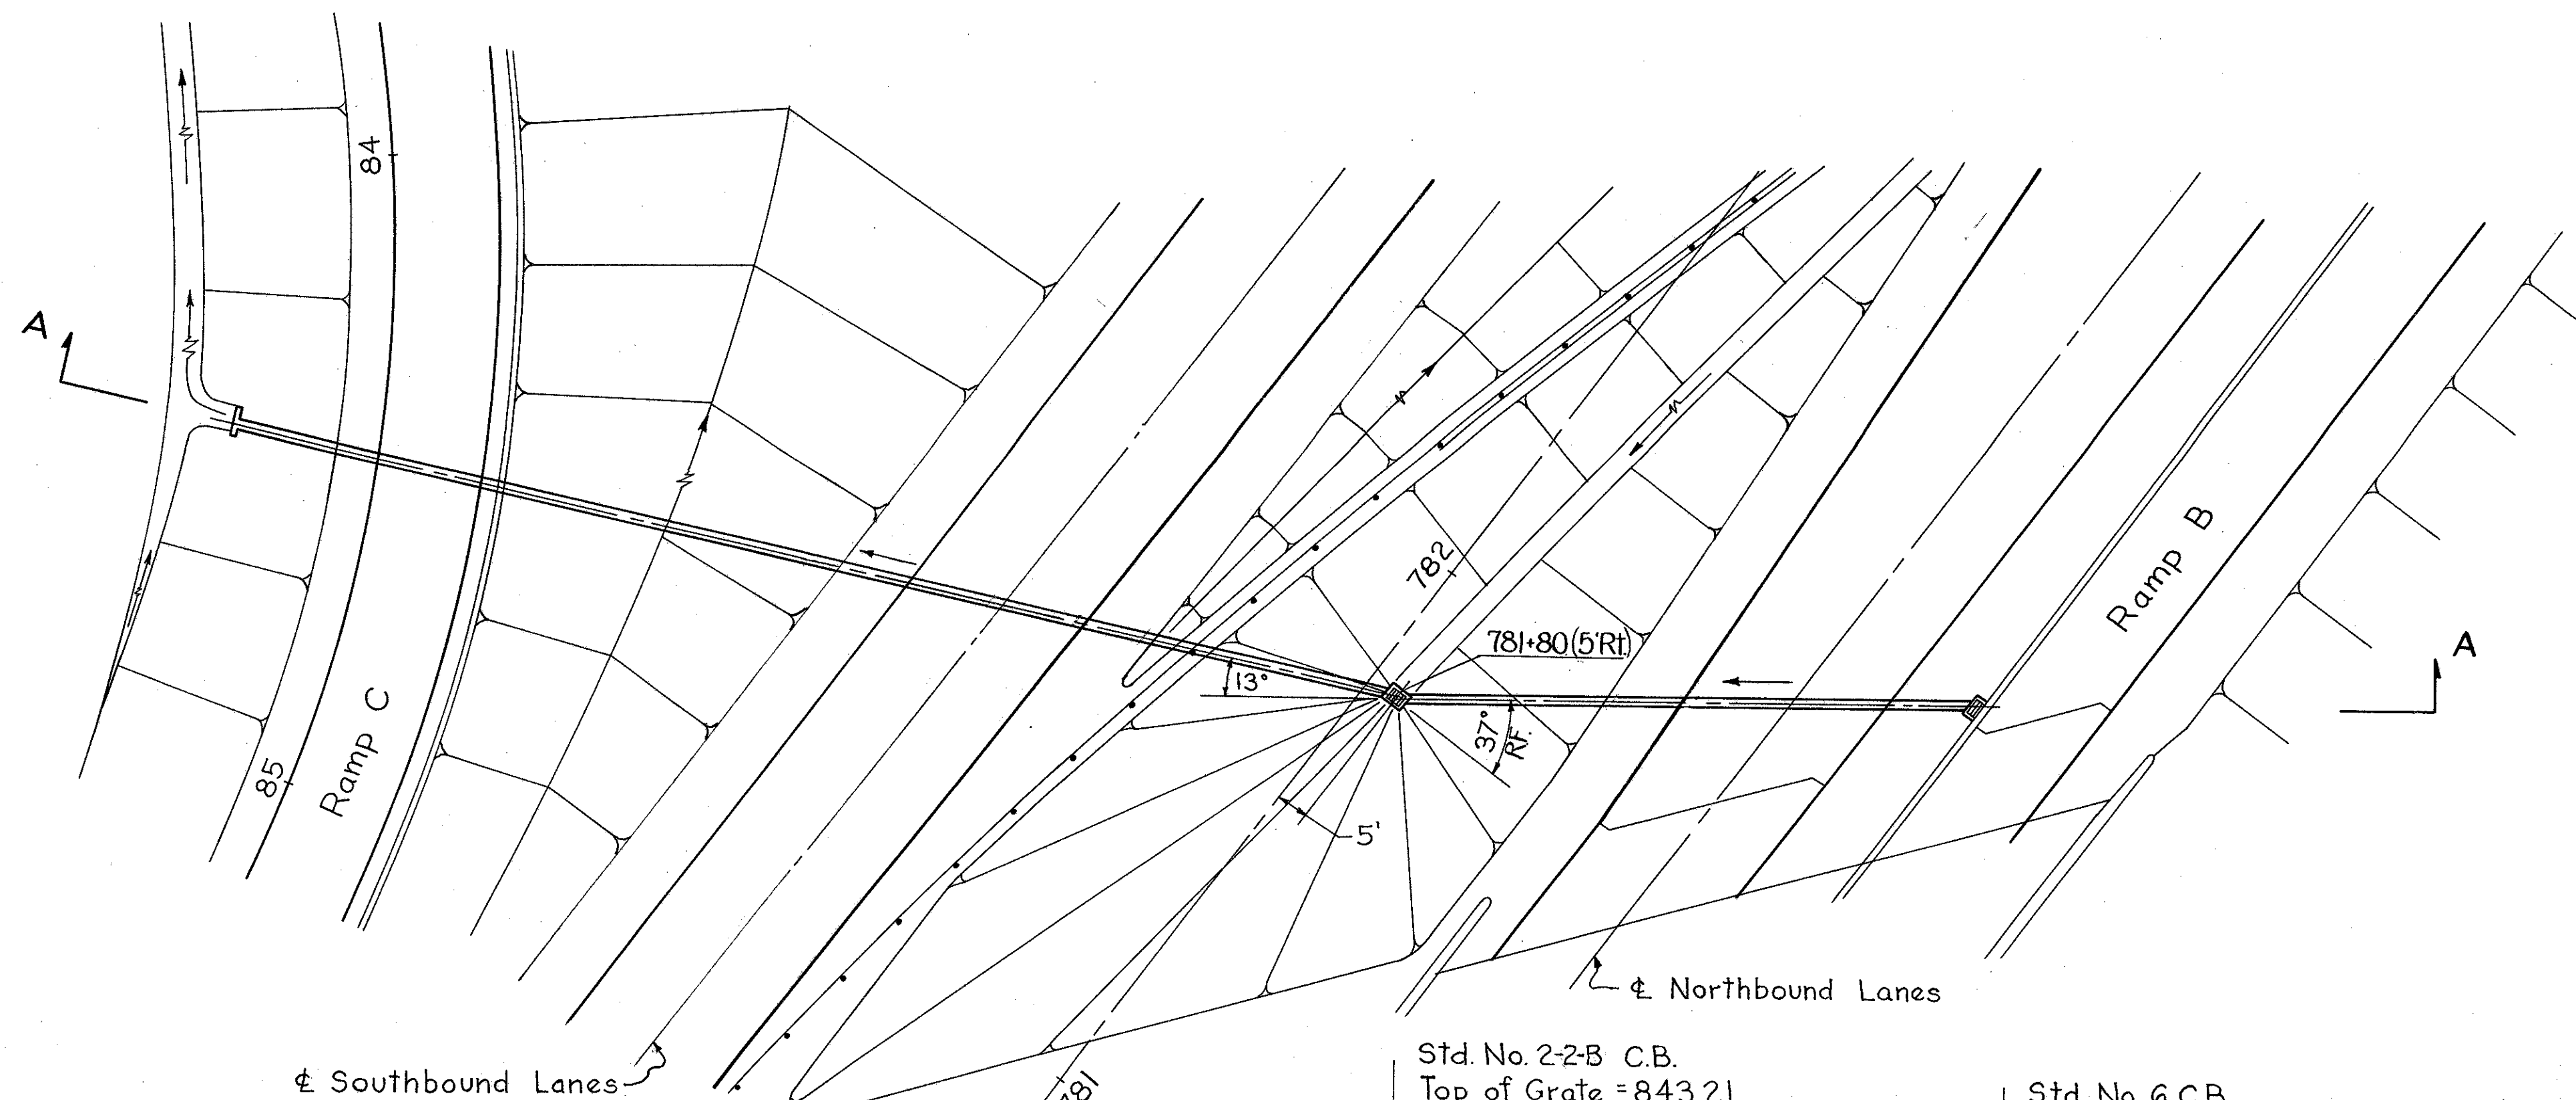


ESTIMATED QUANTITIES

I-1 12" Pipe Class J-1	90	L.F.
I-1 15" Pipe Class J-1	192	L.F.
I-2 Masonry	0.3	C.Y.
I-8 Std. No. 2-2-B C.B.	1	EA.
I-8 Std. No. 6 C.B.	1	EA.
L-10 Sodding	2	S.Y.

Drainage Area = 0.9 Ac
Q₁₀ = 2.7 CFS

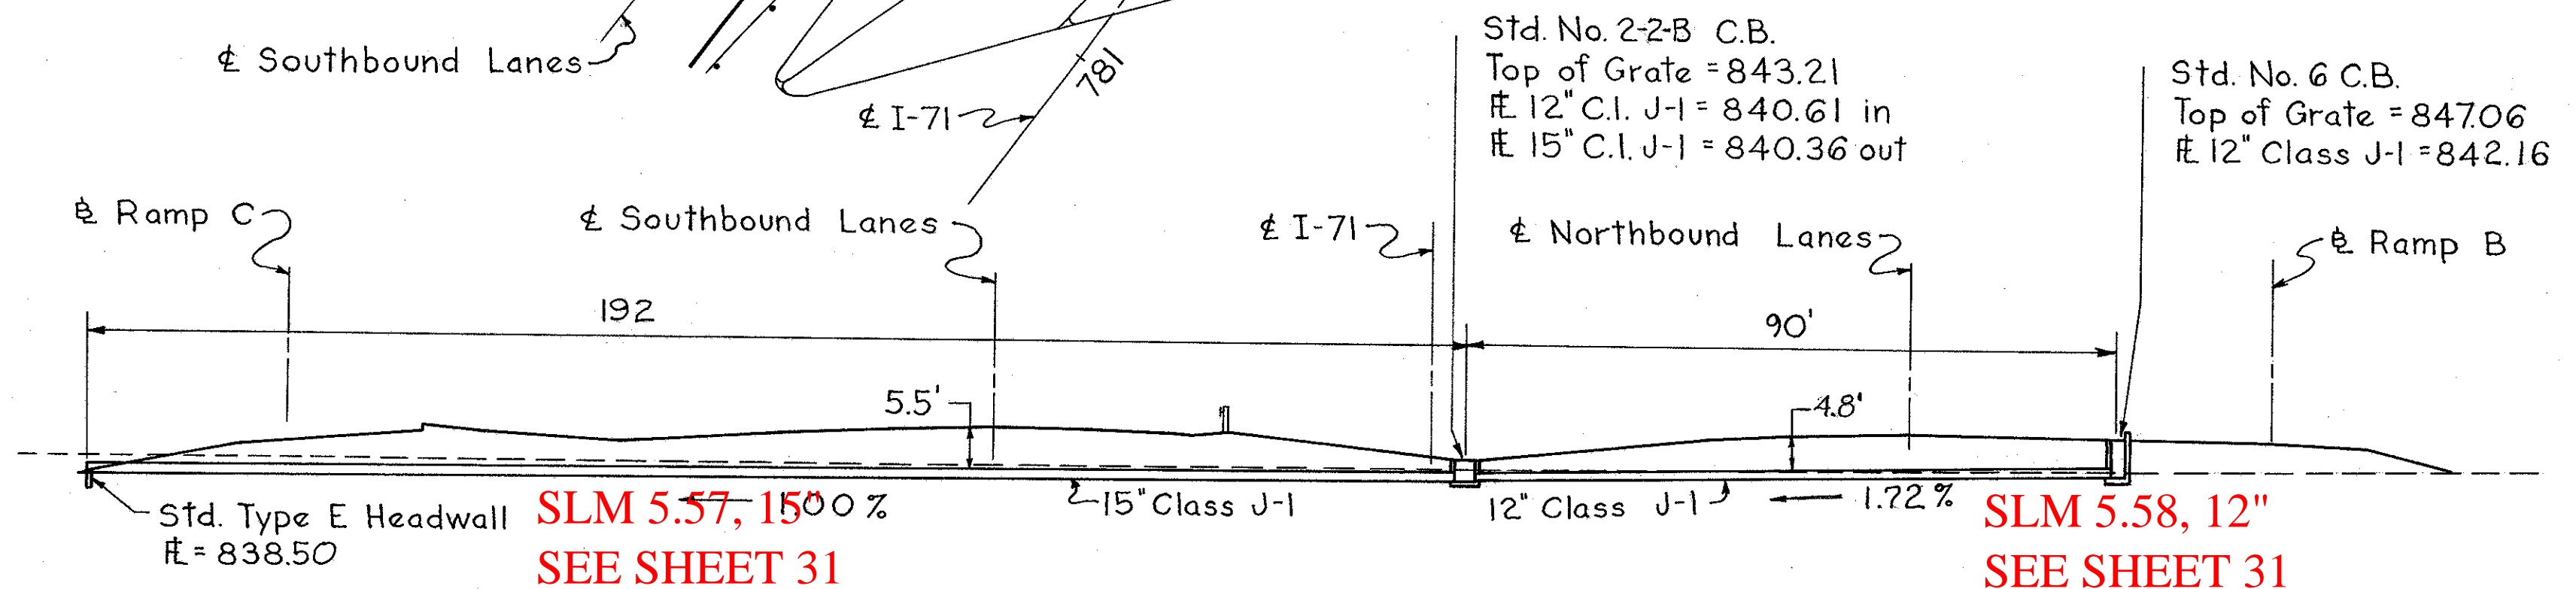

STORM SEWER AT STA. 781+80
Scale: 1" = 20'

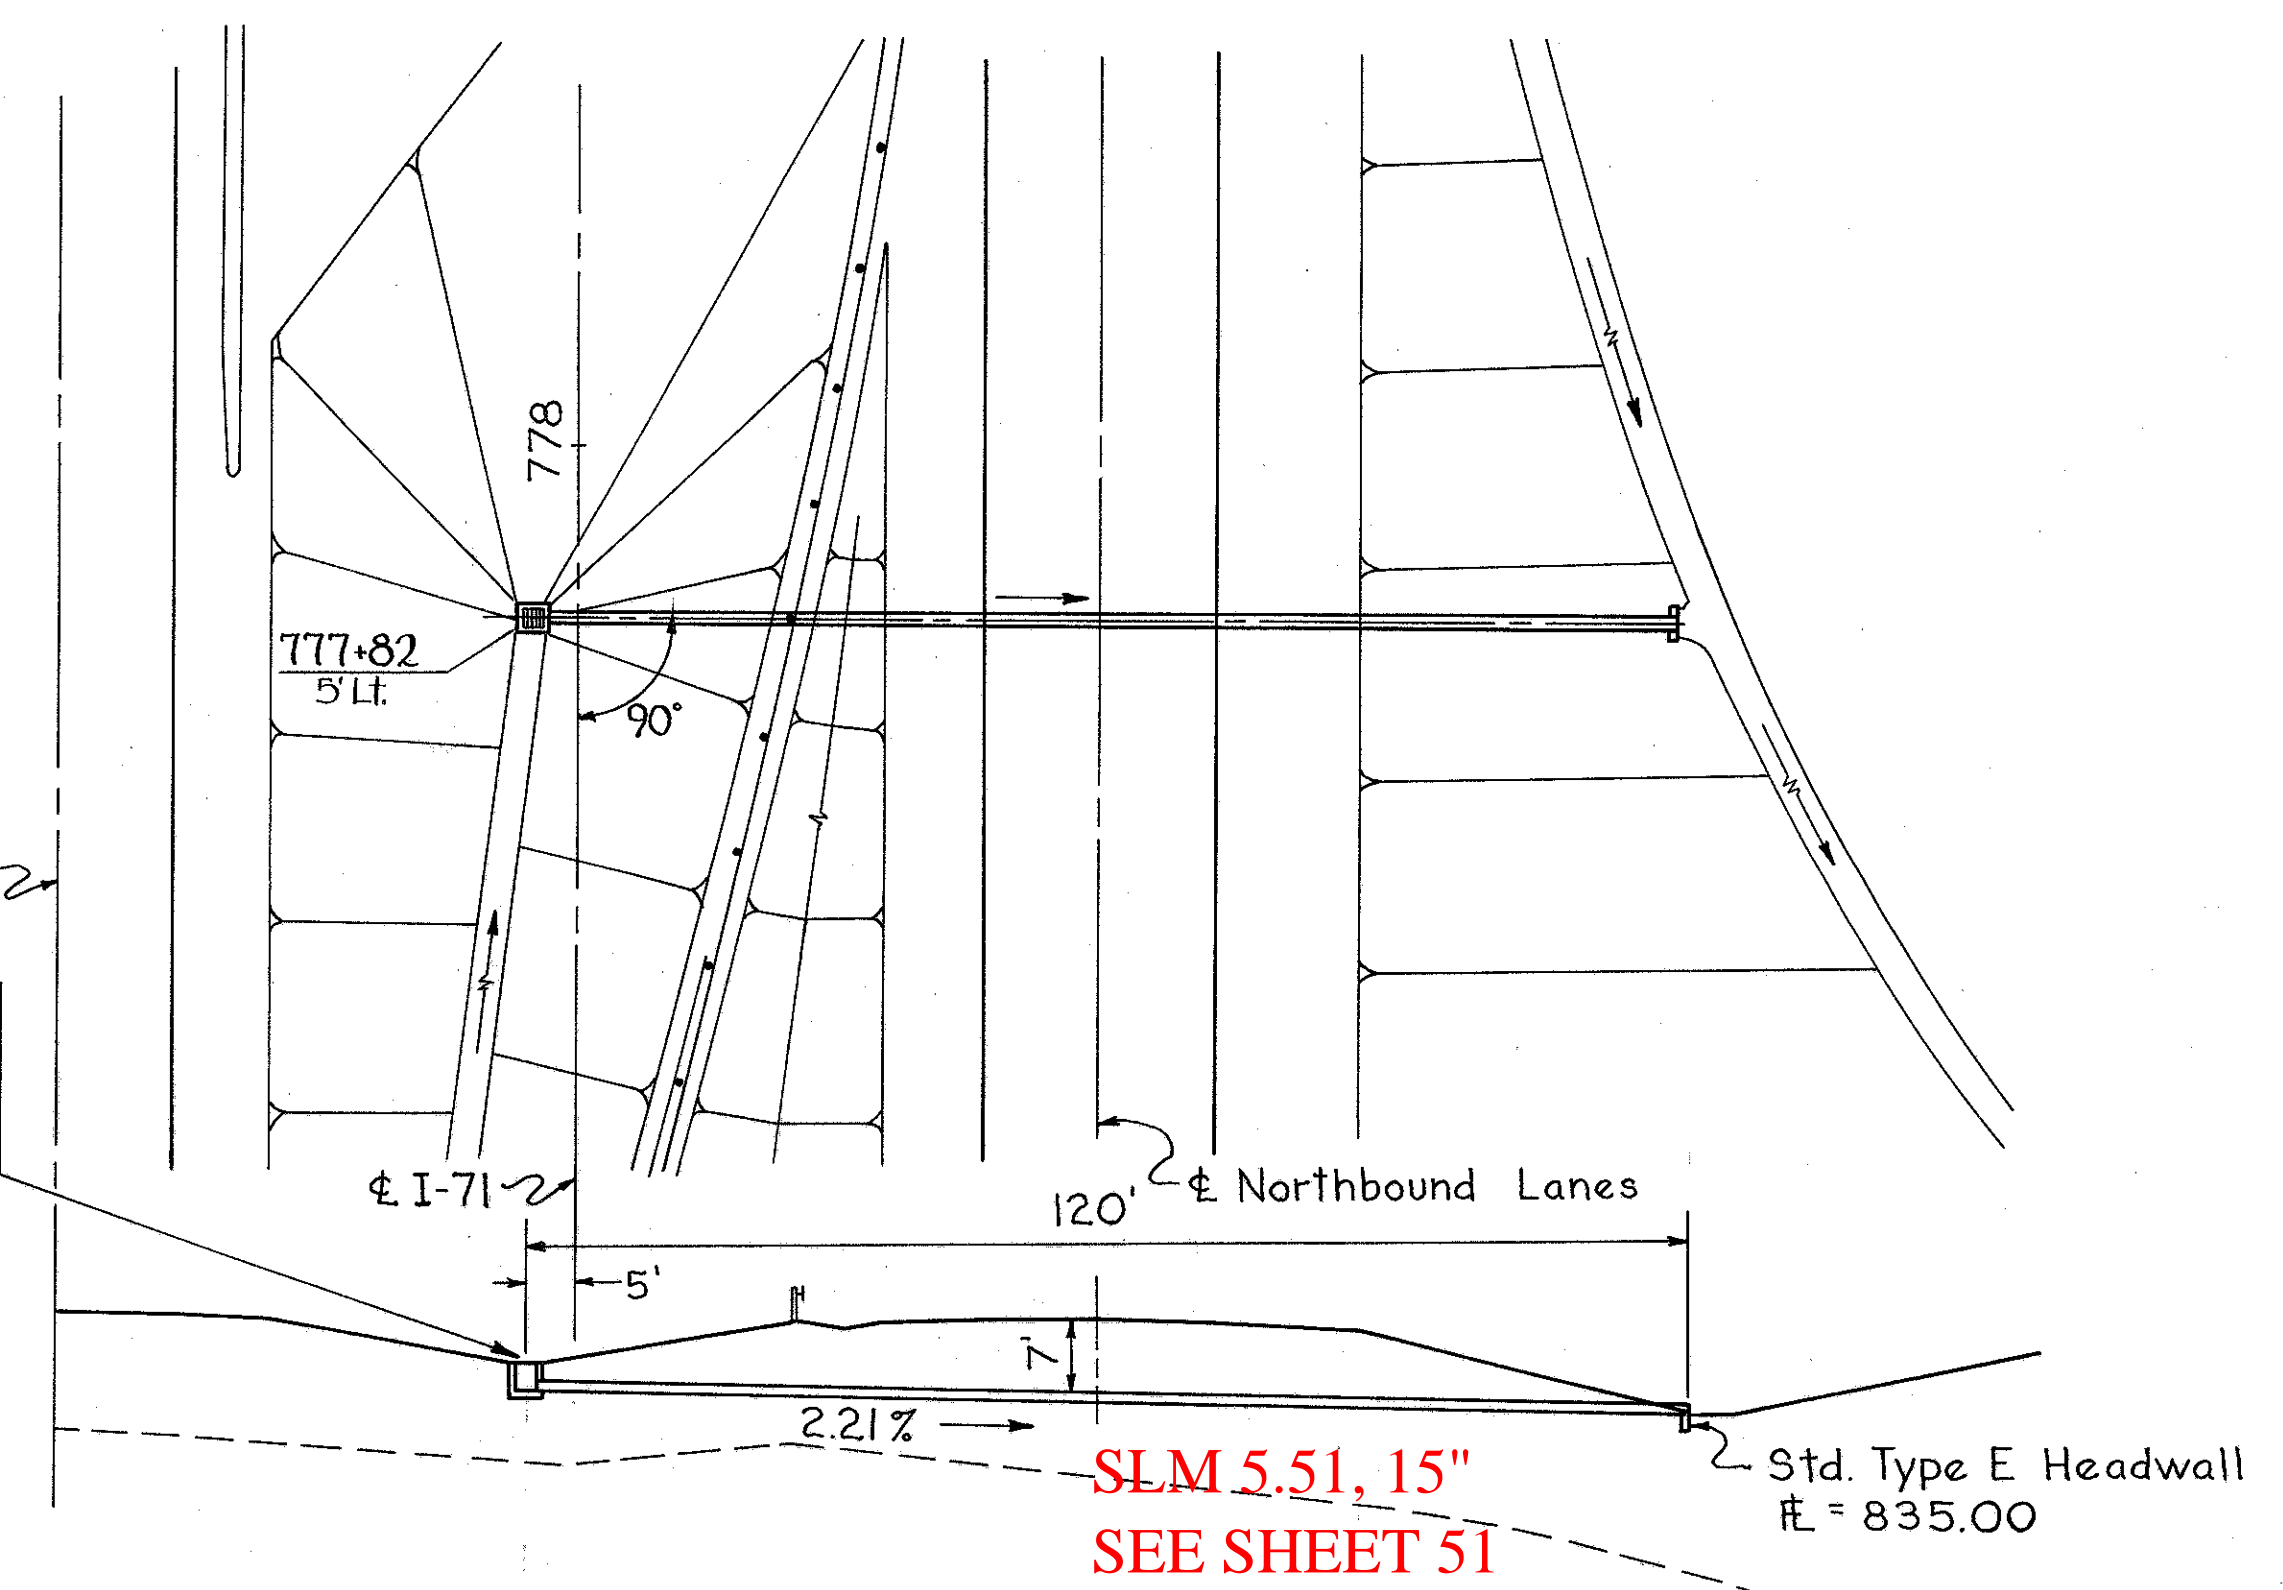

ESTIMATED QUANTITIES

I-1 15" Pipe Class J-1	120	L.F.
I-2 Masonry	0.3	C.Y.
I-8 Std. No. 2-2-B C.B.	1	EA.
L-10 Sodding	2	S.Y.

Drainage Area = 0.8 Ac
Q₁₀ = 2.4 CFS

STORM SEWER AT STA. 777+82
Scale: 1" = 20'