



SLM 4.32, 15"
SEE SHEET 51

Ref. P.O.T. Sta. 717+59.69
28' Beech
I-71
13.29' 110° 14' Elm
29.15' 12° Elm

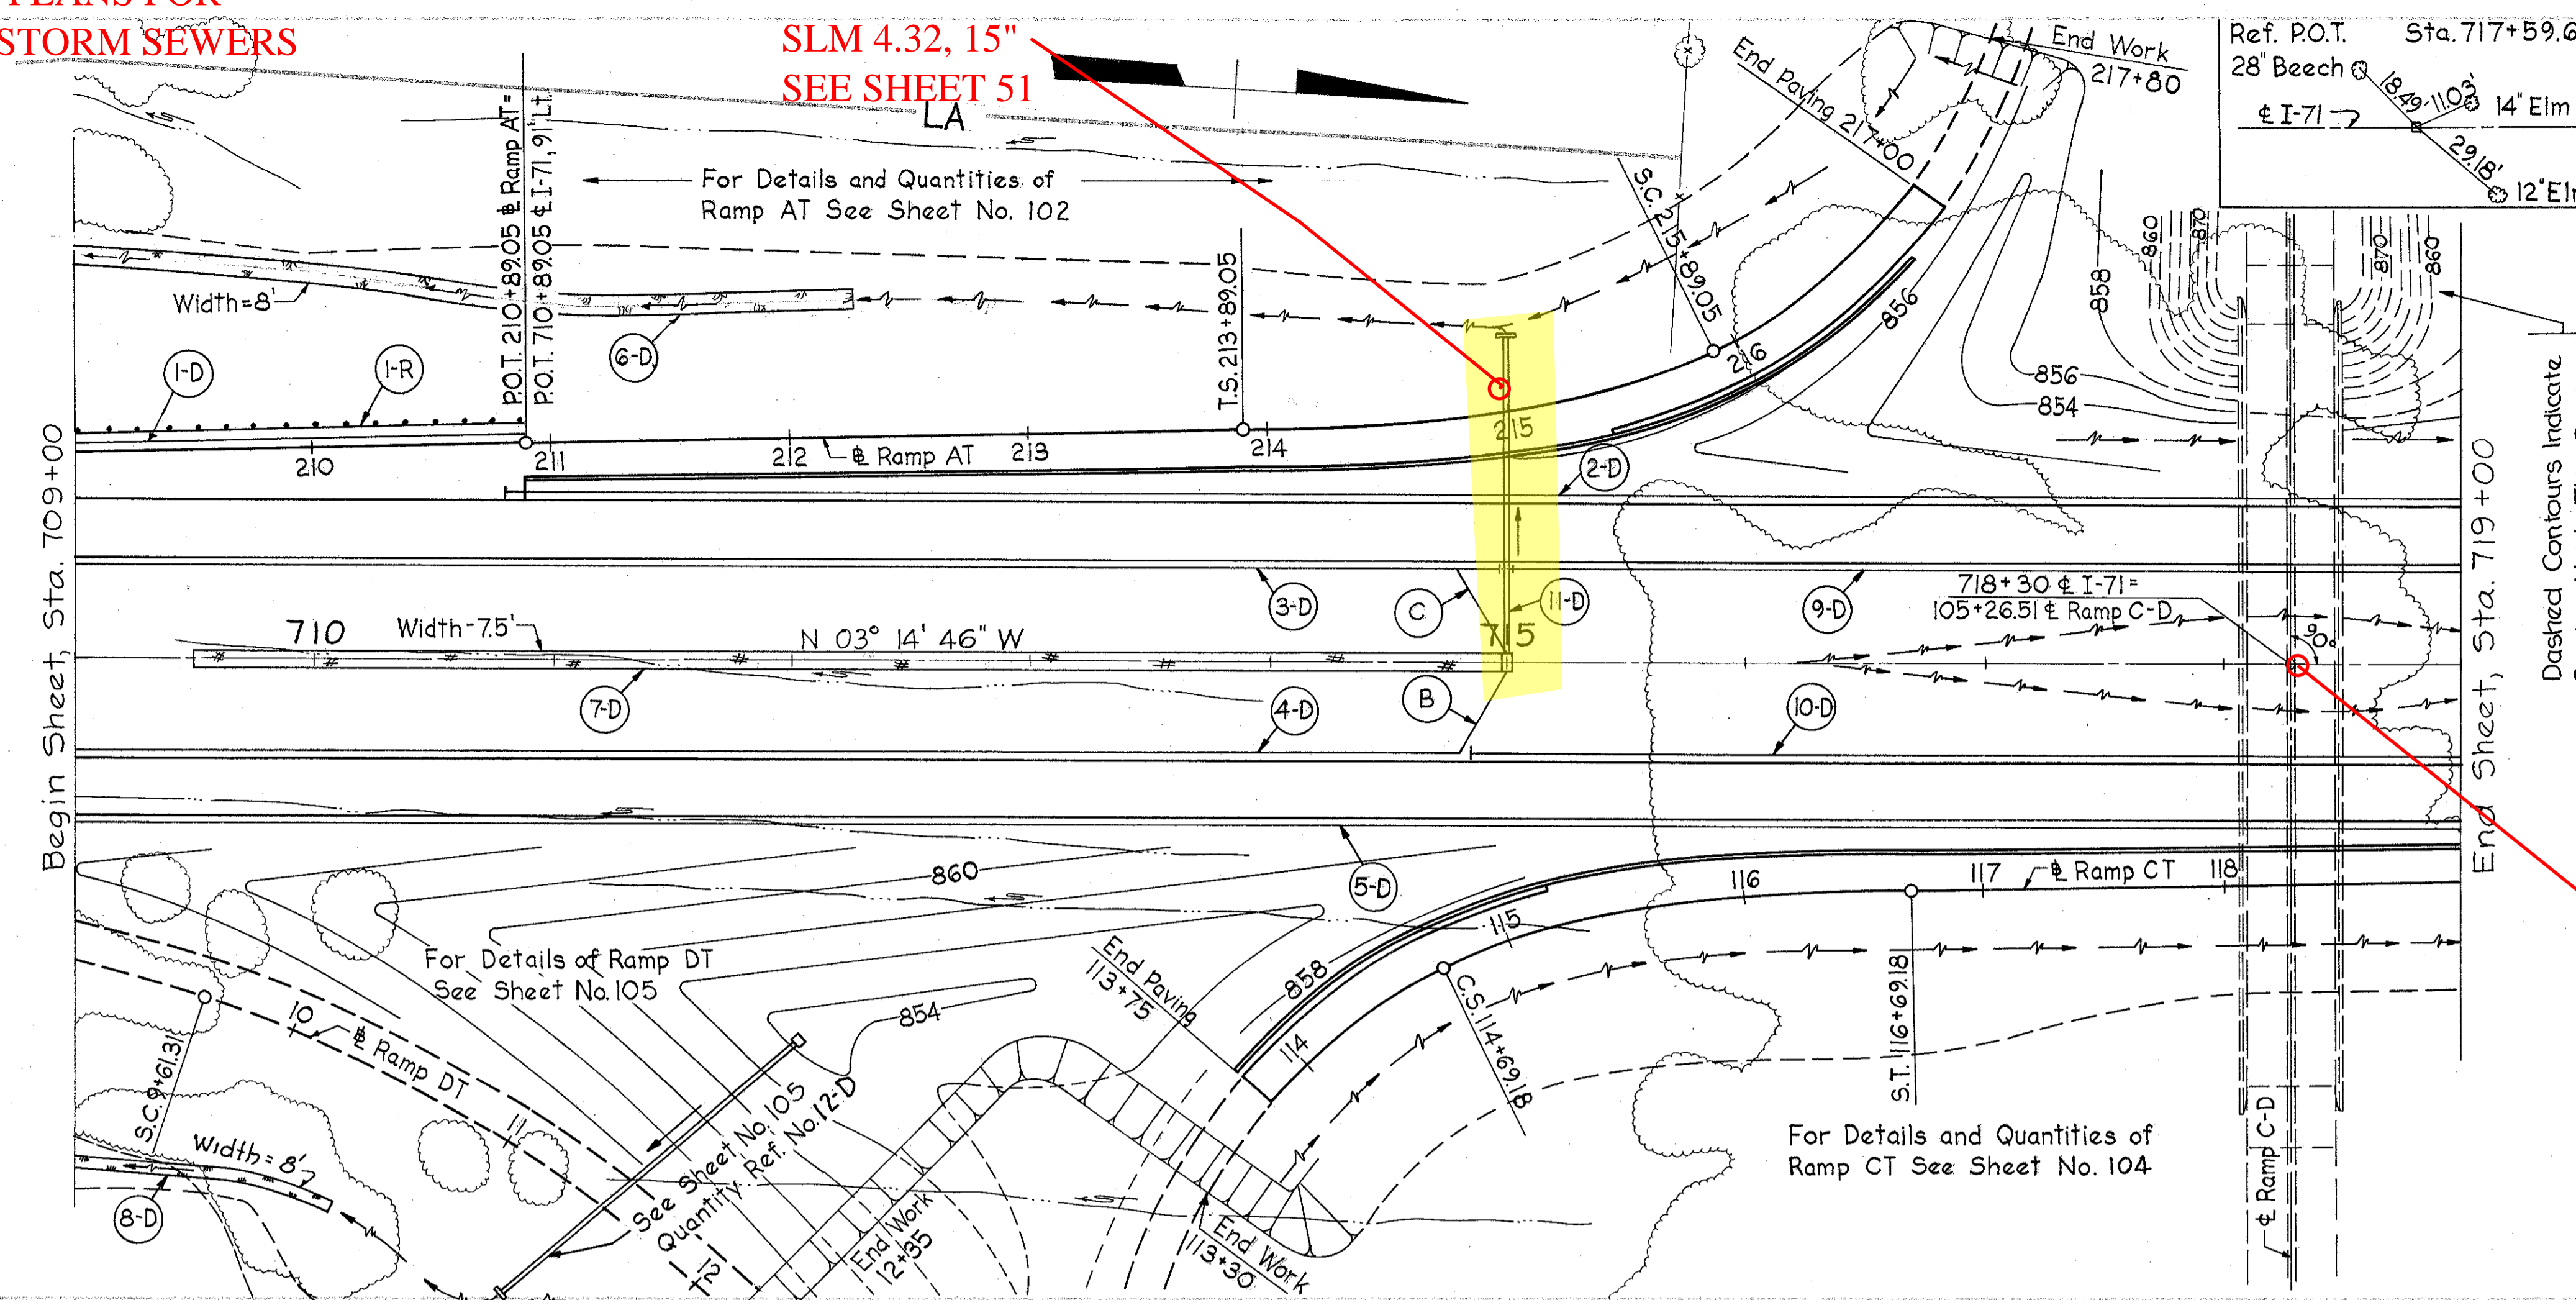

Dashed Contours Indicate Grading Not In This Contract

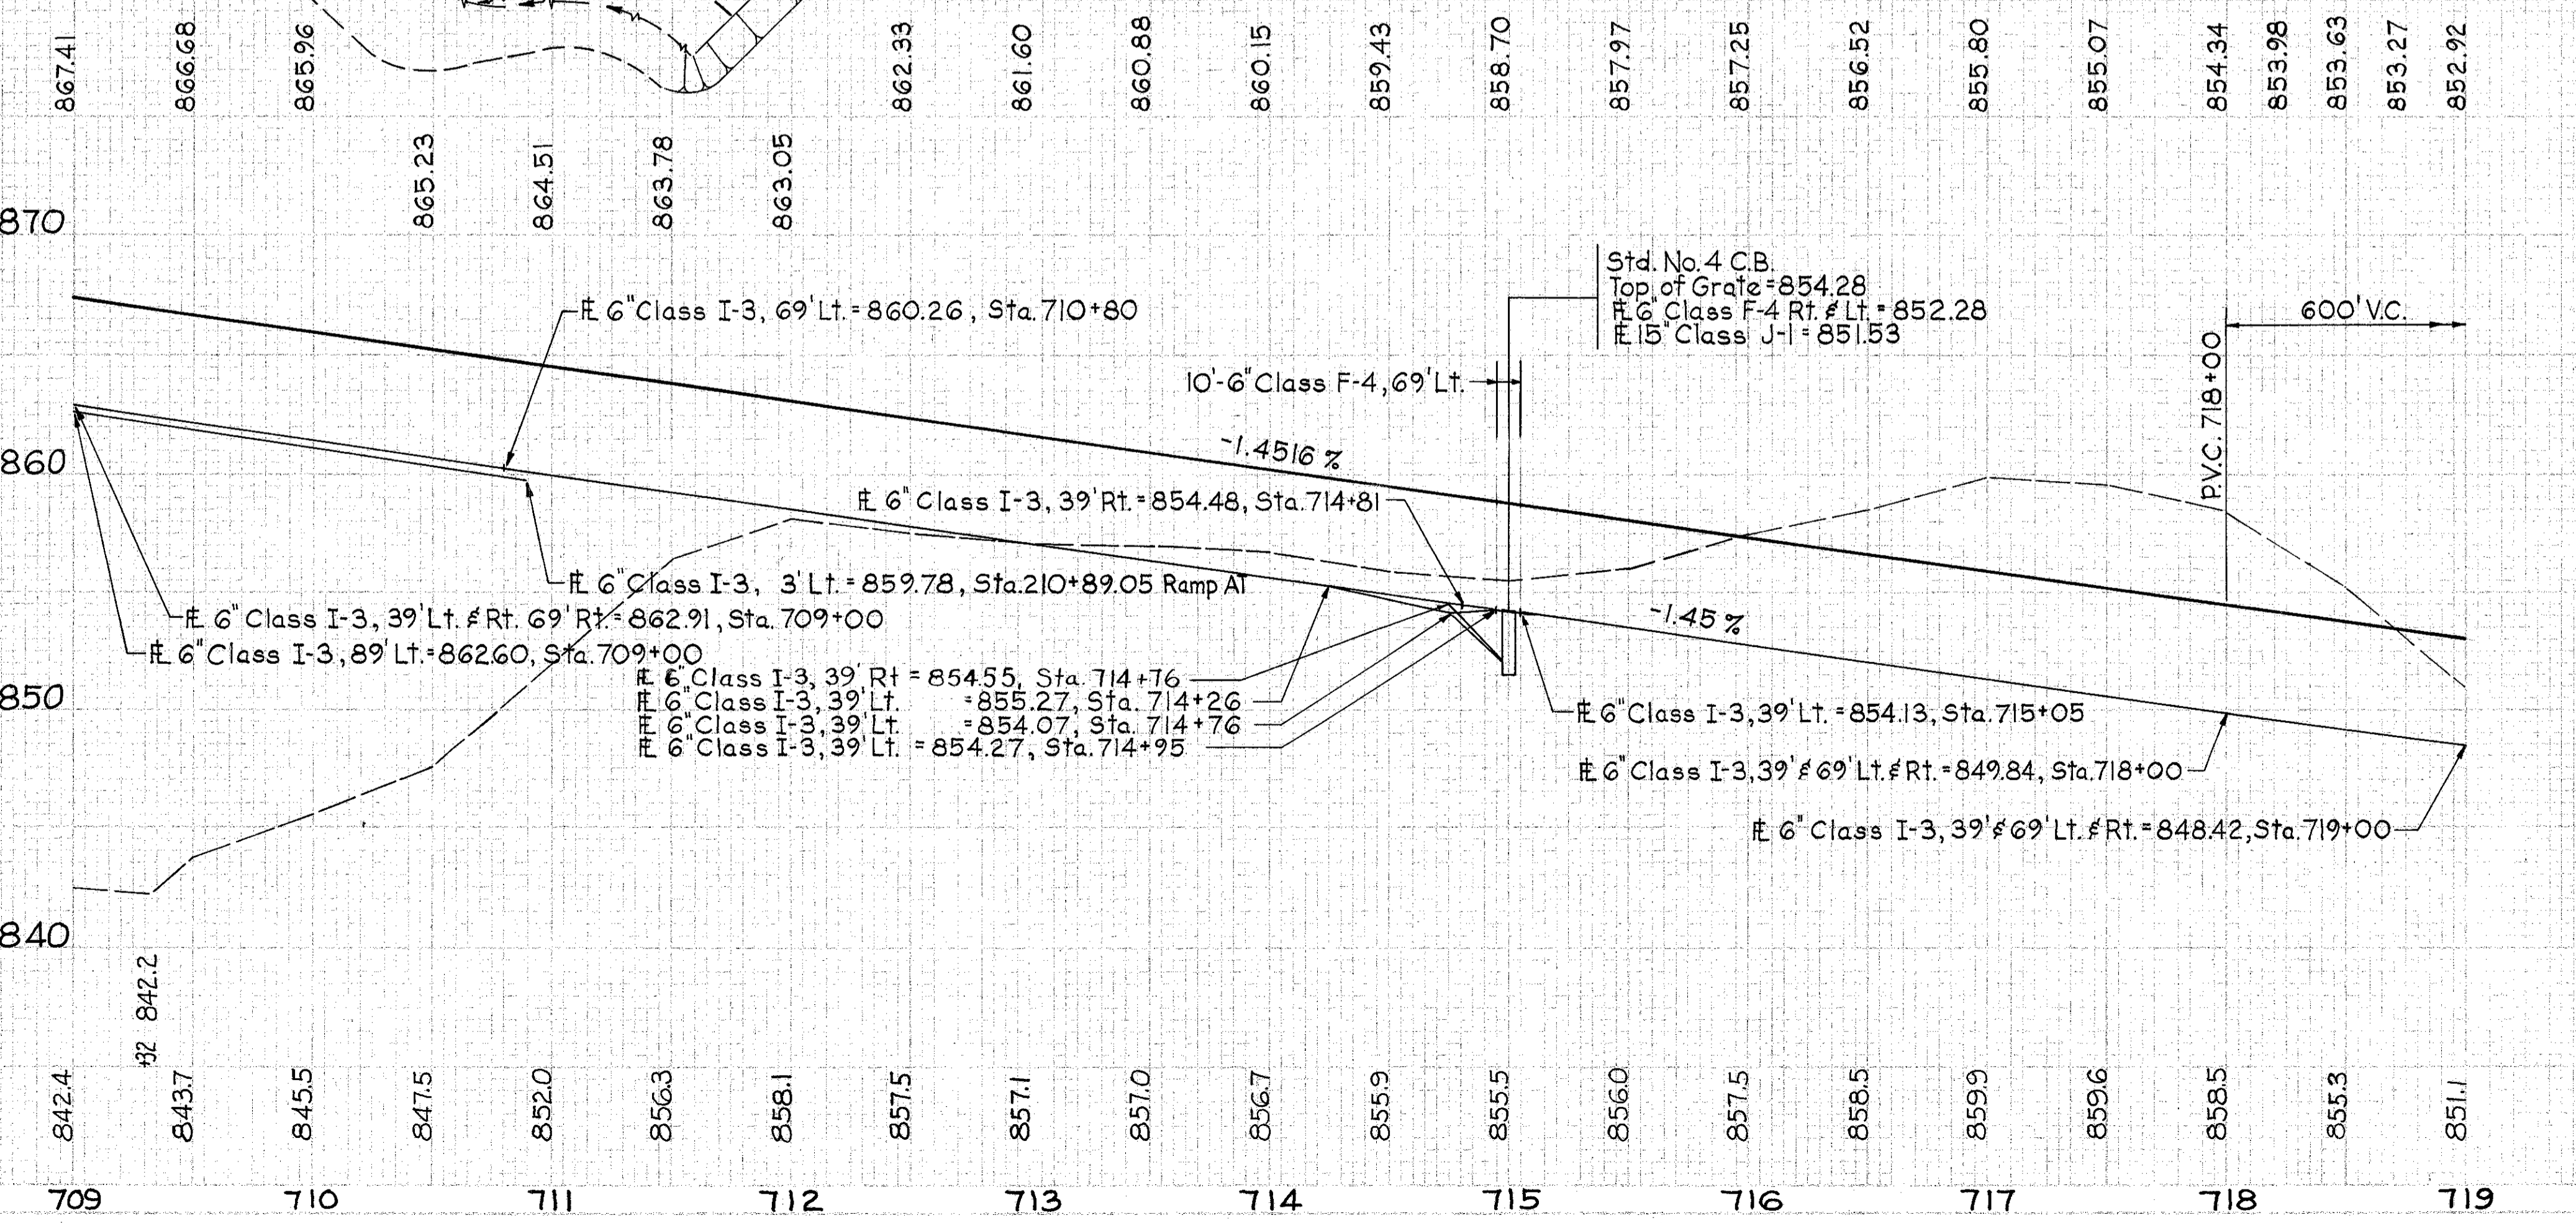

ESTIMATED QUANTITIES

| REF NO. | STATION TO STATION | SIDE | I-1 CI I-3 Pipe Shallow Lin. Ft. | I-1 CI F-4, CI, J-1 Pipe Lin. Ft. | I-1 15' Pipe Lin. Ft. | I-15 Guard Rail Lin. Ft. | I-2 Masonry Headwall Type E Sq. Yds. | I-10 Sodding No. 4 C. B. Sq. Yds. | I-8 Std Jute Matting Each | L-120 Sq. Yds. |
|---------------|-----------------------|------|-------------------------------------------|--------------------------------------------|--------------------------------|-----------------------------------|--------------------------------------------------|-----------------------------------------------|---------------------------------------|-------------------|
| I-D | 709+00 to 710+89 | Lt. | 190 | | | | | | | |
| 2-D | 710+80 to 719+00 | Lt. | 810 | | | | | | | |
| 3-D | 709+00 to 714+95 | Lt. | 625 | | | | | | | |
| 4-D | 709+00 to 715+00 | Rt. | 606 | | | | | 289 | | |
| 5-D | 709+00 to 719+00 | Rt. | 1000 | | | | | 133 | | 489 |
| 6-D | 709+00 to 712+25 | Lt. | | | | | | | | |
| 7-D | 709+50 to 715+00 | Med. | | | | | | | | |
| 8-D | 9+00 to 10+50 Ramp DT | Rt. | 395 | | | | | | | |
| 9-D | 715+05 to 719+00 | Rt. | 419 | | | | | | | |
| 10-D | 714+81 to 719+00 | Rt. | | | | | | | | |
| I-1 | 715+00 | Lt. | | | 134 | | | | | |
| I-R | 709+00 to 710+89 | Lt. | | | | 190 | 0.3 | 2 | 1 | |
| TOTALS | | | | | | | | | | |

* (40' 50% Slope & 50% Turnpike, 94' Normal)

TURNPIKE RAMPS
SLM 4.37 = MM 233.08