

SLM 4.42, 15"
SEE SHEET XX

SLM 4.46, 15"
SEE SHEET 53

SLM 4.53, 24"
SEE BELOW

SLM 4.46, 18"
SEE SHEET 53


SLM 4.58, 24"
SEE BELOW

SLM 4.58, 18"
SEE SHEET 55

SLM 4.53, 15"
SEE SHEET 54

SLM 4.58, 30"
SEE SHEET 55

SLM 4.58, 30"
SEE SHEET 55

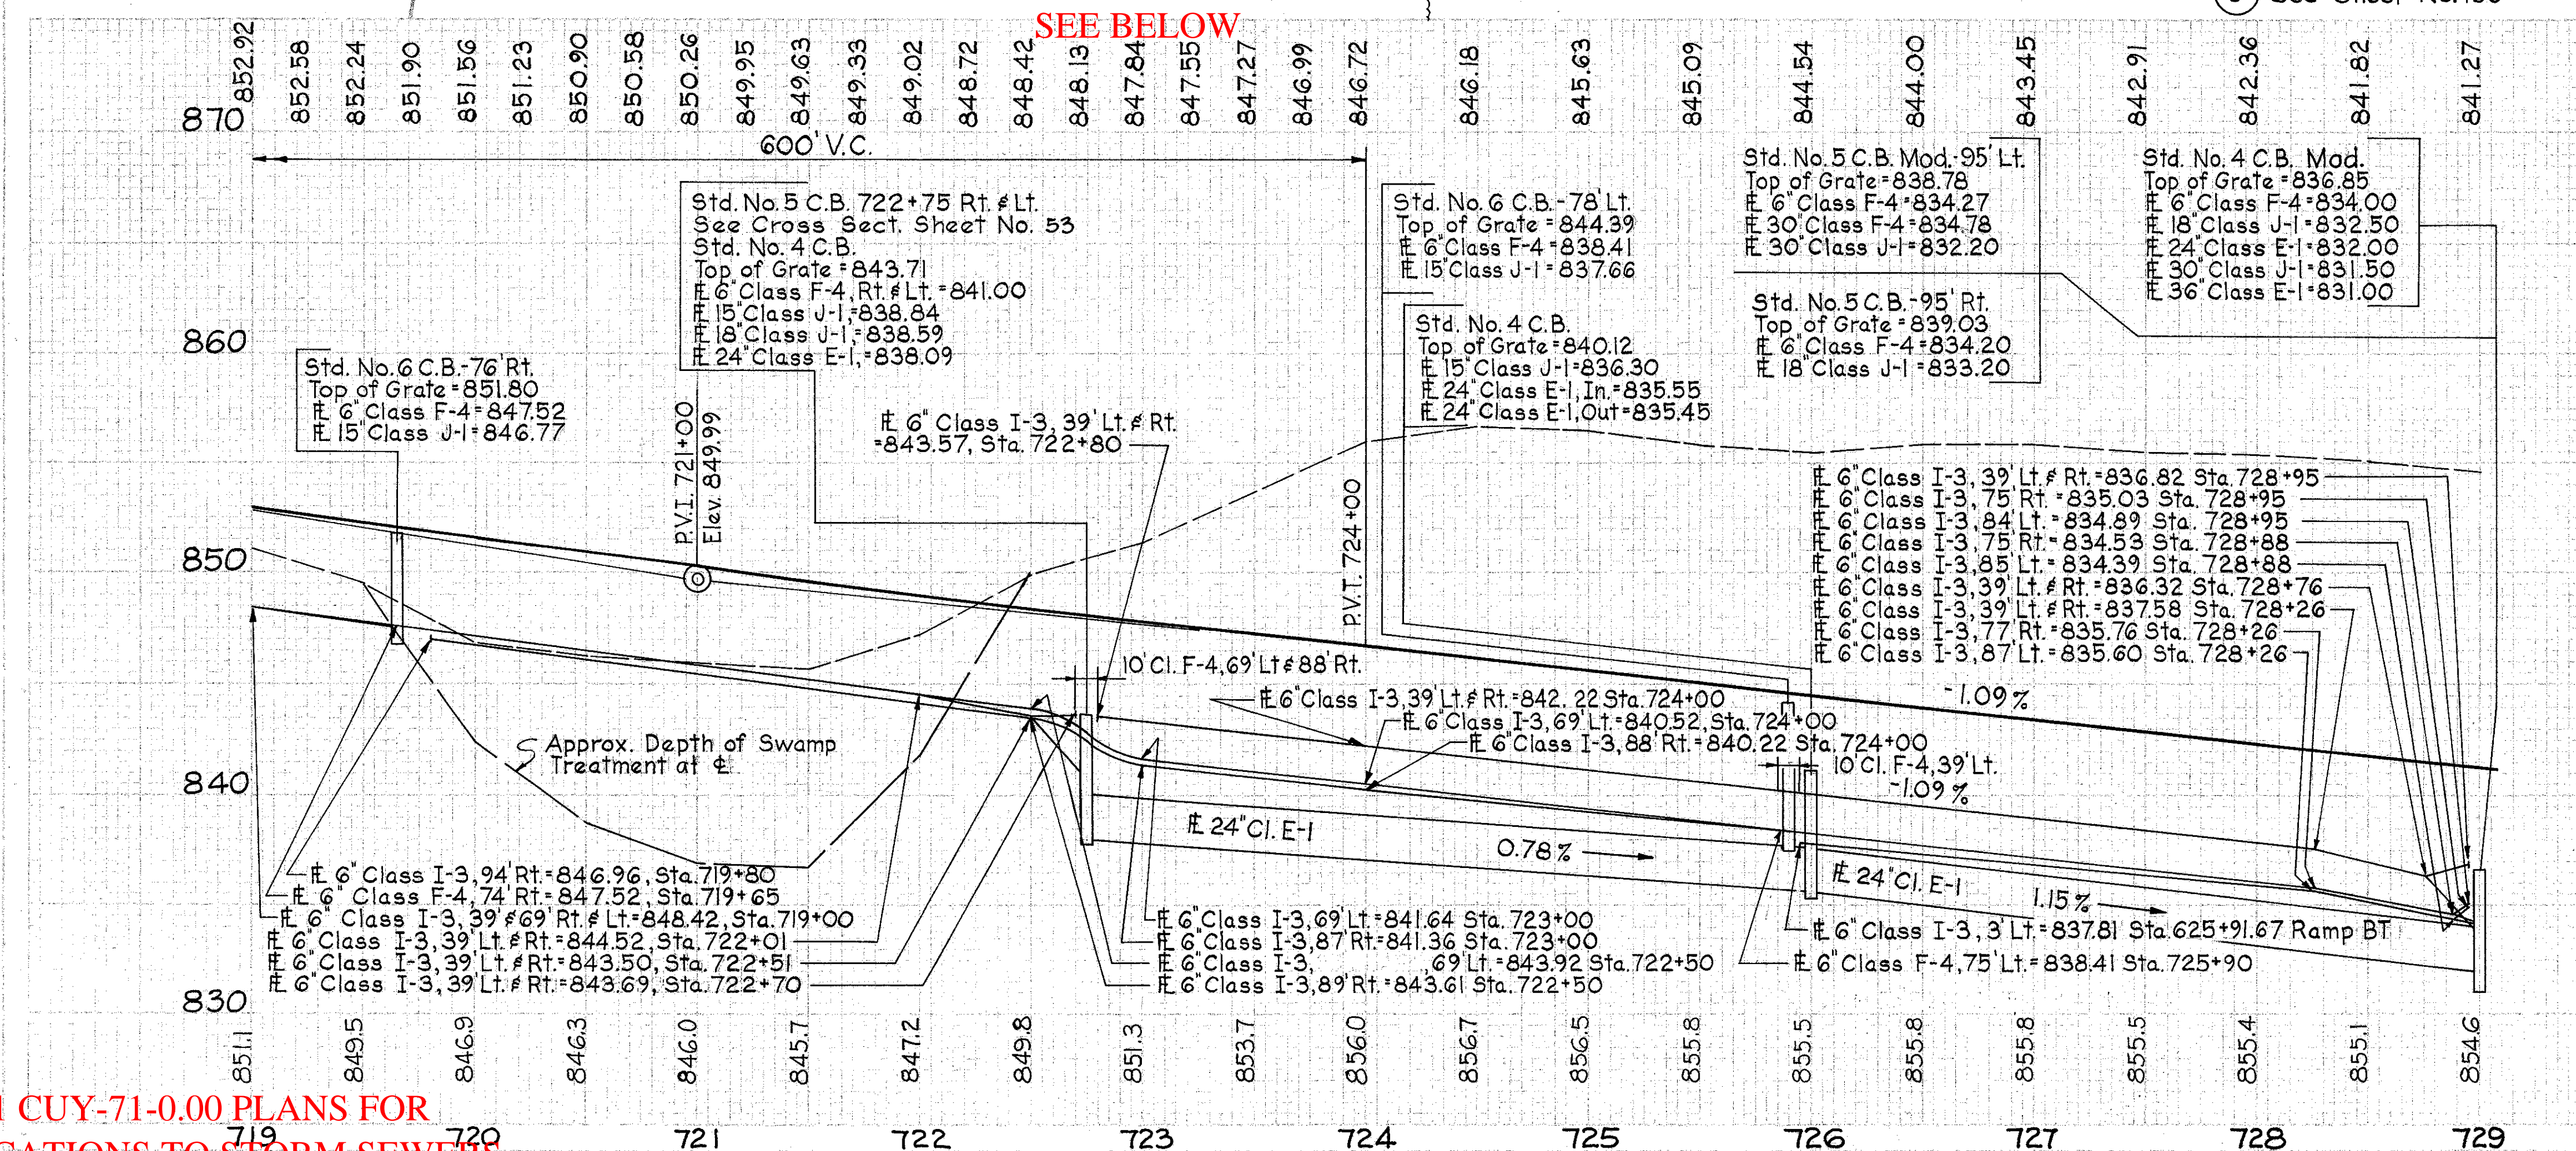

SEE 2001 CUY-71-0.00 PLANS FOR
MODIFICATIONS TO STORM SEWERS

REF. NO.	STATION TO STATION	SIDE	ESTIMATED QUANTITIES																			
			Class J-1	Class F-4	Class I-3	I-2	I-5	I-6	I-8	I-15	L-10	L-120										
			15" Lin. Ft.	18" Lin. Ft.	24" Lin. Ft.	30" Lin. Ft.	36" Lin. Ft.	Shallow	Deep	Headwall	Masonry	Pipe Special	CI-F-4	Stand. C.B.	Stand. No. 5	Stand. No. 6	Stand. No. 6	Special Guard Rail	Sodding	Jute Matting	Other	
I-D	719+00 to 725+90	Lt.																				
2-D	719+00 to 722+70	Lt.																				
4-D	719+00 to 722+70	Rt.																				
5-D	719+00 to 728+95	Rt.																				
9-D	722+80 to 728+95	Lt.																				
7-D	722+80 to 728+95	Lt.																				
8-D	722+80 to 728+95	Lt.																				
9-D	722+80 to 728+95	Lt.																				
10-D	722+75 to 722+75	Med.																				
11-D	722+75 to 729+00	Med.																				
13-D	724+50 to 729+00	Med.																				
14-D	727+50 to 729+00	Lt.																				
15-D	727+50 to 729+00	Lt.																				
16-D	727+50 to 729+00	Lt.																				
I-R	727+04 to 727+84	Med.																				
2-R	727+04 to 727+84	Lt.																				
			194	200	102	625	110	46	2,785	1,399	0.5	6	2	2	3	1	1	1	100	3	799	1
TOTALS																						

Sta. 719+00 to Sta. 729+00